




FED. ROAD DIST. NO.	STATE	FED-AID PROJ. NO.	FISCAL YEAR	SHEET NO.	TOTAL SHEETS
HAWAII	HAW.	11NP-01-80M	1980	6	10

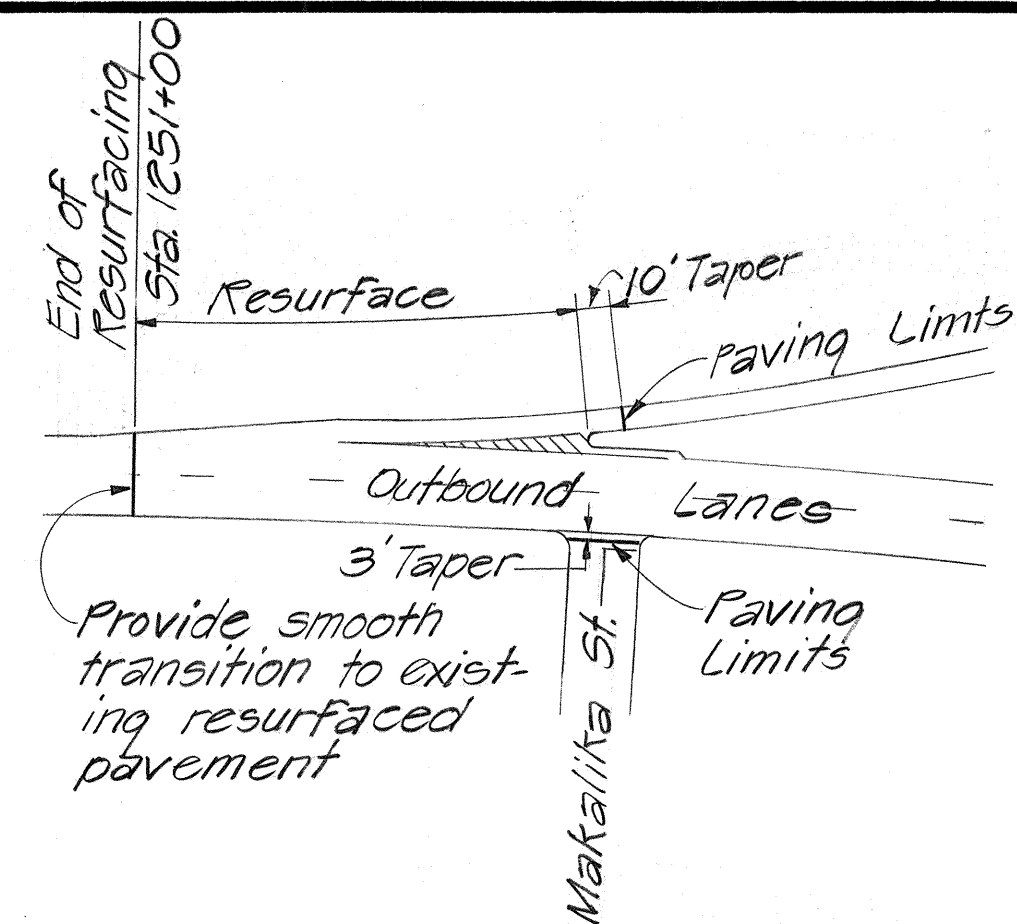


DETAIL AT MAKALIKA ST.
STA. 1251+00 TO STA. 1253+00

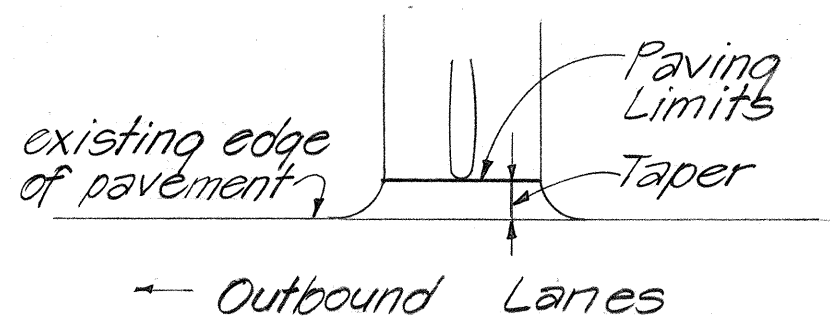


DETAIL AT KILAUEA
AVE. CONNECTION
STA. 1265+64

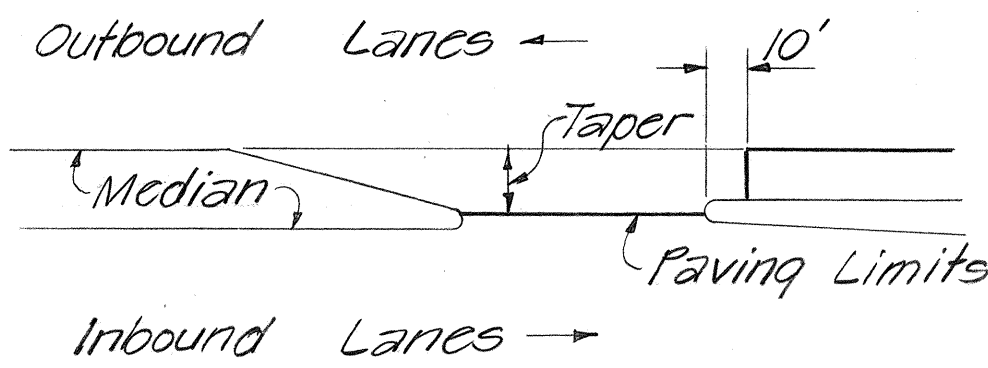


MEDIAN DETAILS AT
PALAI, KAHAOPEA, &
KAWAILANI STREETS

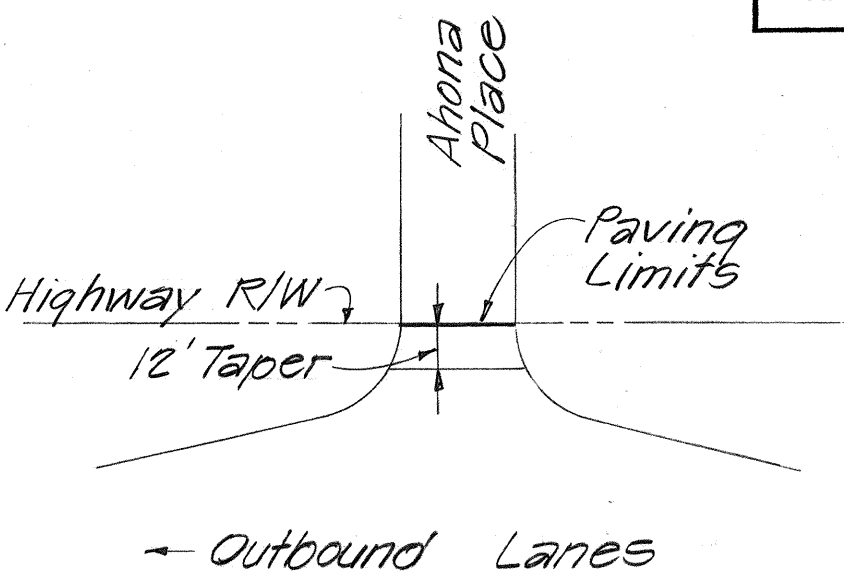


DETAIL AT
AHONA PLACE
STA. 1318+62

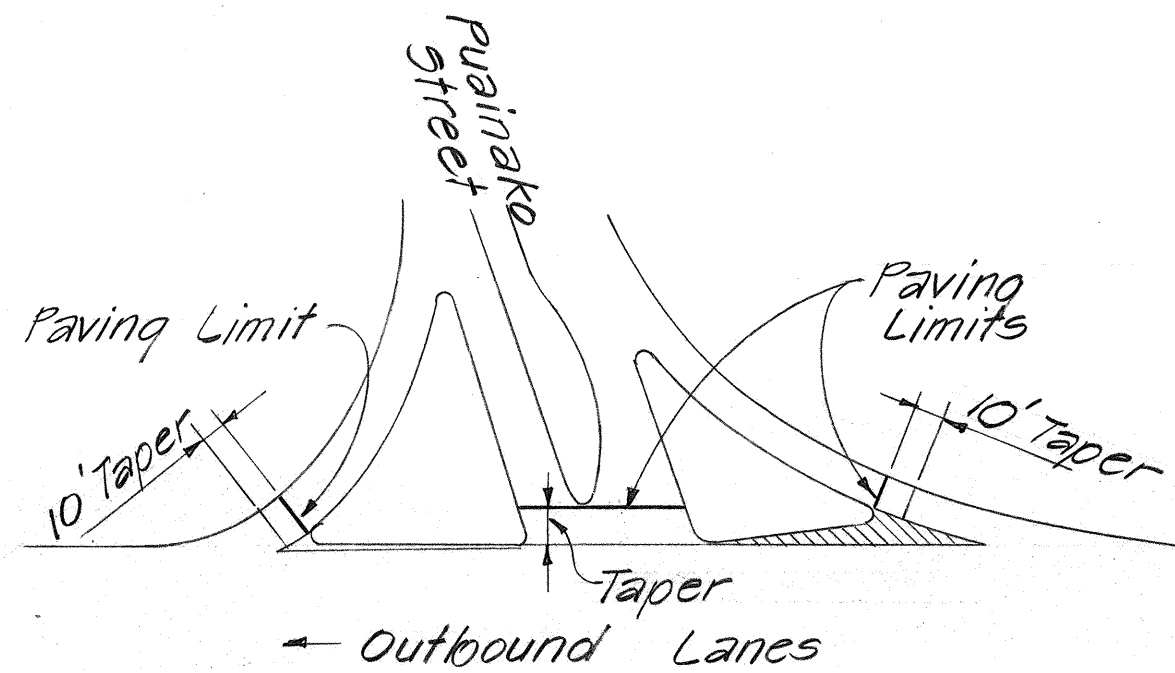


DETAIL AT PUAINAKO ST.

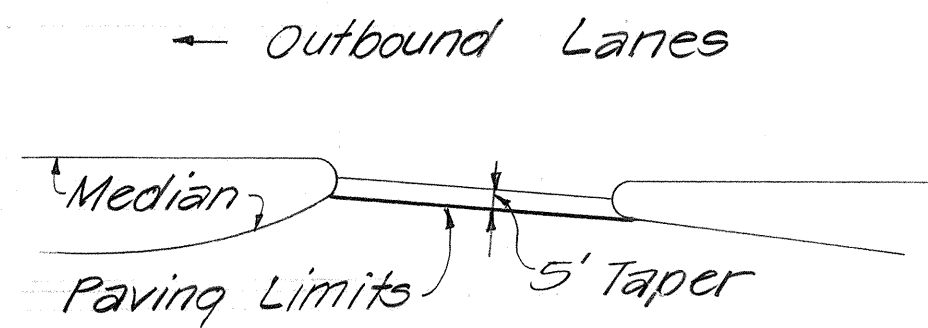

MEDIAN DETAILS AT PIILANI,
KEKUANAOA, LEILANI, KAWILI,
MAKAALA, AND PUAINAKO ST.,
AND KILAUEA AVENUE

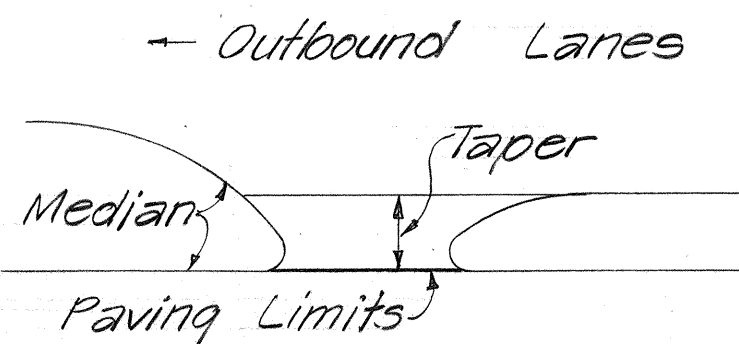

MEDIAN DETAILS
AT POHAKU ST.

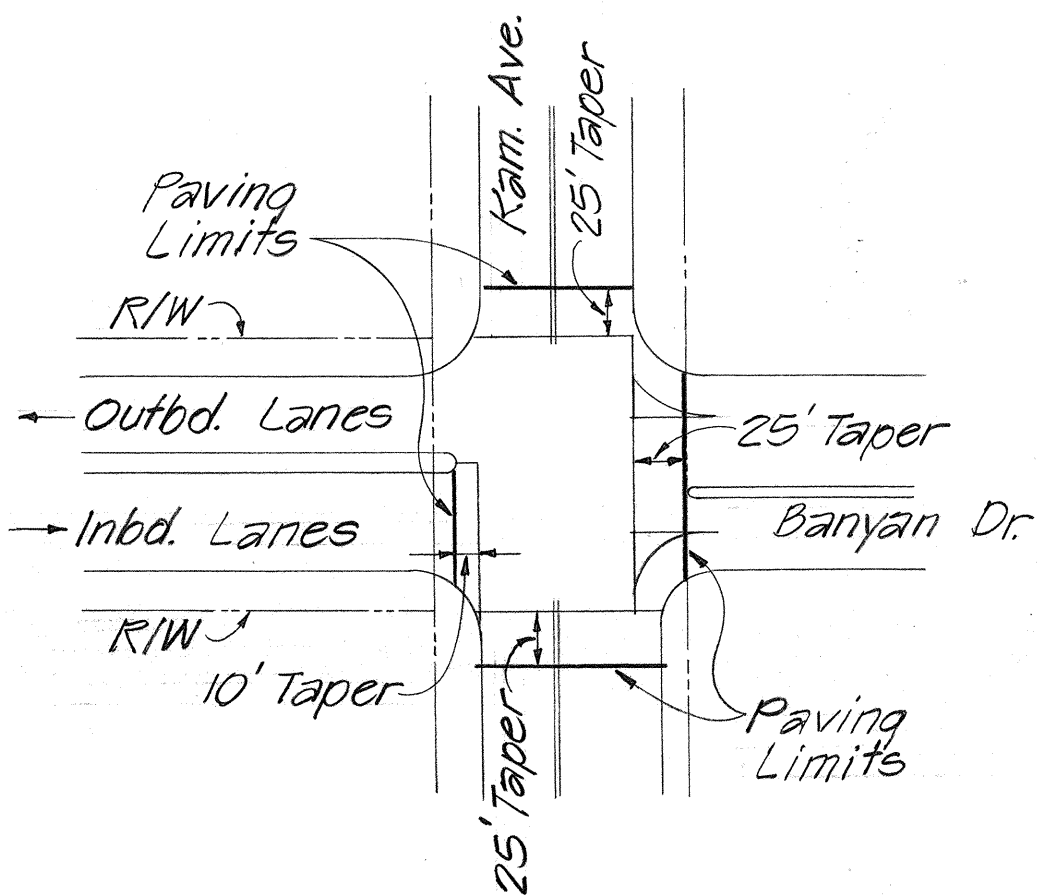

DETAIL AT KAMEHAMEHA AVE.

UTILITY & STREET MONUMENT SCHEDULE						
STATION	UTILITY (WATER & SEWER)		STREET MONUMENT		REMARKS	
	Water V.B.	Water M.H.	Sewer M.H.	St. Survey & Mon.		
No Station	4.5			+ 2	1	Kam. Intersection
86 + 65±	3				1	@ Piilani St.
78 + 80±			1		1	@ Hualani St.
69 + 76±			±	1	±	@ Kekuanaoa St.
61 + 34±	3		1		1	@ Leilani St.
52 + 90					1	@ Lanikaula St.
48 + 26					1	@ Kawili St.
42 + 65.86					1	
36 + 85				1		@ Pohaku St.
33 + 11.71					1	
25 + 00					1	
23 + 00	1					@ Makaala St.
1351 + 44					1	@ Puainako St.
1349 + 57.13					1	
1335 + 81.49					1	
1318 + 70		±				@ Ahona Place
1298 + 30					1	
1271 + 42.32					1	@ Equation St.
1255 + 00	±					@ Makalika St.
1251 + 00					1	End of Project
					1	@ Kuanono St.
1256 + 00					1	F.A.P.
TOTALS	12	± 0	3 2	± 4	± 17	@ Kanoelehua

STATE OF HAWAII
DEPARTMENT OF TRANSPORTATION
HIGHWAYS DIVISION

KANOELEHUA AVE. DETAILS
KANOELEHUA AVENUE
RESURFACING
PROJECT NO. 11NP-01-80M
Date: July 1979
SHEET No. 1 OF 1 SHEETS

SURVEY PLOTTED BY	DATE
DRAWN BY	
DESIGNED BY	
CHECKED BY	
ORIGINAL PLAN	
NOTE BOOK	
No.	