	INDEX TO DRAWINGS
SHEET NO.	DESCRIPTION
l	TITLE SHEET
2-3	GENERAL LOCATION PLANS
4	TYPICAL SECTIONS & DETAILS
5	PAVEMENT MARKERS SCHEDULE
6	KANOELEHUA AVENUE DETAIL
7	CONCRETE DITCH & SPILLWAY
8-10	STANDARD DETAILS



#### STATE OF HAWAII

### DEPARTMENT OF TRANSPORTATION

HIGHWAYS DIVISION

AS BUILI PLANS FOR

# QUEEN KAAHUMANU HIGHWAY RESURFACING PALANI ROAD TO HONOKOHAU HARBOR

PROJECT NO. 19A-01-80M

DISTRICT OF NORTH KONA

CONTRACTOR: OKADA TRUCKING CO., LTD. CONTRACT NO: 11205

## KANOELEHUA AVENUE RESURFACING KAMEHAMEHA AVENUE TO MAKALIKA STREET

PROJECT NO. IINP-01-80M

DISTRICT OF SOUTH HILO

CONTRACTOR: JAMES W. GLOVER, LTD.
CONTRACT NO: 11204

## HAWAII BELT ROAD RESURFACING HAWAII VOLCANOES NATIONAL BOUNDARY TOWARD PAHALA

PROJECT NO. 11H-01-80M

DISTRICT OF KAU

CONTRACTOR: JAMES W. GLOVER, LTD.
CONTRACT NO: 11204

CITY OF REFUGE ROAD RESURFACING HAWAII BELT ROAD TO SCENIC LOOKOUT


FEDERAL AID SECONDARY PROJECT NO. RS-0160(6)

DISTRICT OF SOUTH KONA

CONTRACTOR: OKADA TRUCKING CO., LTD. CONTRACT NO: L1205

 FED. ROAD DIST. NO.
 STATE
 PROJECT NO.
 FISCAL YEAR NO.
 SHEET SHEETS

 HAWAII
 HAW.
 II NP-0I-80M II H-0I-80M RS-0I60(6)
 1980 I
 IO

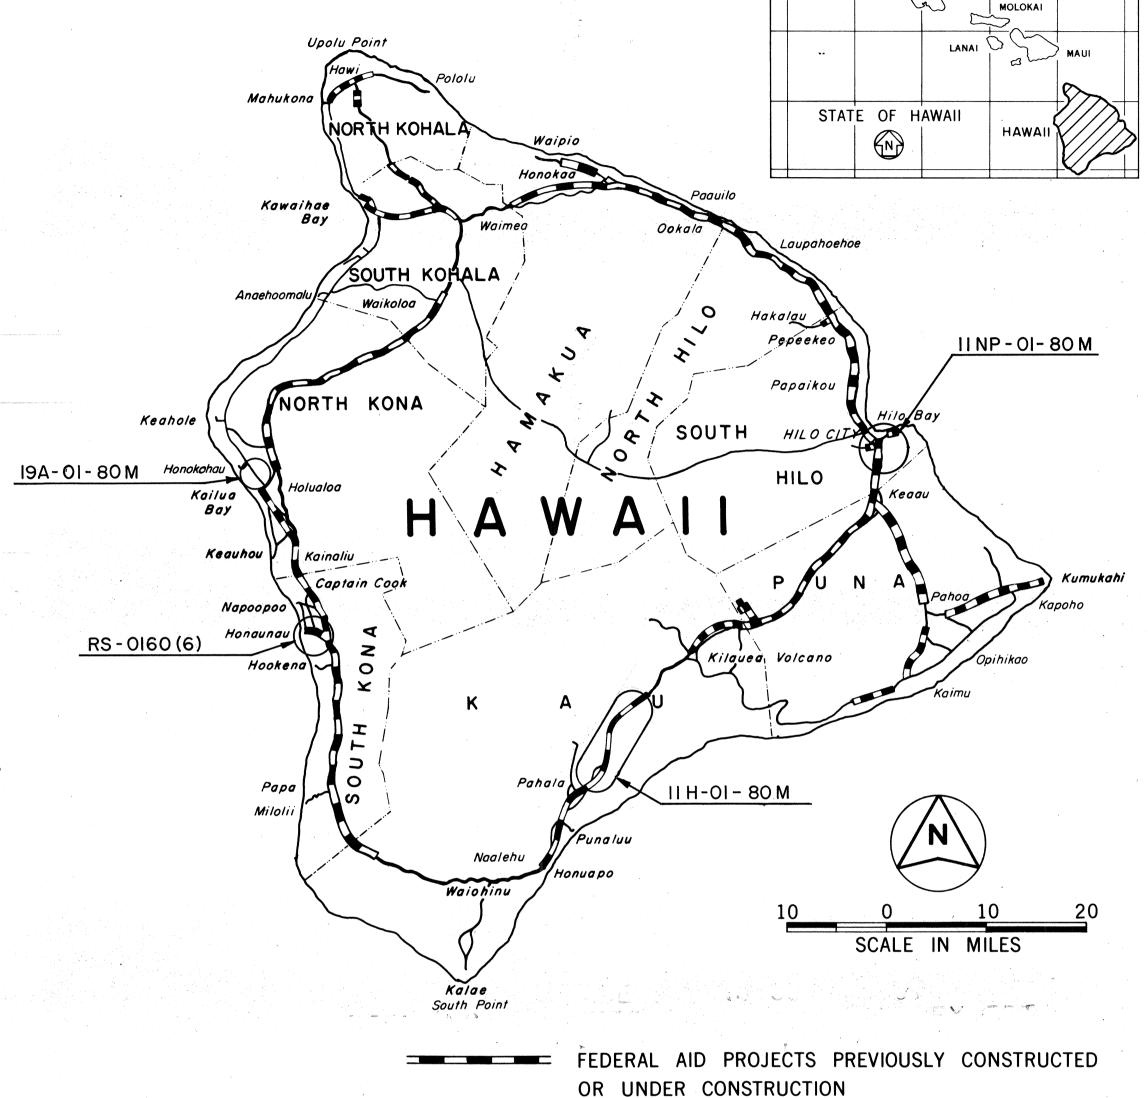

NOTE:

ALL CHANGES MADE DURING CONSTRUCTION HAVE BEEN NOTED IN RED ON THESE TRACINGS AND CHECKED BY:

PROJECT ENGINEER DATE

DEPARTMENT OF TRANSPORTATION
STATE OF HAWAII

APPROVED:

James R Carras

[/k5/80]

But DIR. OF TRANSPORTATION

DATE

9 6648-2122