


FED. ROAD DIST. NO.	STATE	PROJ. NO.	FISCAL YEAR	SHEET NO.	TOTAL SHEETS
HAWAII	HAW.	11D-0181	1981	3	14

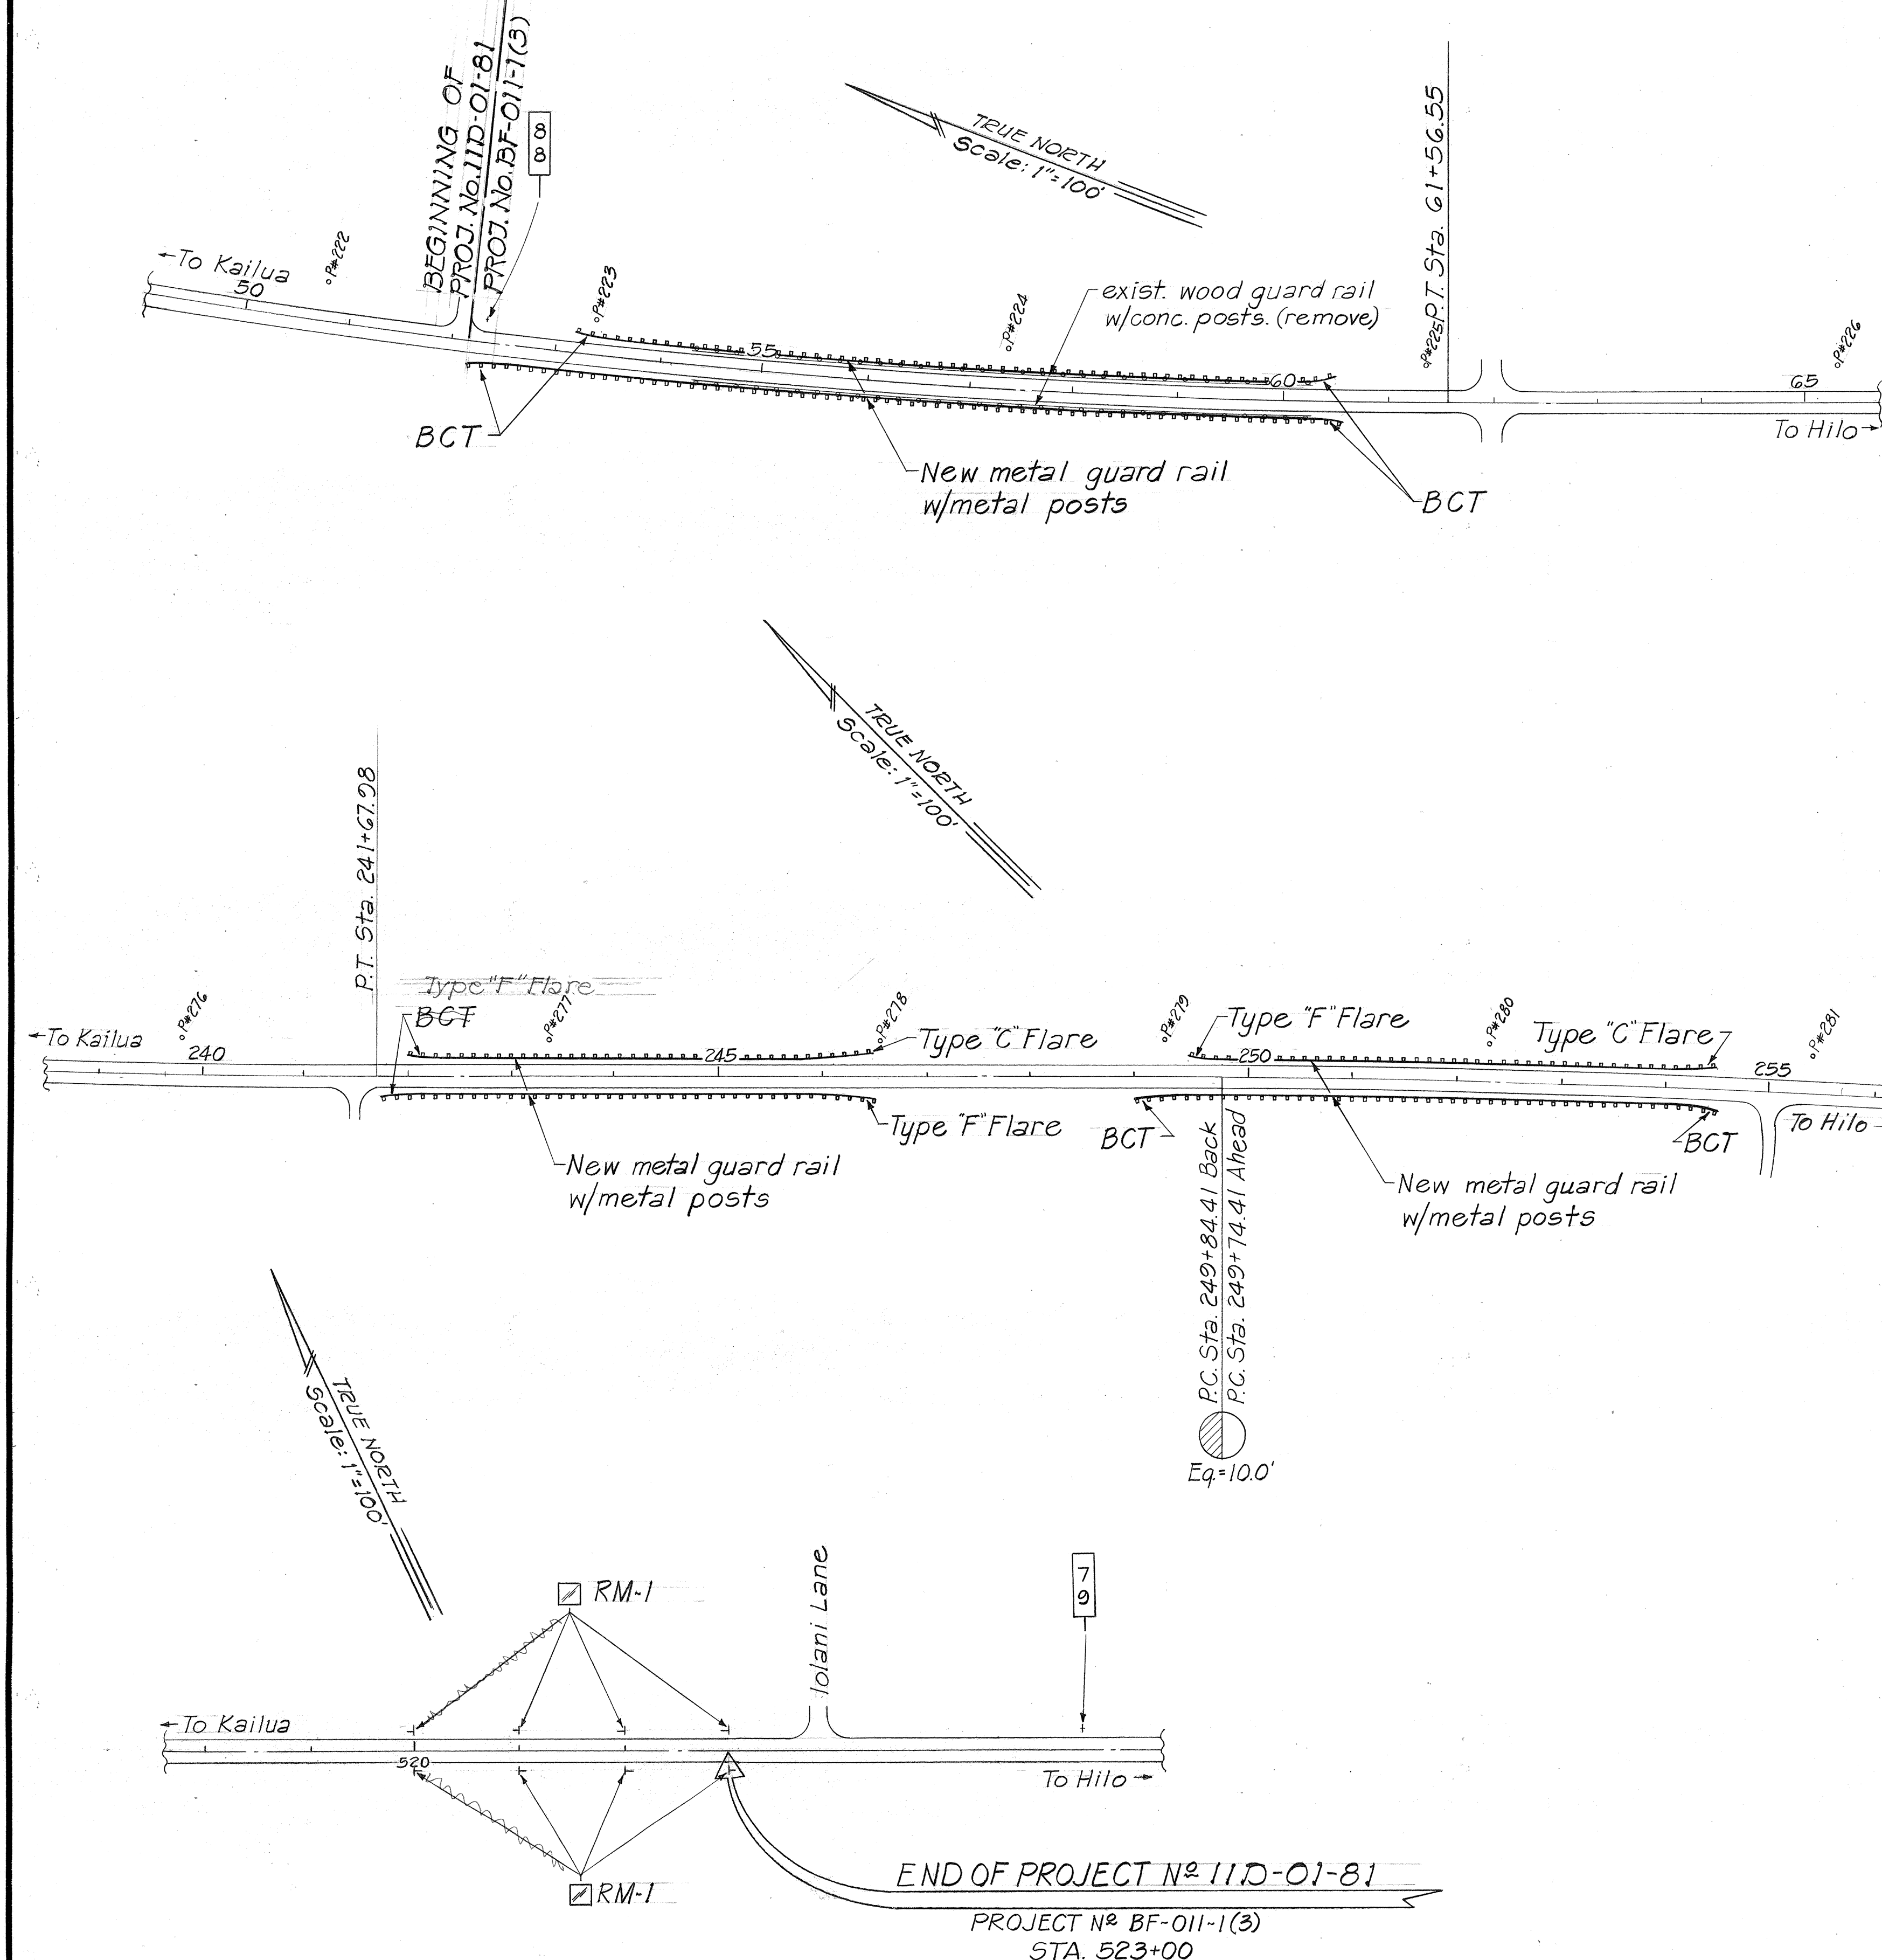

GUARD RAIL & REFLECTOR MARKER SCHEDULE										
REMOVAL (EXISTING)				INSTALLATION (NEW)						
GUARD RAIL							GUARD RAIL		REFLECTOR MARKER	
BEGIN STATION	END STATION	LINEAR FEET	G.R. POSTS	BEGIN STATION	END STATION	LINEAR FEET	TYPE FLARE	EDGE OF PAVT. TO G.R. FACE	RM-1	
53+75 L	60+16 L	641	72	53+15 L	60+50 ²⁵ L 662	667.5	B.C.T'S	4		
53+75 R	60+16 R	641	72	53+15 R	60+55 R 671	787.5	B.C.T'S	4		
				51+20						20
										20
										20
				241+63 L			F			
				242+00 L	246+50 L 430	425	B.C.T'S	5		
				241+70 R	246+50 R 432	445	B.C.T'S	5		
				249+50 L	254+50 L 515	500	F.C.	5		
				249+00 R	254+50 R 475	500	B.C.T'S	5		
				520+00 L & R						20
				521+00 L & R						2
				522+00 L & R						2
				523+00 L & R						2
						3409.4				
TOTALS	1282	144		TOTALS	3350					140

ORIGINAL PLAN	SURVEY PLOTTED BY _____ DATE _____
NOTE BOOK	DRAWN BY _____ "
	TRACED BY _____ "
	DESIGNED BY _____ "
	QUANTITIES BY _____ "
No. _____	CHECKED BY _____ "

STATE OF HAWAII
DEPARTMENT OF TRANSPORTATION
HIGHWAYS DIVISION

**ROADWAY PLAN, GUARD RAIL &
REFLECTOR MARKER SCHEDULE**

PAPA TOWARDS KAHUKU
GUARD RAIL IMPROVEMENT
PROJECT NO. 11D-01-81
KAU, HAWAII

Scale: 1" = 100' Date: April 1980

SHEET NO. 2 OF 2 SHEETS