




FED. ROAD DIST. NO.	STATE	PROJ. NO.	FISCAL YEAR	SHEET NO.	TOTAL SHEETS
HAWAII	HAW.	11GH-01-81	1981	4	14

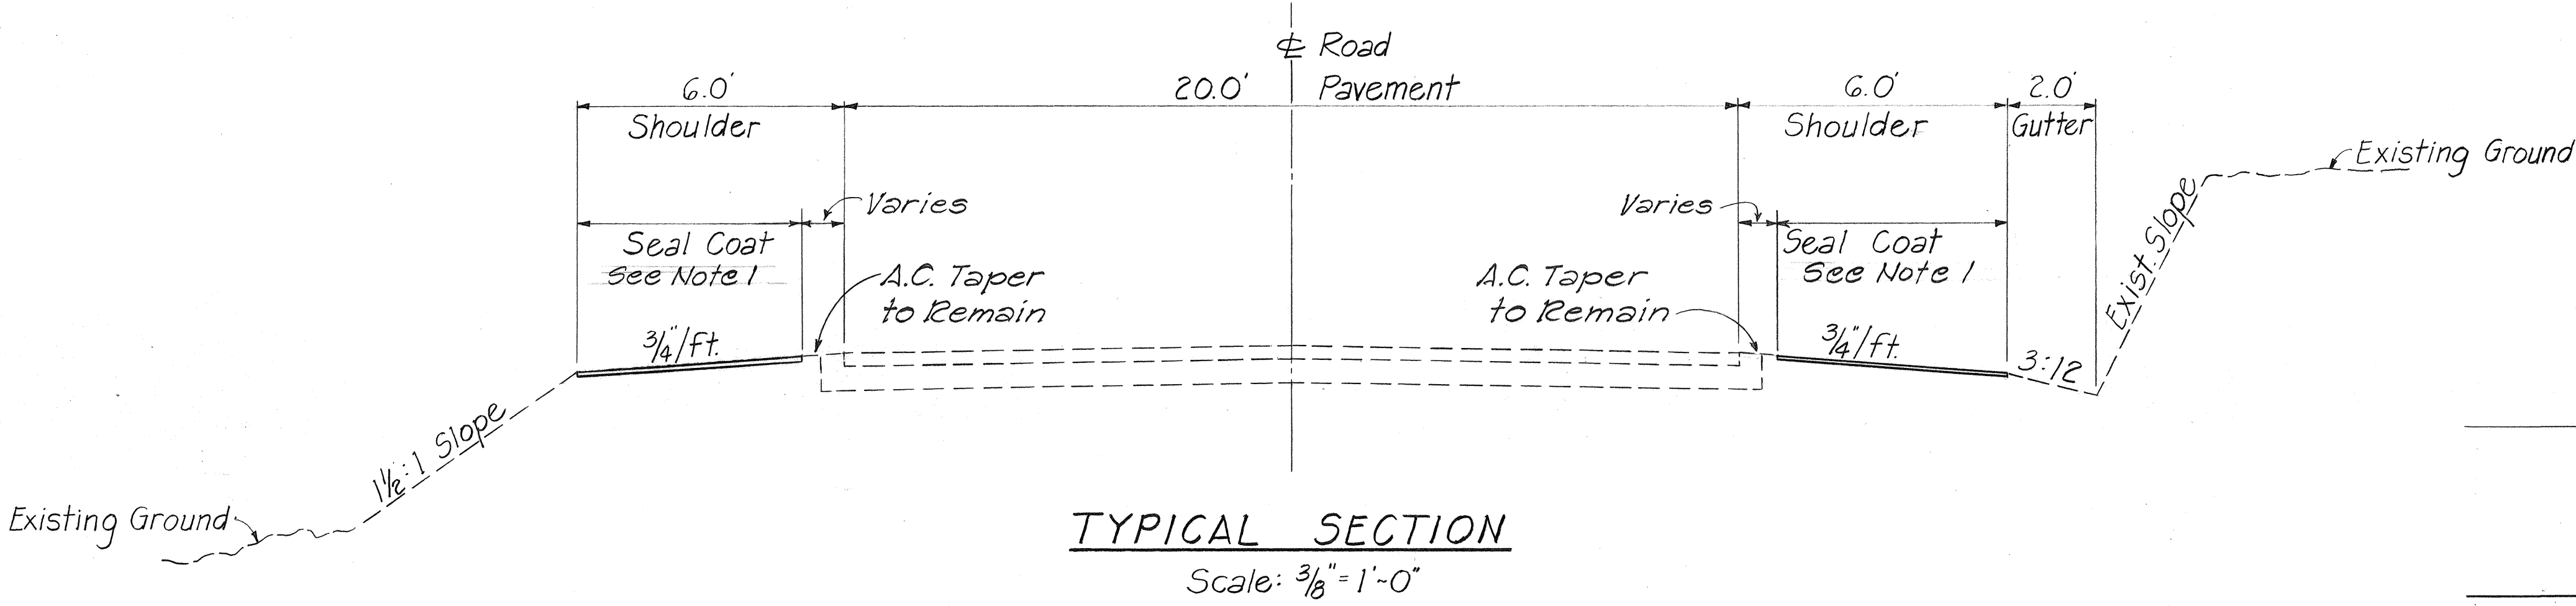

- GENERAL NOTES
- 1. Existing pavement and structures in shoulder areas shall be excluded from shoulder treatment and the Contractor shall exercise reasonable care to prevent disturbing any such existing pavement and structures within the limits of work.
 - 2. Edge of pavement striping to be done by others.

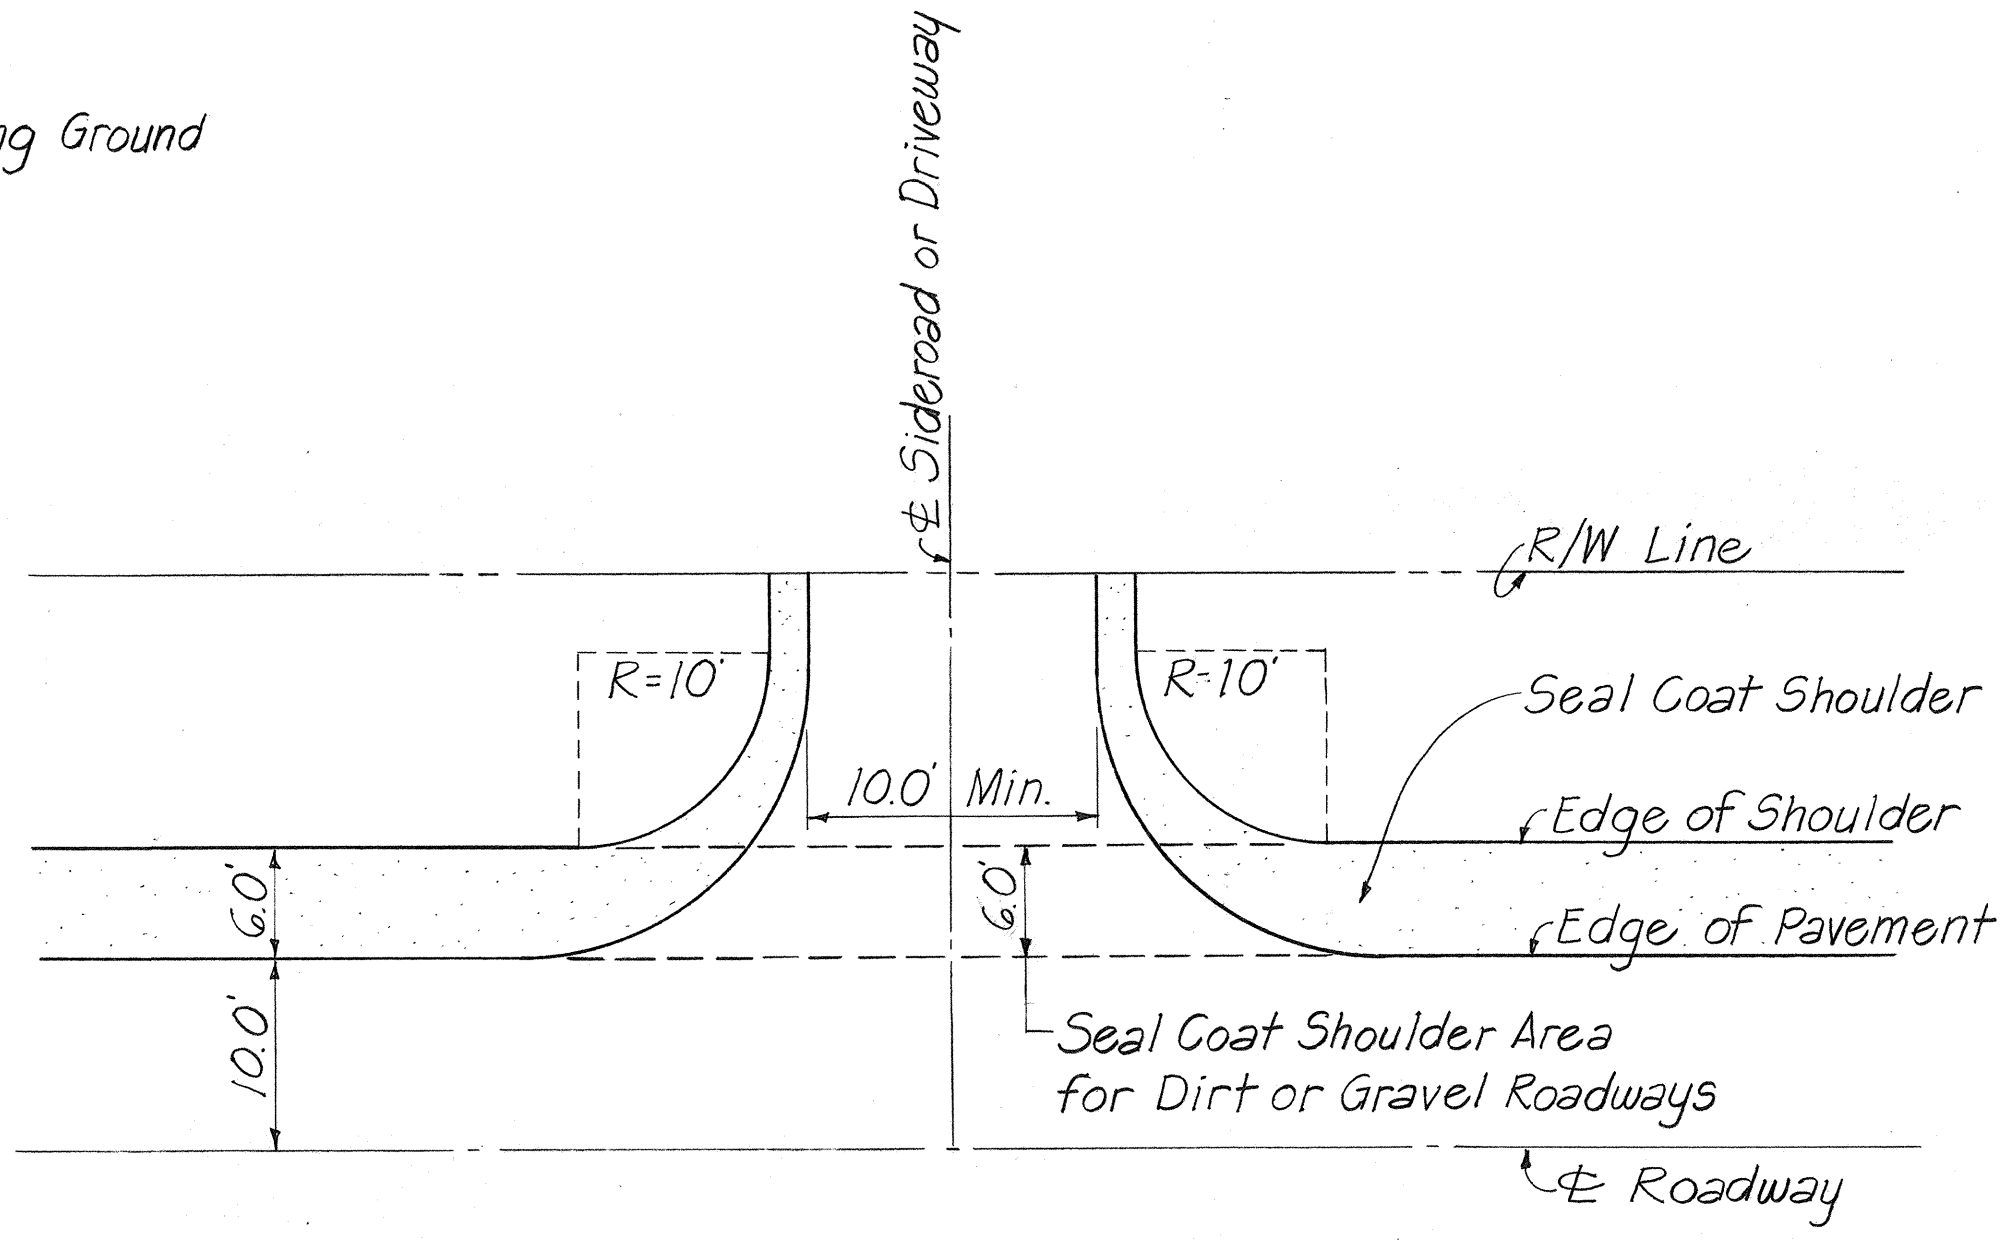

TYPICAL PLAN
SIDEROAD OR DRIVEWAY
SHOULDER CONNECTION
Not To Scale

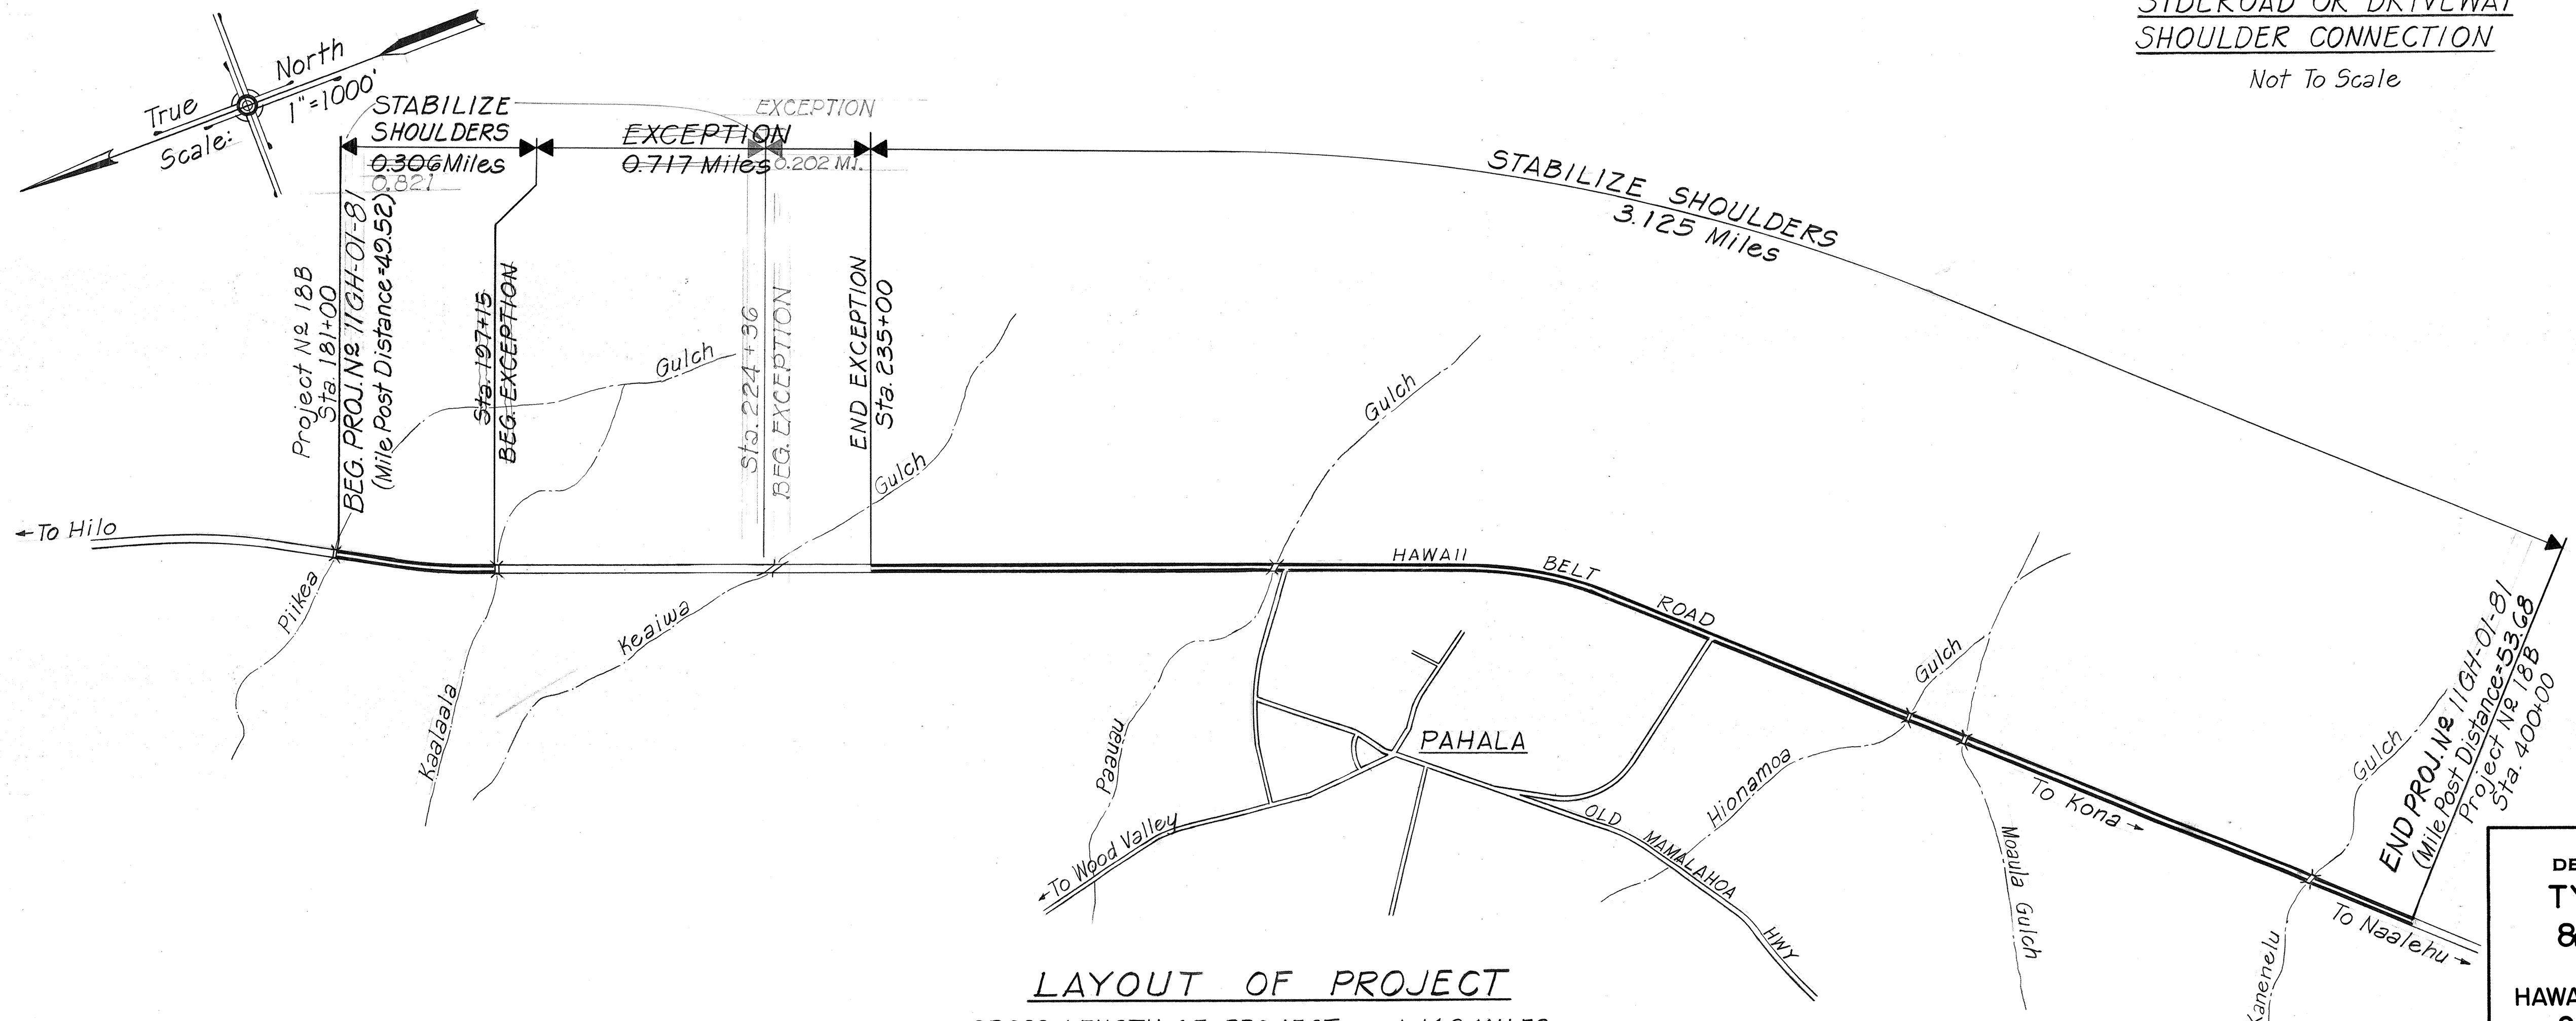

LAYOUT OF PROJECT

GROSS LENGTH OF PROJECT	4.43 MILES
EXCEPTION	0.717 "
NET LENGTH OF PROJECT	3.43 MILES

STATE OF HAWAII
DEPARTMENT OF TRANSPORTATION
TYPICAL PLAN, SECTION
& LAYOUT OF PROJECT
PAHALA TOWARDS
HAWAII VOLCANOES NATIONAL PARK
SHOULDER STABILIZATION
PROJECT NO. 11GH-01-81
KAU, HAWAII
Scale: As Noted Date: April 1980
SHEET No. 1 OF 1 SHEETS

SURVEY PLOTTED BY	DATE
DRAWN BY	
TRACED BY	
DESIGNED BY	
CHECKED BY	

ORIGINAL PLAN	No.
NOTE BOOK	