

FED. ROAD DIST. NO.	STATE	PROJ. NO.	FISCAL YEAR	SHEET NO.	TOTAL SHEETS
HAWAII	HAW.	11B-01-81M	1981	2	18

± & REFERENCE SURVEY MONUMENT(RECOVER)

STATION	
PROJ. N ^o WPH 8F	
P.C. STA.	221+42.22
P.T. STA.	201+13.75
P.C. STA.	199+50.41
P.T. STA.	177+74.30
P.C. STA.	174+01.97
P.T. STA.	168+71.35
P.C. STA.	164+22.59
± MON. STA.	145+03.46
± MON. STA.	140+63.46
± MON. STA.	128+53.69
± MON. STA.	123+22.75
± MON. STA.	28+04.22
P.T. STA.	63+13.44
P.C. STA.	58+25.75
P.T. STA.	54+70.16
P.C. STA.	50+41.12
P.T. STA.	46+28.78
PROJ. N ^o NRH 8E	
P.C. STA.	42+28.75
P.T. STA.	40+32.24
P.C. STA.	34+16.27
P.T. STA.	24+58.84
P.C. STA.	21+12.15
P.T. STA.	10+42.50
P.C. STA.	3+55.48
PROJ. N ^o FAP 8D	
P.C. STA.	328+25.10
P.T. STA.	330+58.90
P.C. STA.	332+23.00
P.T. STA.	333+26.50
P.C. STA.	334+27.40
P.T. STA.	335+89.90
P.C. STA.	336+73.00
P.T. STA.	337+53.60
P.C. STA.	338+84.70
P.T. STA.	341+03.70
P.C. STA.	341+65.10
P.T. STA.	343+87.70
P.C. STA.	345+08.90
P.T. STA.	346+27.60
P.C. STA.	350+06.90
P.T. STA.	351+11.00
P.C. STA.	352+17.80
P.T. STA.	353+25.70
P.C. STA.	358+37.80
P.T. STA.	359+61.70
P.C. STA.	360+85.50
P.T. STA.	362+69.40
P.C. STA.	363+57.40
P.T. STA.	364+50.70
P.C. STA.	367+82.50
P.T. STA.	369+46.90
P.C. STA.	370+61.40
P.T. STA.	371+32.90
P.C. STA.	377+31.80
P.T. STA.	378+60.70
P.C. STA.	380+53.30
P.T. STA.	381+64.20
P.C. STA.	383+08.50
P.T. STA.	384+41.50
P.C. STA.	388+65.70
P.T. STA.	389+89.20
P.C. STA.	391+17.20
P.T. STA.	393+36.70
TOTAL = 62 EACH	

See 25-17

PAVEMENT MARKER SCHEDULE

STATION		DESCRIPTION	TYPE		
FROM	TO		D	H	J
PROJ. N ^o WPH 8F					
222+50	219+90	No Passing-L Passing-R	7	7	28
219+90	216+10	Passing-Both Sides	9		36
216+10	211+00	Passing-L No Passing-R	13	13	52
211+00	199+50	Passing-Both Sides	29		116
199+50	192+40	No Passing-L Passing-R	18	18	72
192+40	185+00	Passing-L No Passing-R	18	18	72
185+00	177+40	No Passing-L Passing-R	19	19	76
177+40	176+60	No Passing-Both Sides	4		
176+60	168+71.4	Passing-L No Passing-R	20	20	80
168+29.4	67+42.8	Passing-Both Sides	2		8
66+36.1	60+60	No Passing-L Passing-R	14	14	56
60+60	46+50	No Passing ~ Both Sides	70		
PROJ. N ^o NRH 8E					
46+50	24+80	No Passing ~ Both Sides	108		
24+80	17+70	Passing-L No Passing-R	18	18	72
17+70	14+00	Passing ~ Both Sides	9		36
14+00	6+40	No Passing-L Passing-R	19	19	76
6+40	0+00	No Passing ~ Both Sides	32		
Proj. N ^o FAP 8D					
326+00	351+35	No Passing - Both Sides	127		
351+35	351+75	Open			
351+75	353+40	No Passing ~ Both Sides	8		
353+40	356+40	Passing-L No Passing-R	6	6	24
356+40	396+00	Passing - Both Sides	99		396
TOTALS			649	152	1200

UTILITY (WATER) SCHEDULE

STATION	V.B.	M.H.	H.H.	Meter
112+20			1	
140+32	1			+
344+62	1			
351+36	3			
371+72	1			
376+80	1	+		
379+80	+		1	
385+60	1			
394+03		+		
TOTALS				
	78	20	+2	+0


STATE OF HAWAII
DEPARTMENT OF TRANSPORTATION
HIGHWAYS DIVISION

TYP. SECTION, LOCATION, PAV'T MARKER
UTILITY & ± MON. SCHEDULES

HAWAII BELT ROAD
MACHADO STORE TO KIILAE
PROJ. N^o 11B-01-81M
SOUTH KONA, HAWAII


Scale: As Shown Date: May 1981

SHEET NO. 1 OF 1 SHEETS

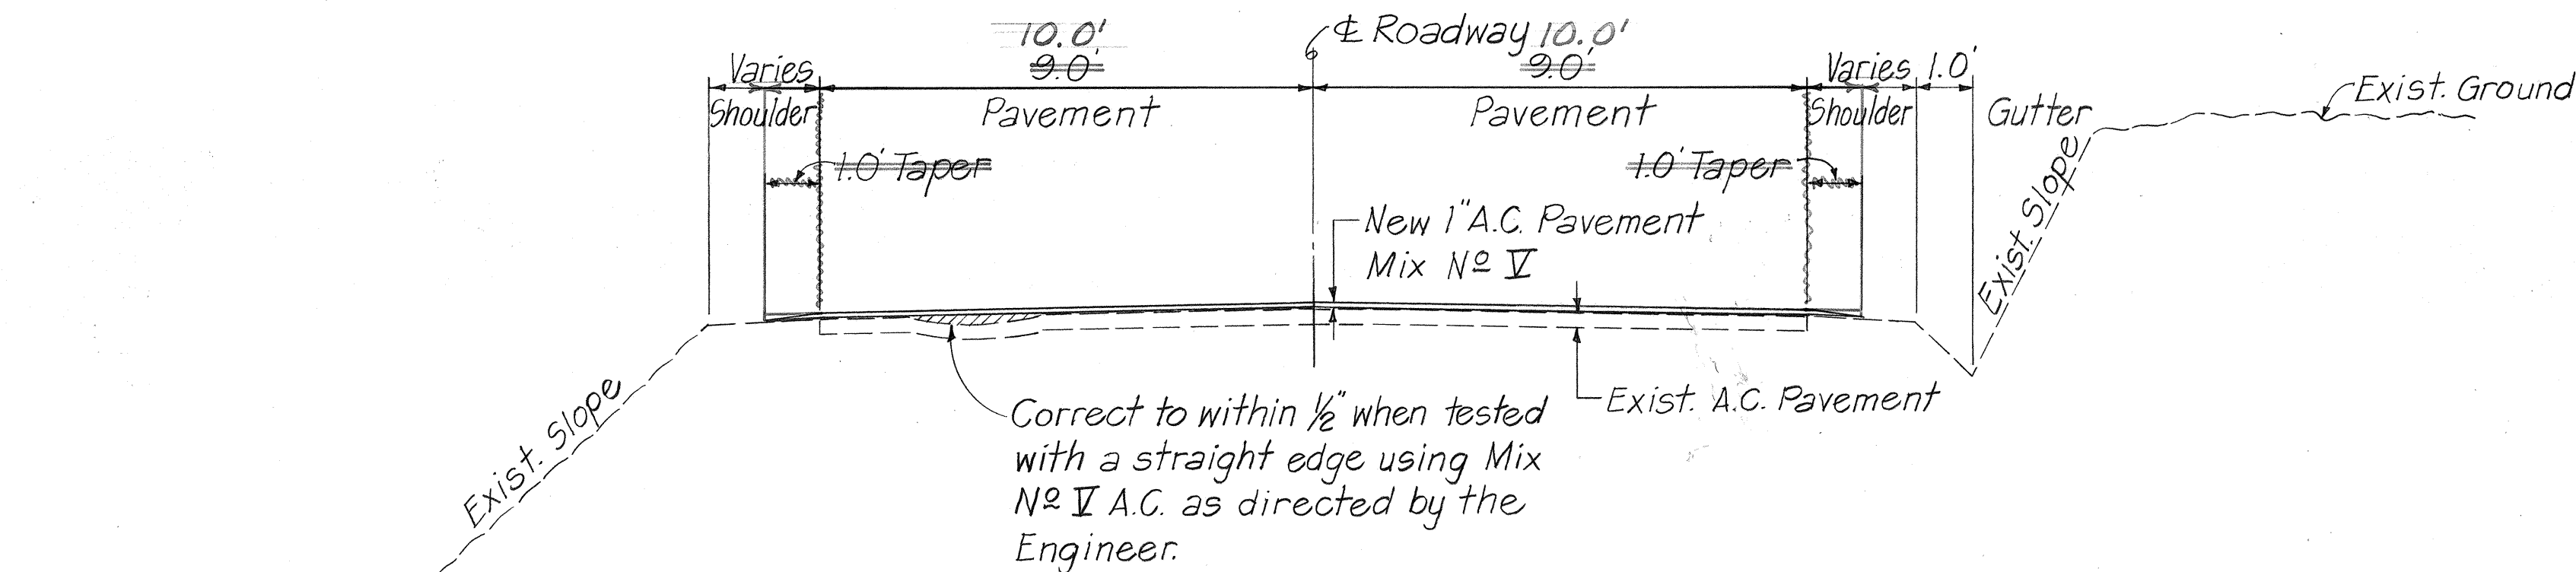



TYPICAL SECTION

STA. 326+00 TO STA. 396+00
Scale: 3/8\"/>

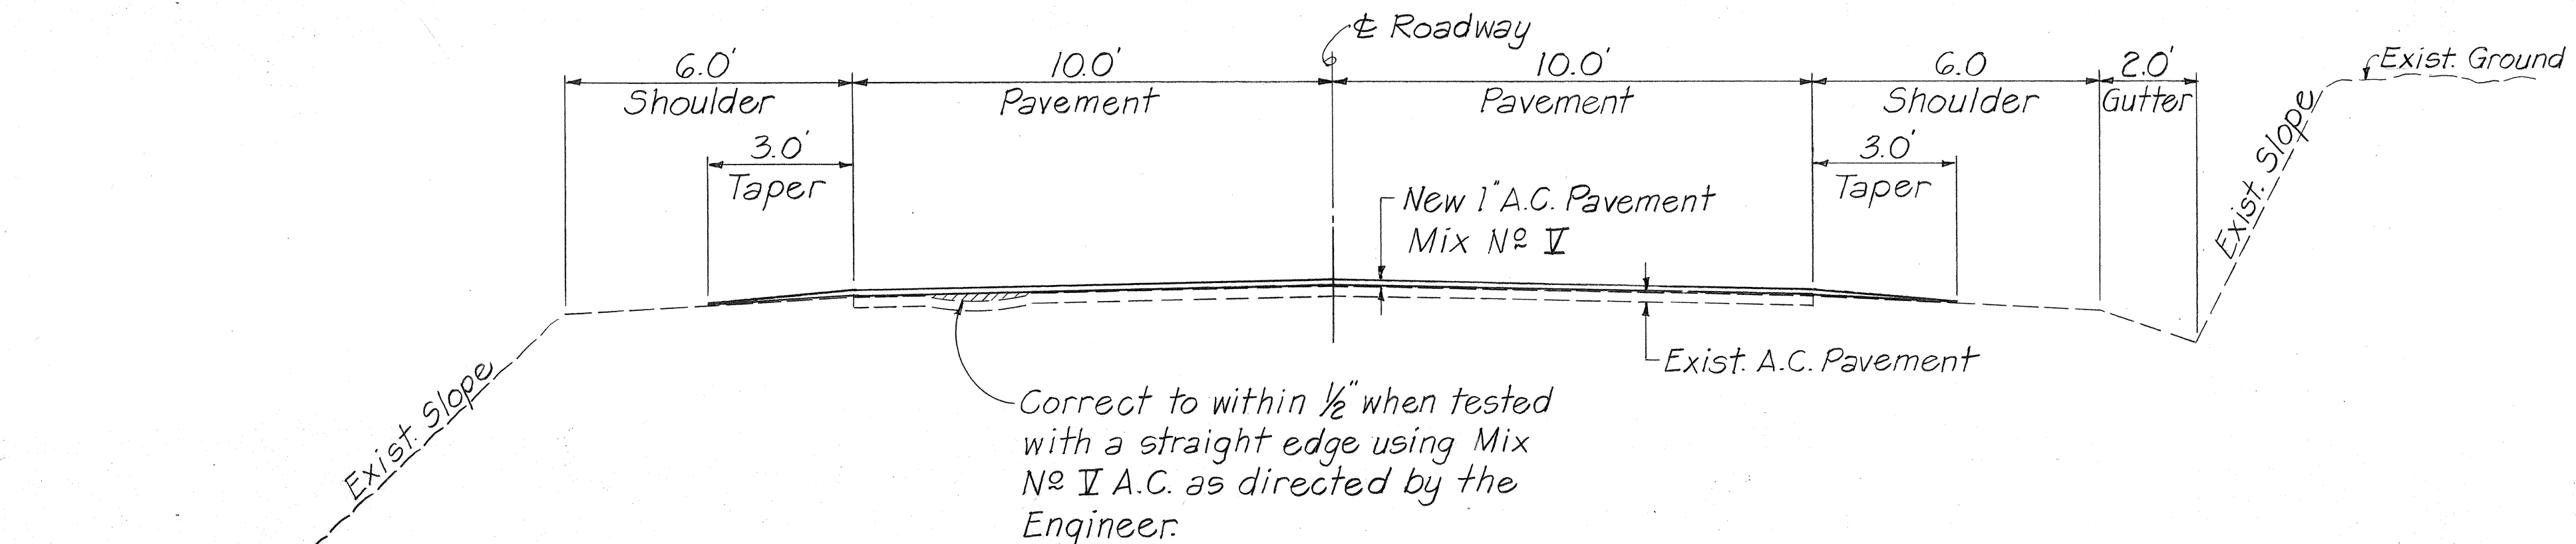

TYPICAL SECTION

STA. 0+00 TO STA. 222+50
Scale: 3/8\"/>

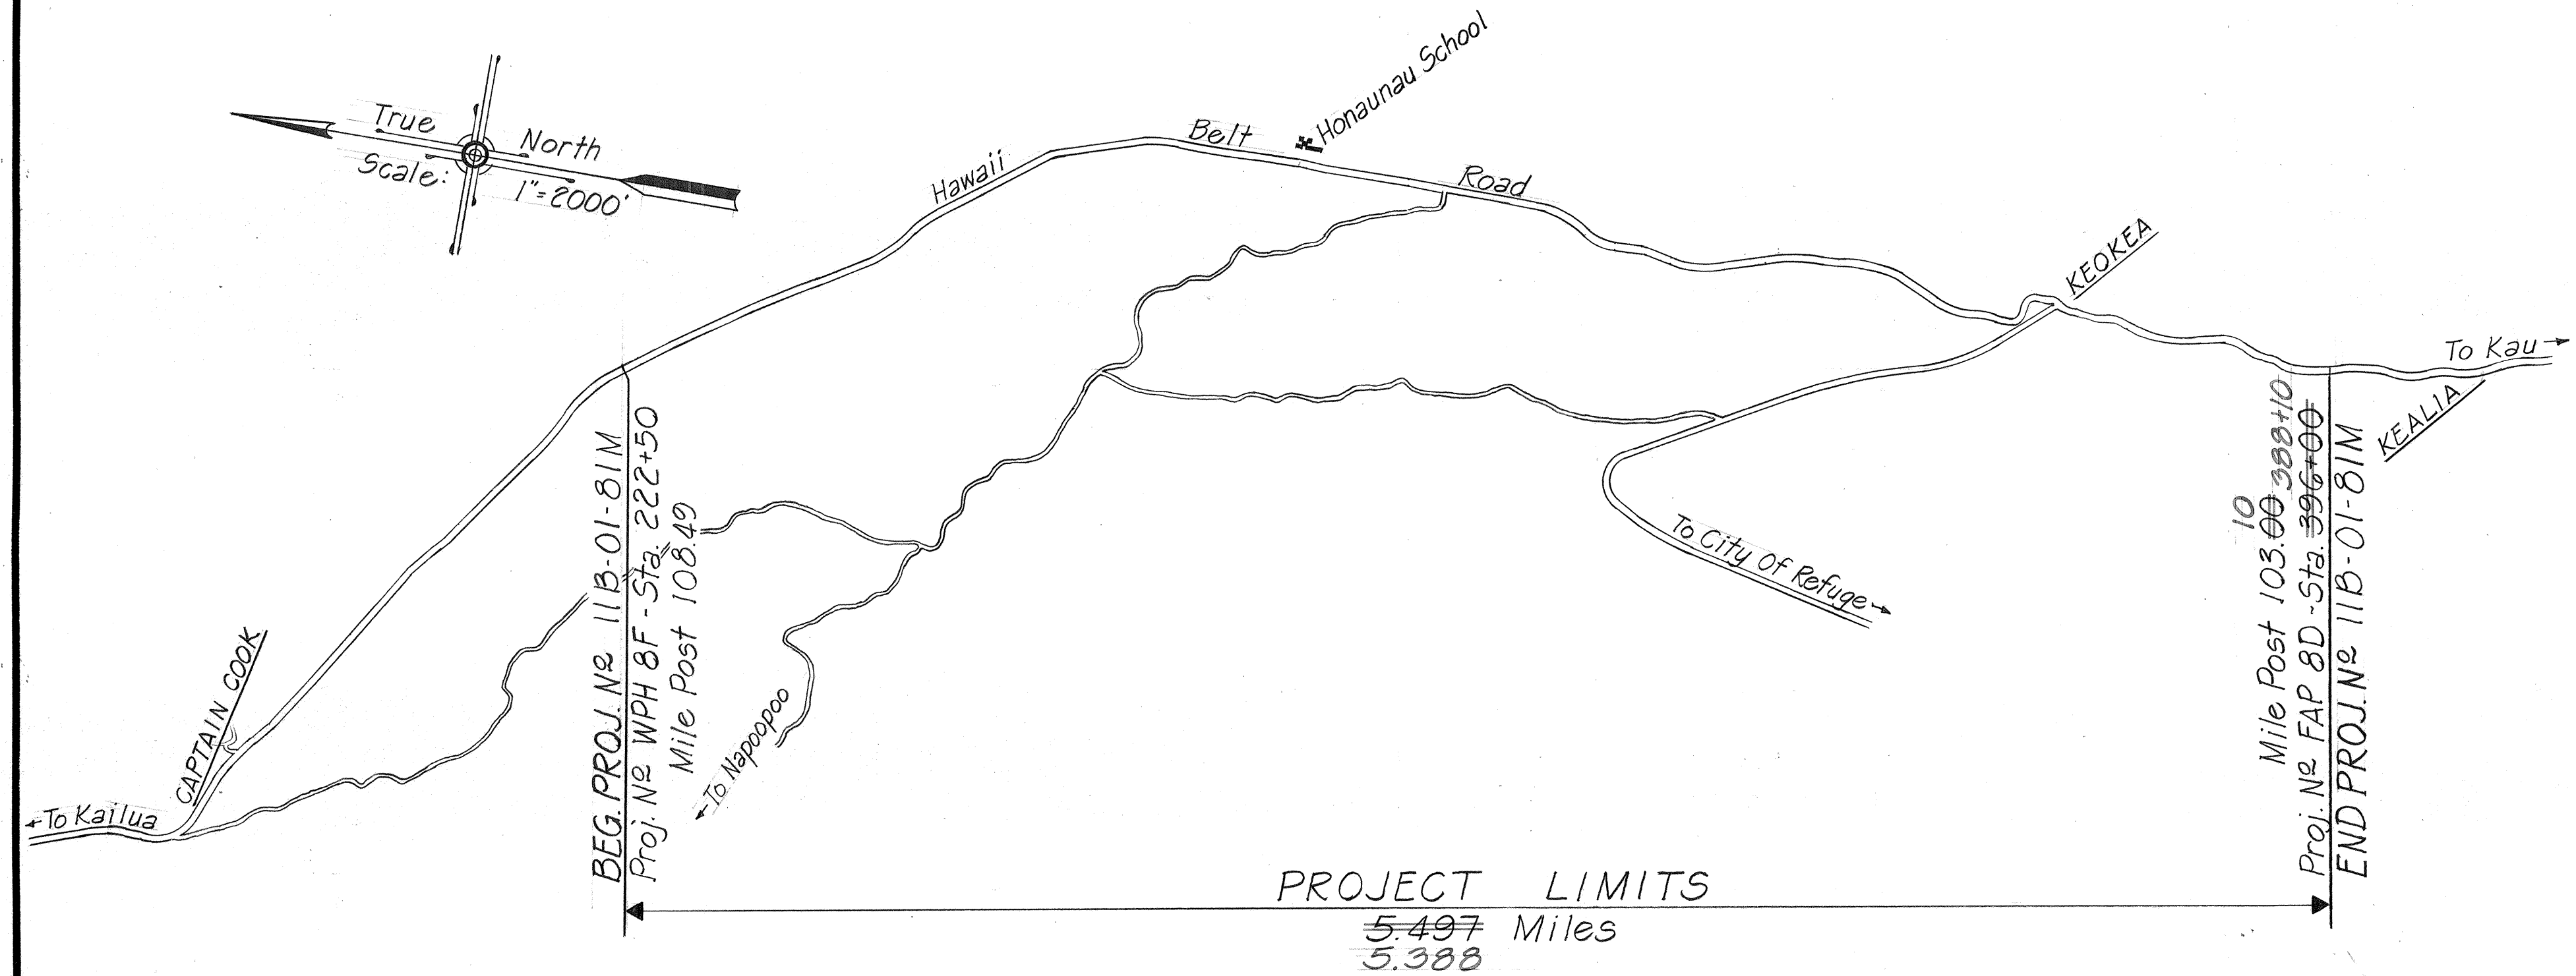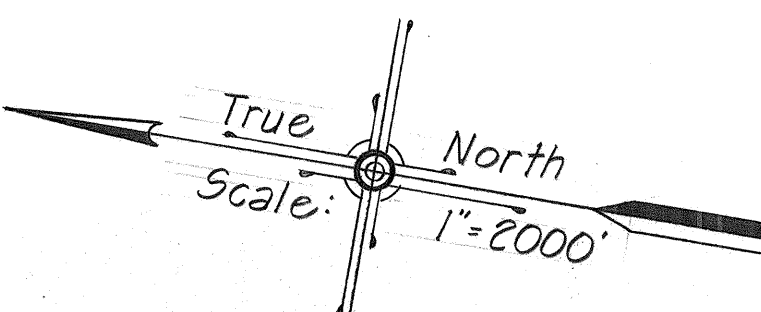

LAYOUT OF PROJECT

SURVEY PLOTTED BY	DATE
DRAWN BY	
TRACED BY	
NOTE BOOK	
QUANTITIES BY	
CHECKED BY	

ORIGINAL PLAN	SURVEY PLOTTED BY	DATE
	DRAWN BY	
	TRACED BY	
	NOTED BY	
NOTE BOOK	QUANTITIES BY	
	CHECKED BY	
No.		

PAVEMENT MARKER SCHEDULE					
STATION		DESCRIPTION	TYPE		
FROM	TO		D	H	J
PROJ. No.	WPH 8F				
222+50	219+81	No Passing-L Passing-R	7	7	28
219+81	215+93	Passing-Both Sides	10		
215+93	210+92	Passing-L No Passing-R	12	13	52
210+92	199+38	Passing-Both Sides	30		
199+38	192+50	No Passing-L Passing-R	18	18	72
192+50	192+22	No Passing-Both Sides	1		
192+22	185+04	Passing-L No Passing-R	18	19	76
185+04	184+03	Passing-Both Sides	3		8
184+03	177+27	No Passing-L Passing-R	17	17	68
177+27	176+48	No Passing-Both Sides	4		
176+48	168+94	Passing-L No Passing-R	19	20	80
168+94	148+49	Passing-Both Sides	51		200
148+49	143+98	No Passing-L Passing-R	11	12	48
143+98	143+76	Passing-Both Sides	1		
143+76	139+70	Passing-L No Passing-R	10	11	44
139+70	132+03	Passing-Both Sides	20		76
132+03	127+57	No Passing-L Passing-R	11	12	48
127+57	127+33	Passing-Both Sides	1		
127+33	123+65	Passing-L No Passing-R	9	10	40
123+65	108+14	Passing-L No Passing-R	39		148
108+14	103+90	No Passing-L Passing-R	10	11	44
103+90	103+33				
103+33	94+57	No Passing-Both Sides	42		
94+57	88+22	Passing-Both Sides	16		60
88+22	85+06	No Passing-L Passing-R	8	8	32
85+06	81+06	No Passing-Both Sides	19		
81+06	80+65				
80+65	75+66	Passing-L No Passing-R	12	13	52
75+66	68+78	Passing-Both Sides	18		68
68+78	61+78	No Passing-L Passing-R	17	17	68
61+78	47+60	No Passing-Both Sides	71		
PROJ. No.	NRH 8E				
47+60	26+10	No Passing-Both Sides	103		
26+10	18+64	Passing-L No Passing-R	19	19	76
18+64	14+89	Passing-Both Sides	10		36
14+89	7+36	No Passing-L Passing-R	19	19	76
7+36	0+00	No Passing-Both Sides	37		
PROJ. No.	FAP 8D				
326+00	350+37	No Passing-Both Sides	122		
350+37	350+77	Open			
350+77	352+34	No Passing-Both Sides	9		
352+34	354+65	Passing-L No Passing-R	6	6	24
354+65	388+10	Passing-Both Sides	106		332
TOTALS			936	232	1,856

FED. ROAD DIST. NO.	STATE	FED. AID PROJ. NO.	FISCAL YEAR	SHEET NO.	TOTAL SHEETS
HAWAII	HAW.	11B-01-81M	1981	25-1	18

STATE OF HAWAII
DEPARTMENT OF TRANSPORTATION
HIGHWAYS DIVISION
PAVEMENT MARKER SCHEDULE
HAWAII BELT ROAD
Machado Store to Kealia
Proj. No. 11B-01-81M
South Kona, Hawaii
Scale: As Shown Date: May, 1981
SHEET No. OF SHEETS