



FED. ROAD DIST. NO.	STATE	PROJ. NO.	FISCAL YEAR	SHEET NO.	TOTAL SHEETS
HAWAII	HAW.	11M-01-81M	1981	3	18

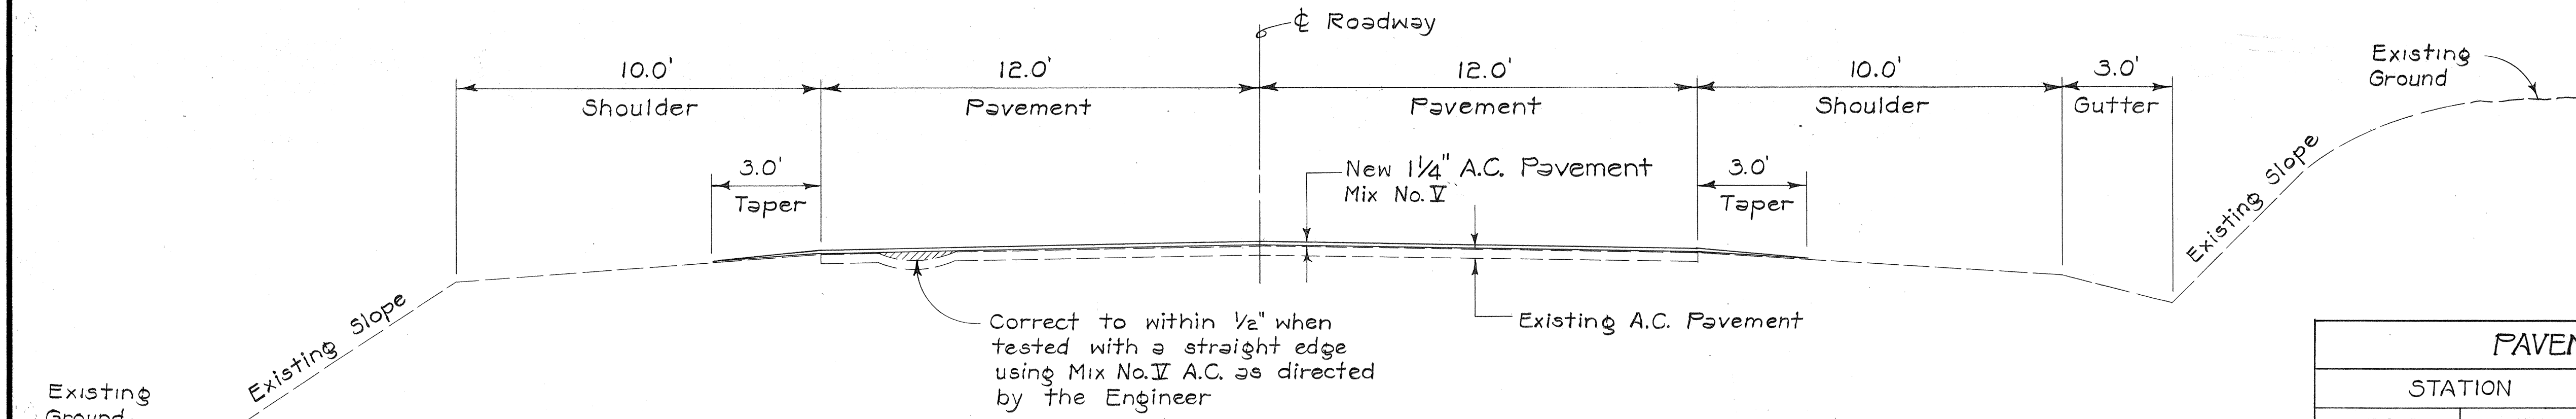

TYPICAL SECTION
Scale : 3/8" = 1'-0"

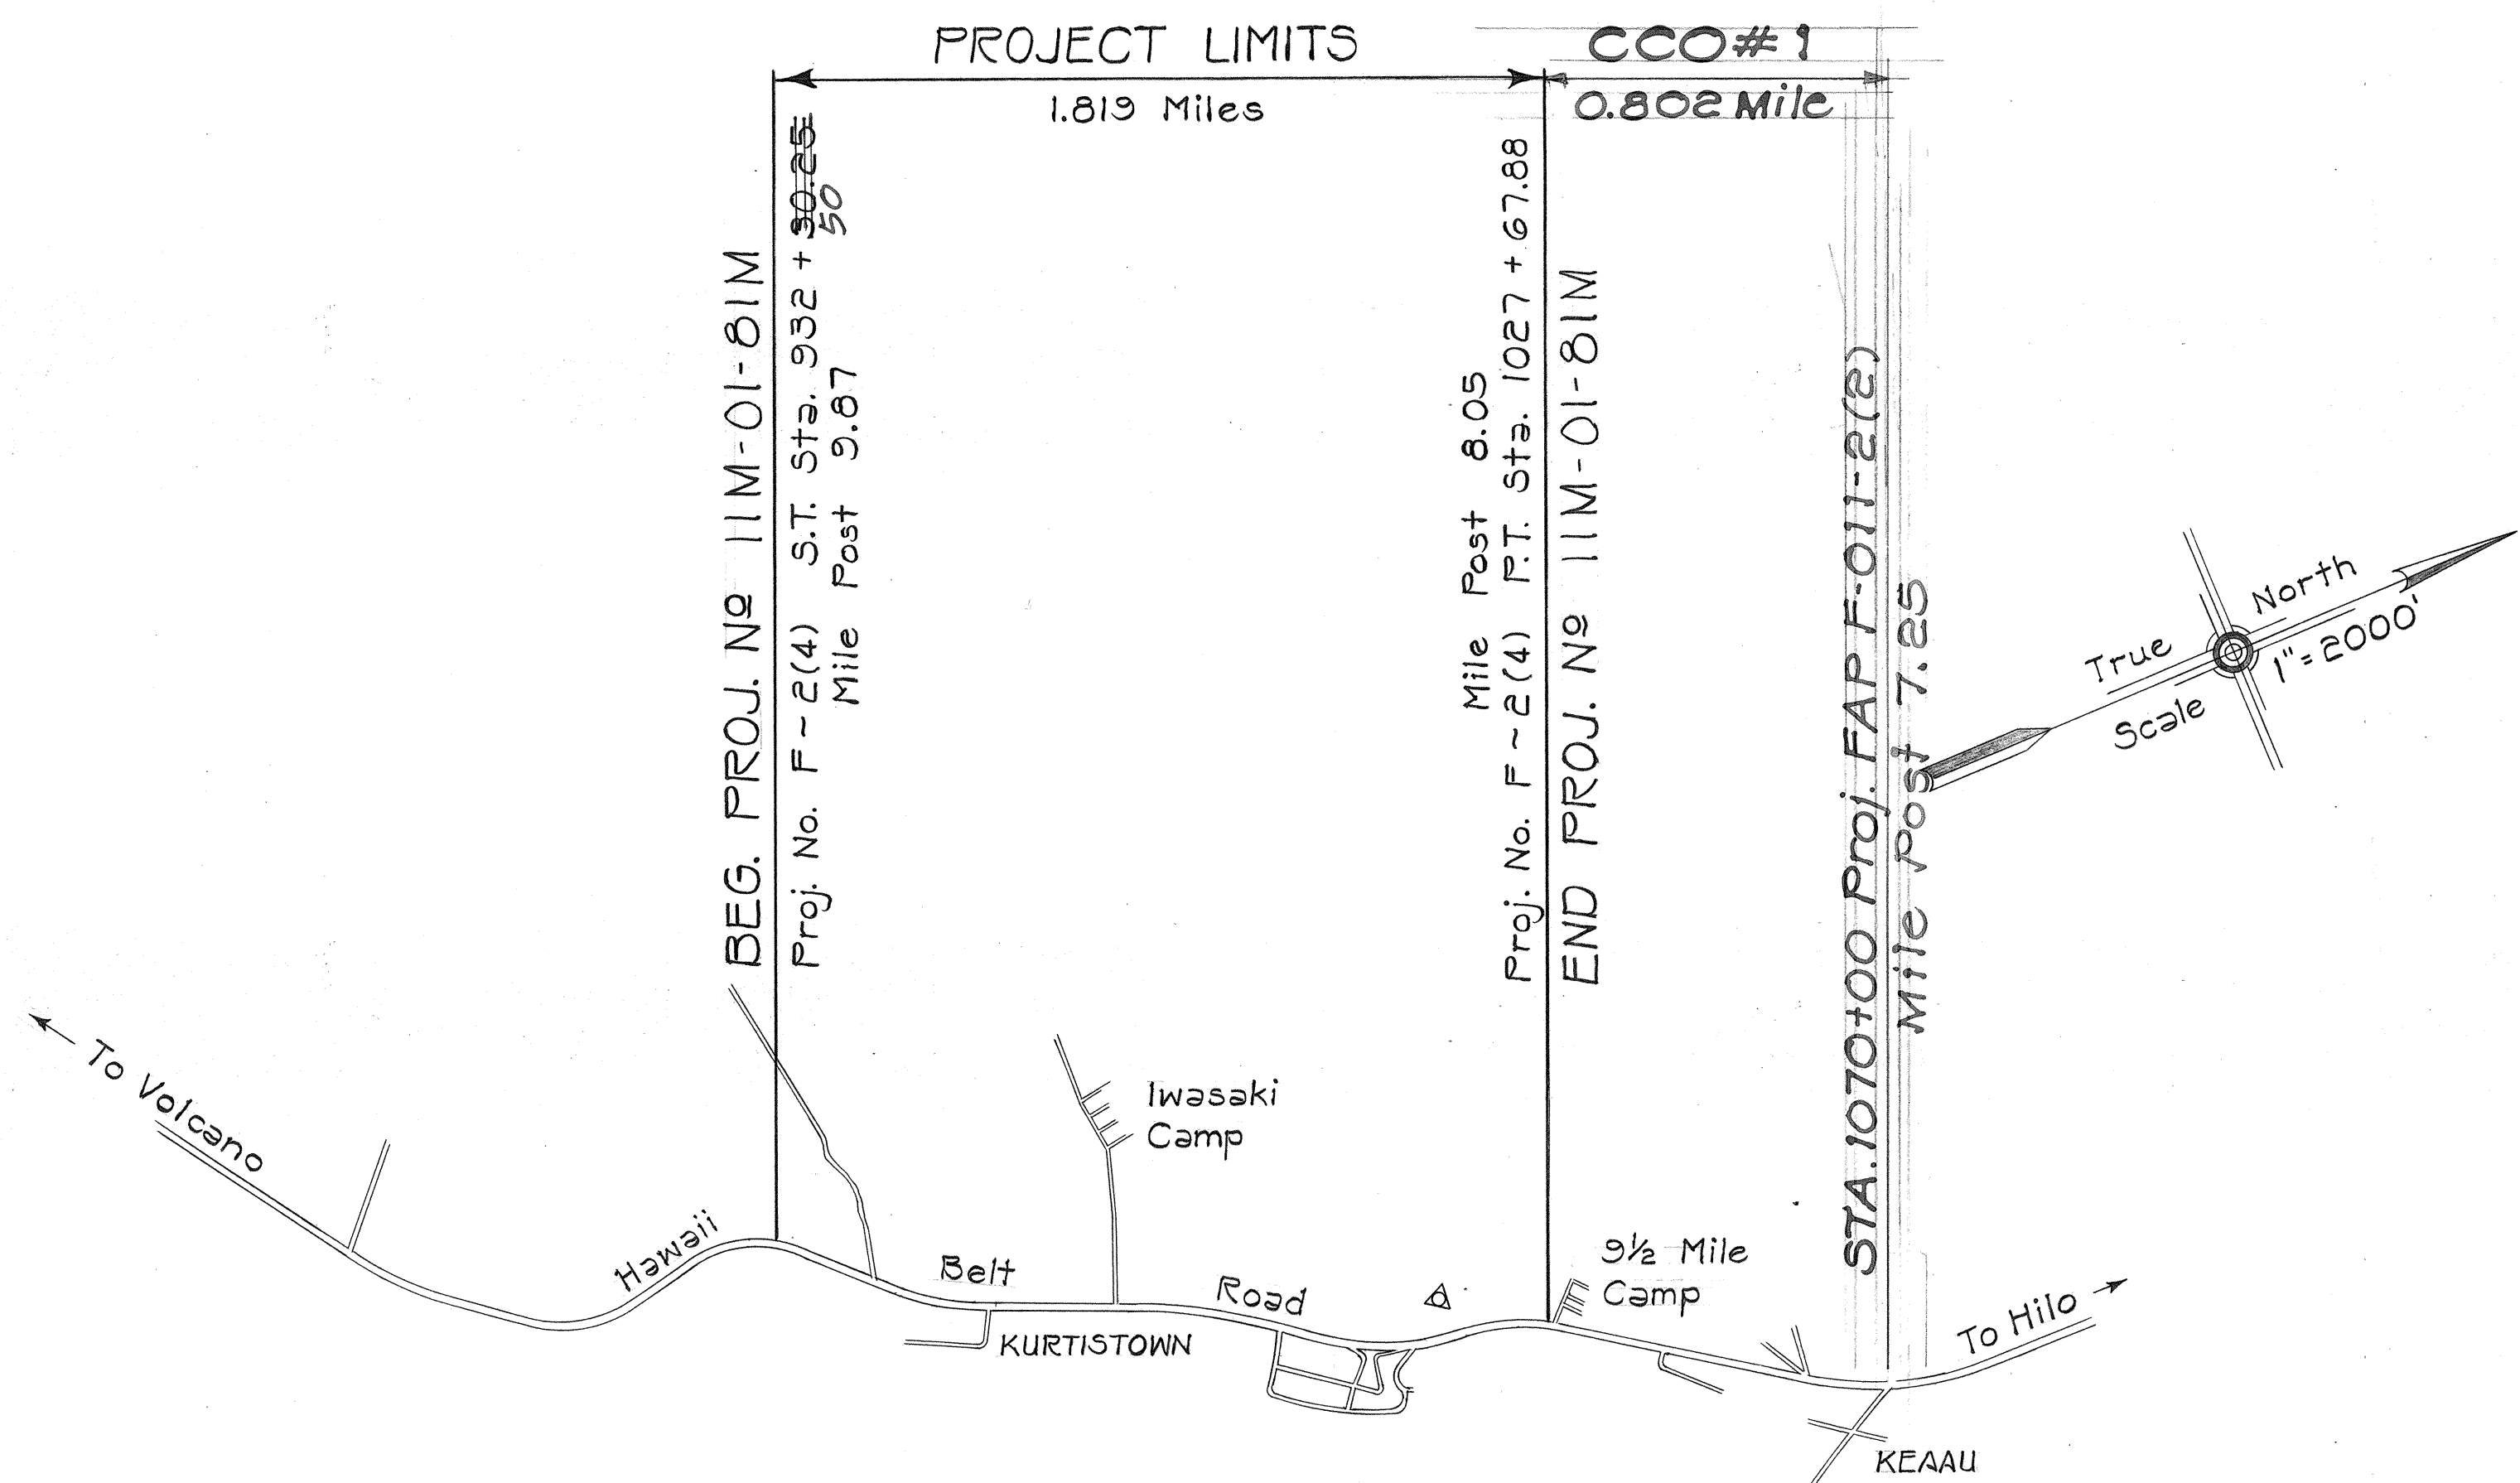

LAYOUT OF PROJECT

PAVEMENT MARKER SCHEDULE					
STATION		DESCRIPTION	TYPE		
FROM	TO		D	H	J
932 + 30.25	934 + 60	No Passing ~L Passing ~R	8	9	36
934 + 60	941 + 30	Passing ~ Both Sides	15	4	61
941 + 30	942 + 00	Open			
942 + 00	943 + 00	No Passing ~ Both Sides	-6-		
943 + 00	972 + 30	Passing ~ Both Sides	73		222
972 + 30	972 + 70	Open			
972 + 70	979 + 20	Passing ~ Both Sides	+6-		-64-
979 + 20	980 + 10	Open			
980 + 10	996 + 40	Passing ~ Both Sides	-4-		+64-
996 + 40	1001 + 30	Passing ~L No Passing ~R	14	14	56
1001 + 30	1010 + 40	No Passing ~ Both Sides	35	42	
1010 + 40	1011 + 20	Open			
1011 + 20	1020 + 50	No Passing ~ Both Sides	76		
1020 + 50	1027 + 67.88	No Passing ~L Passing ~R	25	18	102
1030 + 40	1036 + 30	Passing ~ Both Sides	15		56
1036 + 30	1041 + 20	Passing Lt. ~ No Passing Rt.	12	13	52
1041 + 20	1046 + 77	No Passing Lt. ~ Passing Rt.	12	13	52
1046 + 77	1061 + 60	Passing ~ Both Sides	37		144
		Totals	279	38	740
1061 + 60	1066 + 90	Passing Lt. ~ No Passing Rt.	13	14	58
1067 + 54	1071 + 00	No Passing ~ Both Sides	16		
		TOTALS	401	88	1164

REF. SURVEY MONUMENTS (RECOVER)

- P.C. Sta. 945 + 29.07
- P.T. Sta. 954 + 49.90
- P.C. Sta. 966 + 42.87
- P.T. Sta. 972 + 09.54
- P.C. Sta. 974 + 93.57
- P.T. Sta. 990 + 60.24
- P.C. Sta. 999 + 25.16
- P.T. Sta. 1014 + 28.49
- P.T. Sta. 1018 + 93.95
- P.T. Sta. 1027 + 67.88
- P.C. Sta. 1060 + 26.47
- 1067 + 22.73

STATE OF HAWAII
DEPARTMENT OF TRANSPORTATION
HIGHWAYS DIVISION
TYP. SECTION, LOCATION, PAVEMENT
MARKER & MON. SCHEDULES
VOLCANO ROAD
KURTISTOWN TO 3 1/2 MILE CAMP
PROJ. NO 11M-01-81M
PUNA, HAWAII
Scale: As Shown Date: May 1981
SHEET NO. 1 OF 1 SHEETS

ORIGINAL PLAN	SURVEY PLOTTED BY	DATE
NOTED BY	DRAWN BY	
QUANTITIES BY	DESIGNED BY	
CHECKED BY		