

INDEX TO DRAWINGS	
SHEET NO.	DESCRIPTION
1	TITLE SHEET
① 2	PLAN-PROJ. NO. IIB-01-81M
3	PLAN-PROJ. NO. IIM-01-81M
4	PLAN-PROJ. NO. I9FG-01-81M
5	DETAILS FOR ALL PROJECTS, LAYOUT OF F.A.S. PROJ. NO. RS-SR-0130(19)
6-7	TYPICAL SECTIONS - F.A.S. PROJ. NO. RS-SR-0130(19)
8-10	PLAN - F.A.S. PROJ. NO. RS-SR-0130(19)
11-16	STANDARD DETAILS
17-18	BARRICADES

① 2S-11S SUPPLEMENT SHEET TO THE
CONTRACT PLANS.
NEW TOTAL = 19 SHEETS.



STATE OF HAWAII
DEPARTMENT OF TRANSPORTATION
HIGHWAYS DIVISION

PLANS FOR
CONSTRUCTION OF
"AS BUILT"
HAWAII BELT ROAD RESURFACING
MACHADO STORE TO KIILAE
PROJECT NO. IIB-01-81M

DISTRICT OF SOUTH KONA
CONTRACTOR : YAMADA & SONS INC.
CONTRACT NO. : I2966

VOLCANO ROAD RESURFACING
KURTISTOWN TO 9.5 MILE CAMP
PROJECT NO. IIM-01-81M

DISTRICT OF PUNA
CONTRACTOR : JAS. W. GLOVER, LTD.
CONTRACT NO. : I2967


HAWAII BELT ROAD RESURFACING
PAKALANA STREET TO VICINITY OF KAHAWAILIILII BRIDGE
PROJECT NO. I9FG-01-81M

DISTRICT OF HAMAKUA
CONTRACTOR : JAS. W. GLOVER, LTD.
CONTRACT NO. : I2967

PAHOA - KALAPANA ROAD RESURFACING
BEG. OF PROJ. NO. ER 4(I) TO PAHOA SCHOOL JUNCTION
FEDERAL AID SECONDARY PROJ. NO. RS-SR-0130(19)

DISTRICT OF PUNA
CONTRACTOR : YAMADA & SONS INC.
CONTRACT NO. : I2966

FED. ROAD DIST. NO.	STATE	PROJ. NO.	FISCAL YEAR	SHEET NO.	TOTAL SHEETS
HAWAII	HAW.	IIB-01-81M IIM-01-81M I9FG-01-81M RS-SR-0130(19)	1981	1	18

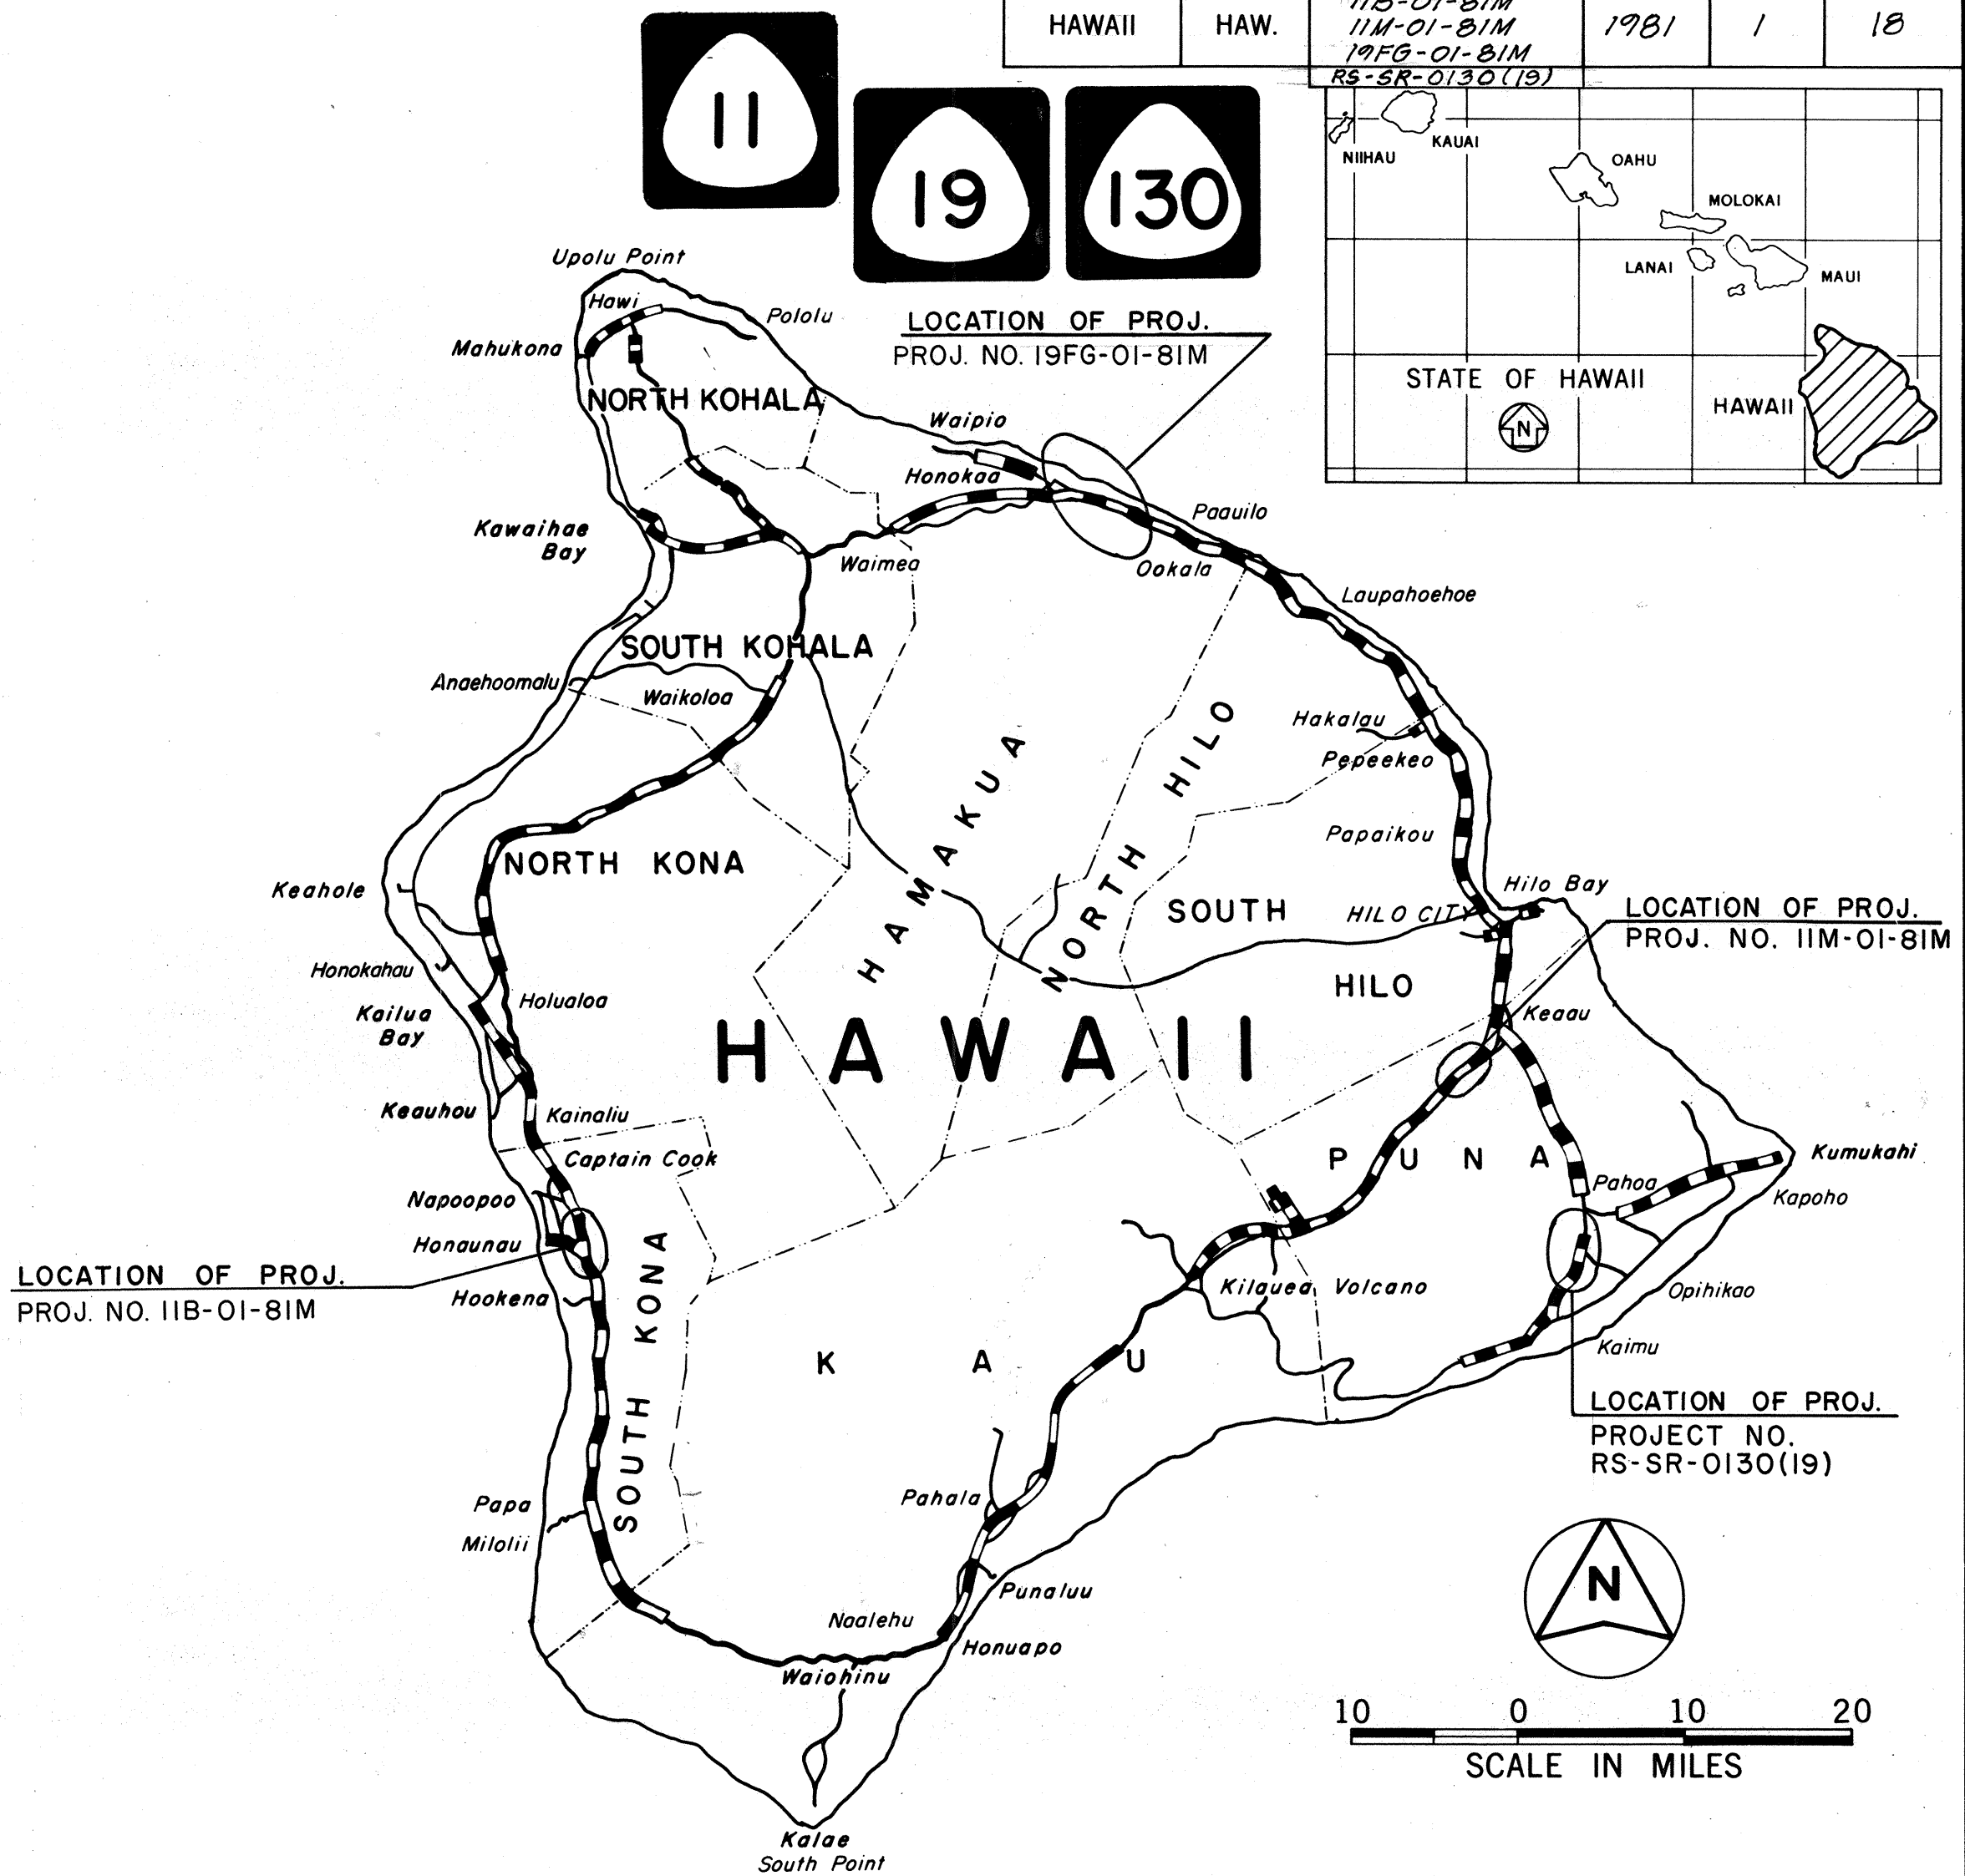

CHANGES MADE DURING CONSTRUCTION HAVE
BEEN INCORPORATED ON THESE PLANS EXCEPT
CHANGES IN THE ORIGINAL THEORETICAL
QUANTITIES. FOR ACTUAL QUANTITIES, REFER TO
PROJECT LEDGER AND/OR COMPUTATION BOOK.

Resident Engineer Signature
RESIDENT ENGINEER
9-5-84
DATE

DESIGN CLASSIFICATION
FEDERAL AID SECONDARY PROJECT NO. RS-SR-0130(19)

CURRENT ADT (1981)	1,091
DESIGN ADT (1991)	1,786
DHV	11.5%
D	55/45
T24	6.0%

DEPARTMENT OF TRANSPORTATION
STATE OF HAWAII
APPROVED:
James R. Carras
DIR. OF TRANSPORTATION
5/13/84
DATE

HWY - H
DESIGNED BY
R. MIKAMI
P. S. & E. BY
548-7534
PHONE
MAY, 1981
DATE