<u> </u>			
	INDEX TO DRAWINGS		
SHEET NO.	DESCRIPTION		
l som	TITLE SHEET		
2,3	GENERAL LOCATION PLAN		
4	TYPICAL DELINEATION AND PAVE-		
	MENT MARKING LAYOUT, SUMMARY		
5	STANDARD DETAILS		
and the state of t			



STATE OF HAWAII

DEPARTMENT OF TRANSPORTATION

HIGHWAYS DIVISION

"AS-BUILT"

PLANS FOR

PAVEMENT MARKINGS AT VARIOUS BRIDGES ON THE ISLAND OF HAWAII

ROUTE NOS. 11, 19, 27, 190, 220, 240, 250, 270

FEDERAL AID PROJ. NO. HES-PMS-0100(21)

ISLAND OF HAWAII

CONTRACTOR: THE KASPAC CORPORATION


CONTRACT NO: 13698

ALL CHANGES MADE DURING CONSTRUCTION HAVE BEEN INCORPORATED ON THESE PLANS IN RED EXCEPT CHANGES IN THE ORIGINAL THEORETICAL QUANTITIES. FOR ACTUAL QUANTITIES, REFER TO PROJECT LEDGER AND/OR COMPUTATION BOOK

Benge Krdani
RESIDENT ENGINEER


12-8-82 DATE FED. ROAD DIST. NO. STATE FED. AID PROJ. NO. FISCAL SHEET TOTAL SHEETS

HAWAII HAW. HES-PMS-OIOO(21) 1982 / 5

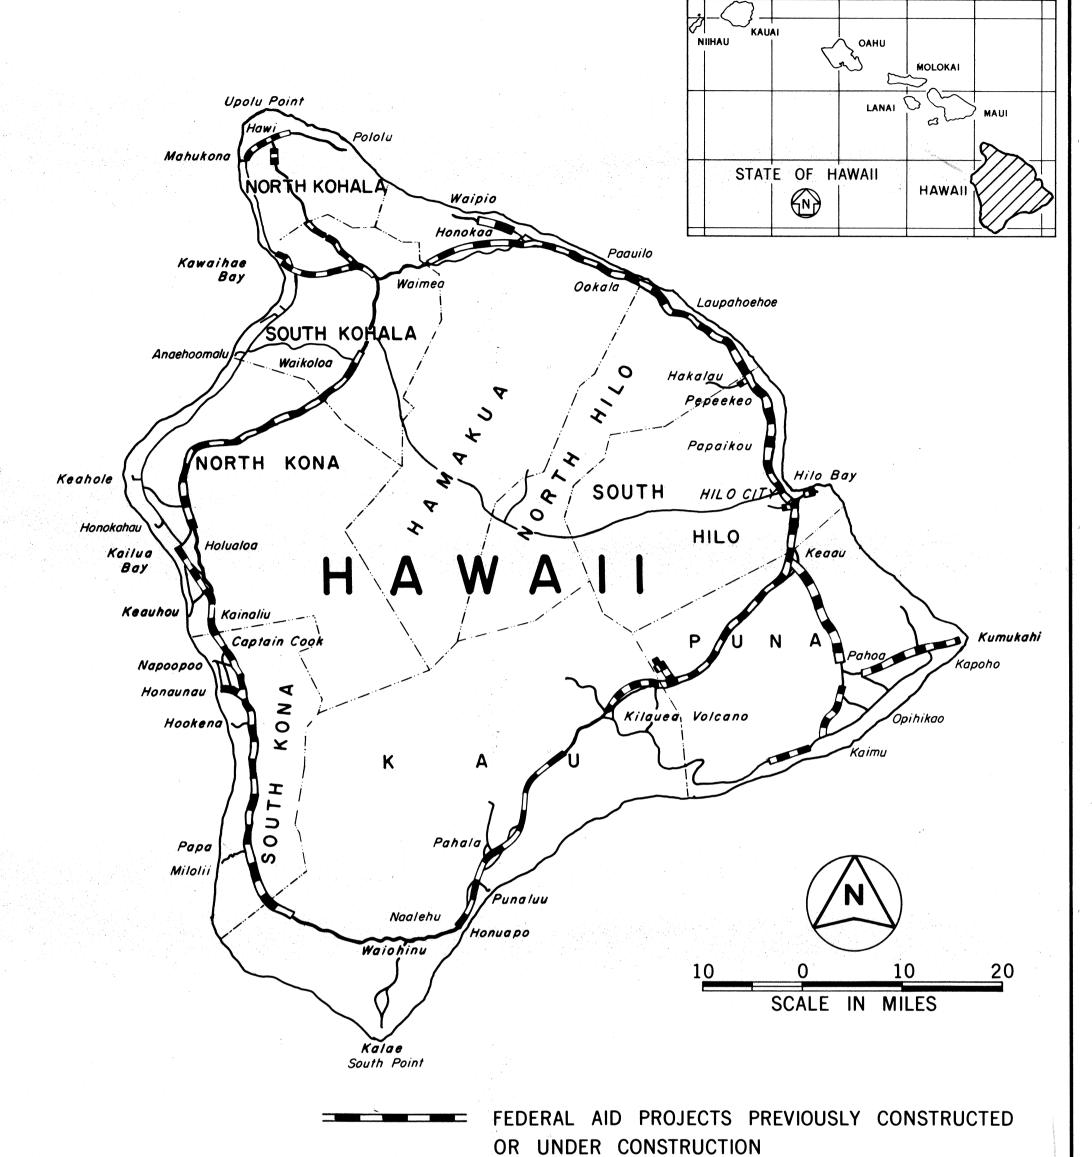

The scope of work for this project consist of installation of reflector markers and edge of pavement striping at various bridges on the State Highway System, Island of Hawaii.

Length of Project......21.22 Miles

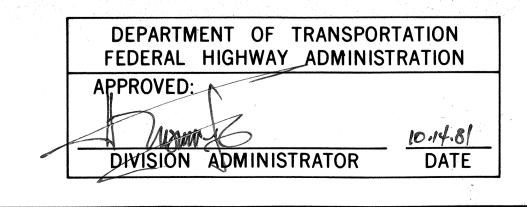

		집합하는 중요를 받는데, 말하는 그는 것 같	
DE	PART	MENT OF TRANSPO STATE OF HAWAII	RTATION
APP	ROVE	D:	
Ja	m	es R. Carras	10/13/81
DIR.	OF	TRANSPORTATION	DÂTE