
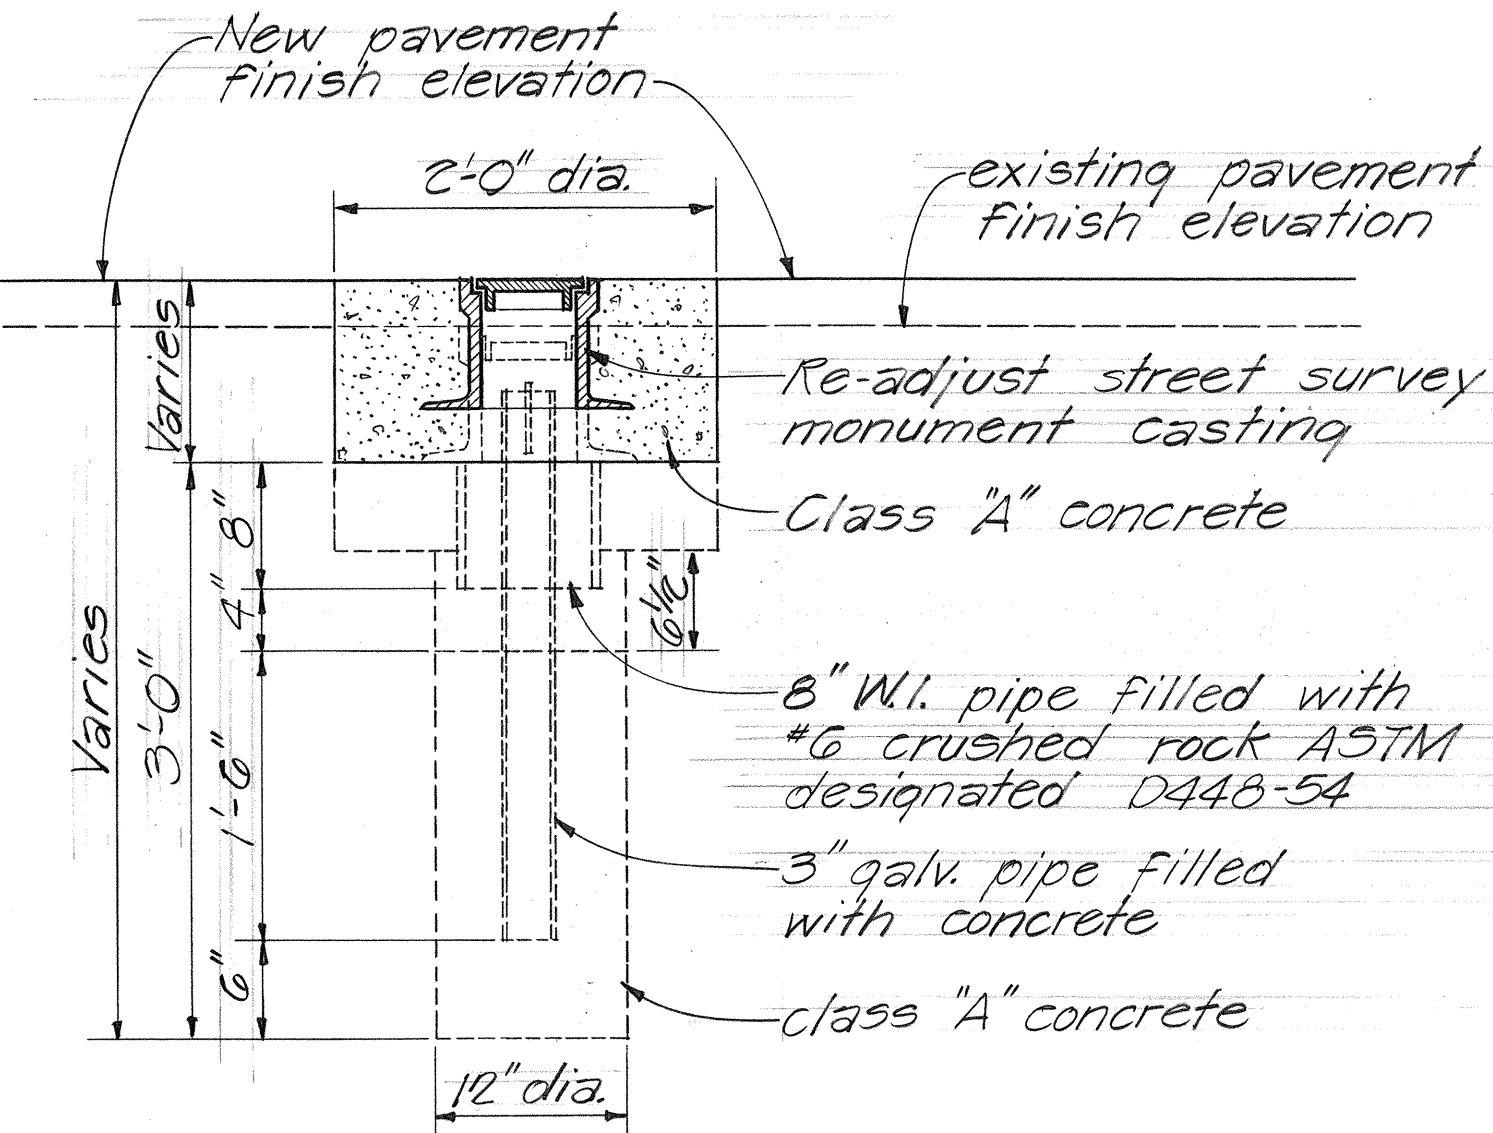


FED. ROAD DIST. NO.	STATE	PROJ. NO.	FISCAL YEAR	SHEET NO.	TOTAL SHEETS
HAWAII	HAW.	11M-01-82M	1981	2	15

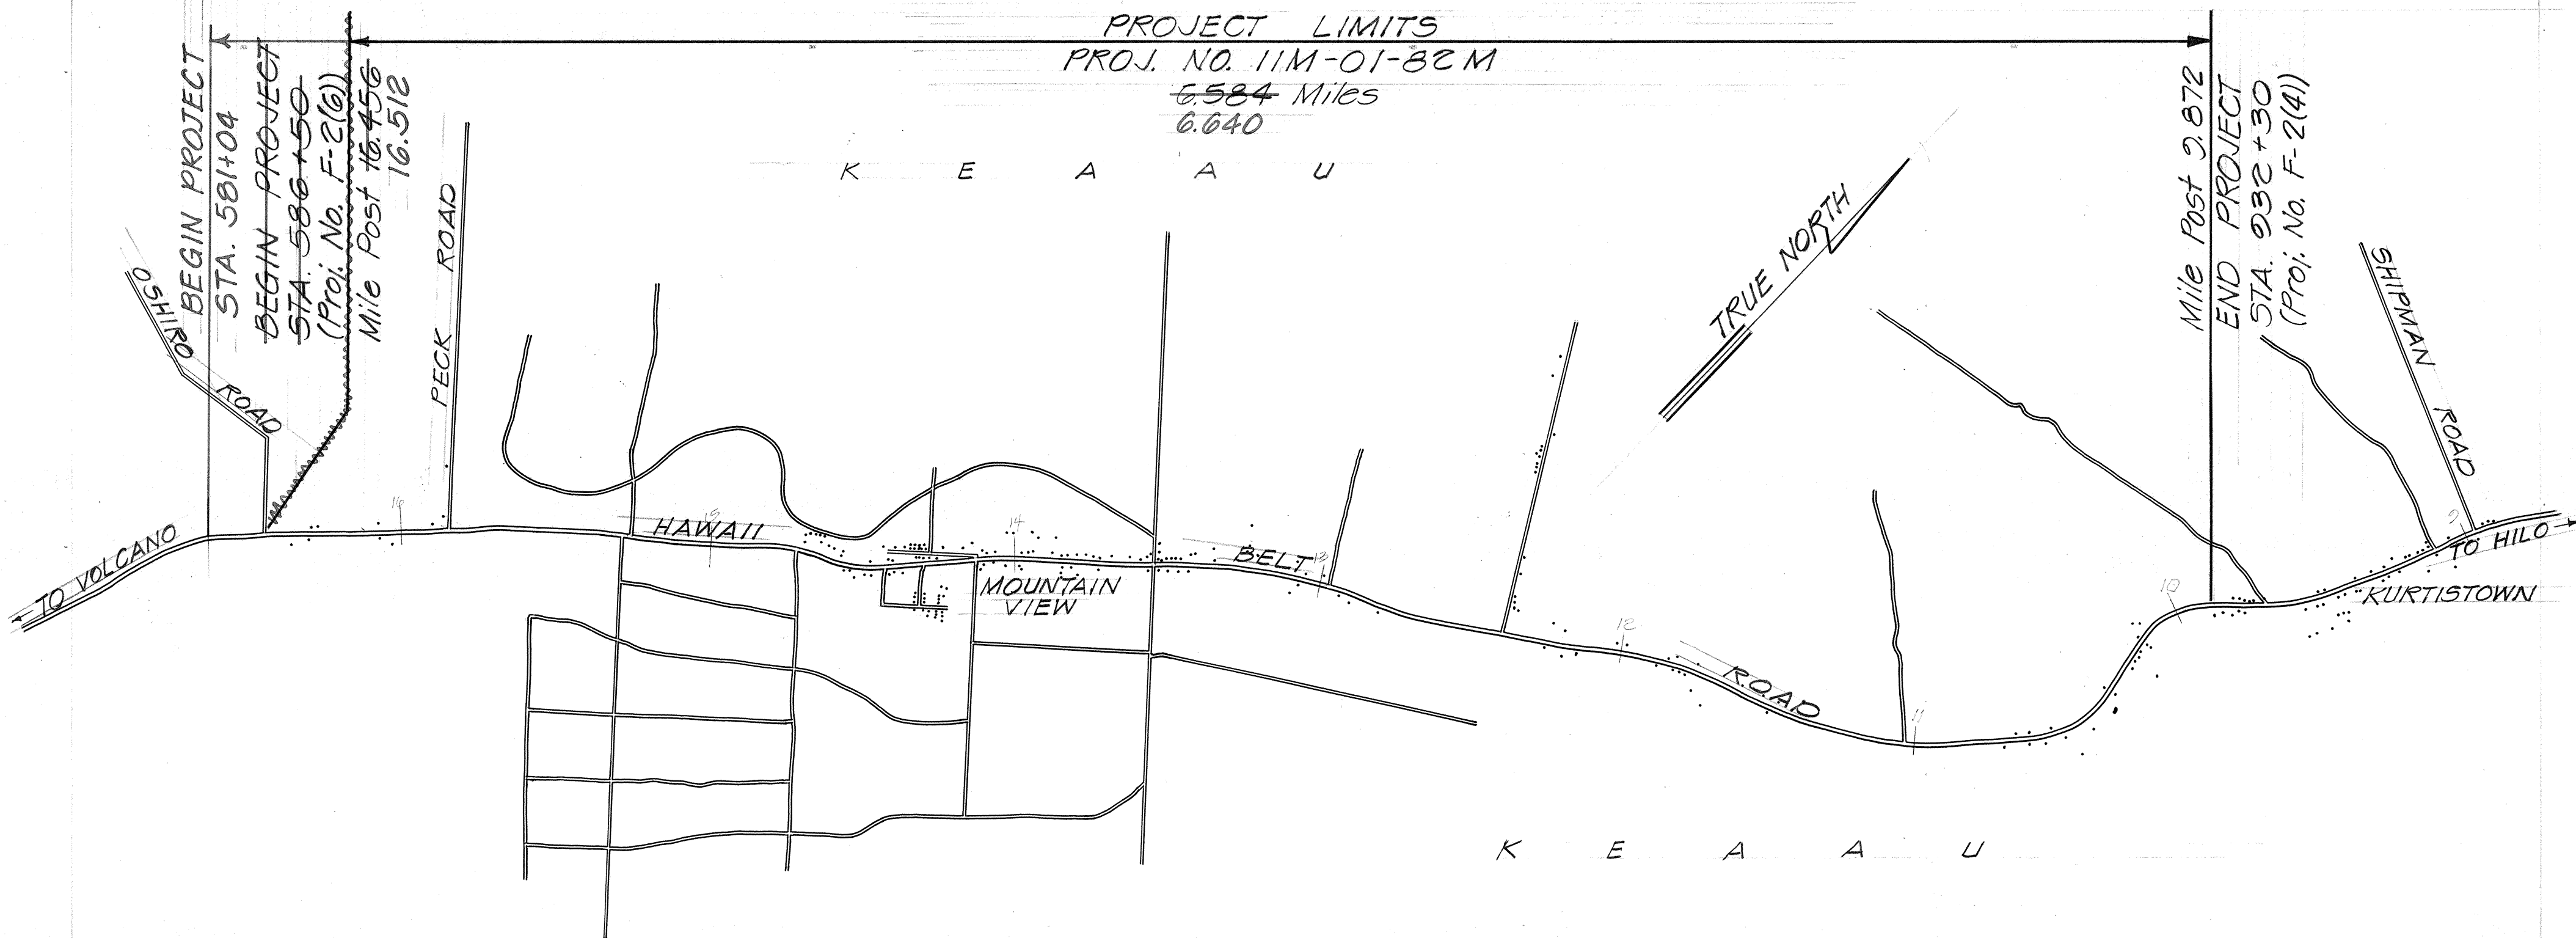

RECOVERY DETAIL FOR
STREET SURVEY MONUMENT
(STA. 907+80, PROJ. NO. F-2(4))
Scale: 1"=1'-0"

HAWAII BELT ROAD (VOLCANO ROAD)
PROJ. NO. 11M-01-82M
Scale: 1"=2,000

ADDITIONAL & MONUMENTS RECOVERED

PROJECT NO. (EXIST.)	STATION
F-011-2(5)	S.T. 581+04
"	586+50

PAVEMENT MARKER SCHEDULE					
STATION		DESCRIPTION	TYPE		
FROM	TO		D	H	J
Proj. No. F-2(4)					
586+50	670 + 556	Passing Both Sides	211		844
670 + 556	676 + 567	Passing L No Passing R	16	15	60
676 + 567	677 + 565	Open			
677 + 565	694 + 1526	No Passing Both Sides	84		
694 + 1526	694 + 94 695 + 00	Open			
694 + 94 695 + 00	892 + 9632	Passing Both Sides	495		1079
892 + 9632	899 + 9652	Passing L No Passing R	19	18	72
899 + 9652	901 + 82 908 + 15	No Passing Both Sides	42		
901 + 82 908 + 15	911 + 6642	No Passing L Passing R	10	9	36
911 + 6642	913 + 92 915 + 36	Passing Both Sides	10		40
913 + 92 915 + 36	921 + 8672	Passing L No Passing R	18	17	68
921 + 8672	927 + 3562	No Passing Both Sides	28		
927 + 3562	932 + 30	No Passing L Passing R	14	13	52
TOTALS			947	72	3151

RECOVER & MONUMENTS

PROJ. NO. (EXIST.)	STATION
F-2(6)	P.C. 626 + 26.09
"	P.T. 631 + 87.76
"	P.C. 660 + 78.56
"	P.T. 663 + 28.56
"	P.O.T. 669 + 00
F-2(4)	P.C. 675 + 49.03
"	P.T. 681 + 48.47
"	P.C. 683 + 64.20
"	P.T. 691 + 83.65
"	P.C. 709 + 61.75
"	P.T. 722 + 10.08
"	P.O.T. 740 + 00
"	P.C. 752 + 24.16
"	P.T. 762 + 57.42 EQ.
"	P.T. 770 + 12.48 EQ.
"	P.C. 781 + 41.84
"	P.T. 791 + 76.01 EQ.
"	P.T. 791 + 77.40 EQ.
"	P.C. 823 + 02.88
"	P.T. 837 + 21.21 EQ.
"	P.T. 837 + 25.43 EQ.
"	P.C. 847 + 66.13
"	P.T. 863 + 29.46 EQ.
"	P.T. 864 + 04.24 EQ.
"	P.C. 875 + 06.22
"	P.T. 883 + 25.30
"	P.O.C. 907 + 80
"	T.S. 916 + 50.44
"	S.T. 932 + 30.25

TOTAL 95 EA.

F-2(4) 894+21.53
" 908+91.74

STATE OF HAWAII
DEPARTMENT OF TRANSPORTATION
HIGHWAYS DIVISION

GENERAL LOCATION PLAN

VOLCANO RD RESURFACING
GLENWOOD TO KURTISTOWN
PROJ. NO. 11M-01-82M
Scale: As Shown Date: July 1981
SHEET No. 1 OF 1 SHEETS

ORIGINAL PLAN	SURVEY PLOTTED BY	DATE
NOTE BOOK	DRAWN BY	
	DESIGNED BY	
	QUANTITIES BY	
	CHECKED BY	