



FED. ROAD DIST. NO.	STATE	PROJ. NO.	FISCAL YEAR	SHEET NO.	TOTAL SHEETS
HAWAII	HAW.	116-01-82 19K-01-82	1982	2	15

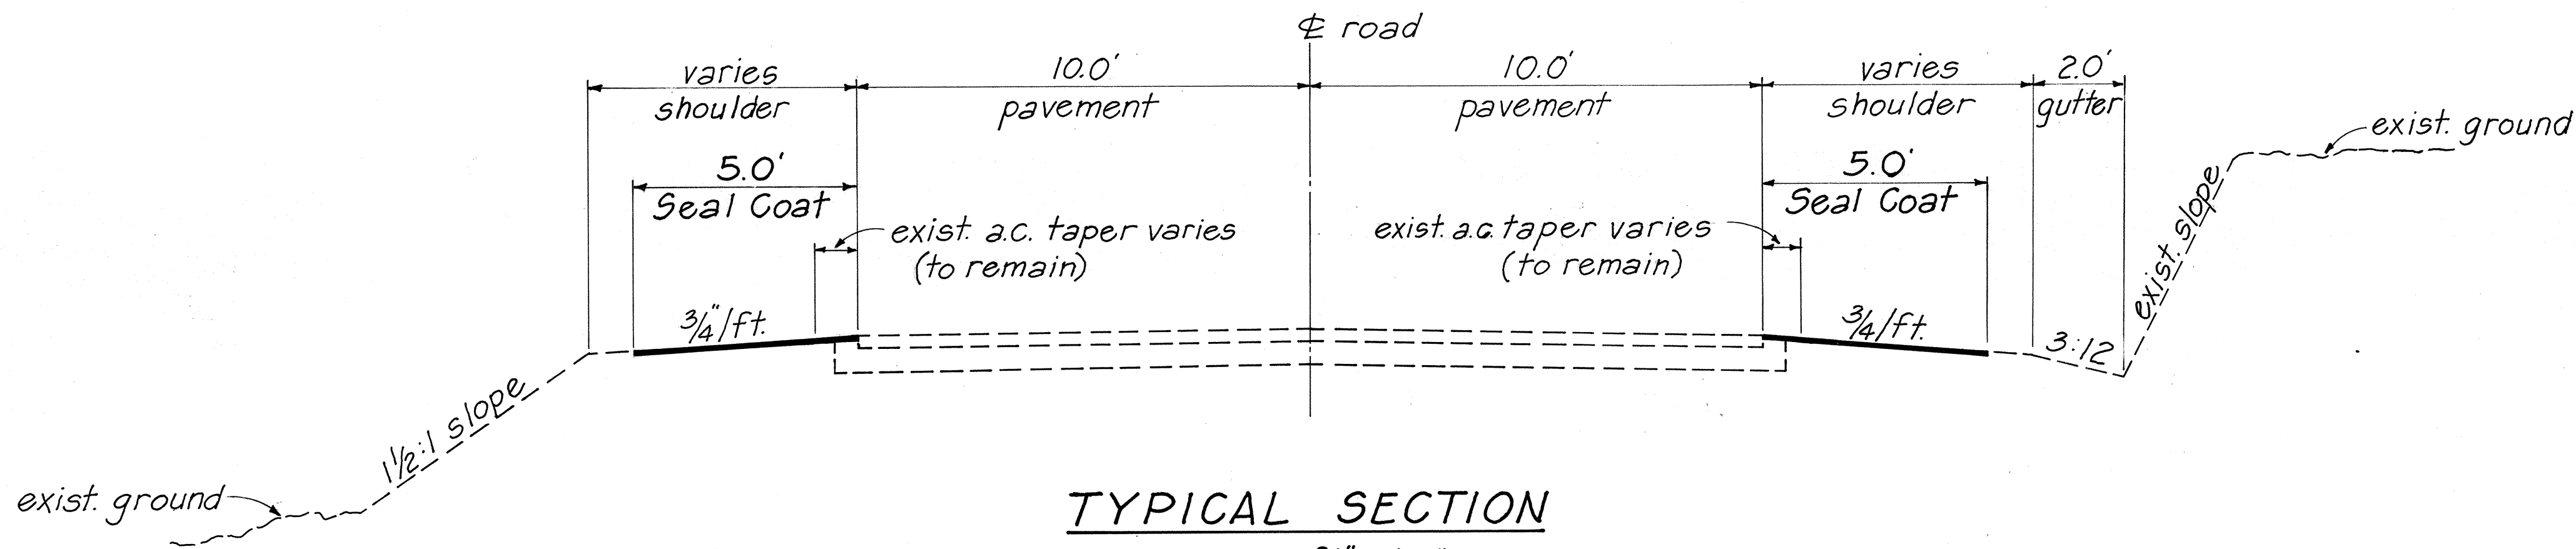


TYPICAL SECTION
Scale: 3/8" = 1'-0"

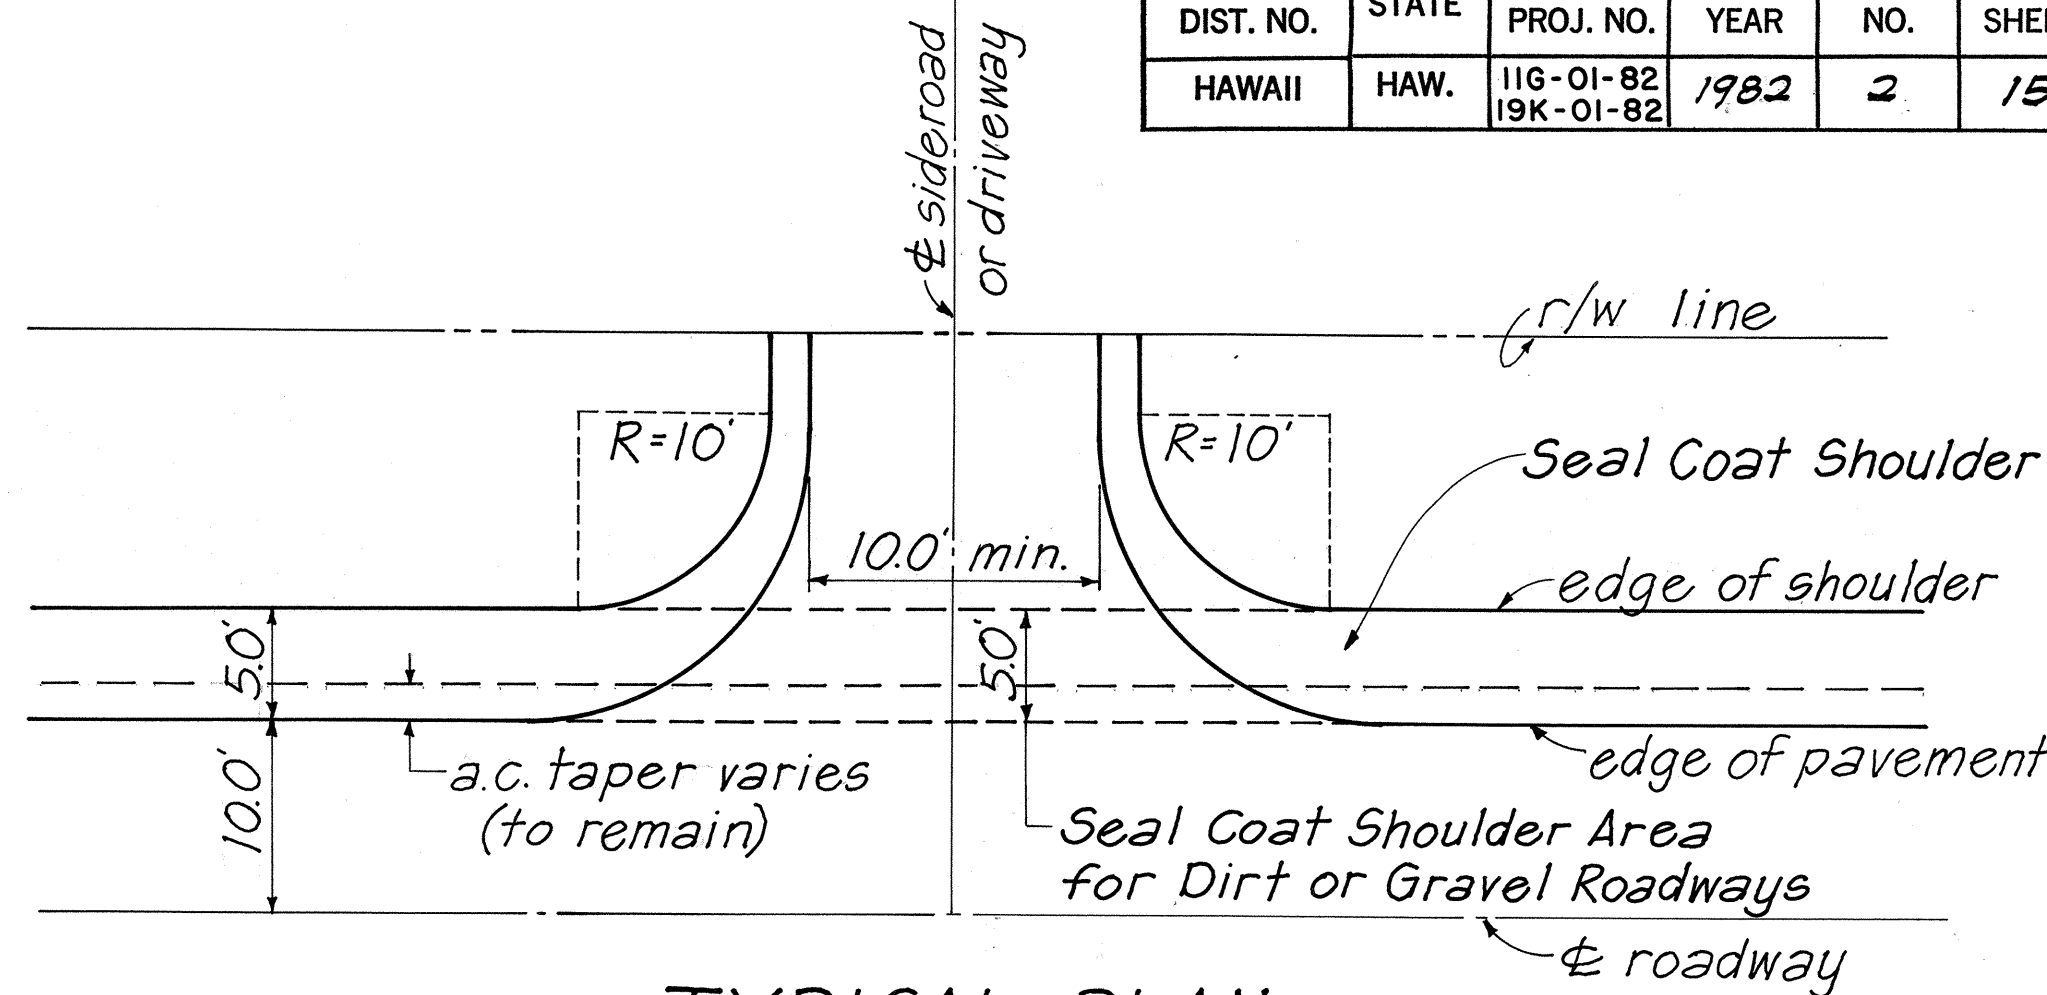

TYPICAL PLAN
INTERSECTION
SHOULDER CONNECTION
Not To Scale

GENERAL NOTES

- Existing pavement and structures in shoulder areas shall be excluded from shoulder treatment and the Contractor shall exercise reasonable care to prevent disturbing any such existing pavement and structures within the limits of work.
- Edge of pavement striping to be done by others.

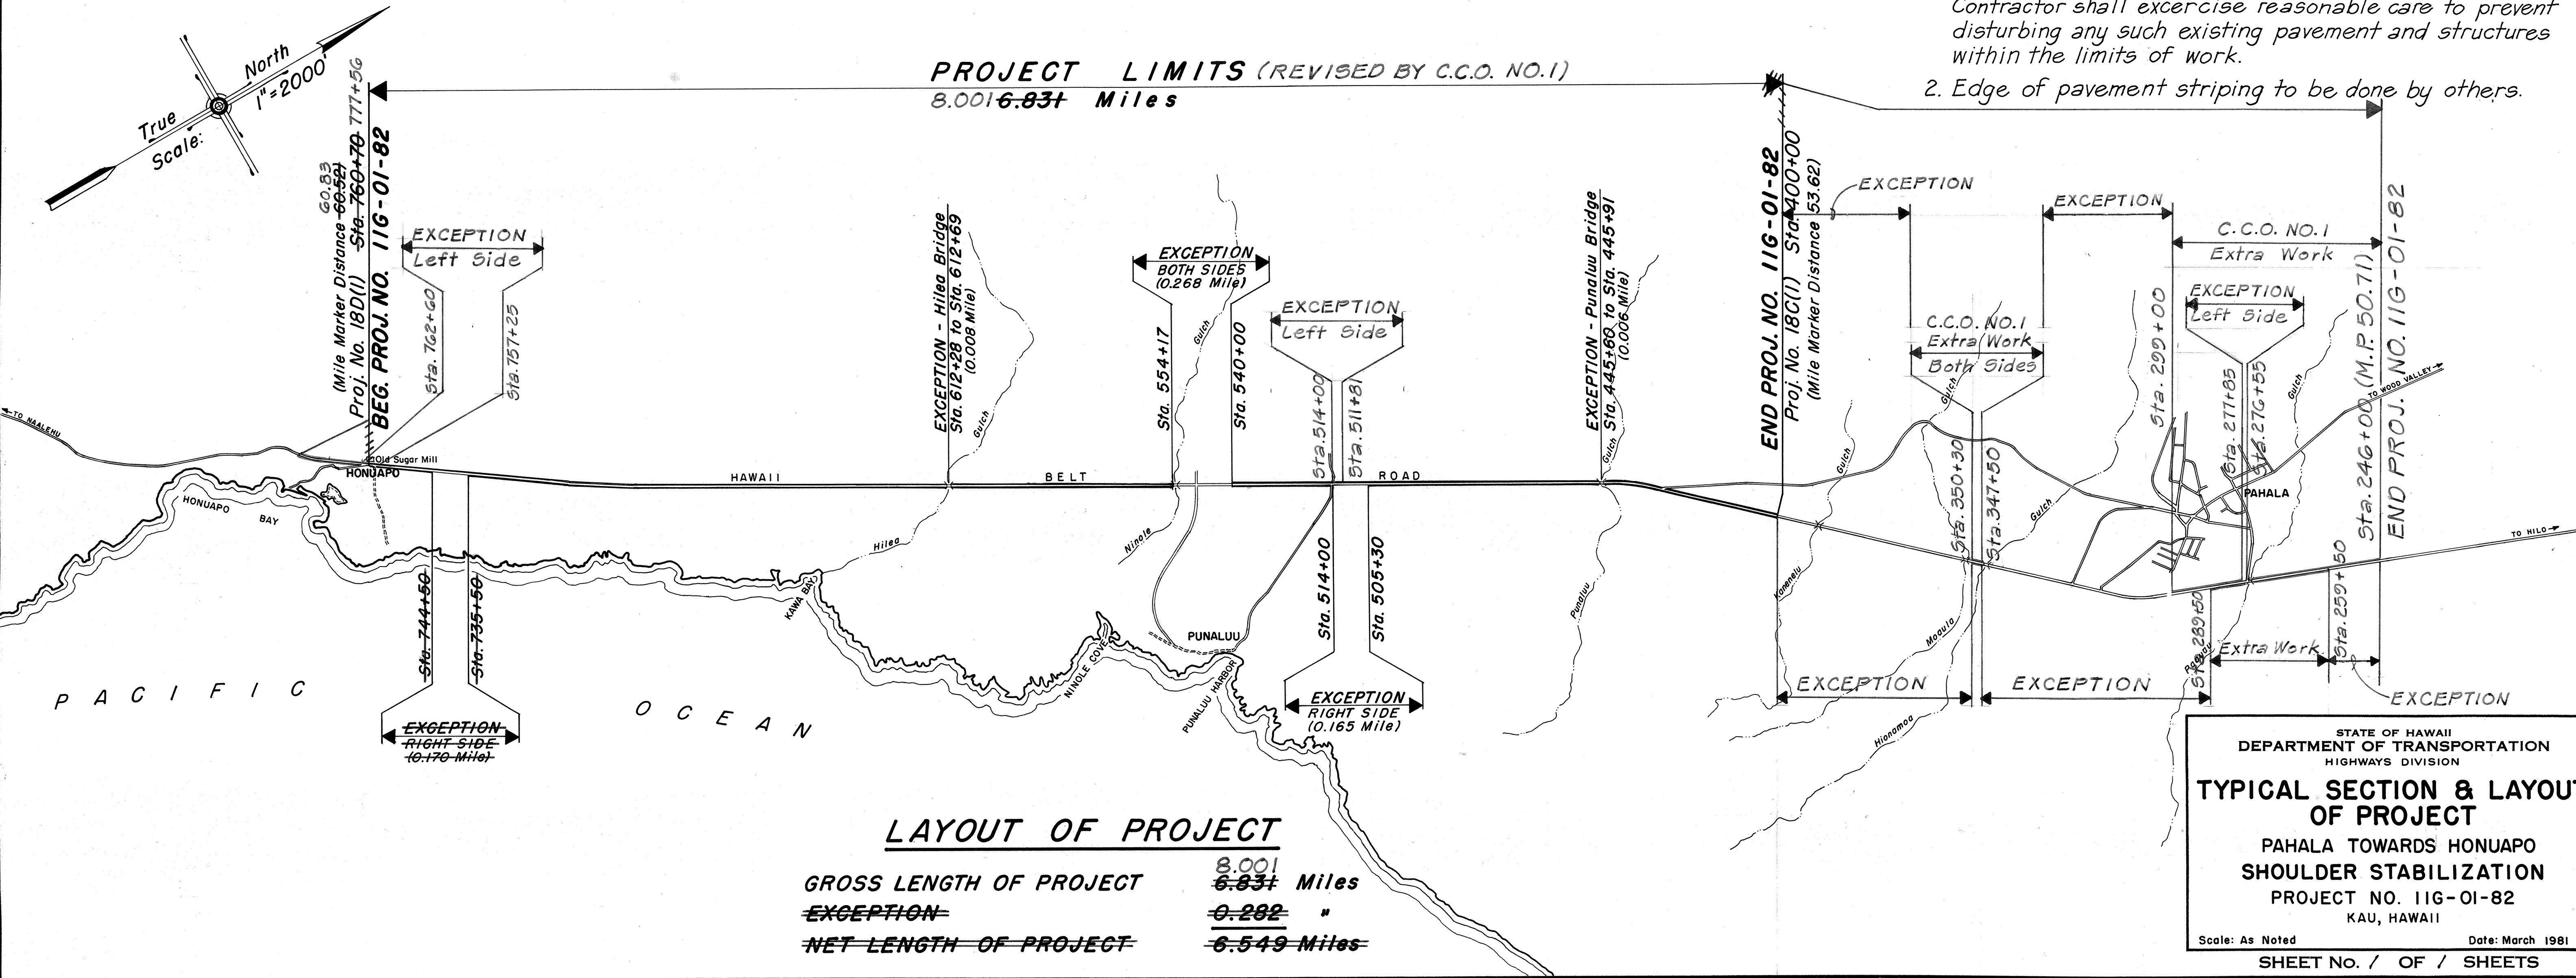

LAYOUT OF PROJECT

GROSS LENGTH OF PROJECT	8.001 Miles
EXCEPTION	0.268 "
NET LENGTH OF PROJECT	6.549 Miles

STATE OF HAWAII
DEPARTMENT OF TRANSPORTATION
HIGHWAYS DIVISION

TYPICAL SECTION & LAYOUT
OF PROJECT

PAHALA TOWARDS HONUAPU
SHOULDER STABILIZATION
PROJECT NO. 116-01-82
KAU, HAWAII

Scale: As Noted Date: March 1981

SHEET NO. / OF / SHEETS

SURVEY PLOTTED BY	DATE
DRAWN BY	
DESIGNED BY	
CHECKED BY	
ORIGINAL PLAN	
NOTE BOOK	
No.	