

FED. ROAD DIST. NO.	STATE	PROJ. NO.	FISCAL YEAR	SHEET NO.	TOTAL SHEETS
HAWAII	HAW.	19H-02-82M	1982	3	6

RECOVERY OF ϕ AND REFERENCE SURVEY MONUMENTS


PROJ. NO.(EXIST.)	LOCATION
SDR~3(17)	R/W Sta. 84 + 60.91
"	R/W Sta. 93 + 90.32
"	R/W Sta. 100 + 77.62
"	P.C. Sta. 111 + 30.84
F~019~2(3)	R/W P.T. Sta. 10 + 18.54
"	R/W P.C. Sta. 31 + 63.70
"	R/W P.T. Sta. 38 + 52.03
"	P.O.T. Sta. 45 + 00
SDR~3(5)	P.O.T. Sta. 49 + 47
"	P.C. Sta. 57 + 31.59
"(C of H Mon.)	P.I. Sta. 62 + 77 ±
"	P.T. Sta. 66 + 69.21
"	P.O.T. Sta. 76 + 00
"	P.C. Sta. 98 + 01.59
"	P.T. Sta. 109 + 34.09
"	P.O.T. Sta. 111 + 11.24
TOTAL	16

SIDE ROAD SCHEDULE


PROJ. NO.	LOCATION
SDR~3(17)	103 + 30 Lt.
"	111 + 74.87 Rt.
F~019~2(3)	39 + 31 Rt.
SDR~3(5)	53 + 92 Rt.
"	56 + 50 Lt.
"	62 + 75 Lt.
"	62 + 75 Rt.
"	78 + 00 Lt.
"	78 + 00 Rt.
TOTAL	9

NOTE: 1)Pave side roads to R/W line.
2)R/W line is 50' from ϕ highway.

PAVEMENT MARKER SCHEDULE						
STATION		DESCRIPTION	TYPE			
FROM	TO		D	H	J	
		Proj. No. SDR~3(17)				
84+00	91 + 0525	No Passing Both Sides	36			
91 + 0525	103 + 2025	No Passing L Passing R	30	30	120	
103 + 2025	103 + 6050	Open				
103 + 6050	111 + 4045	No Passing Both Sides	40			
111 + 4045	112 + 2001	Open				
112 + 2001	116 + 8001	No Passing Both Sides	24			
		Proj. No. F~019~2(3)				
6+50	7 + 0500	Open				
7 + 0500	11 + 99 12 + 30	No Passing L Passing R	12	13	52	
11 + 99 12 + 30	27 + 00	Passing Both Sides	38		148	
27 + 00	36 + 7560	Passing L No Passing R	24	25	100	
36 + 7560	39 + 0510	No Passing Both Sides	12			
39 + 0510	39 + 60	Open				
39 + 60	44 + 4090	No Passing L Passing R	13	14	56	
		Proj. No. F~SDR~019~2(1)				
44 + 4090	51 + 69 52 + 89	Passing Both Sides	17		64	
		Proj. No. SDR~3(5)				
51 + 69 52 + 89	56 + 1004	Passing L No Passing R	12	13	52	
56 + 1004	56 + 75	Open				
56 + 75	62 + 65	No Passing Both Sides	30			
62 + 65	63 + 0001	Open				
63 + 0001	68 + 0023	No Passing L Passing R	12	13	52	
68 + 0023	72 + 6553	Passing Both Sides	12		44	
72 + 6553	77 + 7383	Passing L No Passing R	12	13	52	
77 + 7383	78 + 3026	Open				
78 + 3026	83 + 2056	No Passing L Passing R	12	13	52	
83 + 2056	94 + 8566	Passing Both Sides	29		112	
94 + 8566	103 + 7046	Passing L No Passing R	23	23	92	
103 + 7046	111 + 2859	No Passing Both Sides	38			
TOTALS			426	157	996	

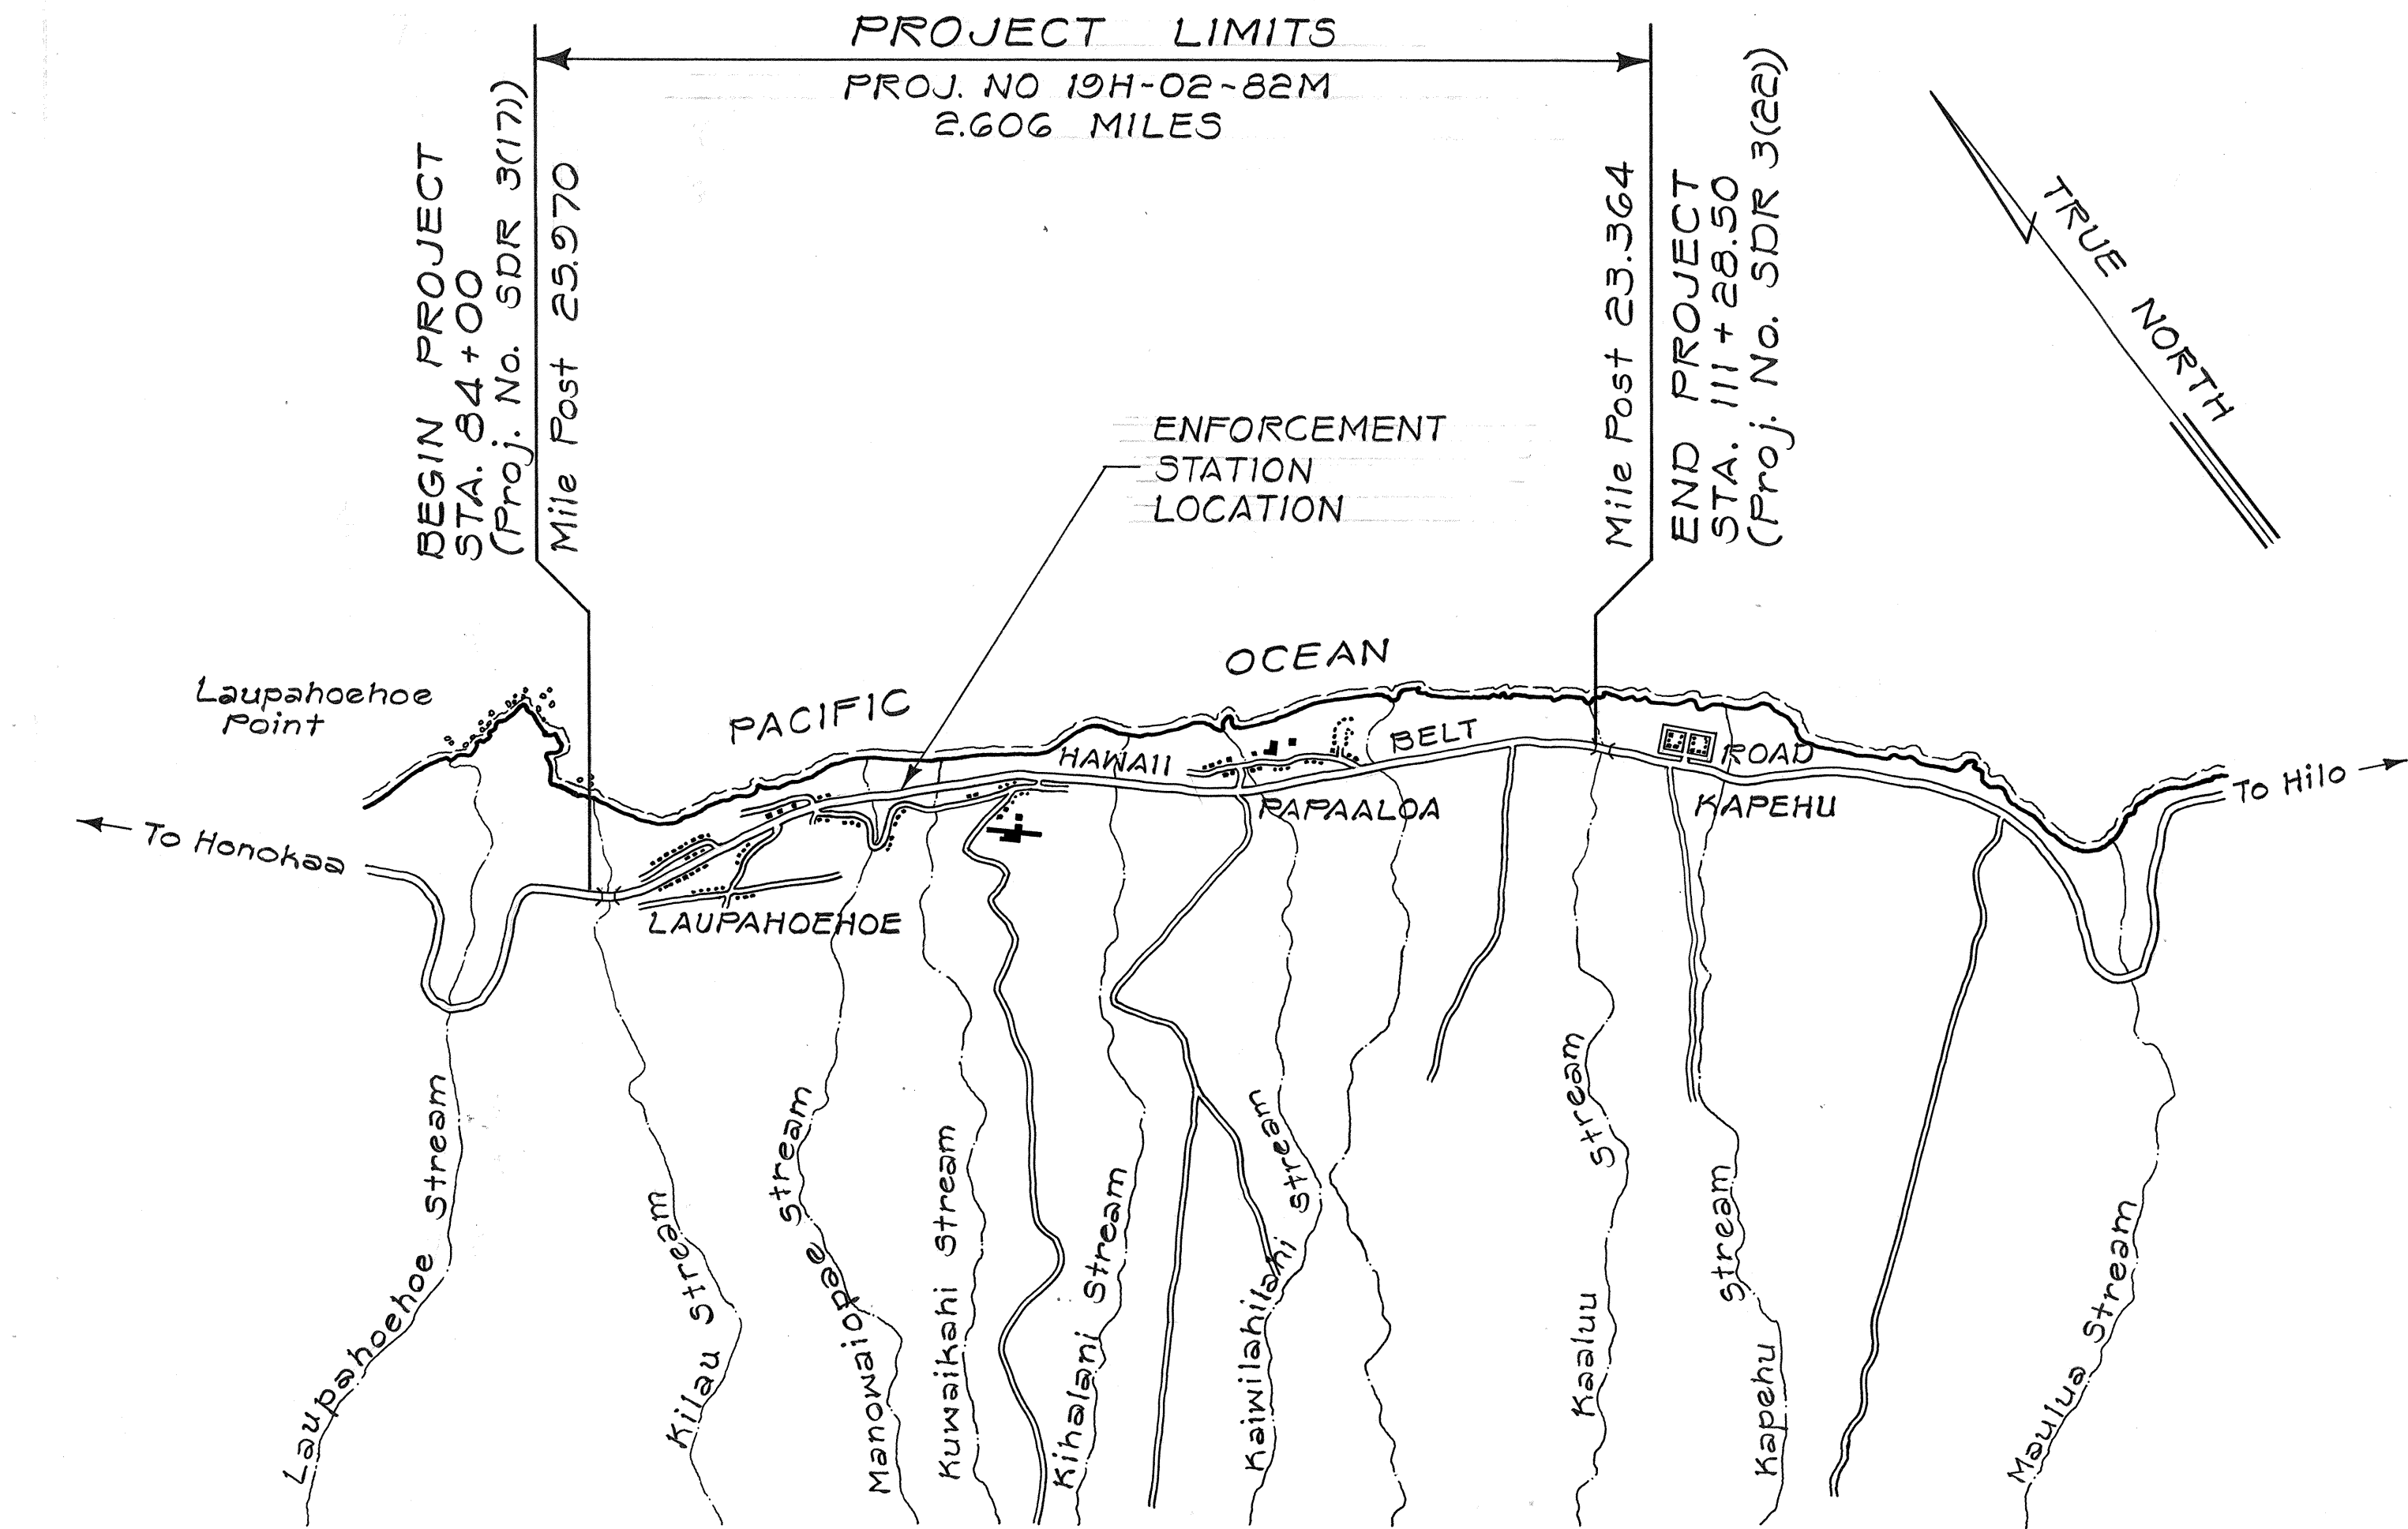

GENERAL LOCATION PLAN
Scale: 1" = 2000'

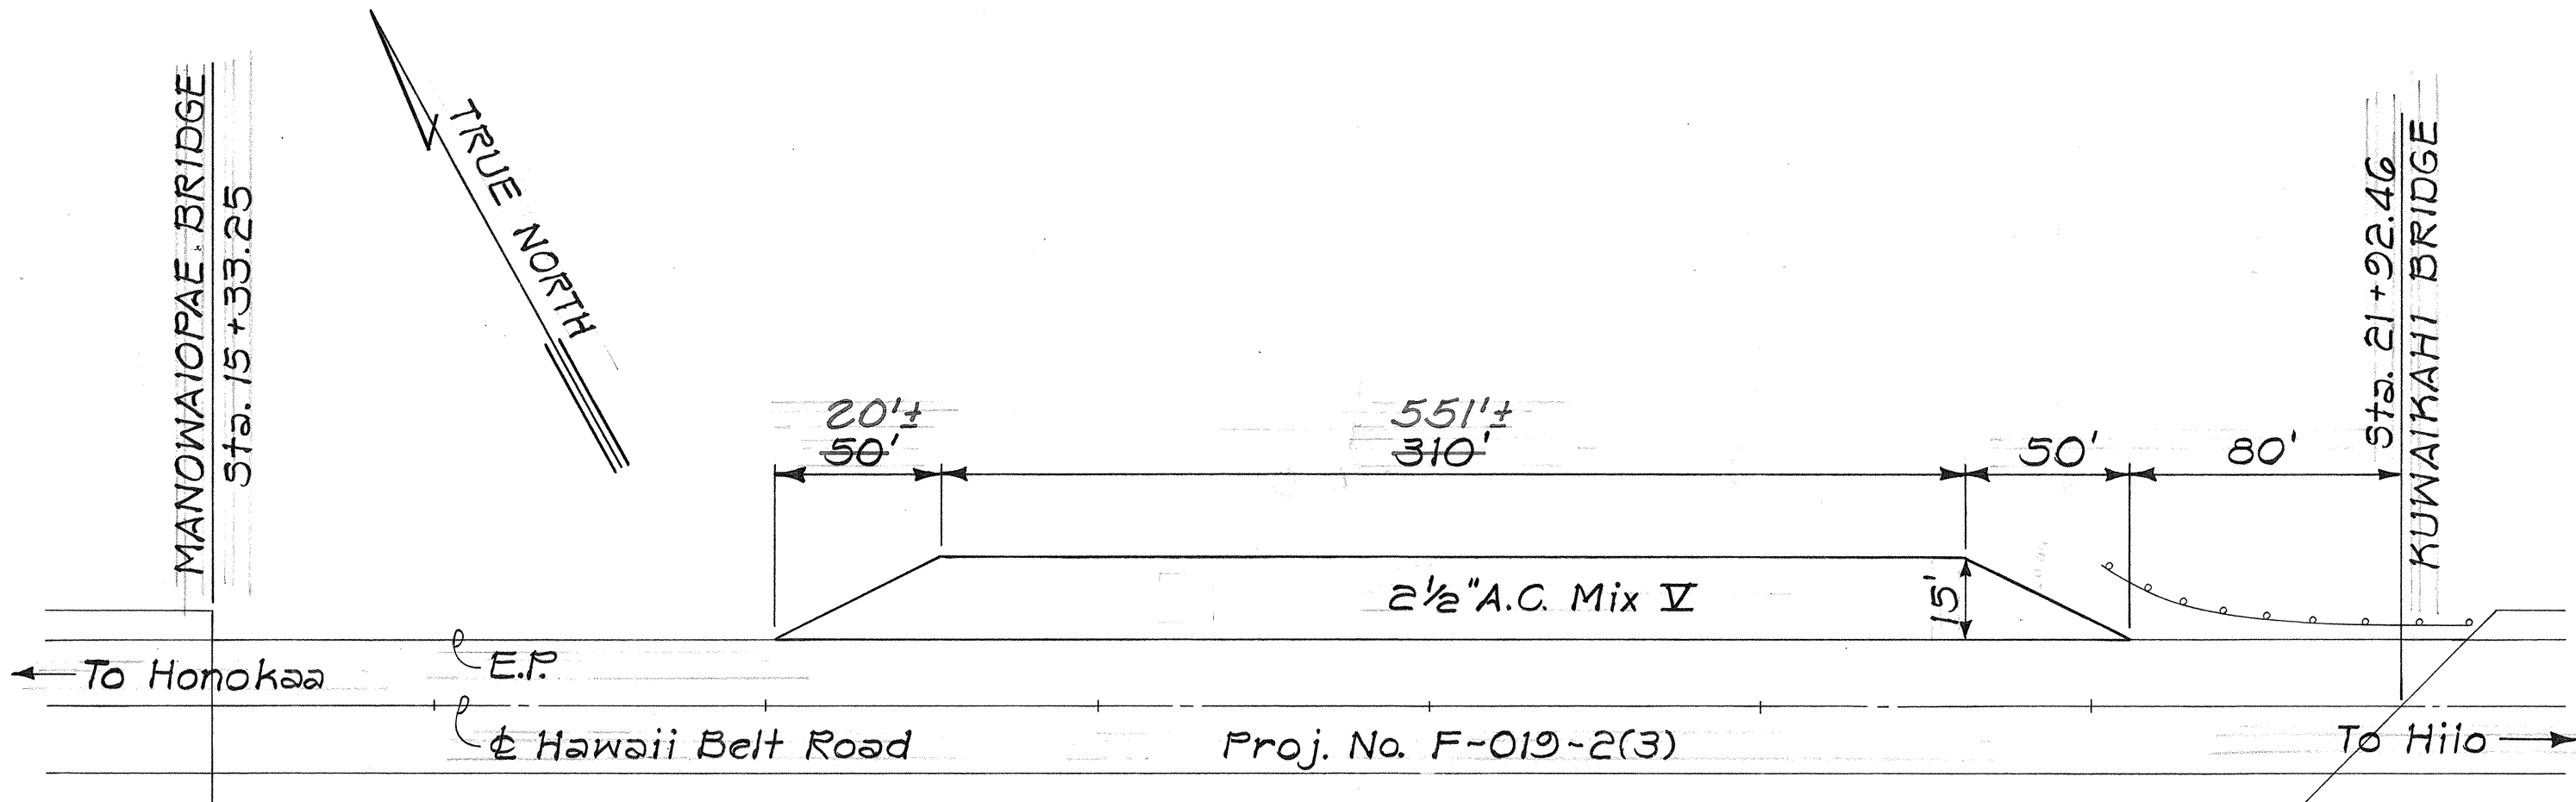

NOTE: Contractor to lay 2 1/2" Mix V only. All other work to be done by others.

SIZE AND WEIGHT ENFORCEMENT STATION
NOT TO SCALE

STATE OF HAWAII

DEPARTMENT OF TRANSPORTATION

HIGHWAYS DIVISION

GENERAL LOCATION PLAN

HAWAII BELT ROAD RESURFACING
KILAUEA BRIDGE TO KAALUU BRIDGE
PROJ. NO. 19H-02-82M

Scale: As Shown Date: March 1982

SHEET NO. 1 OF 1 SHEETS

SURVEY PLOTTED BY	DATE
DRAWN BY	C.A.S.
TRACED BY	
QUANTITIES BY	
CHECKED BY	
ORIGINAL PLAN	
NOTE BOOK	
No.	