


FED. ROAD DIST. NO.	STATE	PROJ. NO.	FISCAL YEAR	SHEET NO.	TOTAL SHEETS
HAWAII	HAW.	F-011-2(17)	1986	113	142


60 50 40 30 20 10 0 10 20 30 40 50

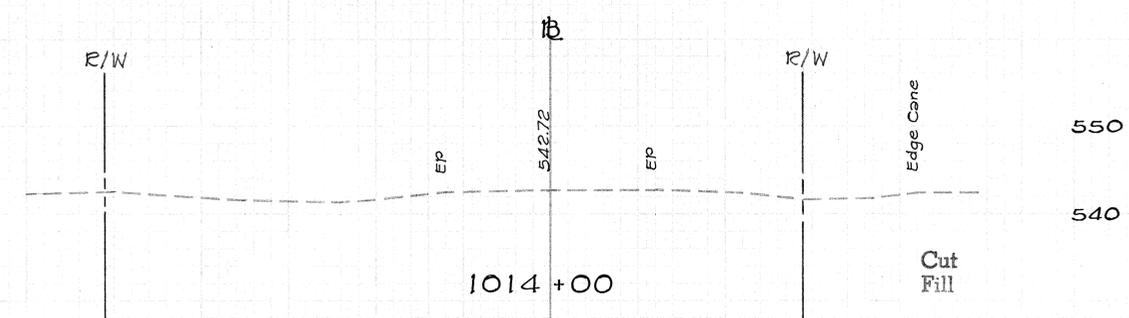

LEGEND

- IGC = Inbound Grade Control Line
- IBL = Inbound Lane
- OBL = Outbound Lane
- = Existing 8" Transite Waterline (Approximate Locations)
- = New 12" D.I. Waterline (Approximate Locations)

NOTE: Right-of-Way baseline (⊕) of Project No. F-011-2(2) has been adopted as the baseline for this project, except in the vicinity of the beginning of project. Refer to baseline data below for revisions.

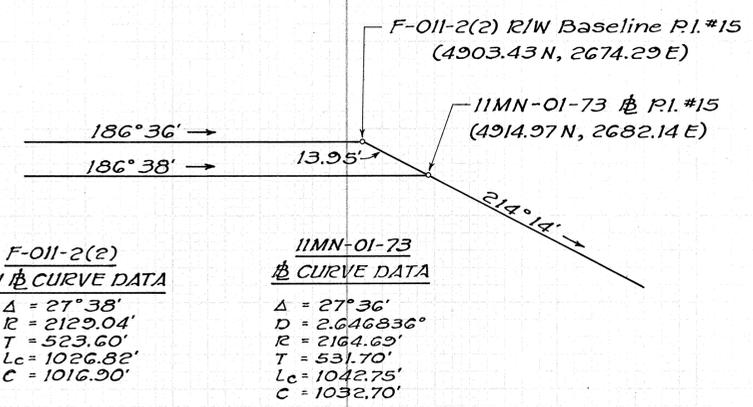

F-011-2(2) R/W ⊕ CURVE DATA


Δ = 27° 38'
R = 2129.04'
T = 523.60'
Lc = 1026.82'
C = 1016.90'

IIMN-01-73 ⊕ CURVE DATA

Δ = 27° 36'
D = 2.646836°
R = 2164.69'
T = 531.70'
Lc = 1042.75'
C = 1032.70'

Origin of Azimuths & Coordinates per Proj. No. F-011-2(2) R/W Map.

60 50 40 30 20 10 0 10 20 30 40 50

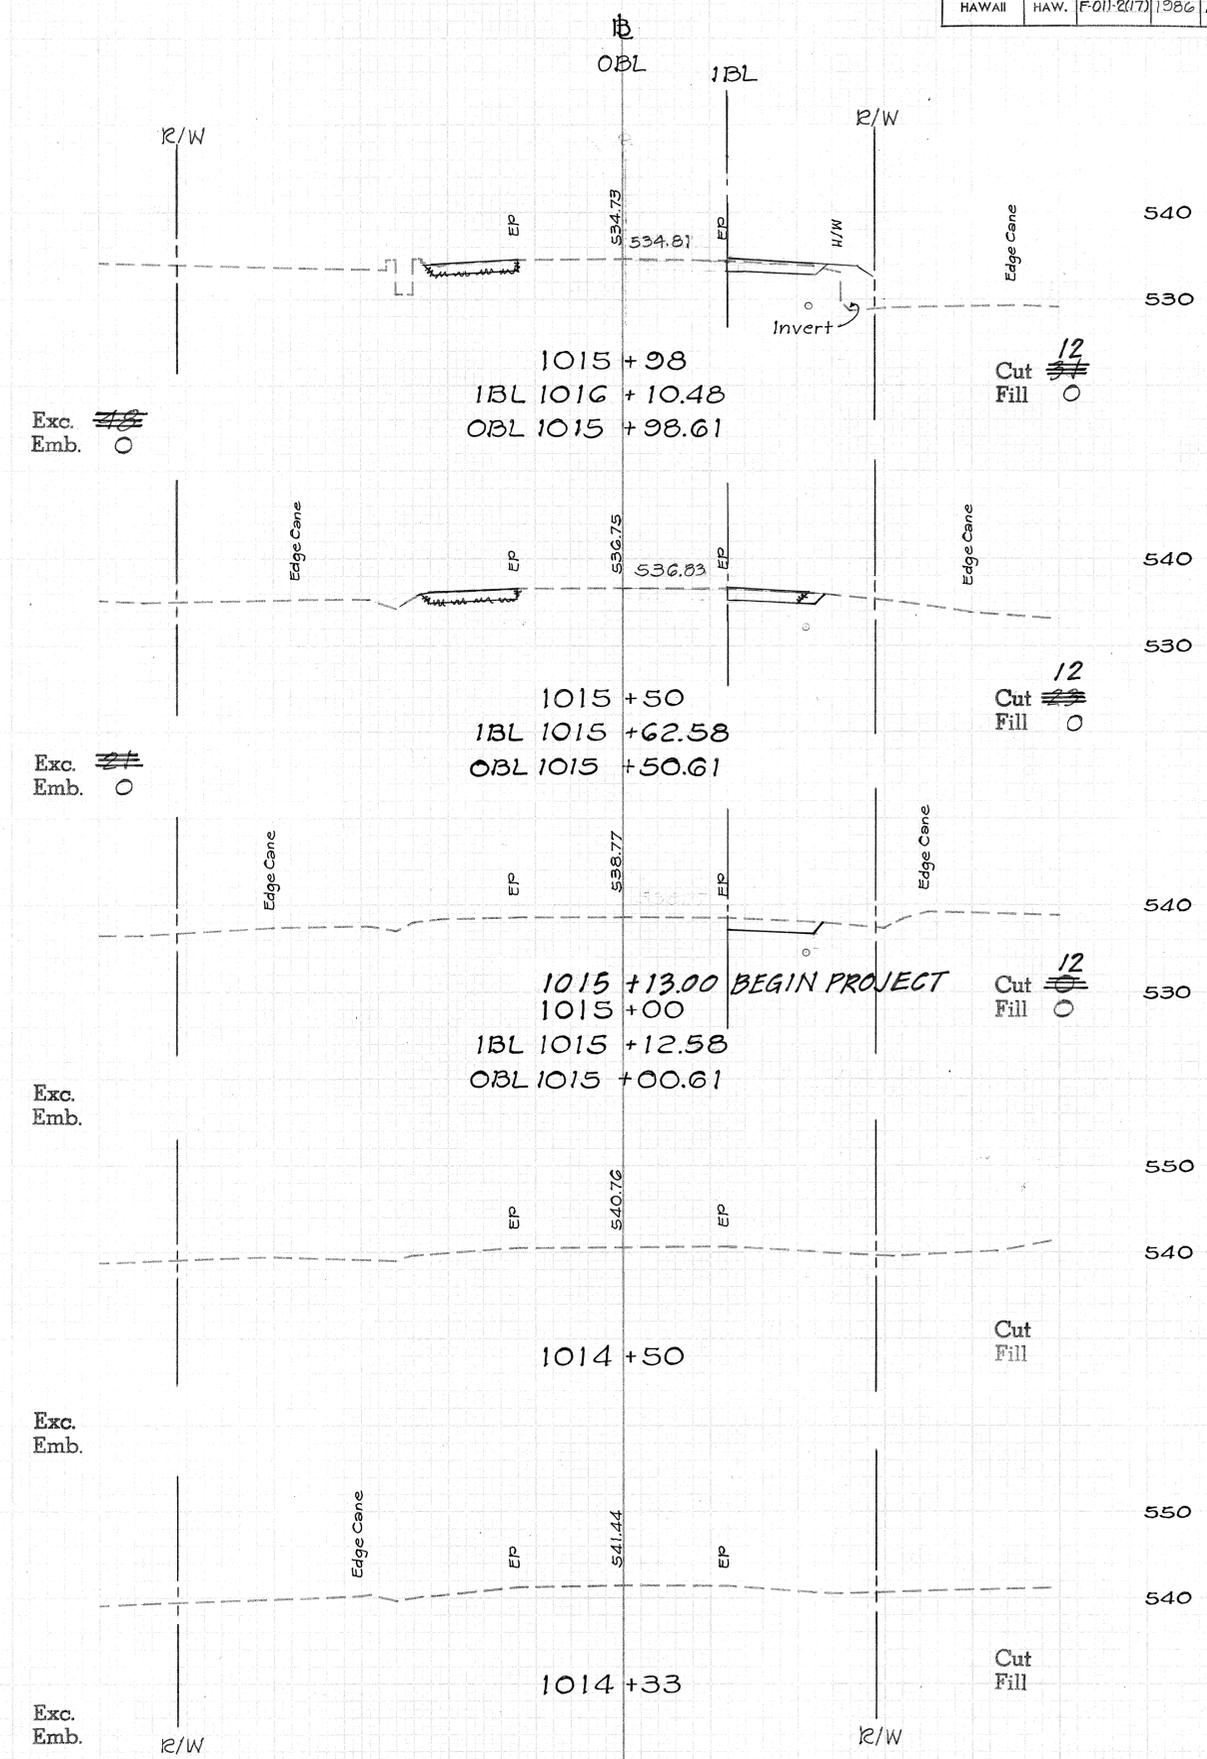

Exc. ~~⊕~~
Emb. ○




ORIGINAL SURVEY
 DATE: 11/15/54
 BY: [Signature]
 CHECKED: [Signature]

ORIGINAL SURVEY
 DATE: 11/15/54
 BY: [Signature]
 CHECKED: [Signature]

DATE	
BY	
ORIGINAL SURVEY	
SUMMITED	
NOTE BOOK	
TEMPLATE	
AREAS	
AREAS DRENED	

DATE	Apr. 86
BY	
ORIGINAL SURVEY	
SUMMITED	
NOTE BOOK	
TEMPLATE	
AREAS	
AREAS DRENED	

FED. ROAD DIST. NO.	STATE	FED. AID PROJ. NO.	FISCAL YEAR	SHEET NO.	TOTAL SHEETS
HAWAII	HAW.	F-011-2(17)			

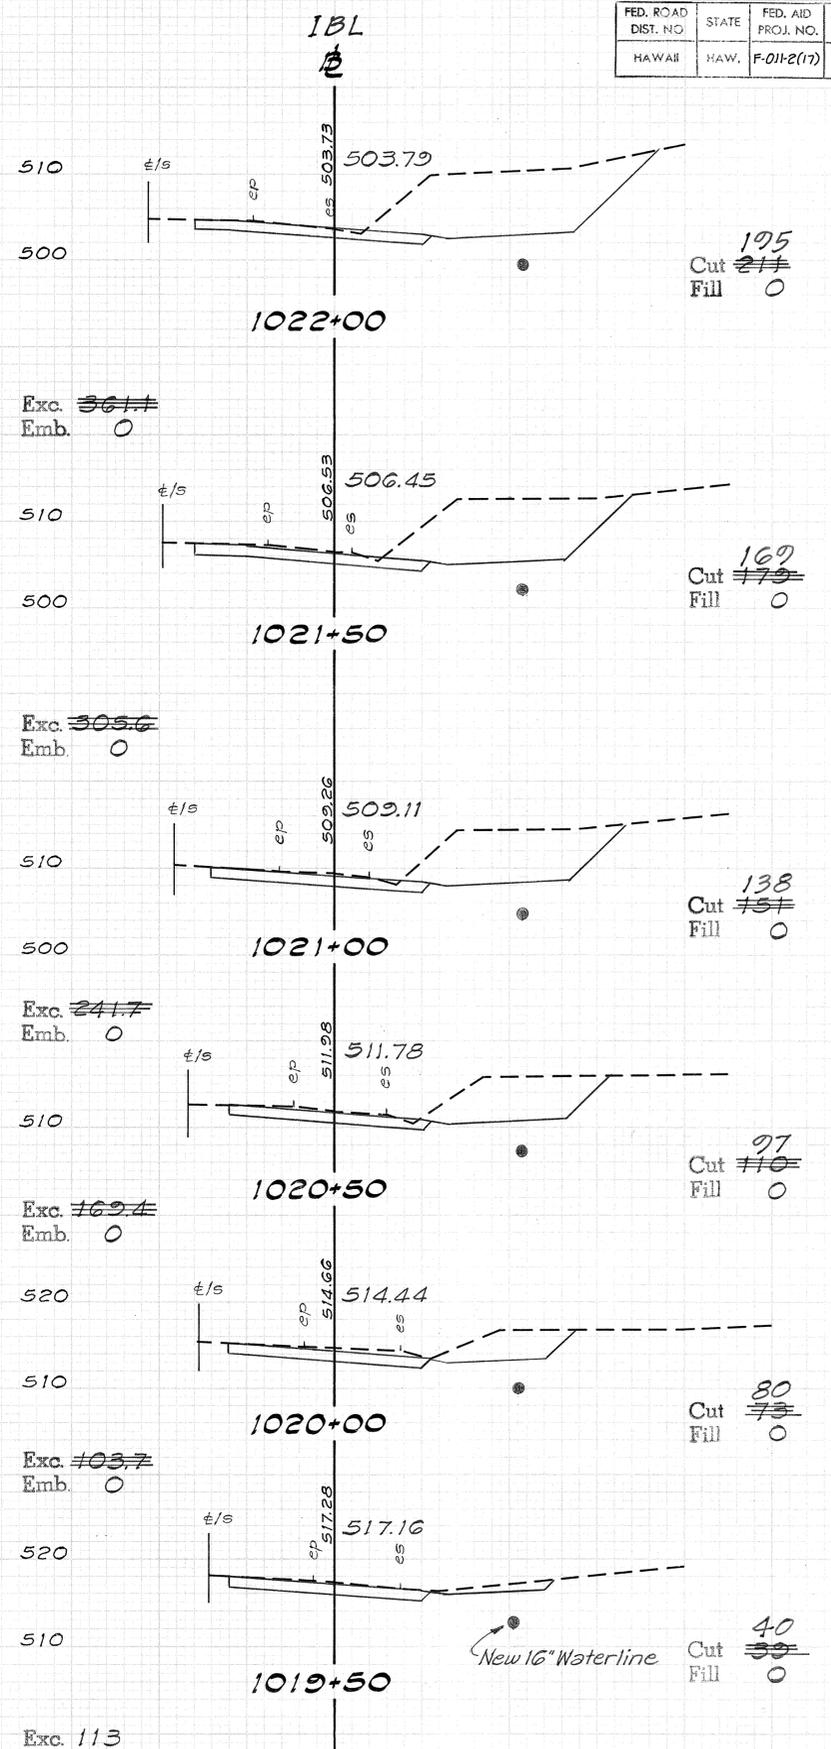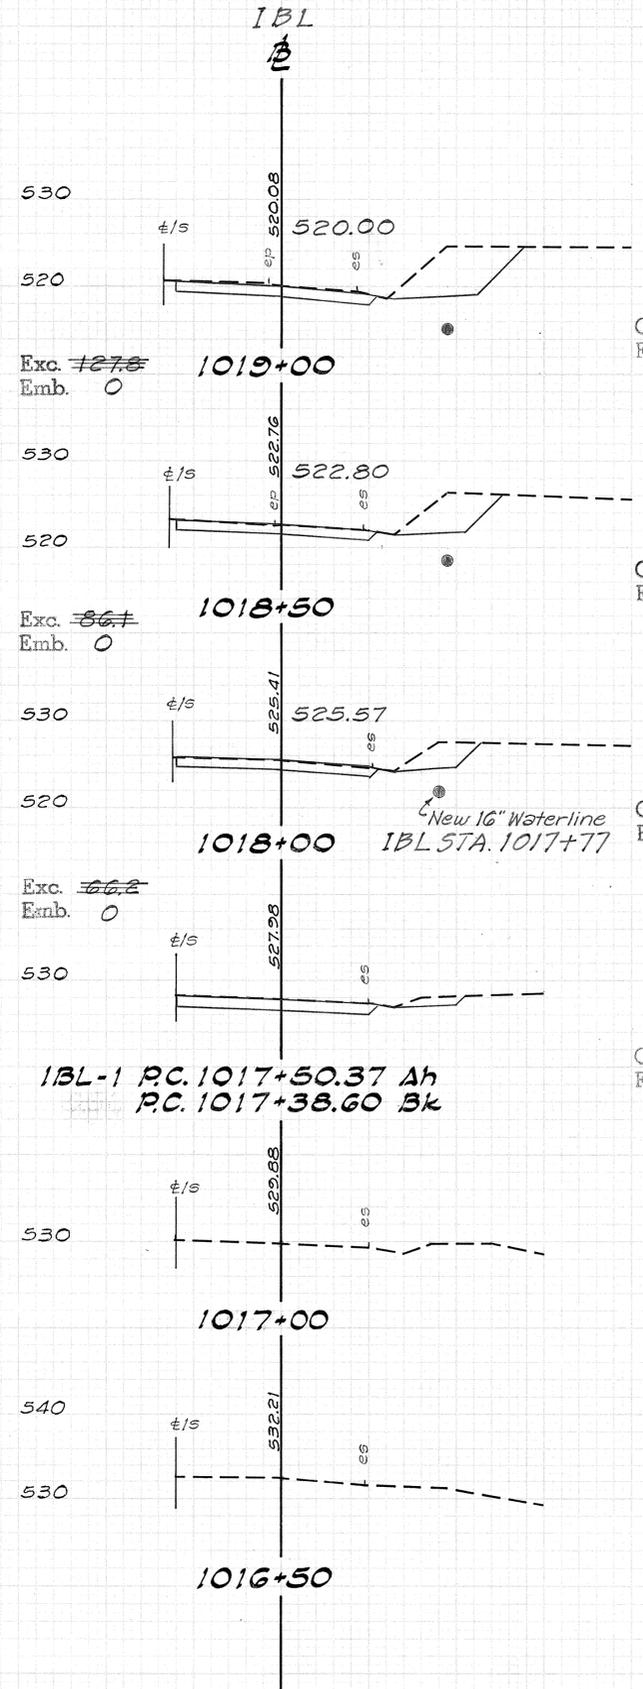
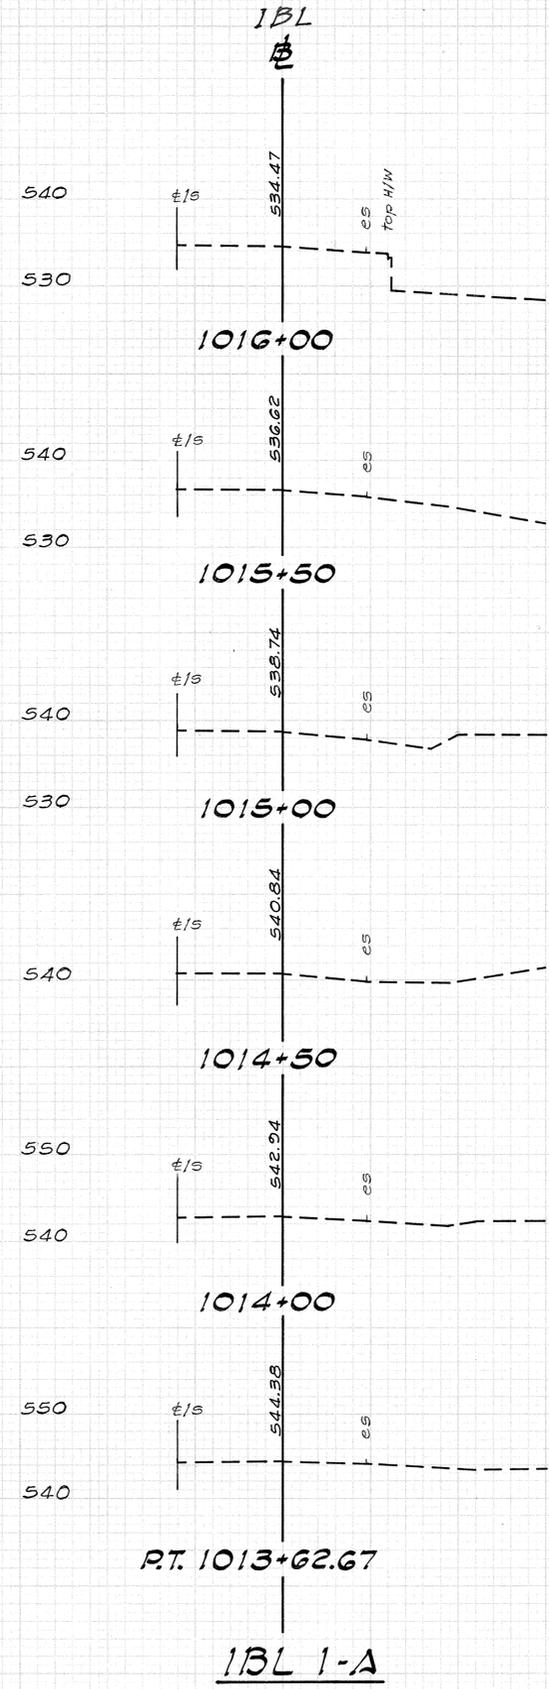


C.O.113 S-1

FED. ROAD DIST. NO.	STATE	FED. AID PROJ. NO.	FISCAL YEAR	SHEET NO.	TOTAL SHEETS
HAWAII	HAW.	F-011-2(17)			

DATE	BY
DATE	BY
DATE	BY


DATE	BY
Apr. 86	
DATE	BY
DATE	BY

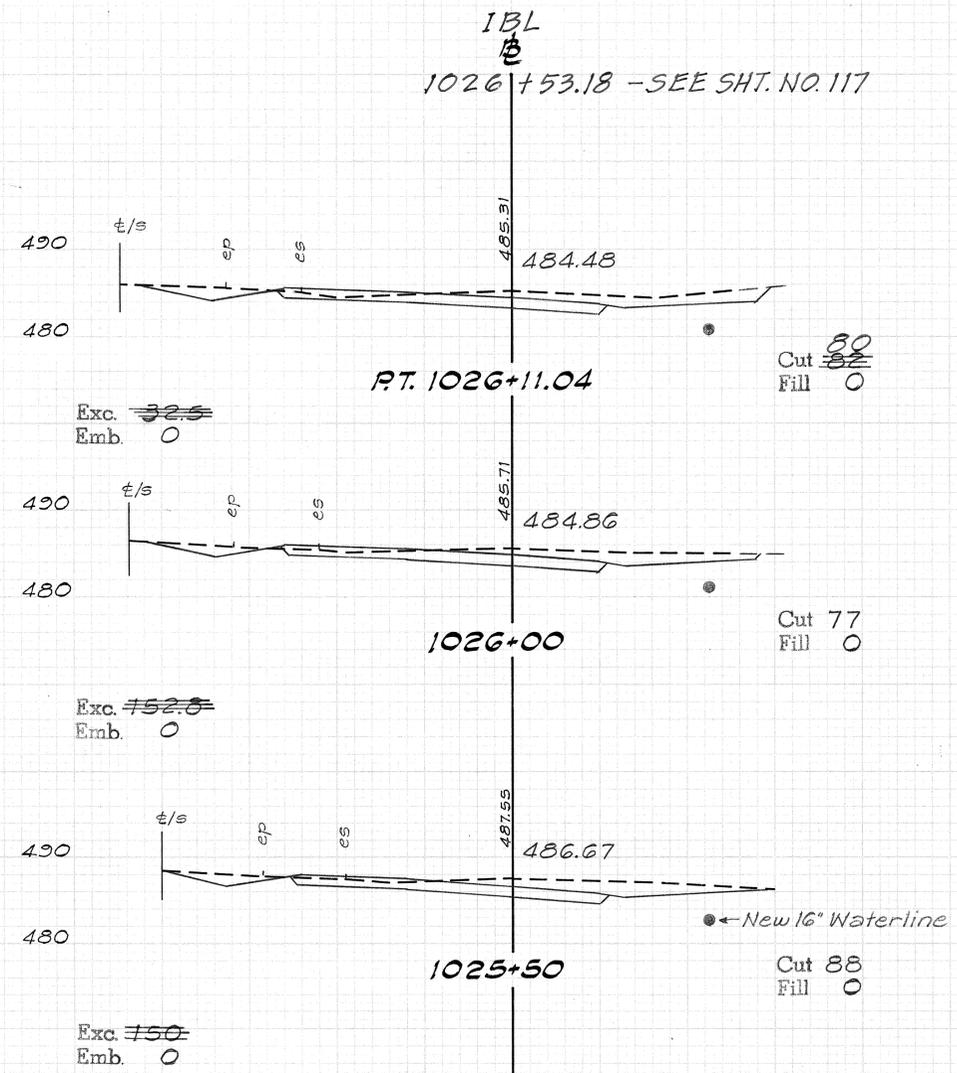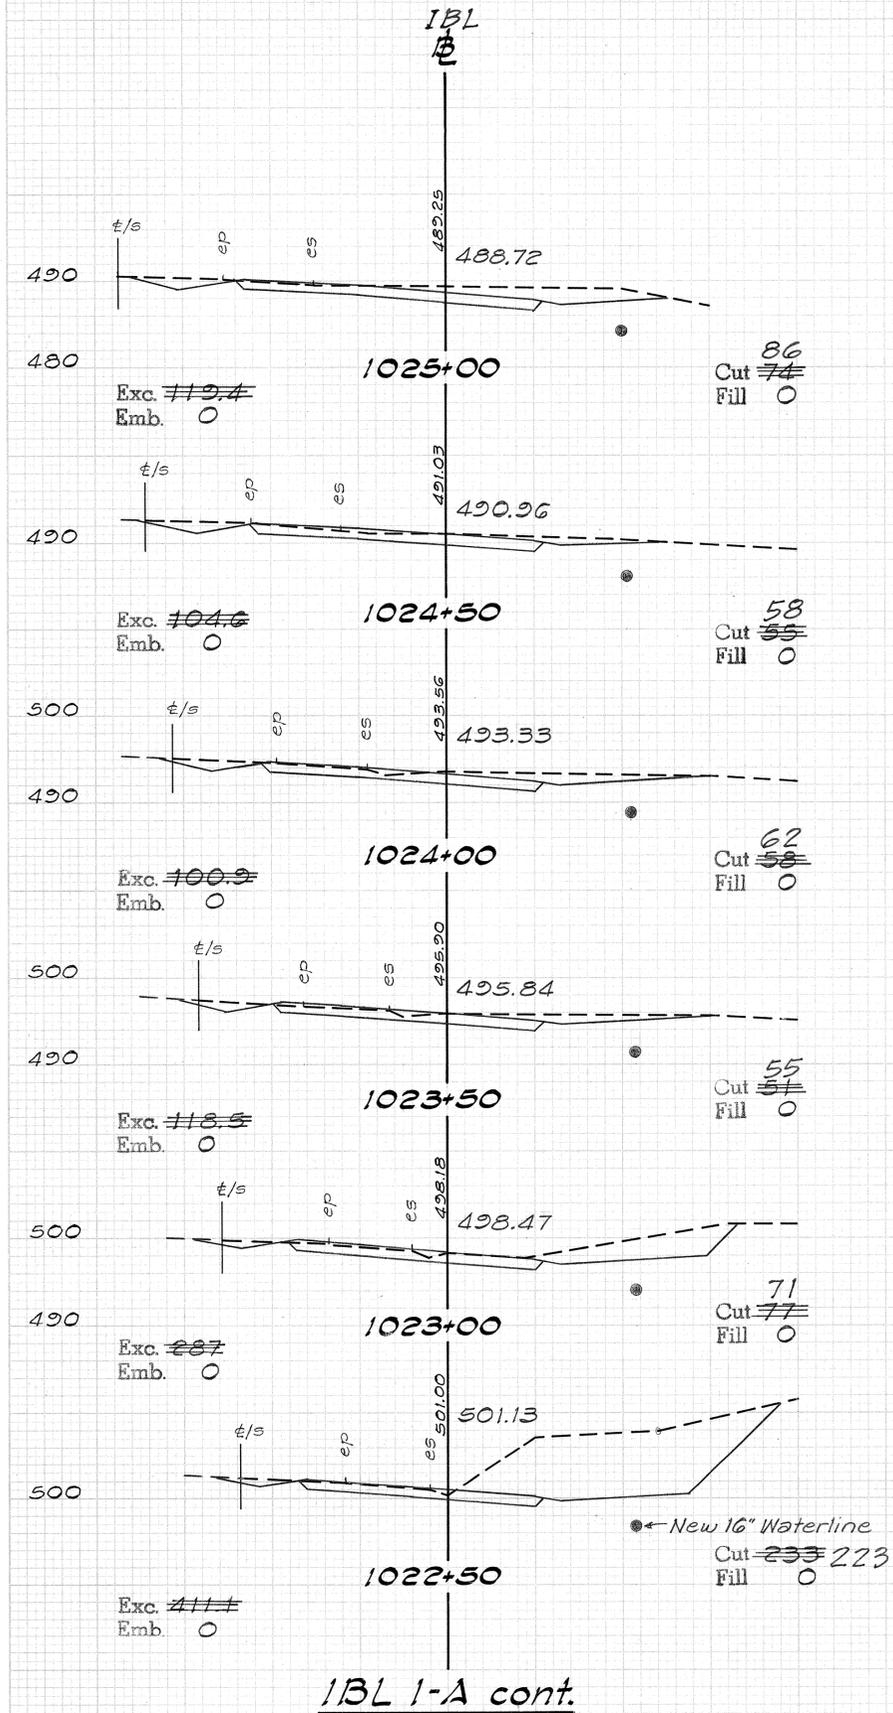

FED. ROAD DIST. NO.	STATE	FED. AID PROJ. NO.	FISCAL YEAR	SHEET NO.	TOTAL SHEETS
HAWAII	HAW.	F-011-2(17)			

DATE	BY	FINAL SURVEY	REVISIONS




DATE	BY	ORIGINAL SURVEY	REVISIONS
Apr. 26			

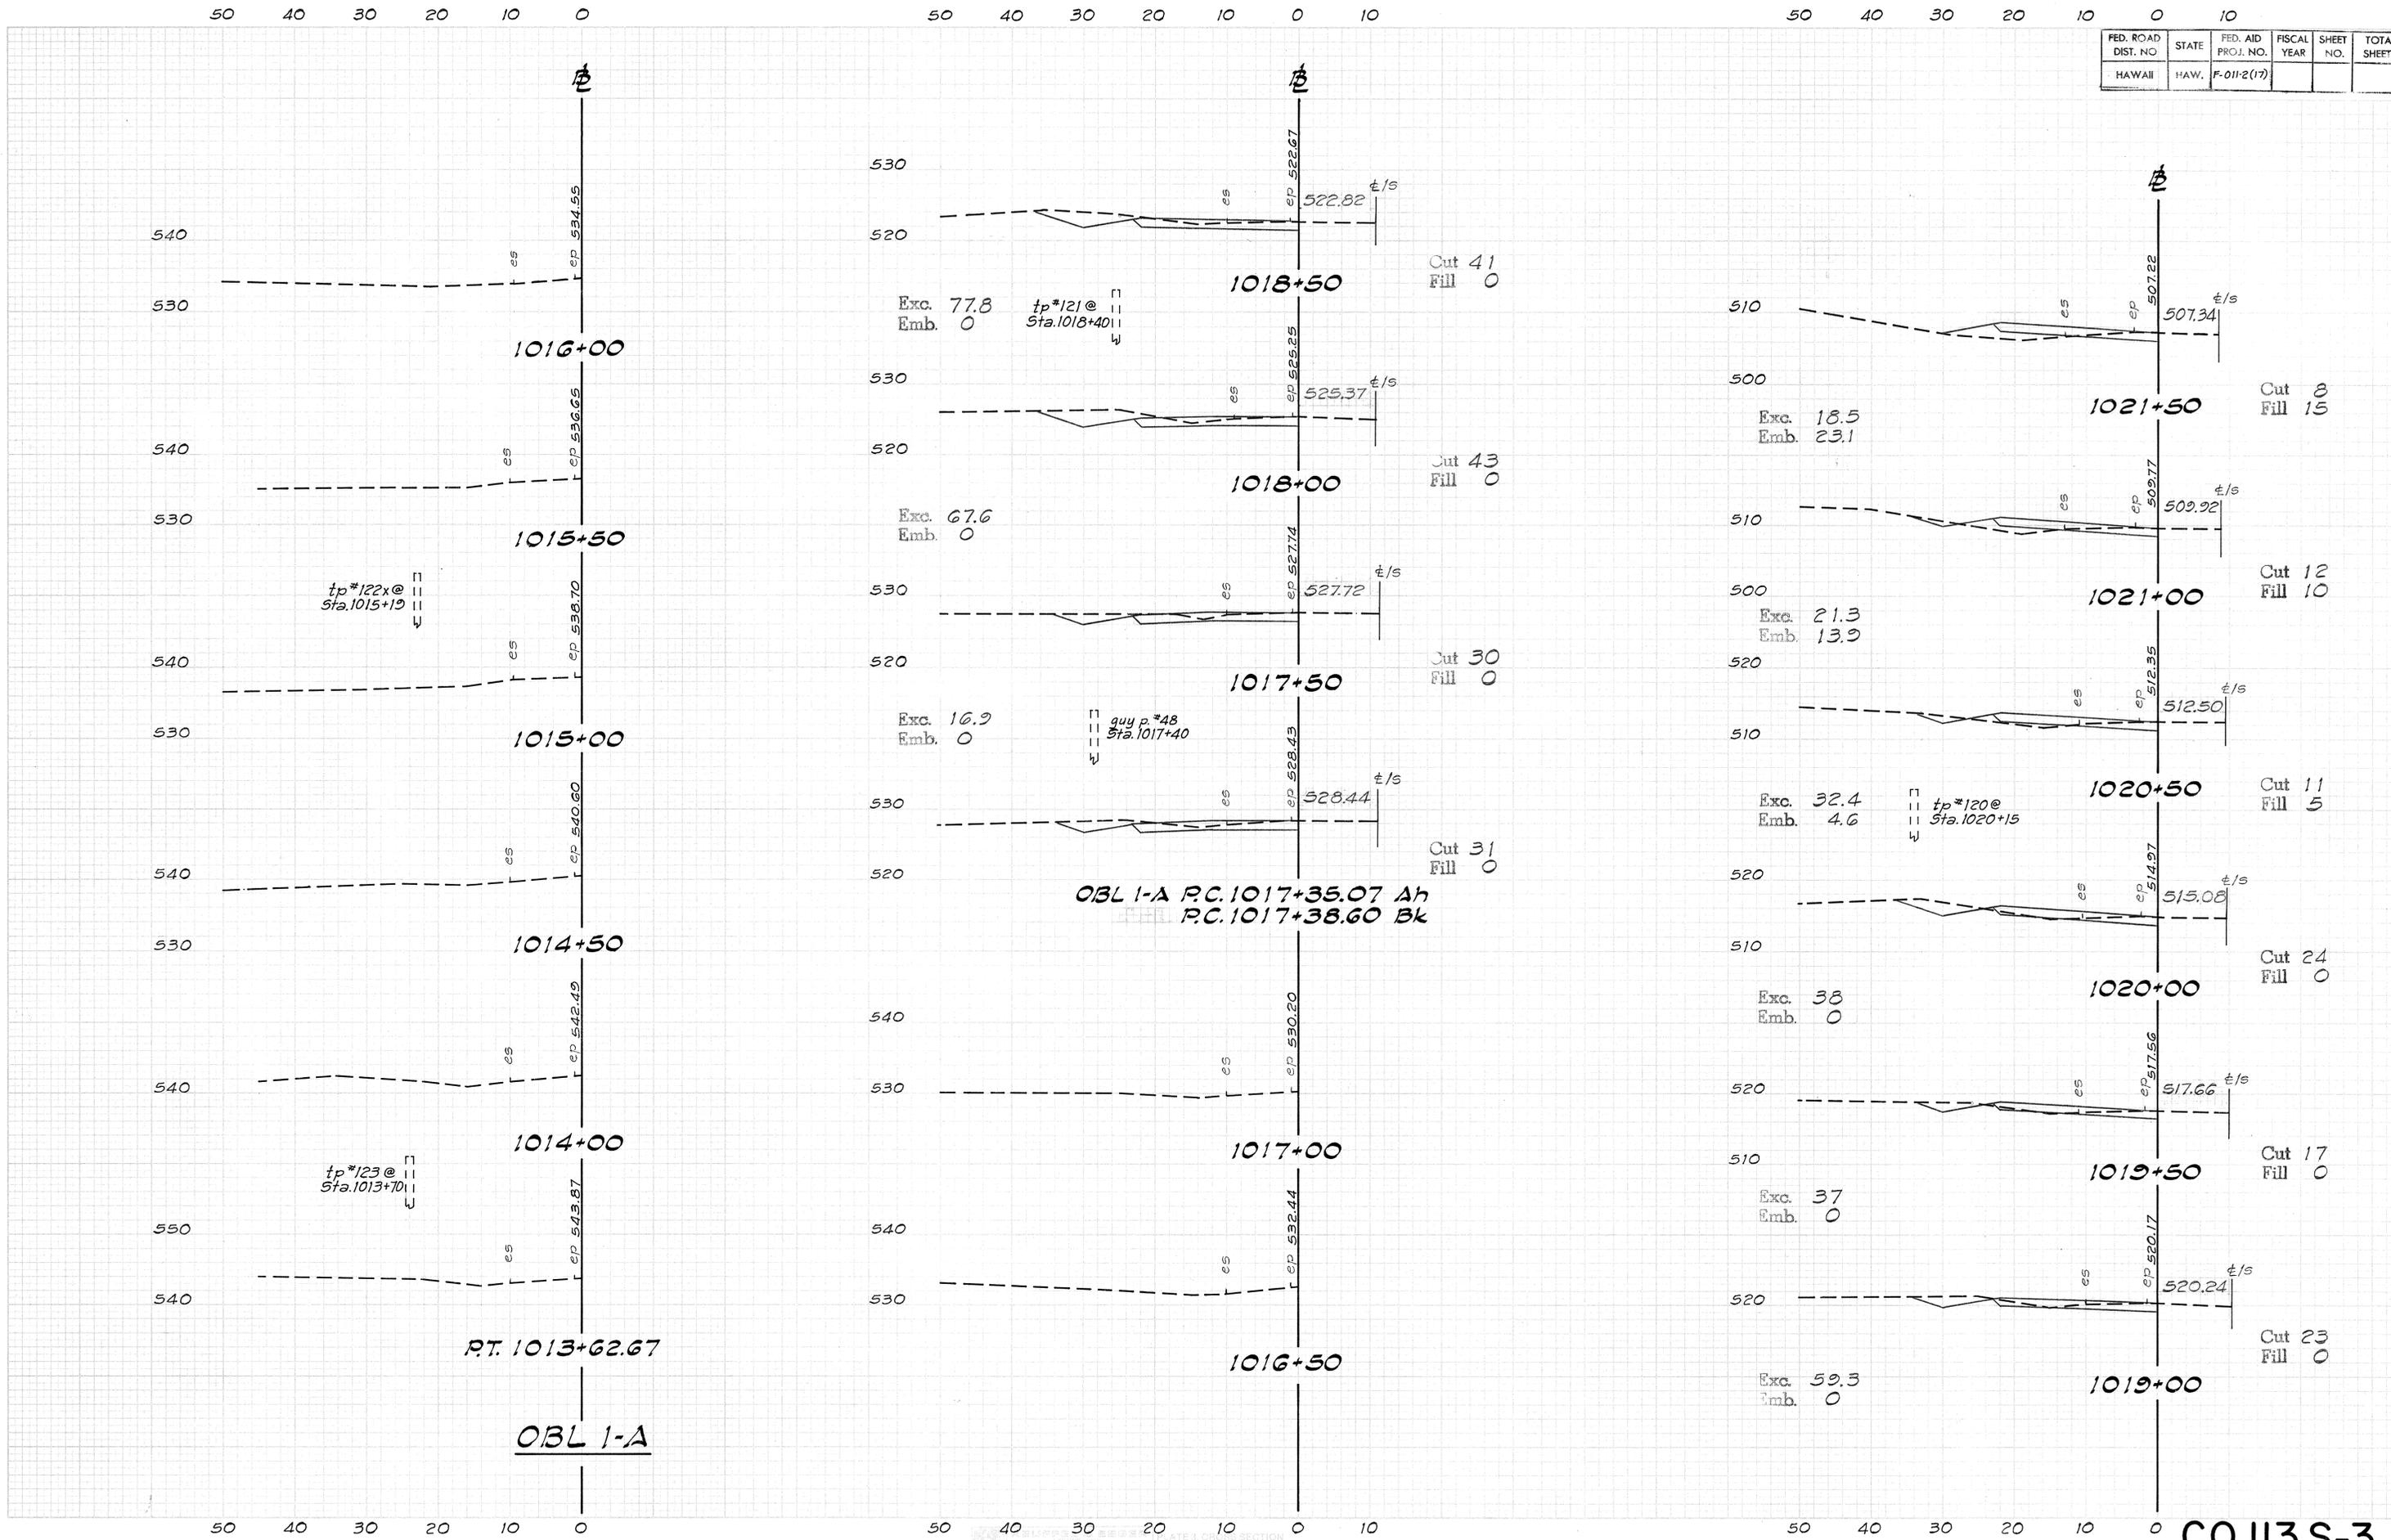

FED. ROAD DIST. NO.	STATE	FED. AID PROJ. NO.	FISCAL YEAR	SHEET NO.	TOTAL SHEETS
HAWAII	HAW.	F-011-2(17)			

DATE	BY
DATE	BY
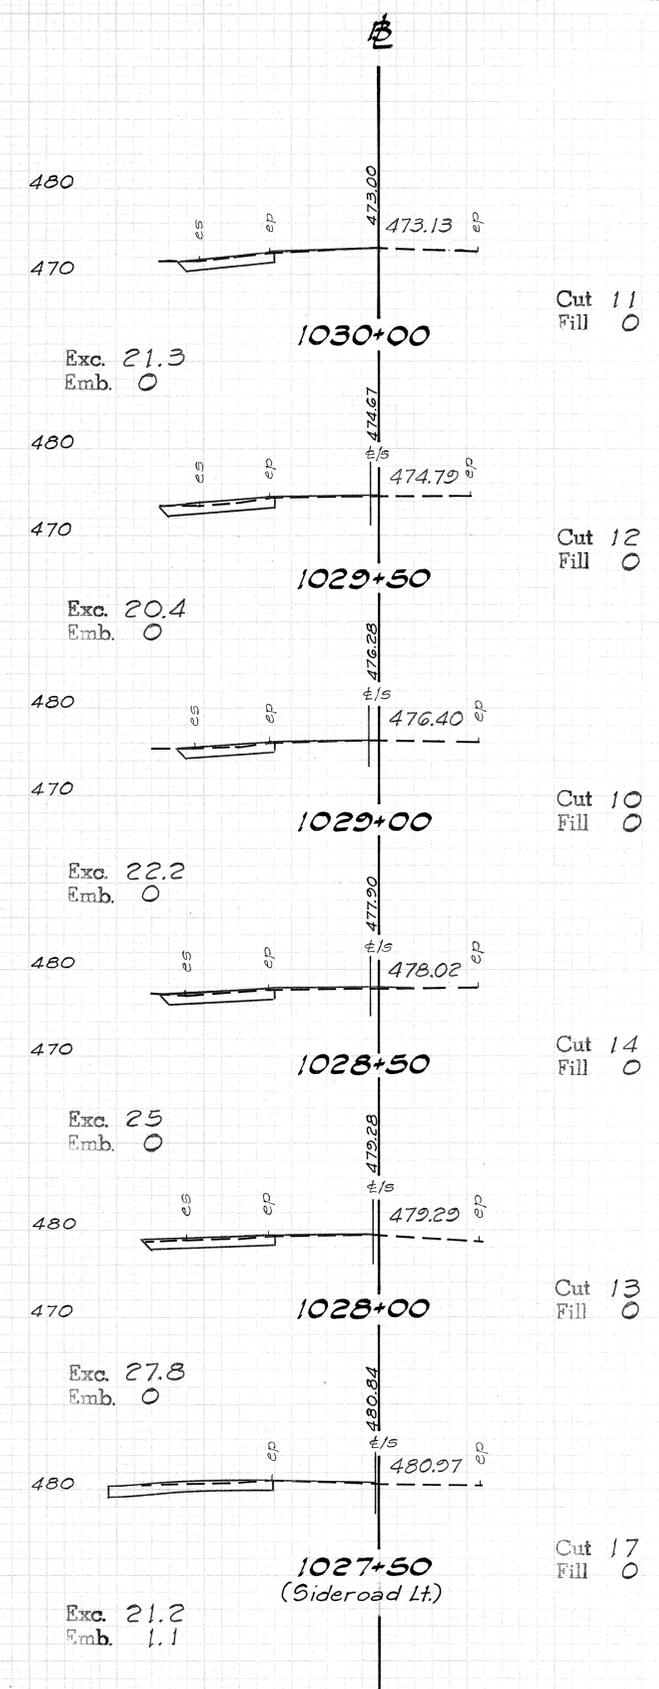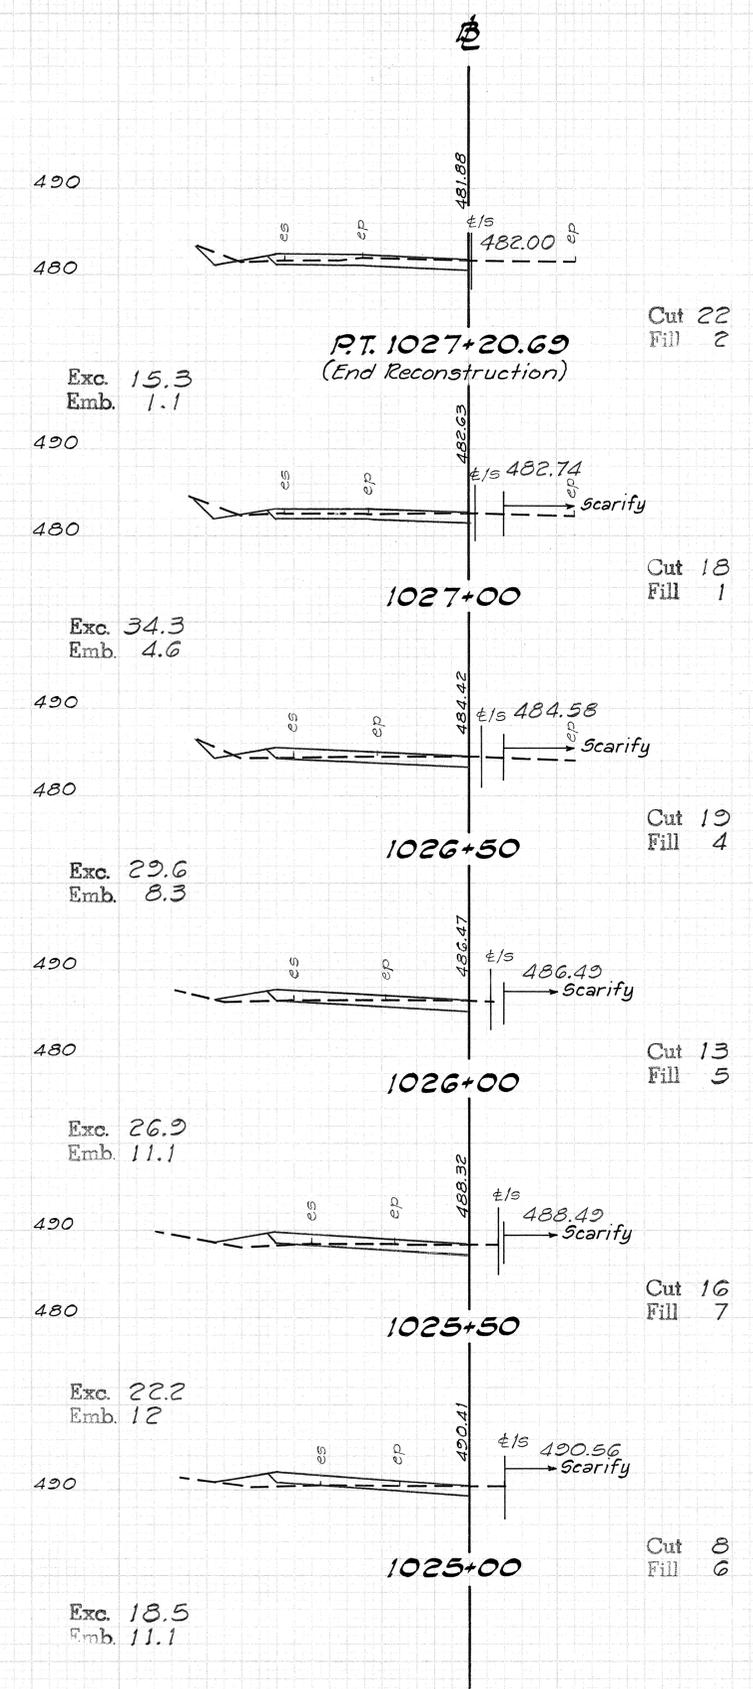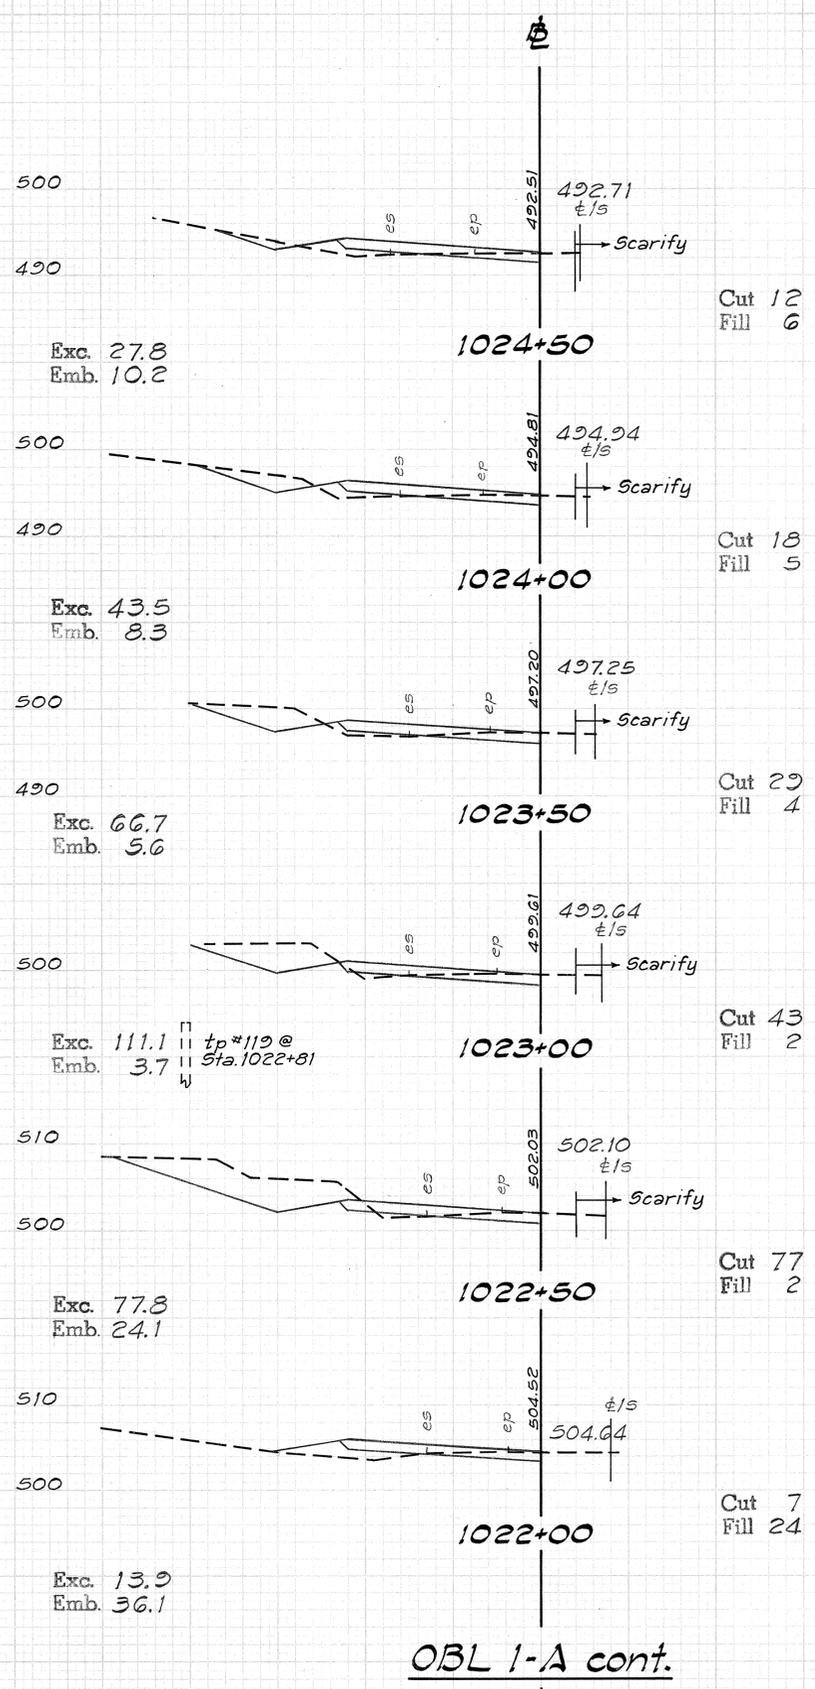

FED. ROAD DIST. NO.	STATE	PROJ. NO.	FISCAL YEAR	SHEET NO.	TOTAL SHEETS
HAWAII	HAW.	F011-2(17)	1986	114	142

BY: _____ DATE: _____
 SURVEYED: _____
 SURVEY: _____
 NOTE BOOK: _____
 TEMPLATE: _____
 AREAS CHECKED: _____

BY: _____ DATE: _____
 SURVEYED: _____
 SURVEY: _____
 NOTE BOOK: _____
 TEMPLATE: _____
 AREAS CHECKED: _____

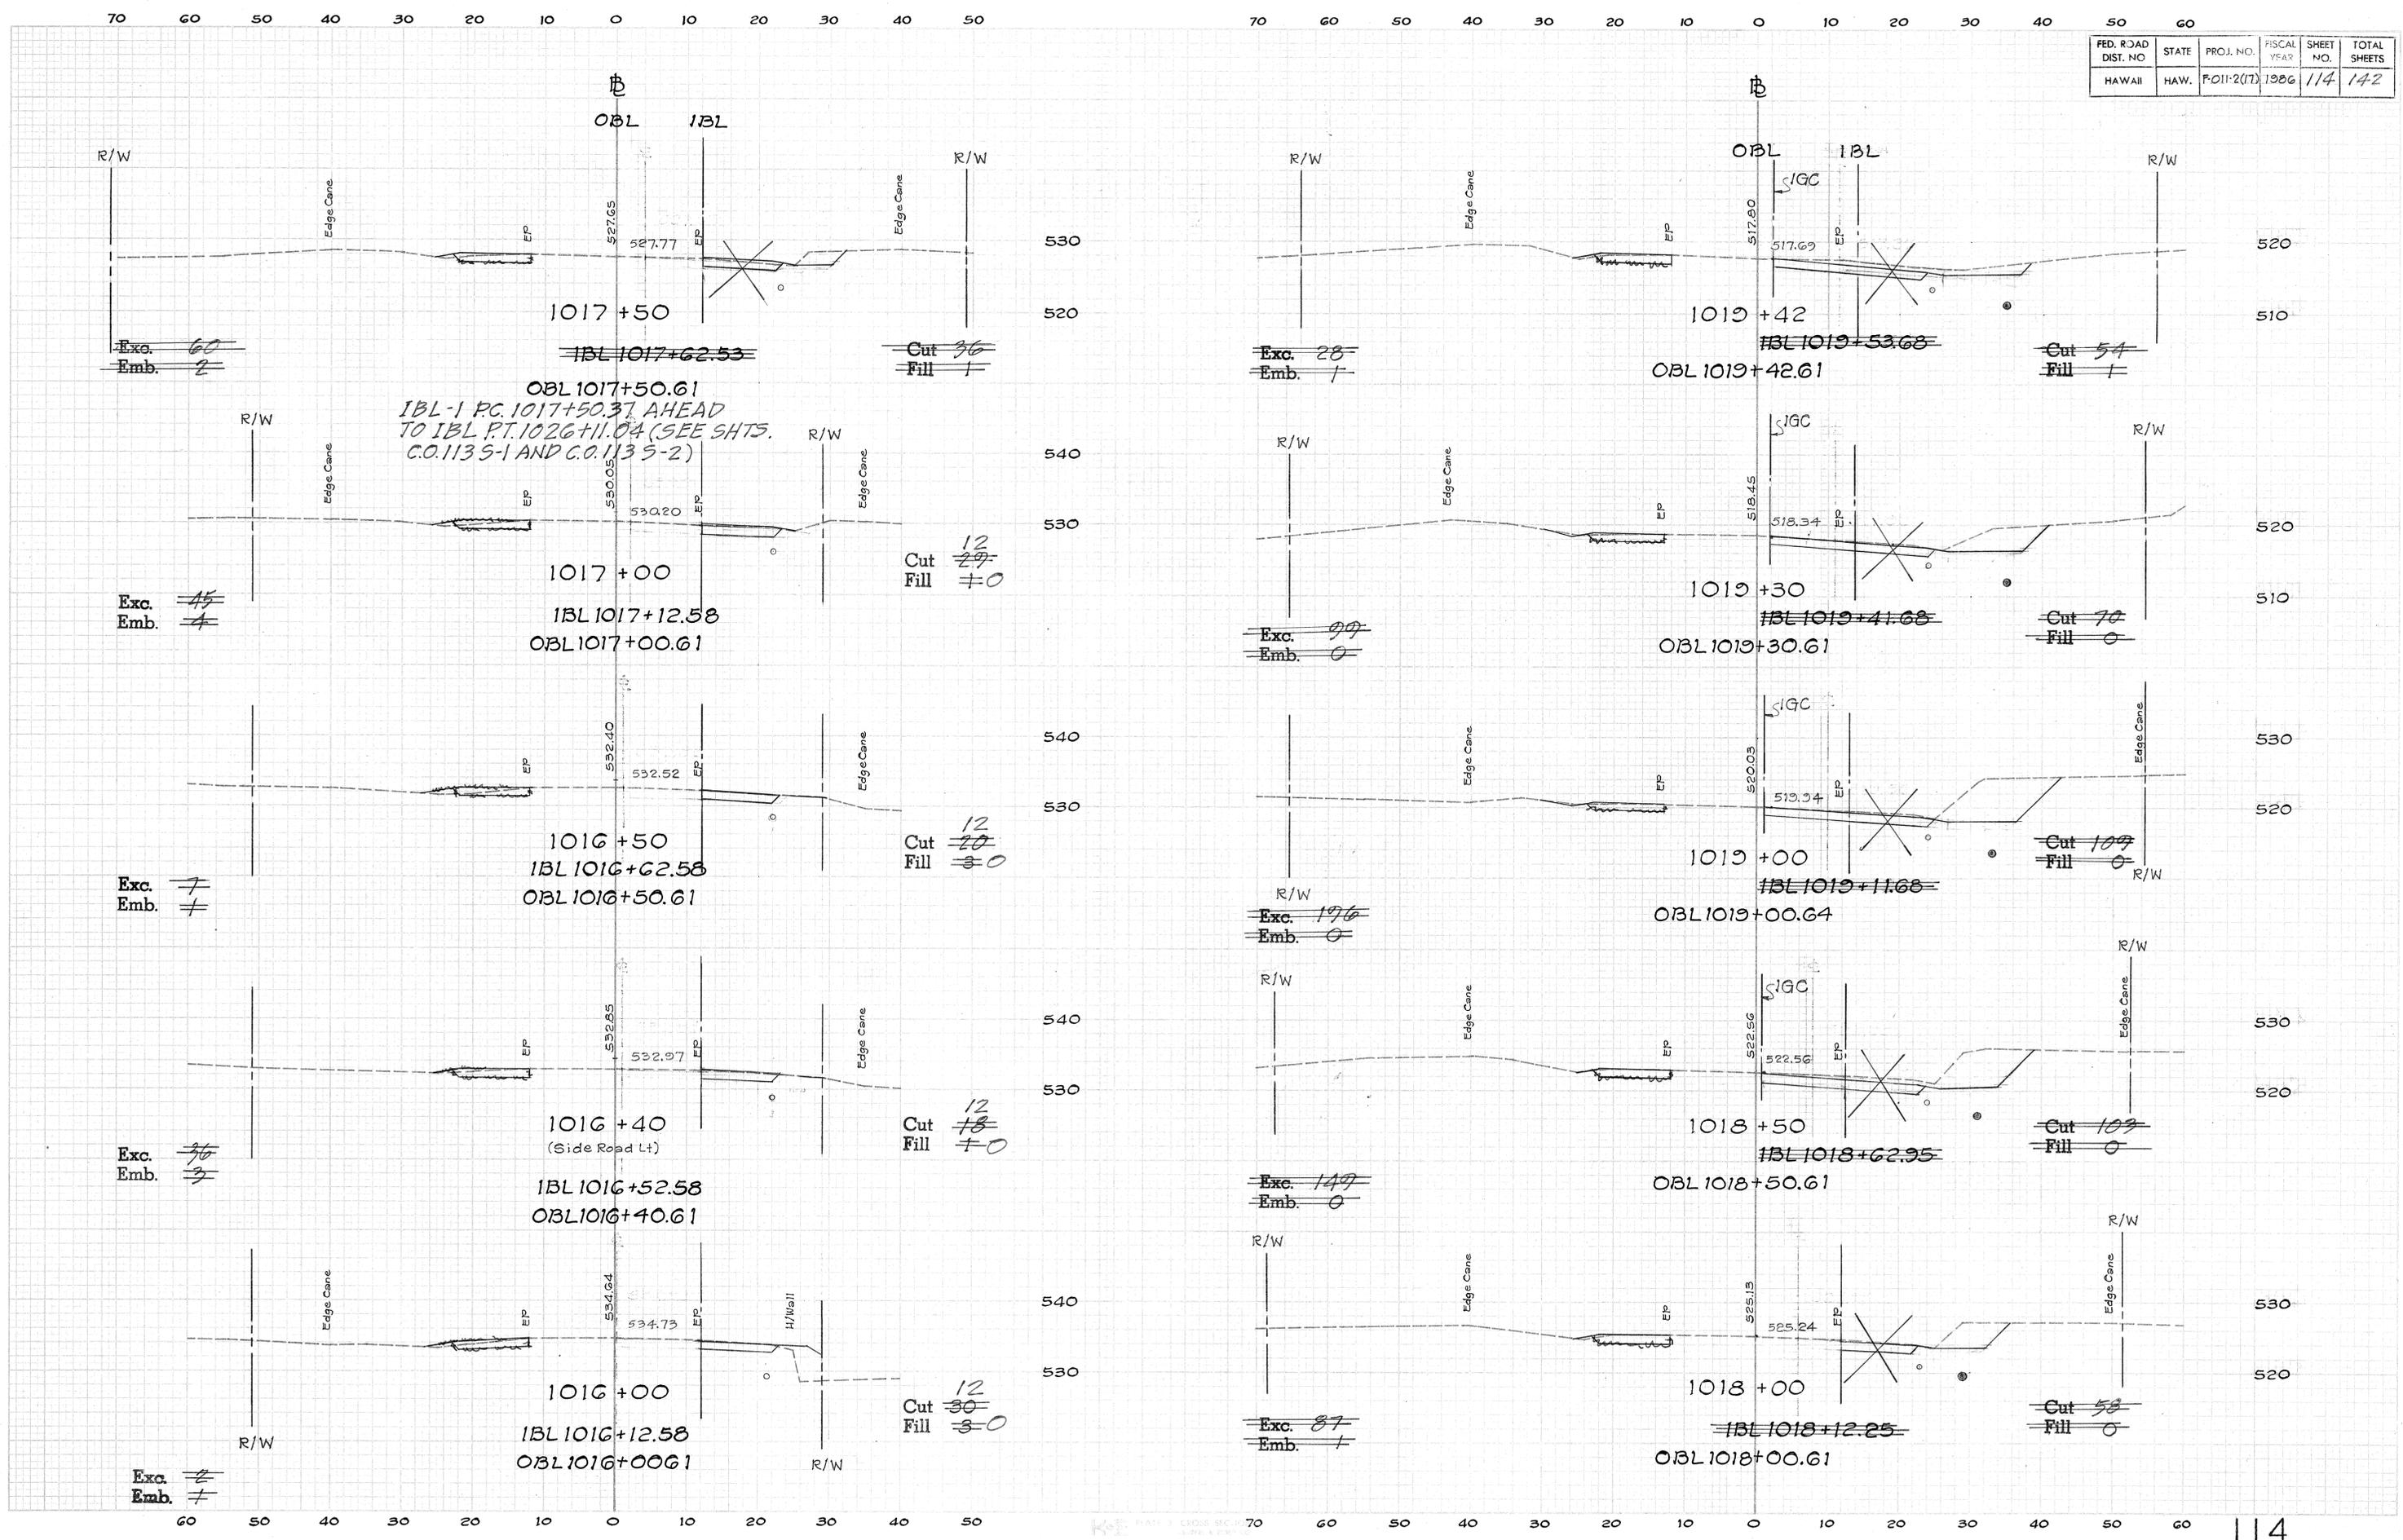



FED. ROAD DIST. NO.	STATE	PROJ. NO.	FISCAL YEAR	SHEET NO.	TOTAL SHEETS
HAWAII	HAW.	F-011-2(17)	1986	115	142

DATE	BY

FINAL SURVEY PLOTTED
NOTE BOOK TEMPLATE
NO. 115-57

DATE	BY









ORIGINAL SURVEY PLOTTED
NOTE BOOK TEMPLATE
NO. 115-57

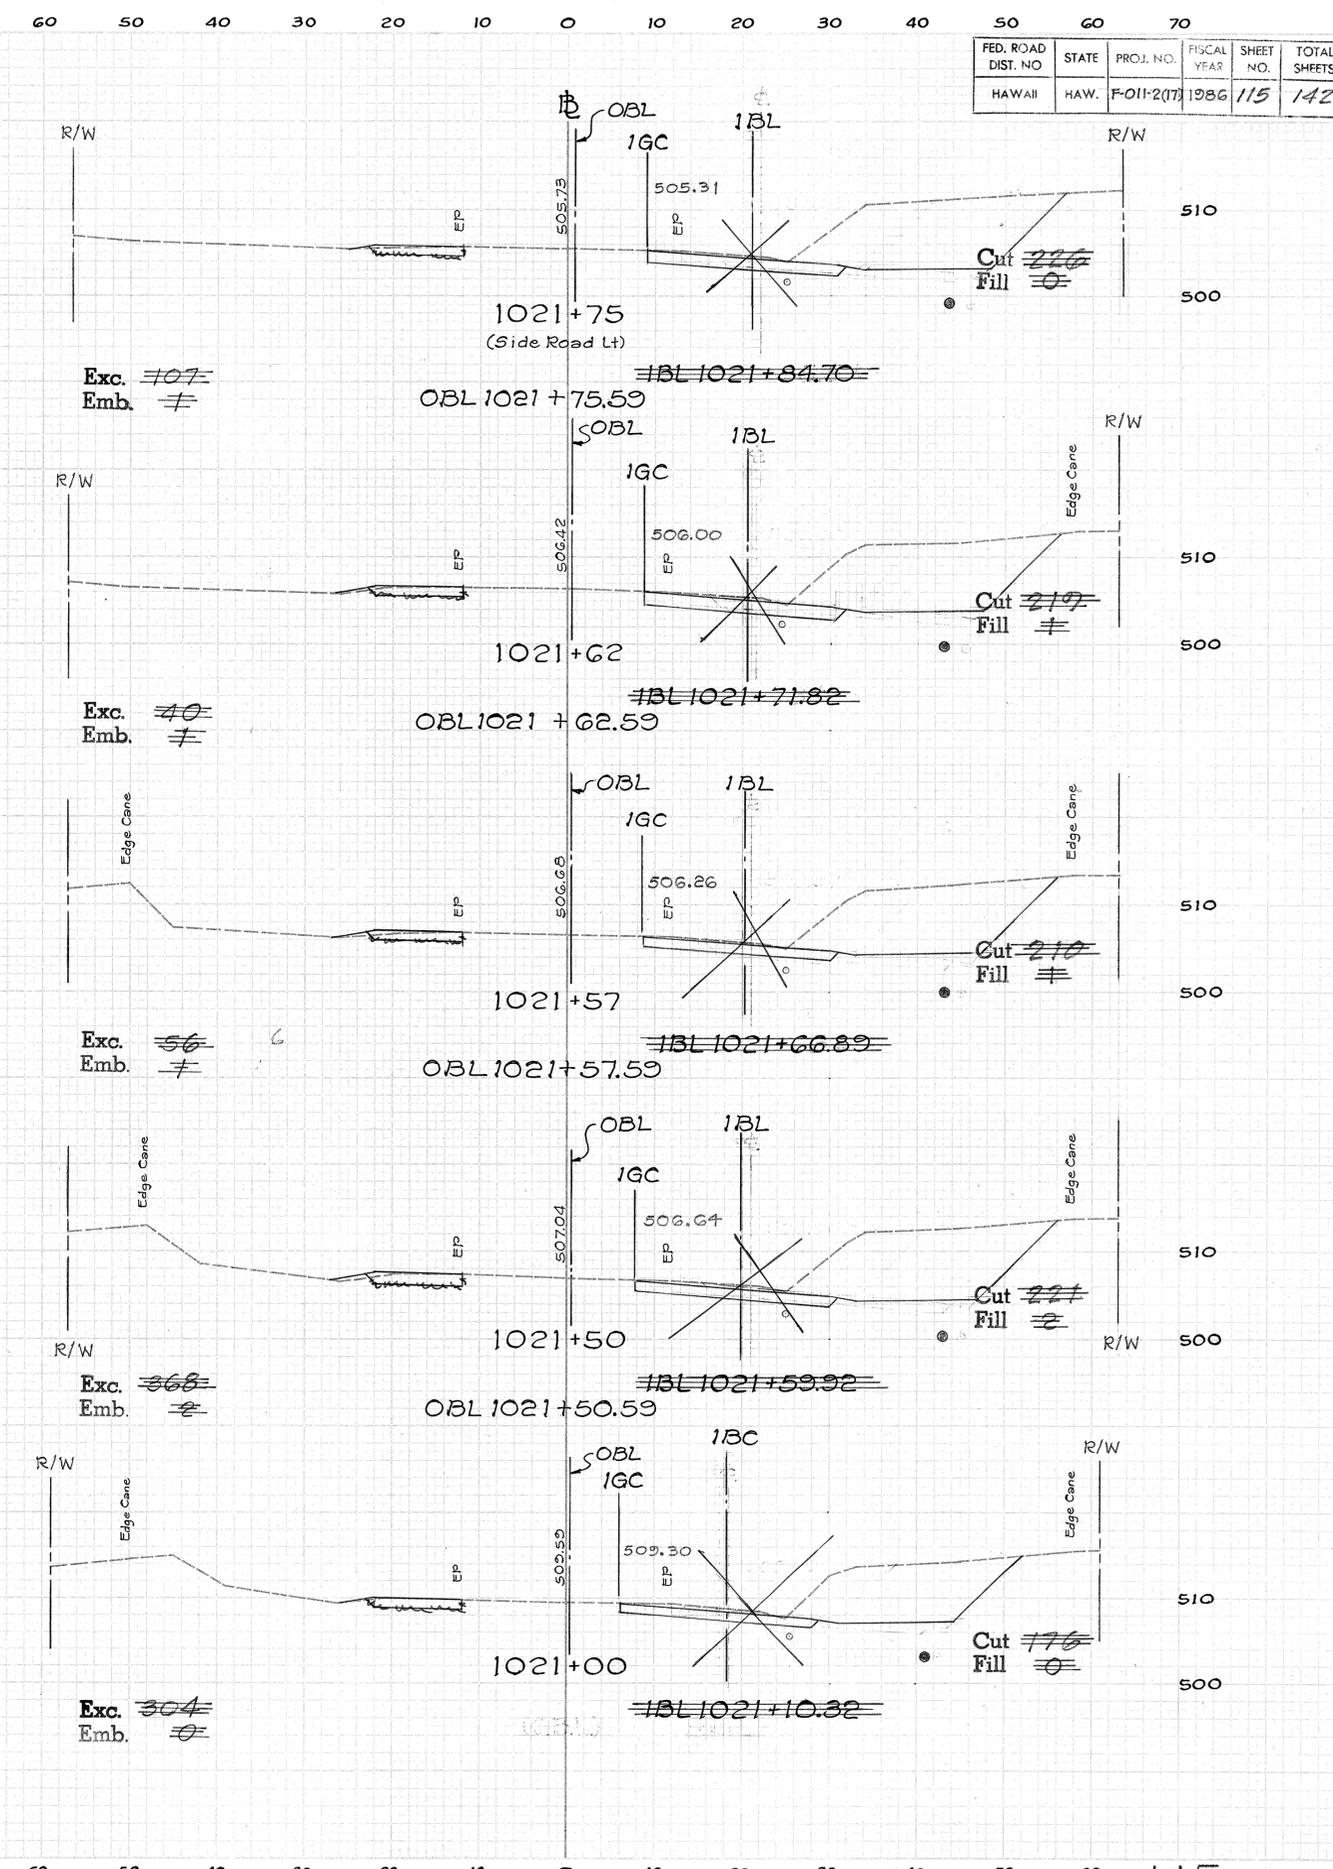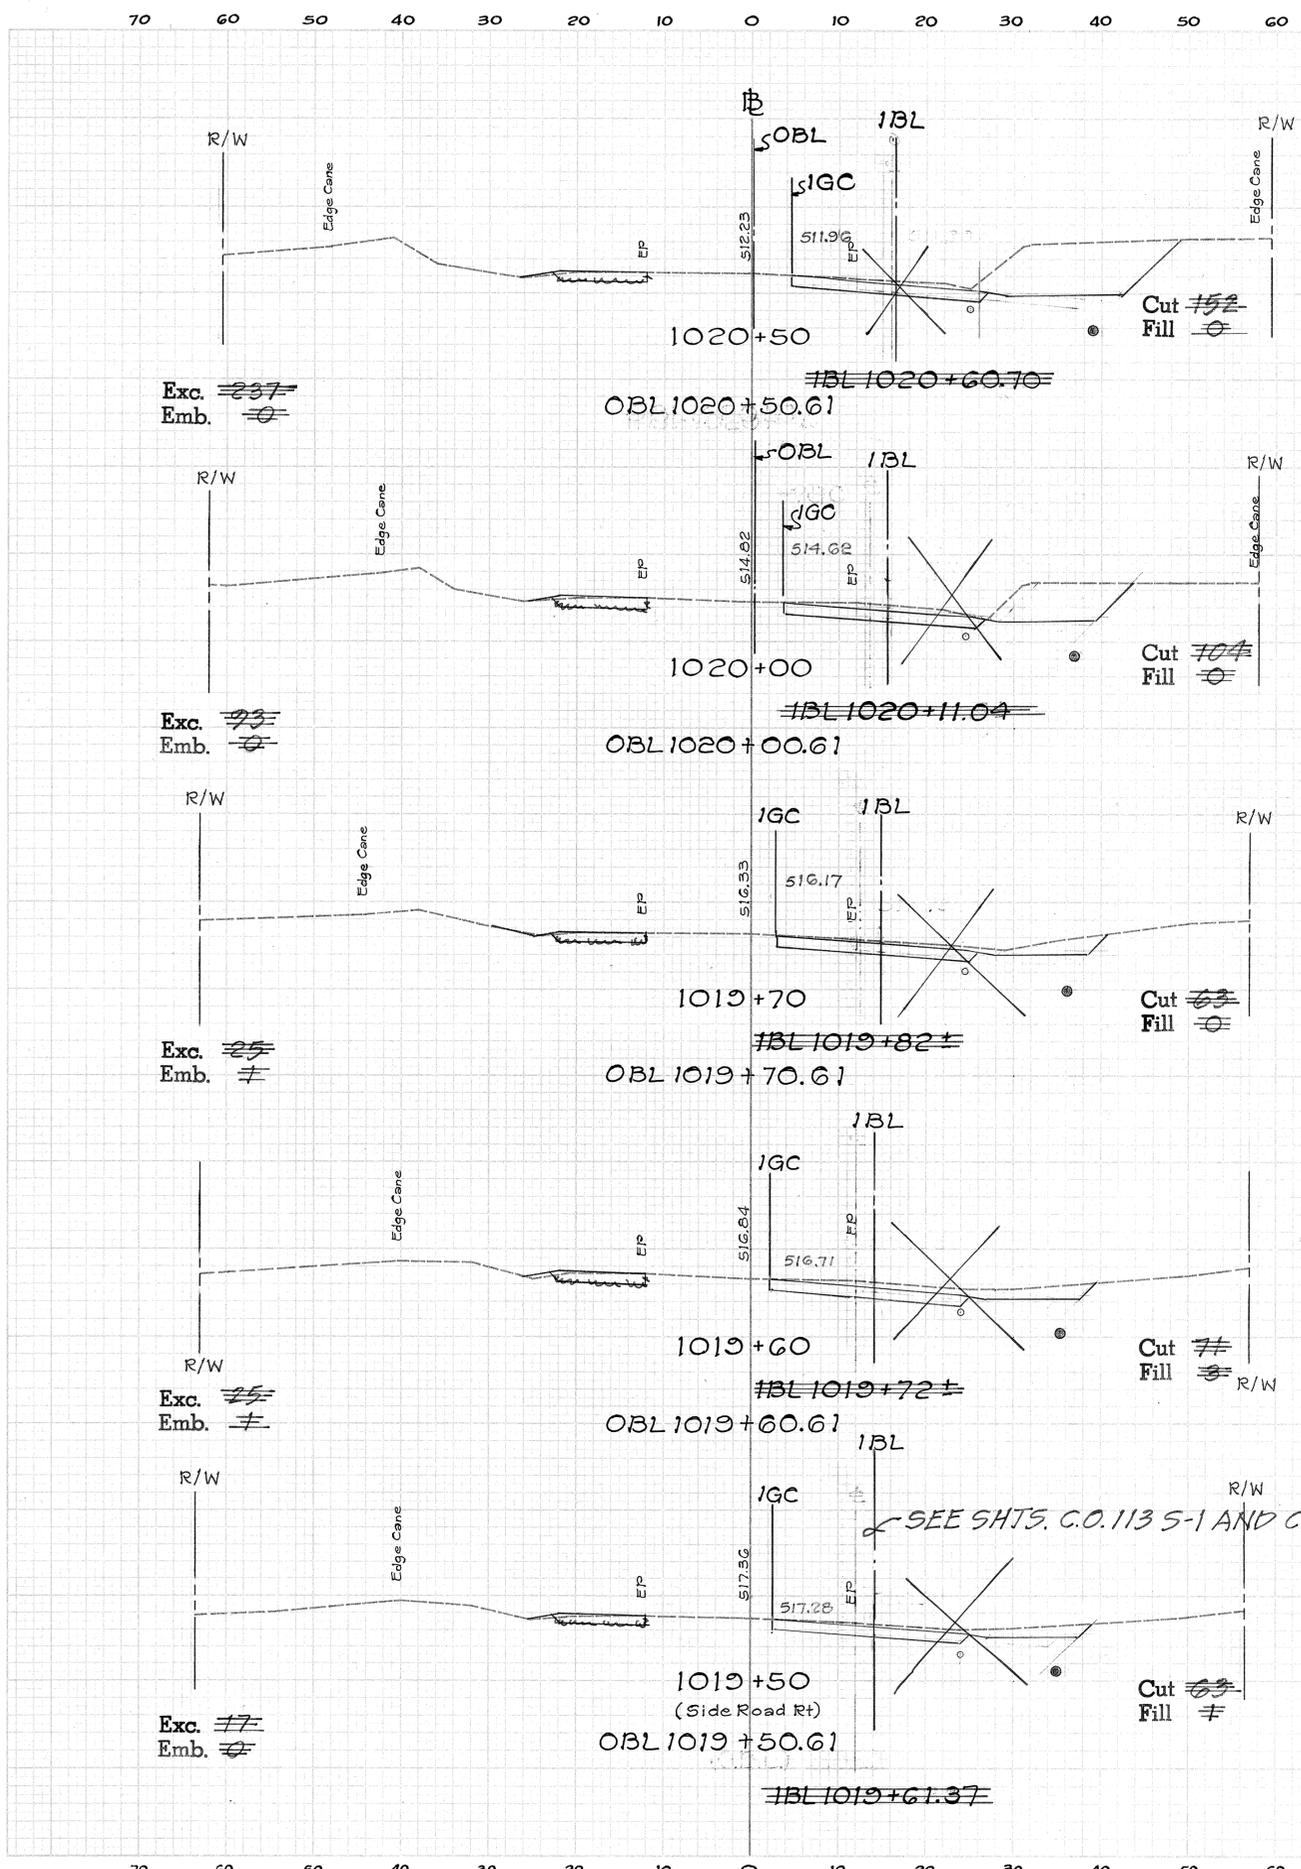

60 50 40 30 20 10 0 10 20 30 40 50 60 70

60 50 40 30 20 10 0 10 20 30 40 50 60 70

FED. ROAD DIST. NO.	STATE	PROJ. NO.	FISCAL YEAR	SHEET NO.	TOTAL SHEETS
HAWAII	HAW.	F-011-2(17)	1986	116	142

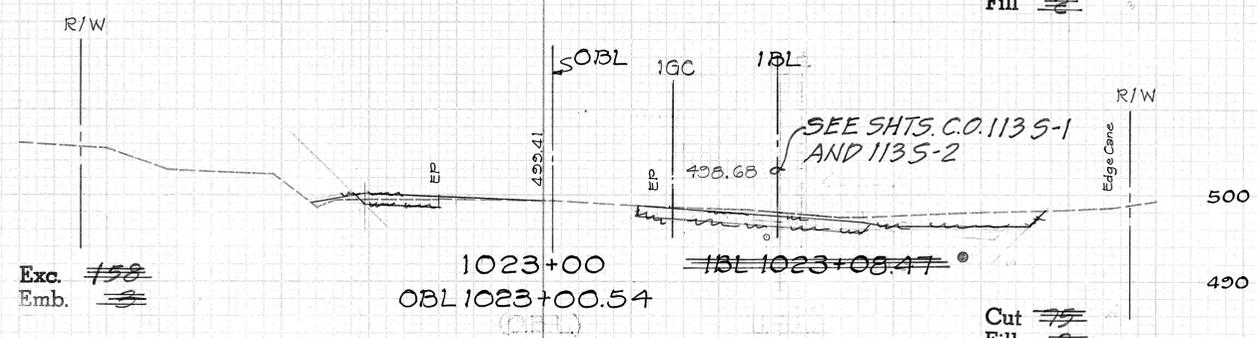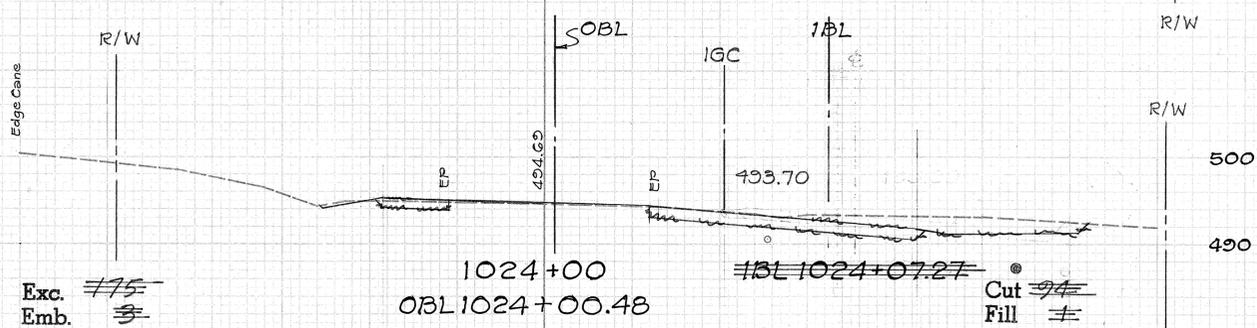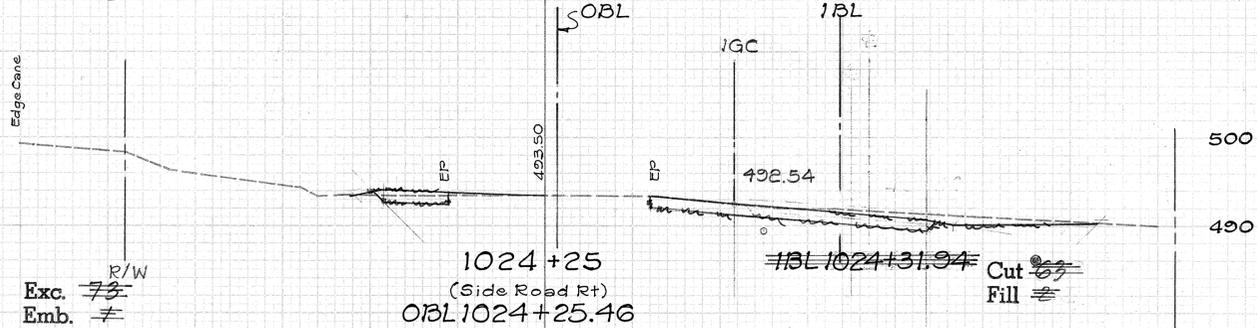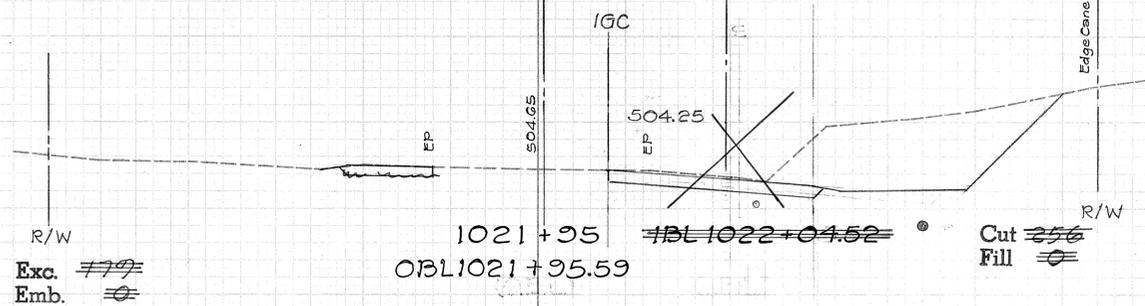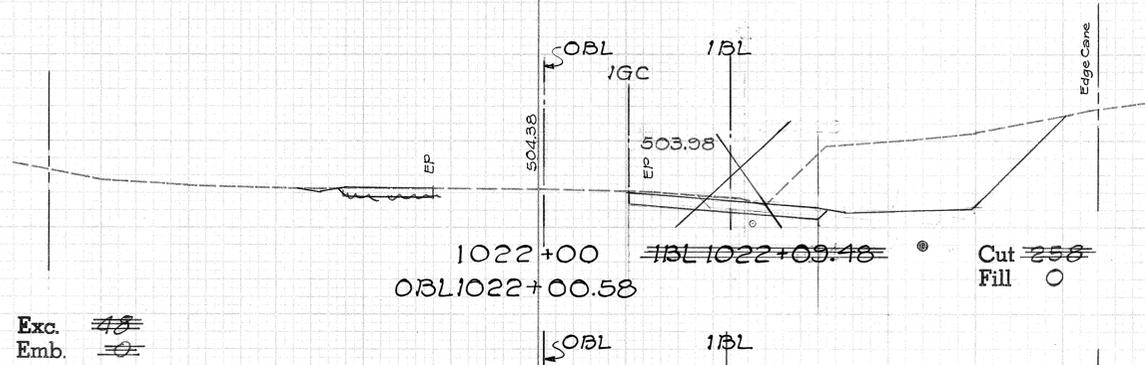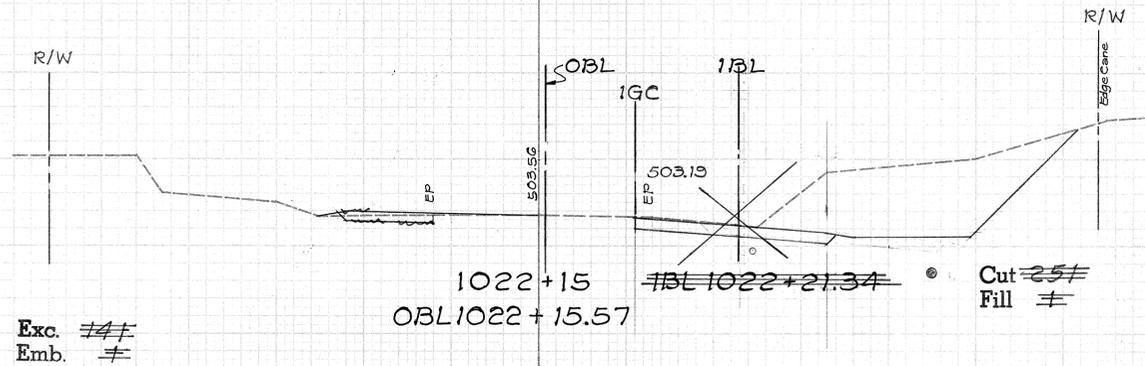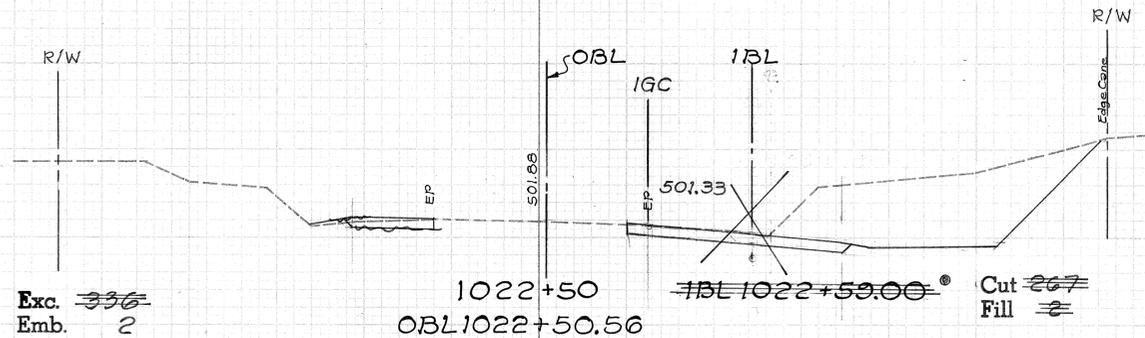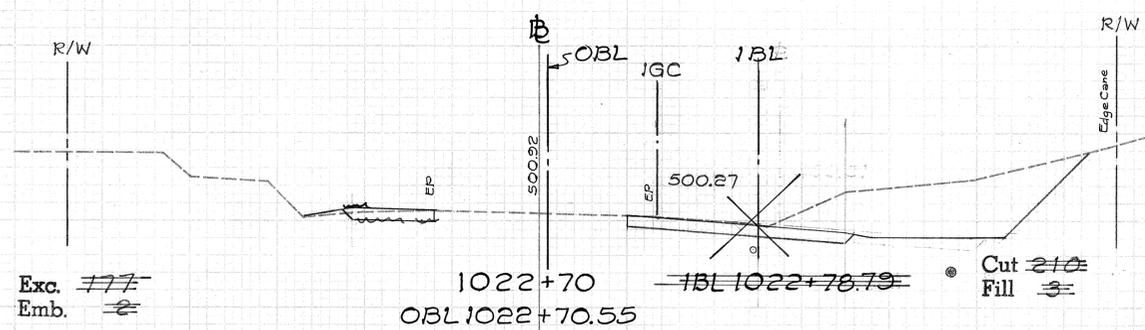

60 50 40 30 20 10 0 10 20 30 40 50 60 70

60 50 40 30 20 10 0 10 20 30 40 50 60 70

DATE: _____
 BY: _____
 CHECKED: _____
 ORIGINAL SURVEY: _____
 SURVEY: _____
 EMBANKMENT: _____
 EXCAVATION: _____
 AREAS: _____
 AREAS CHECKED: _____
 DATE: 11/5/59

DATE: _____
 BY: _____
 CHECKED: _____
 ORIGINAL SURVEY: _____
 SURVEY: _____
 EMBANKMENT: _____
 EXCAVATION: _____
 AREAS: _____
 AREAS CHECKED: _____
 DATE: 11/5/59



50 40 30 20 10 0 10 20 30 40 50 60 70

40 30 20 10 0 10 20 30 40 50 60 70


FED. ROAD DIST. NO.	STATE	PROJ. NO.	FISCAL YEAR	SHEET NO.	TOTAL SHEETS
HAWAII	HAW.	FOH-2(17)	1986	117	142

DATE: _____
 BY: _____
 SURVEYED: _____
 SURVEY: _____
 TEMPLATE: _____
 NOTE BOOK: _____
 AREAS: _____
 AREAS CHECKED: _____


DATE: _____
 BY: _____
 SURVEYED: _____
 SURVEY: _____
 TEMPLATE: _____
 NOTE BOOK: _____
 AREAS: _____
 AREAS CHECKED: _____

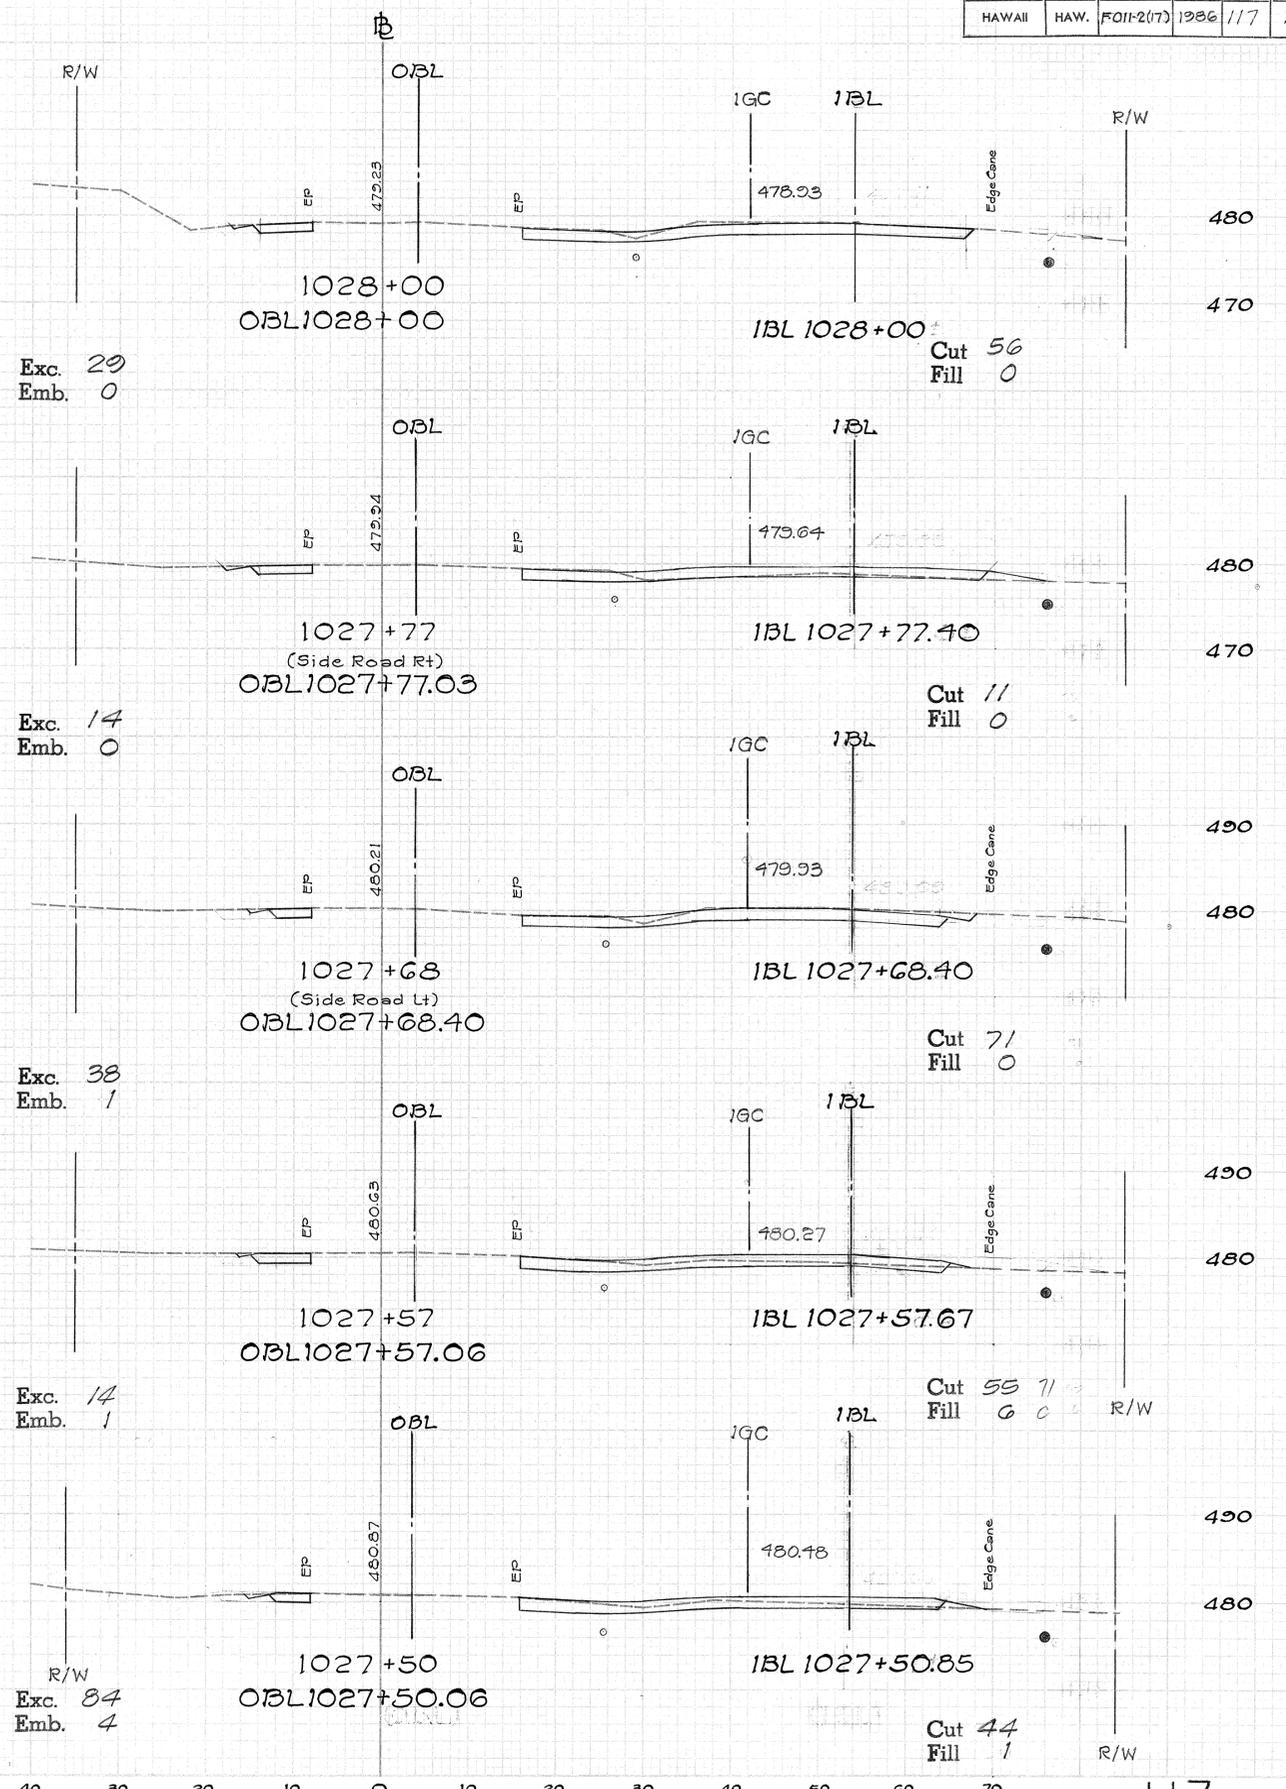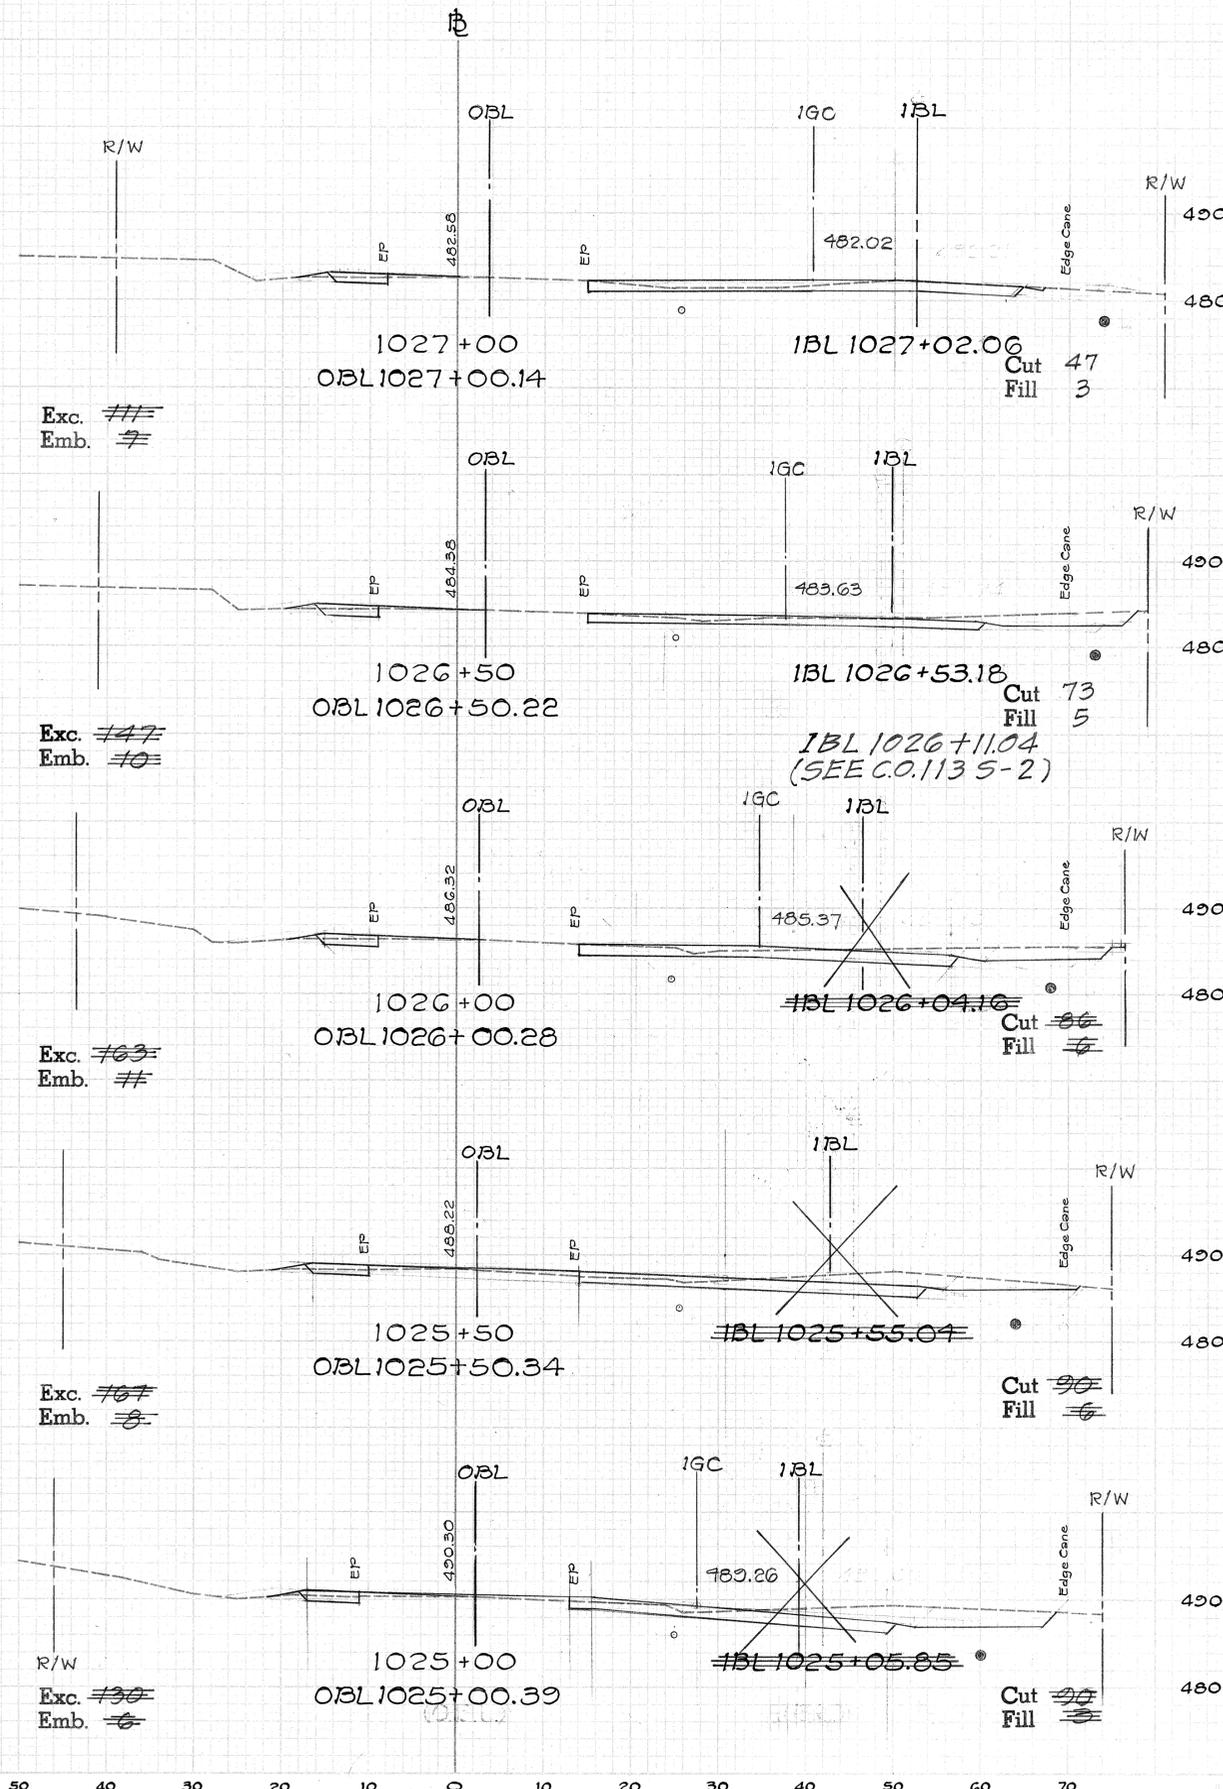

FED. ROAD DIST. NO.	STATE	PROJ. NO.	FISCAL YEAR	SHEET NO.	TOTAL SHEETS
HAWAII	HAW.	F011-2(17)	1986	118	142

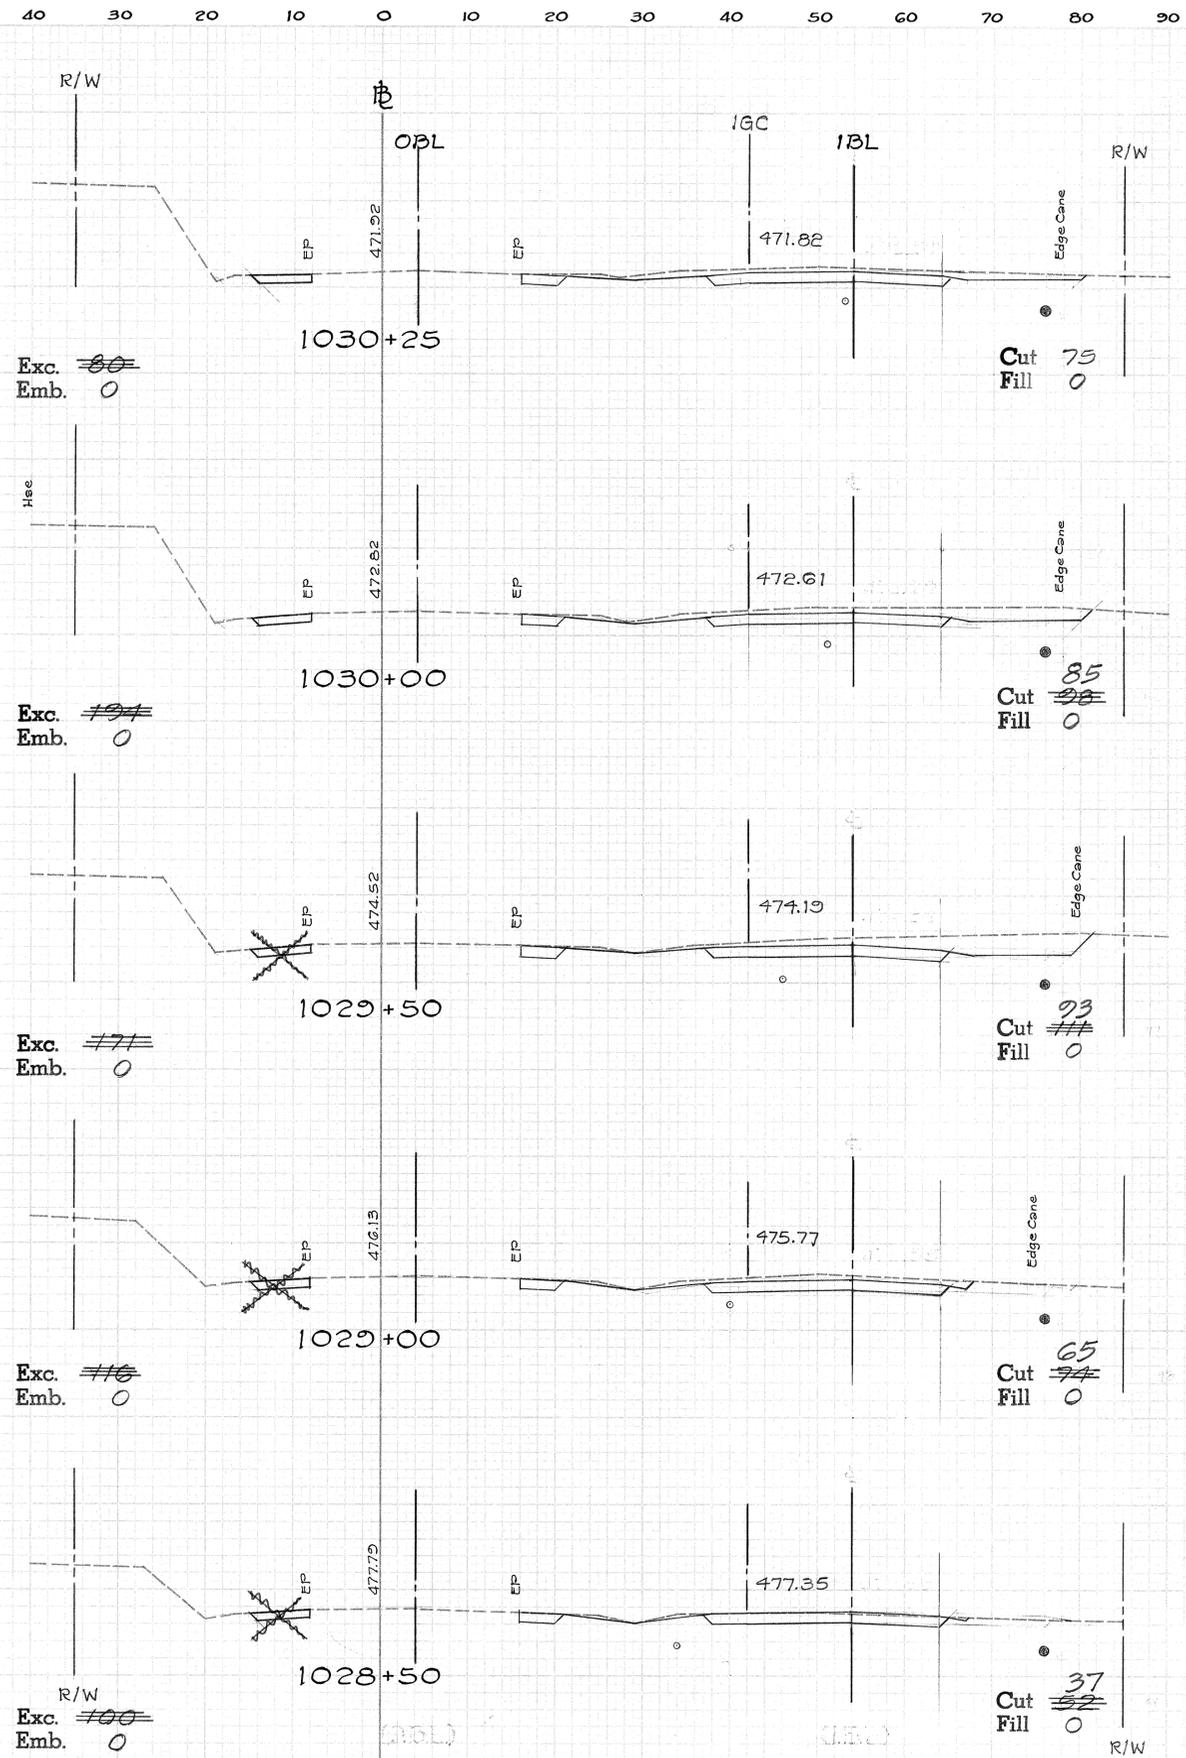

(OBL & IBL Stations = \oplus Stations)

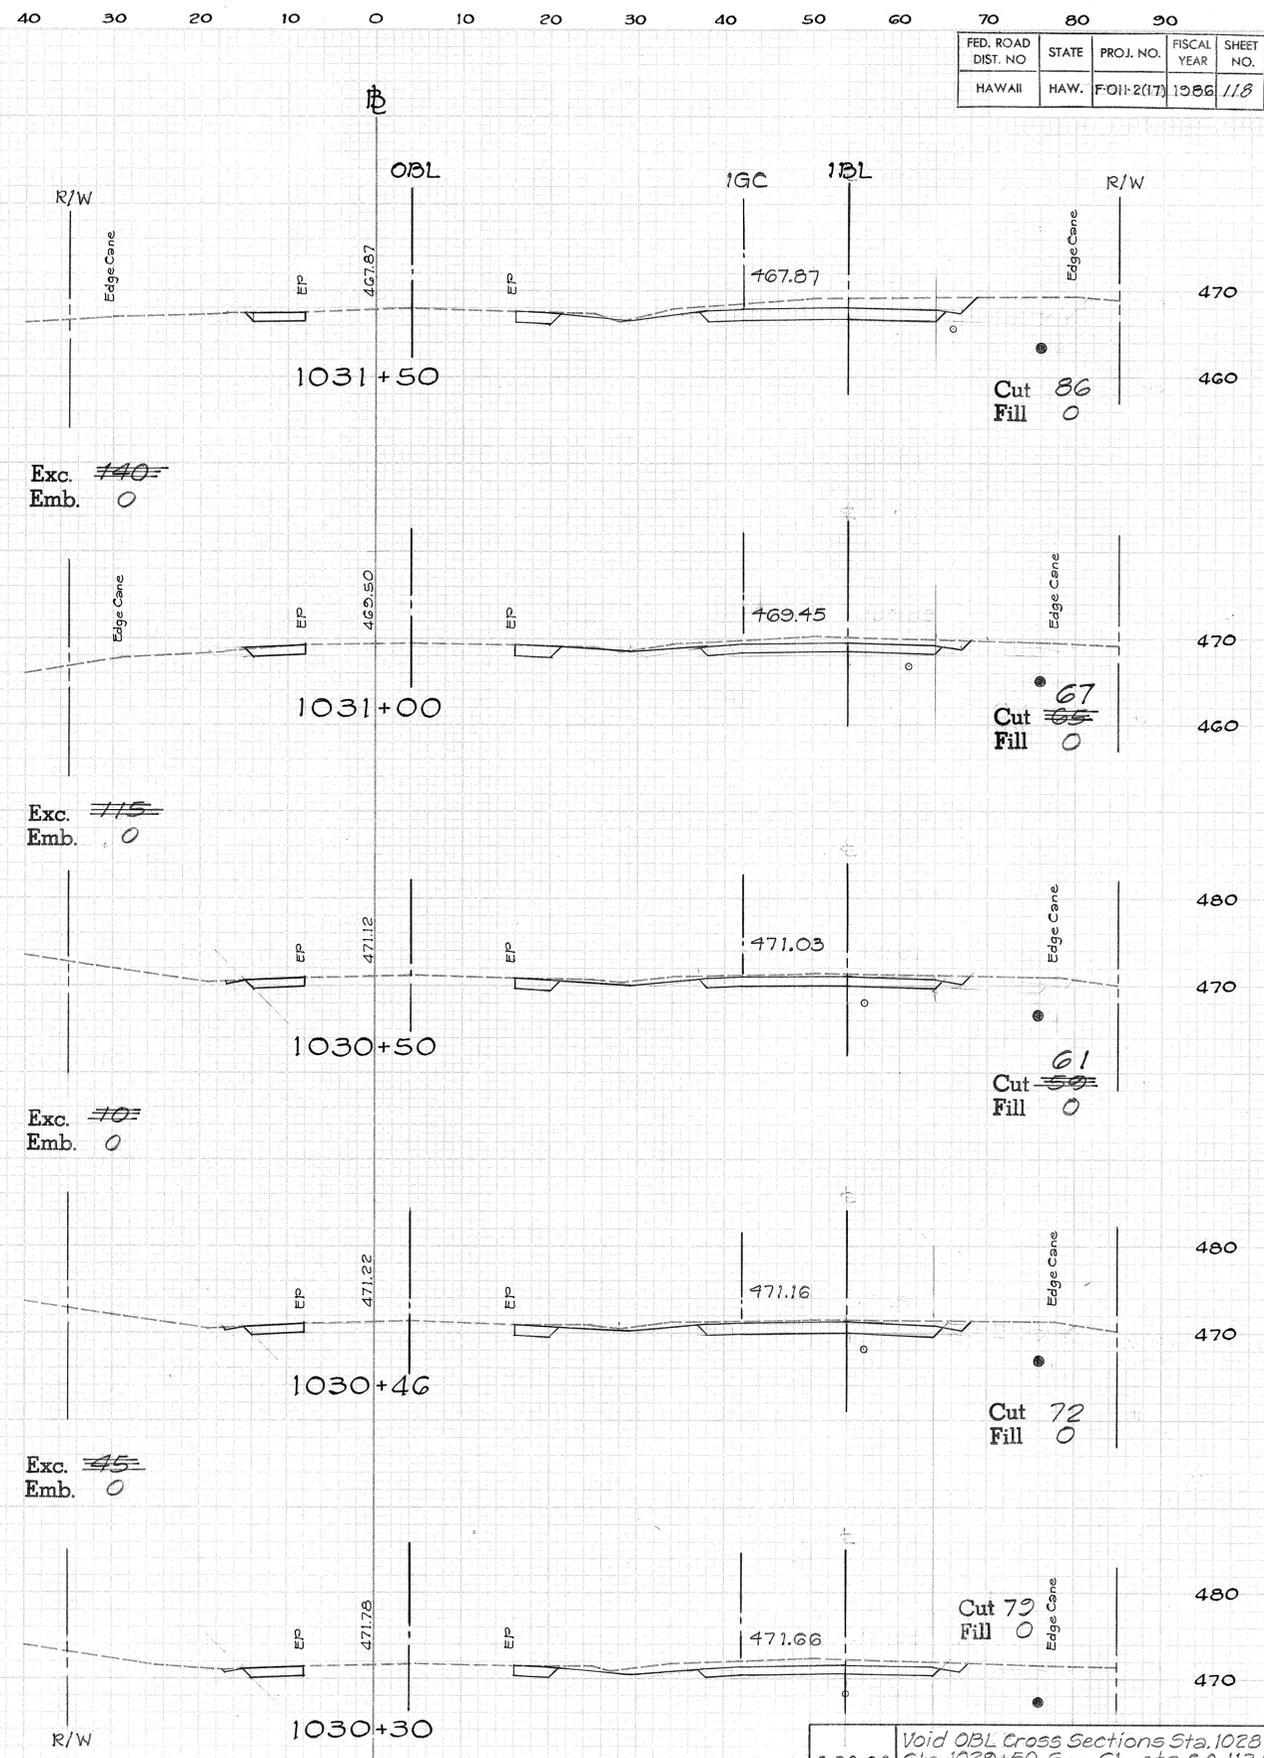

(OBL & IBL Stations = \oplus Stations)

Void OBL Cross Sections Sta. 1028+50 to Sta. 1029+50. See Sheets C.O. 113 S-1 thru S-4 for revised data.
DATE REVISIONS


DATE	
BY	
FINAL SURVEY	
PROFESSIONAL	
NO. 1115-1	

DATE	
BY	See
ORIGINAL SURVEY	
PROFESSIONAL	
NO. 1115-1	


40 30 20 10 0 10 20 30 40 50 60 70 80

40 30 20 10 0 10 20 30 40 50 60 70 80 90

FED. ROAD DIST. NO.	STATE	PROJ. NO.	FISCAL YEAR	SHEET NO.	TOTAL SHEETS
HAWAII	HAW.	F-011-2(17)	1986	119	142

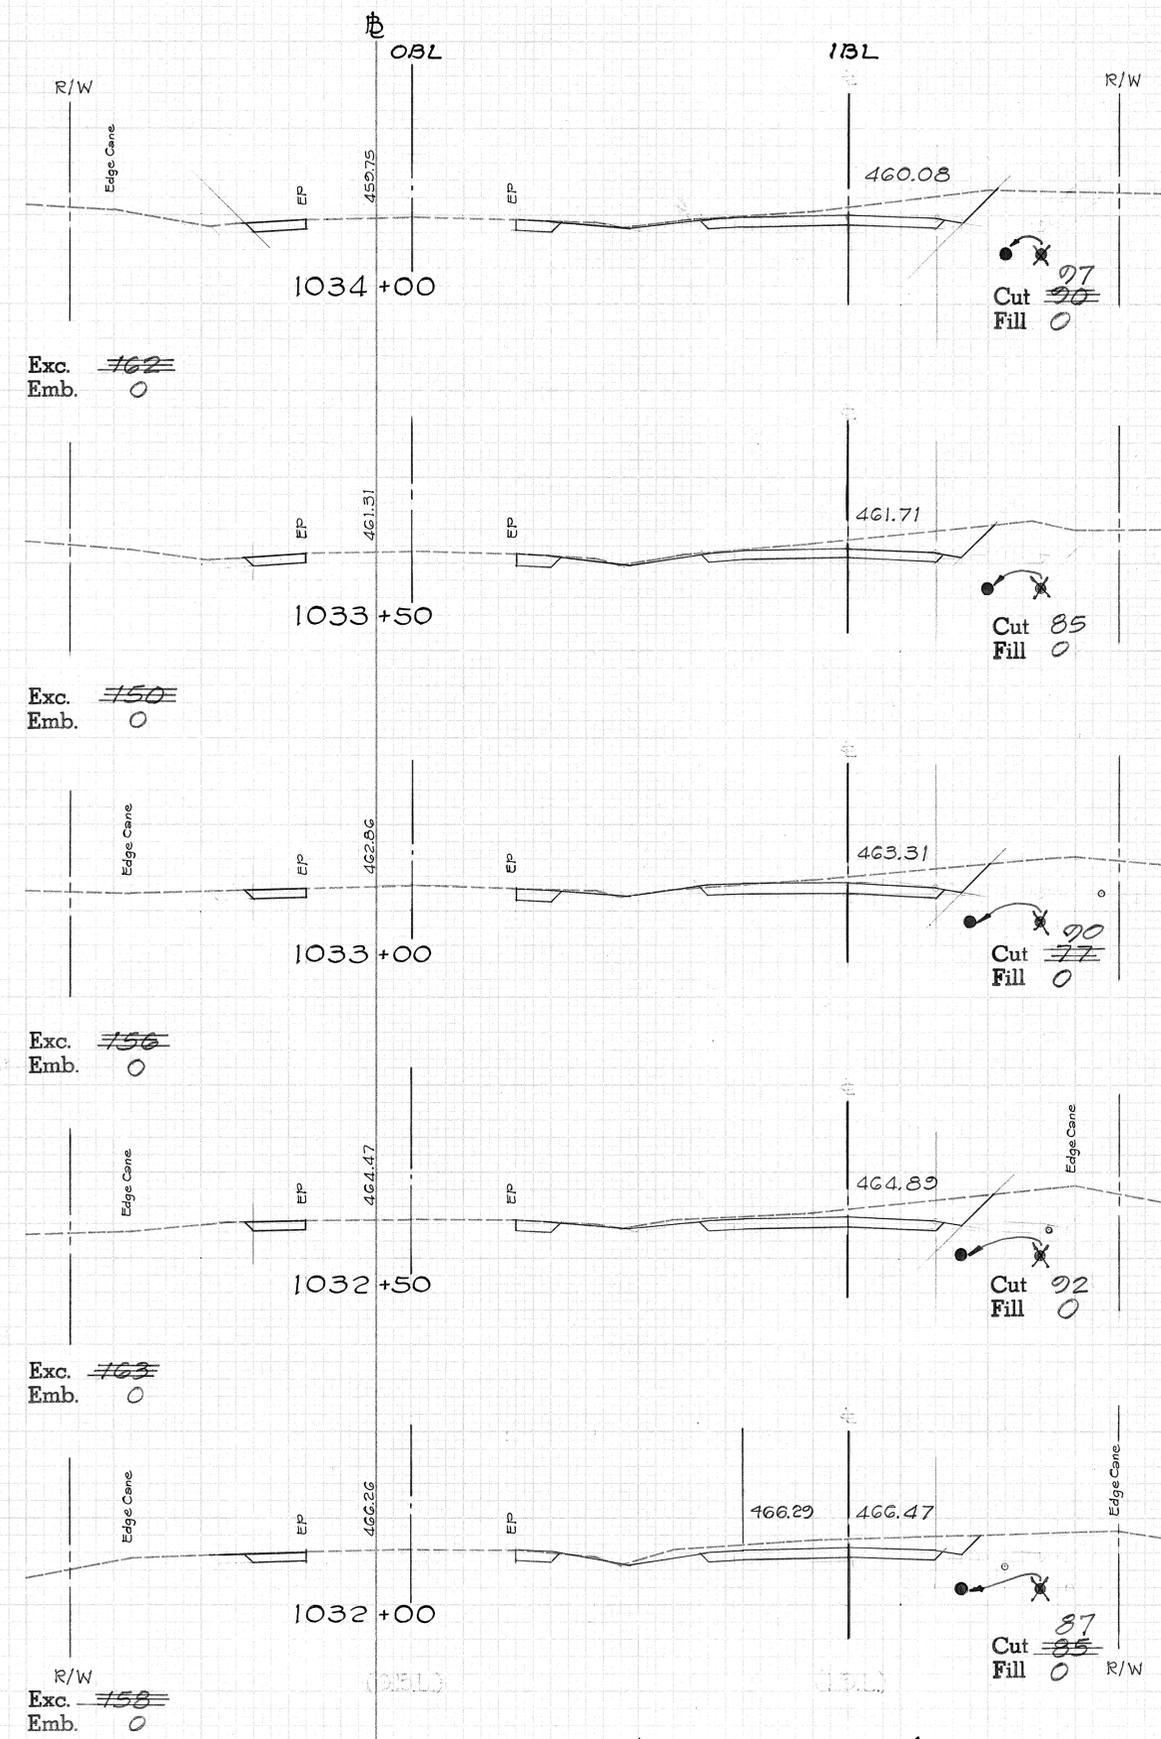

OBL & IBL Stations = $\frac{1}{2}$ Stations

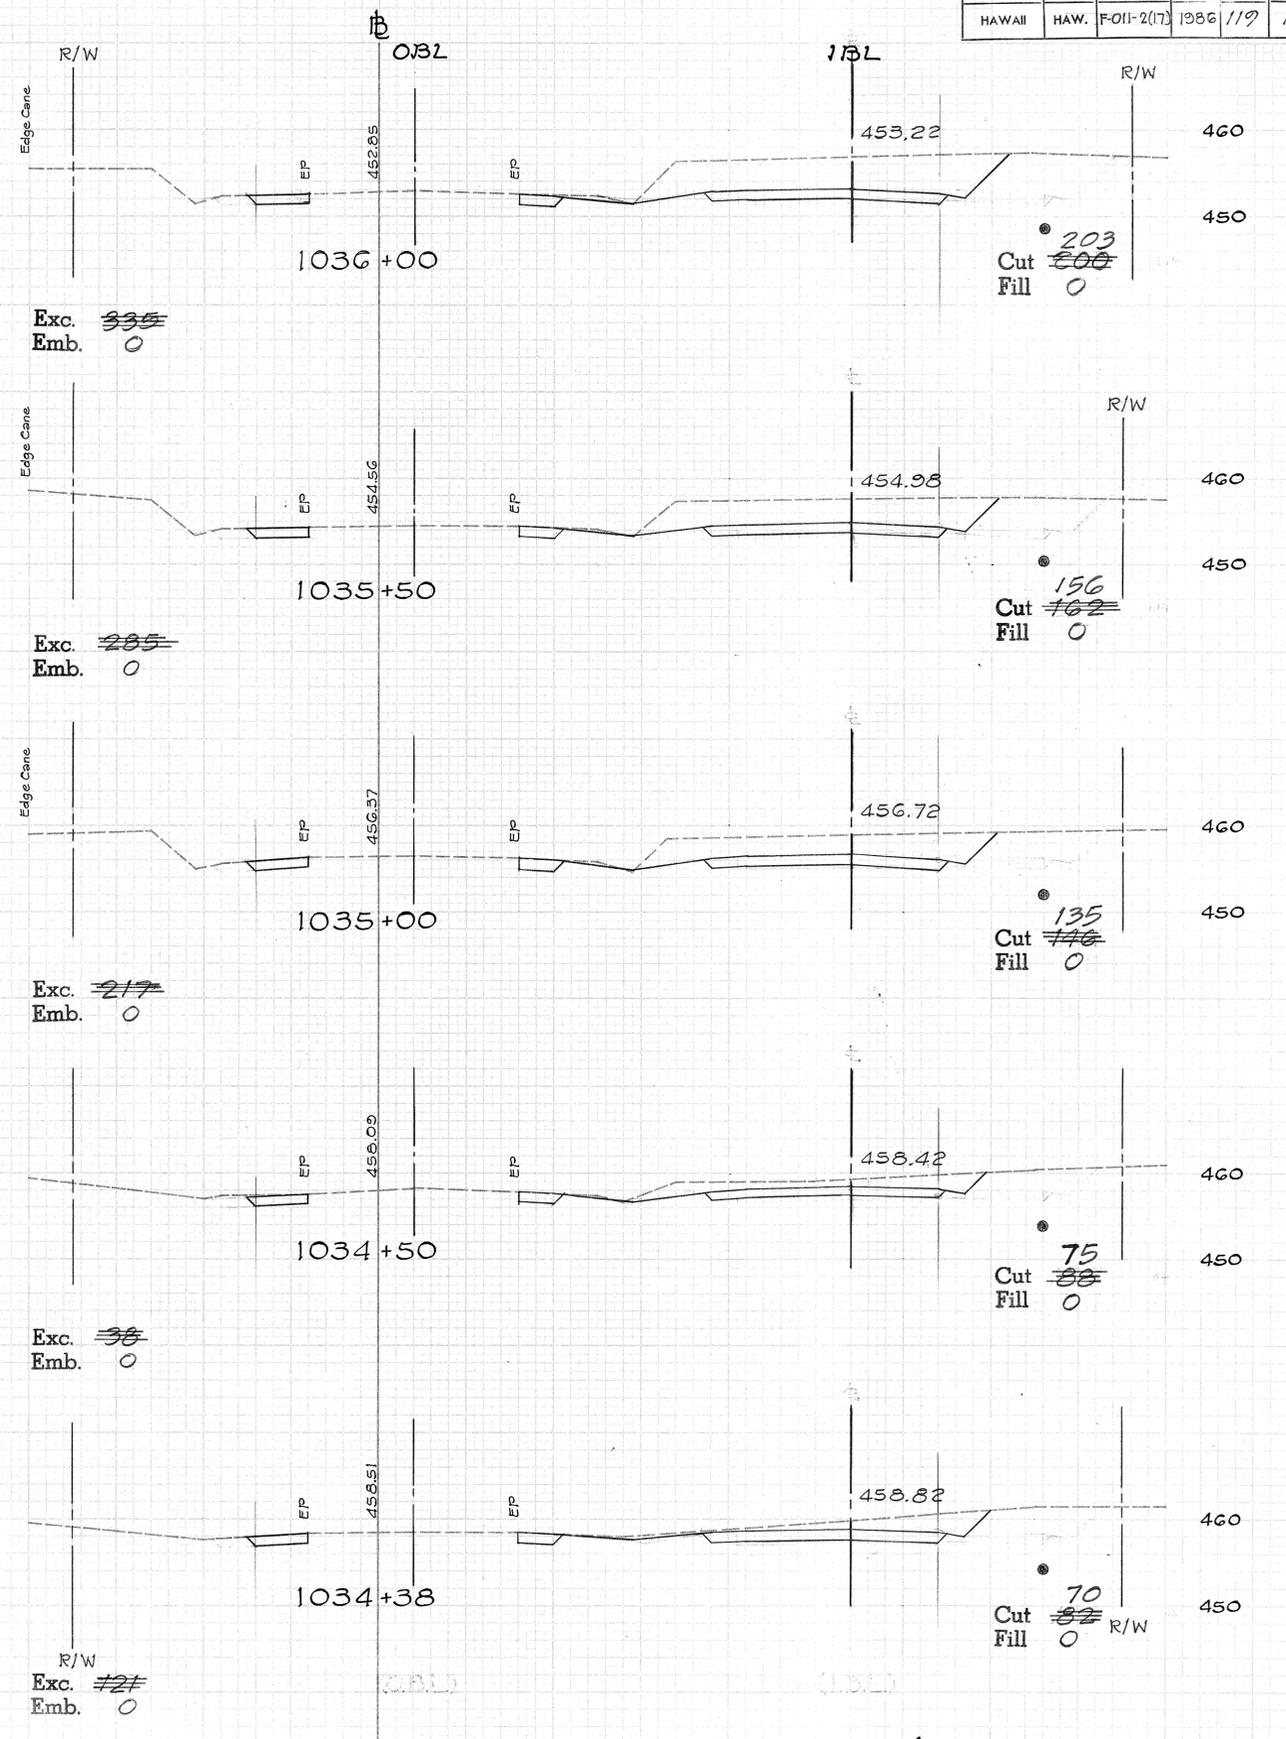


OBL & IBL Stations = $\frac{1}{2}$ Stations

DATE: _____
 BY: _____
 ORIGINAL SURVEY PLOTTED: _____
 SURVEY PLOTTED: _____
 NOTEBOOK TEMPLATE: _____
 AREAS CHECKED: _____
 NO. 1115-3

DATE: _____
 BY: _____
 ORIGINAL SURVEY PLOTTED: _____
 SURVEY PLOTTED: _____
 NOTEBOOK TEMPLATE: _____
 AREAS CHECKED: _____
 NO. 1115-3

FED. ROAD DIST. NO.	STATE	PROJ. NO.	FISCAL YEAR	SHEET NO.	TOTAL SHEETS
HAWAII	HAW.	F-011-2(17)	1986	120	142

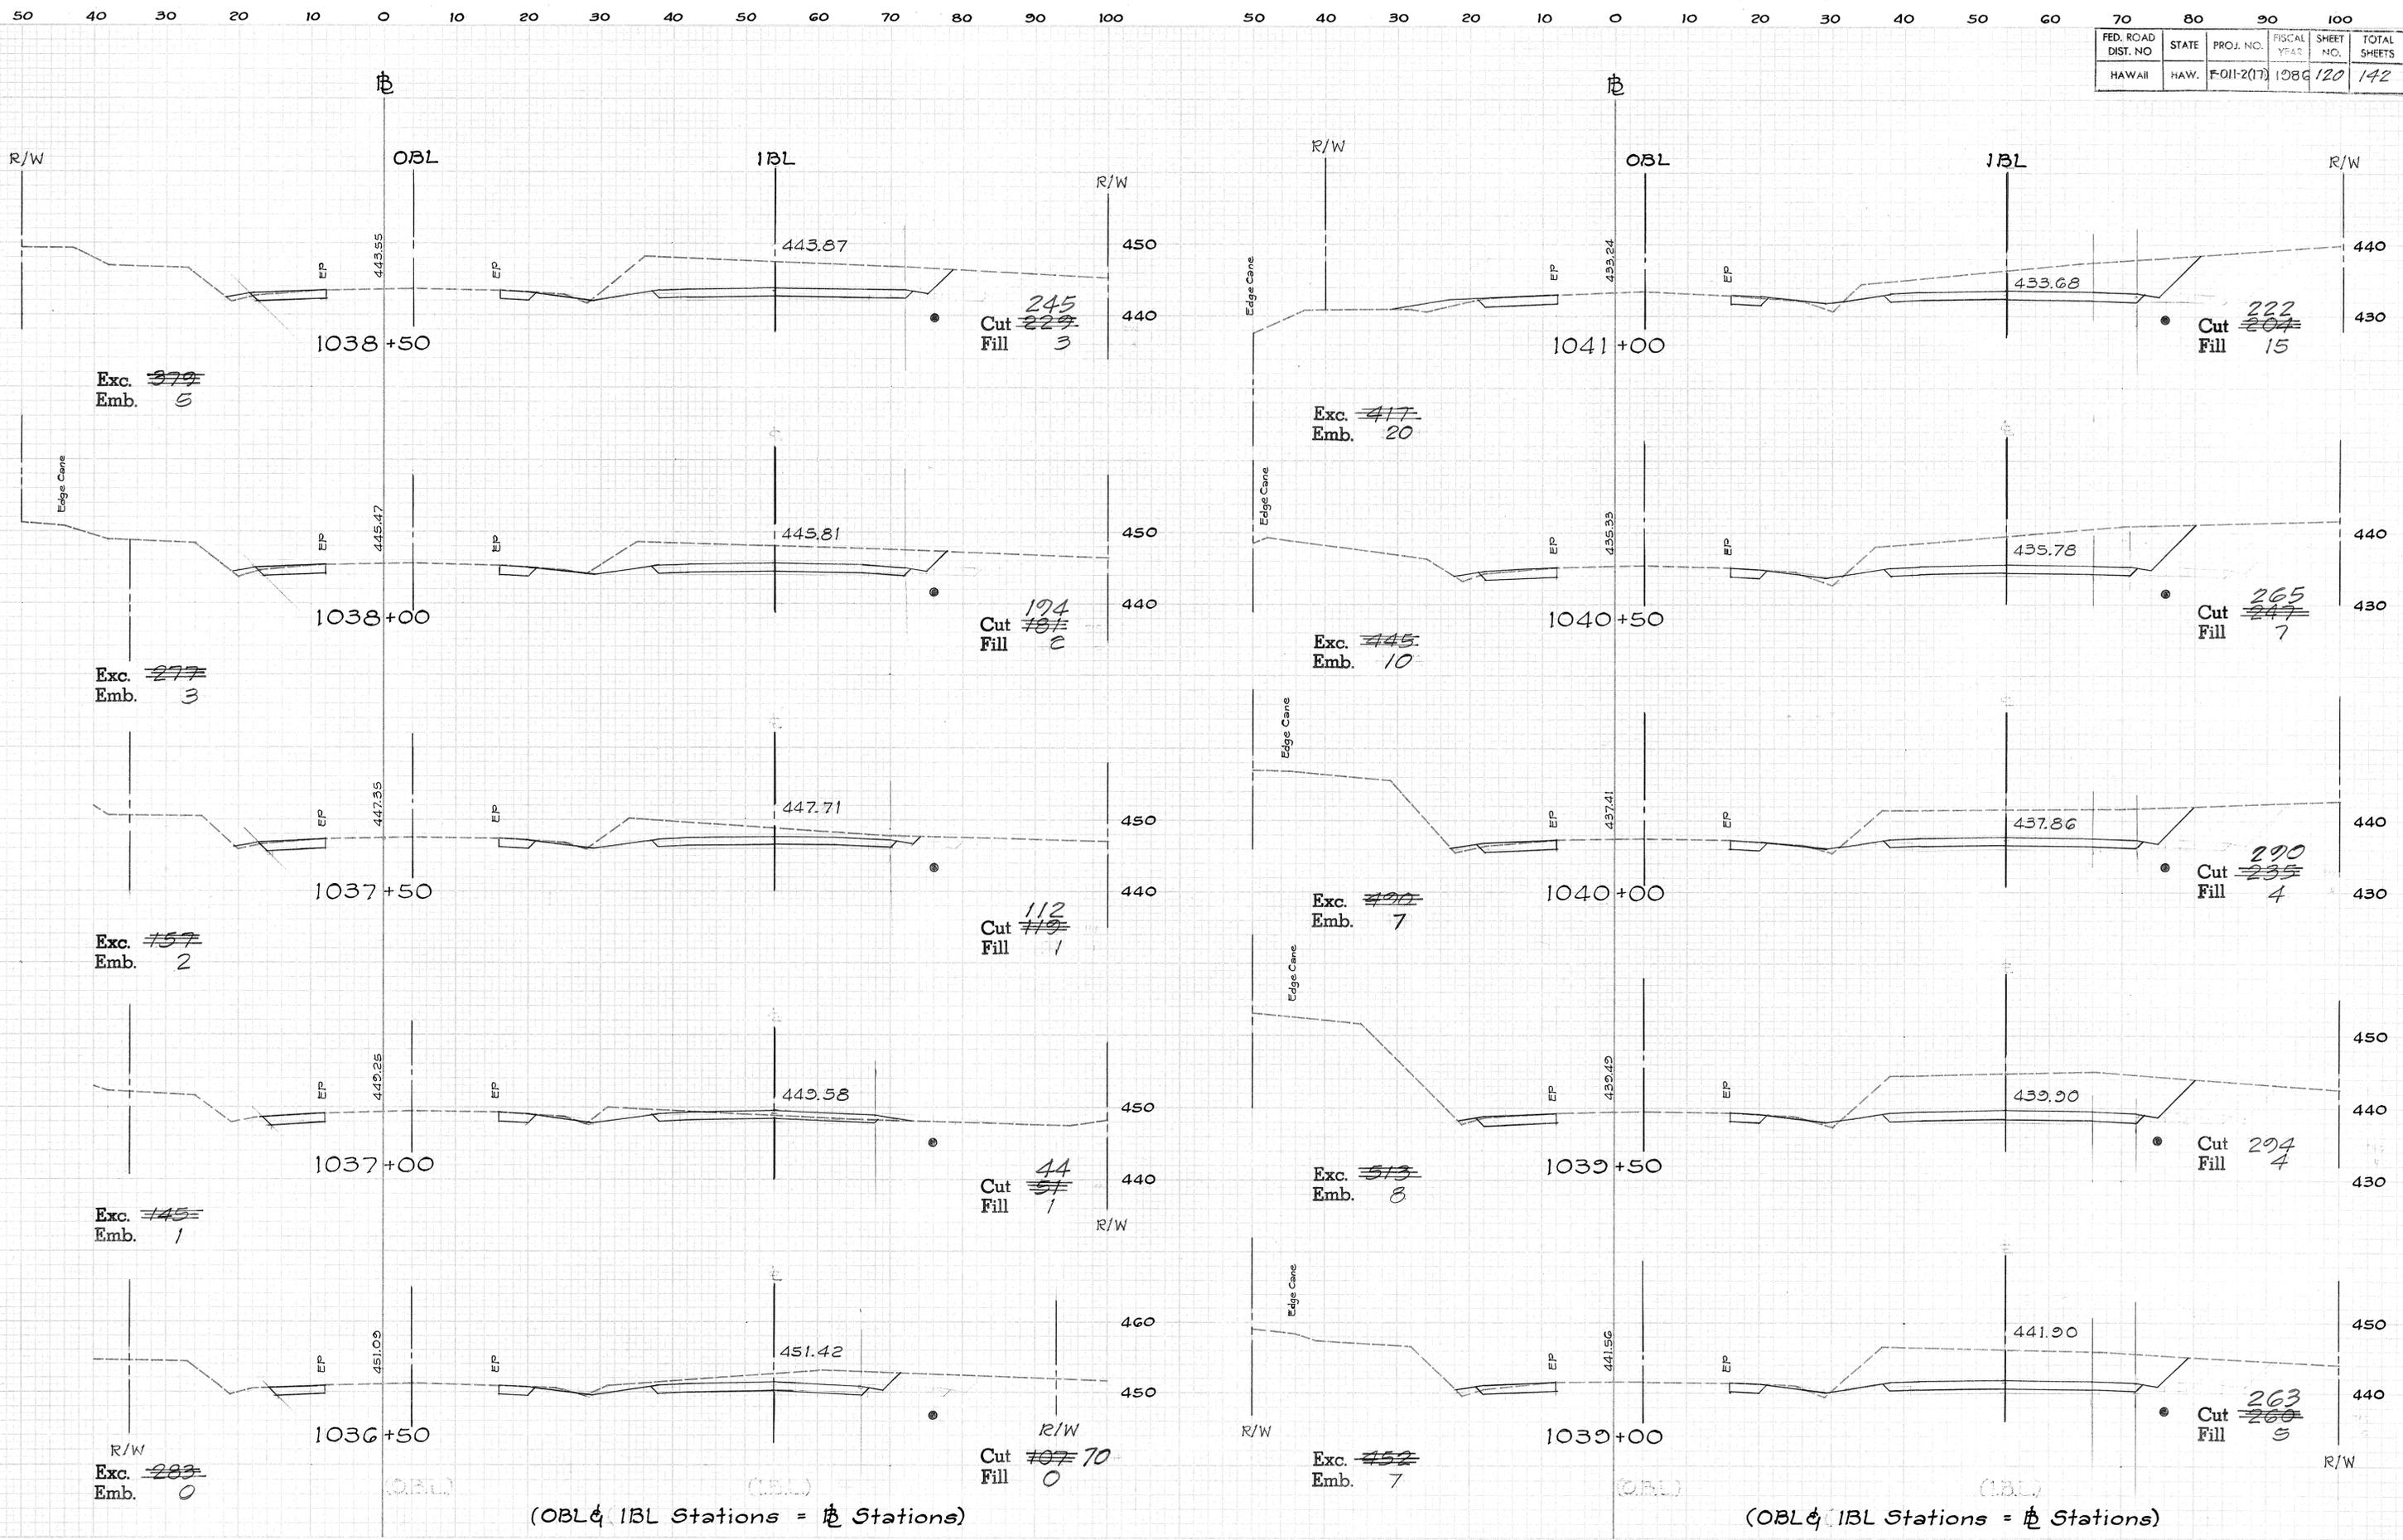



DATE: _____
 BY: _____
 SURVEYED: _____
 SURVEY: _____
 PHOTO: _____
 TEMPLATE: _____
 AREAS: _____
 CHECKED: _____
 INC. _____

DATE: _____
 BY: _____
 SURVEYED: _____
 SURVEY: _____
 PHOTO: _____
 TEMPLATE: _____
 AREAS: _____
 CHECKED: _____
 INC. _____

FED. ROAD DIST. NO.	STATE	PROJ. NO.	FISCAL YEAR	SHEET NO.	TOTAL SHEETS
HAWAII	HAW.	FOI-2(17)	1986	121	142

DATE: _____
 BY: _____
 SURVEYED: _____
 ORIGINAL SURVEY: _____
 NOTE BOOK: _____
 TEMPLATE: _____
 AREAS: _____
 AREAS CHECKED: _____


DATE: _____
 BY: _____
 SURVEYED: _____
 ORIGINAL SURVEY: _____
 NOTE BOOK: _____
 TEMPLATE: _____
 AREAS: _____
 AREAS CHECKED: _____

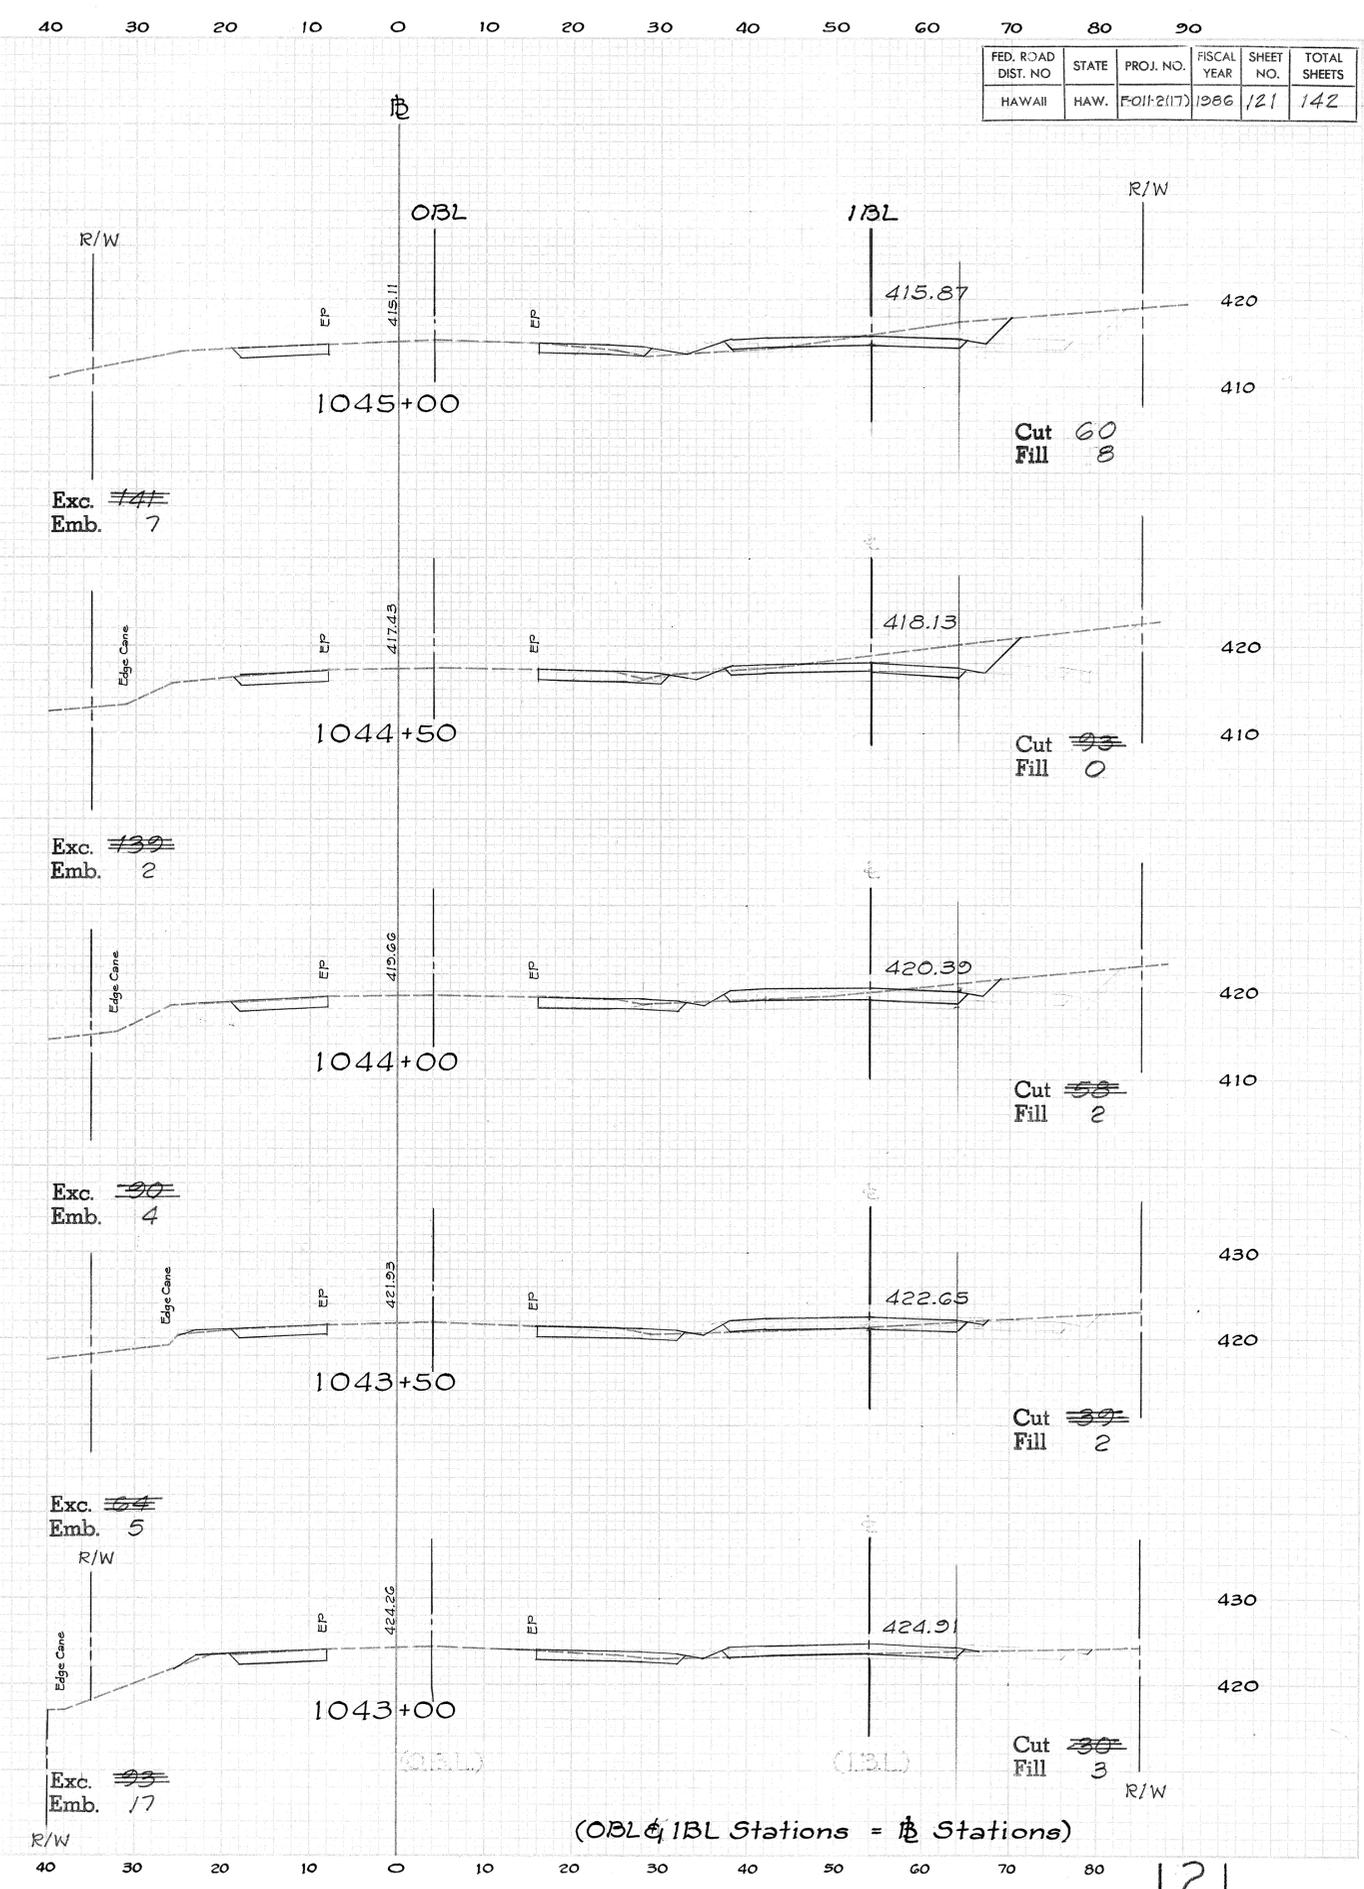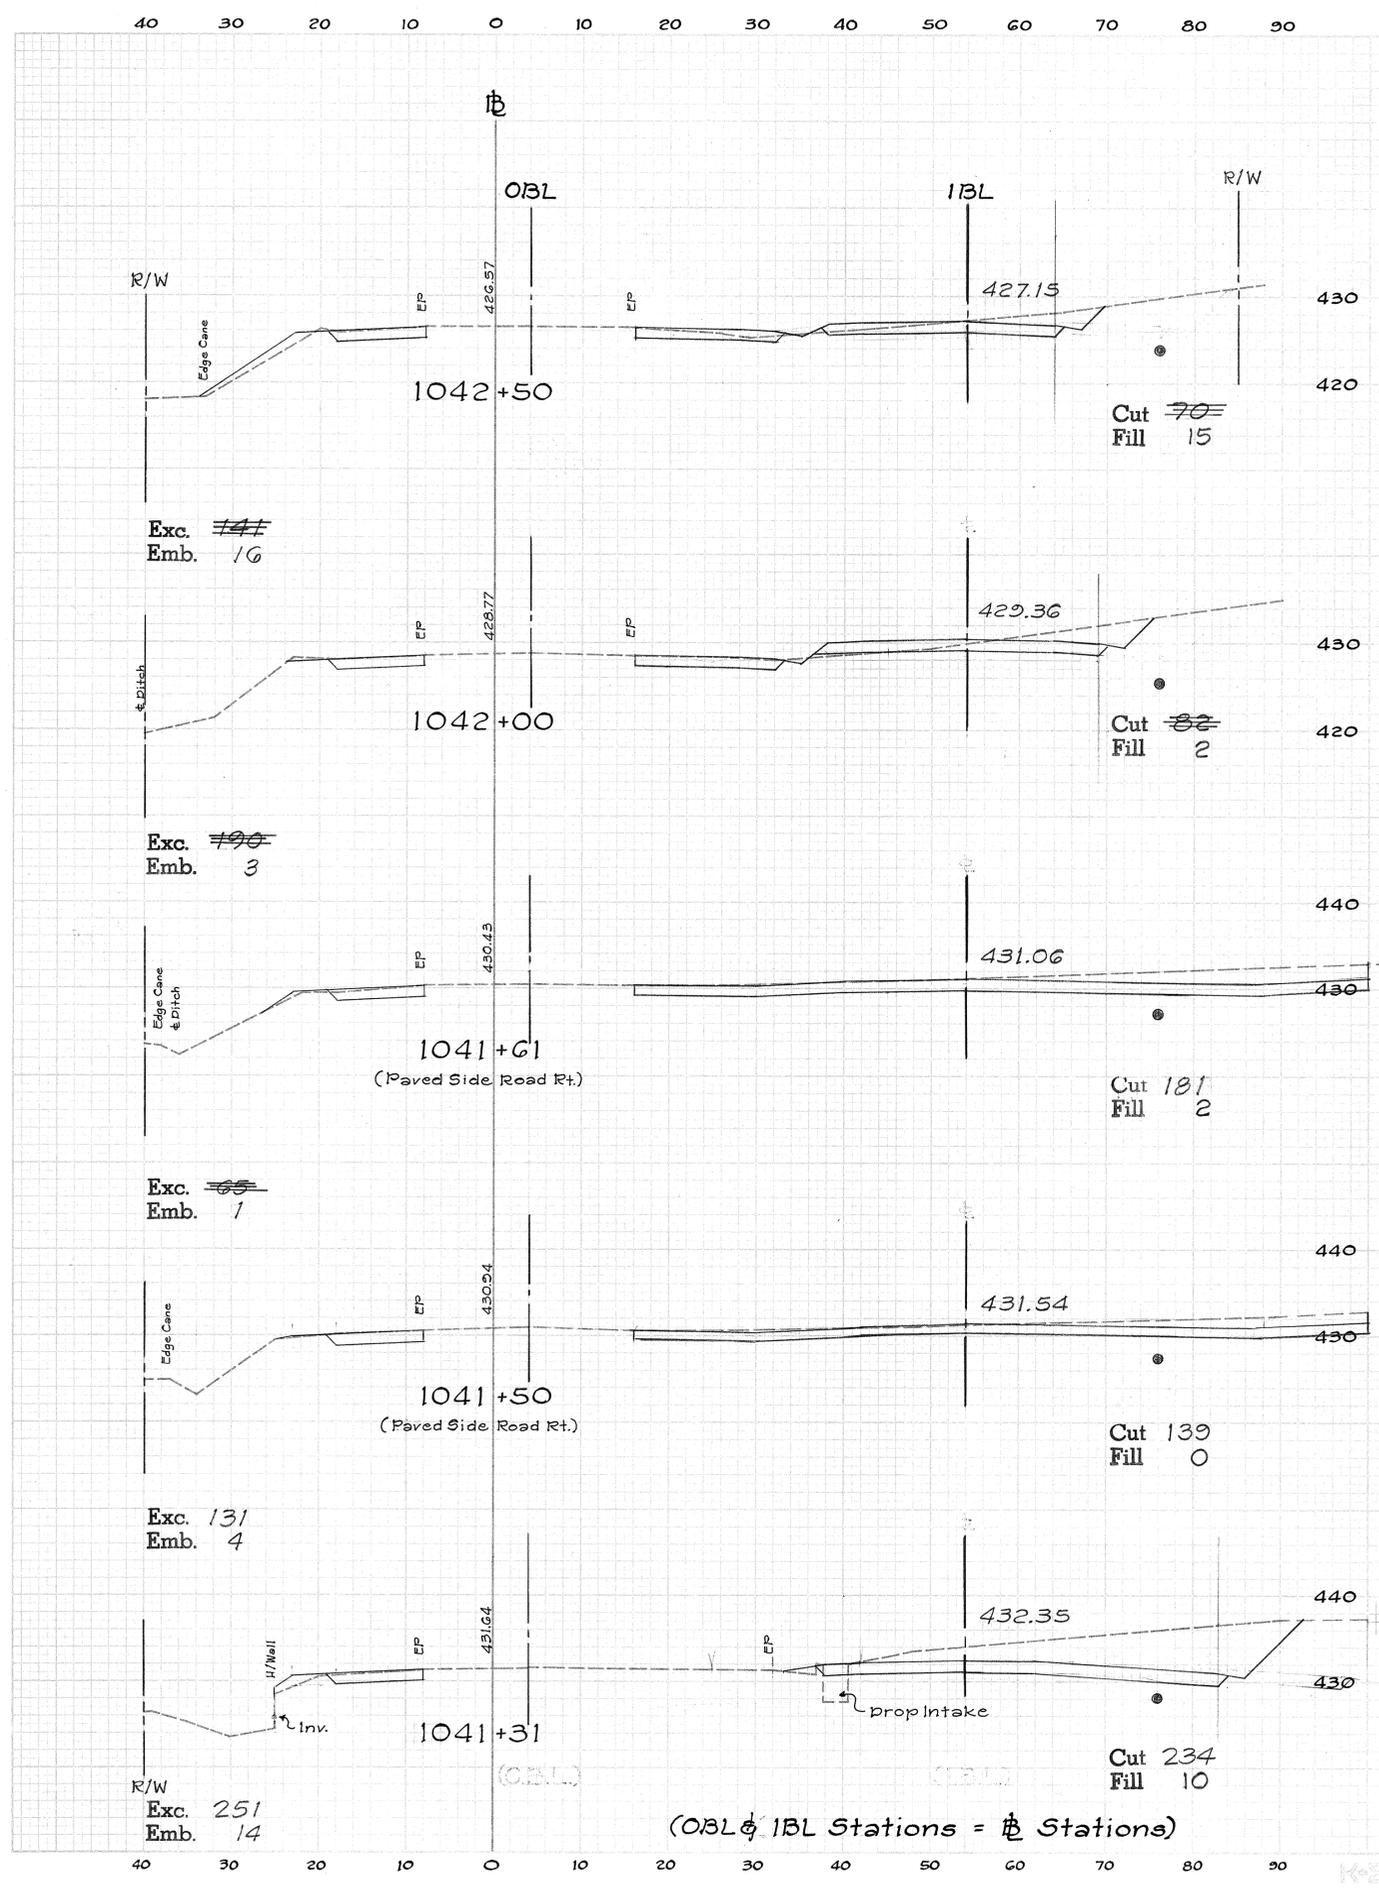

FED. ROAD DIST. NO.	STATE	PROJ. NO.	FISCAL YEAR	SHEET NO.	TOTAL SHEETS
HAWAII	HAW.	F-011-2017	1986	122	142

DATE: _____
 BY: _____
 ORIGINAL SURVEY PLOTTED _____
 SURVEY REVISIONS _____
 NOTE BOOK NO. _____
 AREAS CHECKED _____

DATE: _____
 BY: _____
 ORIGINAL SURVEY PLOTTED _____
 SURVEY REVISIONS _____
 NOTE BOOK NO. 115-11
 AREAS CHECKED _____

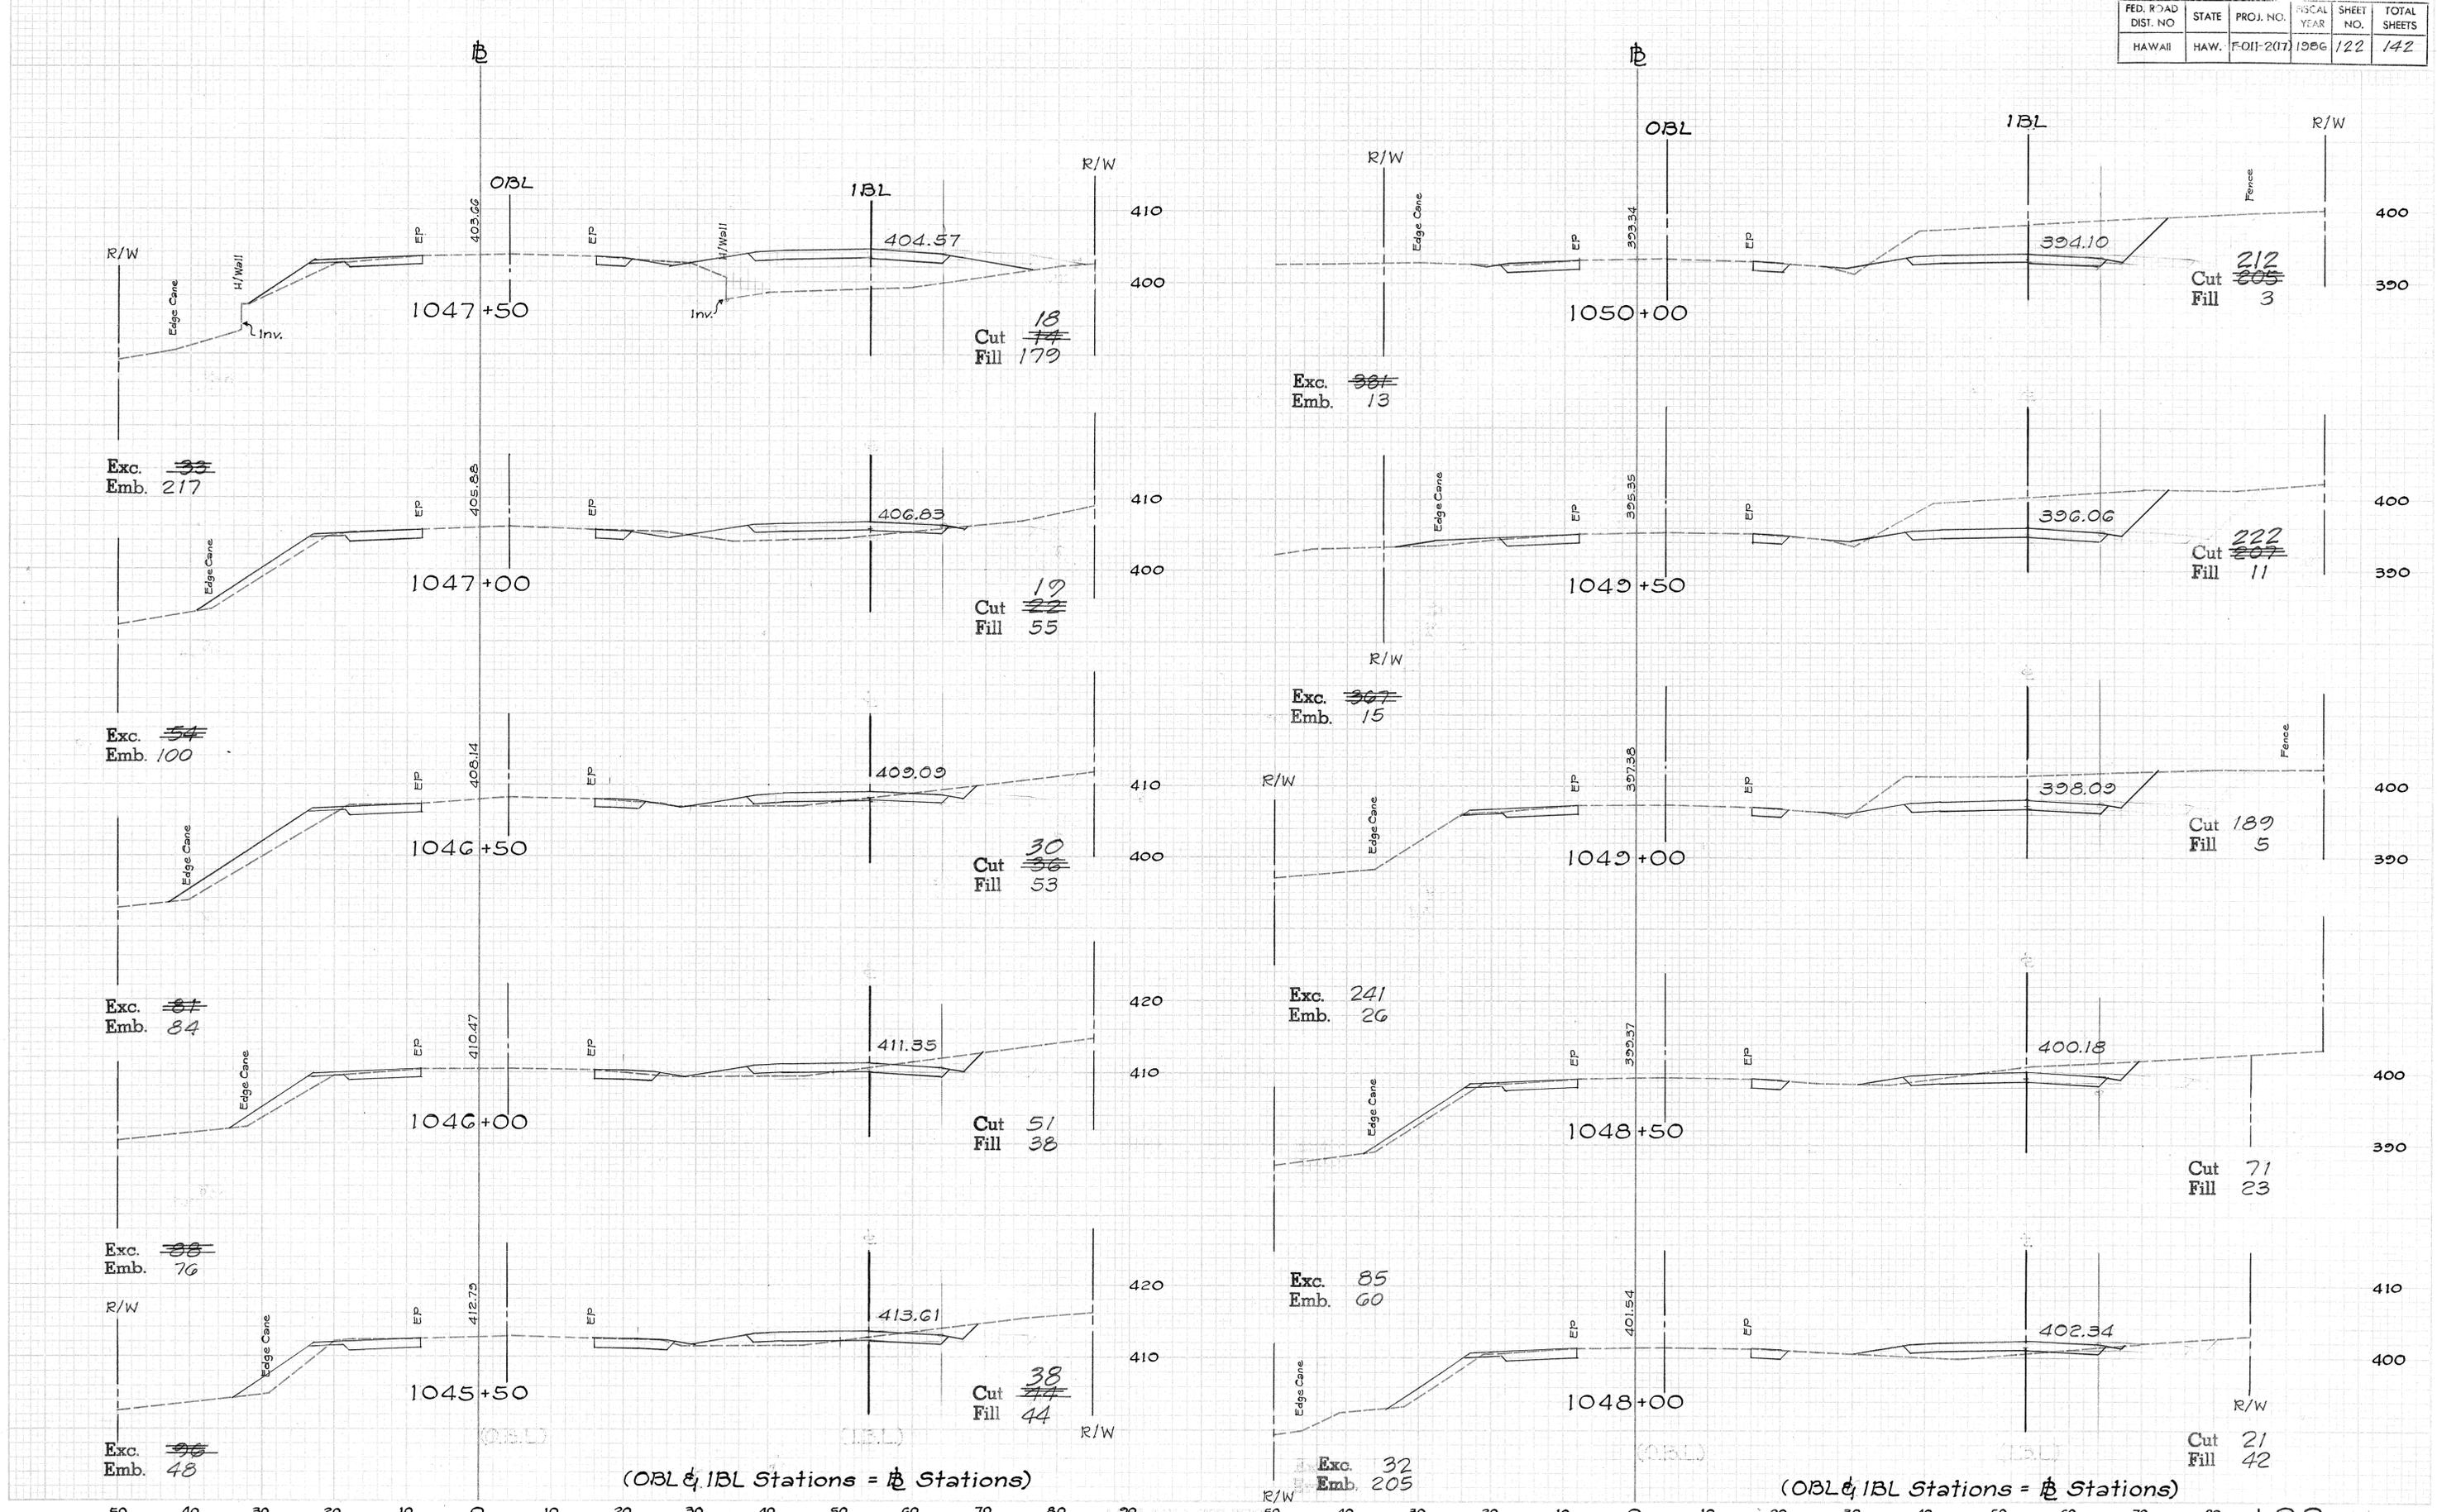



(OBL & IBL Stations = $\frac{1}{2}$ Stations)

(OBL & IBL Stations = $\frac{1}{2}$ Stations)

FED. ROAD DIST. NO.	STATE	PROJ. NO.	FISCAL YEAR	SHEET NO.	TOTAL SHEETS
HAWAII	HAW.	FD11-2(17)	1986	124	142


DATE: _____
 BY: _____
 ORIGINAL SURVEY PLOTTED: _____
 SURVEY PLOTTED: _____
 NOTE BOOK: _____
 AREA CHECKED: _____
 DATE: 1/15/15
 BY: 1/29/48

DATE: _____
 BY: _____
 ORIGINAL SURVEY PLOTTED: _____
 SURVEY PLOTTED: _____
 NOTE BOOK: _____
 AREA CHECKED: _____
 DATE: 1/15/15
 BY: 1/29/48

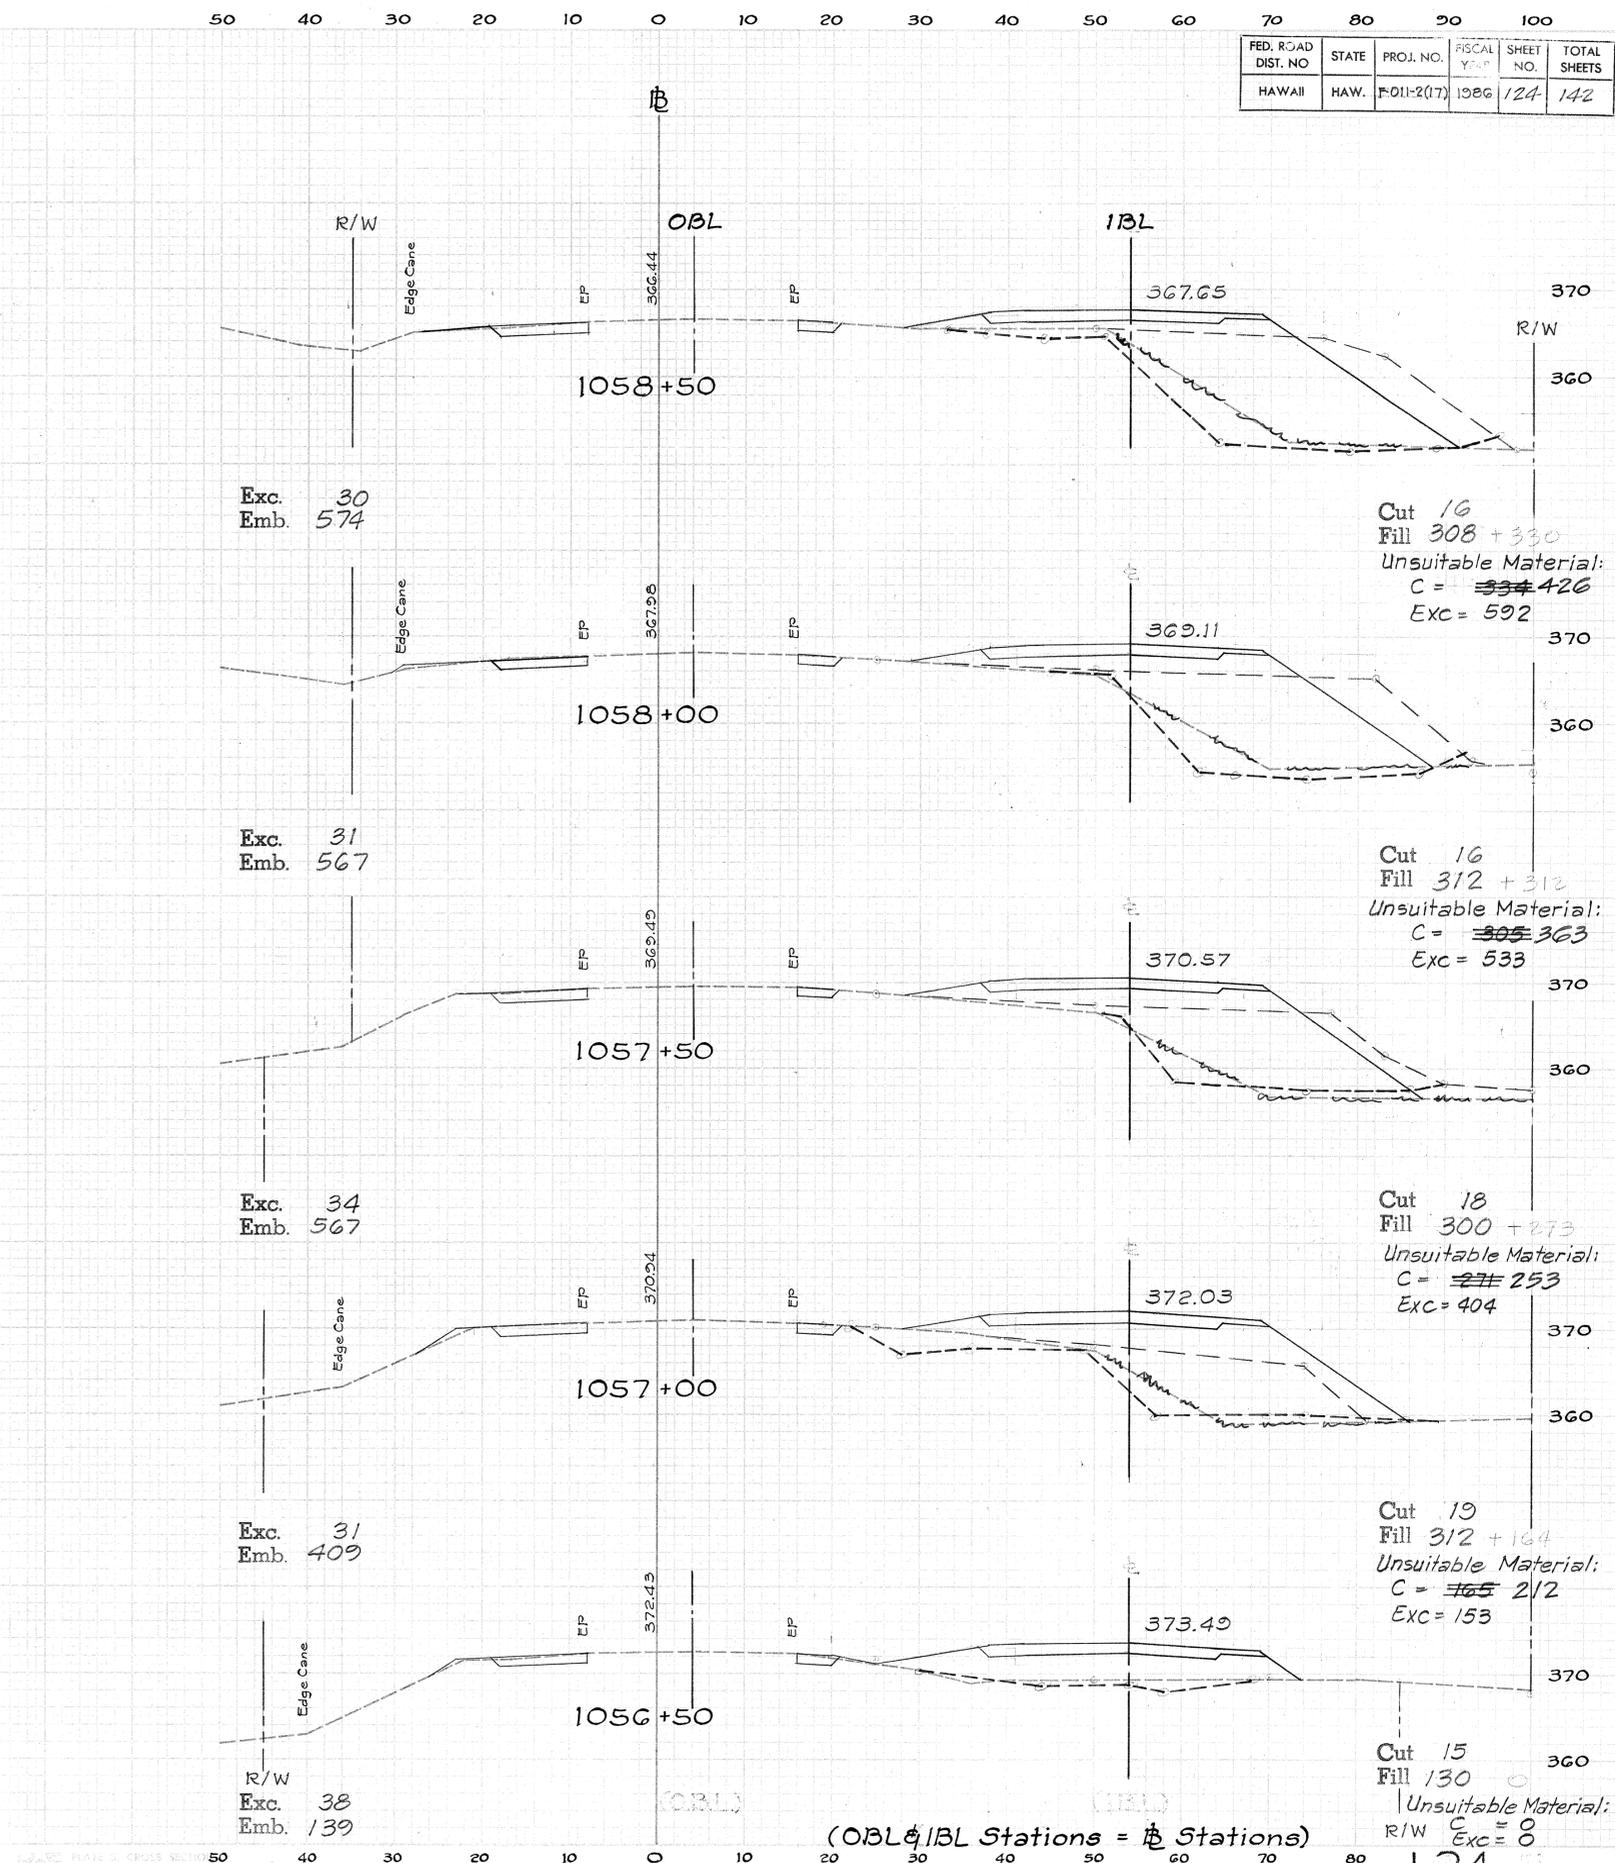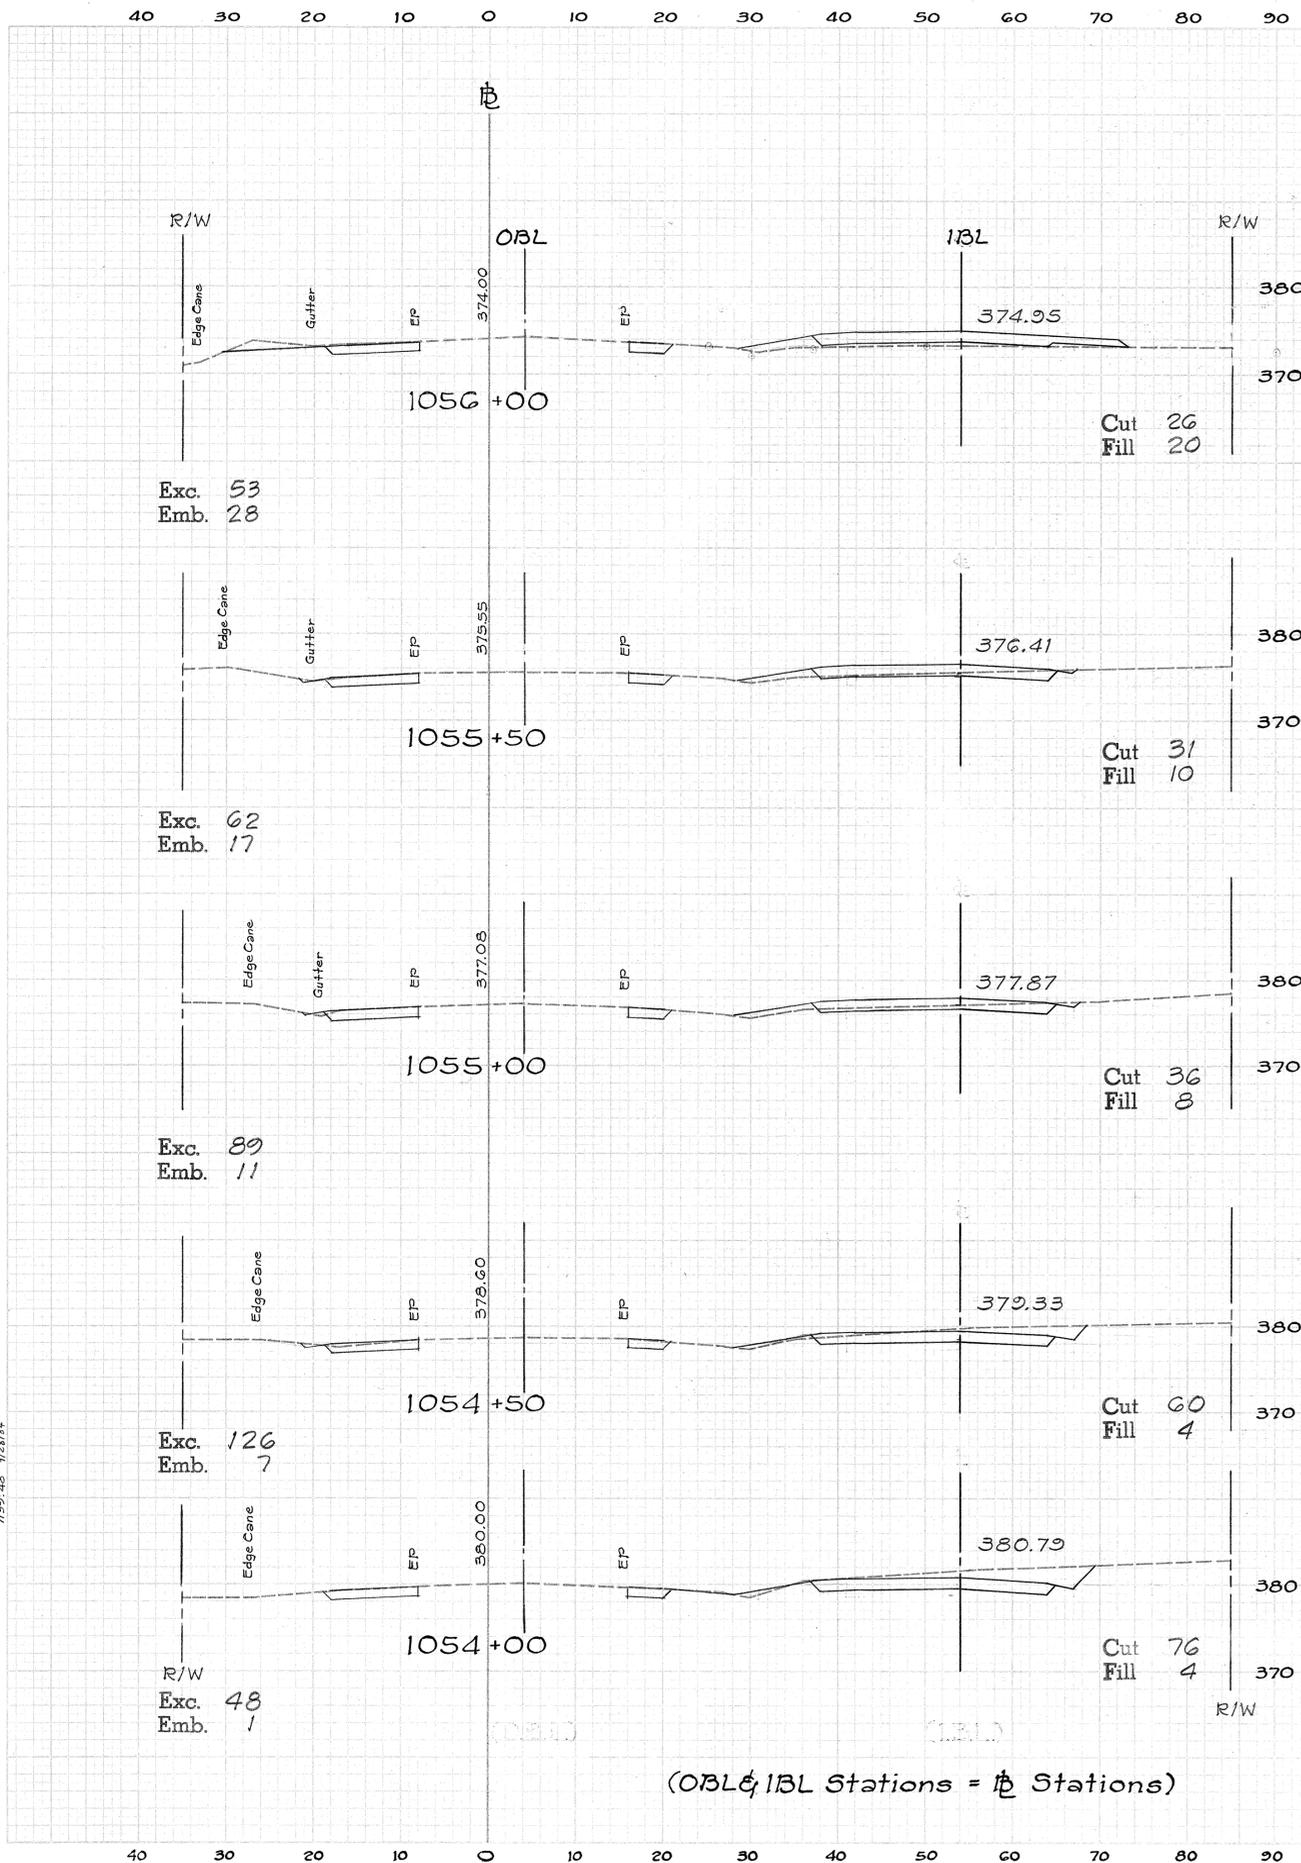

FED. ROAD DIST. NO.	STATE	PROJ. NO.	FISCAL YEAR	SHEET NO.	TOTAL SHEETS
HAWAII	HAW.	FOH-2(17)	1986	125	142

80 70 60 50 40 30 20 10 0 10 20 30 40 50 60 70 80 90 100

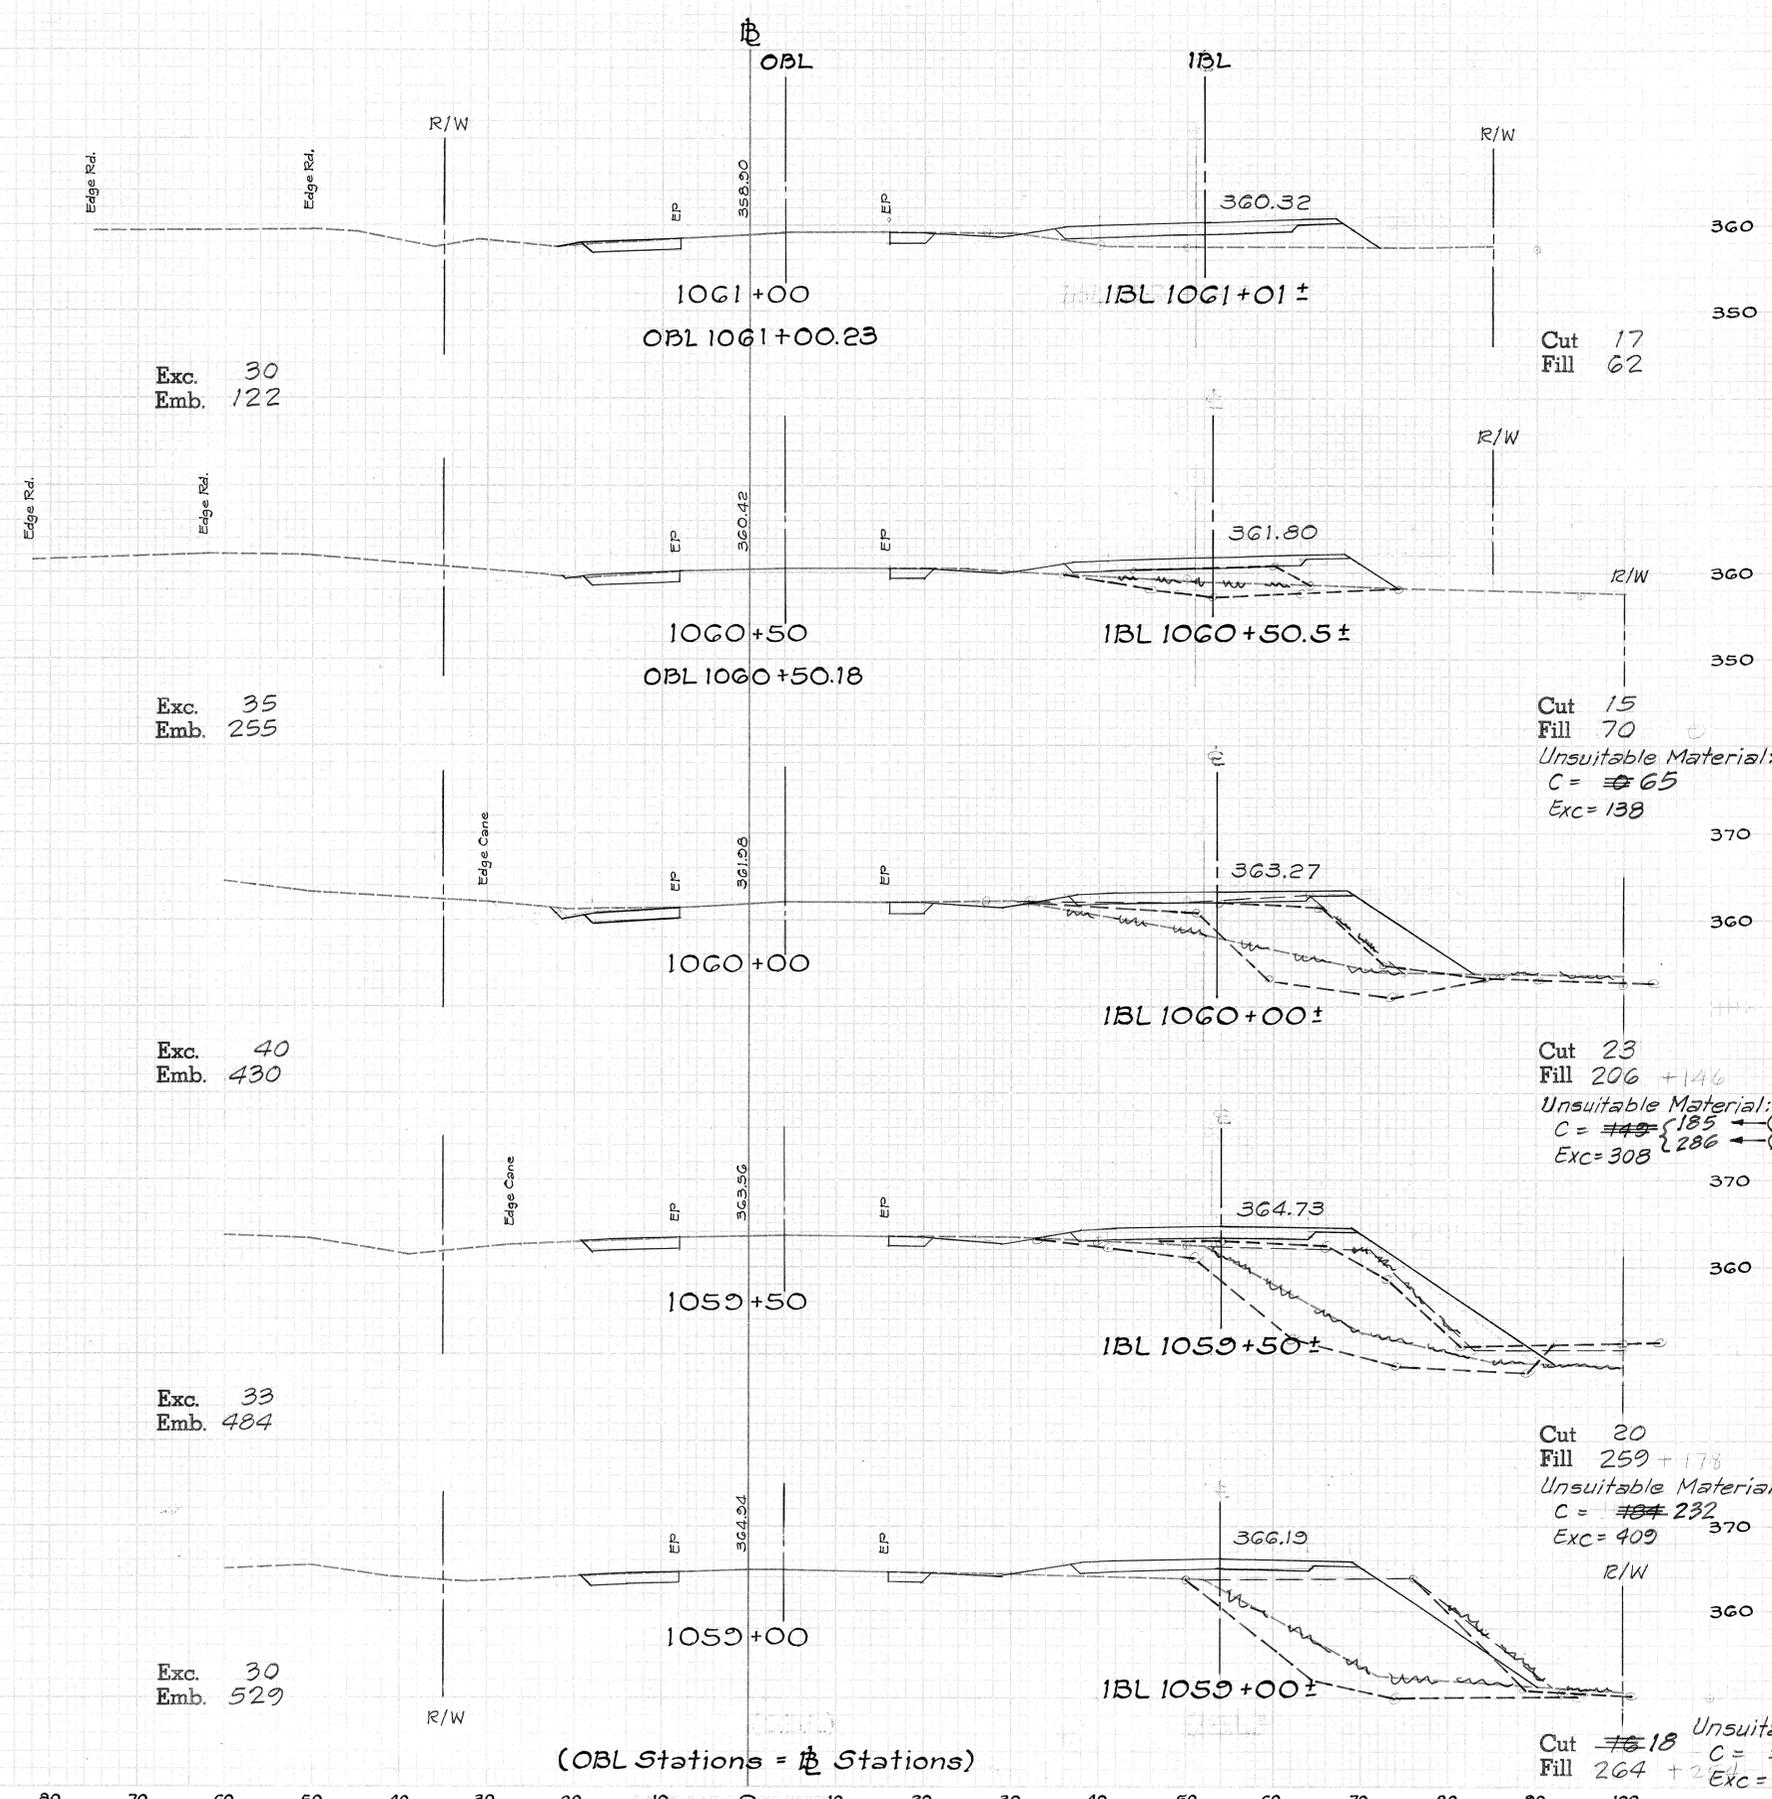

(OBL Stations = ± Stations)

FINAL SURVEY
 SURVEYED BY: _____
 DATE: _____
 CHECKED BY: _____
 DATE: _____

ORIGINAL SURVEY
 SURVEYED BY: _____
 DATE: _____
 CHECKED BY: _____
 DATE: _____

FED. ROAD DIST. NO.	STATE	PROJ. NO.	FISCAL YEAR	SHEET NO.	TOTAL SHEETS
HAWAII	HAW.	F-011-2(17)	1986	126	142


DATE	BY

FINAL SURVEY SUBMITTED
 SURVEY PLOTTED
 NOTE BOOK TEMPLATE
 AREAS CHECKED
 NO. 11/5/15

DATE	BY

ORIGINAL SURVEY SUBMITTED
 SURVEY PLOTTED
 NOTE BOOK TEMPLATE
 AREAS CHECKED
 NO. 11/5/15

80 70 60 50 40 30 20 10 0 10 20 30 40 50 60 70 80 90 100

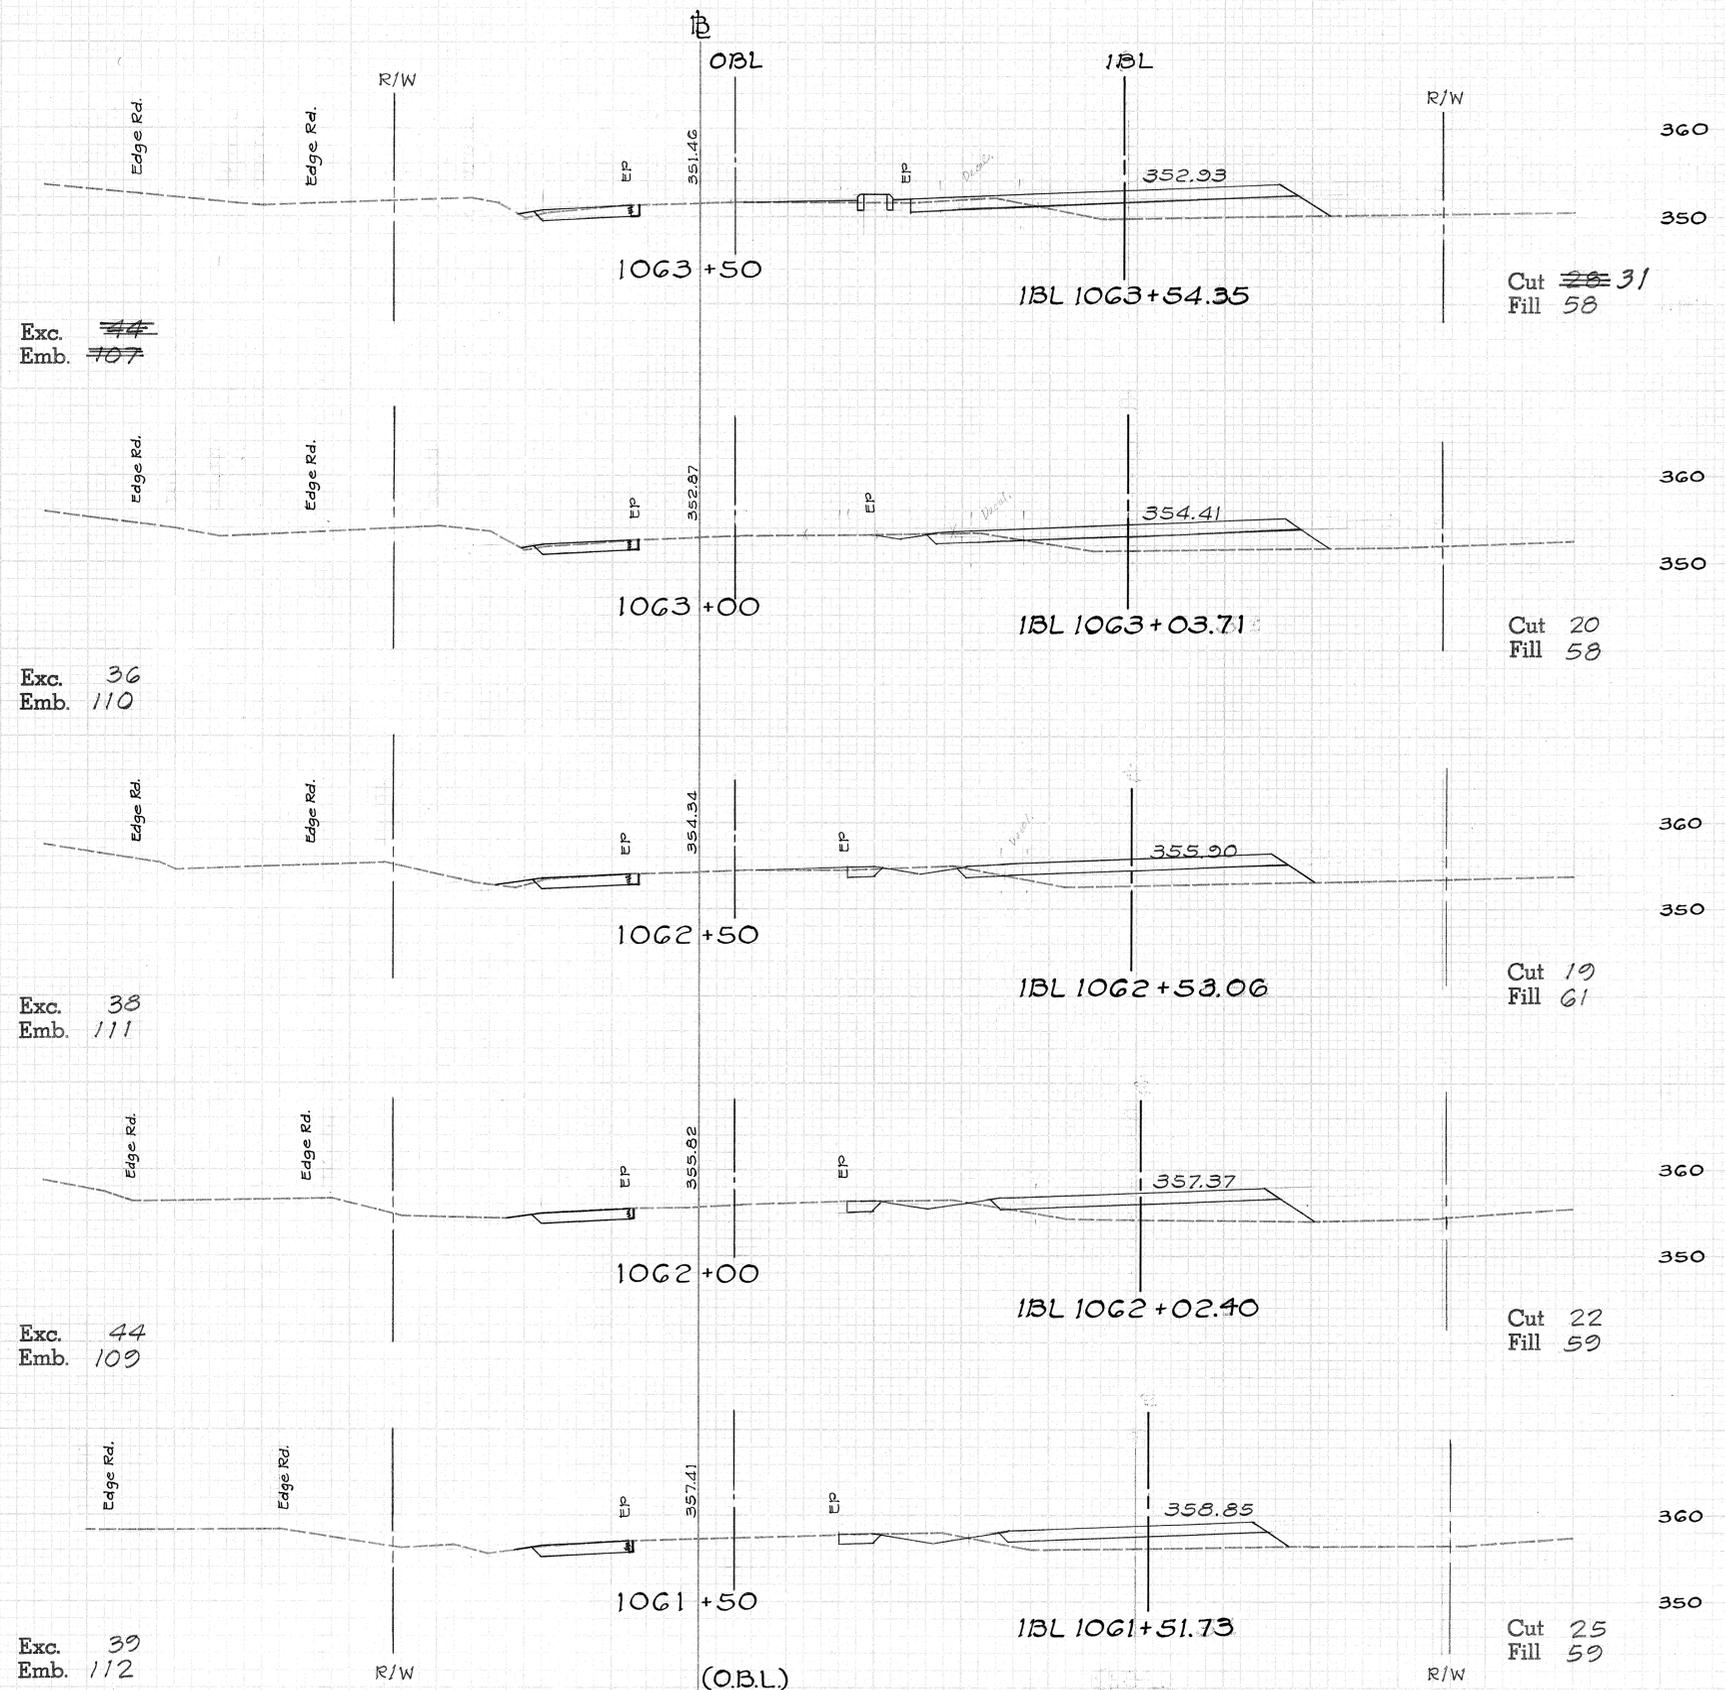


(OBL Stations = \mathbb{B} Stations)

80 70 60 50 40 30 20 10 0 10 20 30 40 50 60 70 80 90 100

FED. ROAD DIST. NO.	STATE	PROJ. NO.	FISCAL YEAR	SHEET NO.	TOTAL SHEETS
HAWAII	HAW.	F-011-2(17)	1986	127	142

80 70 60 50 40 30 20 10 0 10 20 30 40 50 60 70 80 90 100

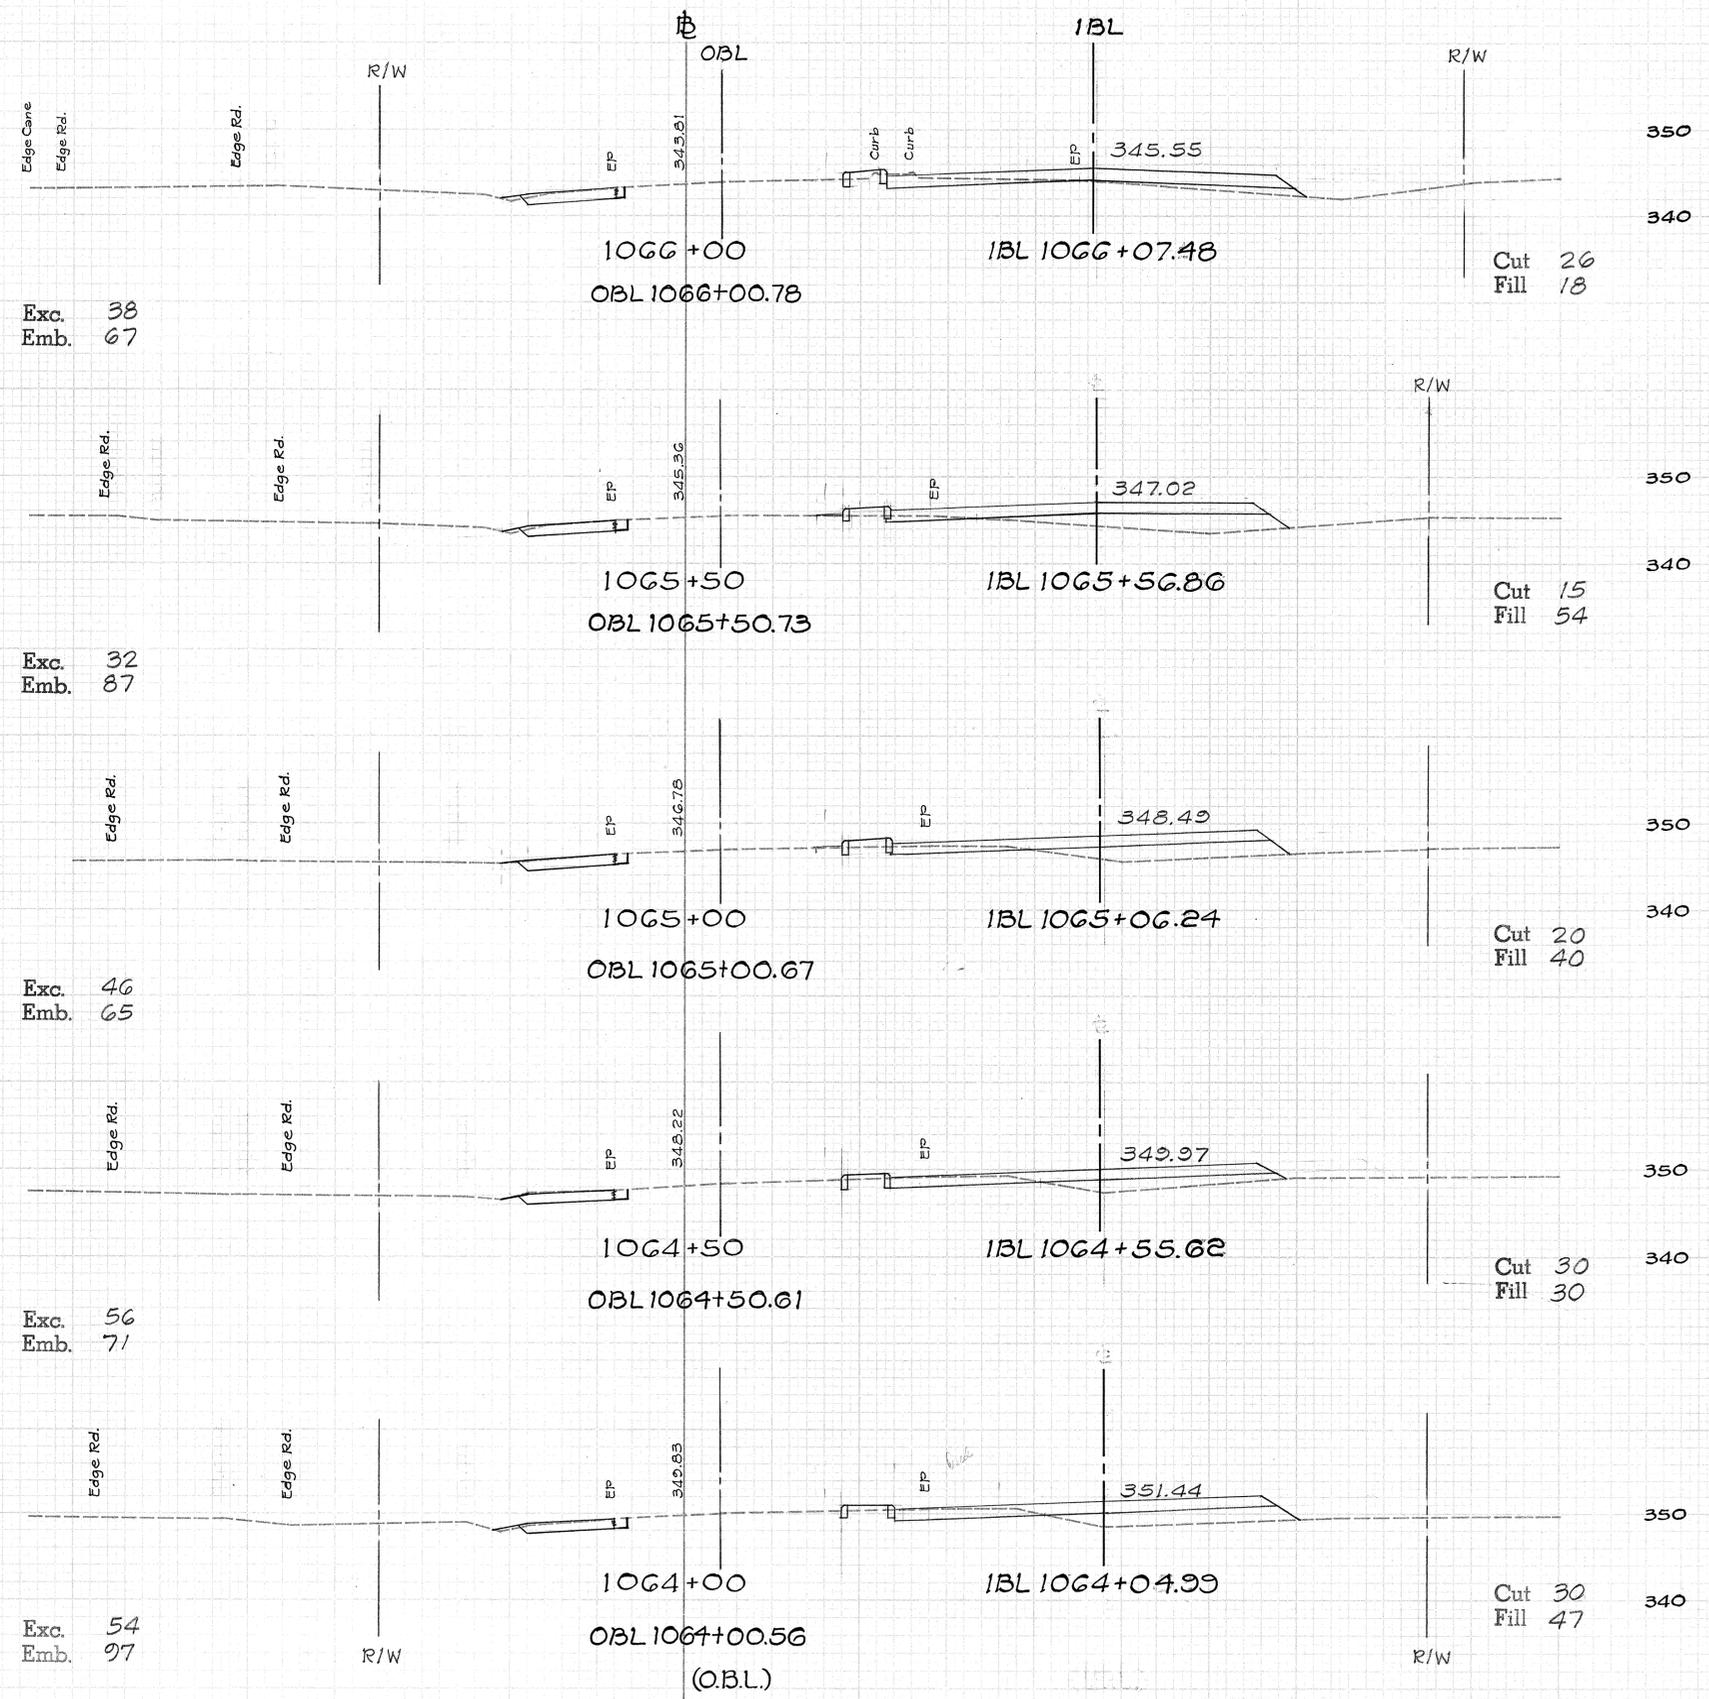

80 70 60 50 40 30 20 10 0 10 20 30 40 50 60 70 80 90 100

FINAL SURVEY PLOTTED
NOTE BOOK TEMPLATE AREAS CHECKED

ORIGINAL SURVEY PLOTTED
NOTE BOOK TEMPLATE AREAS CHECKED
11/15/20

(OBL Station + 2 Station)


FED. ROAD DIST. NO.	STATE	PROJ. NO.	FISCAL YEAR	SHEET NO.	TOTAL SHEETS
HAWAII	HAW.	P-01-2(17)	1986	128	142

DATE	BY

ORIGINAL SURVEY	DATE
11/5/21	

DATE	BY



ORIGINAL SURVEY	DATE
11/5/21	

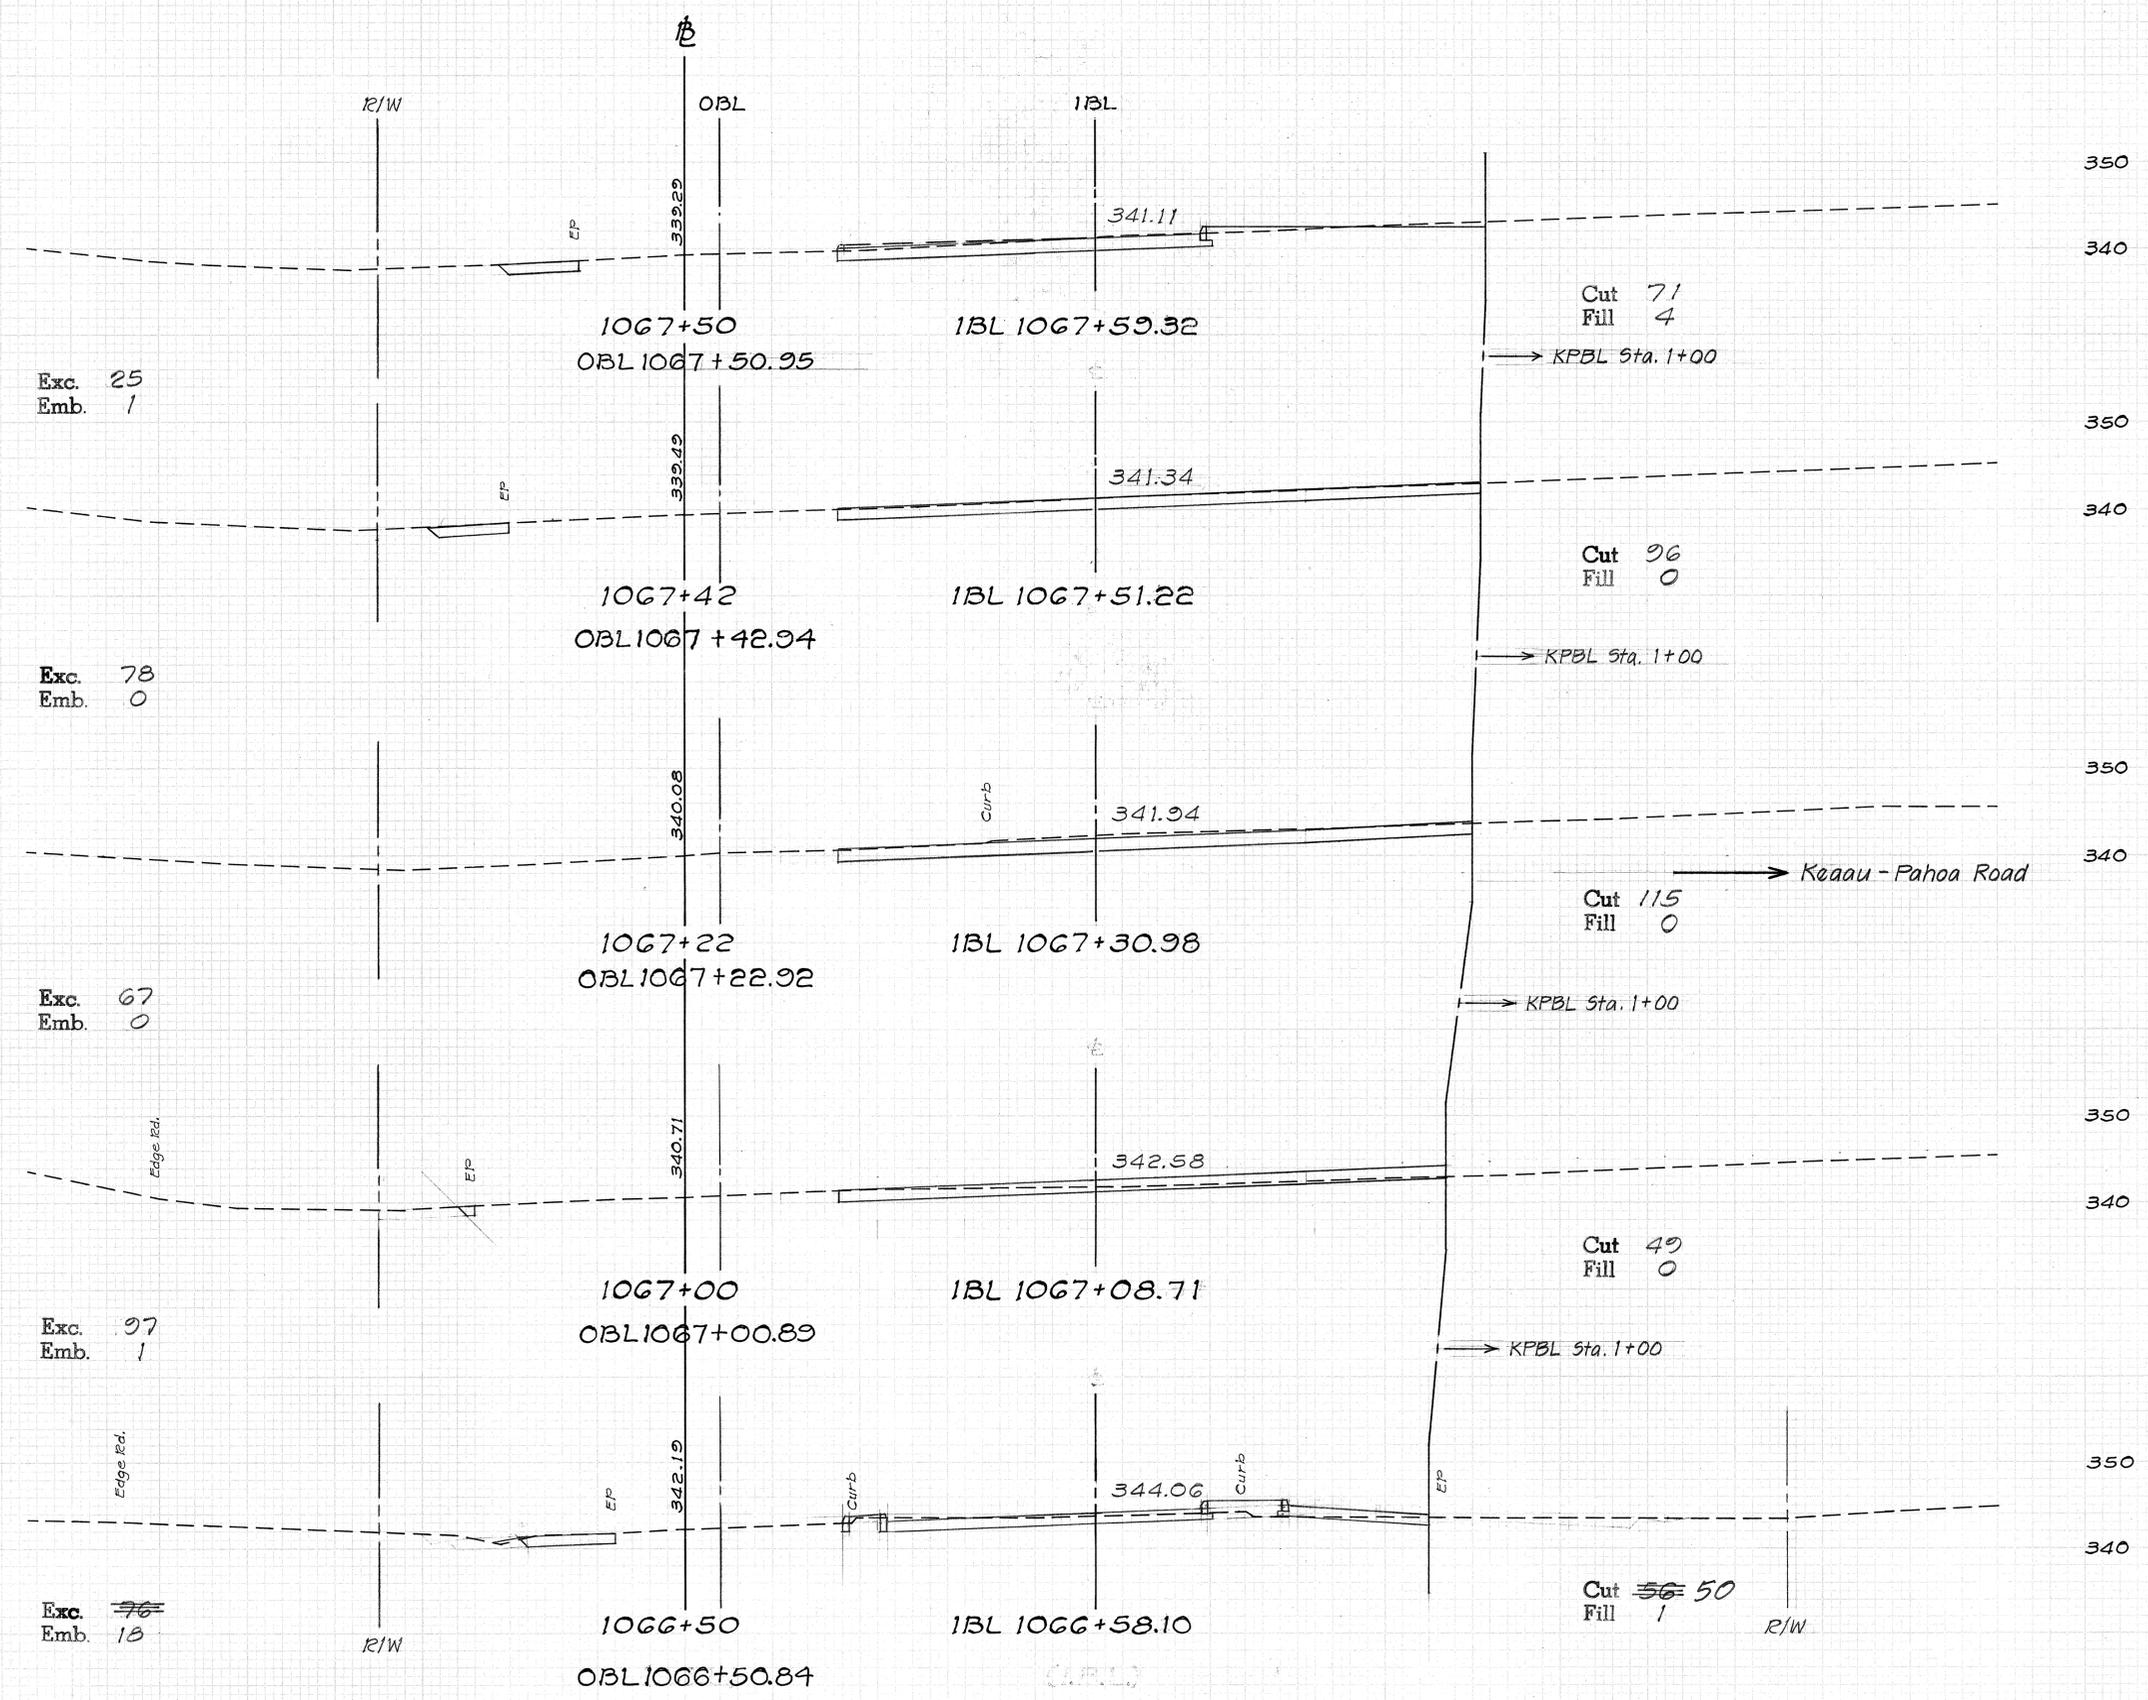

FED. ROAD DIST. NO.	STATE	PROJ. NO.	FISCAL YEAR	SHEET NO.	TOTAL SHEETS
HAWAII	HAW.	F-011-2(17)	1986	129	142


DATE	
BY	
ORIGINAL SURVEY	
REVISIONS	
NOTE BOOK	
TEMPERATURE	
AREAS	
CHECKED	
NO.	

DATE	
BY	
ORIGINAL SURVEY	
REVISIONS	
NOTE BOOK	
TEMPERATURE	
AREAS	
CHECKED	
NO.	

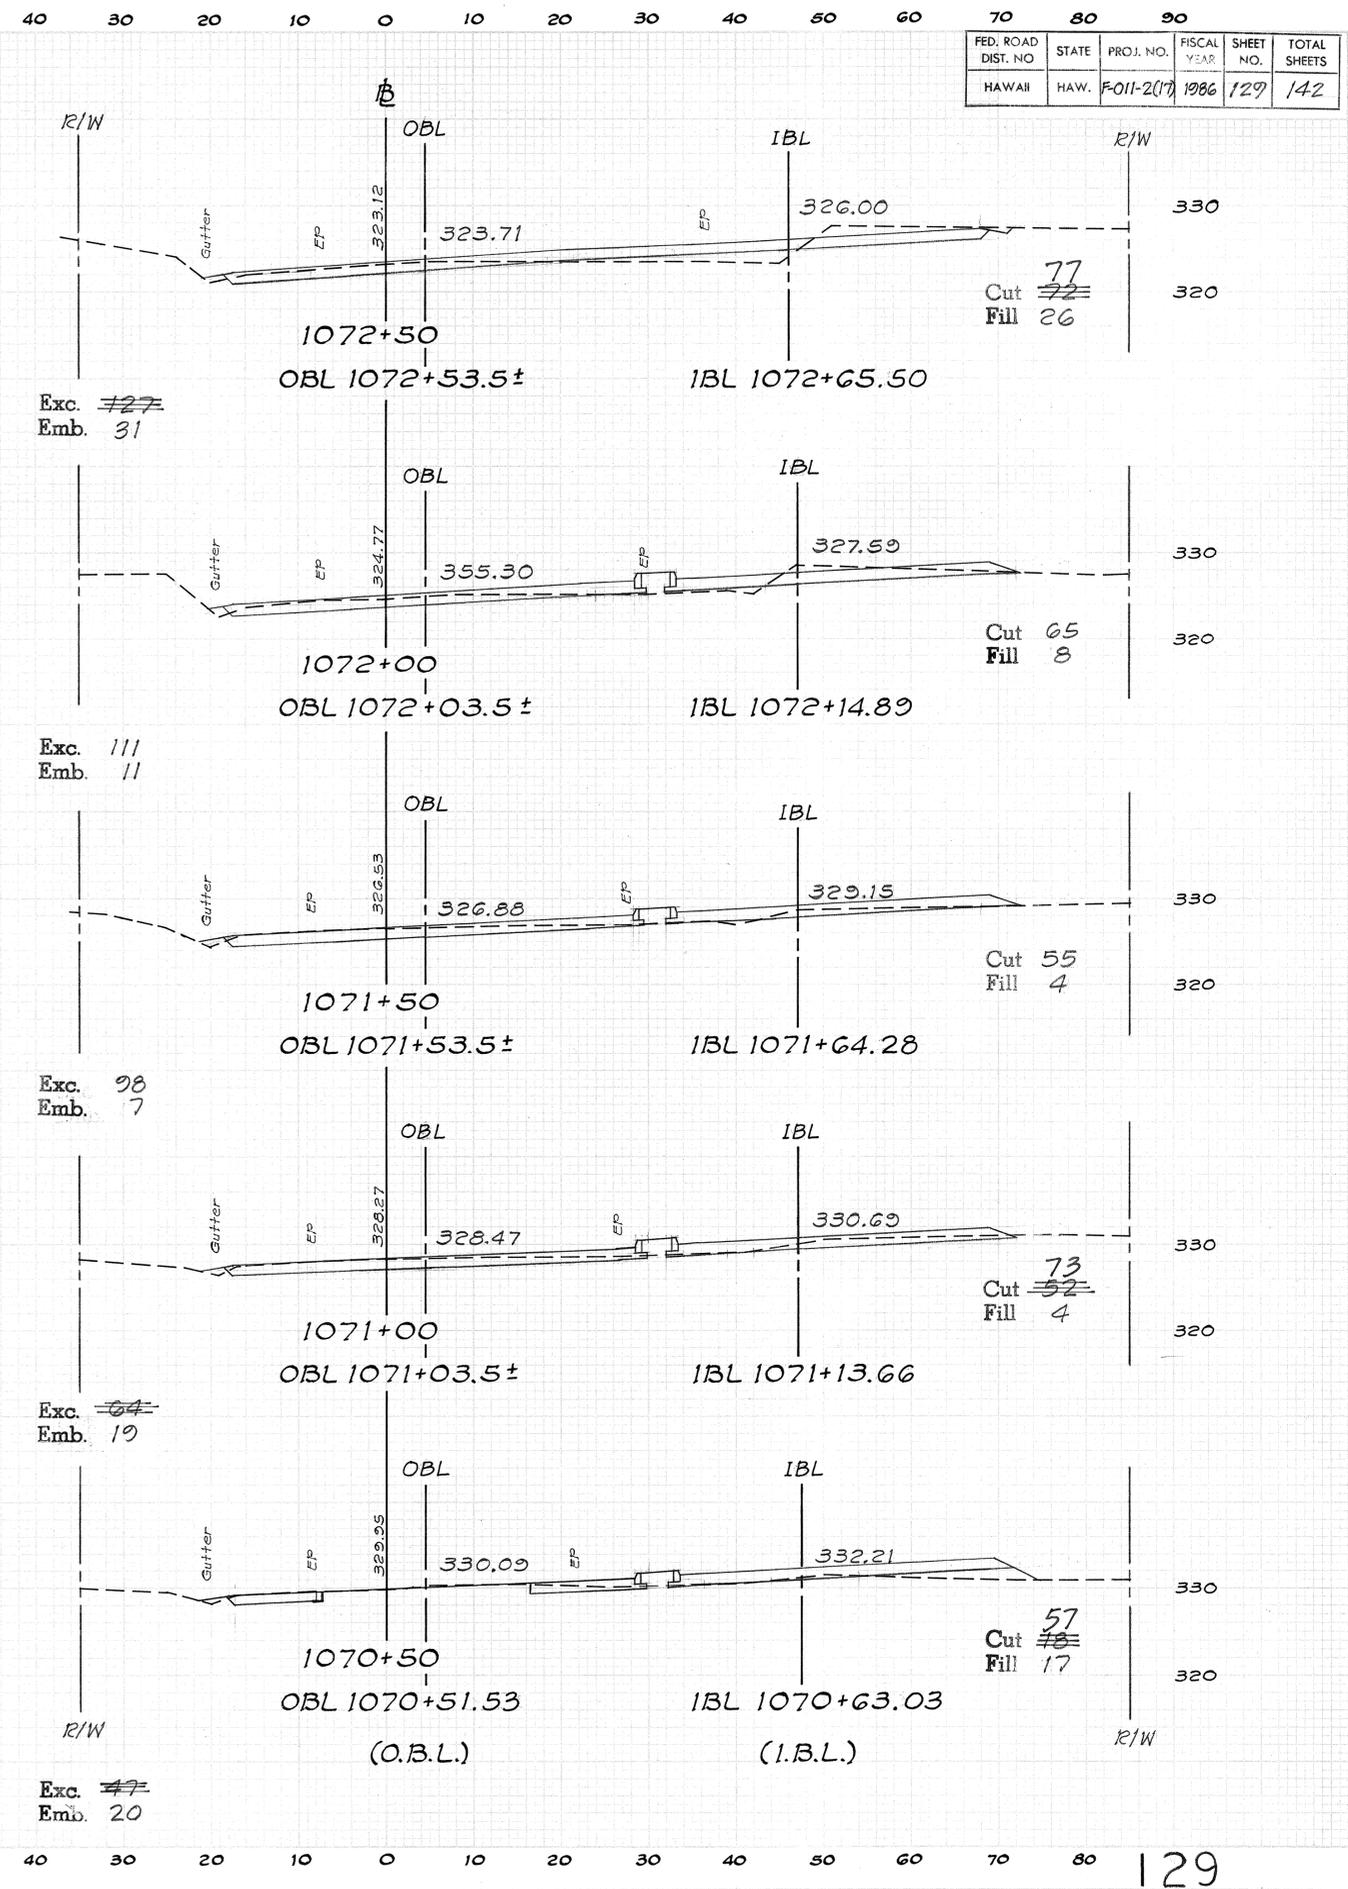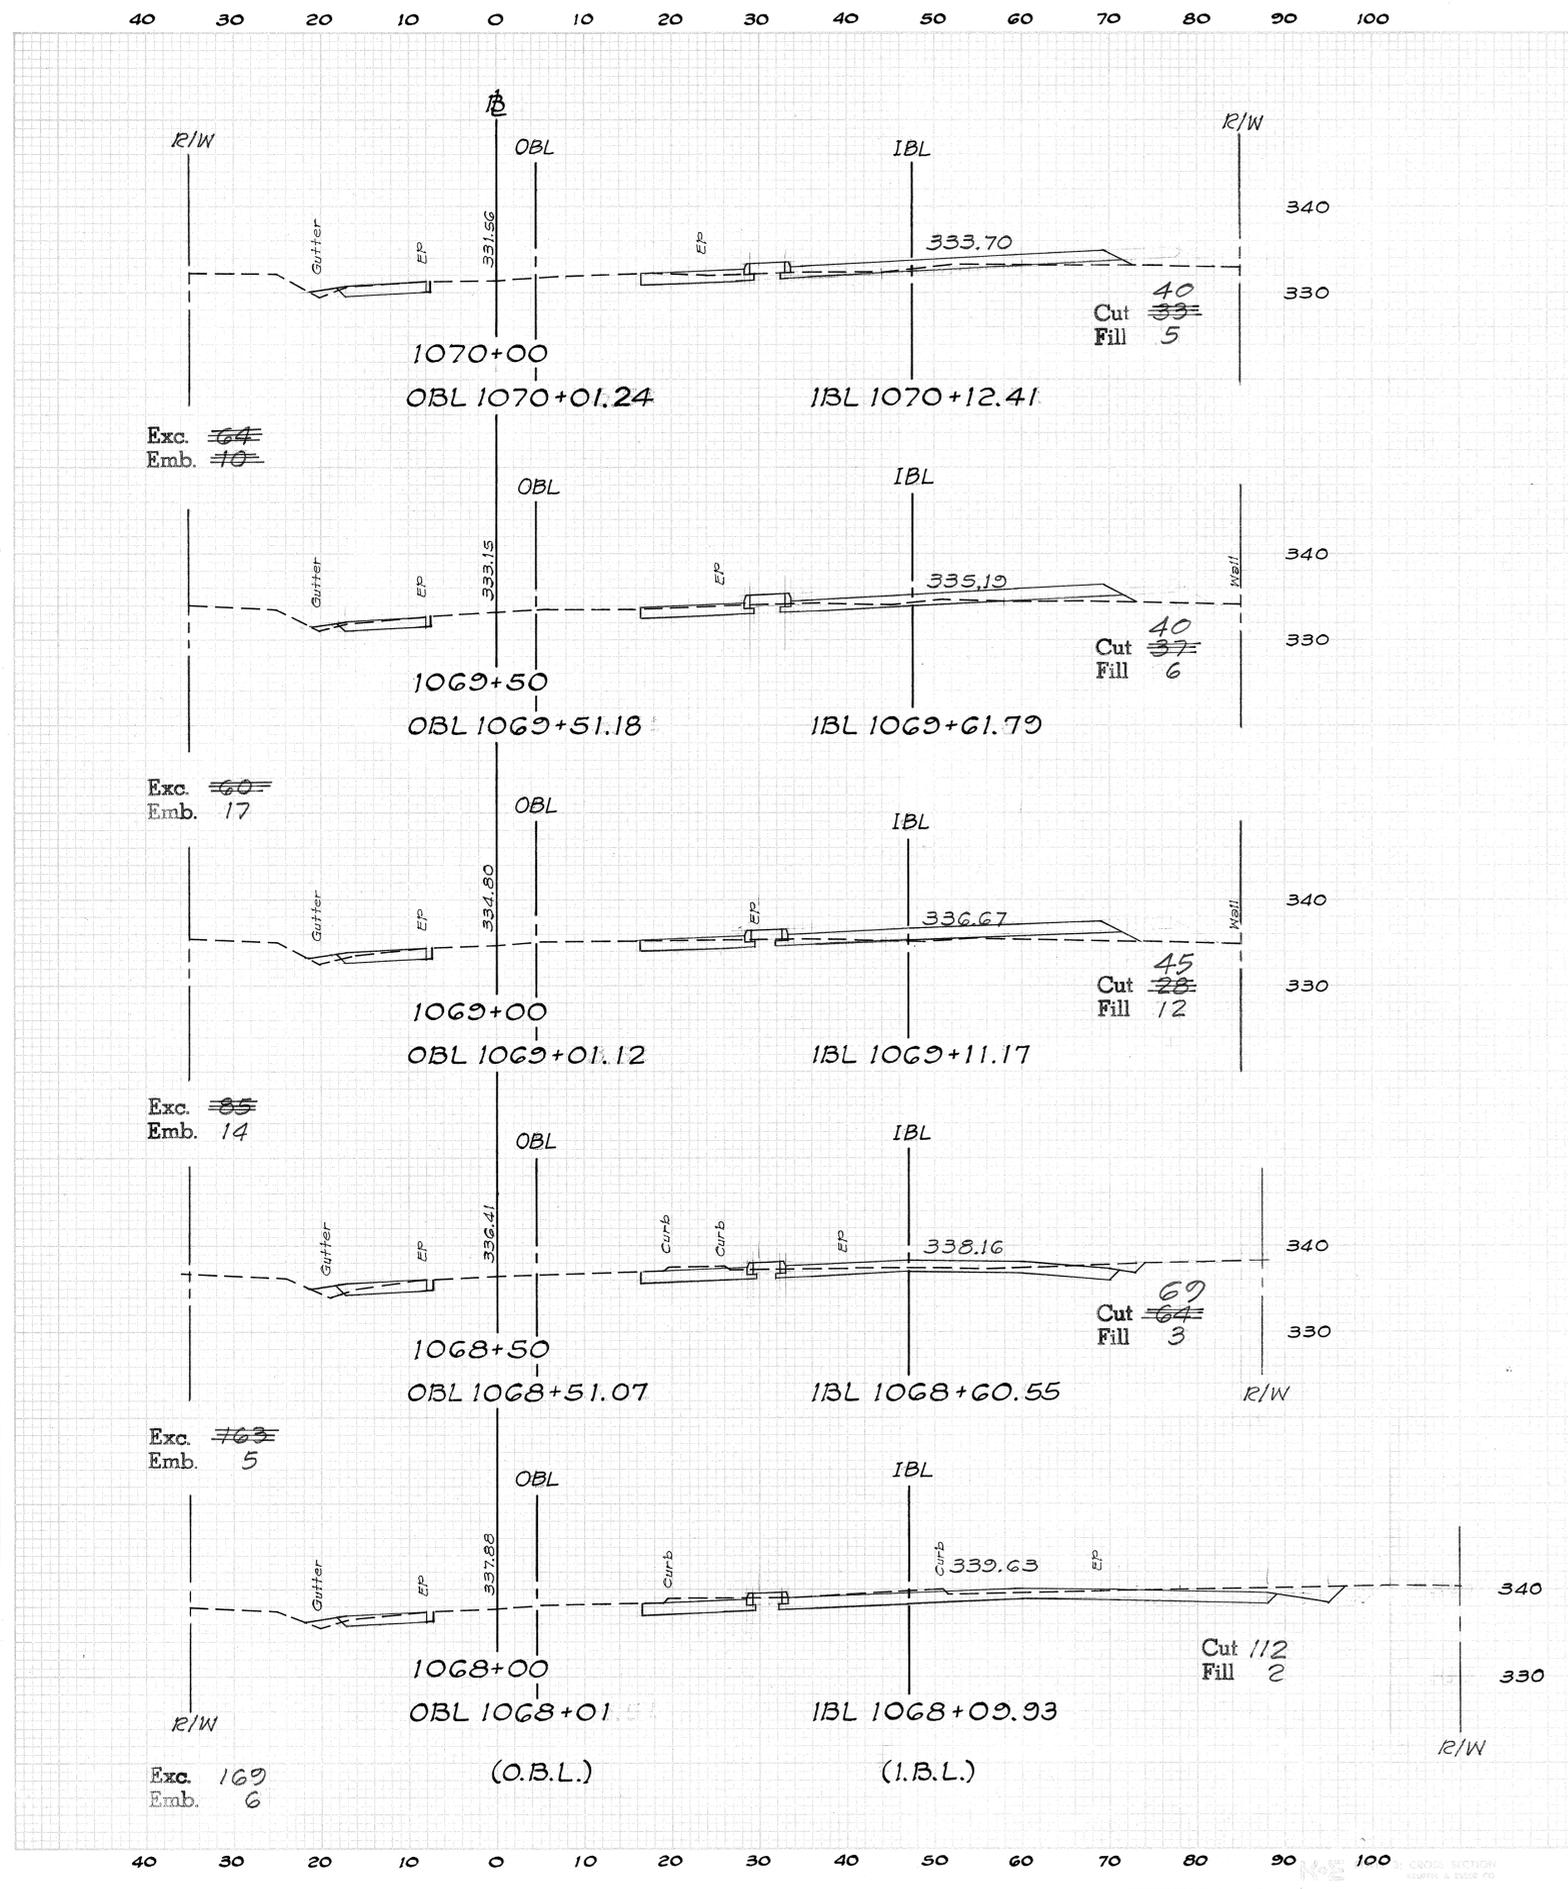


FED. ROAD DIST. NO.	STATE	PROJ. NO.	FISCAL YEAR	SHEET NO.	TOTAL SHEETS
HAWAII	HAW.	F-011-2(17)	1986	130	142

40 30 20 10 0 10 20 30 40 50 60 70 80 90

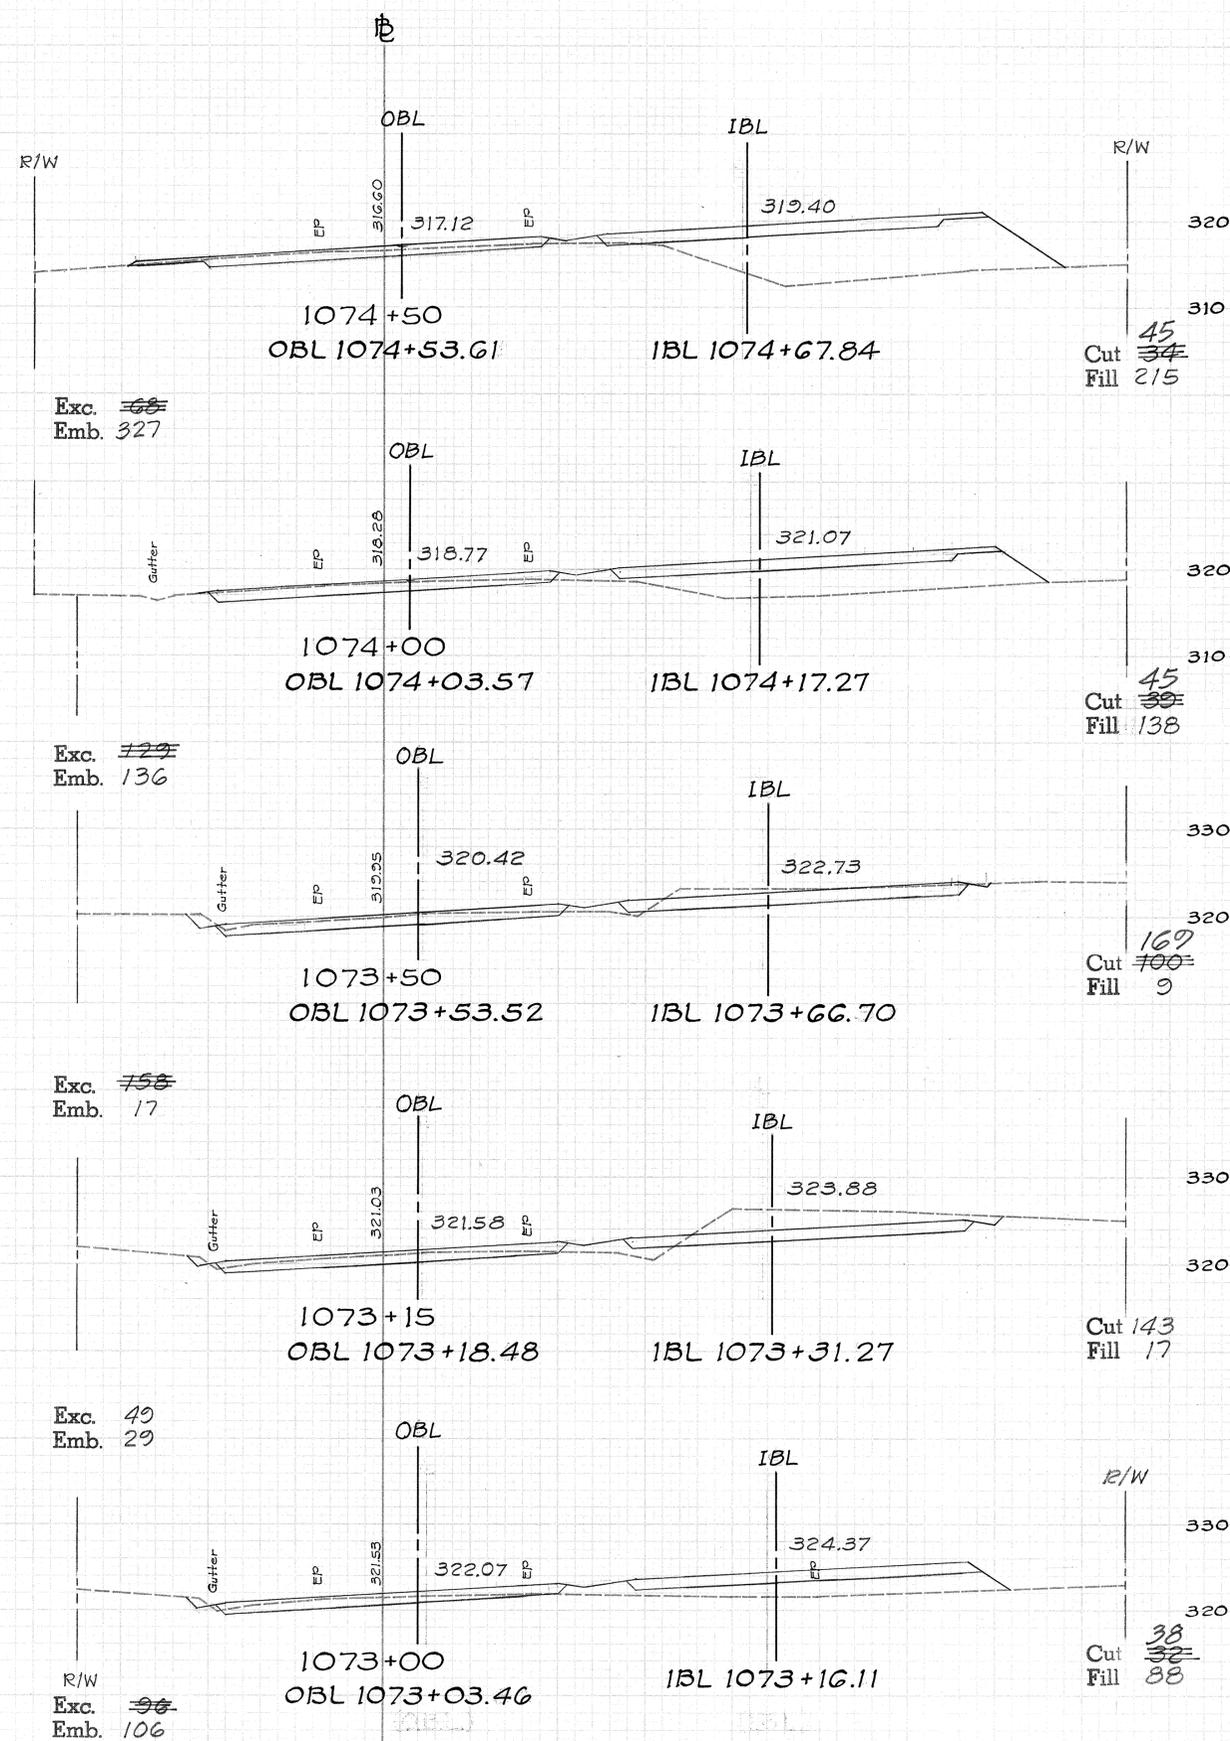

40 30 20 10 0 10 20 30 40 50 60 70 80 90

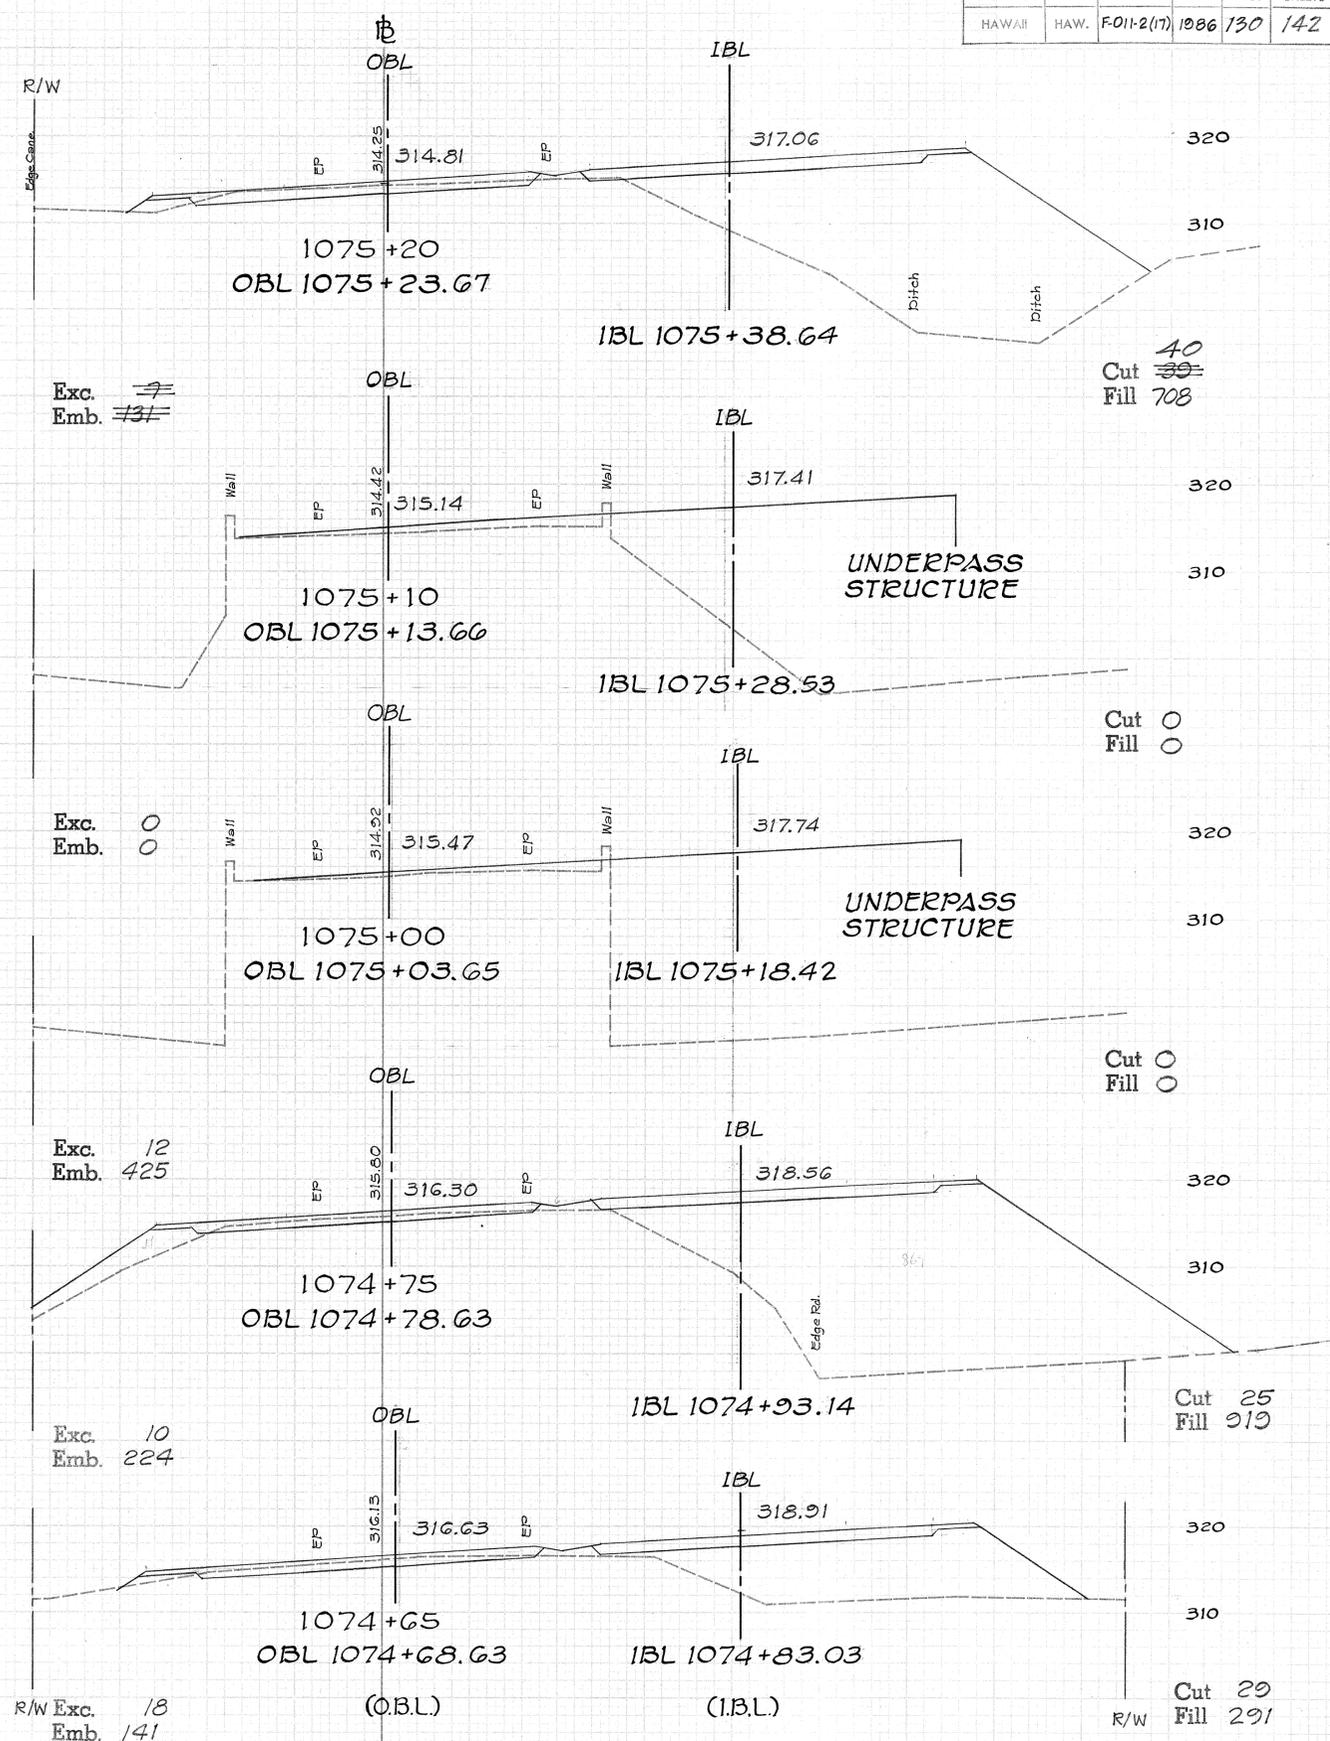



DATE: _____
 BY: _____
 SURVEYED: _____
 CHECKED: _____
 FINAL SURVEY: _____
 NOTE BOOK: _____
 TEMPLATE: _____
 AREAS: _____
 AREAS CHECKED: _____

DATE: _____
 BY: _____
 SURVEYED: _____
 CHECKED: _____
 ORIGINAL SURVEY: _____
 NOTE BOOK: _____
 TEMPLATE: _____
 AREAS: _____
 AREAS CHECKED: _____

FED. ROAD DIST. NO.	STATE	PROJ. NO.	FISCAL YEAR	SHEET NO.	TOTAL SHEETS
HAWAII	HAW.	F-011-2(17)	1986	131	142

DATE: _____
 BY: _____
 ORIGINAL SURVEY PLOTTED: _____
 SURVEY PLOTTED: _____
 NOTE BOOK TEMPLATE: _____
 INK: _____
 NO. 11/5-27
 CHECKS CHECKED: _____



DATE: _____
 BY: _____
 ORIGINAL SURVEY PLOTTED: _____
 SURVEY PLOTTED: _____
 NOTE BOOK TEMPLATE: _____
 INK: _____
 NO. 11/5-27
 CHECKS CHECKED: _____

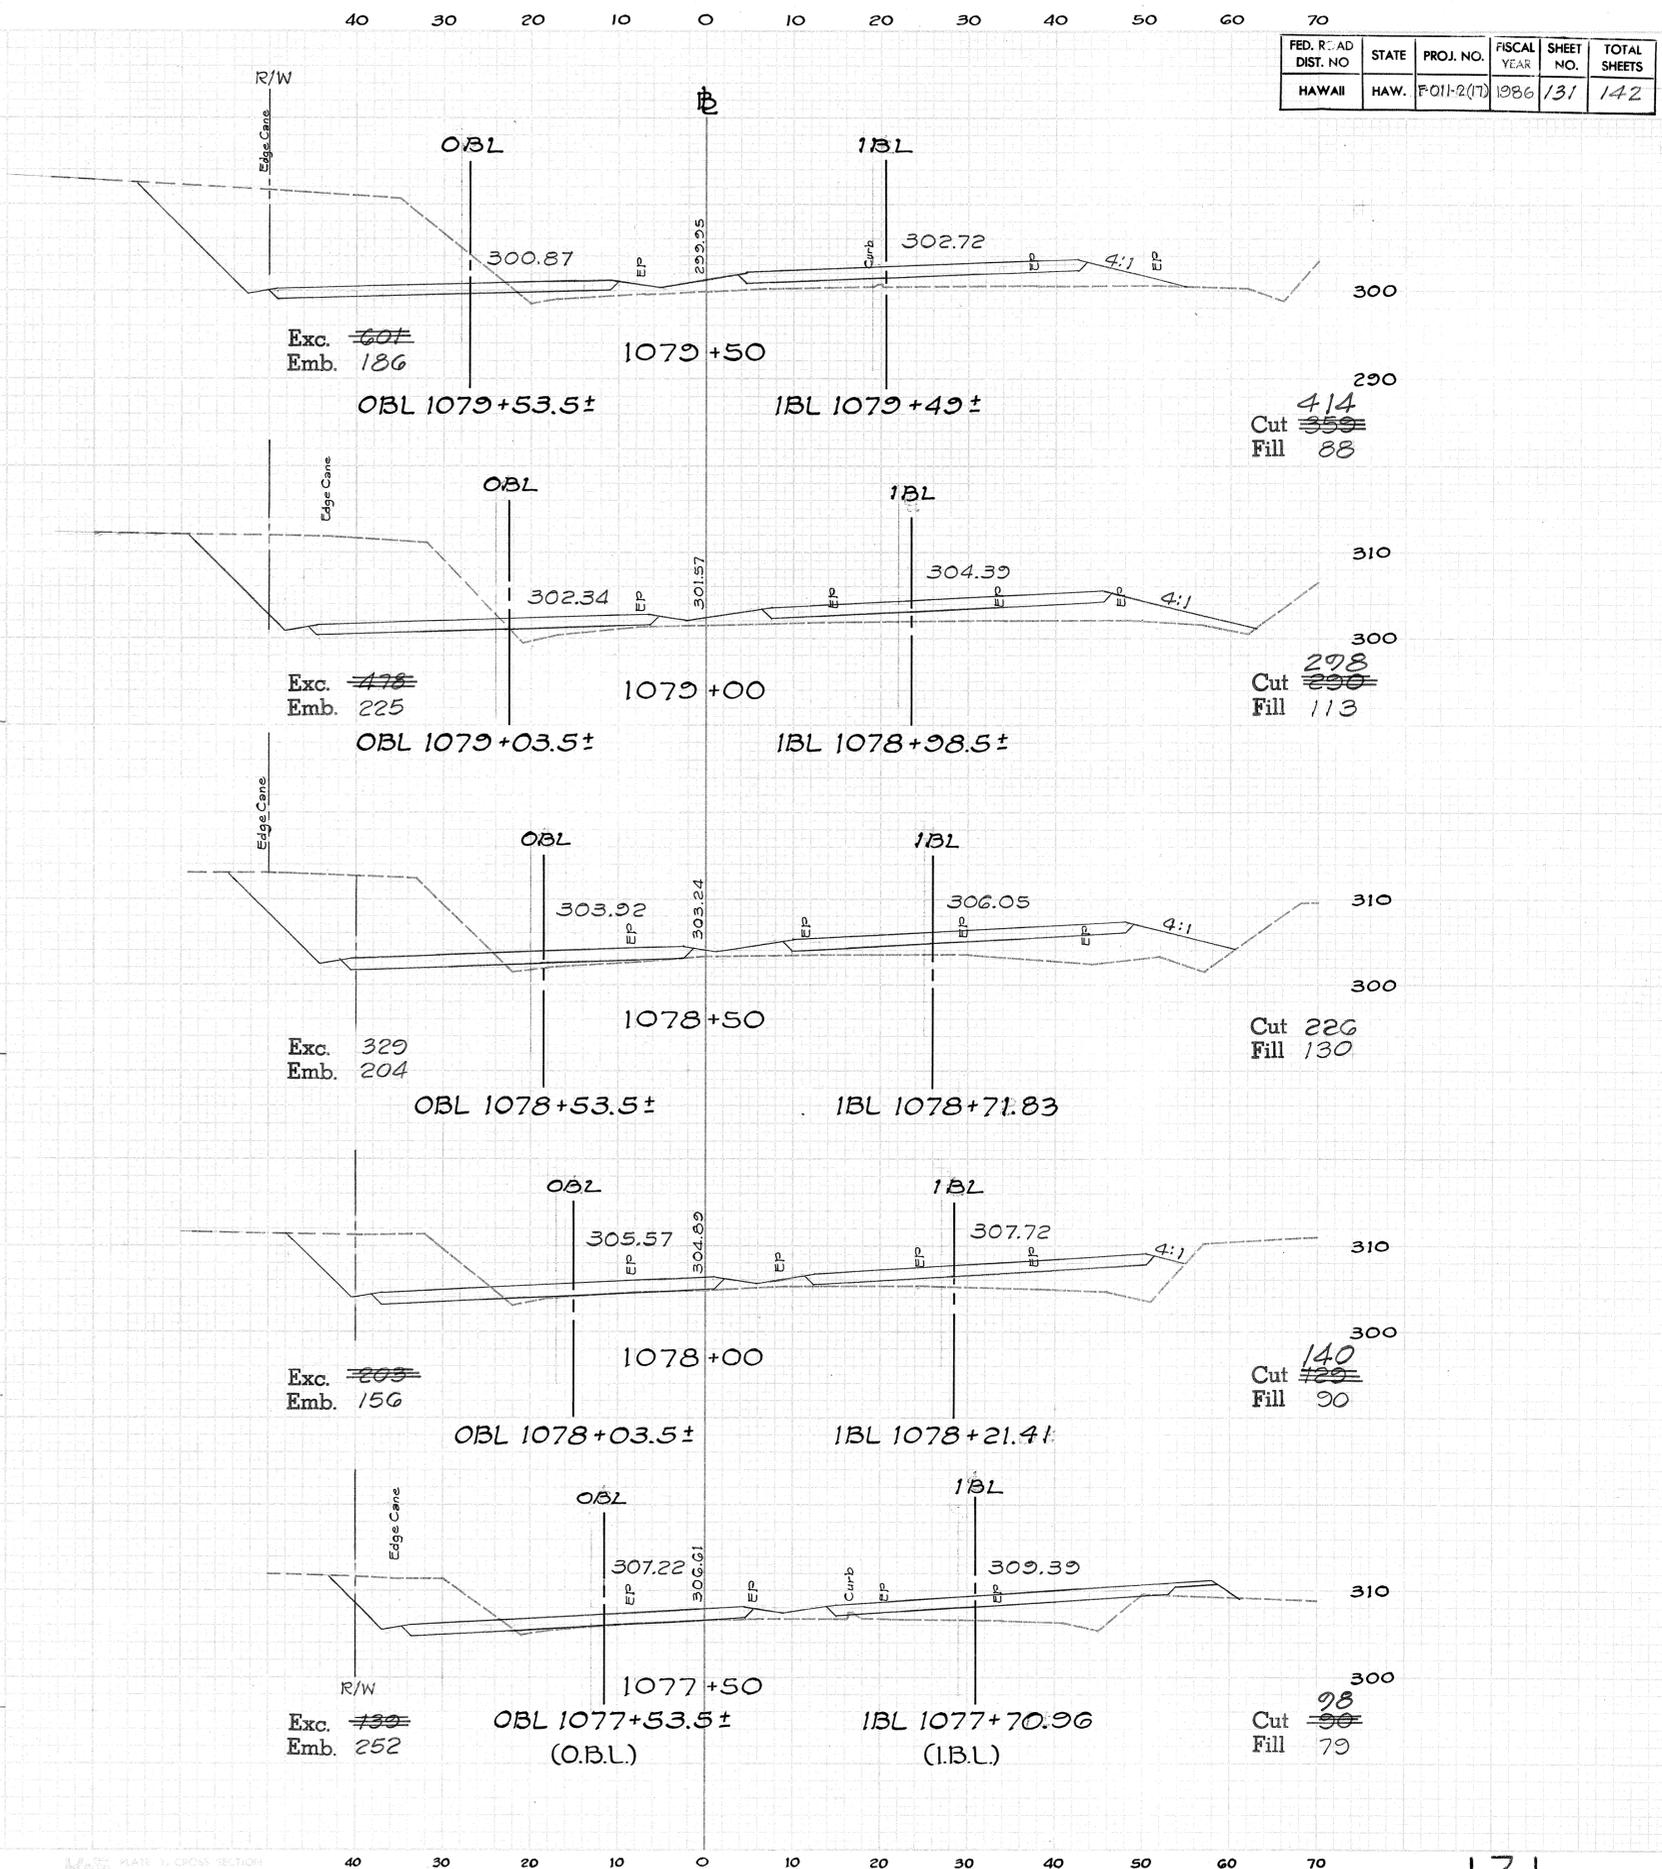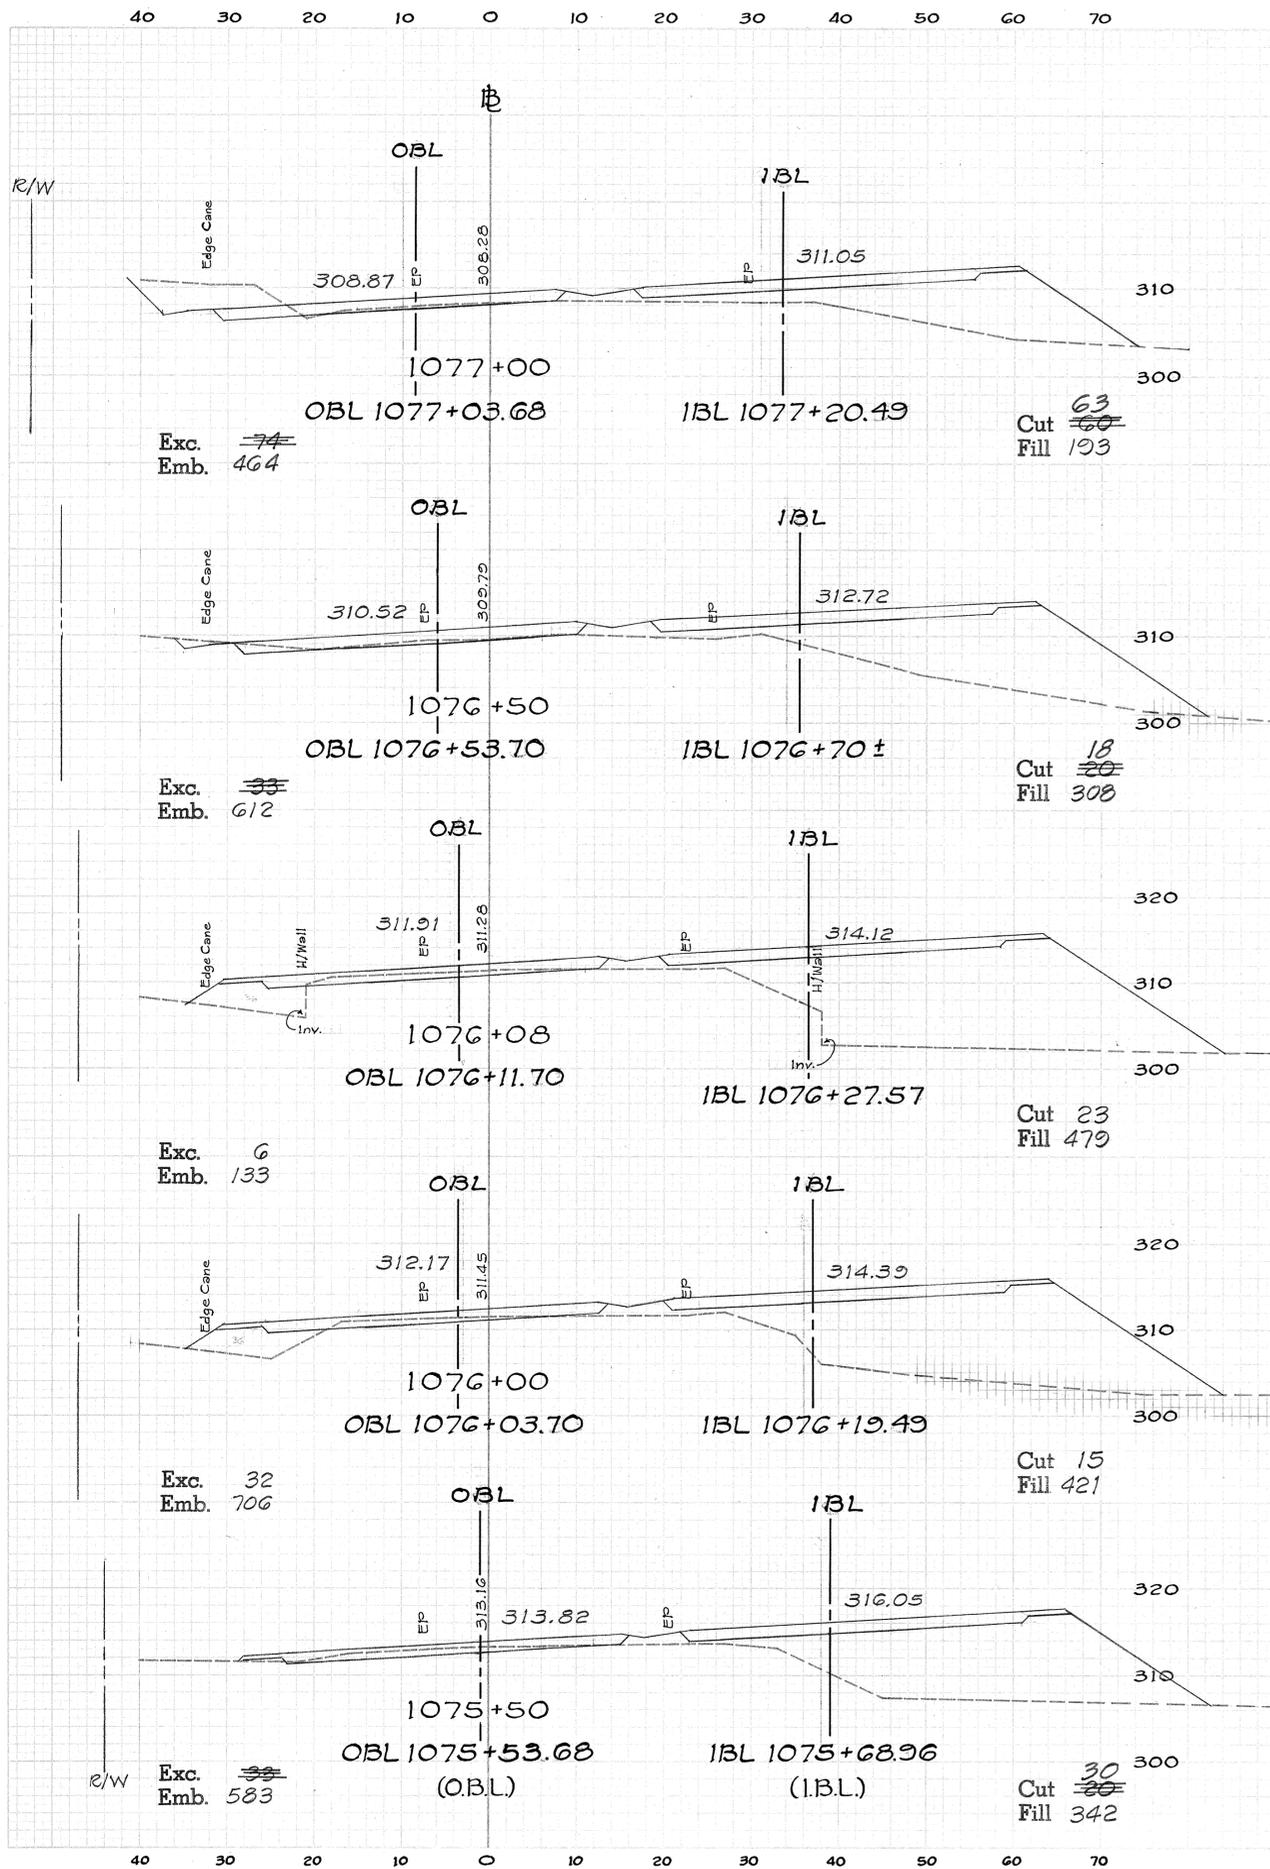

FED. ROAD DIST. NO.	STATE	PROJ. NO.	FISCAL YEAR	SHEET NO.	TOTAL SHEETS
HAWAII	HAW.	F-011-2(17)	1986	132	142

DATE: _____
 BY: _____
 SURVEYED: _____
 PLOTTED: _____
 NOTE BOOK: _____
 TEMPLATE: _____
 NO. 11/5-29
 AREAS CHECKED: _____



DATE: _____
 BY: _____
 SURVEYED: _____
 PLOTTED: _____
 NOTE BOOK: _____
 TEMPLATE: _____
 NO. 11/5-29
 AREAS CHECKED: _____

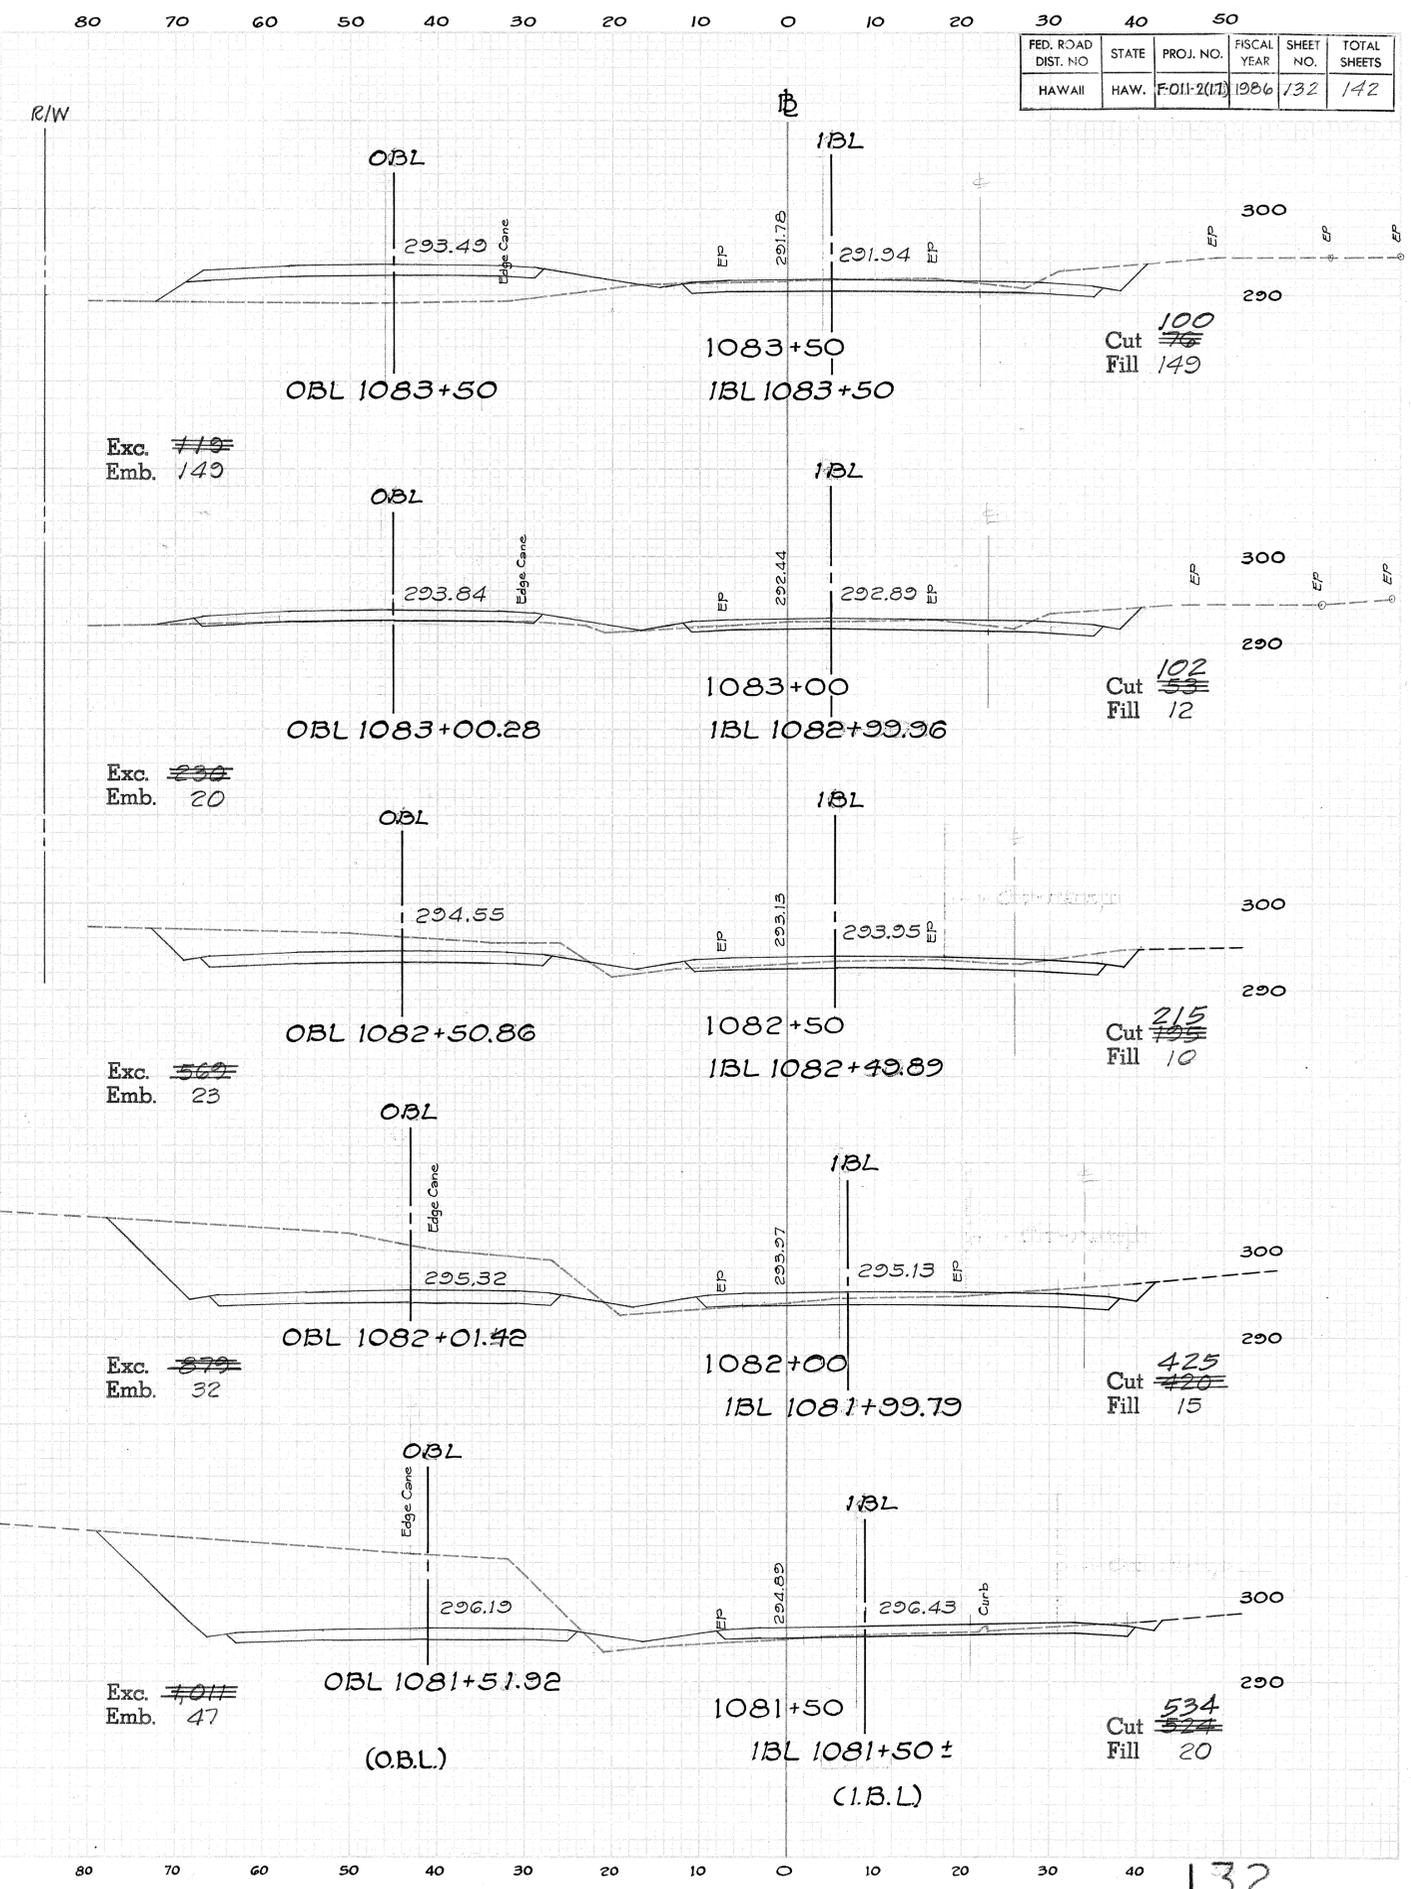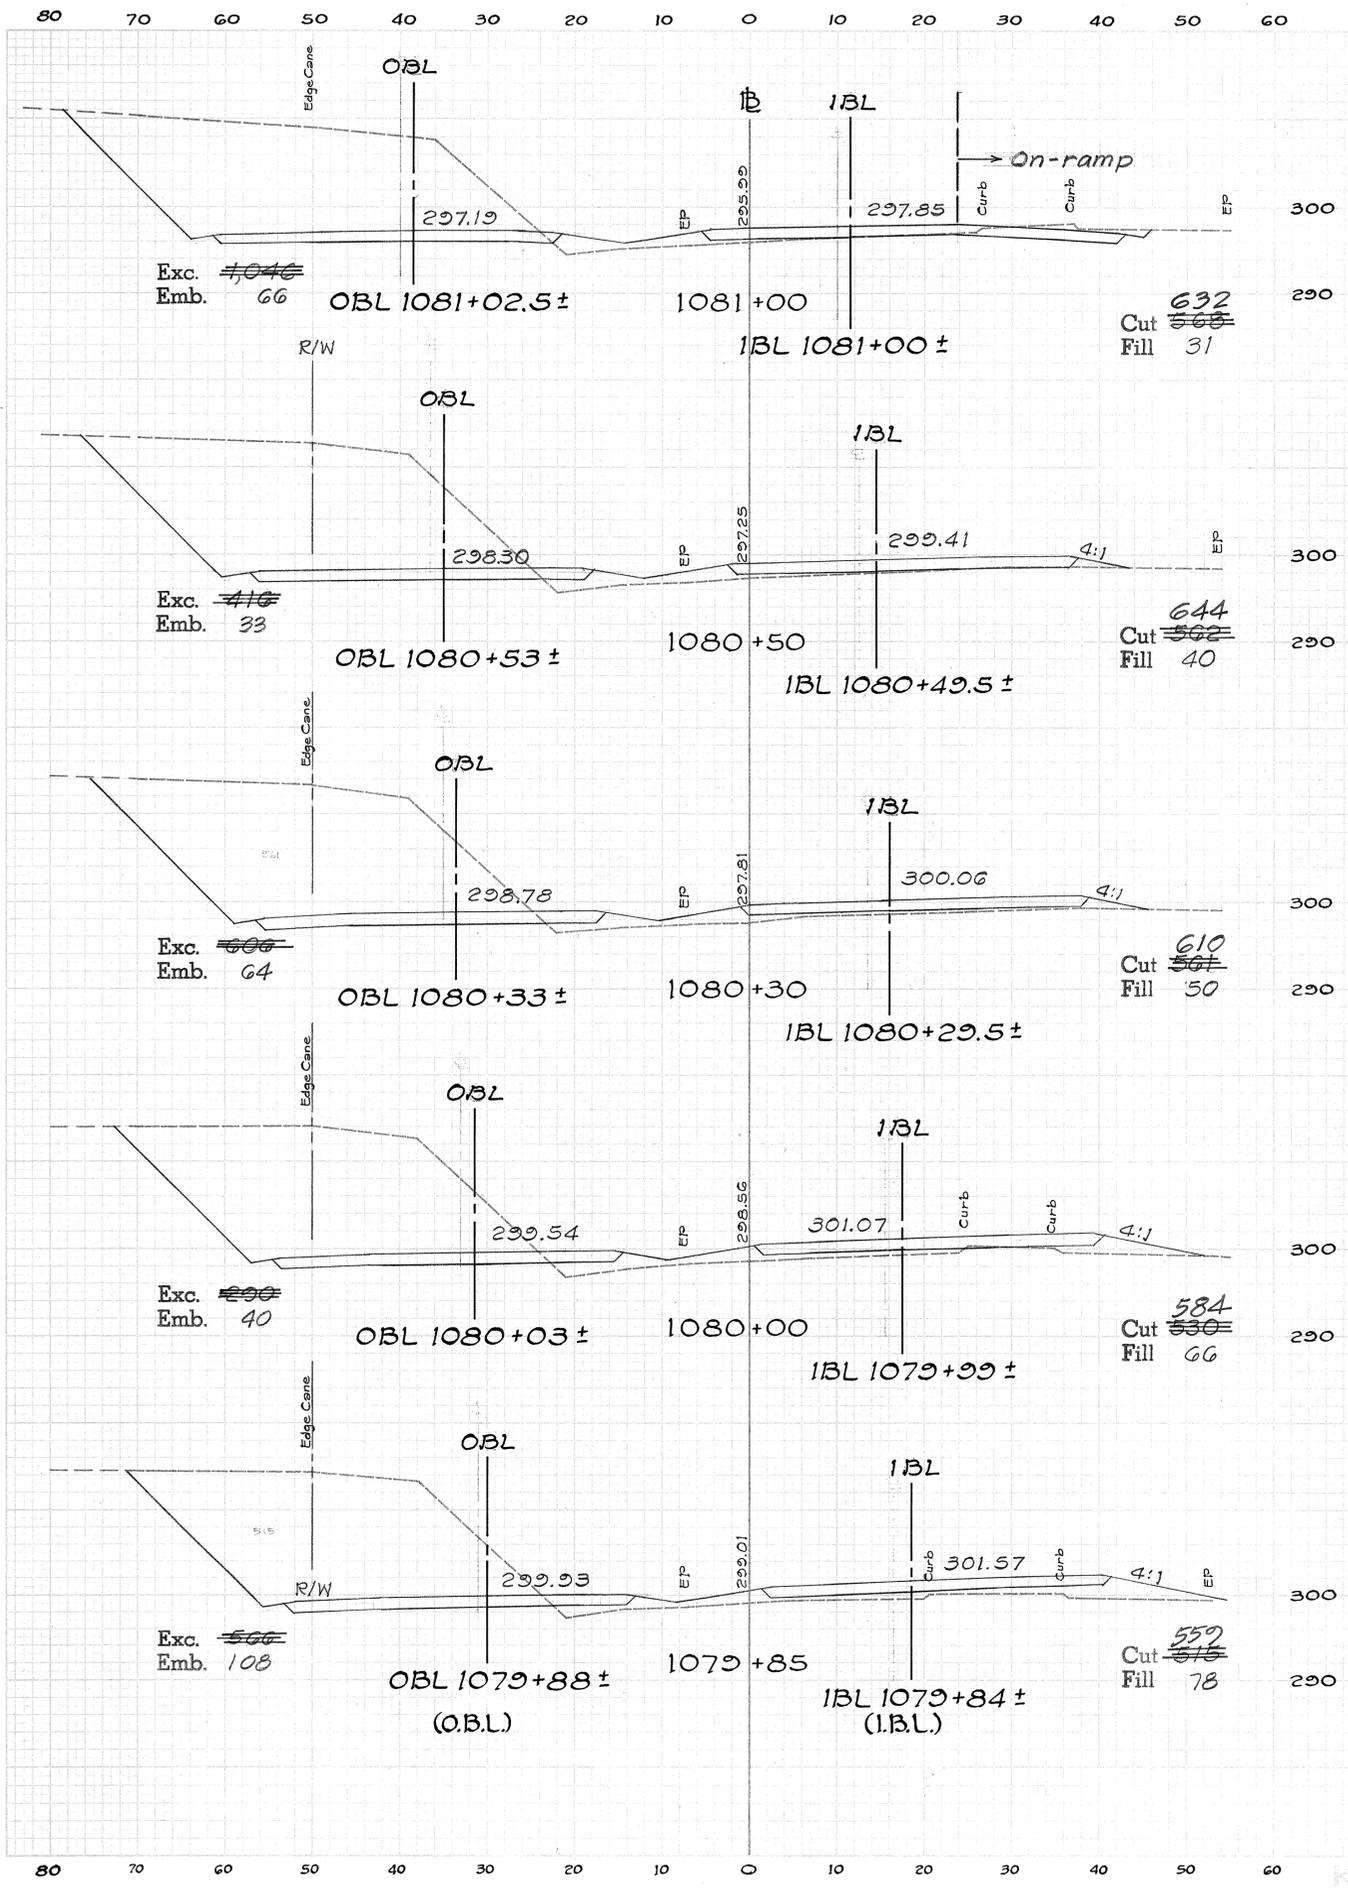

FED. ROAD DIST. NO.	STATE	PROJ. NO.	FISCAL YEAR	SHEET NO.	TOTAL SHEETS
HAWAII	HAW.	FO11-2(17)	1986	134	142

DATE	
BY	
ORIGINAL SURVEYED	
SURVEY PLOTTED	
FINAL SURVEY PLOTTED	
NOTE BOOK TEMPLATE	
NO. 11/5/84	
AREAS CHECKED	

DATE	
BY	
ORIGINAL SURVEYED	
SURVEY PLOTTED	
FINAL SURVEY PLOTTED	
NOTE BOOK TEMPLATE	
NO. 11/5/84	
AREAS CHECKED	

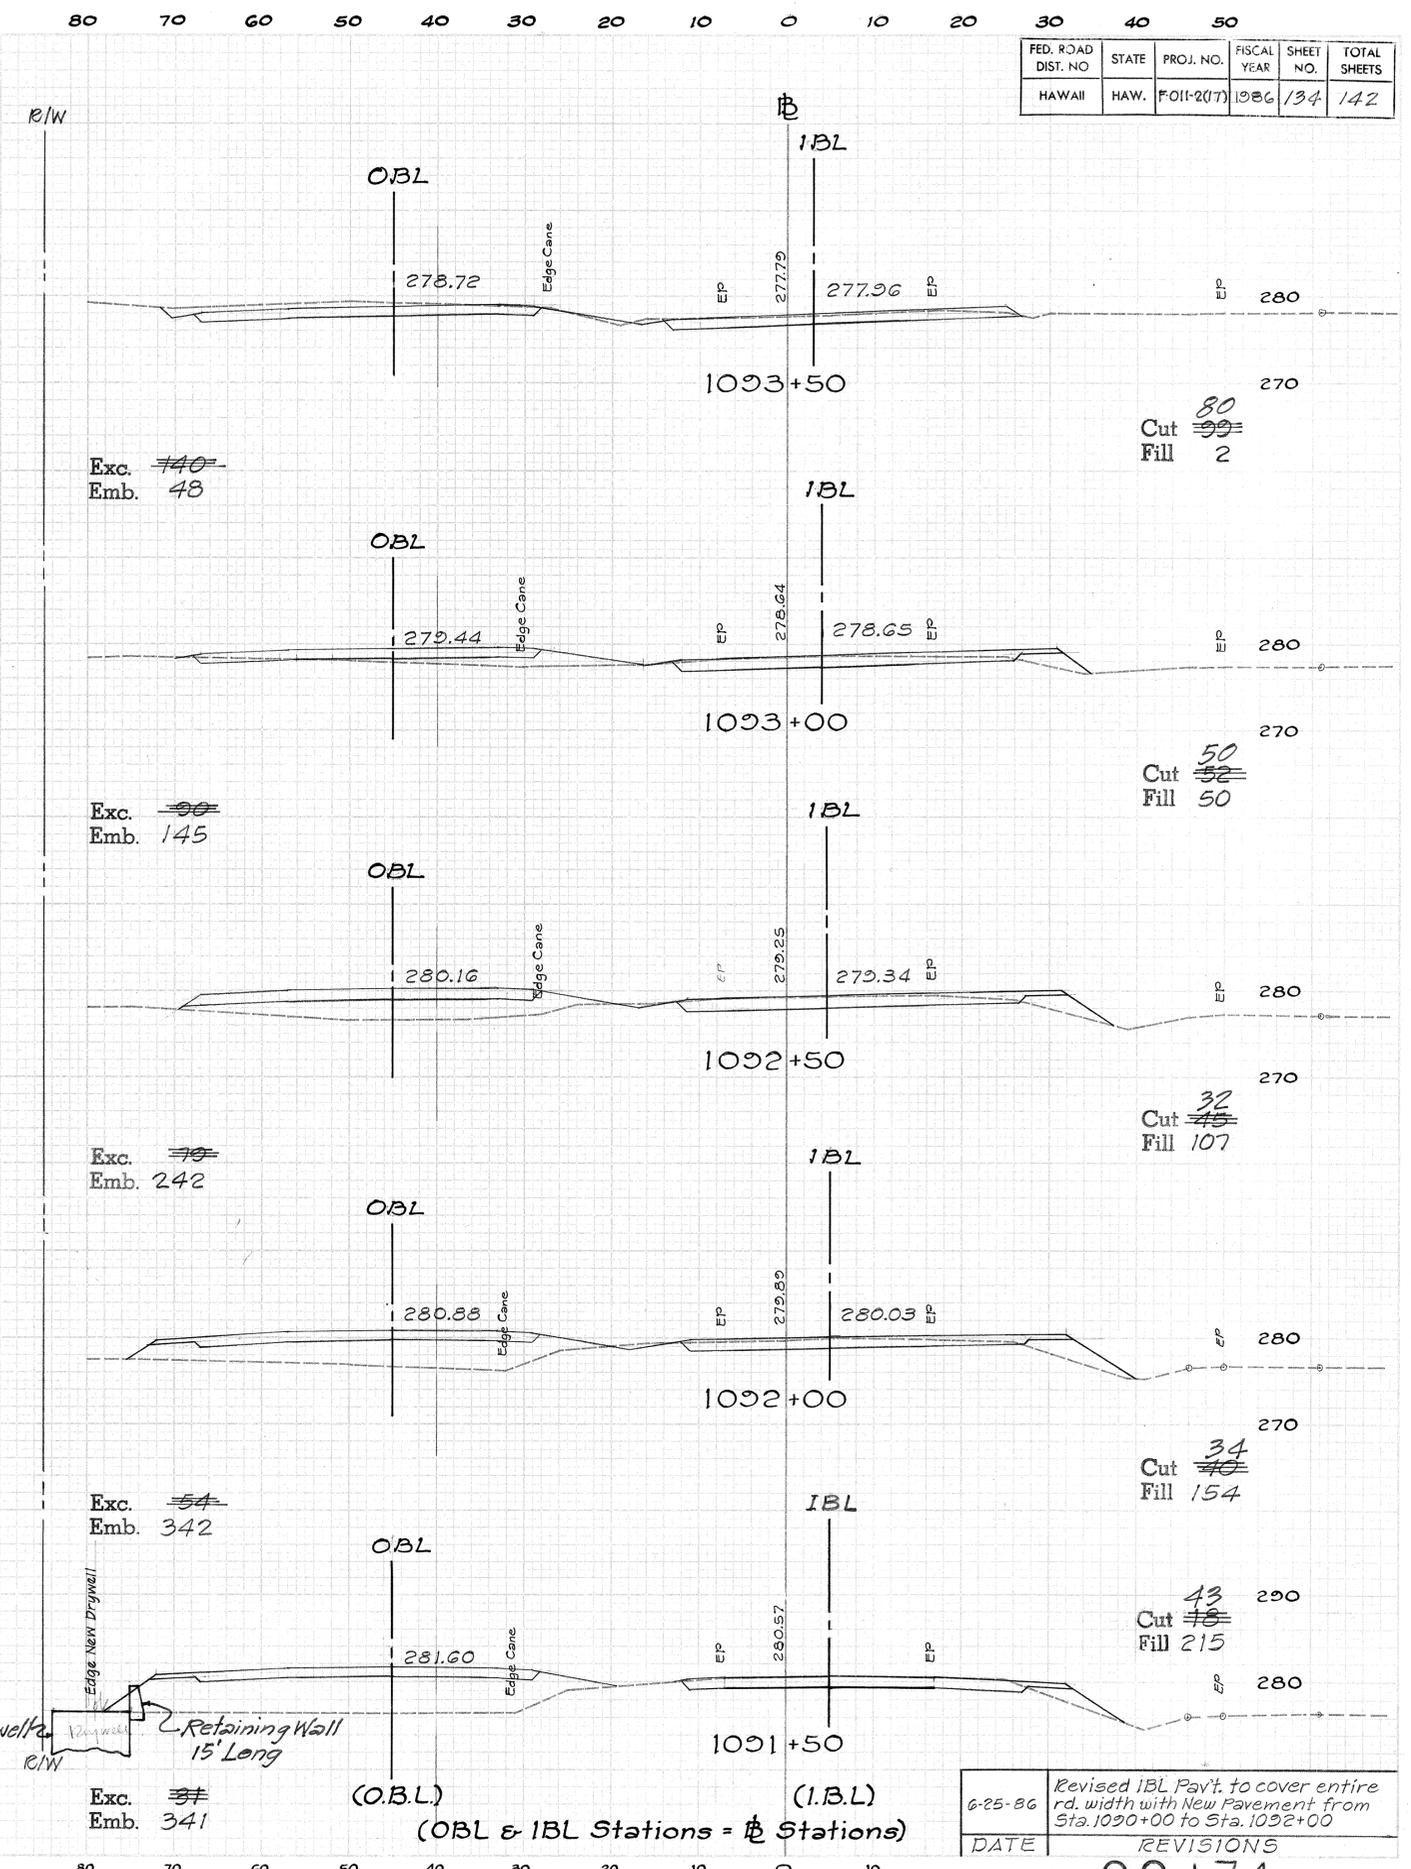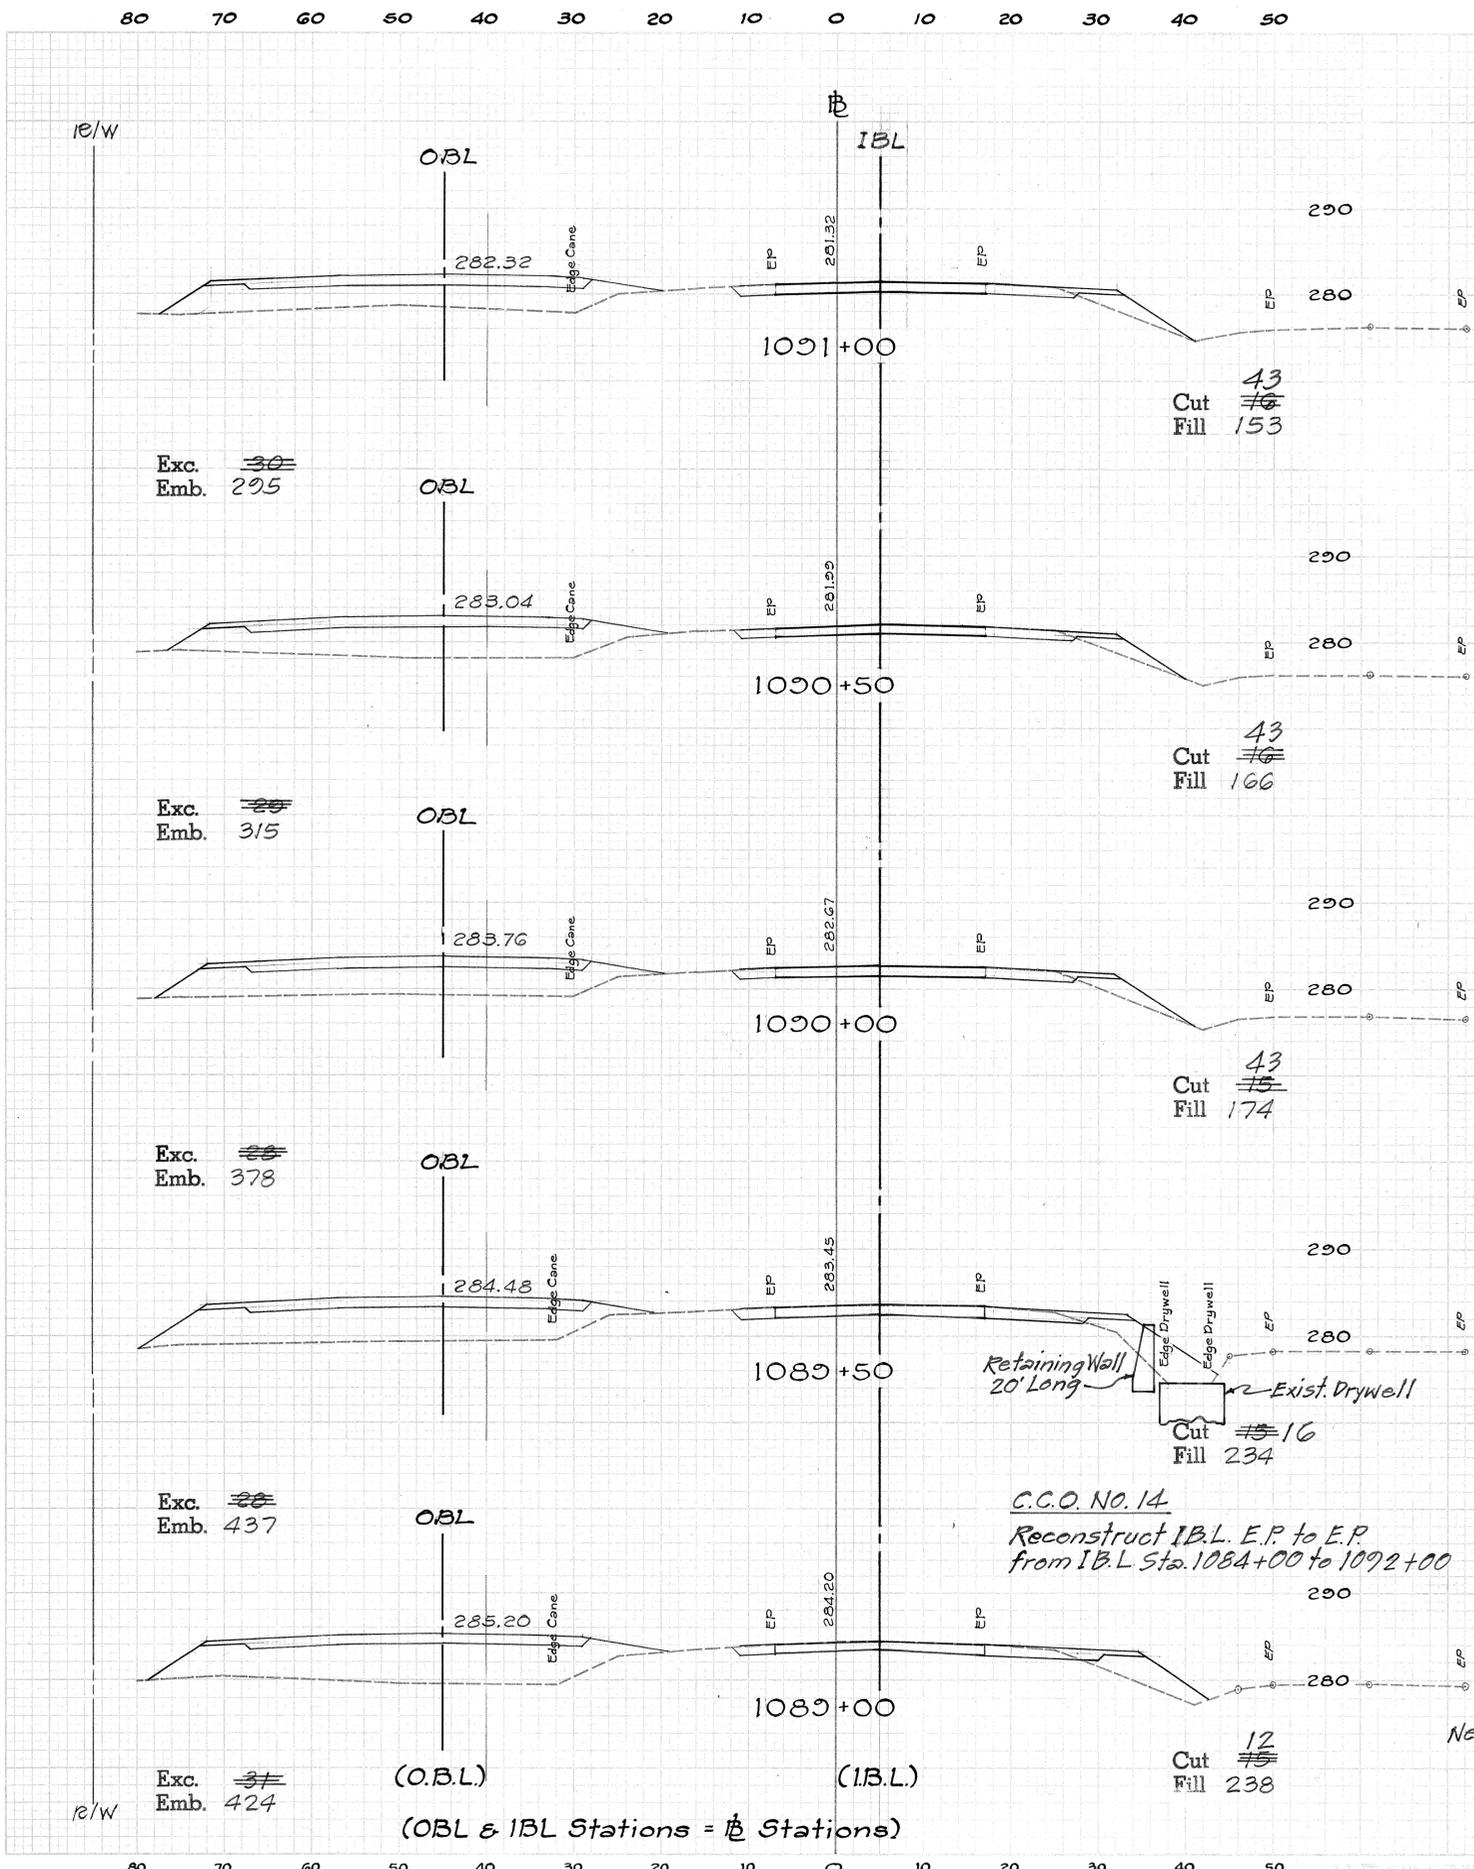


DATE	6-25-86	REVISIONS	Revised IBL Pav't. to cover entire rd. width with New Pavement from Sta. 1090+00 to Sta. 1092+00
------	---------	-----------	--

C0134

FED. ROAD DIST. NO.	STATE	PROJ. NO.	FISCAL YEAR	SHEET NO.	TOTAL SHEETS
HAWAII	HAW.	FOI-2(17)	1986	135	142

DATE: _____
 BY: _____
 ORIGINAL SURVEY PLOTTED: _____
 SURVEY NOTE BOOK: _____
 NO. 11/15/86
 AREAS CHECKED: _____

DATE: _____
 BY: _____
 ORIGINAL SURVEY PLOTTED: _____
 SURVEY NOTE BOOK: _____
 NO. 11/15/86
 AREAS CHECKED: _____

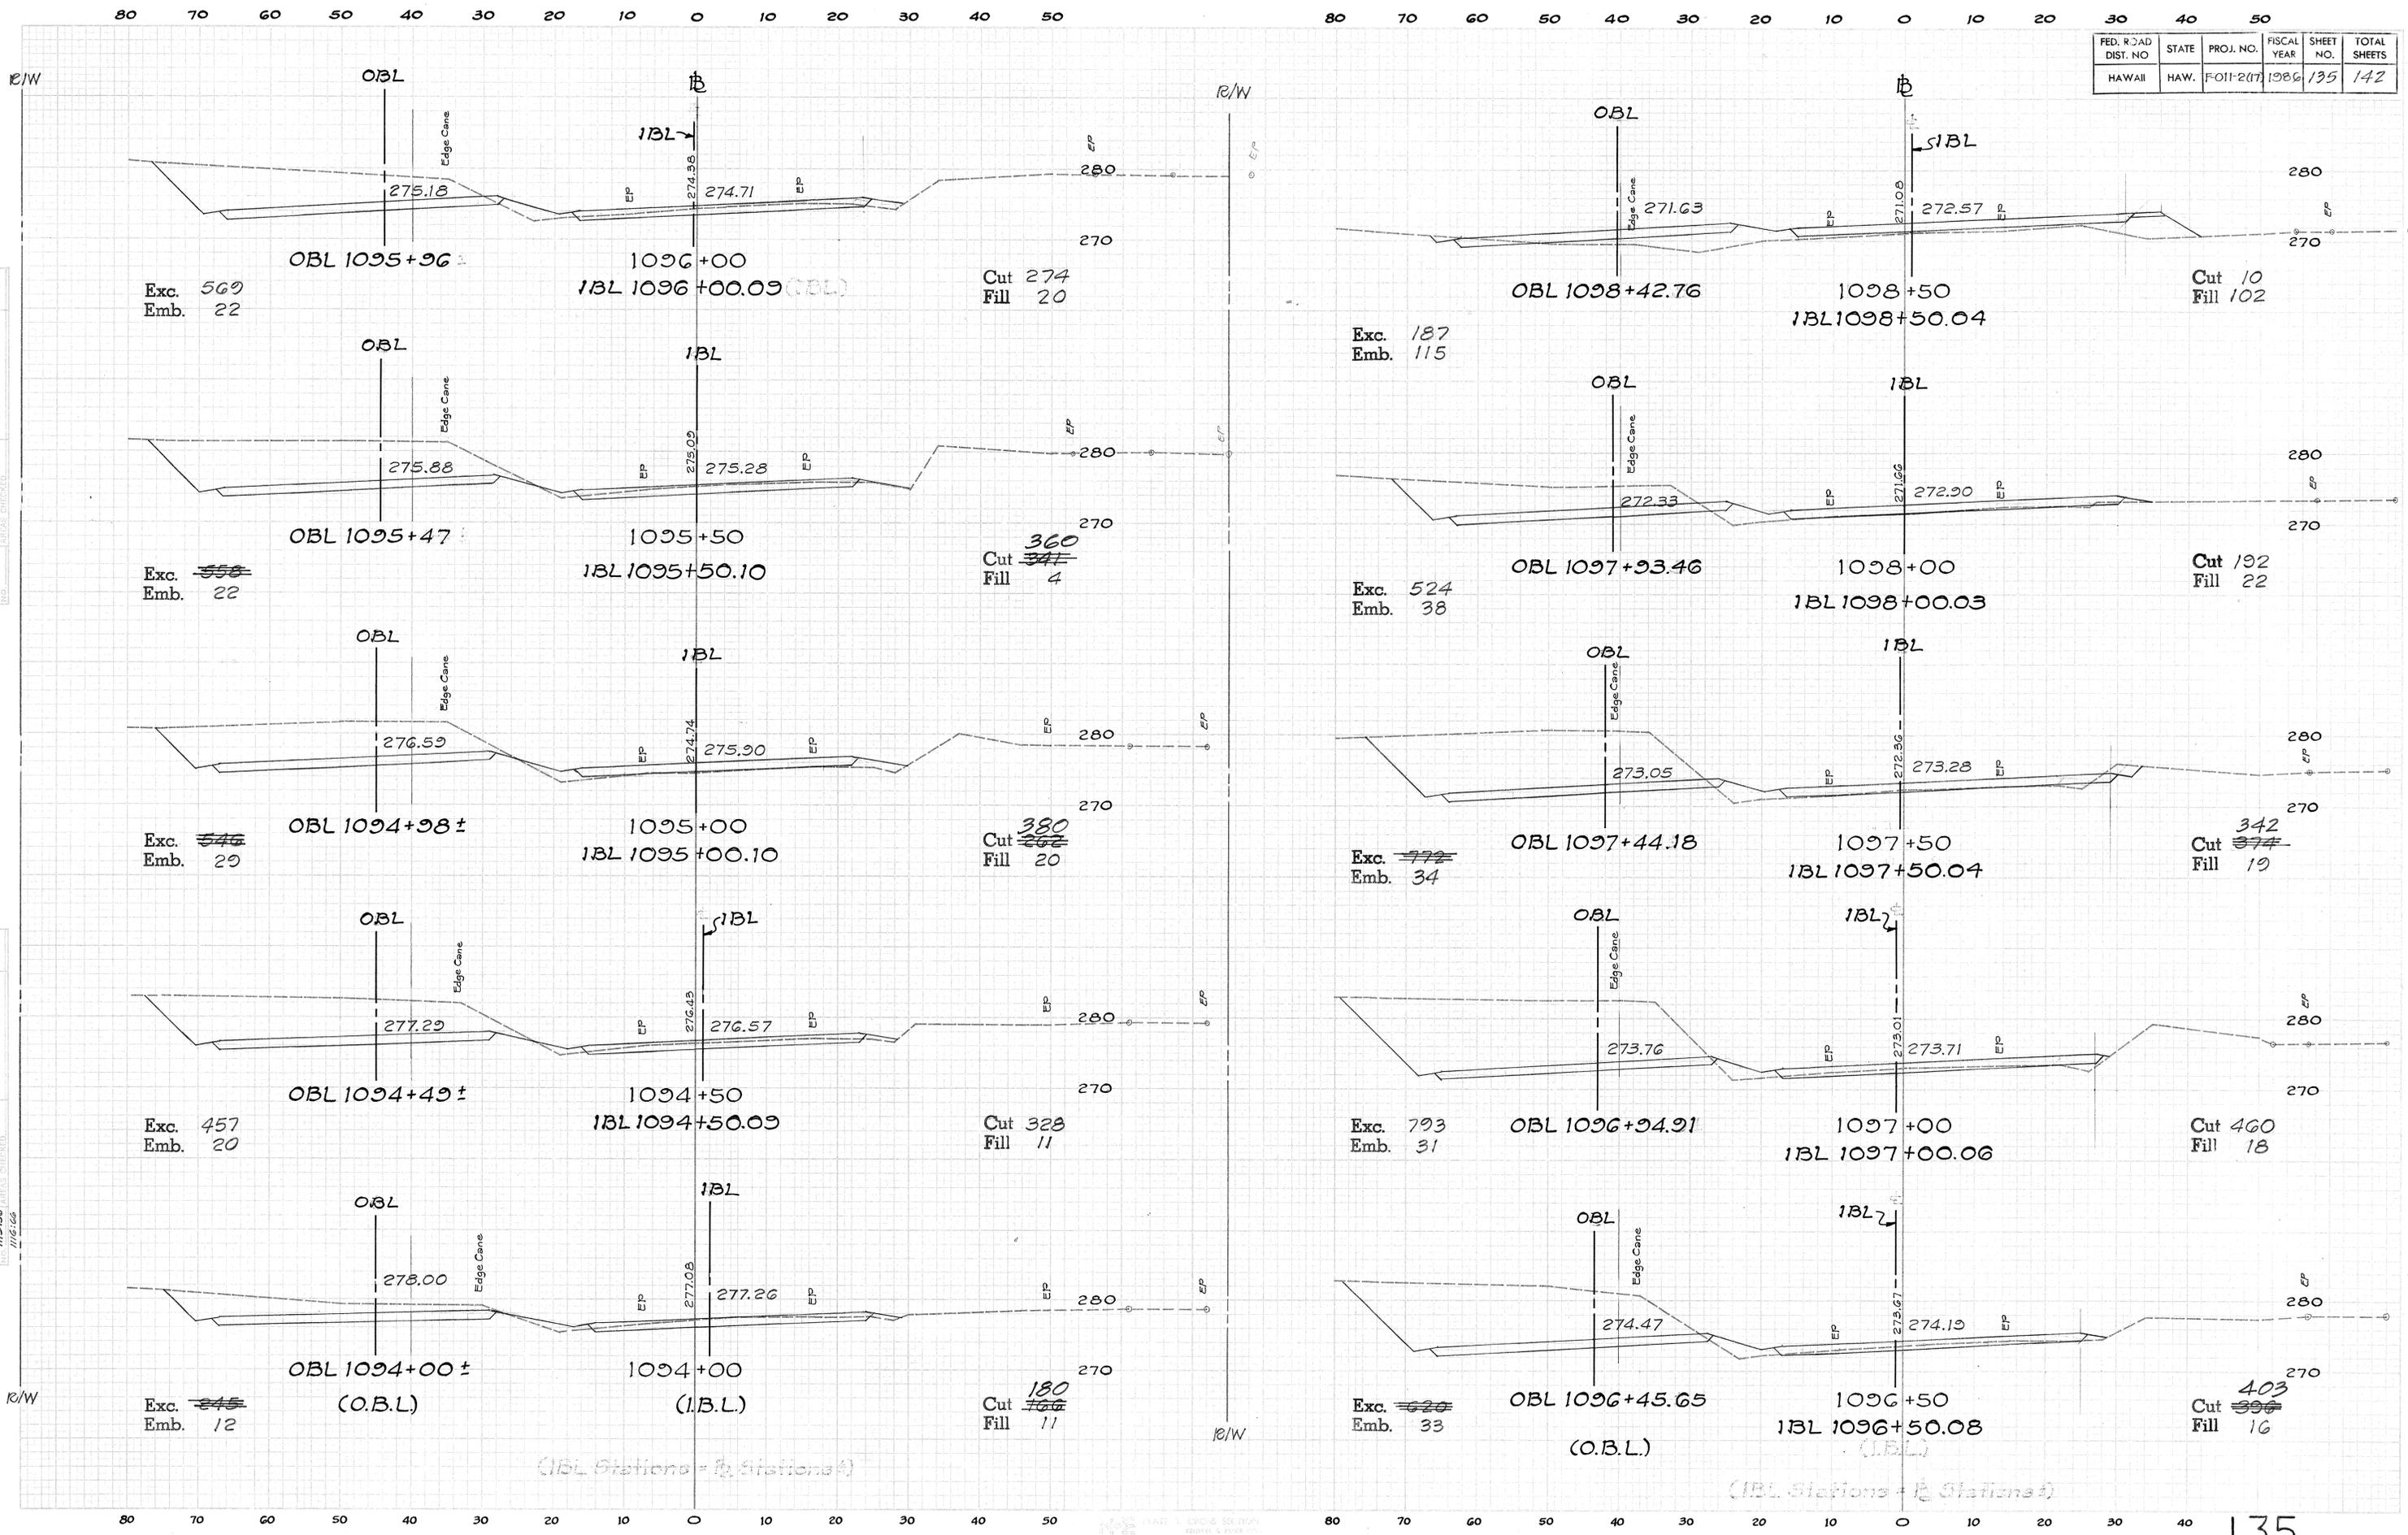


(I.B.L. Stations = $\frac{1}{2}$ Stations)

(I.B.L. Stations = $\frac{1}{2}$ Stations)

FED. ROAD DIST. NO.	STATE	PROJ. NO.	FISCAL YEAR	SHEET NO.	TOTAL SHEETS
HAWAII	HAW.	FOI-2017	1986	136	142

DATE: _____
 BY: _____
 ORIGINAL SURVEY PLOTTED: _____
 SURVEY NOTE BOOK: _____
 TEMPLATE: _____
 REVISIONS CHECKED: _____

DATE: _____
 BY: _____
 ORIGINAL SURVEY PLOTTED: _____
 SURVEY NOTE BOOK: _____
 TEMPLATE: _____
 REVISIONS CHECKED: _____


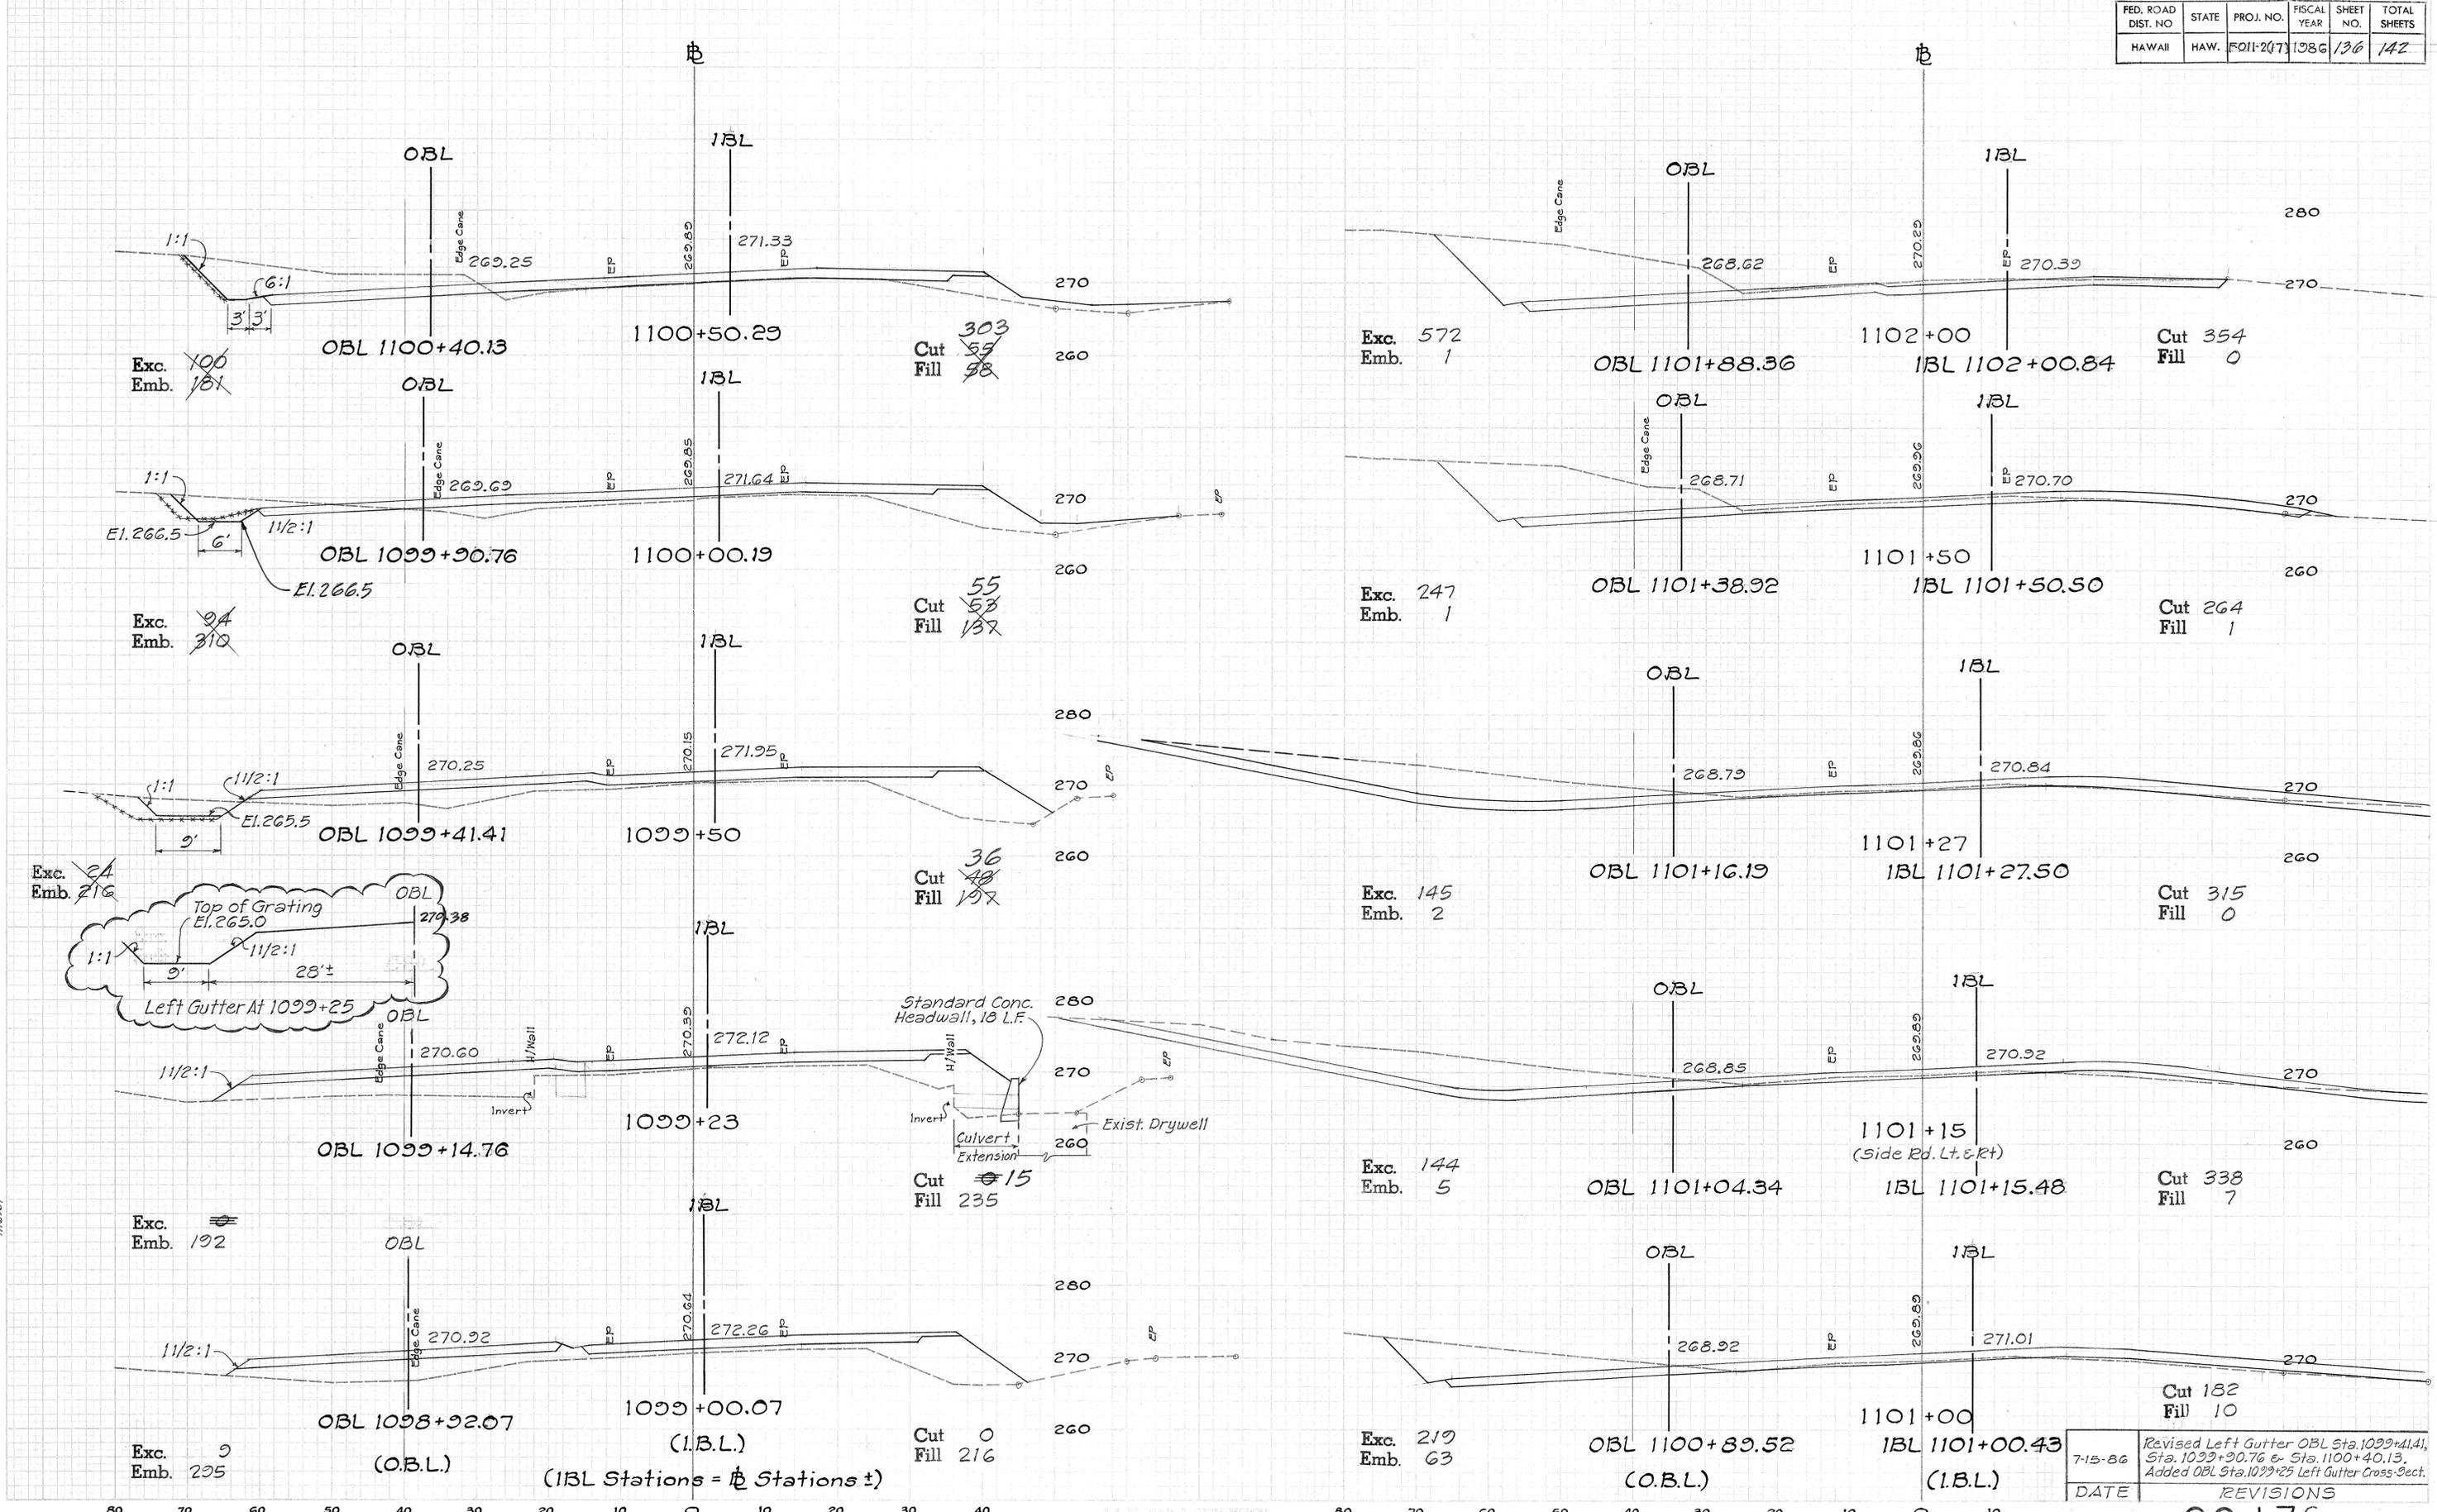


7-15-86
 DATE REVISIONS
 Revised Left Gutter OBL Sta. 1099+41.41, Sta. 1099+30.76 & Sta. 1100+40.13, Added OBL Sta. 1099+25 Left Gutter Cross-Section.

FED. ROAD DIST. NO.	STATE	PROJ. NO.	FISCAL YEAR	SHEET NO.	TOTAL SHEETS
HAWAII	HAW.	FOH-2(7)	1986	137	142

DATE: _____
 BY: _____
 SURVEYED: _____
 CHECKED: _____
 ORIGINAL SURVEY: _____
 TEMPLATE: _____
 NO. 11/5-41 AREAS CHECKED: _____



DATE: _____
 BY: _____
 SURVEYED: _____
 CHECKED: _____
 ORIGINAL SURVEY: _____
 TEMPLATE: _____
 NO. 11/5-41 AREAS CHECKED: _____

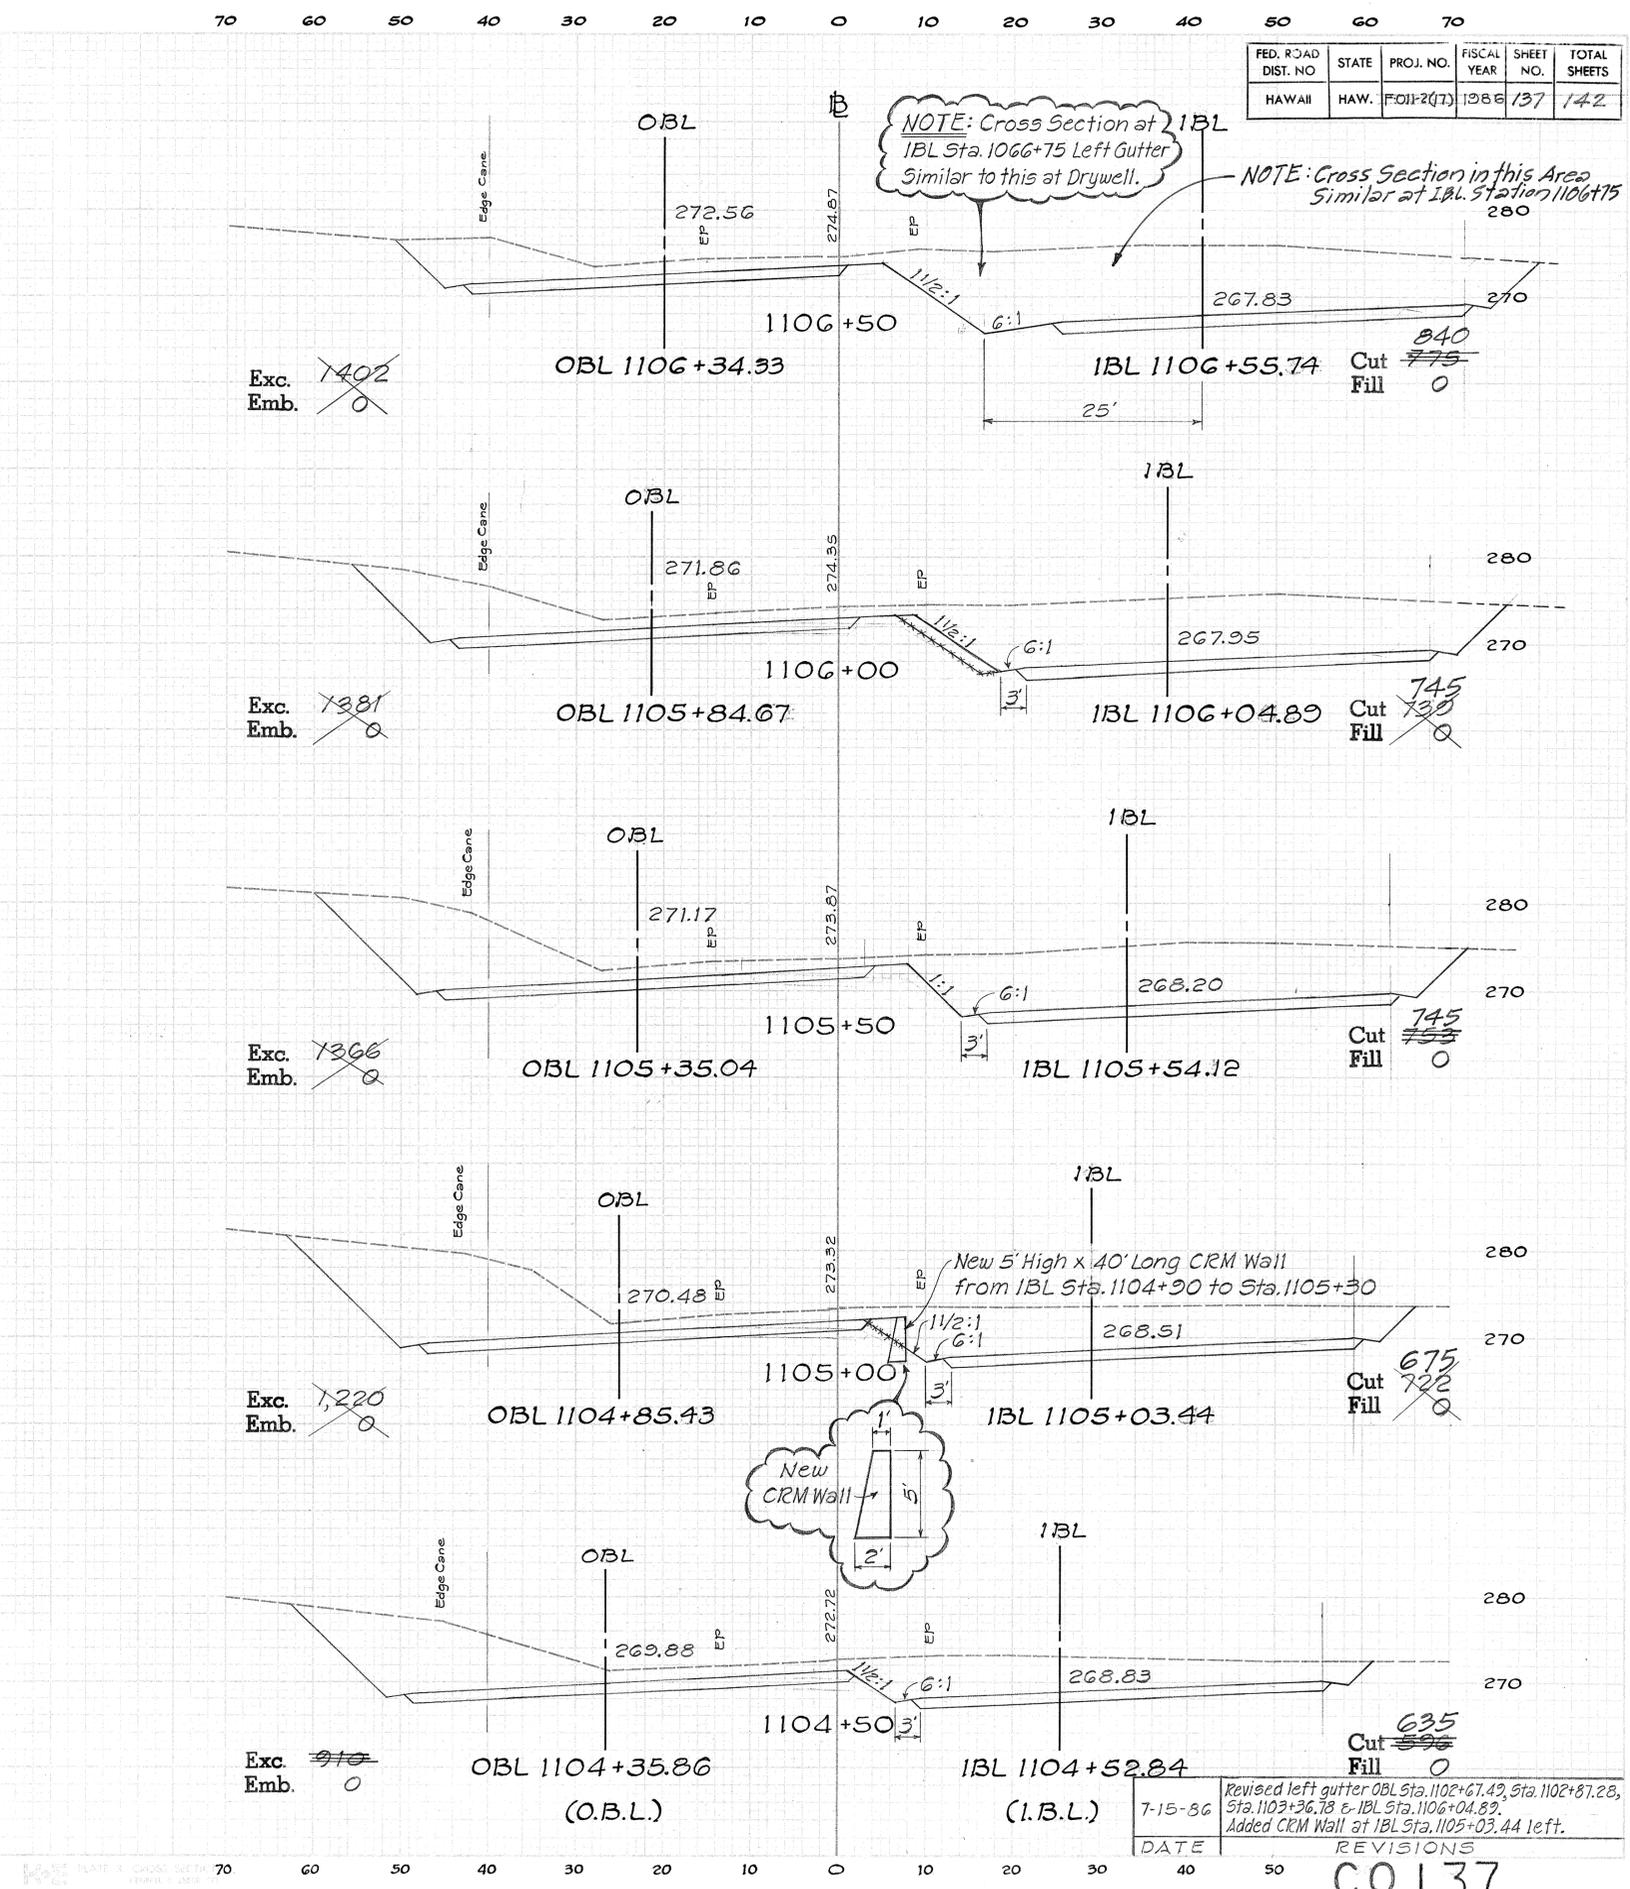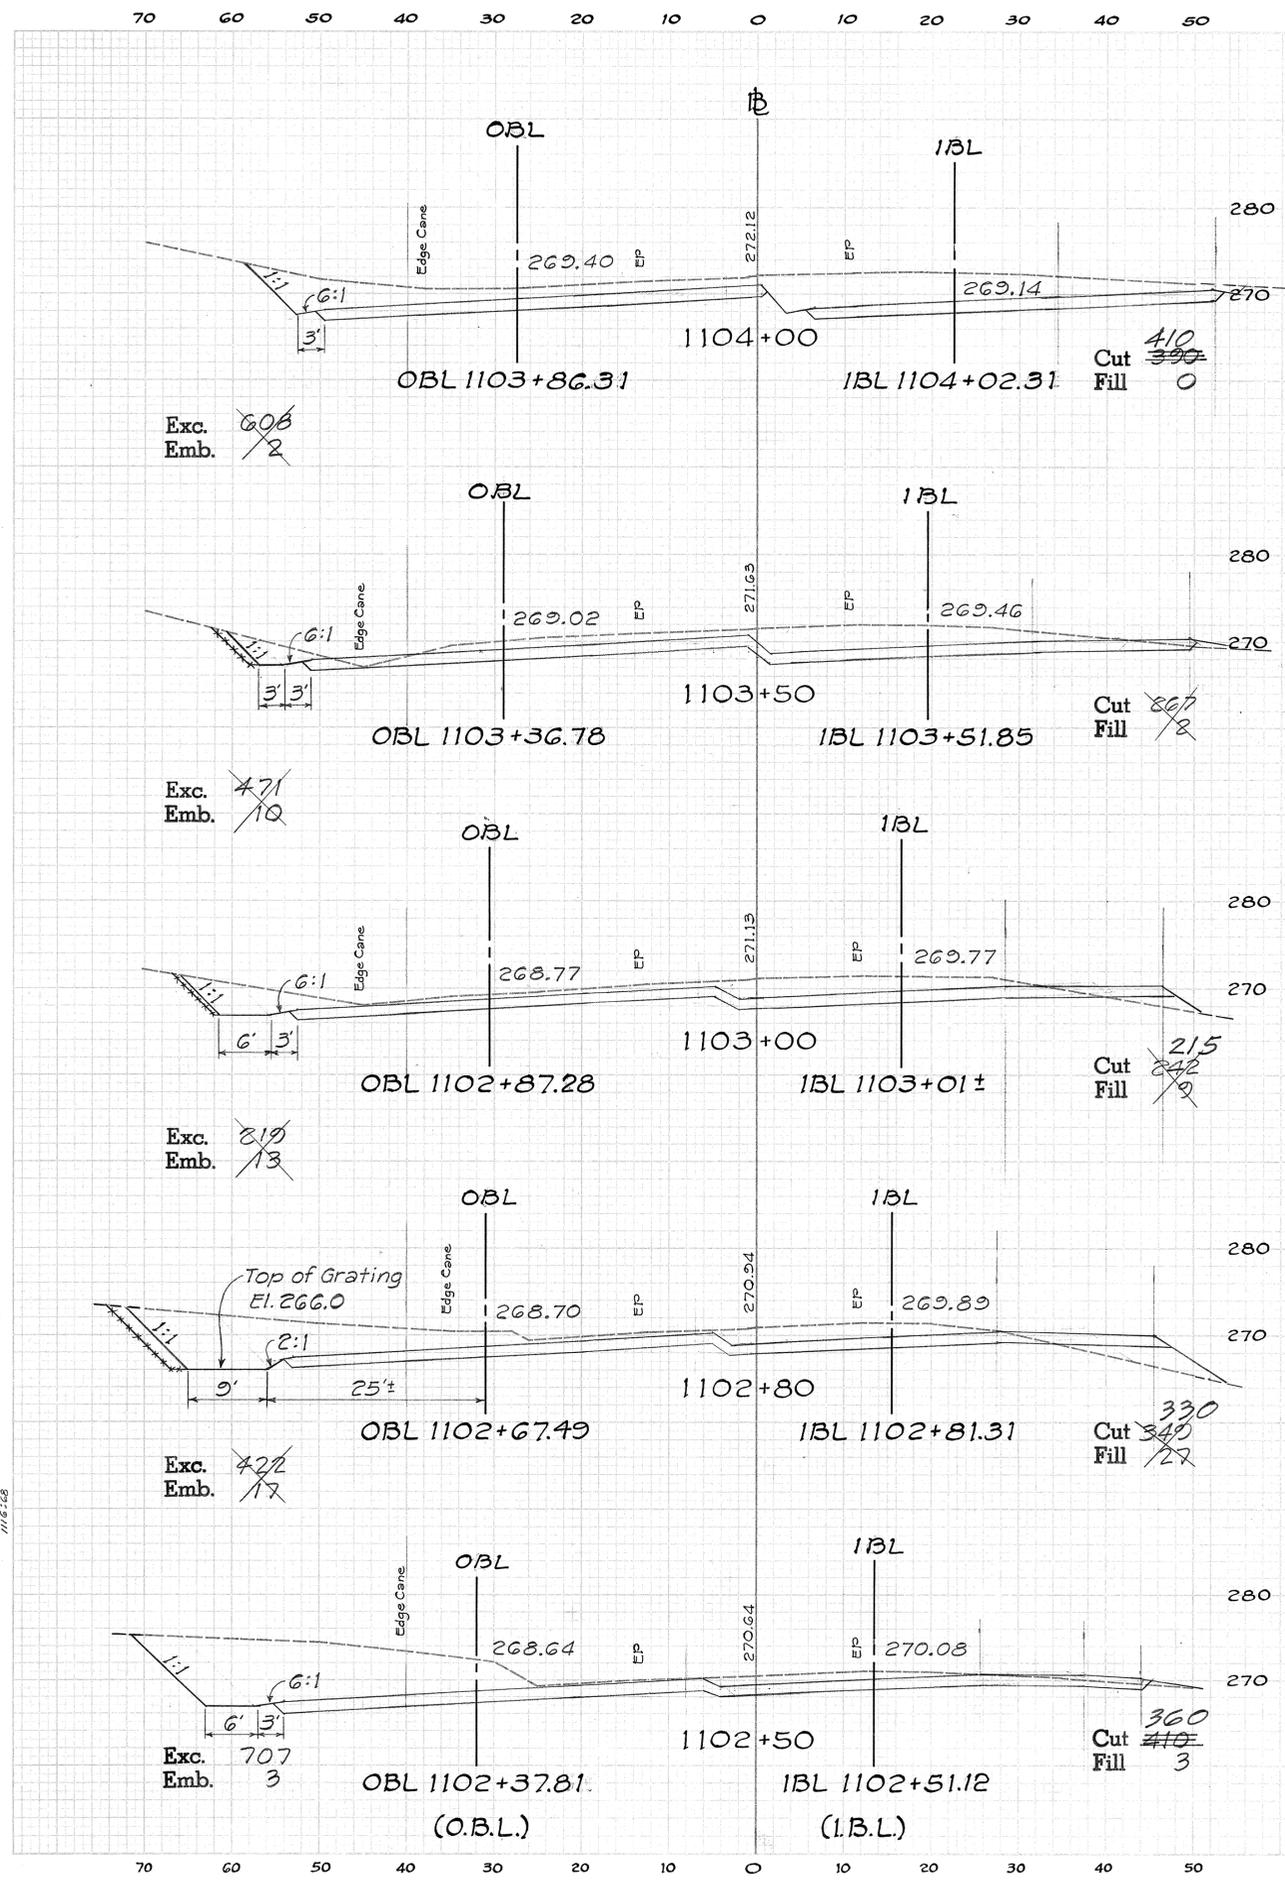

7-15-86
 DATE: _____
 REVISIONS

C0137

FED. ROAD DIST. NO.	STATE	PROJ. NO.	FISCAL YEAR	SHEET NO.	TOTAL SHEETS
HAWAII	HAW.	F-011-2(1)	1966	138	142

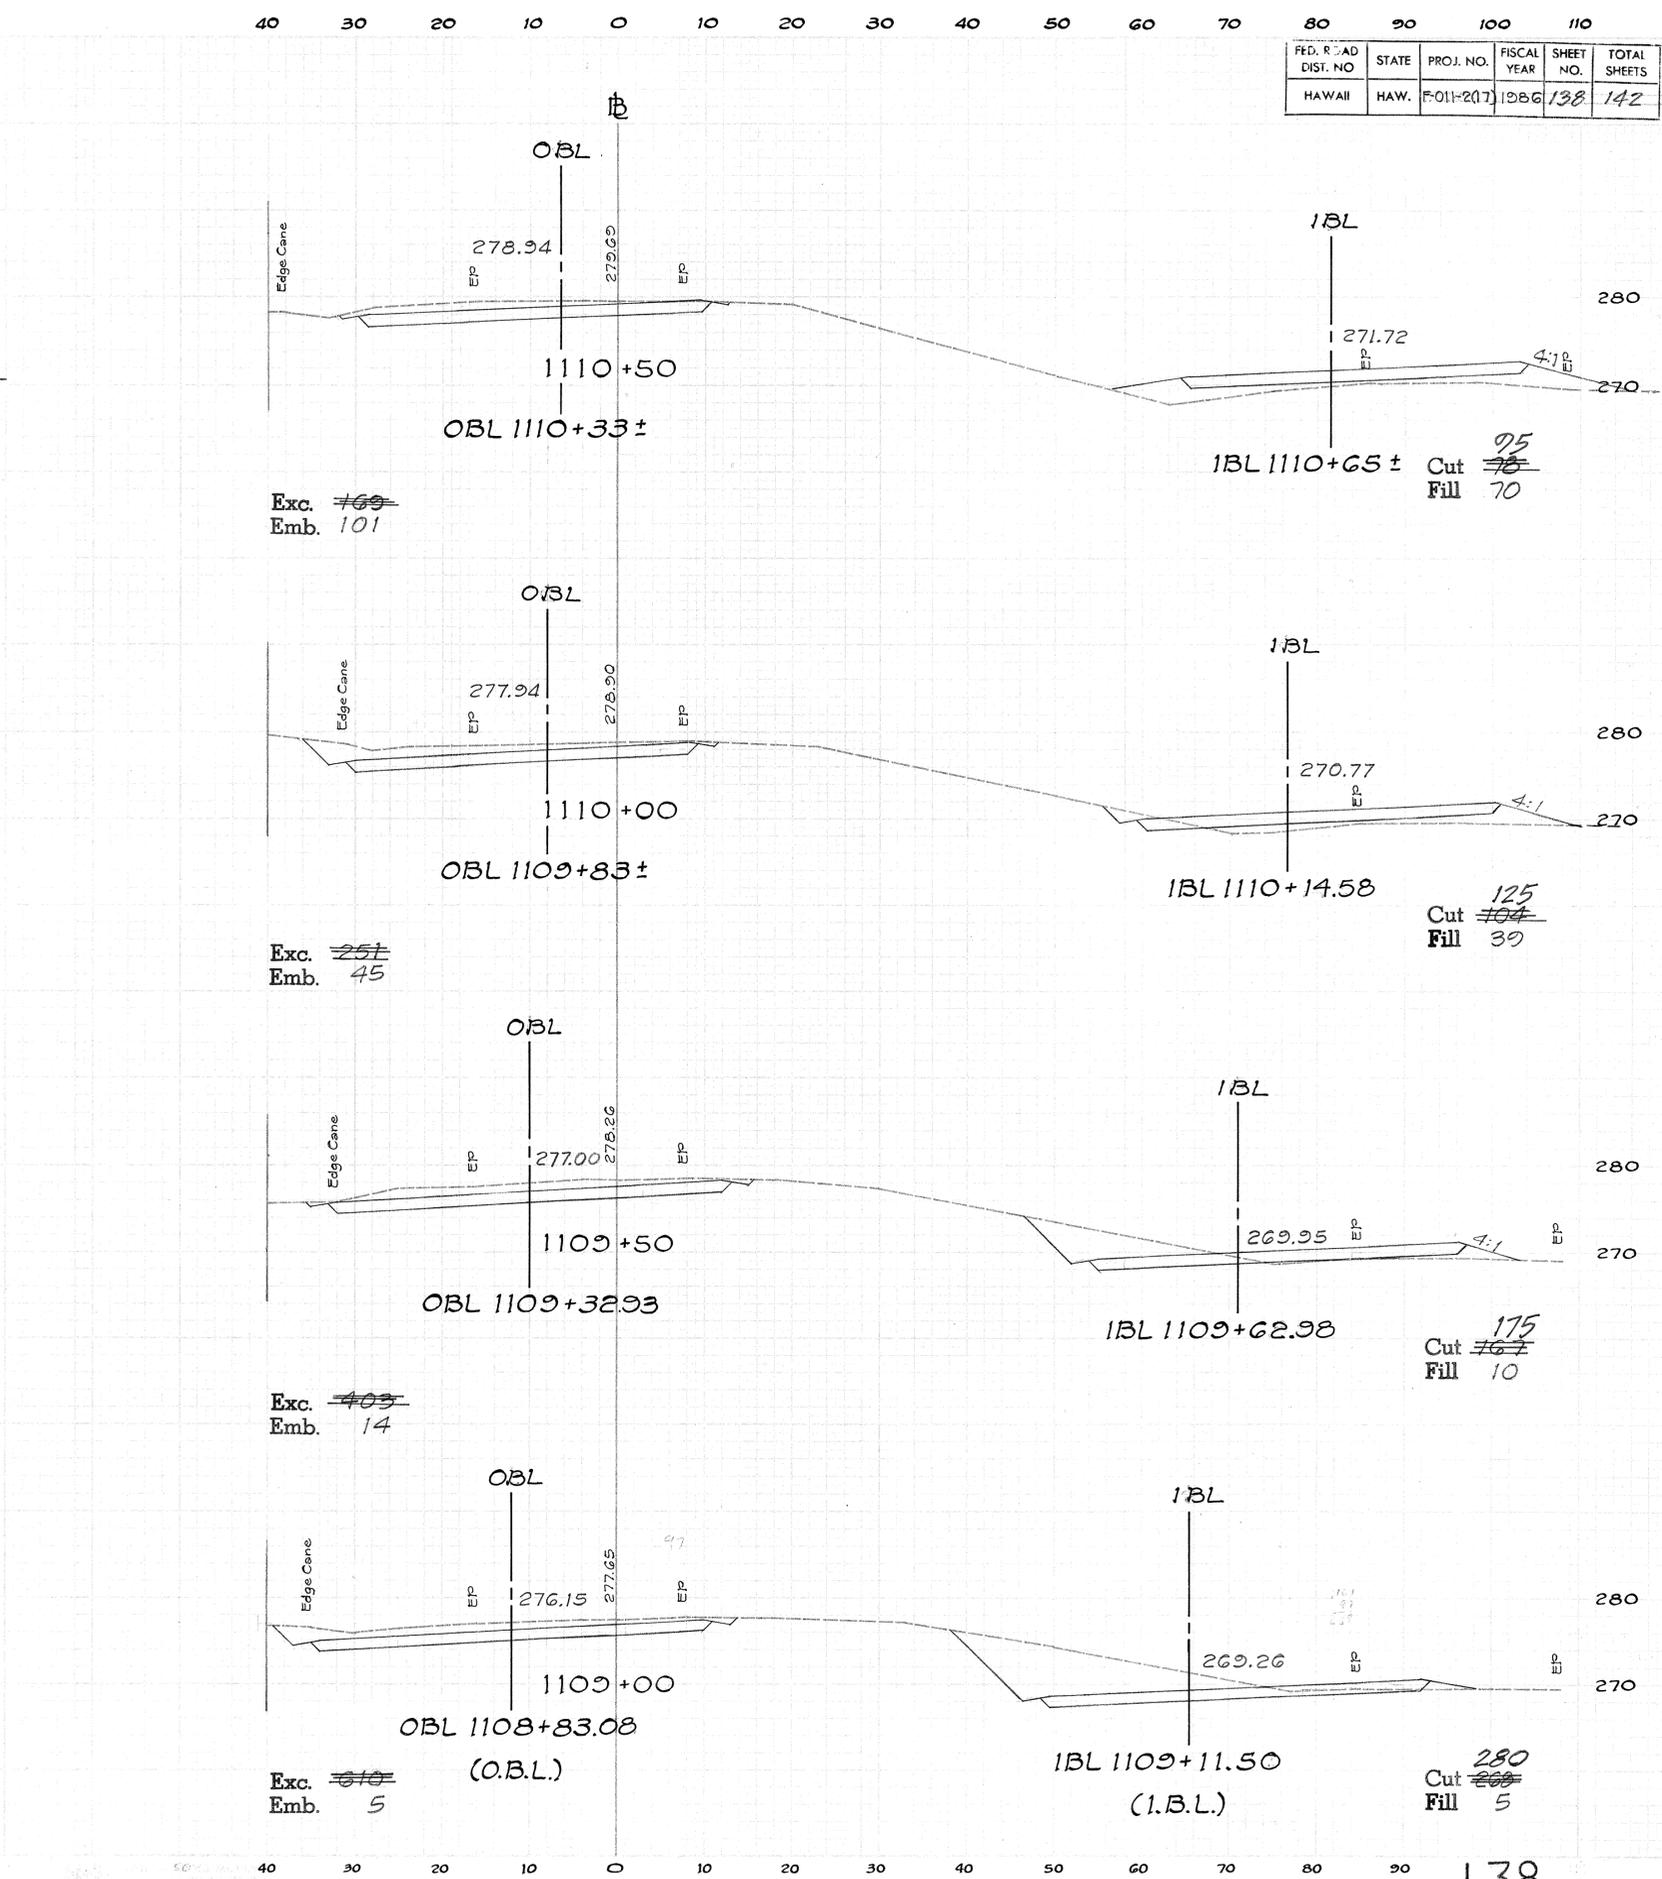
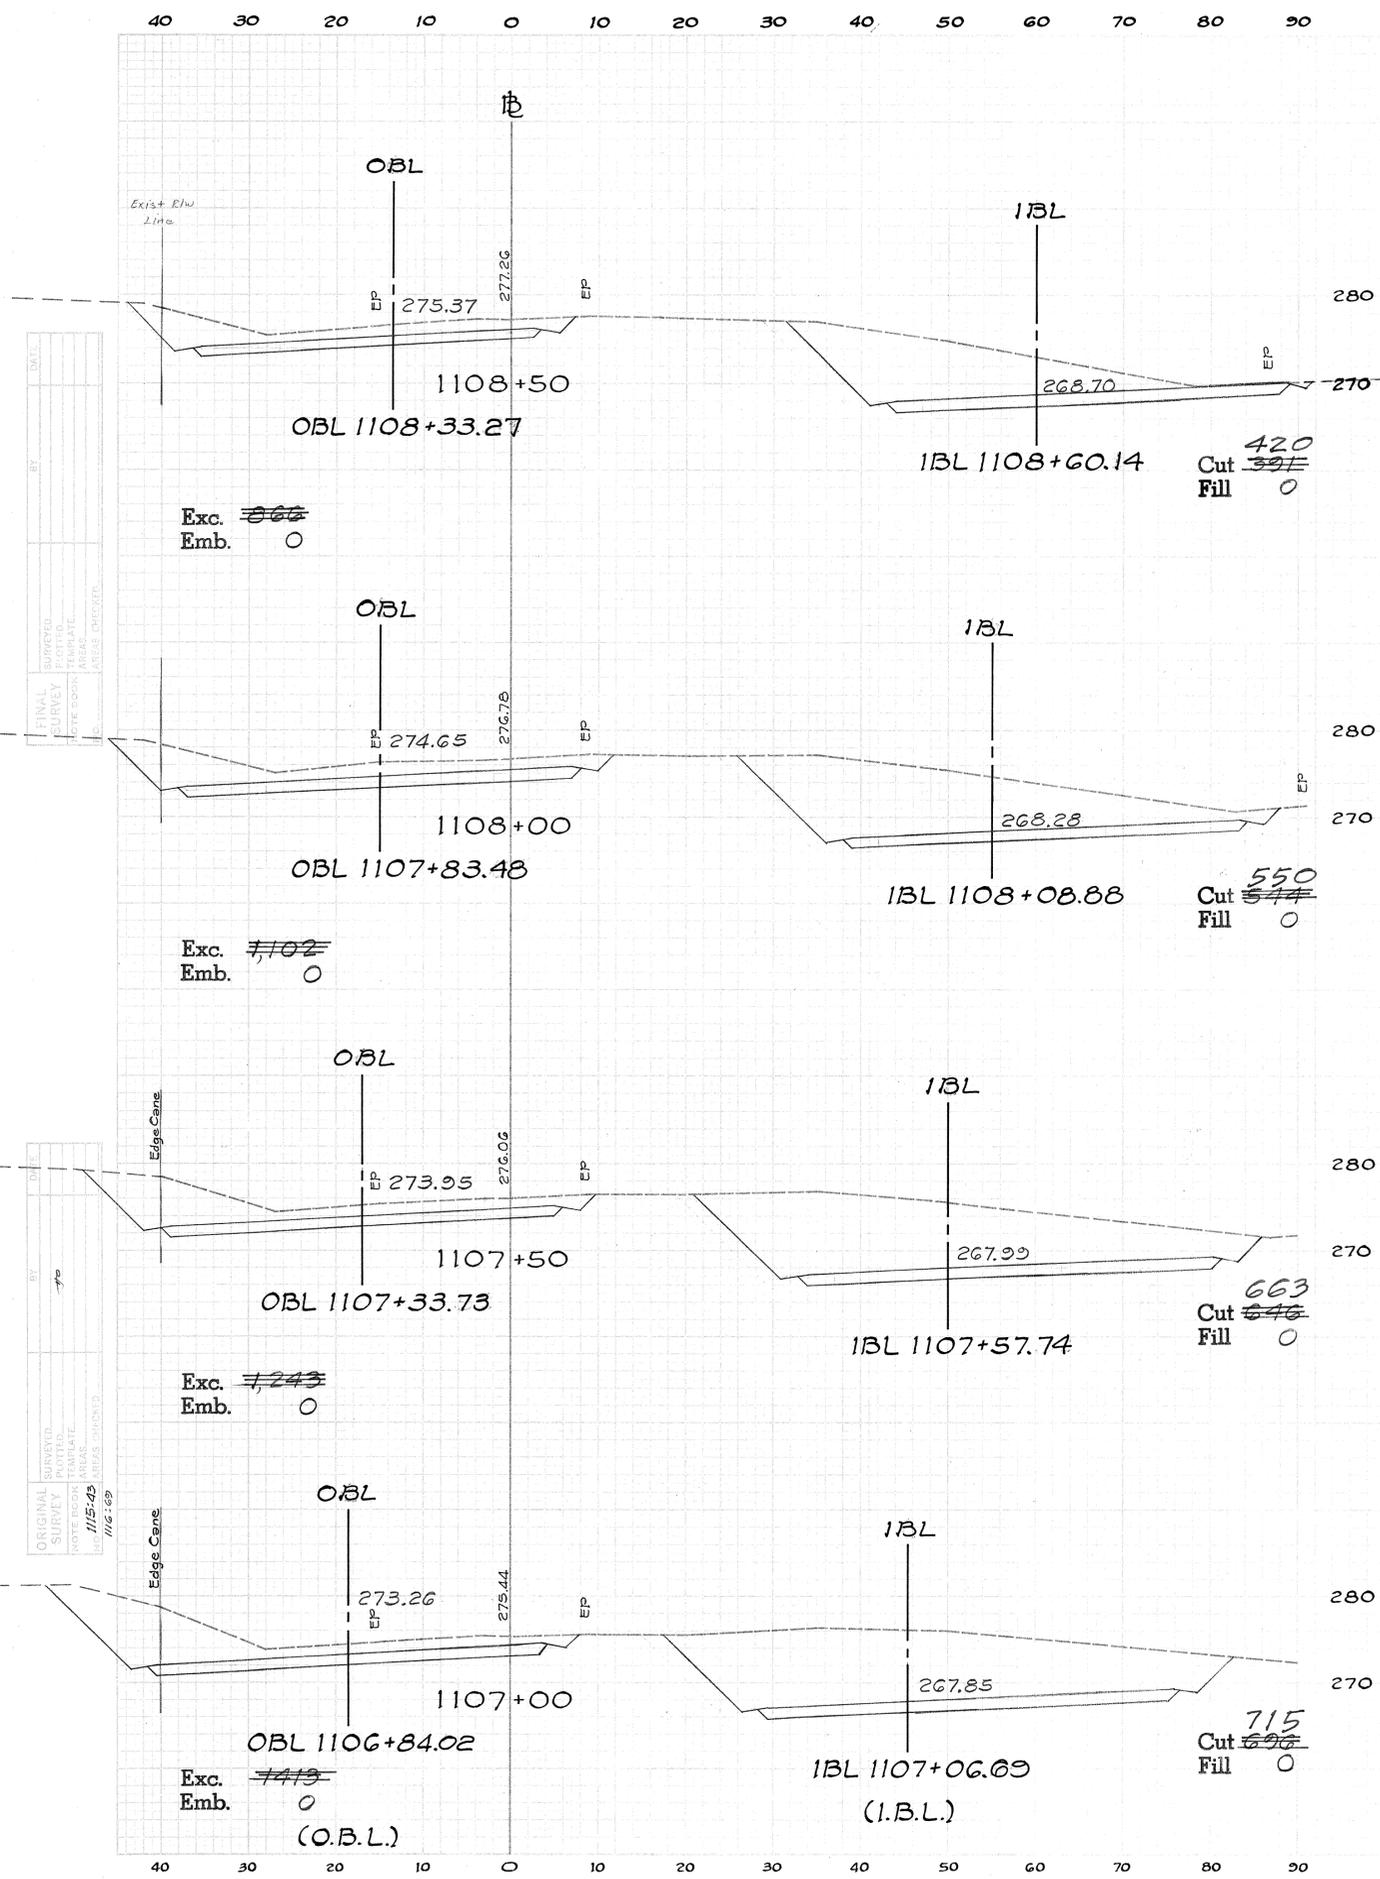


ORIGINAL SURVEY PLOTTED BY 11/15/43
 SURVEY PLOTTED BY 11/16/43
 CHECKED BY 11/16/43
 DATE 11/16/43

50 40 30 20 10 0 10 20 30 40



50 40 30 20 10 0 10 20 30 40 50

FED. ROAD DIST. NO.	STATE	PROJ. NO.	FISCAL YEAR	SHEET NO.	TOTAL SHEETS
HAWAII	HAW.	FOI: 2(1)	1986	139	142

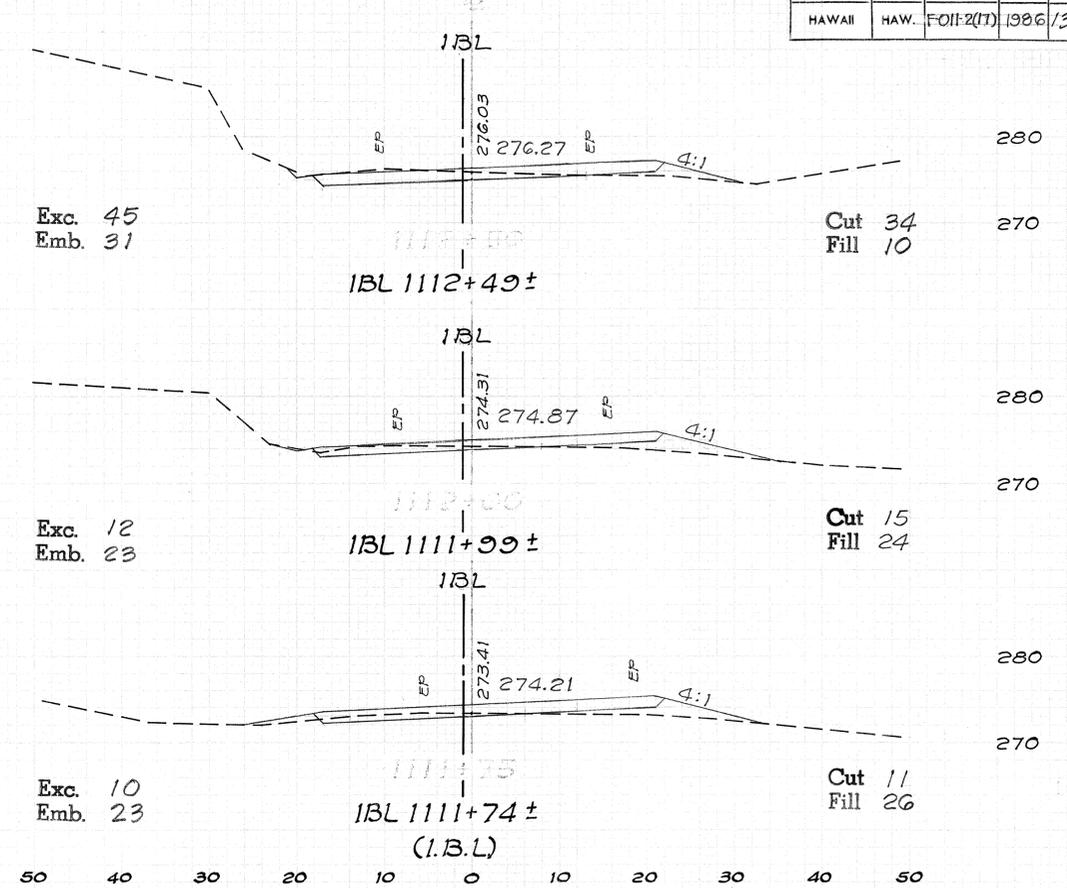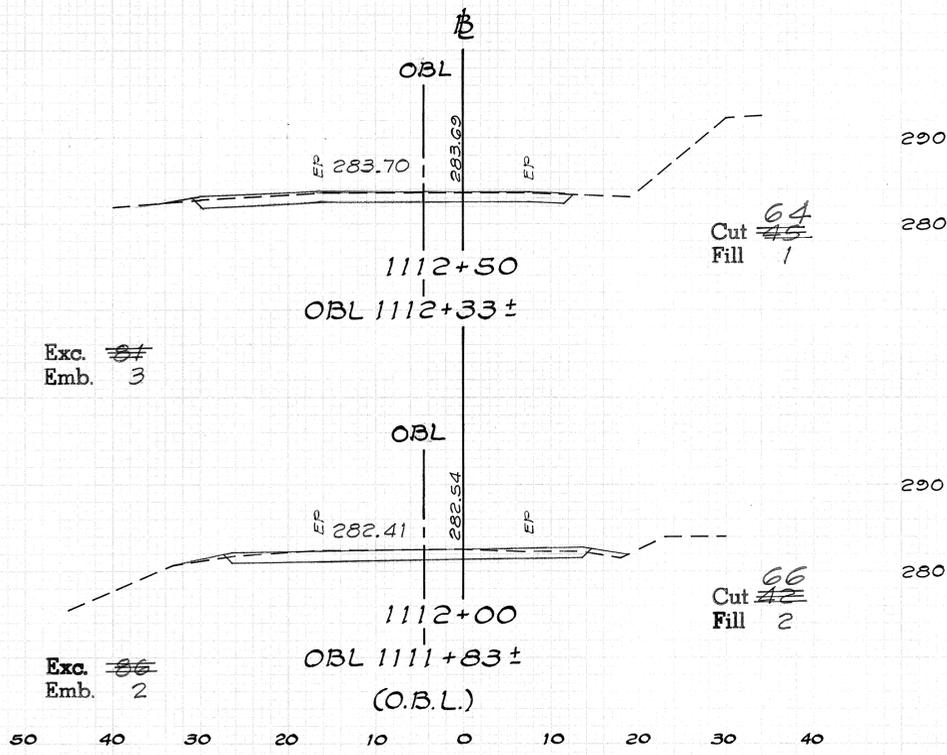

DATE	
BY	
ORIGINAL SURVEY	
ADJUSTED SURVEY	
PLOTTED	
DATE PLOTTED	
DATE CHECKED	
BY	
REVISIONS	
NO.	
DATE	
BY	
DESCRIPTION	




DATE	
BY	
ORIGINAL SURVEY	
ADJUSTED SURVEY	
PLOTTED	
DATE PLOTTED	
DATE CHECKED	
BY	
REVISIONS	
NO.	
DATE	
BY	
DESCRIPTION	

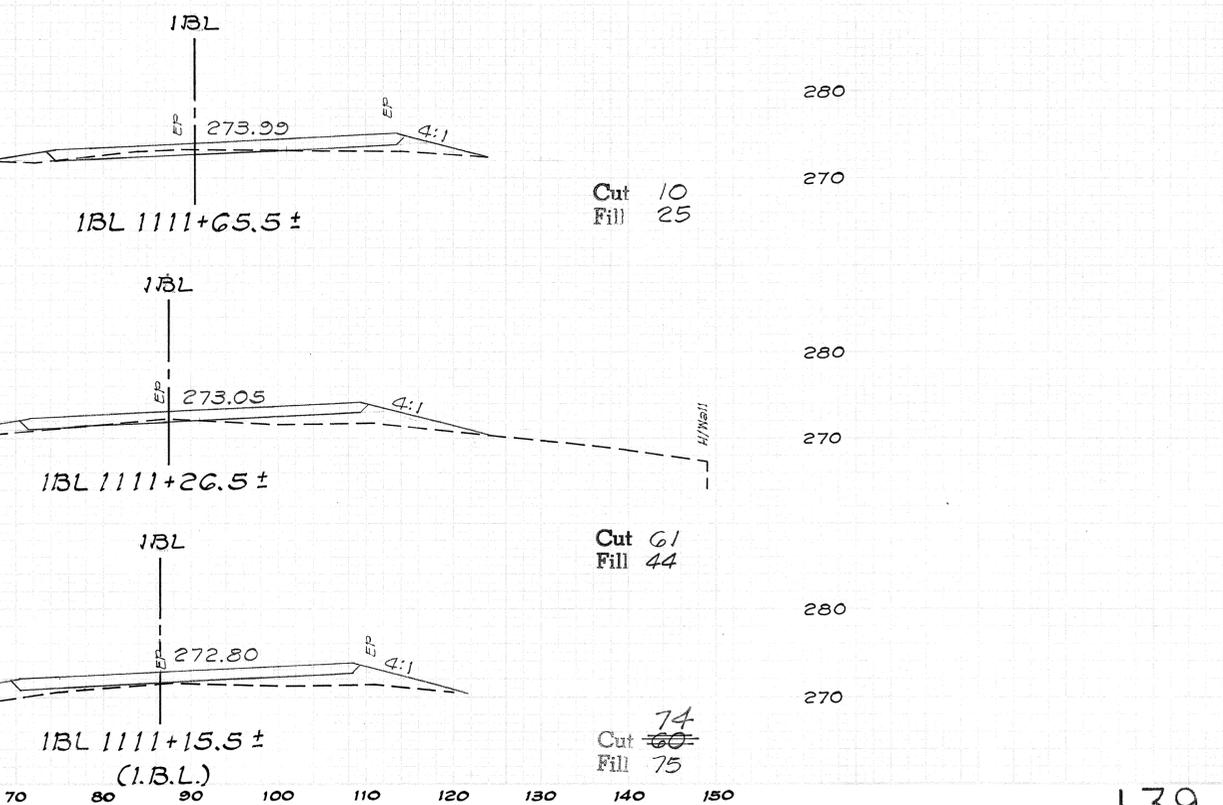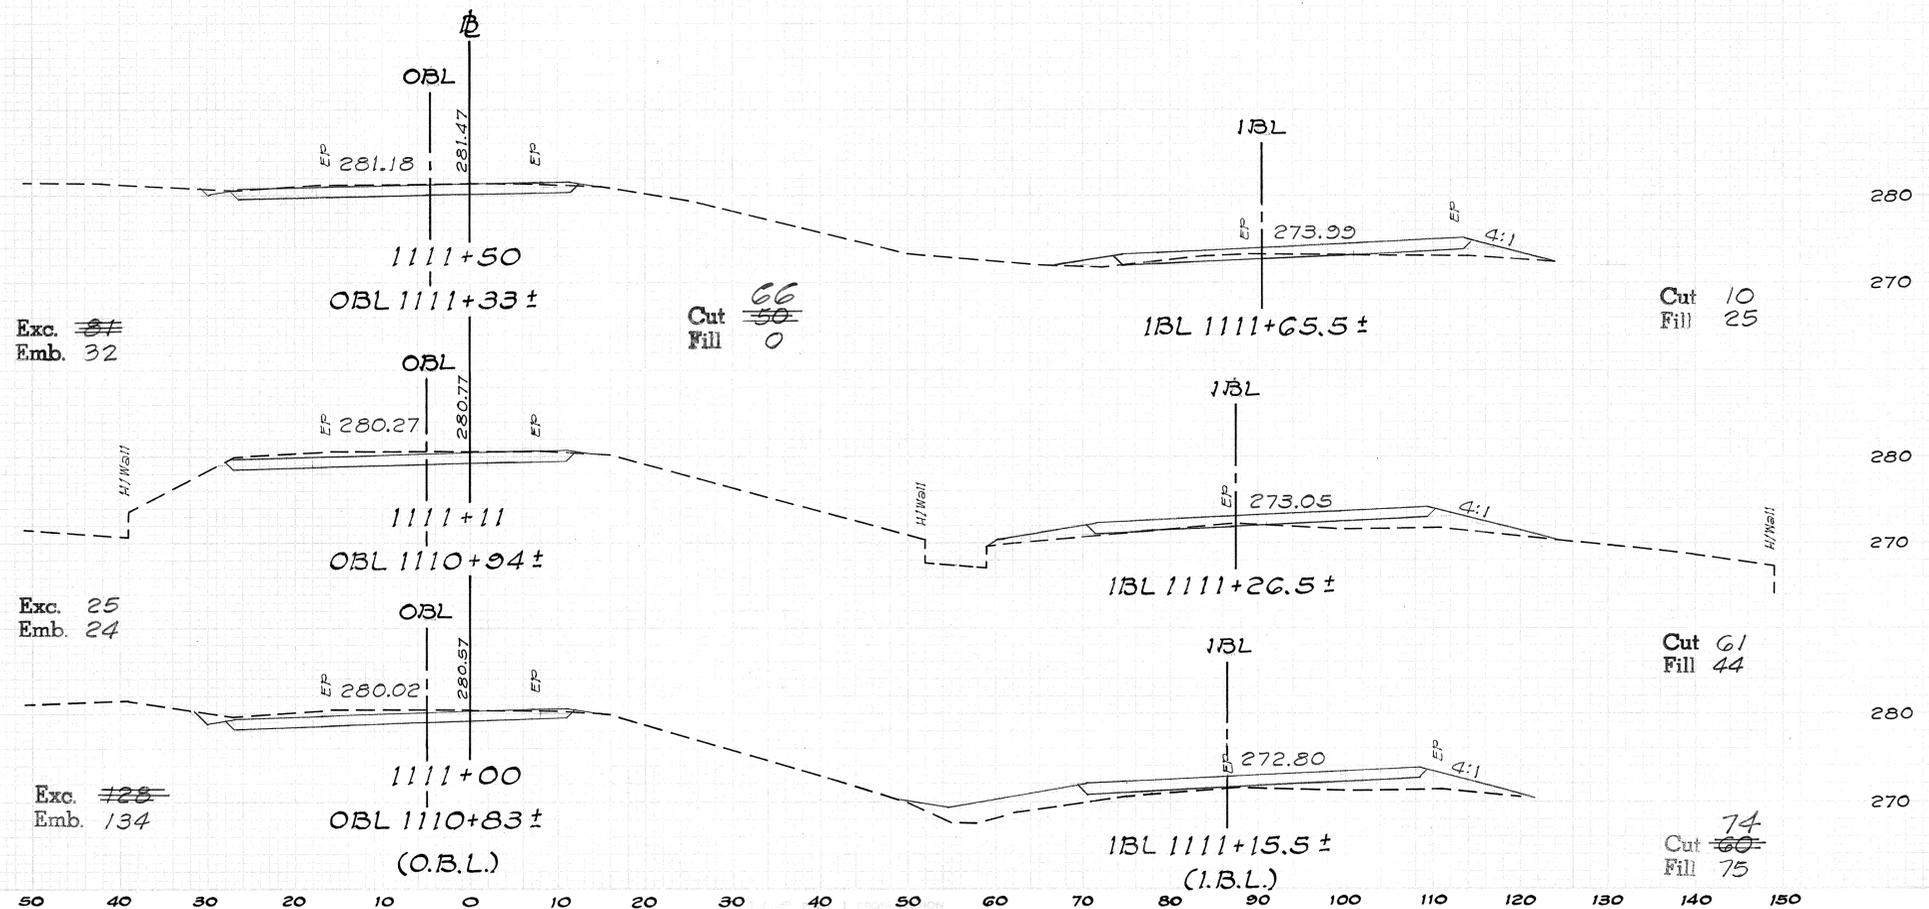


FED. ROAD DIST. NO.	STATE	PROJ. NO.	FISCAL YEAR	SHEET NO.	TOTAL SHEETS
HAWAII	HAW.	F-011-2(17)	1986	140	142

DATE	BY

DATE	BY

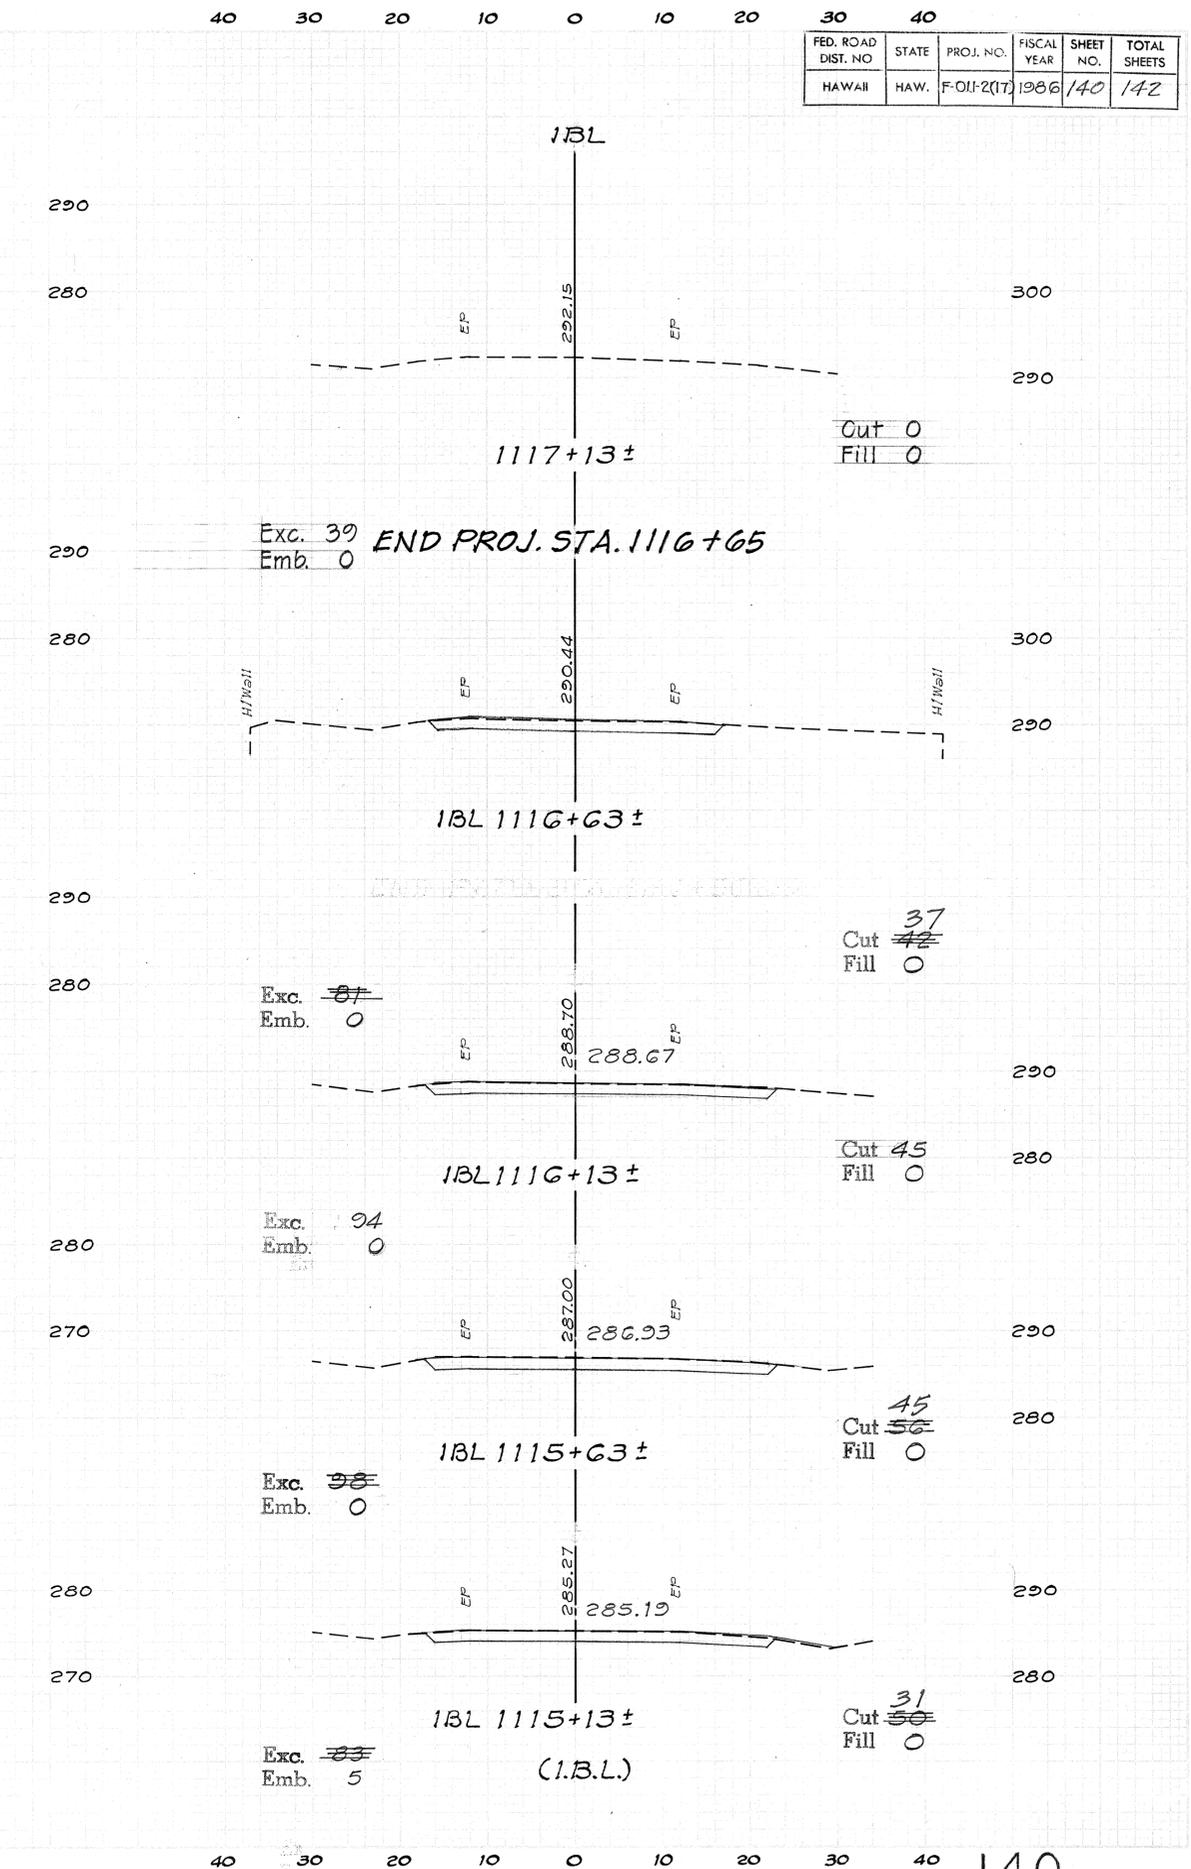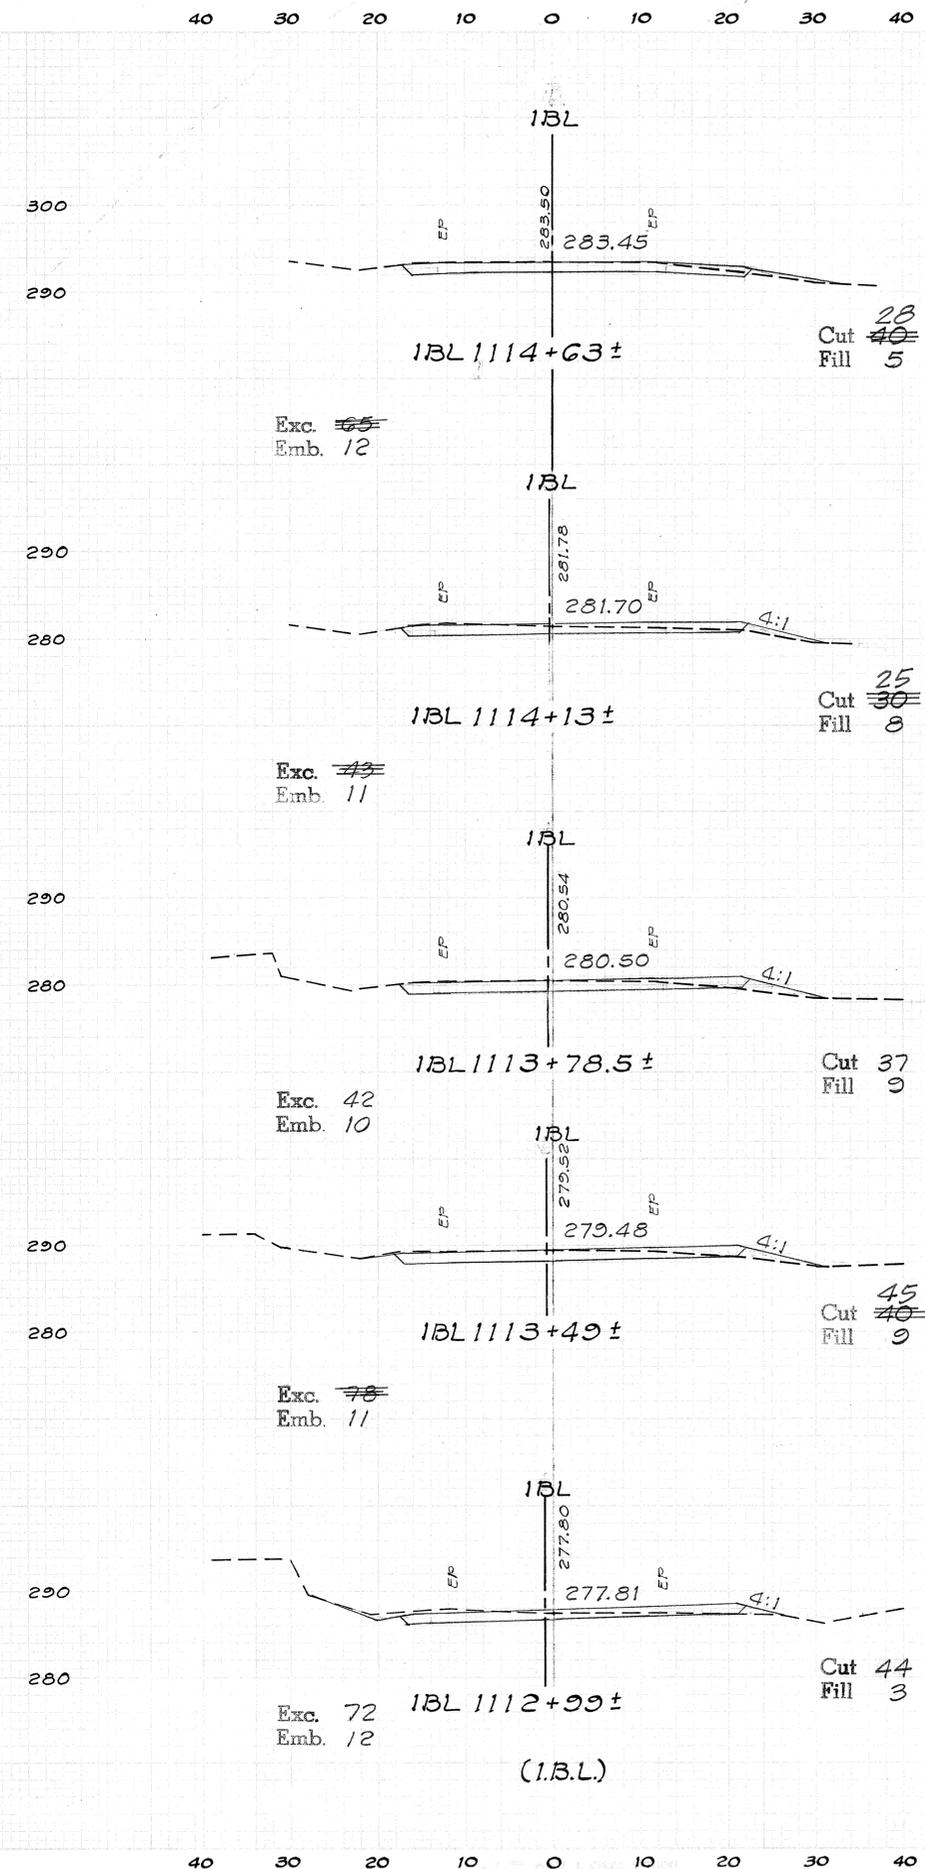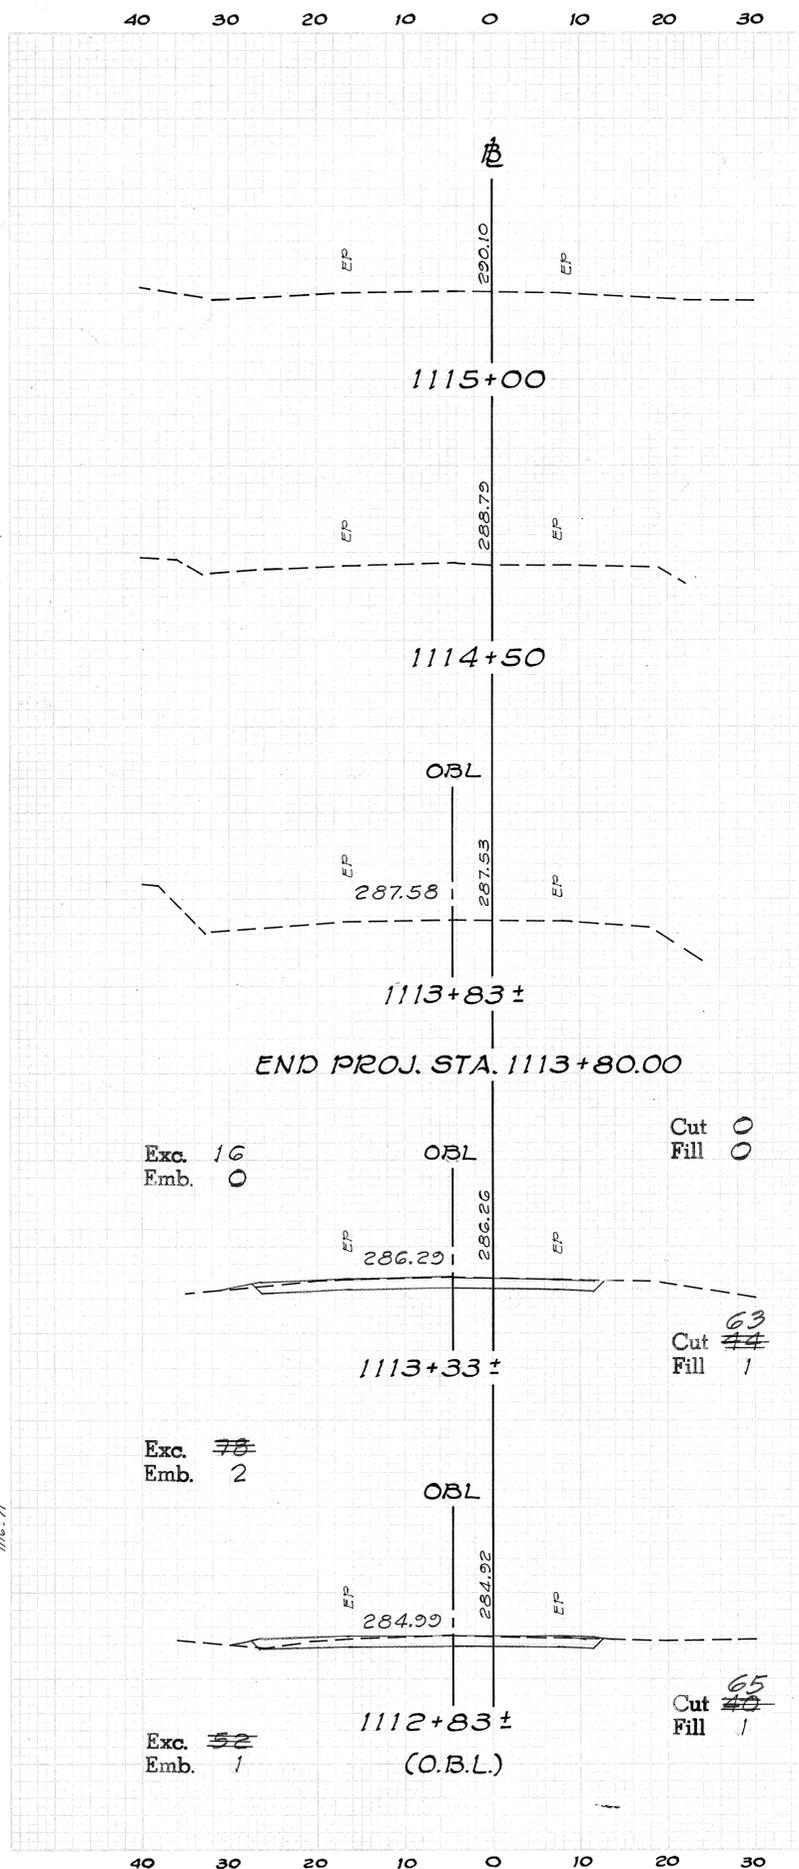

FED. ROAD DIST. NO.	STATE	PROJ. NO.	FISCAL YEAR	SHEET NO.	TOTAL SHEETS
HAWAII	HAW.	FOI-2(17)	1986	141	142

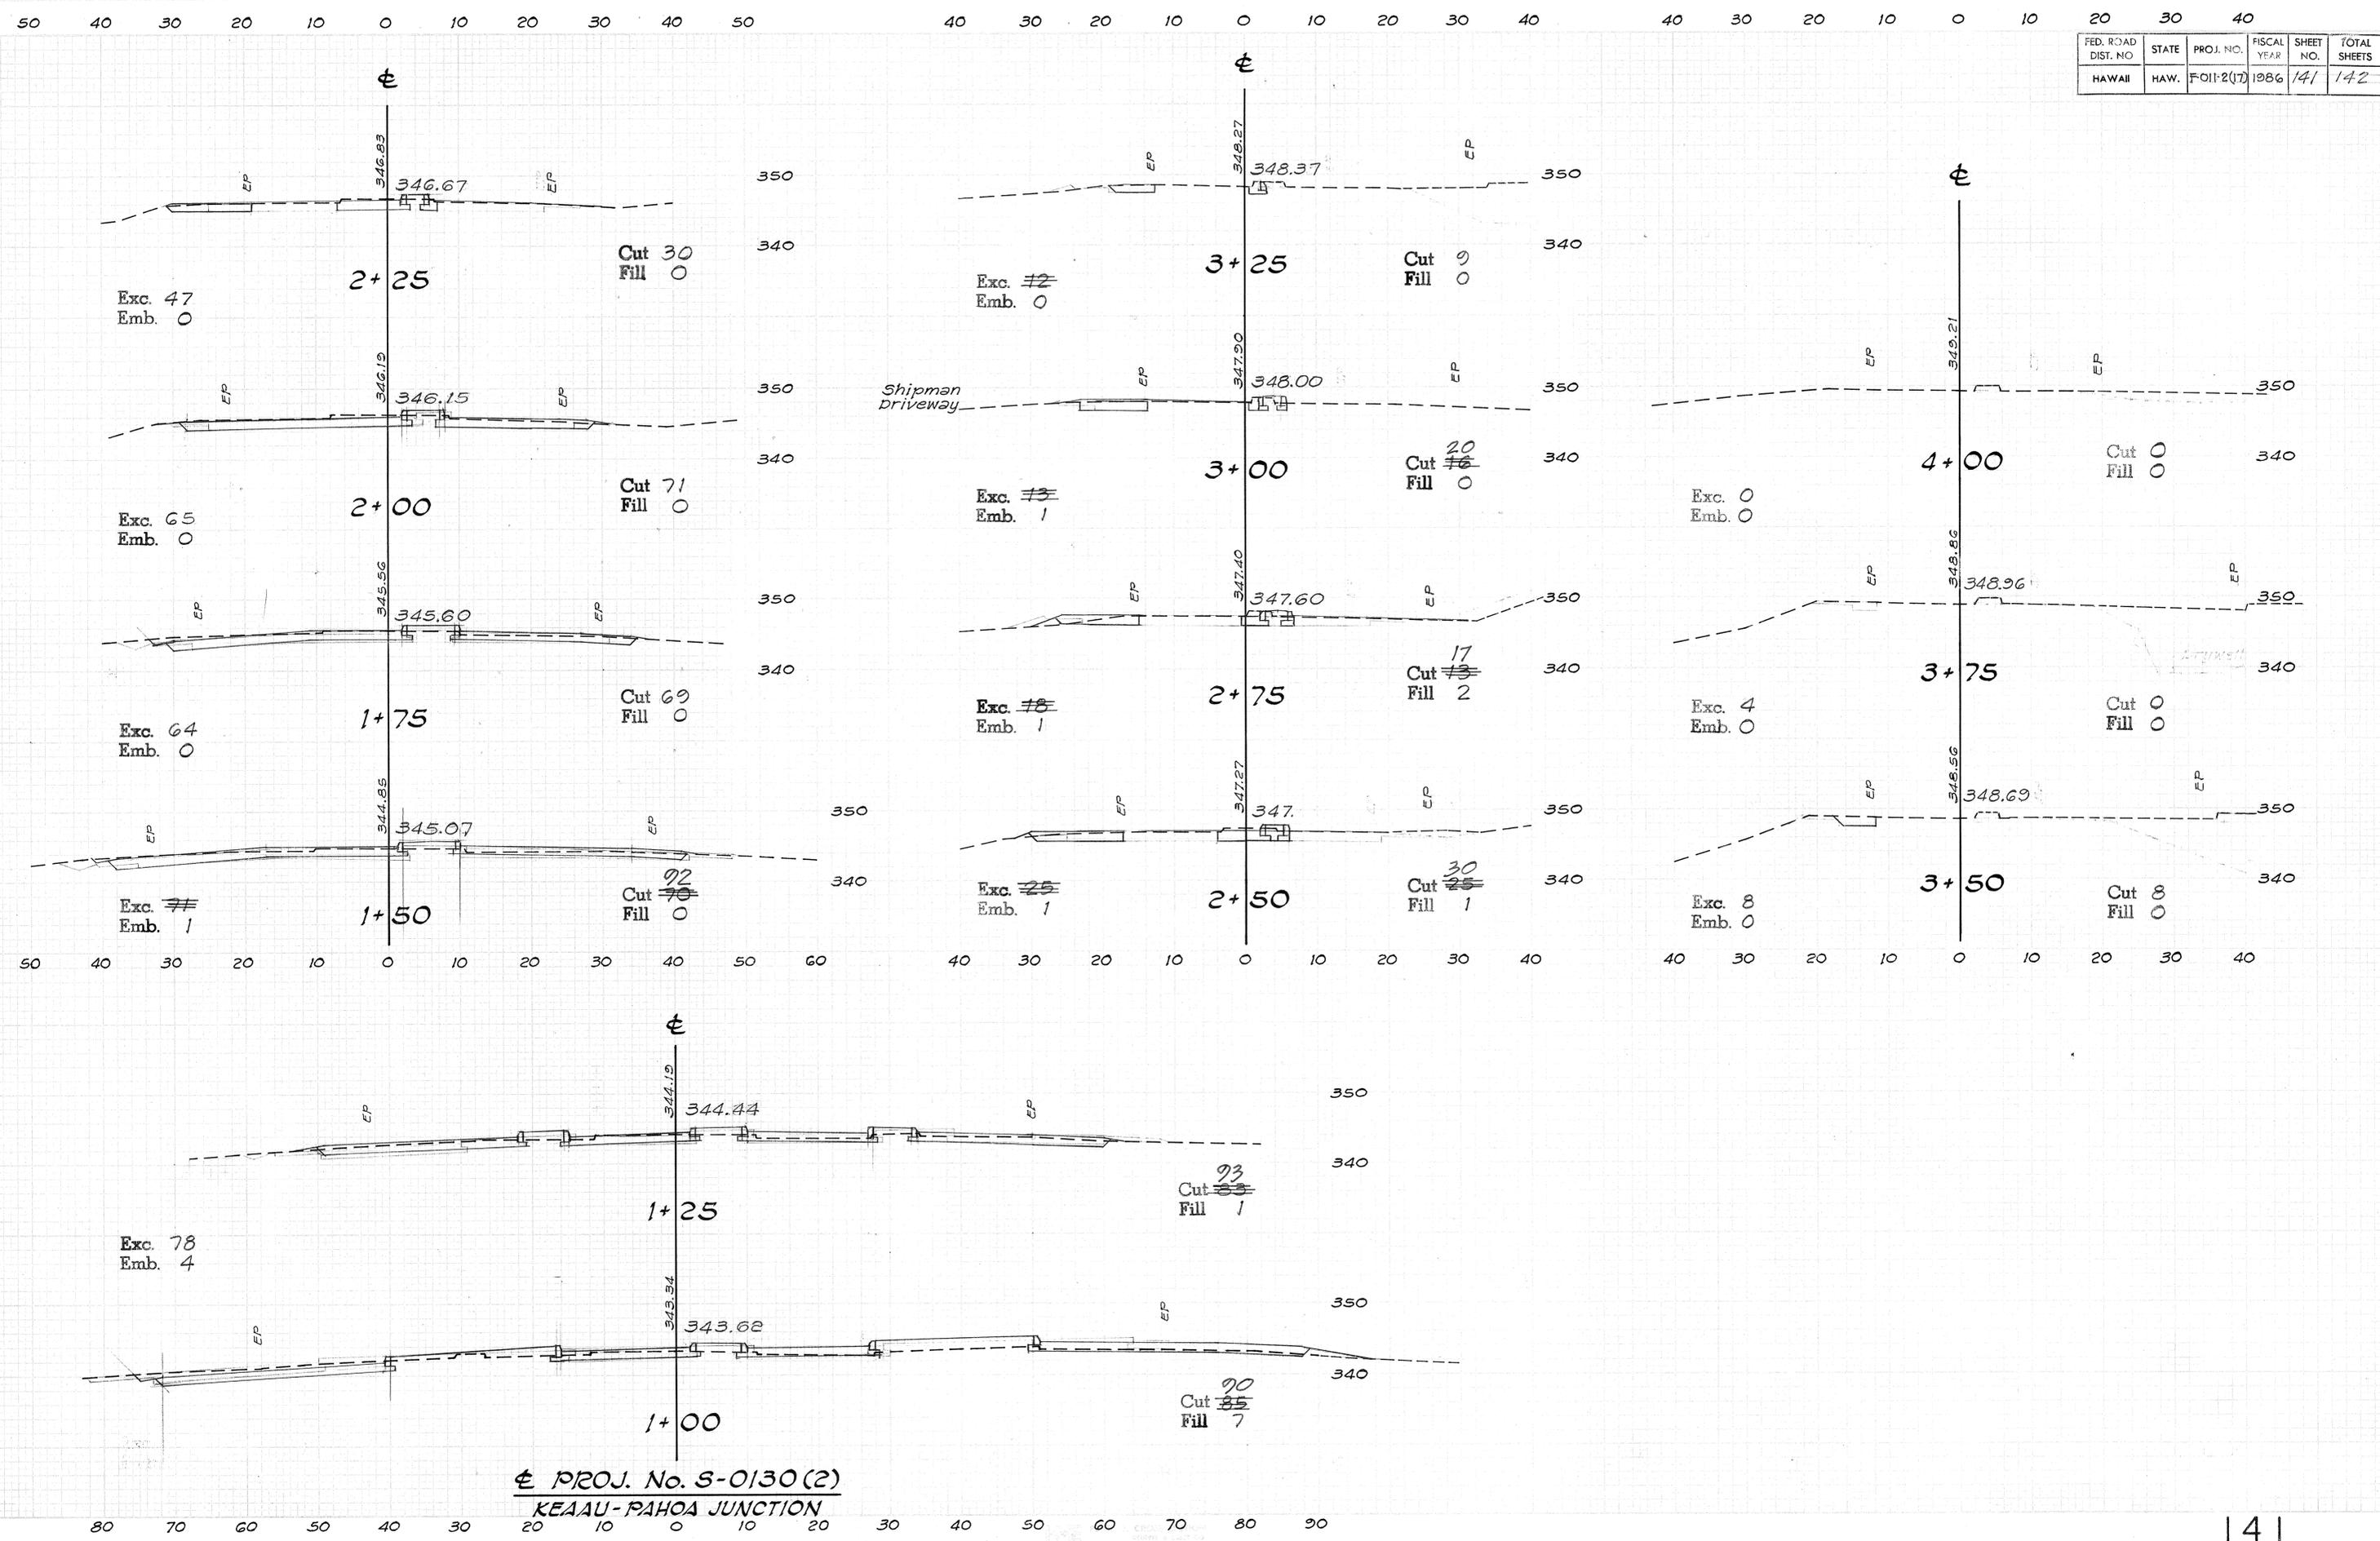


PROJ. No. S-0130(2)
KEAAU-PAHOA JUNCTION

BY	DATE

BY	DATE

FED. ROAD DIST. NO.	STATE	PROJ. NO.	FISCAL YEAR	SHEET NO.	TOTAL SHEETS
HAWAII	HAW.	F.OI-2(17)	1986	142	142


40 30 20 10 0 10 20 30 40

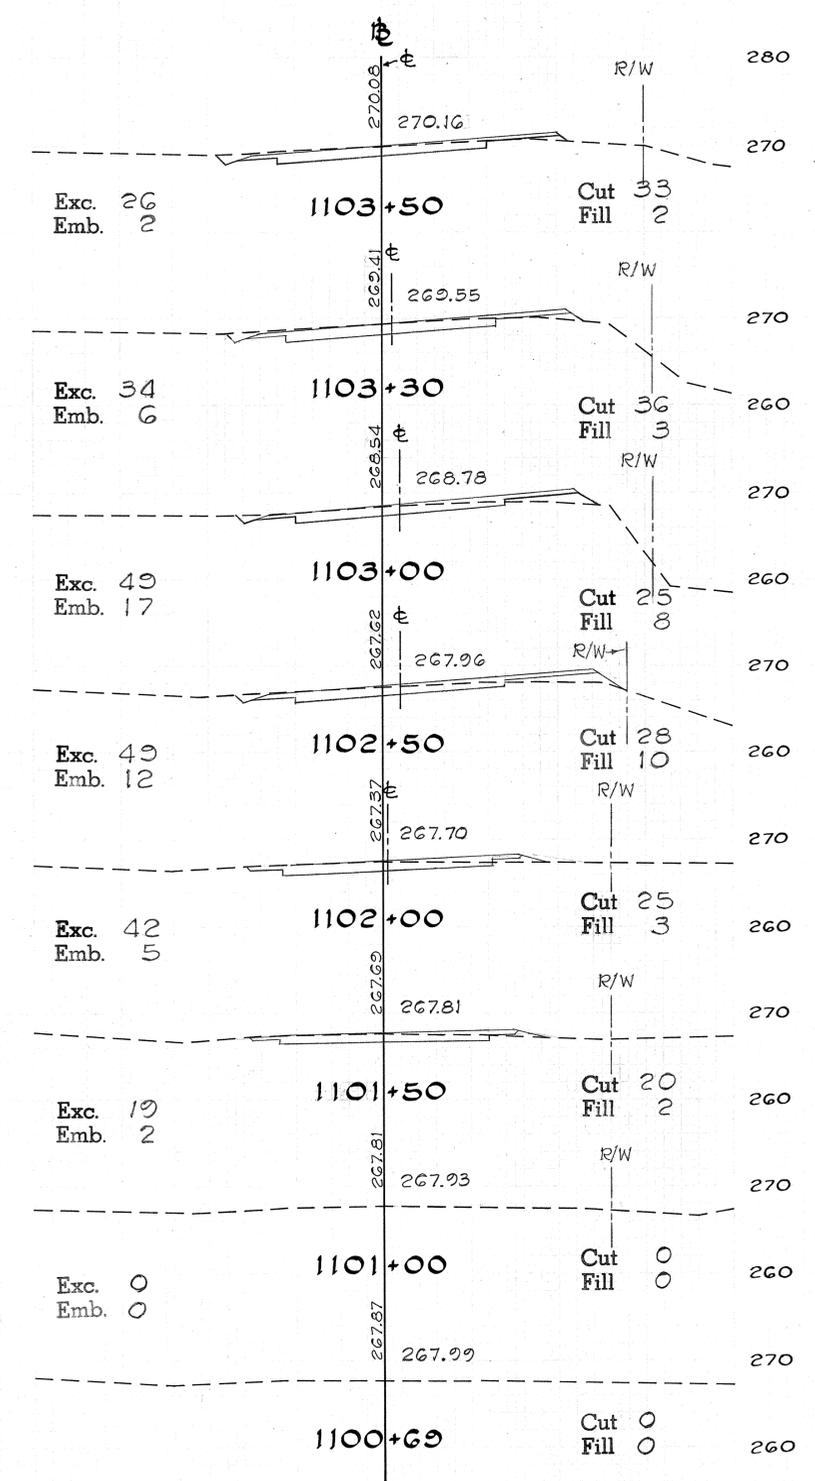

**CROSS SECTION
LOCAL CIRCULATION ROAD**

40 30 20 10 0 10 20 30 40


40 30 20 10 0 10 20 30 40

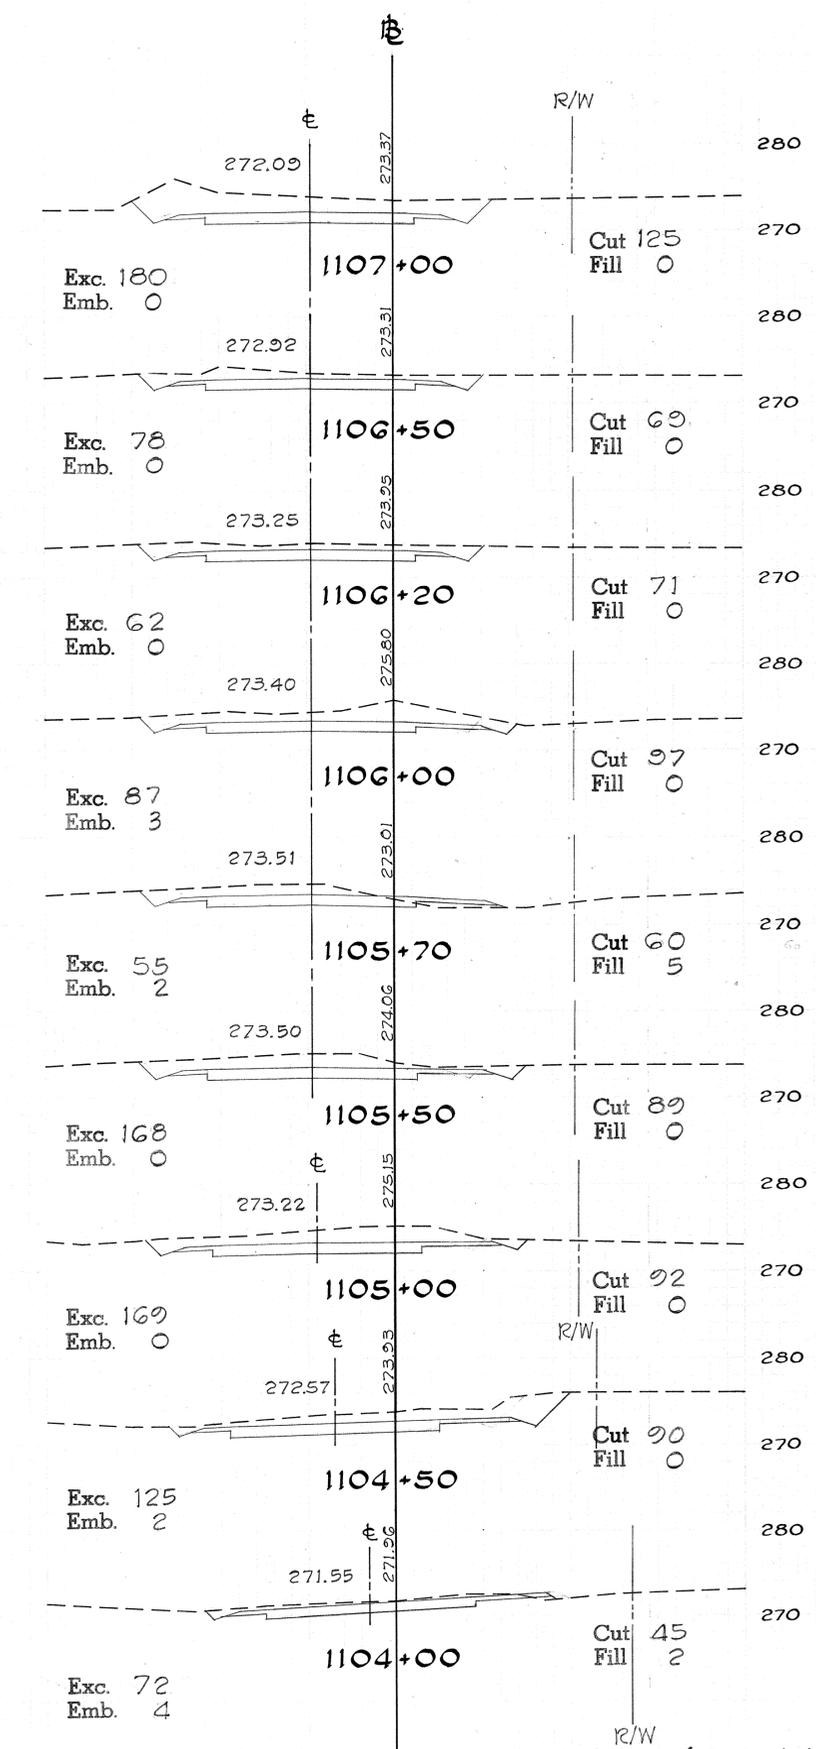

(SUPERSEDED BY SHTS. 1425-1 & 1425-2)

40 30 20 10 0 10 20 30 40

40 30 20 10 0 10 20 30 40

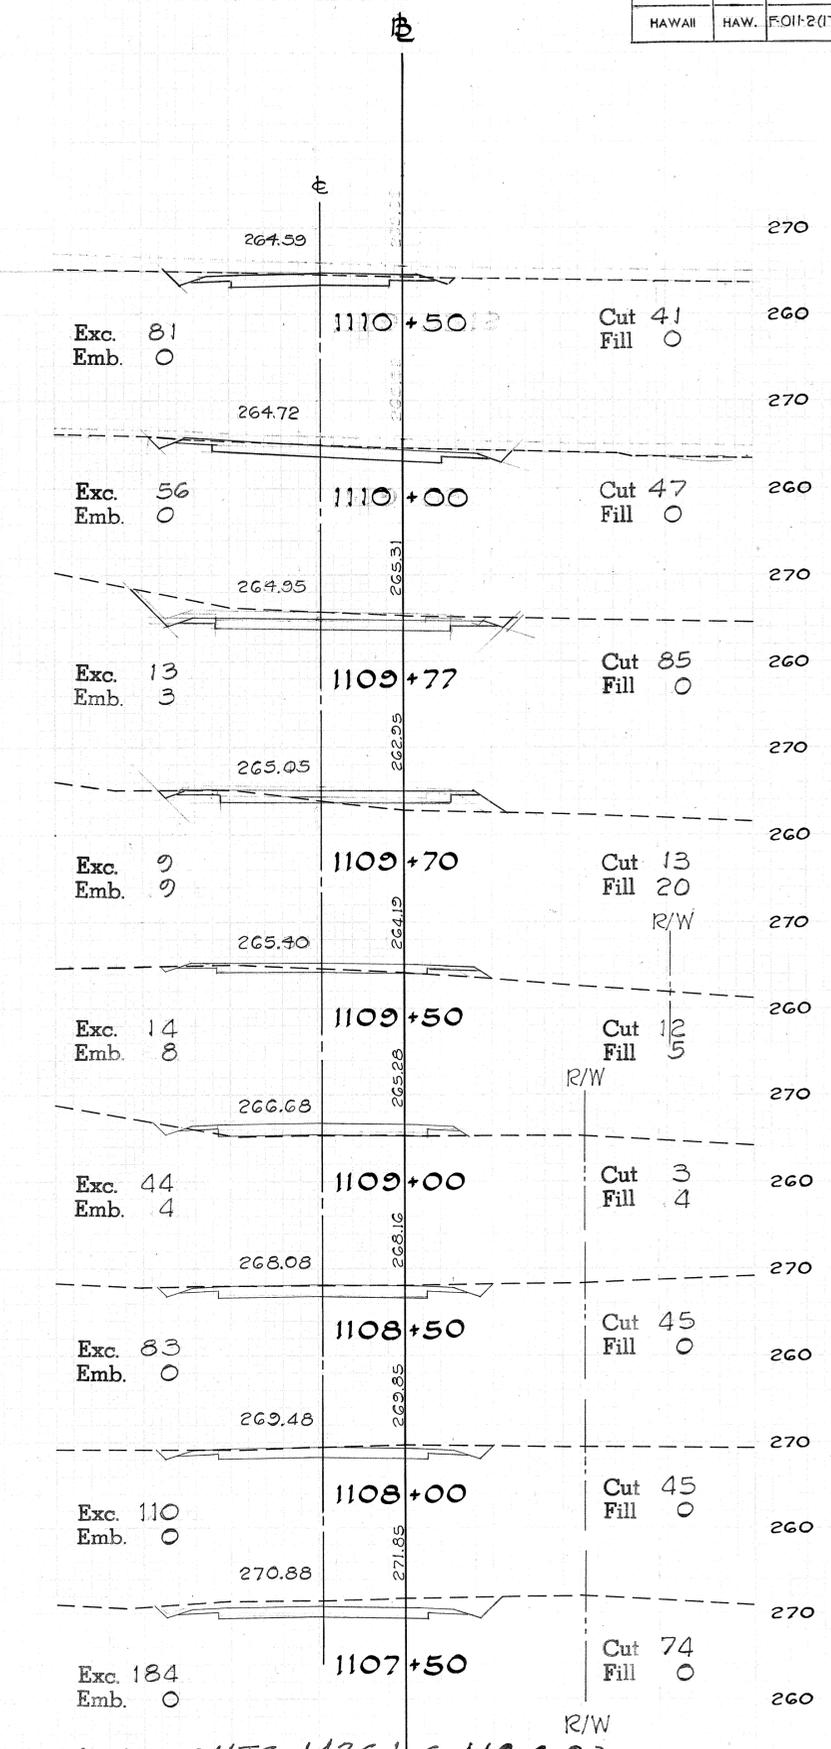

Superseded

142 30

30 20 10 0 10 20 30 40




40 30 20 10 0 10 20 30

40 30 20 10 0 10 20 30

FED. ROAD DIST. NO.	STATE	FED. AID PROJ. NO.	FISCAL YEAR	SHEET NO.	TOTAL SHEETS
HAWAII	HAW.	F-011-2(17)			

DATE	BY	REVISION

DATE	BY	REVISION

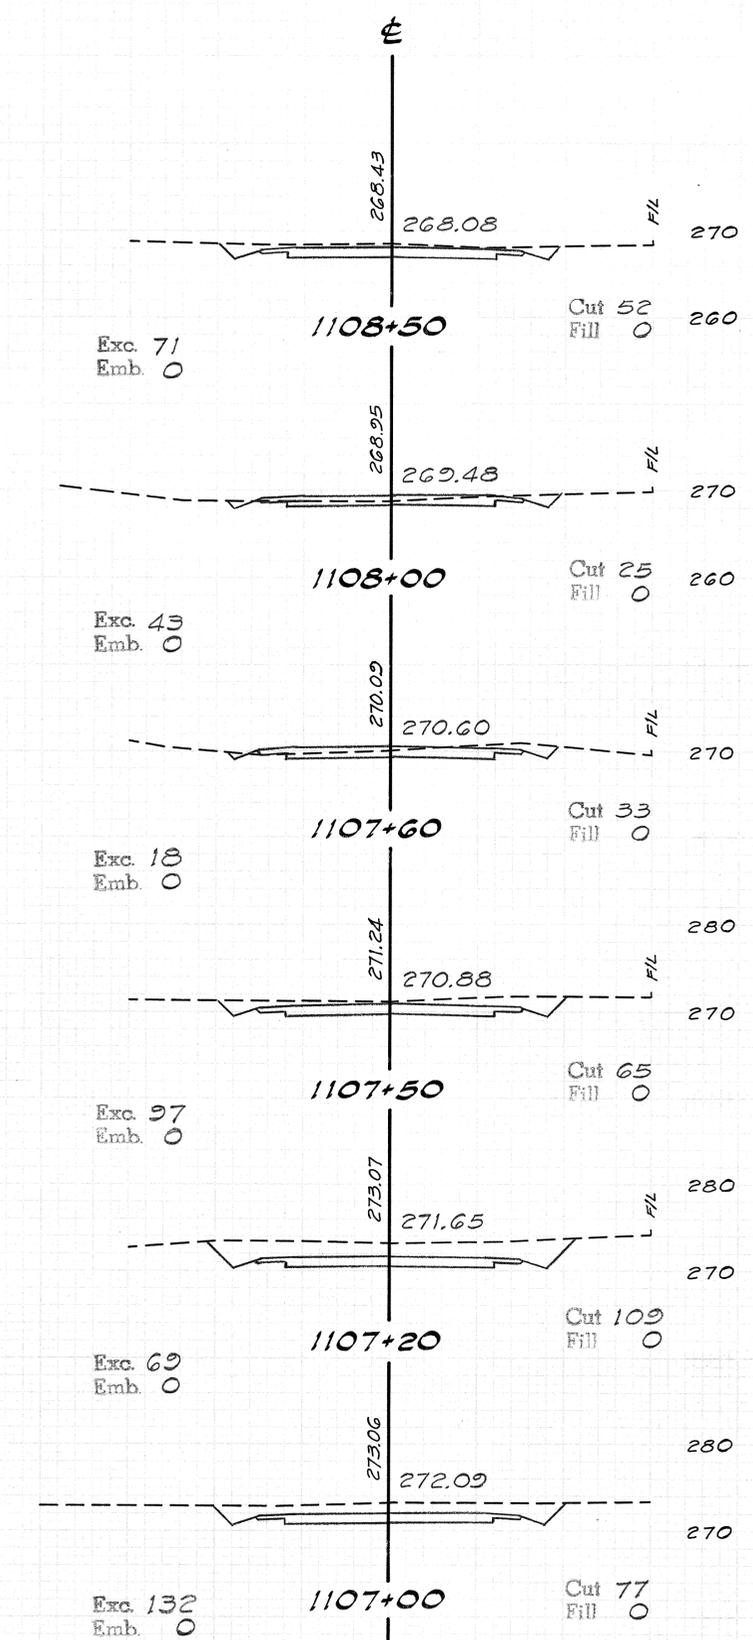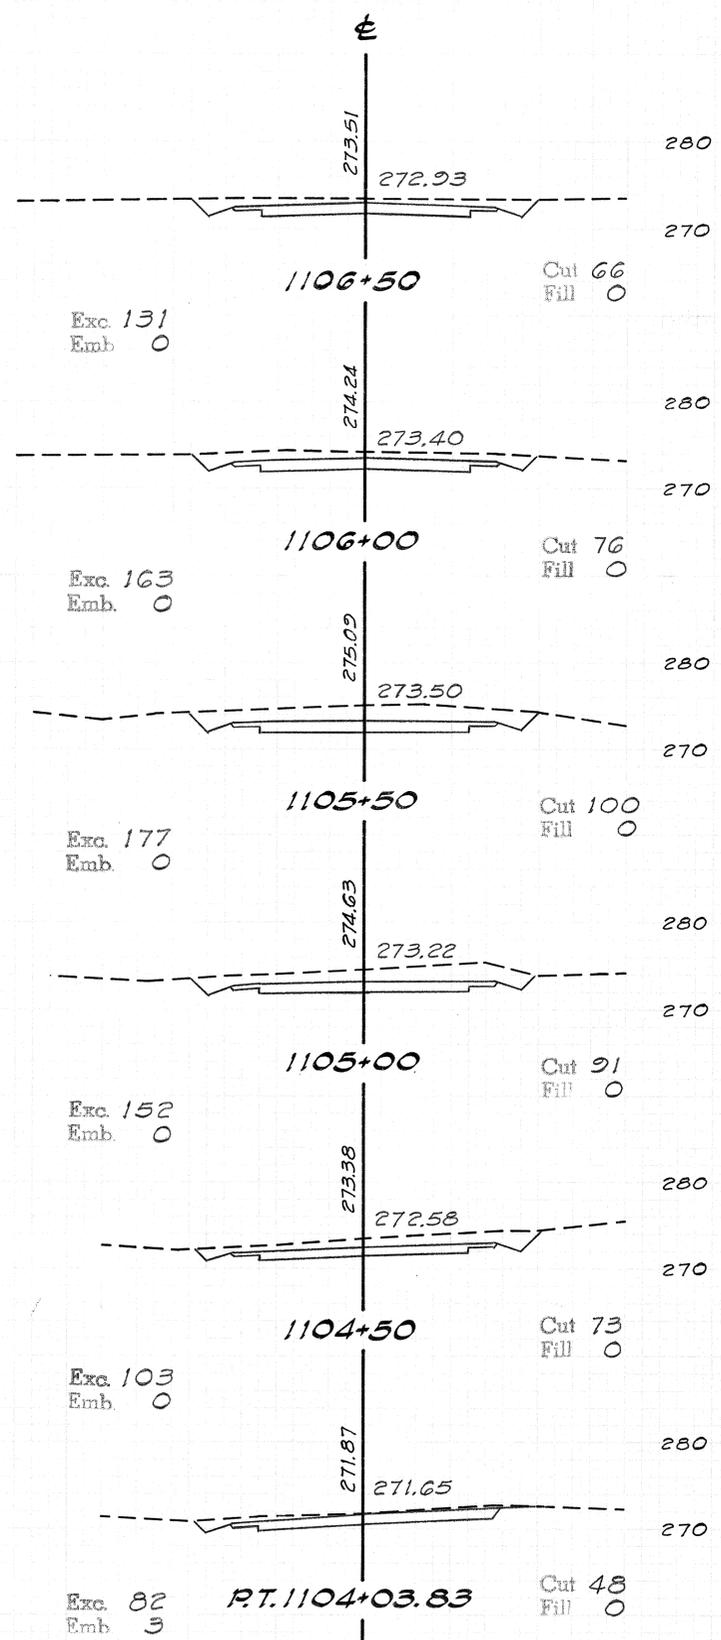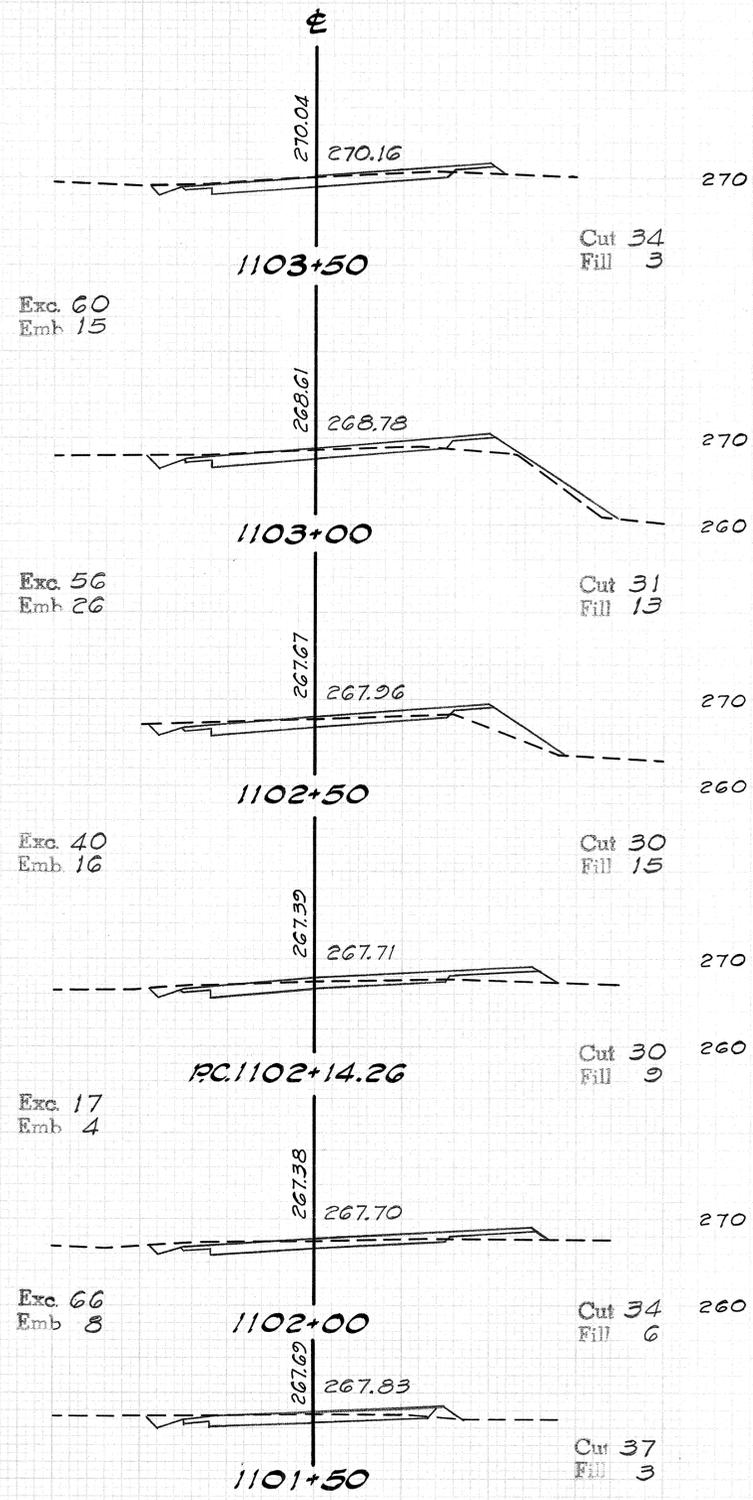

30 20 10 0 10 20 30 40

40 30 20 10 0 10 20 30

40 30 20 10 0 10 20 30

FED. ROAD DIST. NO.	STATE	FED. AID PROJ. NO.	FISCAL YEAR	SHEET NO.	TOTAL SHEETS
HAWAII	HAW.	F-011-2(17)			

30 20 10 0 10 20 30 40 30 20 10 0 10 20 30

DATE	
BT	
NO.	
AREA	
TEMPERATURE	
WIND DIRECTION	
WIND VELOCITY	
MOISTURE	
BAROMETER	
RAIN	
WIND	
TEMPERATURE	
WIND DIRECTION	
WIND VELOCITY	
MOISTURE	
BAROMETER	
RAIN	
WIND	

DATE	
BT	
NO.	
AREA	
TEMPERATURE	
WIND DIRECTION	
WIND VELOCITY	
MOISTURE	
BAROMETER	
RAIN	
WIND	
TEMPERATURE	
WIND DIRECTION	
WIND VELOCITY	
MOISTURE	
BAROMETER	
RAIN	
WIND	

