

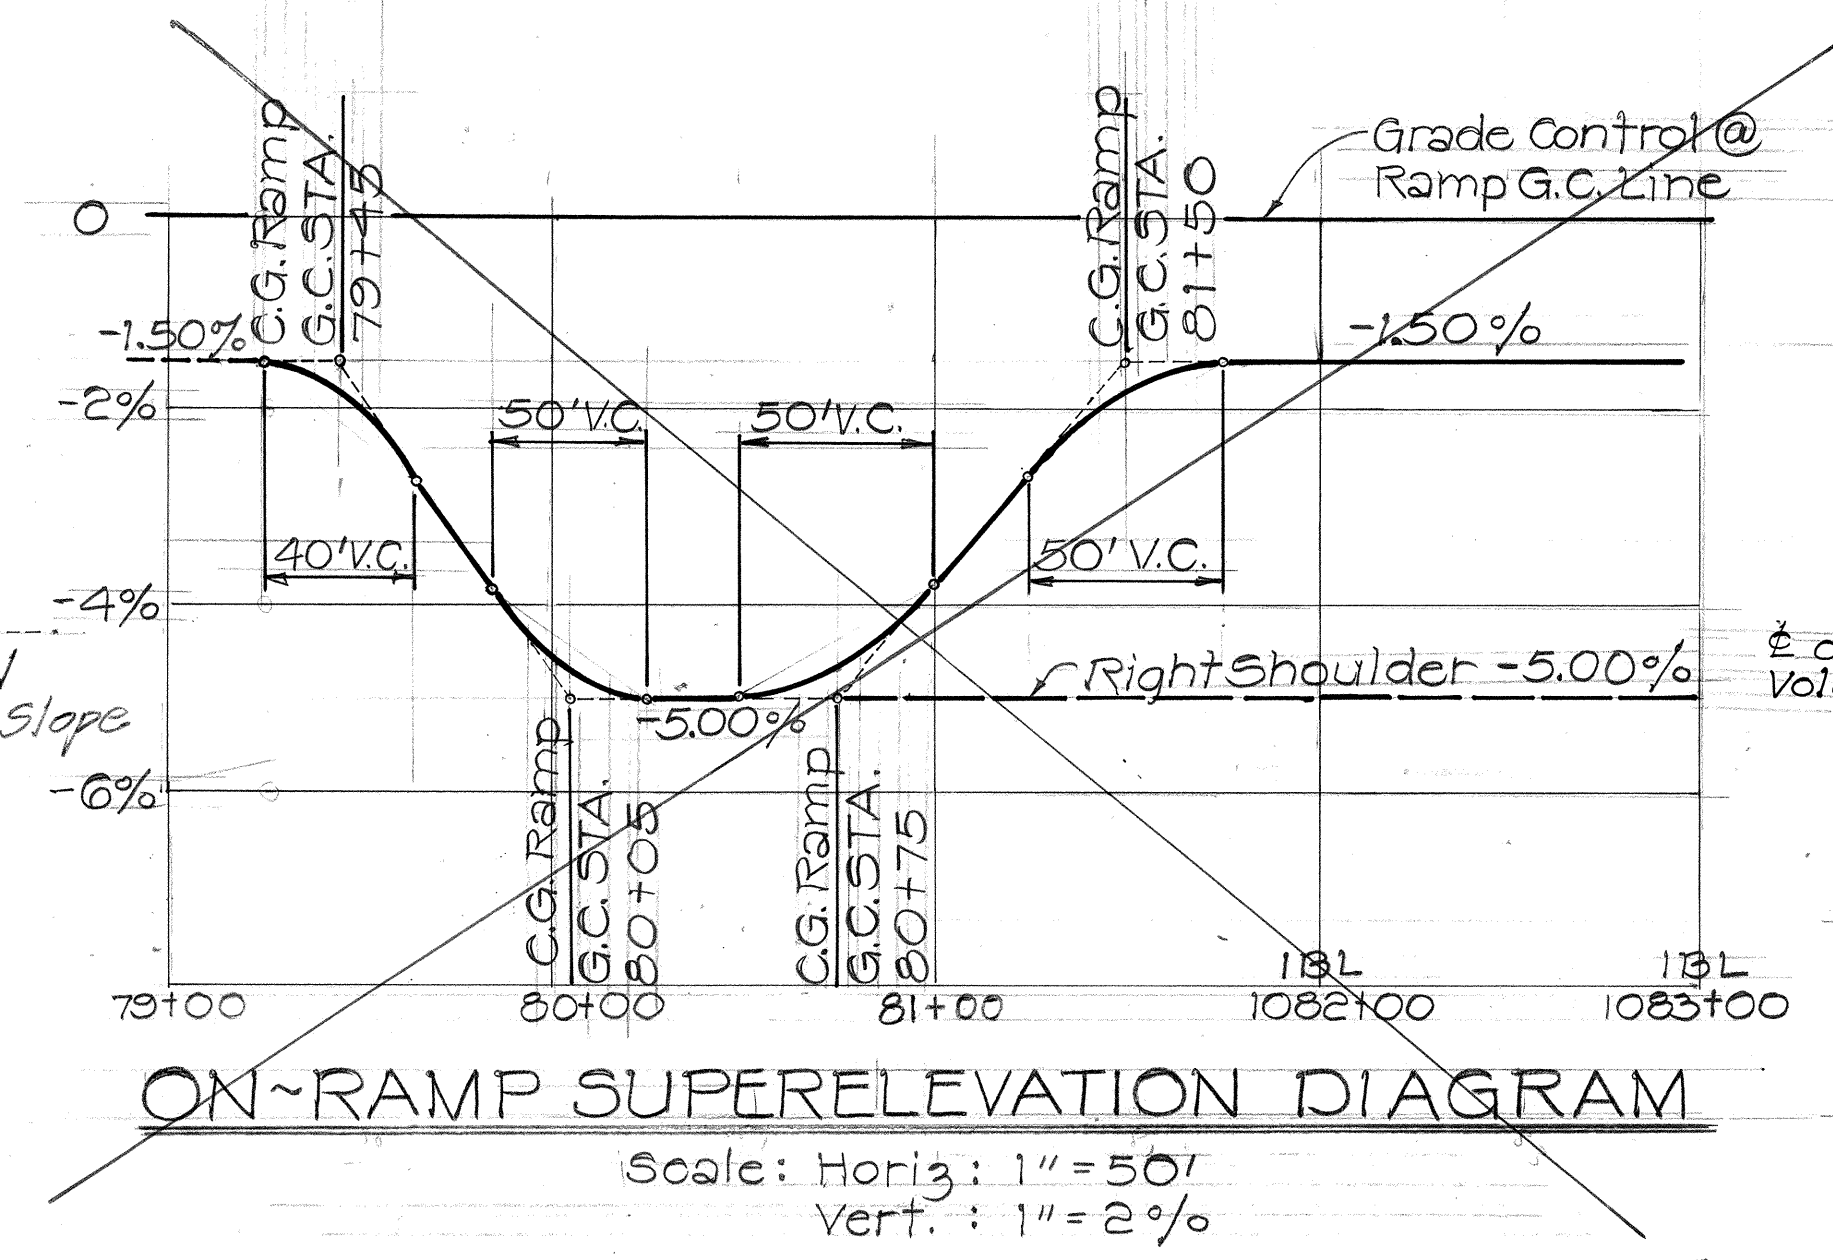


FED. ROAD DIST. NO.	STATE	FED. AID PROJ. NO.	FISCAL YEAR	SHEET NO.	TOTAL SHEETS
HAWAII	HAW.	F-011-2(17)	1986	20	142


PLAN	DATE	BY
SURVEYED		
NOTE BOOK		
NO.		

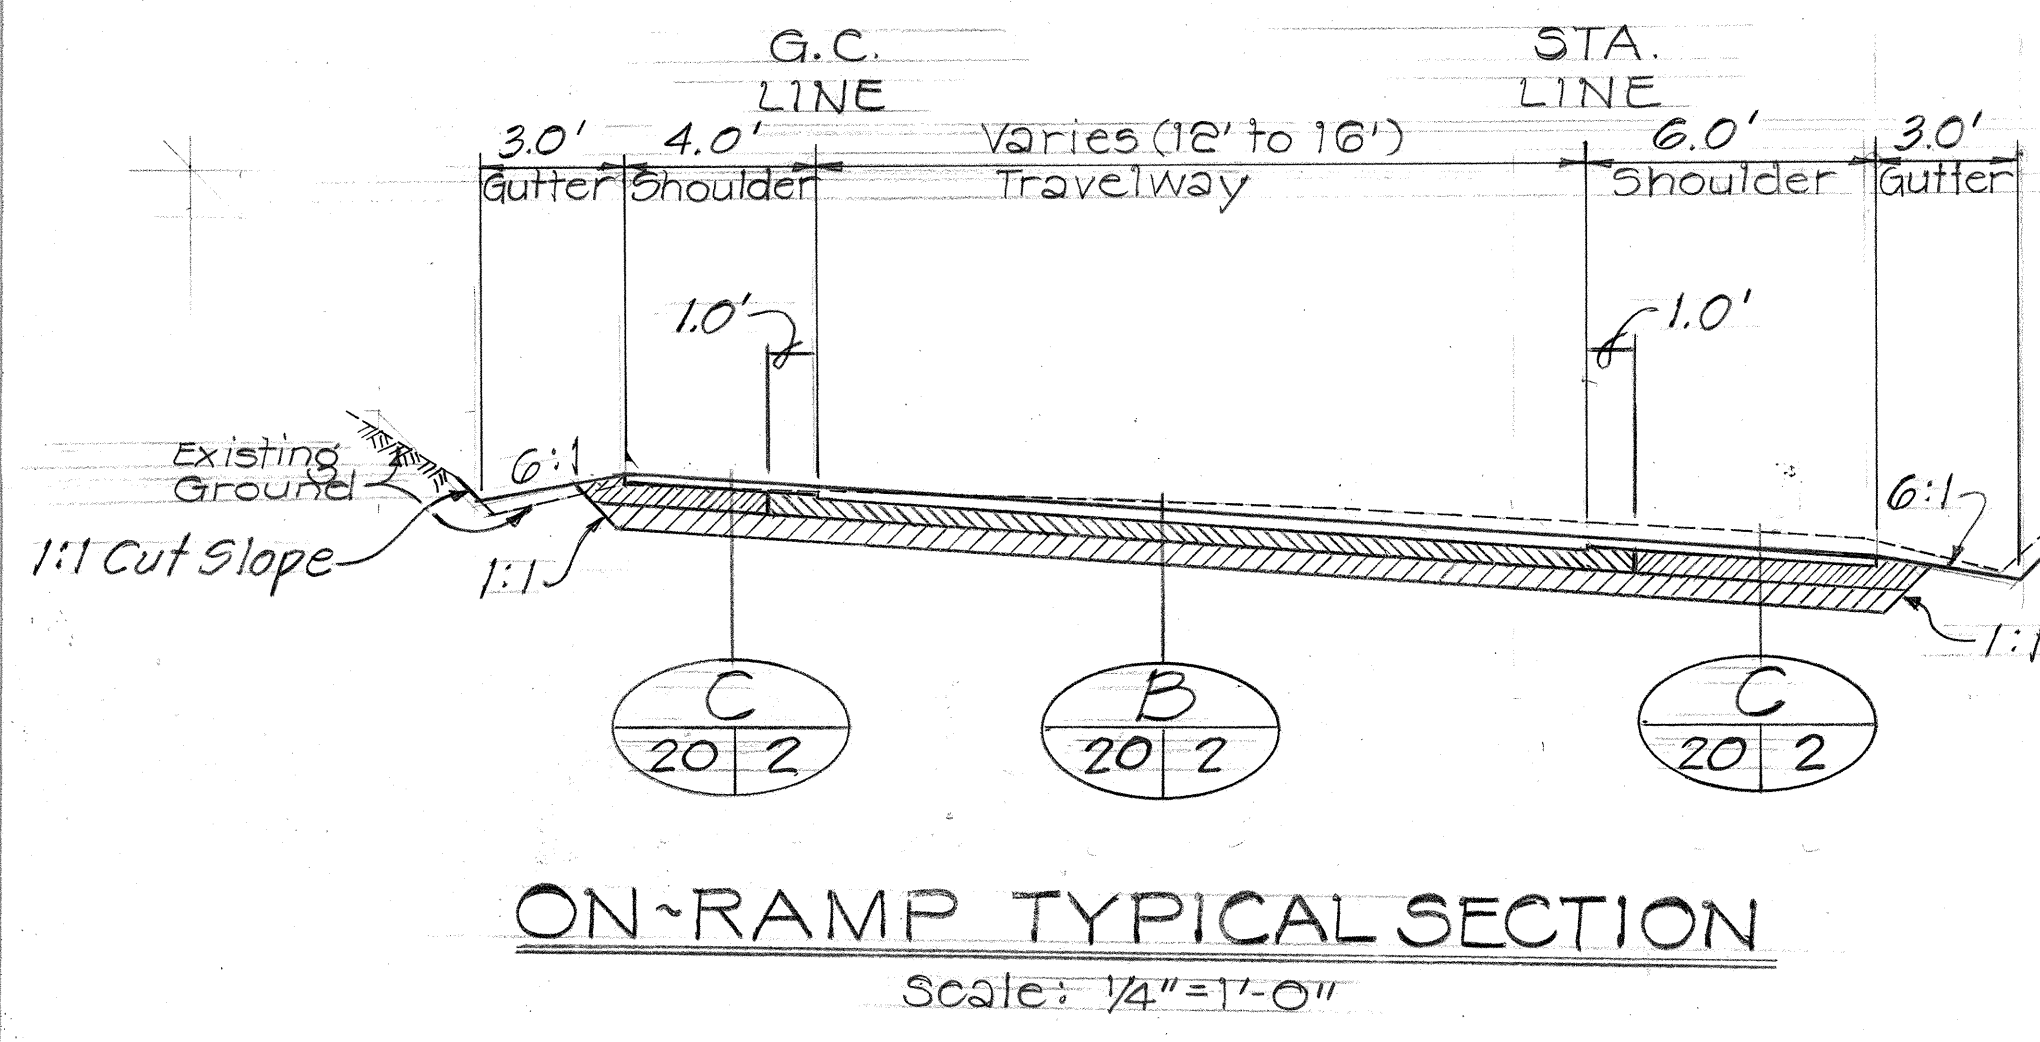







NOTE: See Sheet No. 20 S-1
For Revised On-Ramp Plan,
Profile and Superelevation.

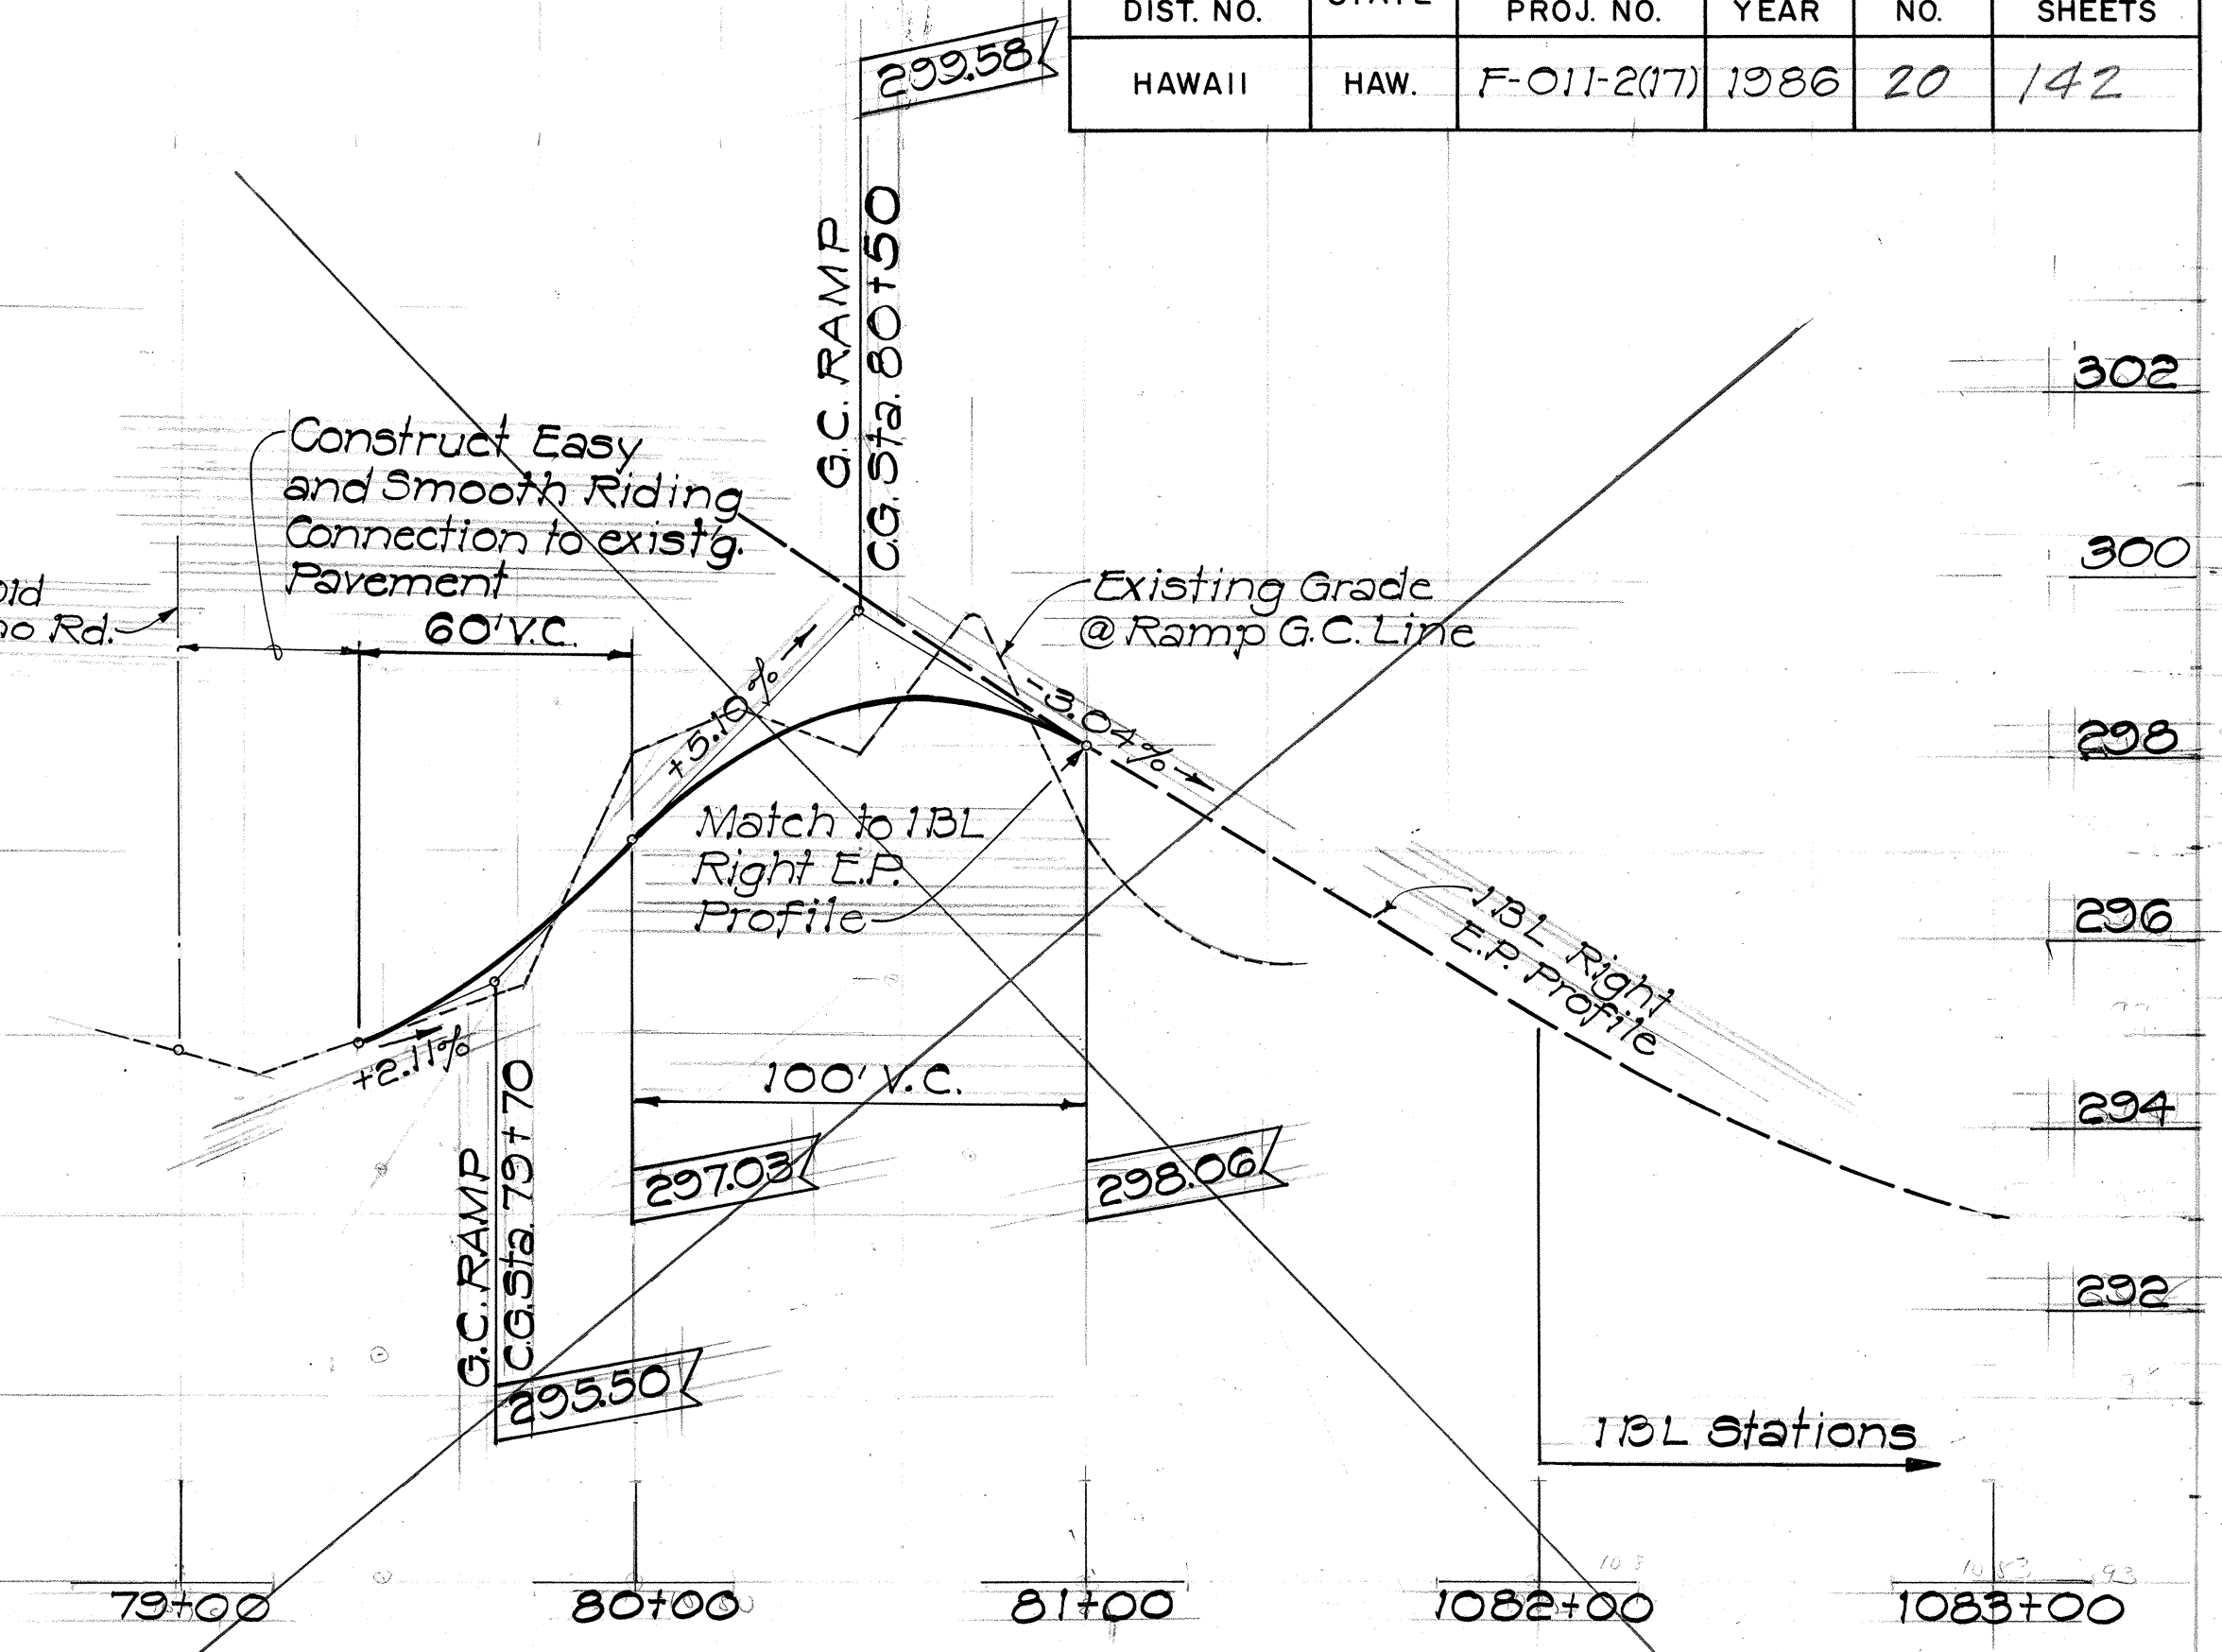

PROFILE	DATE	BY
SURVEYED		
NOTE BOOK		
NO.		

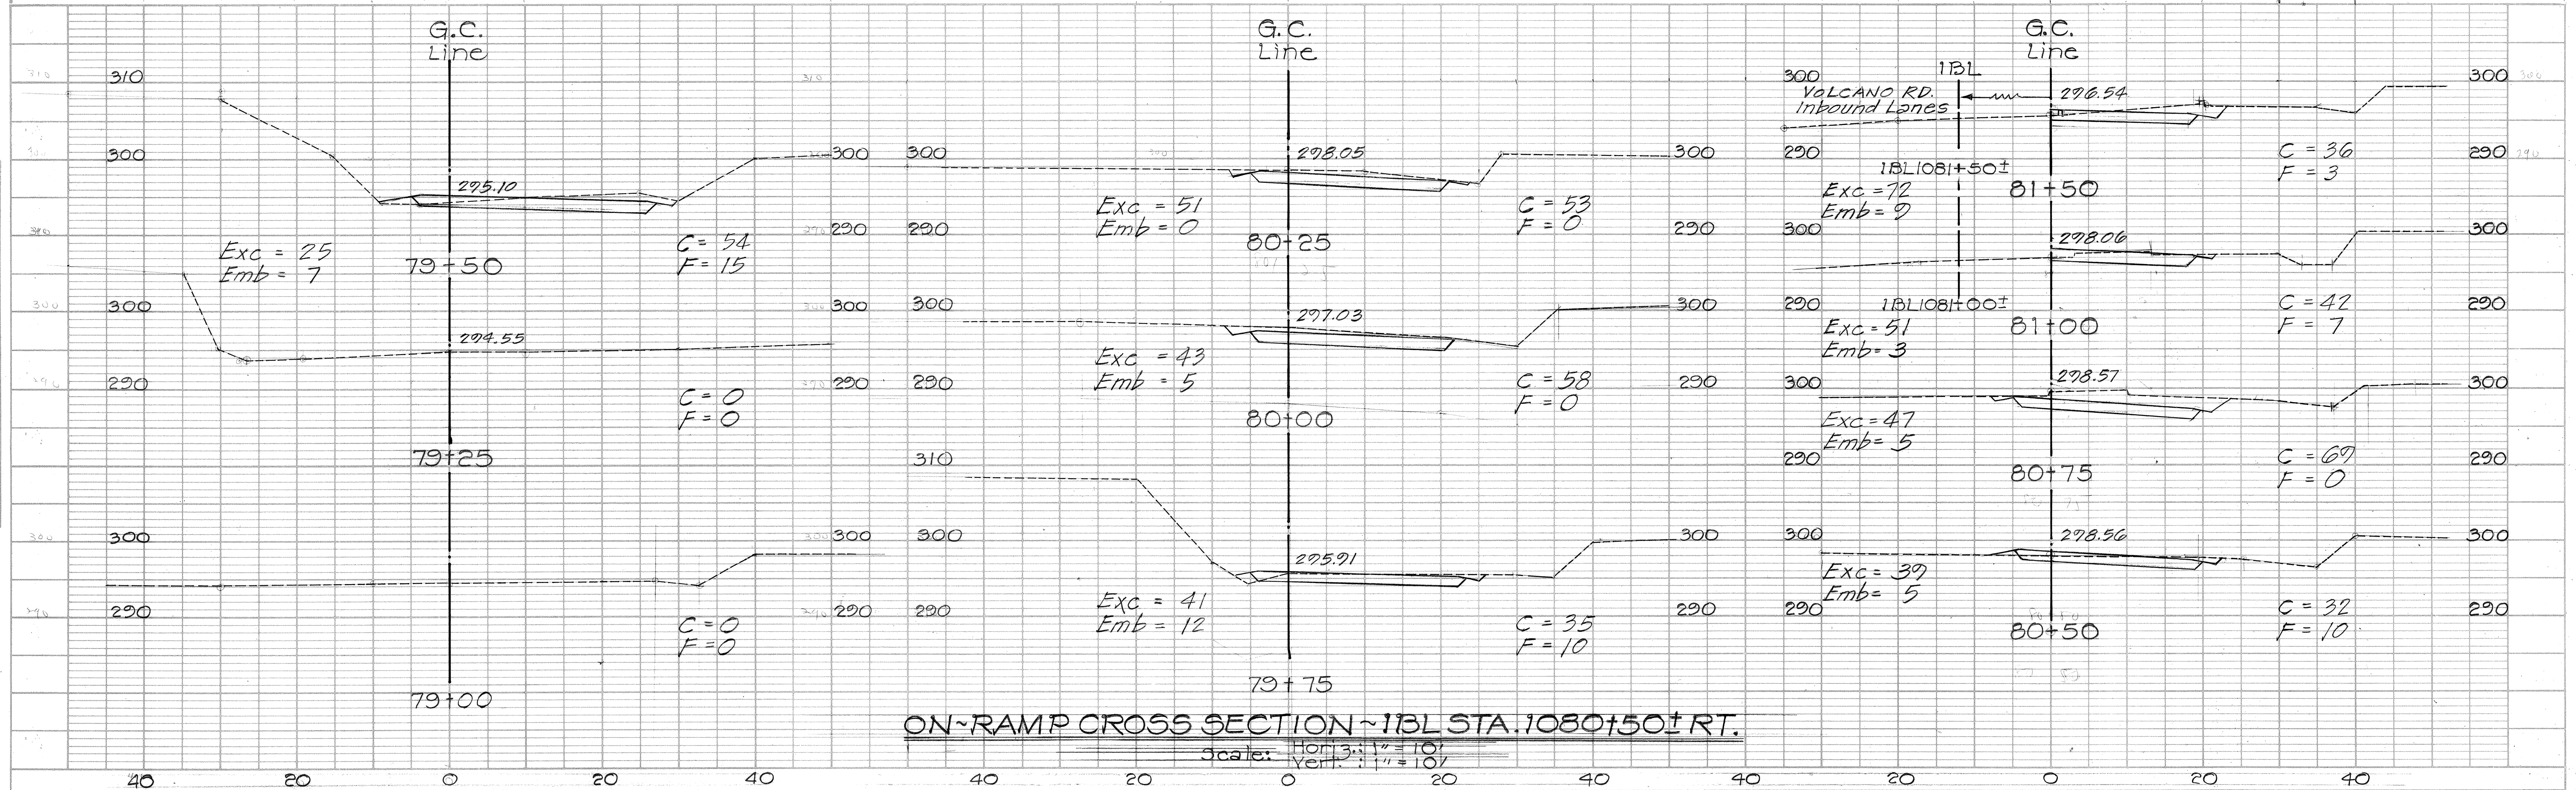

FED. ROAD DIST. NO.	STATE	FED. AID PROJ. NO.	FISCAL YEAR	SHEET NO.	TOTAL SHEETS
HAWAII	HAW.	F-011-2 (17) R59-0130(22)		205-1	

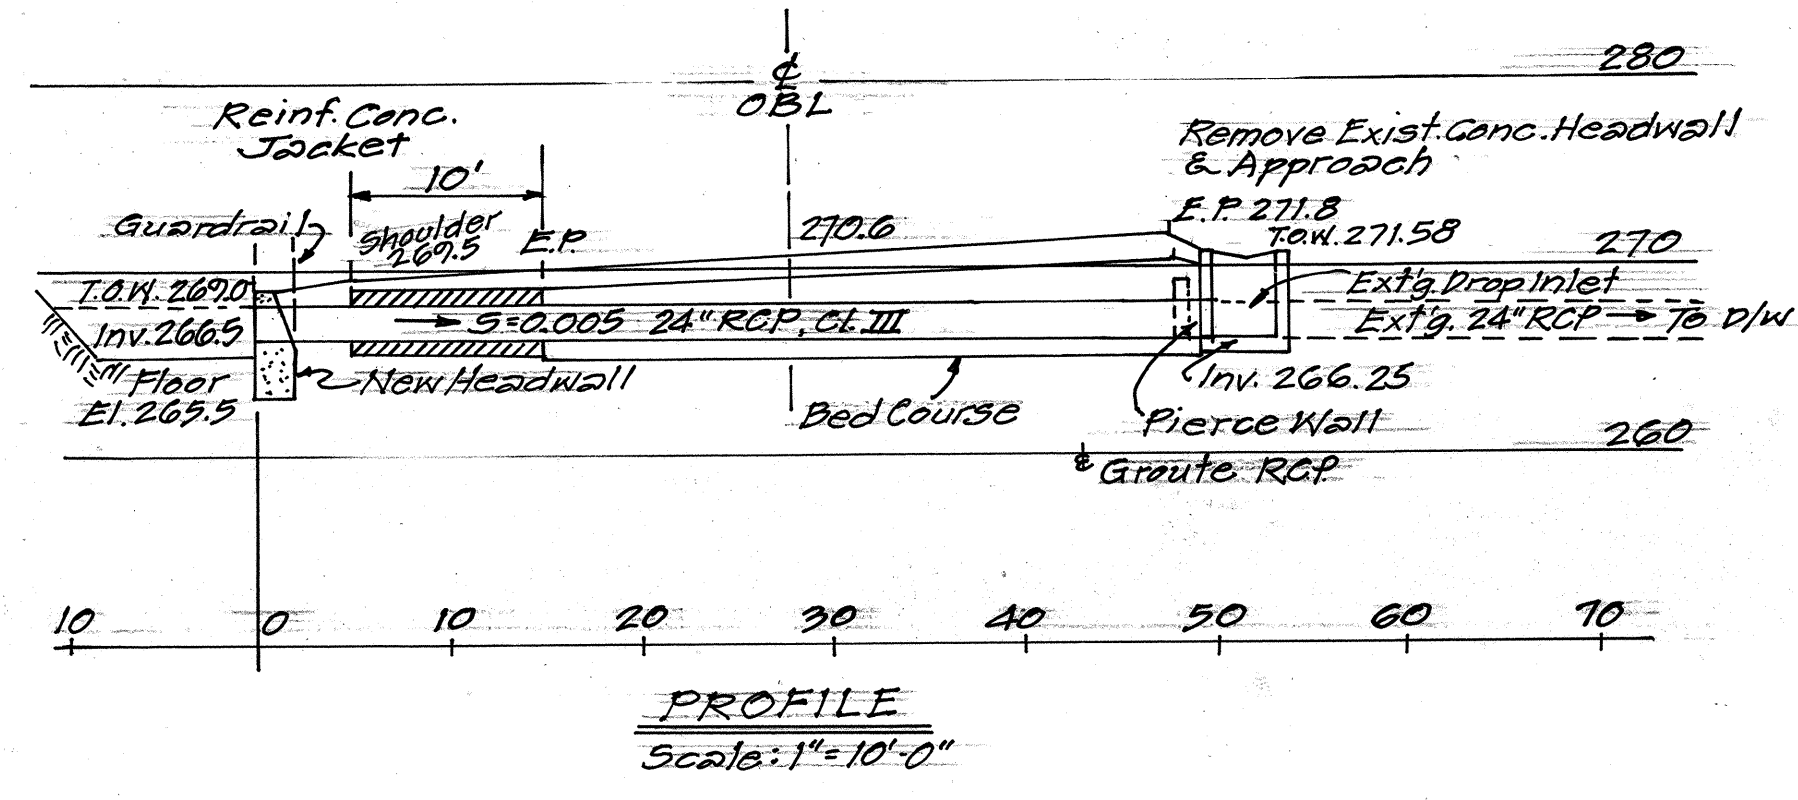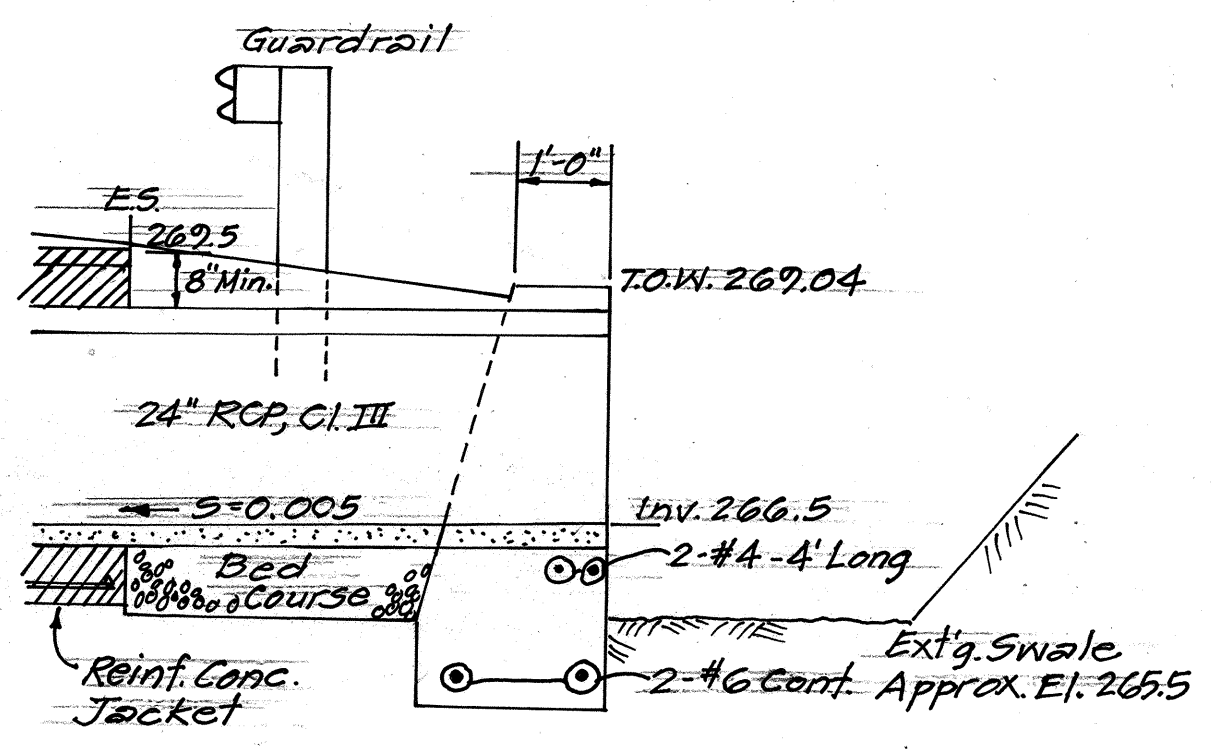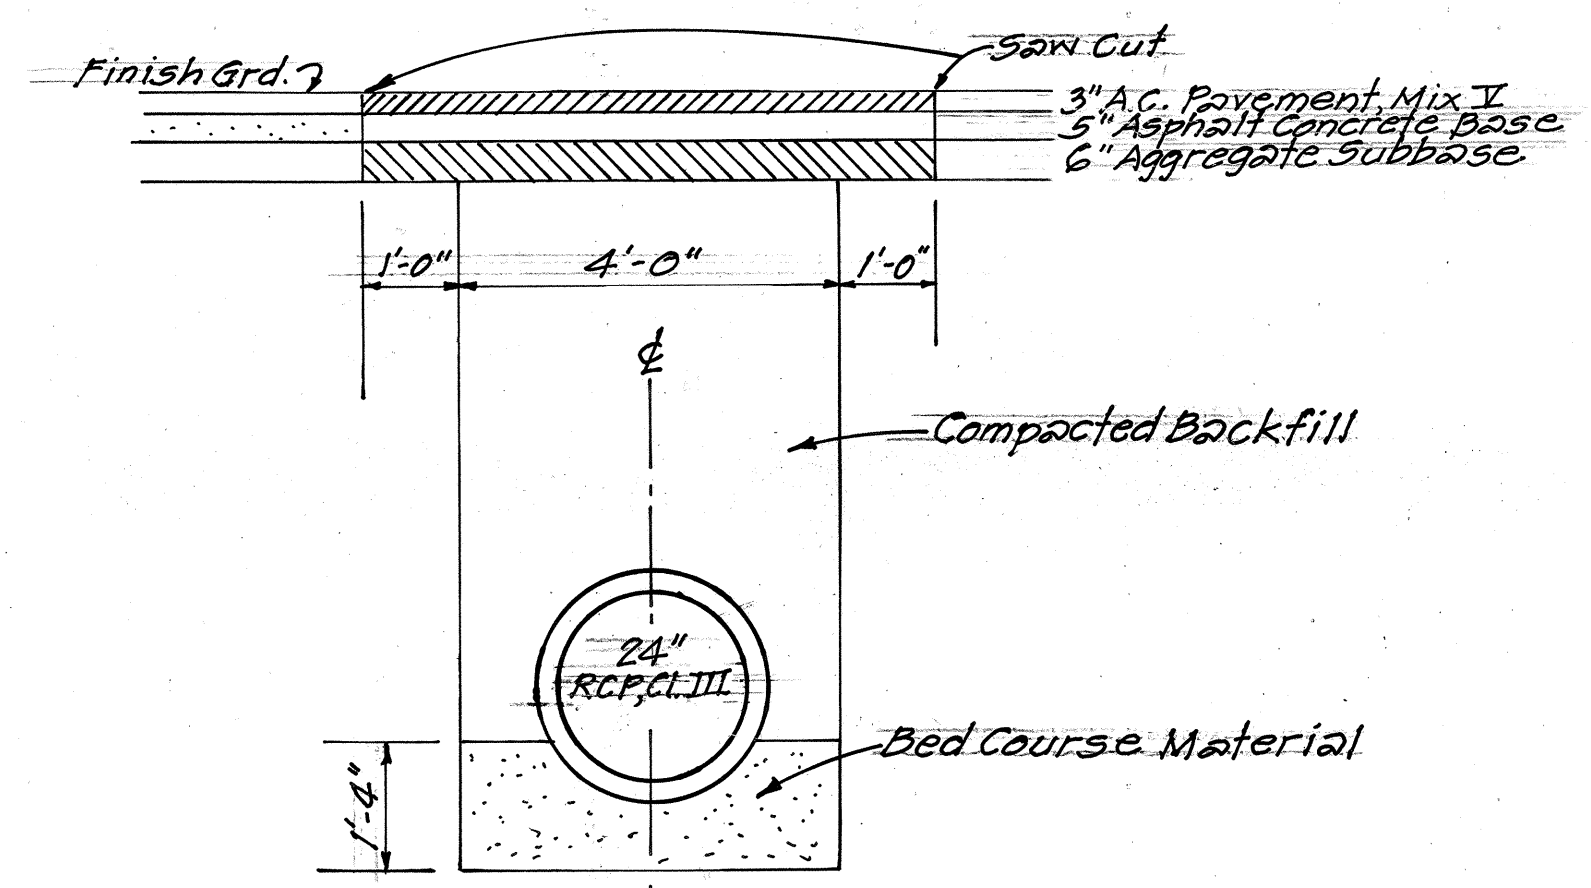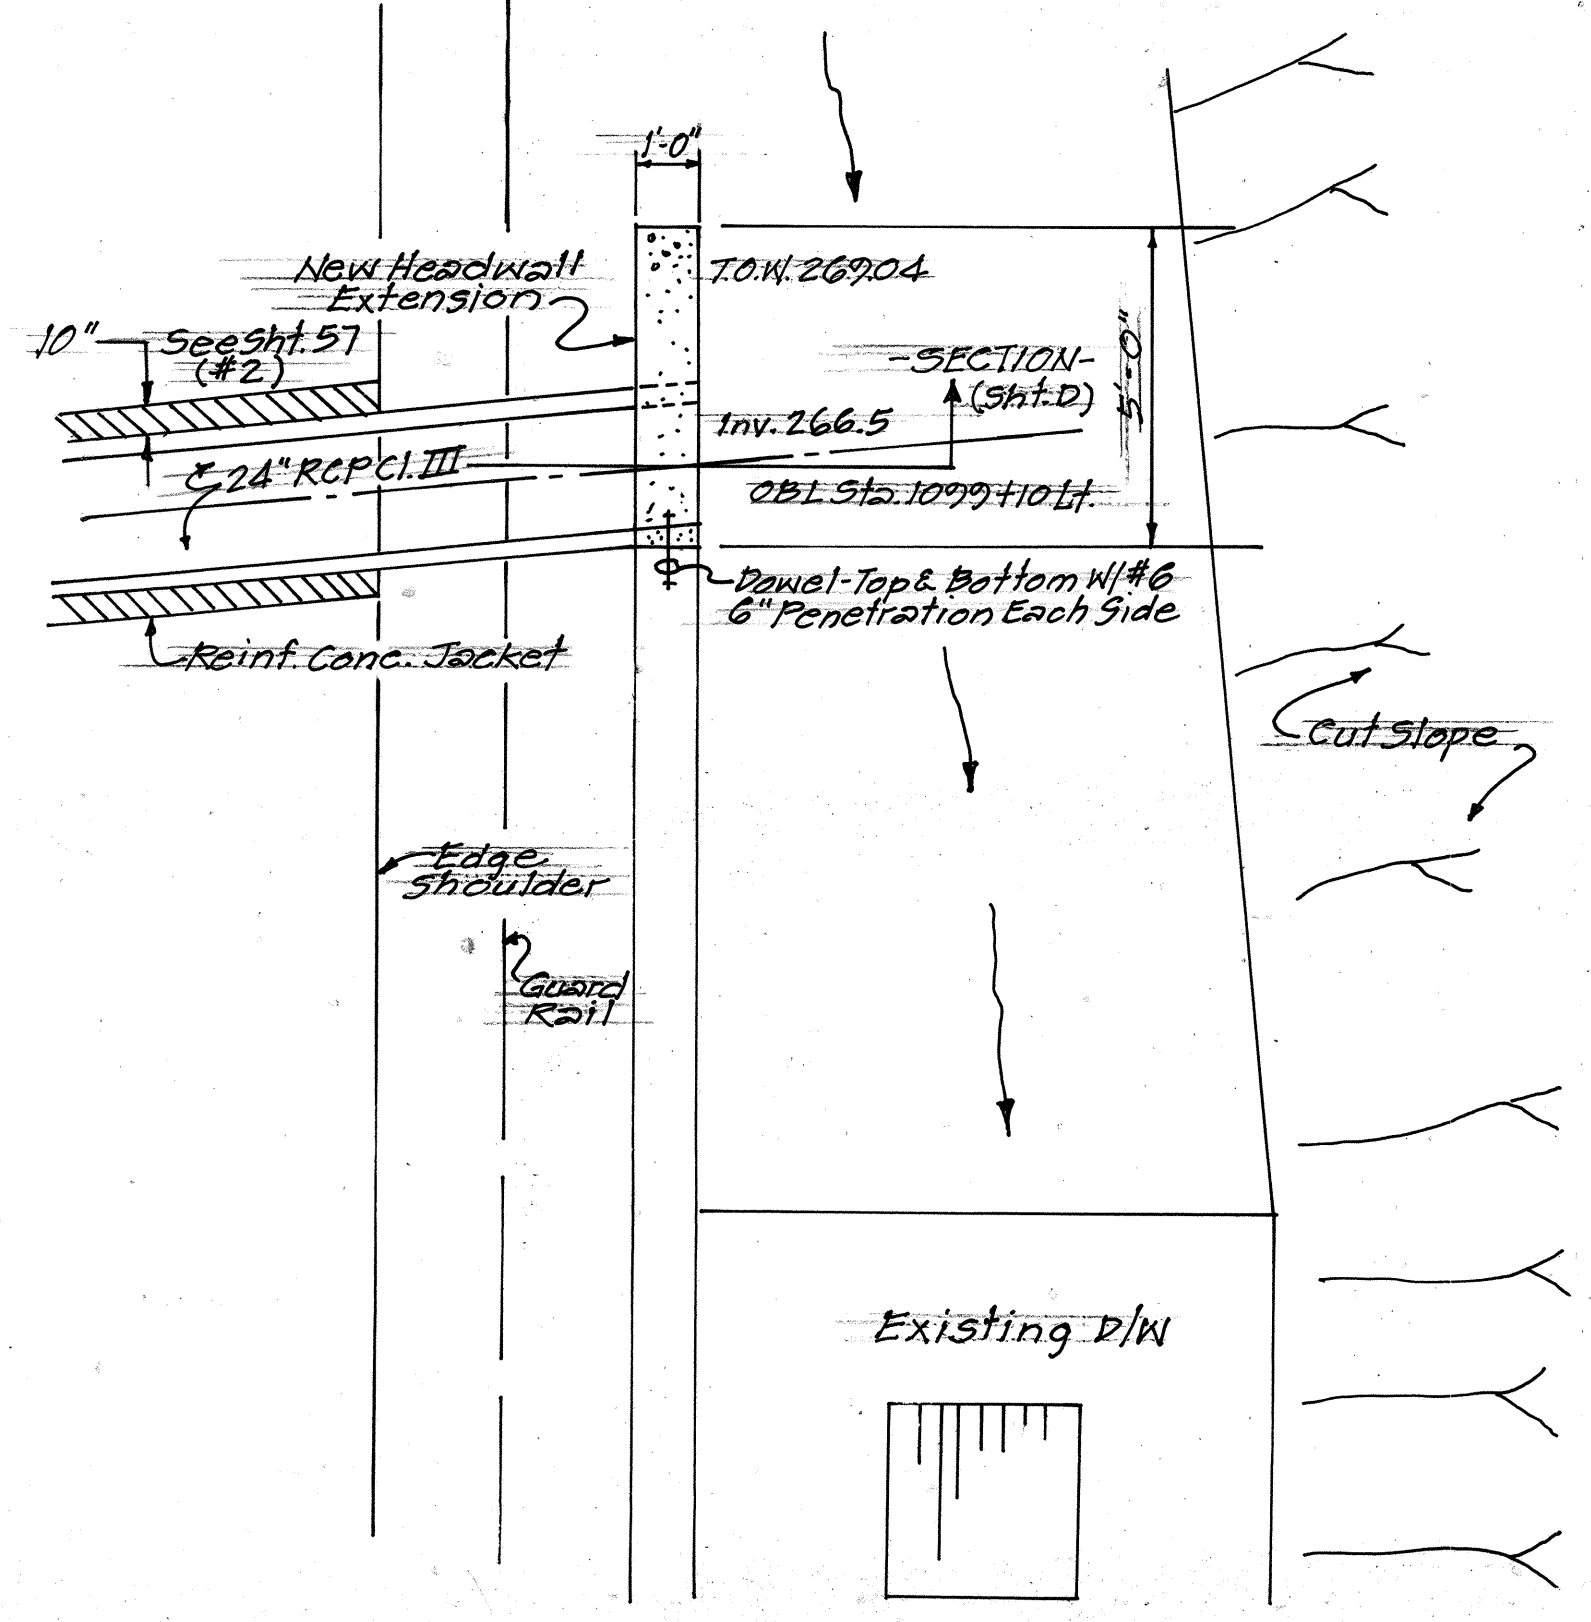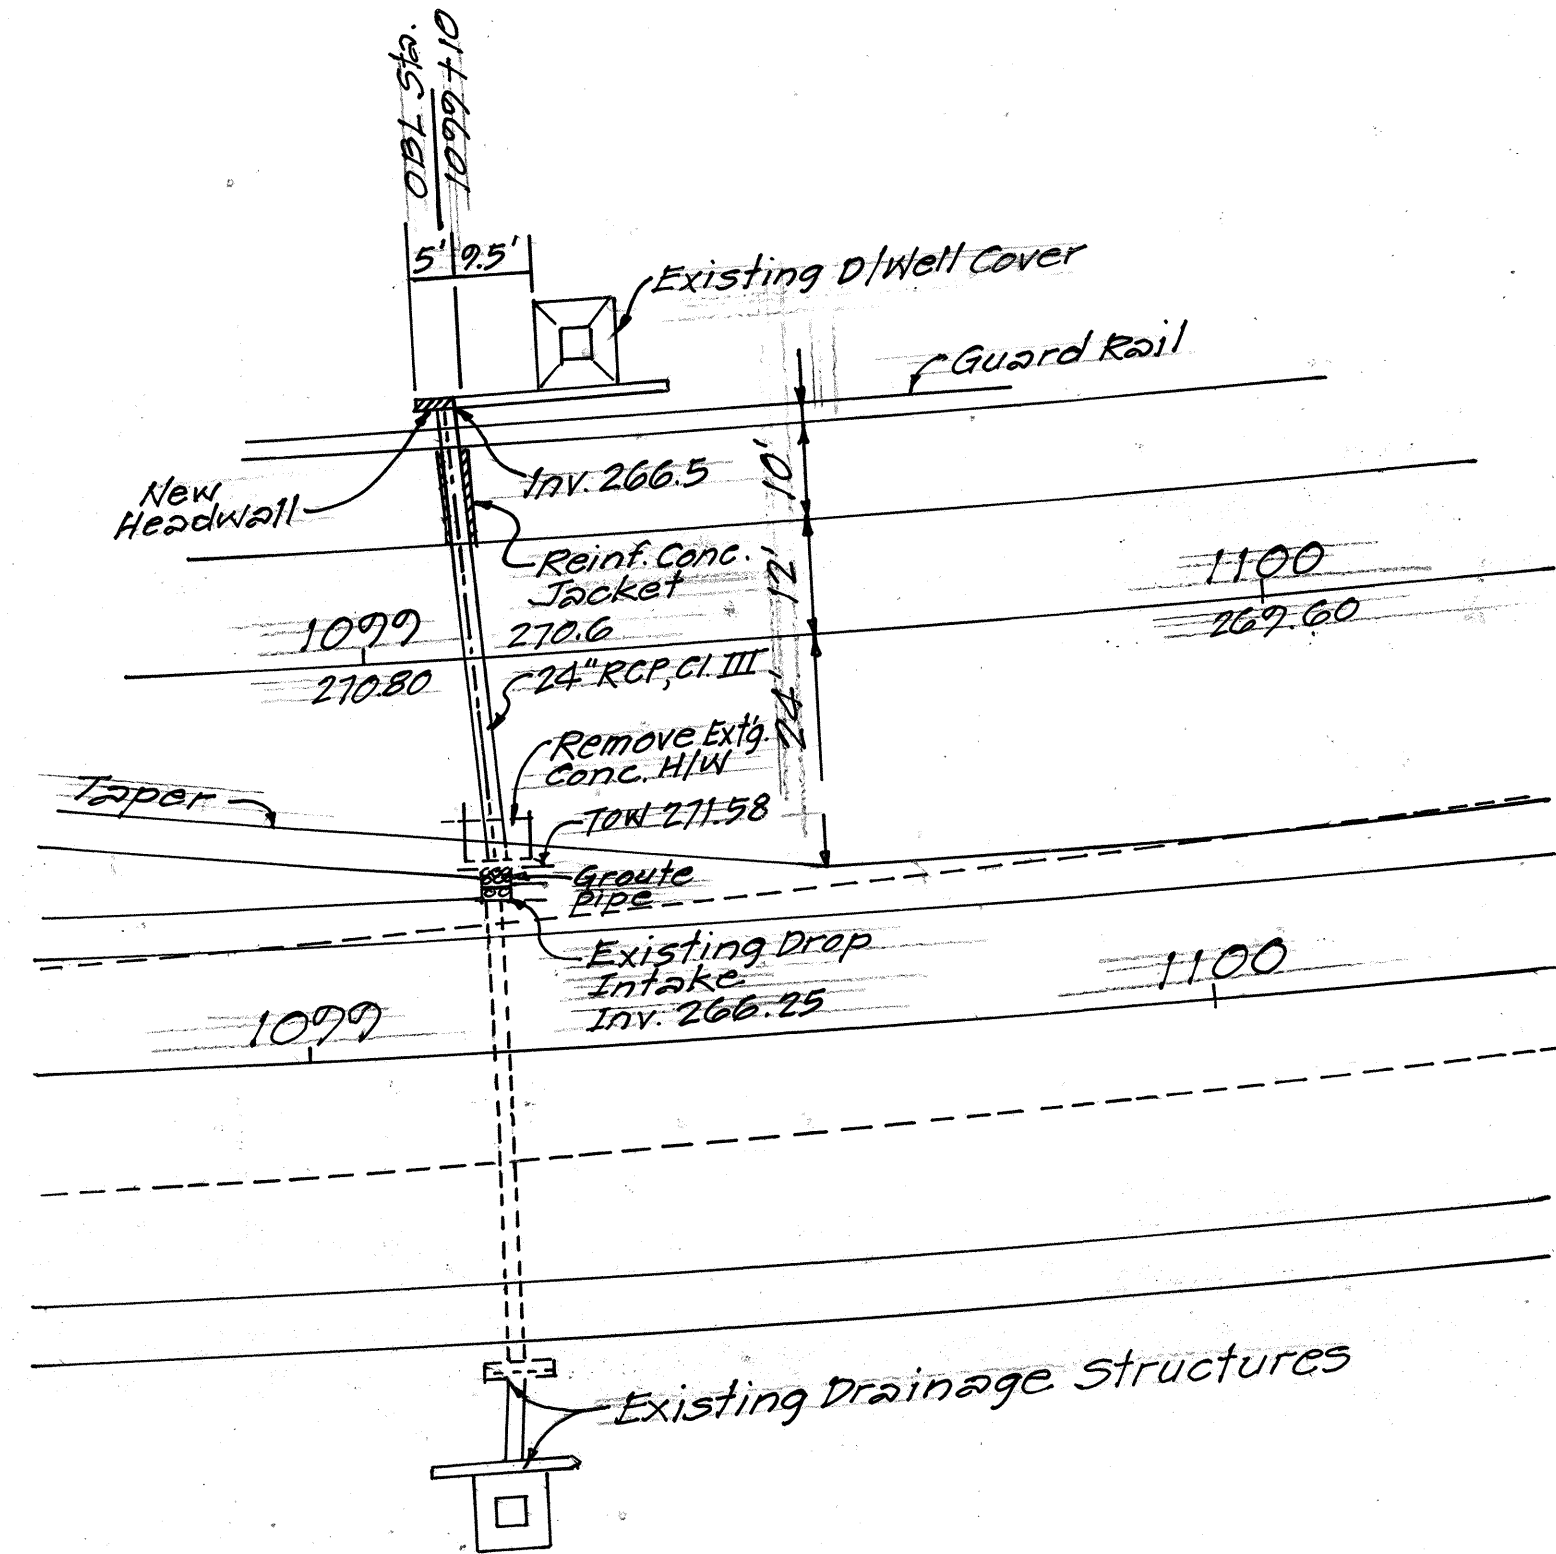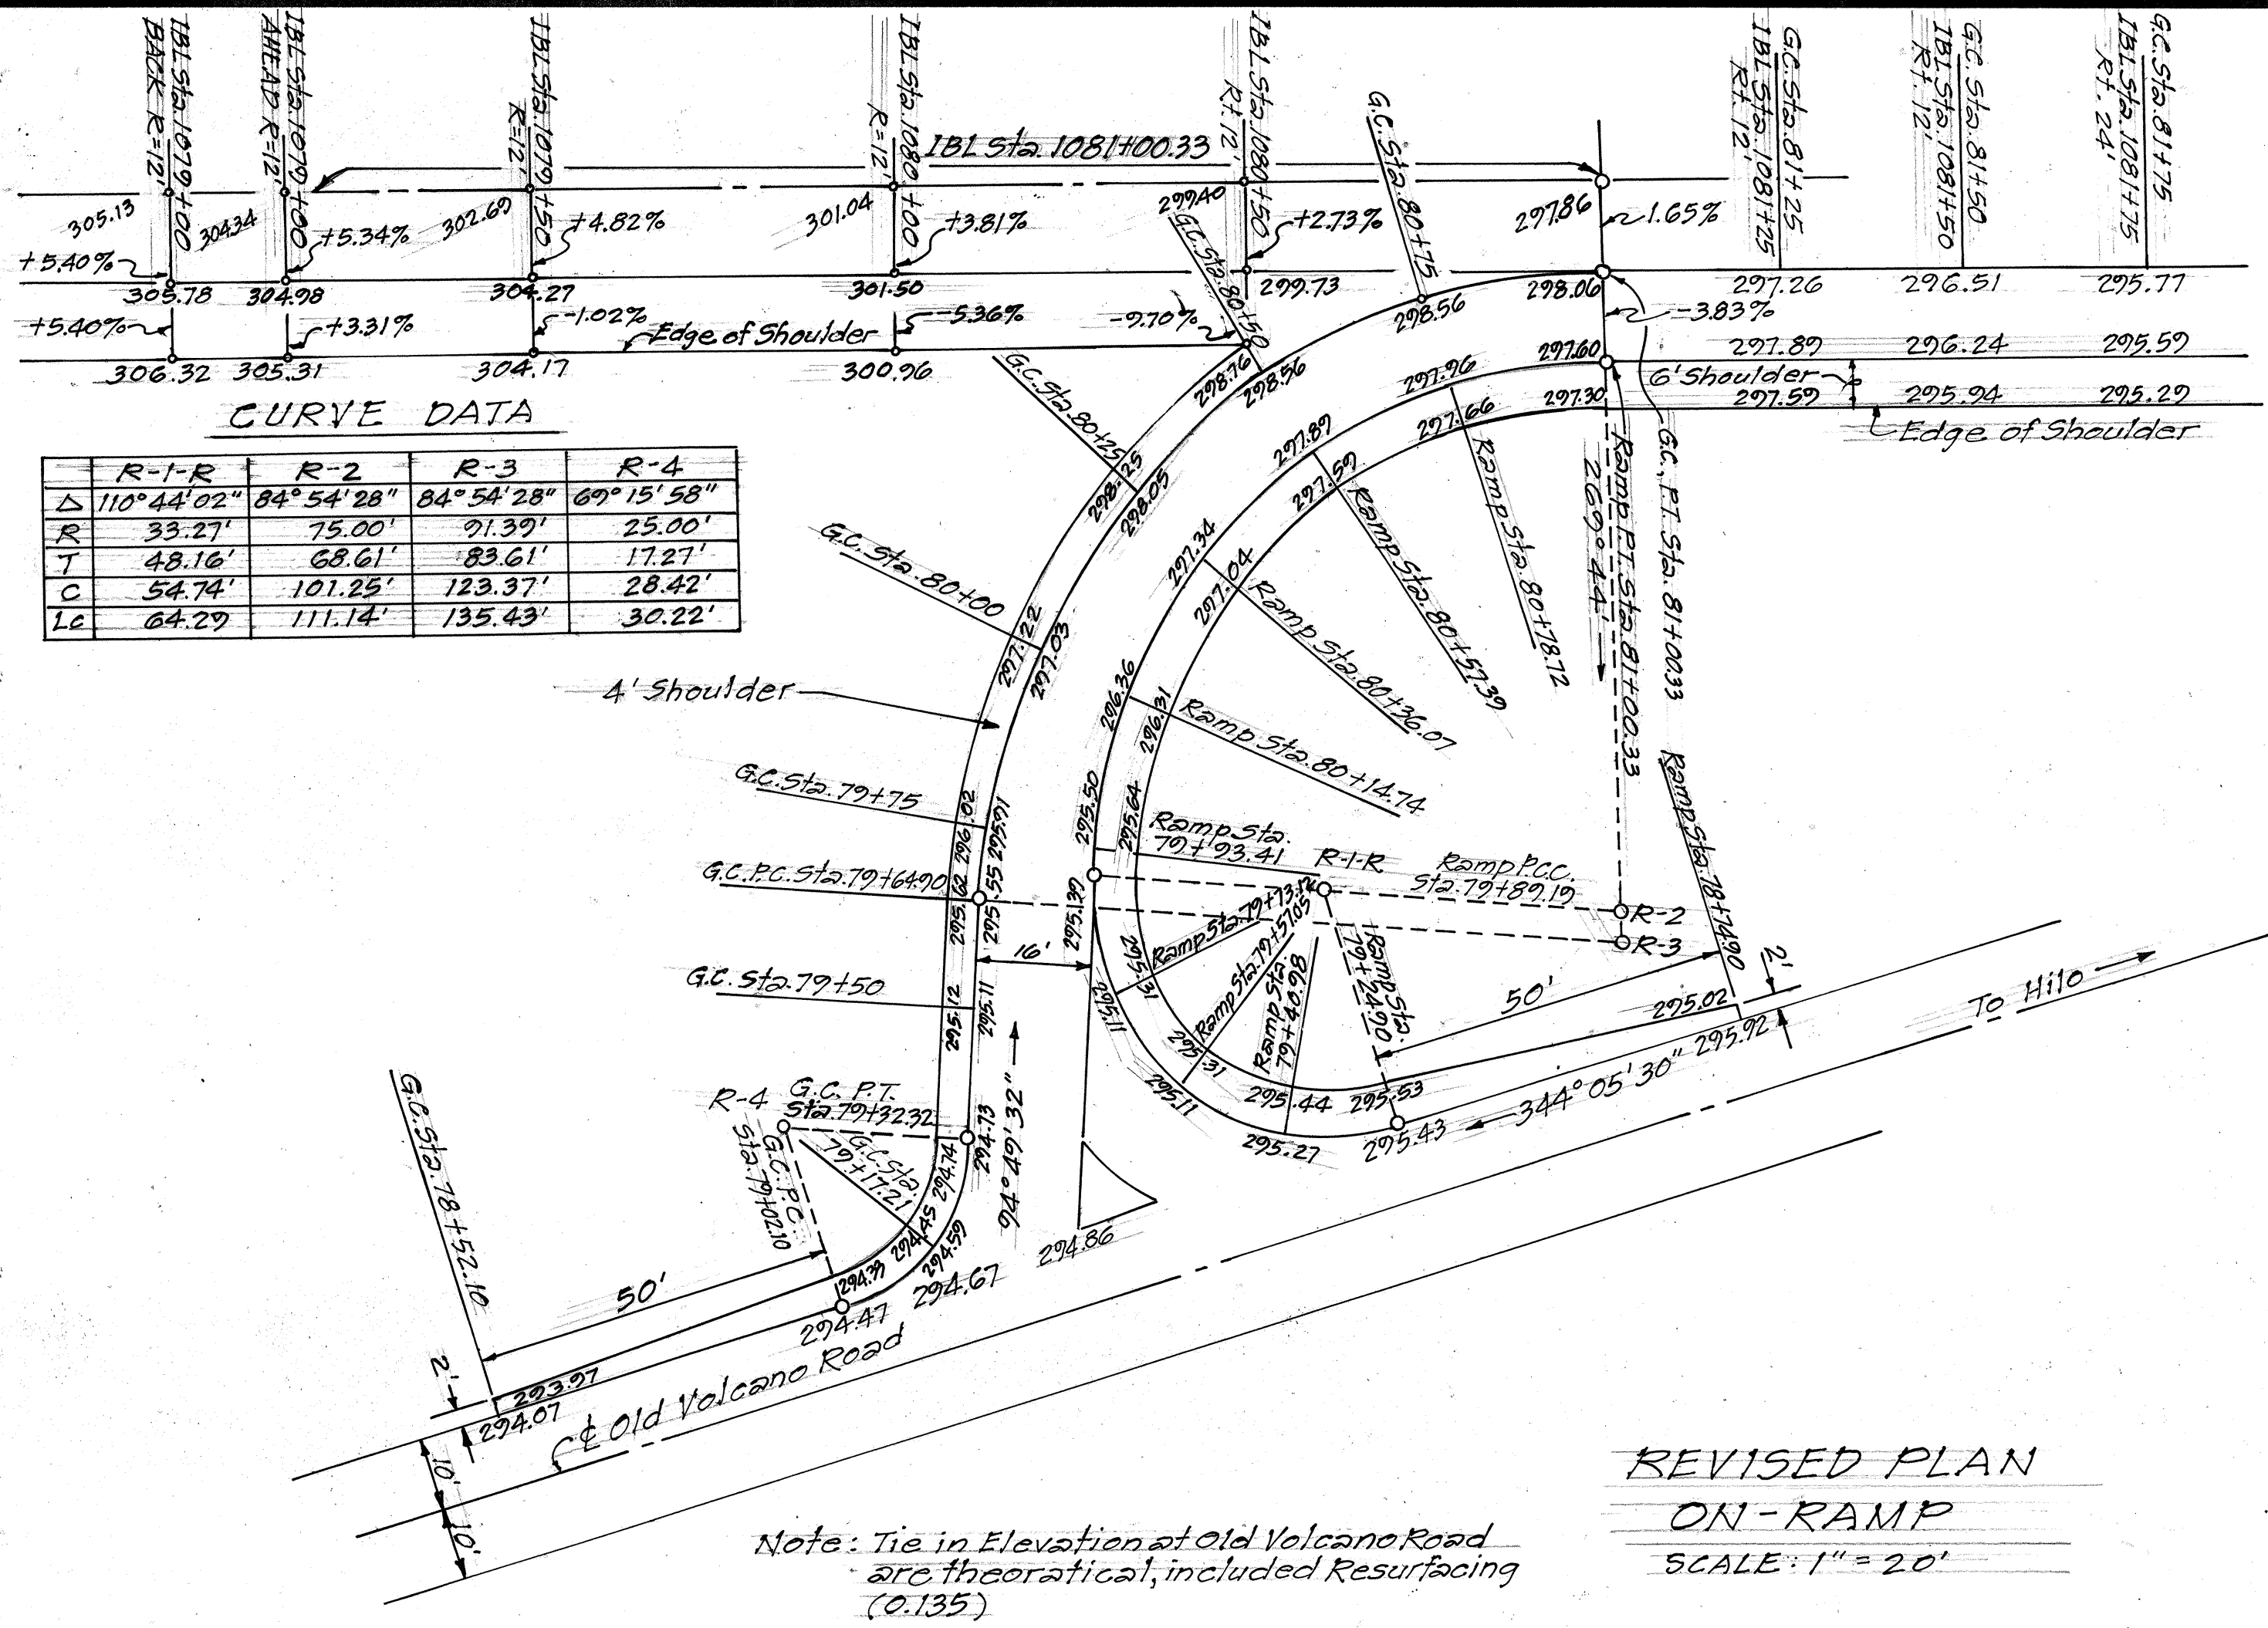

NOTE:
This Tracing/Detail Prepared During "As-Built" Posting.

STATE OF HAWAII
DEPARTMENT OF TRANSPORTATION
HIGHWAYS DIVISION




VOLCANO ROAD
KEAAU AGRICUTUAL SUBDIVISION
TO SLAUGHTER HOUSE ROAD
FEDERAL AID PROJ. NO. F-011-2(17)
Scale: As Shown

SHEET No. OF SHEETS




ORIGINAL PLAN	DATE
SURVEY PLOTTED BY	
DRAWN BY	
DESIGNED BY	
QUANTITIES BY	
CHECKED BY	

21

FED. ROAD DIST. NO.	STATE	FED. AID PROJ. NO.	FISCAL YEAR	SHEET NO.	TOTAL SHEETS
HAWAII	HAW.	F-011-2(17)	1986	22	142

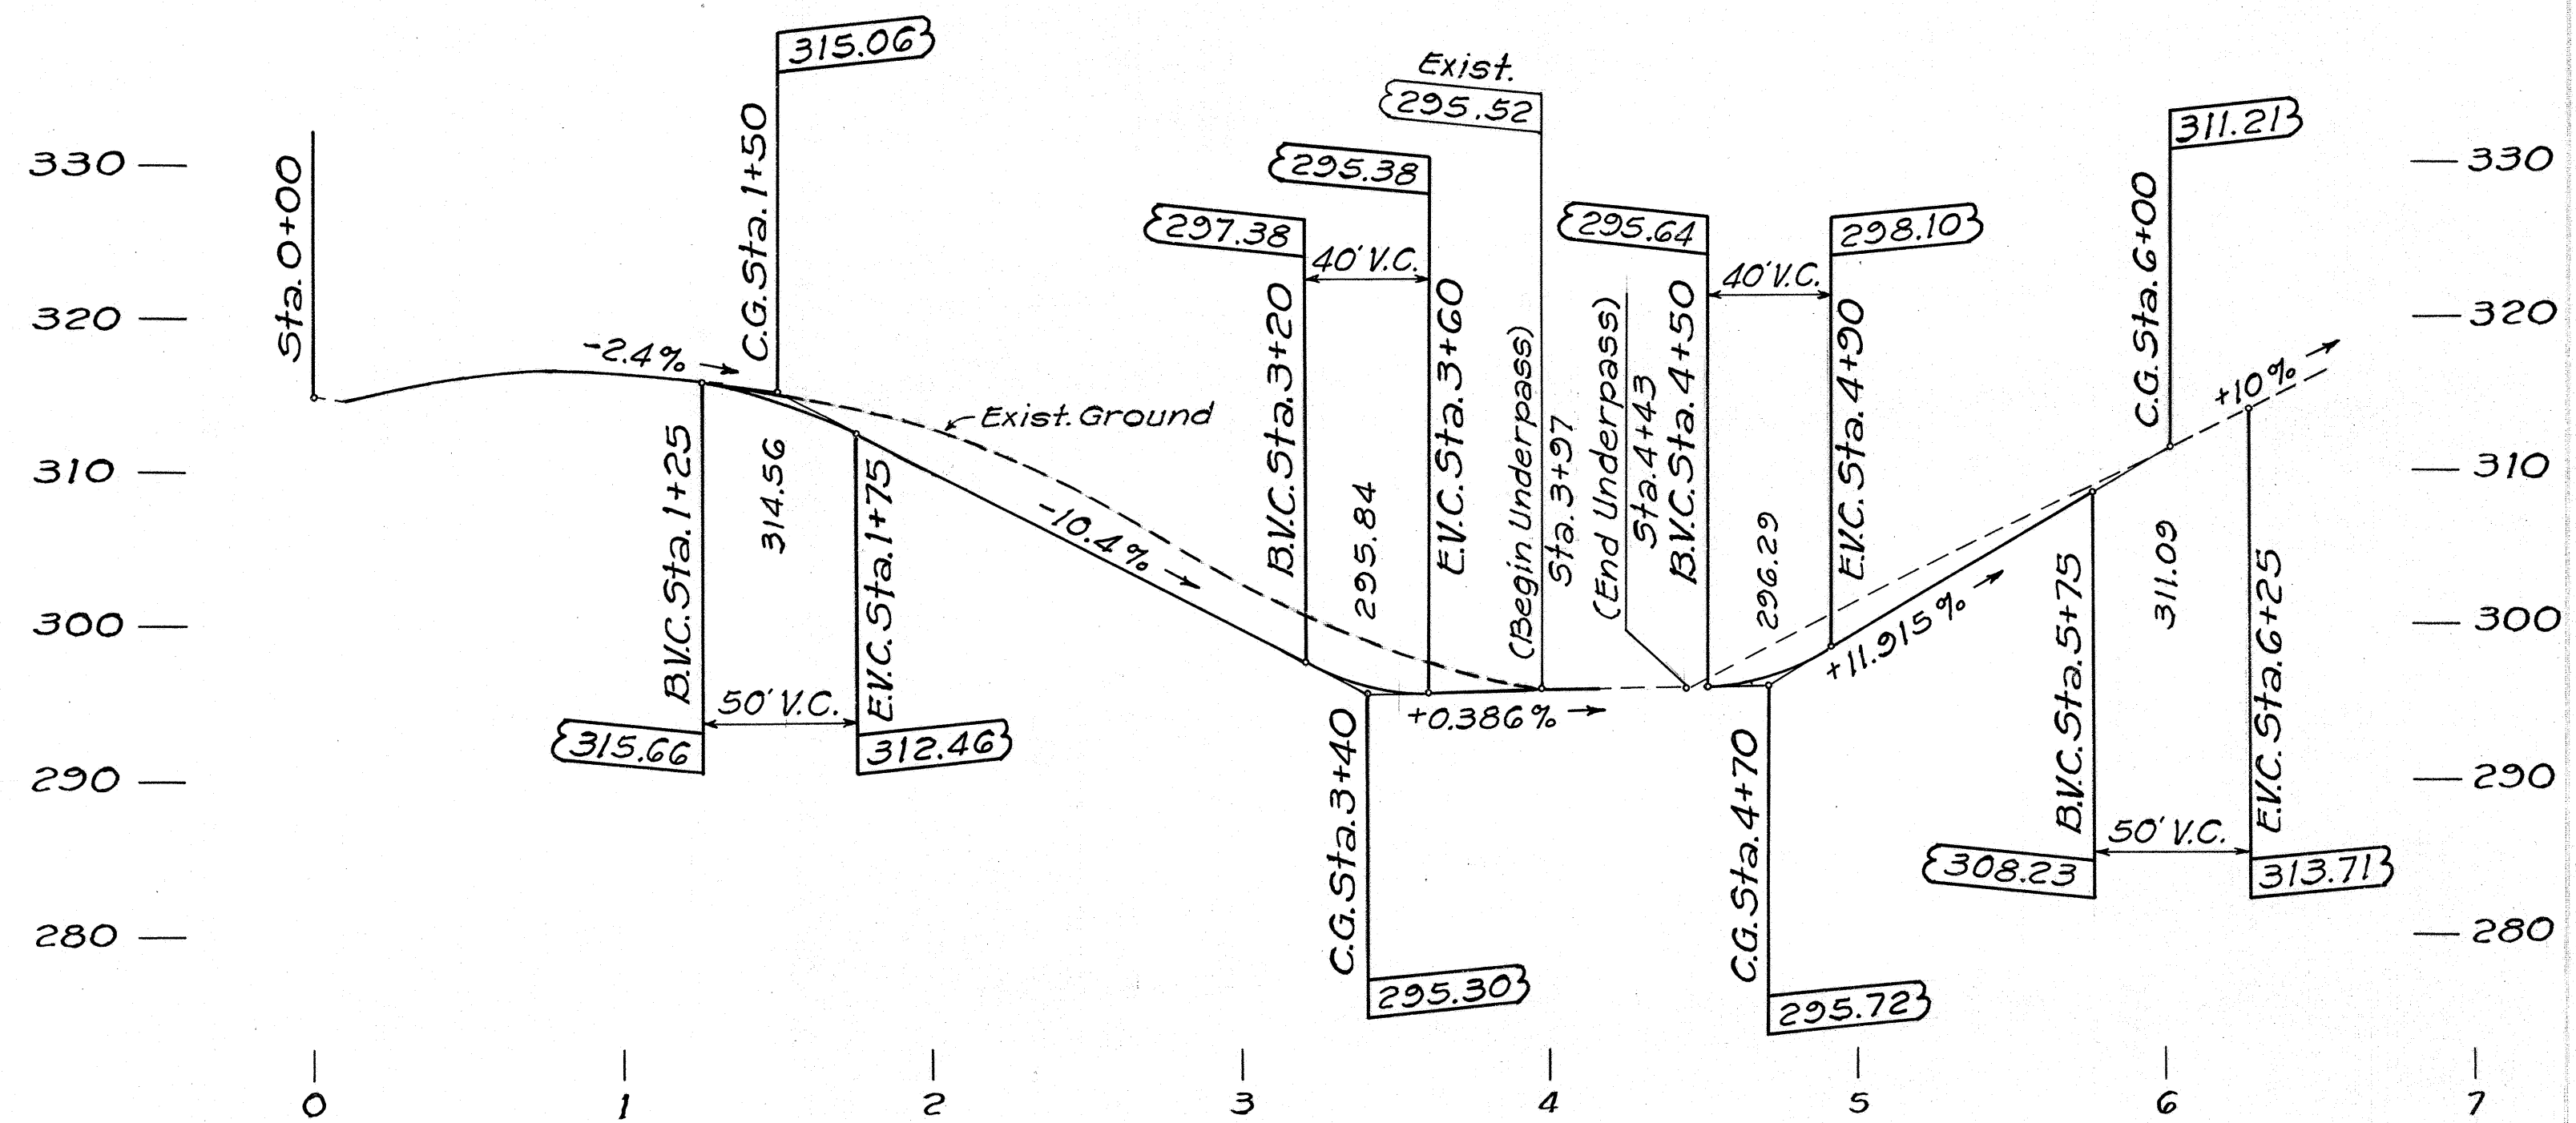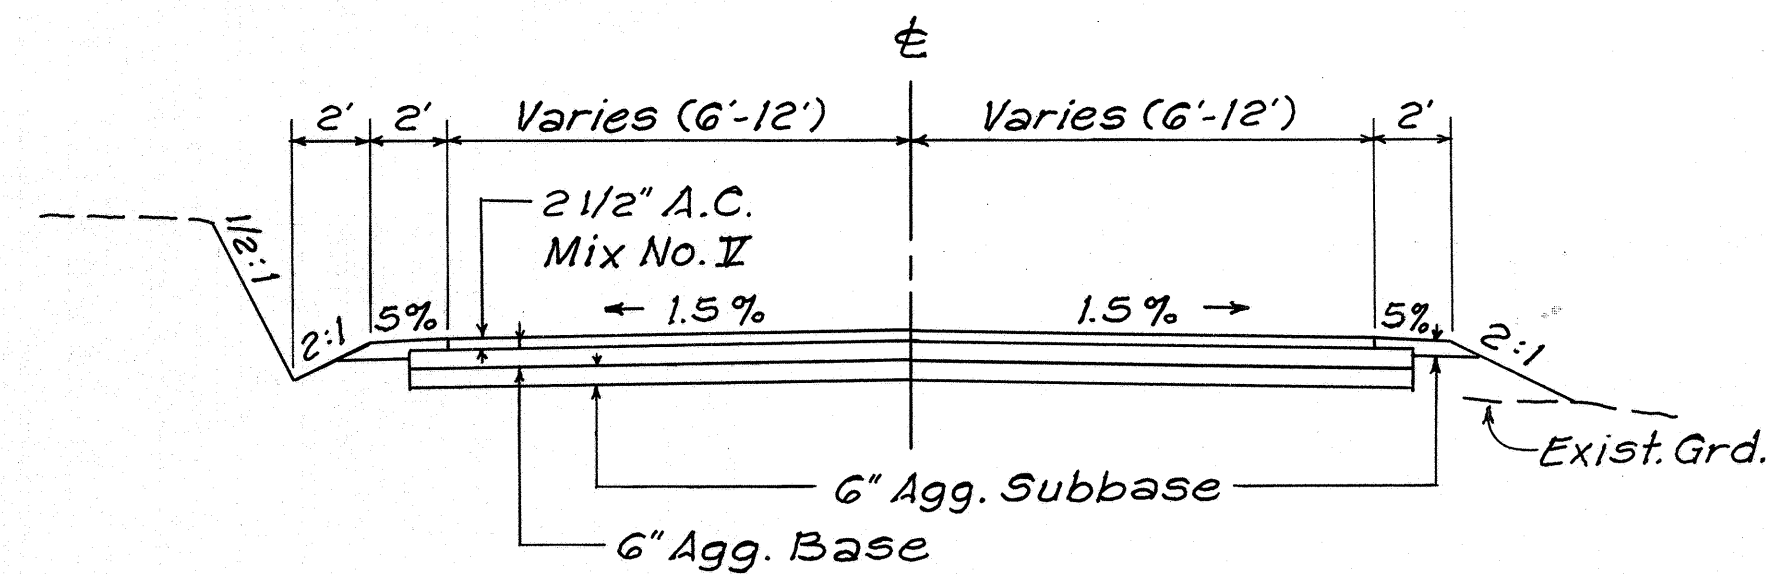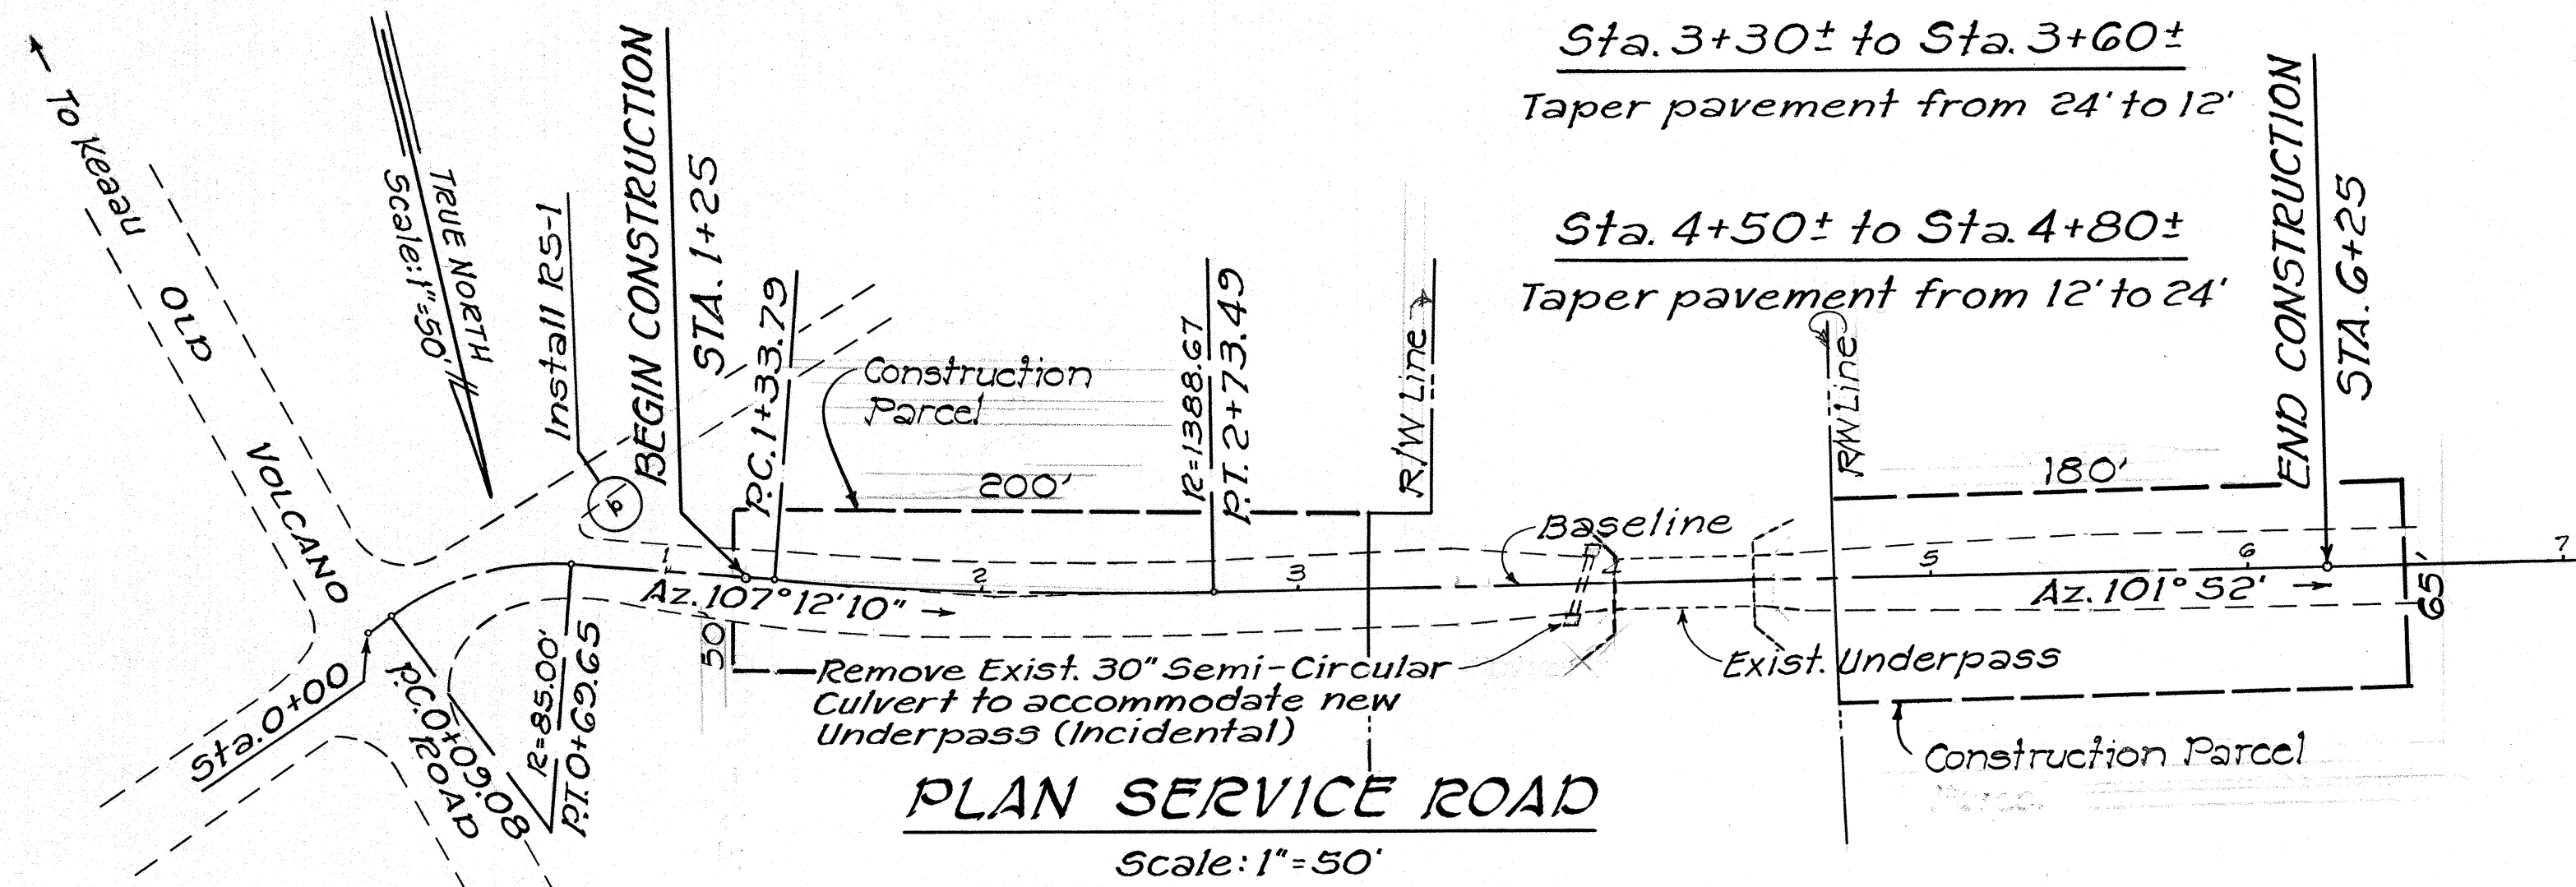

~~SUPERSEDED~~
SEE SHEETS C.O.22A & C.O.22B

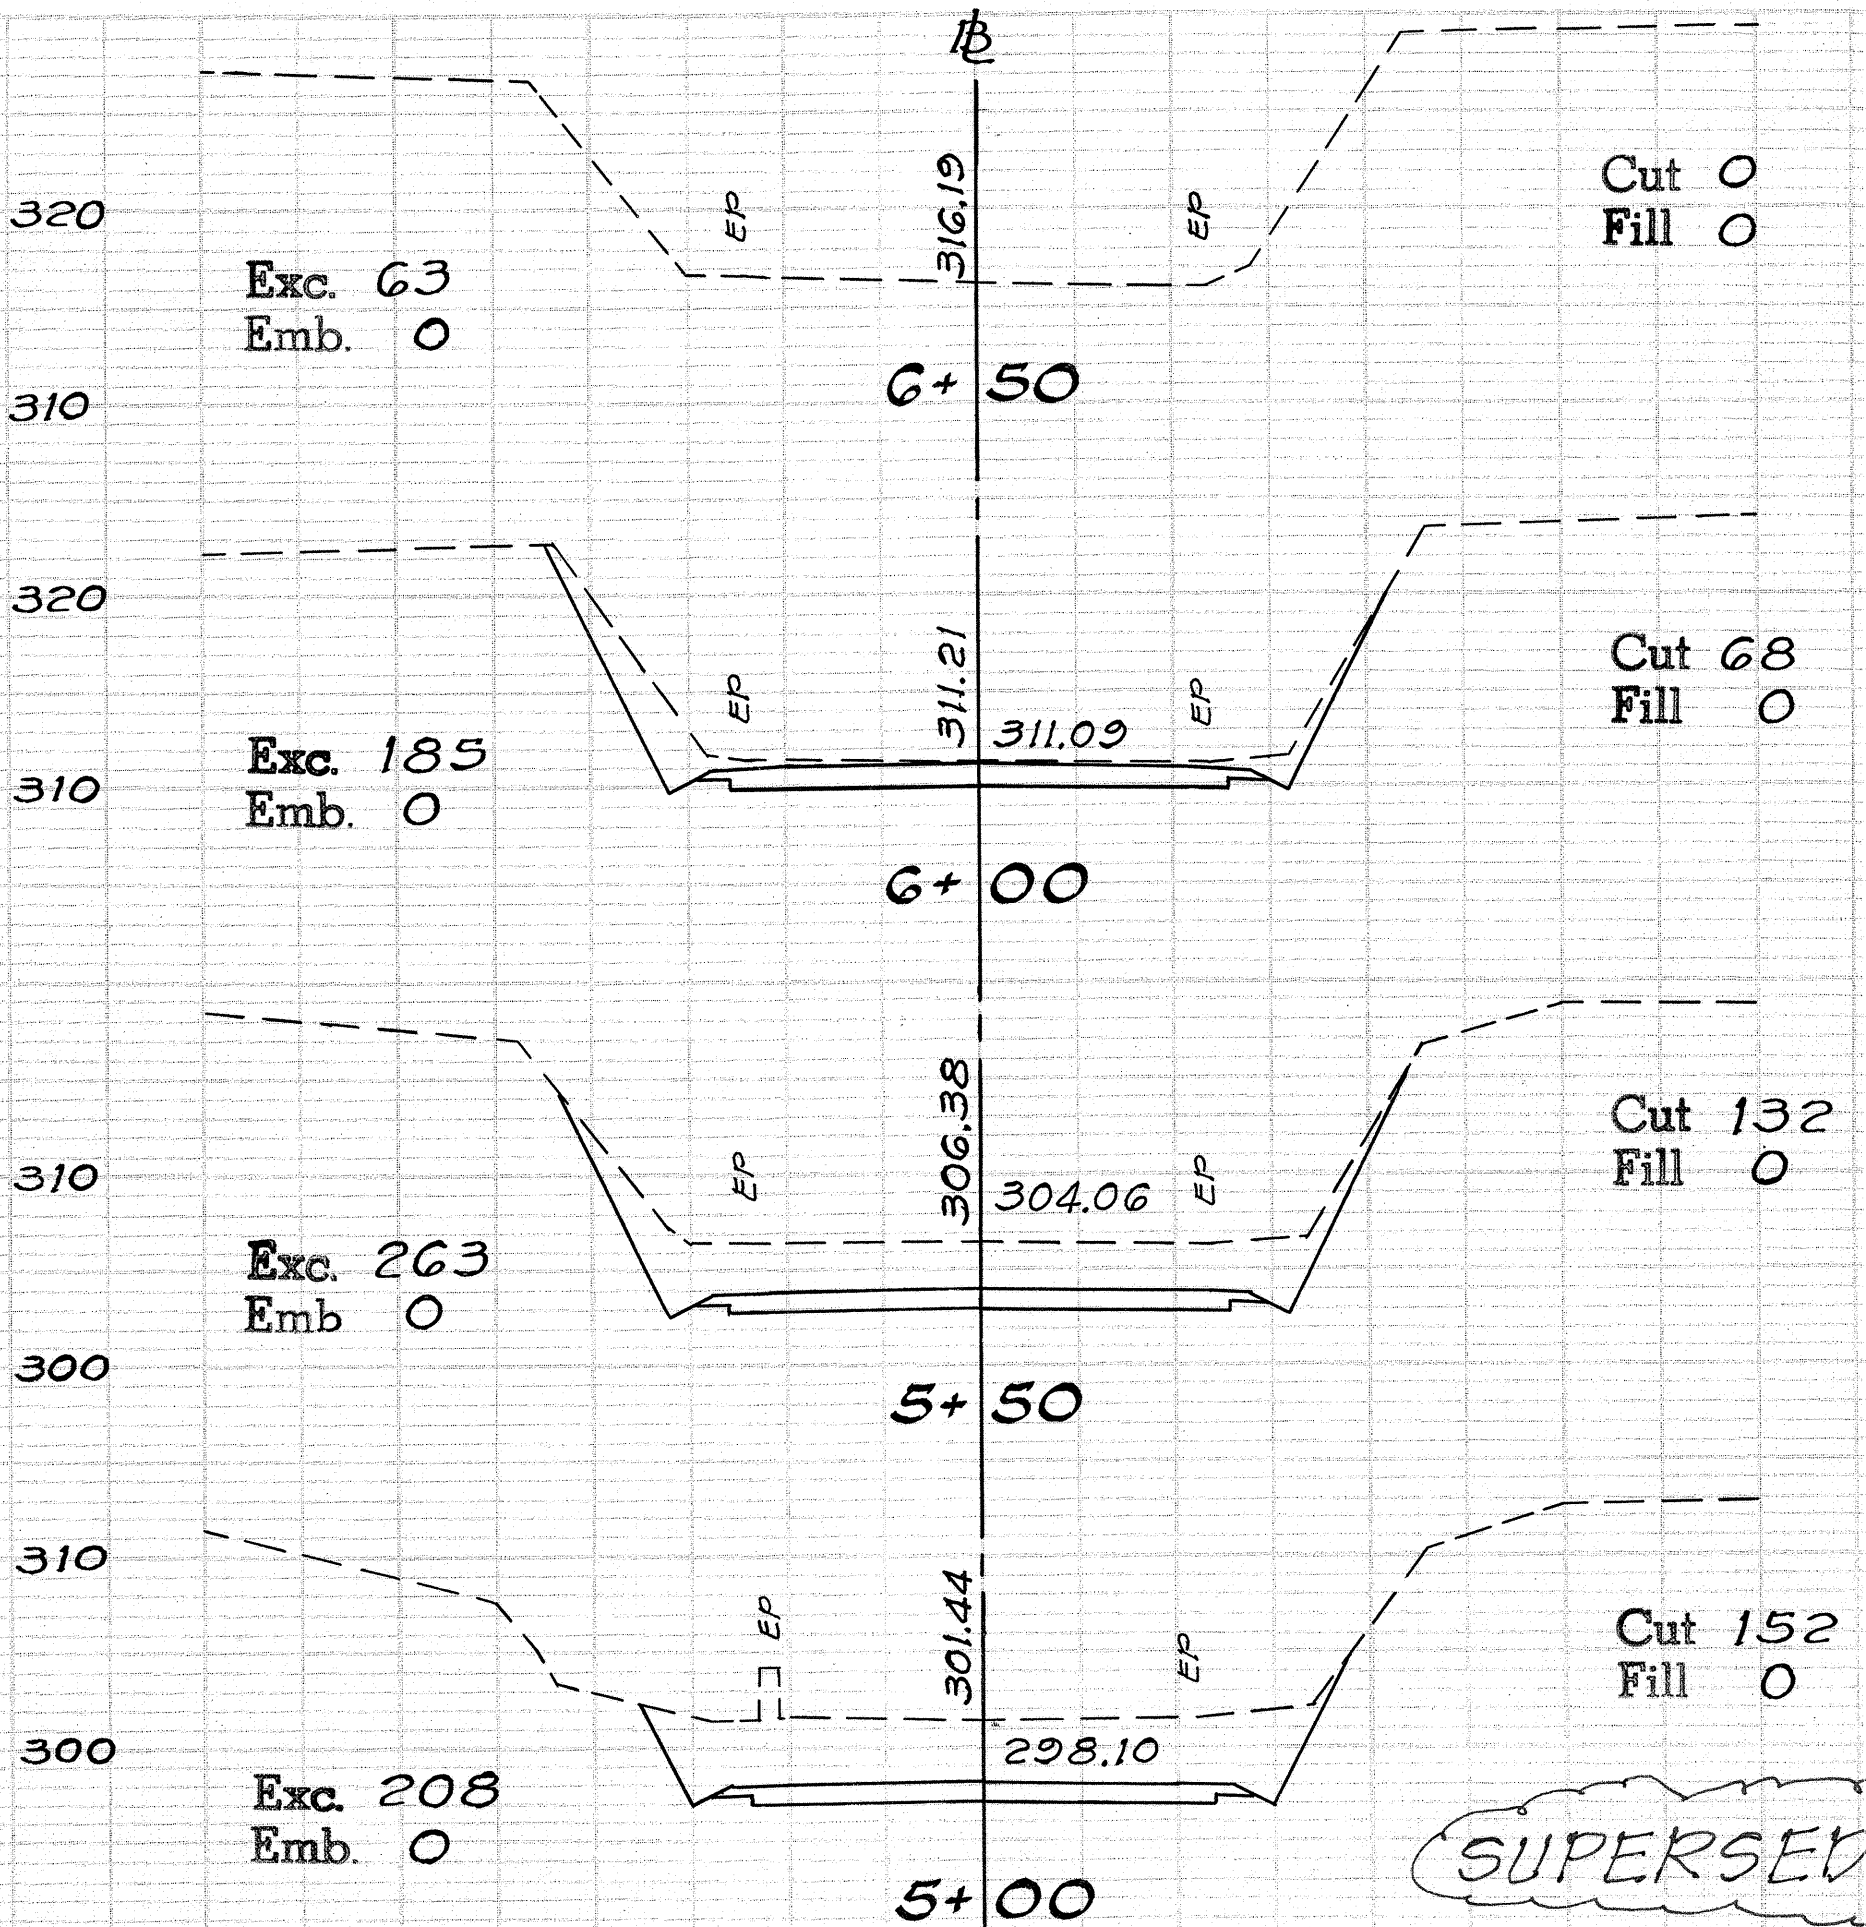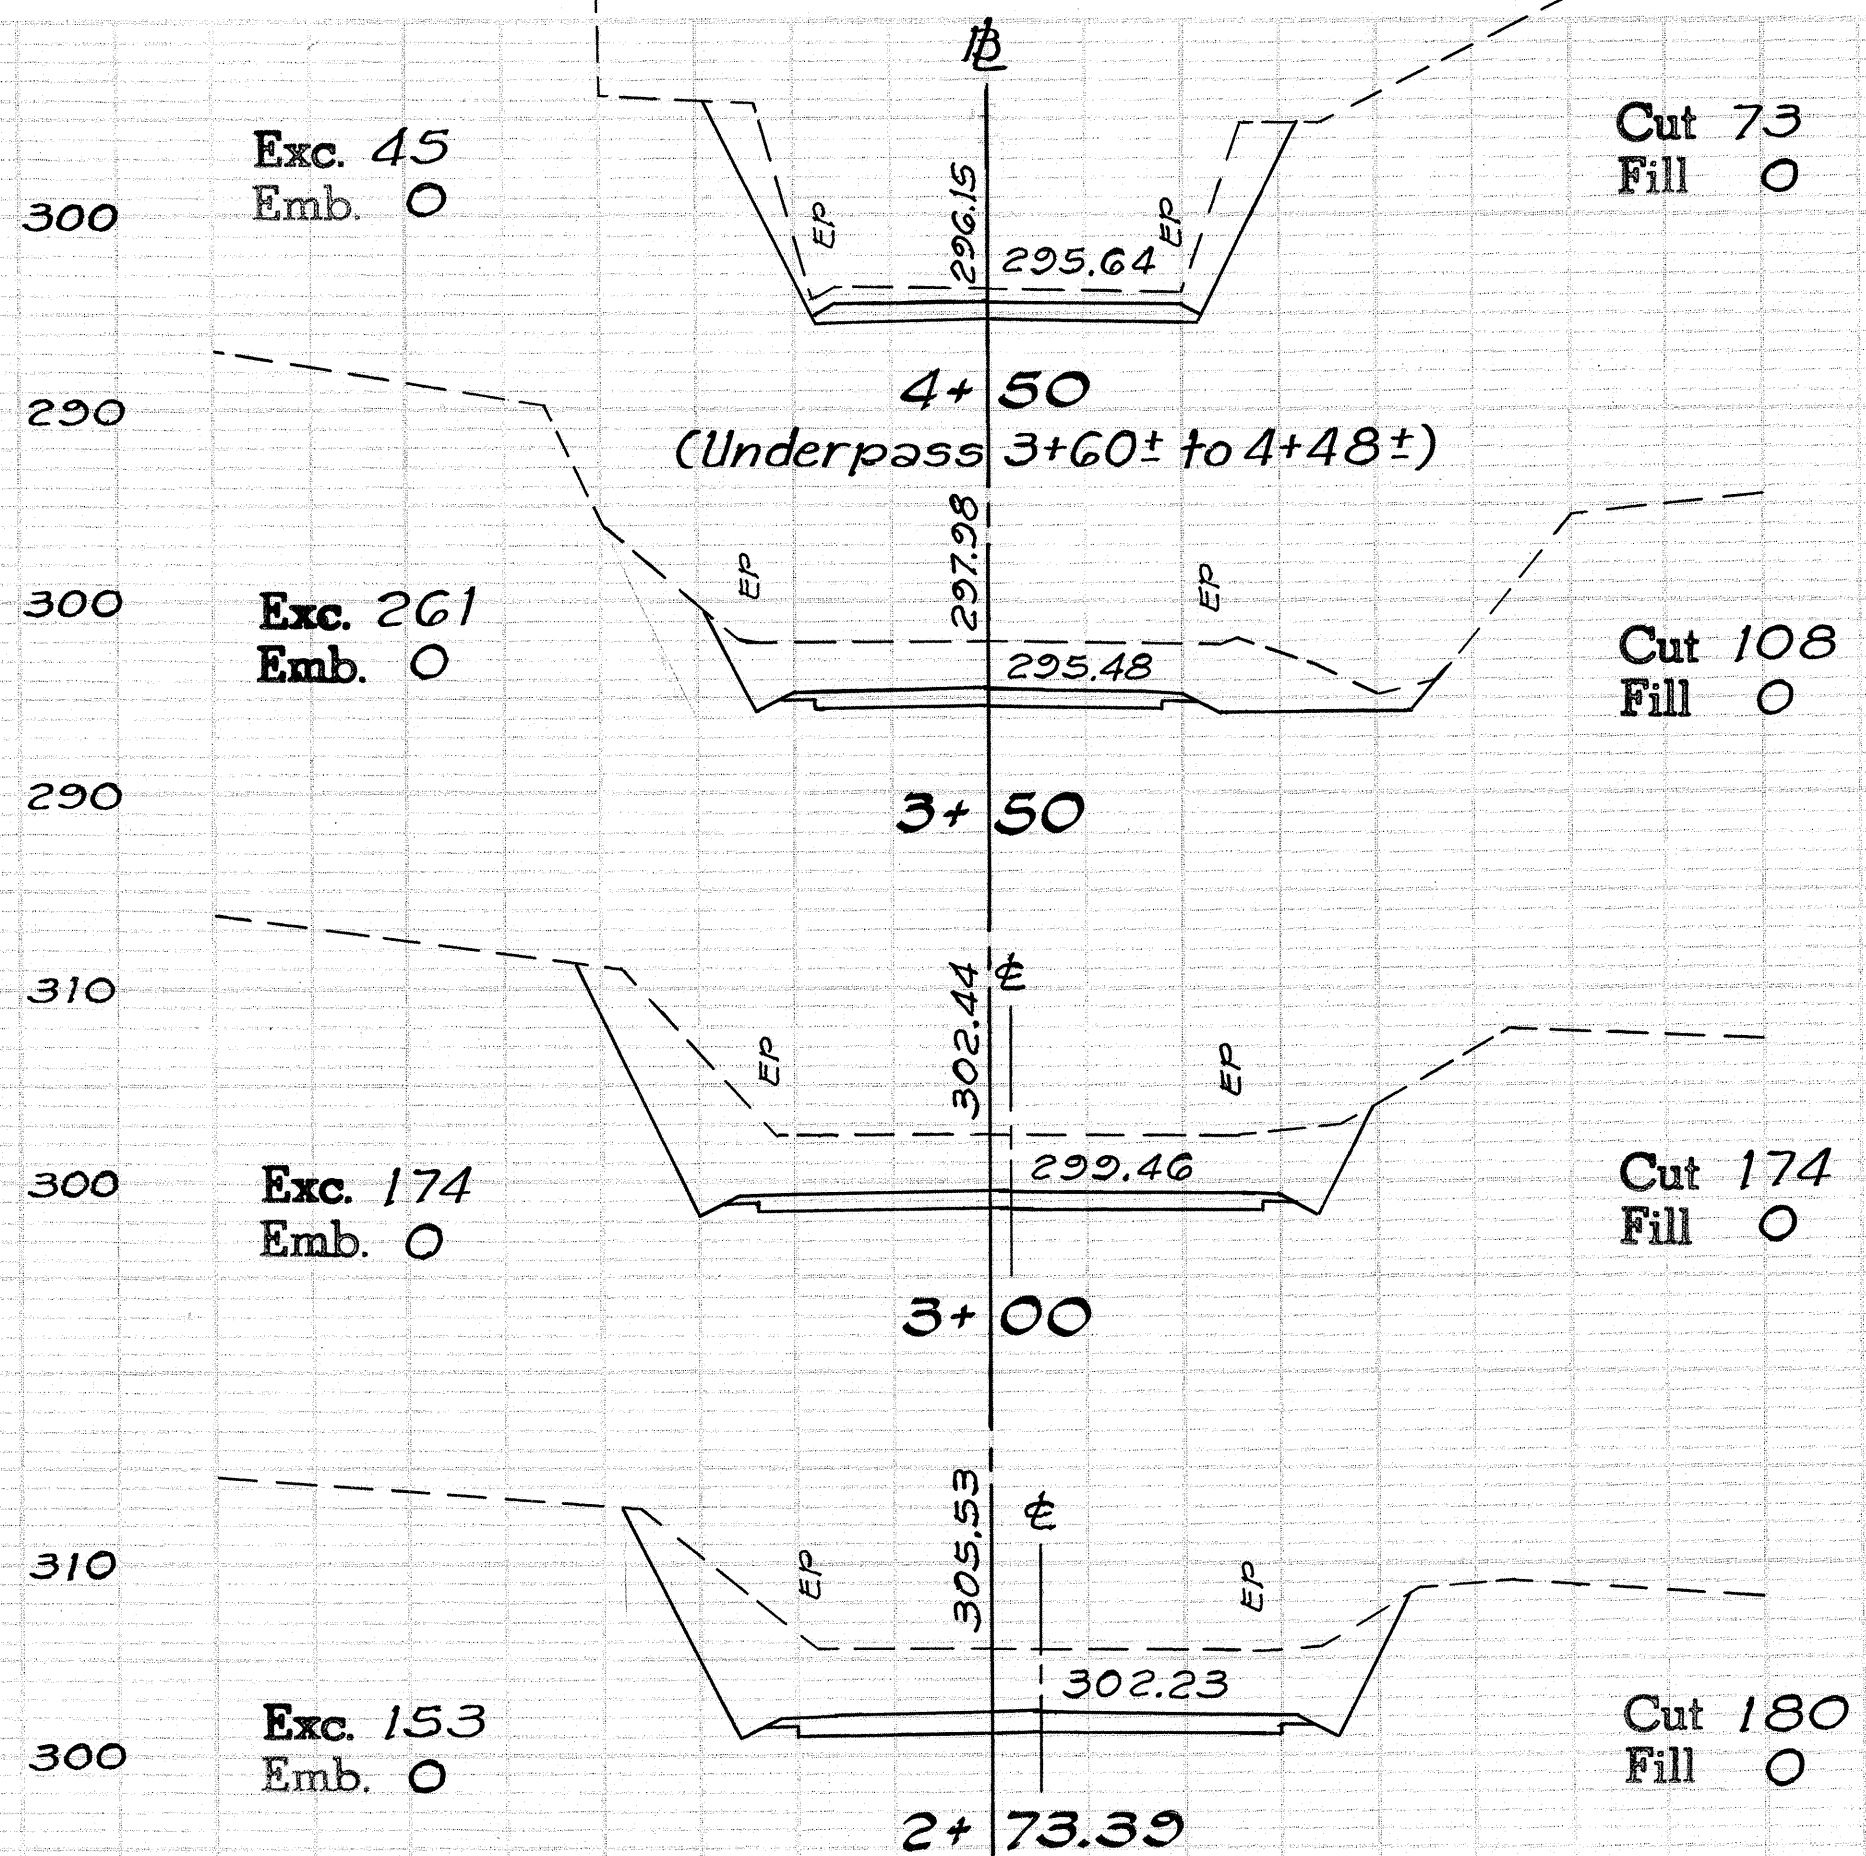
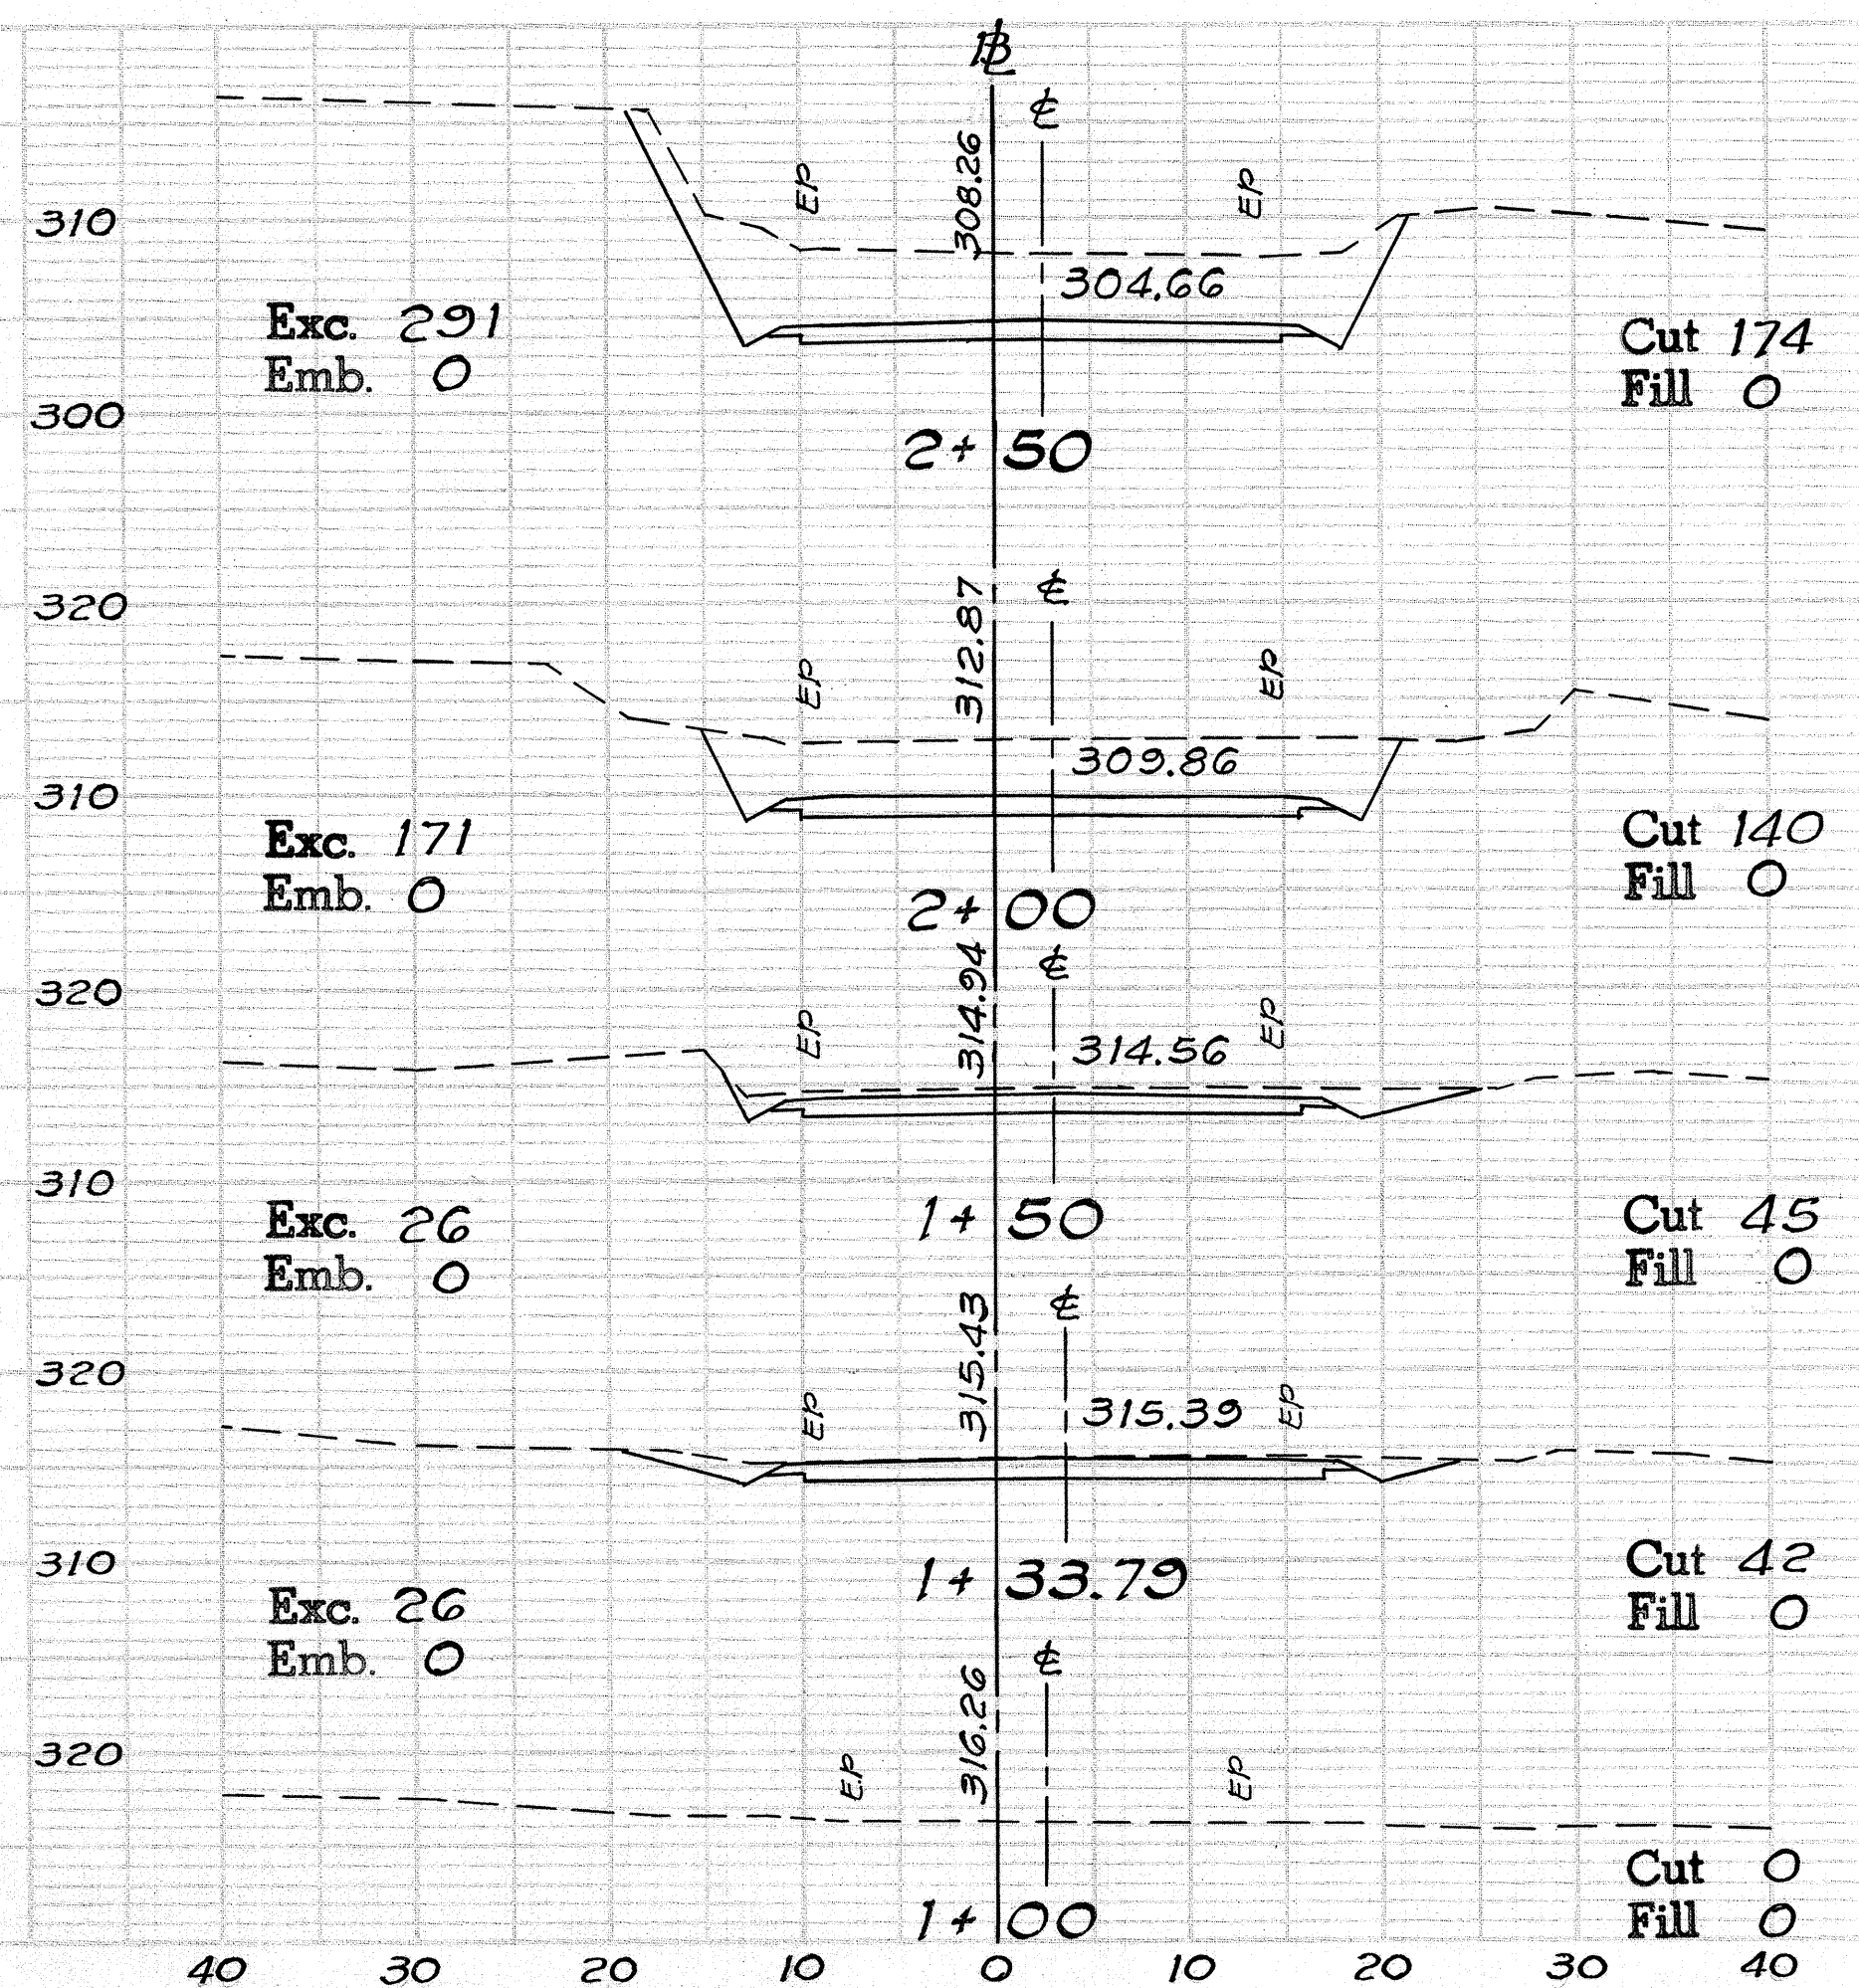


~~SUPERSEDED~~

PLAN	SURVEYED	DATE
	BY	
	PLOTTED	
	ALIGNED	
	CHECKED	
	RT. OF WAY	
	CHECKED	
	NO.	

PROFILE	SURVEYED	DATE
	BY	
	PLOTTED	
	GRADES	
	CHECKED	
	STRUCTURE	
	NOTATIONS	
	CHECKED	
	NO.	



FED. ROAD DIST. NO.	STATE	FED. AID PROJ. NO.	FISCAL YEAR	SHEET NO.	TOTAL SHEETS
HAWAII	HAW.	F-011-2(17)			

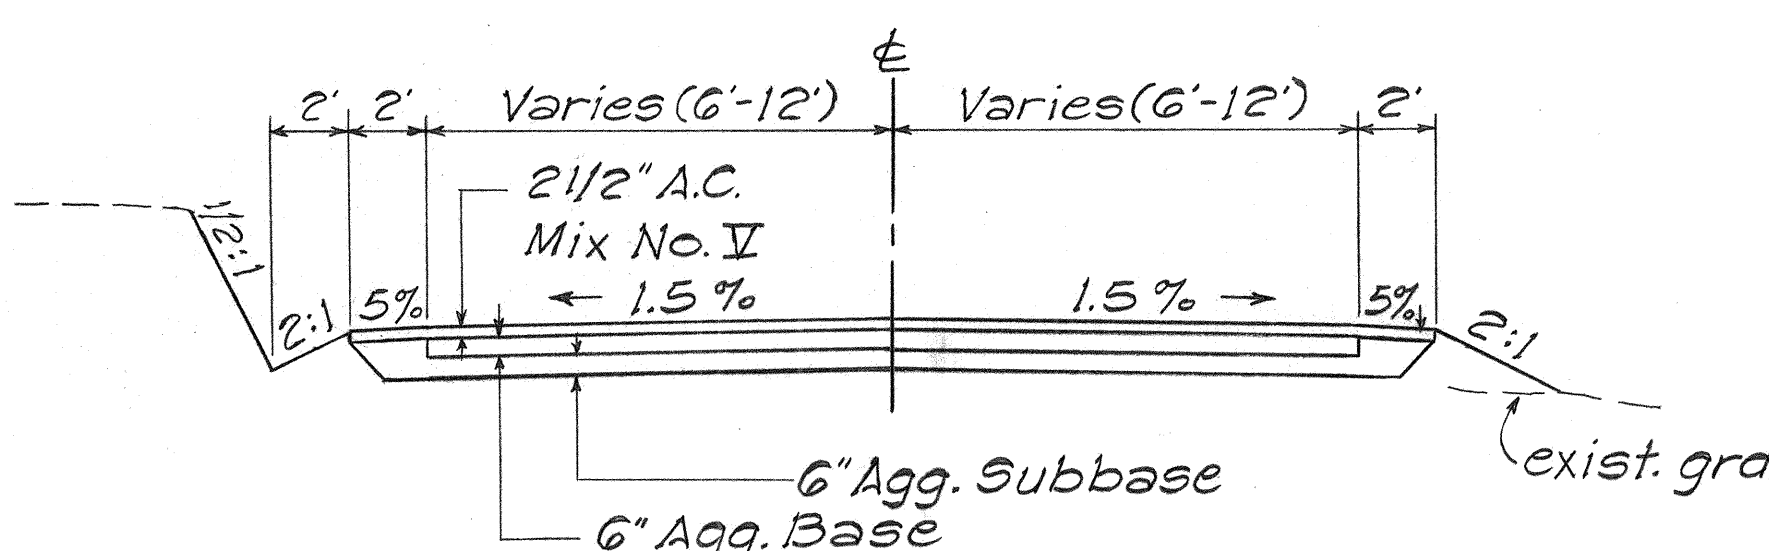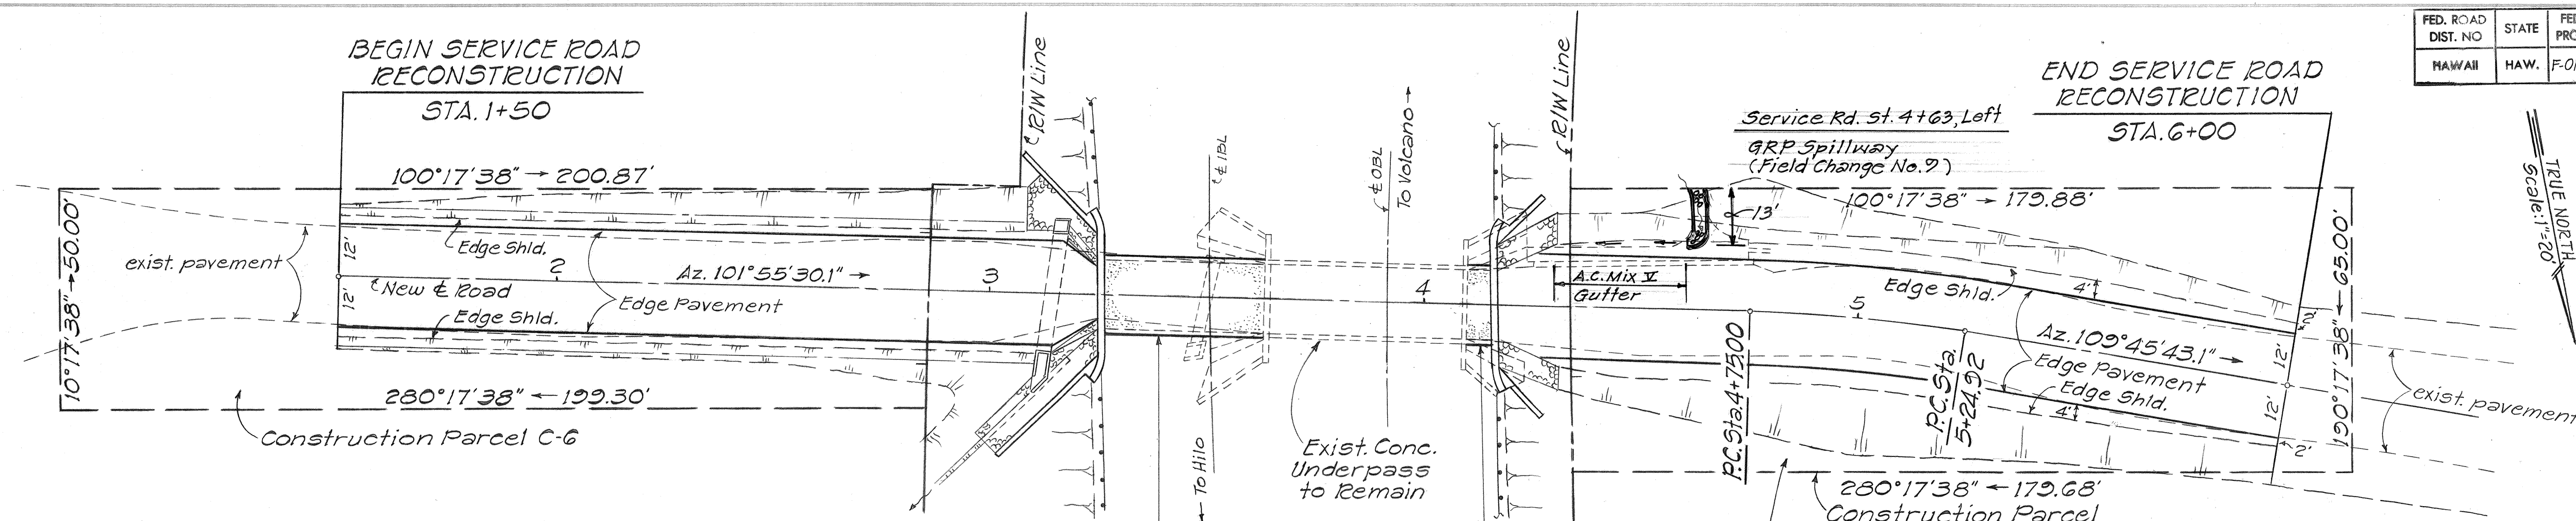

ESTIMATED QUANTITIES

A.C. Mix V	166	Tons
Aggregate Base	158	C.Y.
Aggregate Subbase	223	C.Y.
Roadway Exc.	1,472	C.Y.

CURVE DATA
 $\Delta = 7^\circ 50' 13''$
 $R = 364.98'$
 $T = 25.00'$
 $C = 49.88'$
 $L = 49.92'$


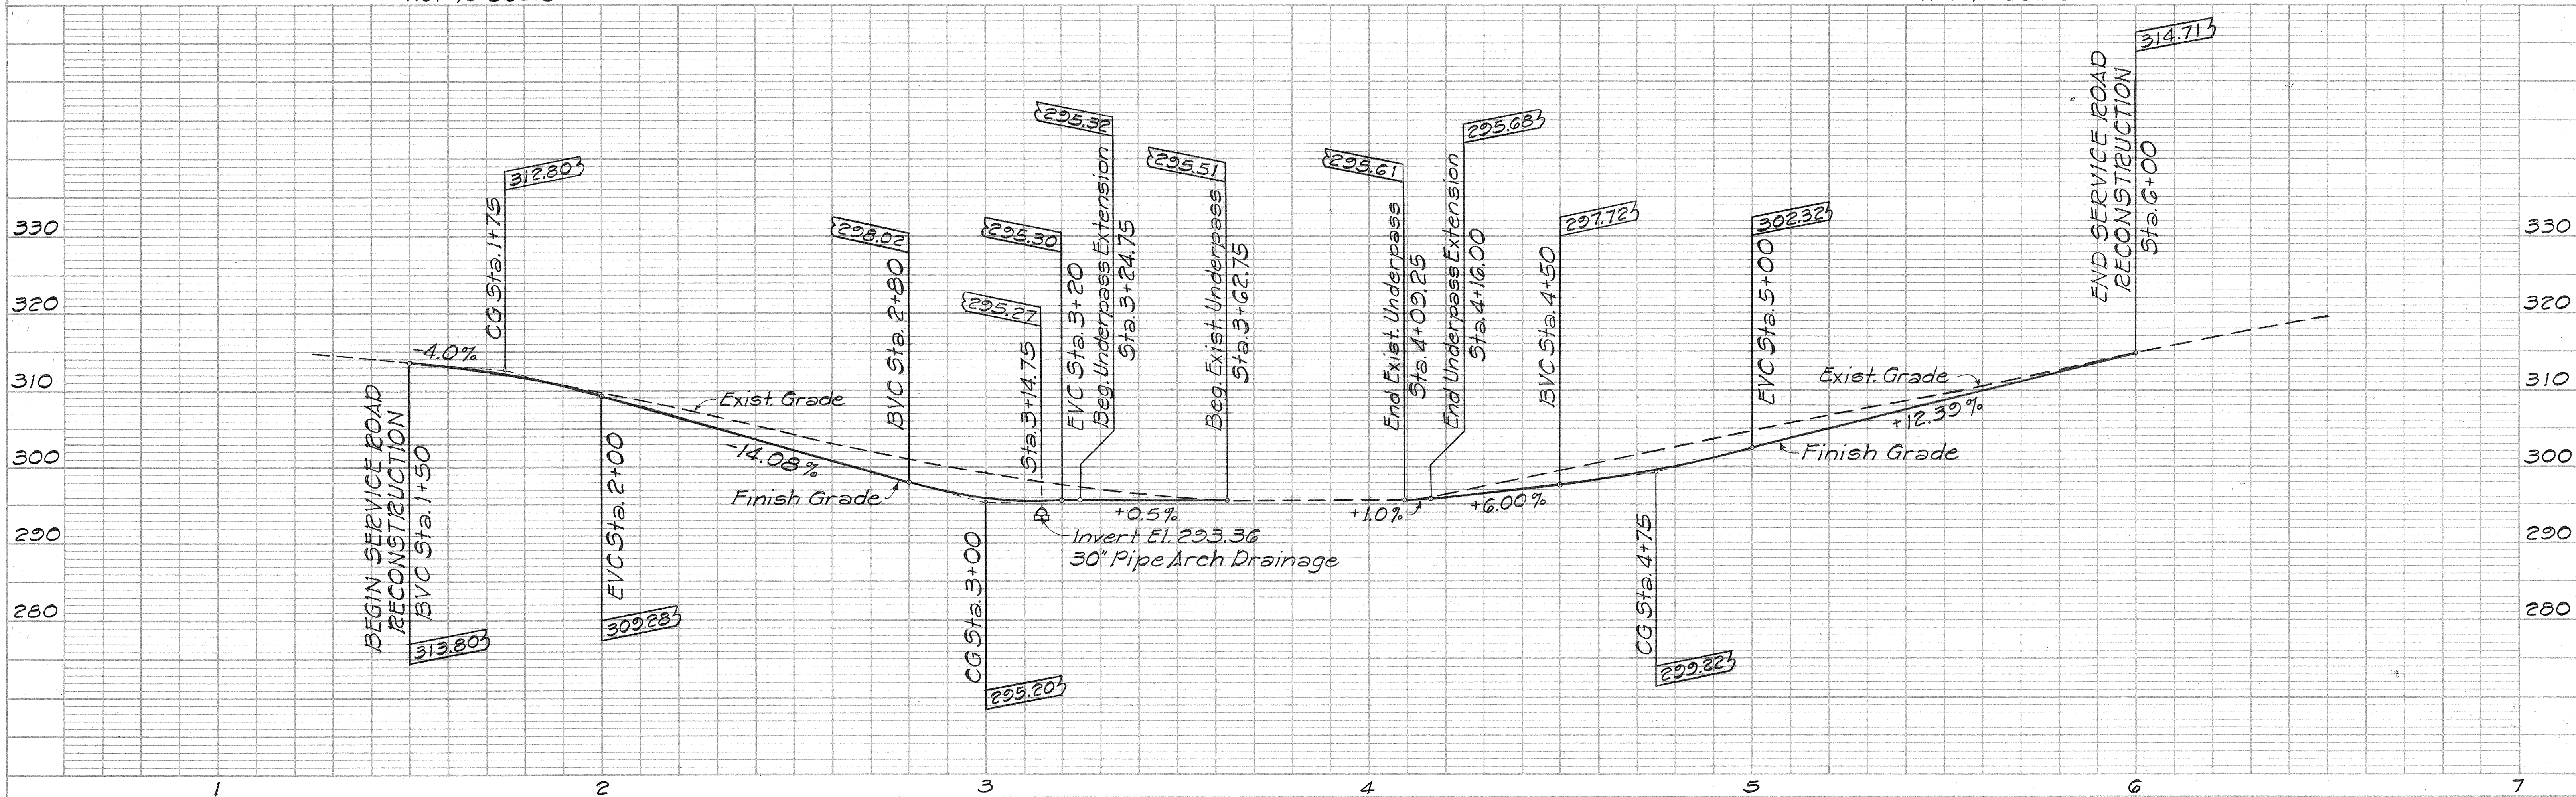
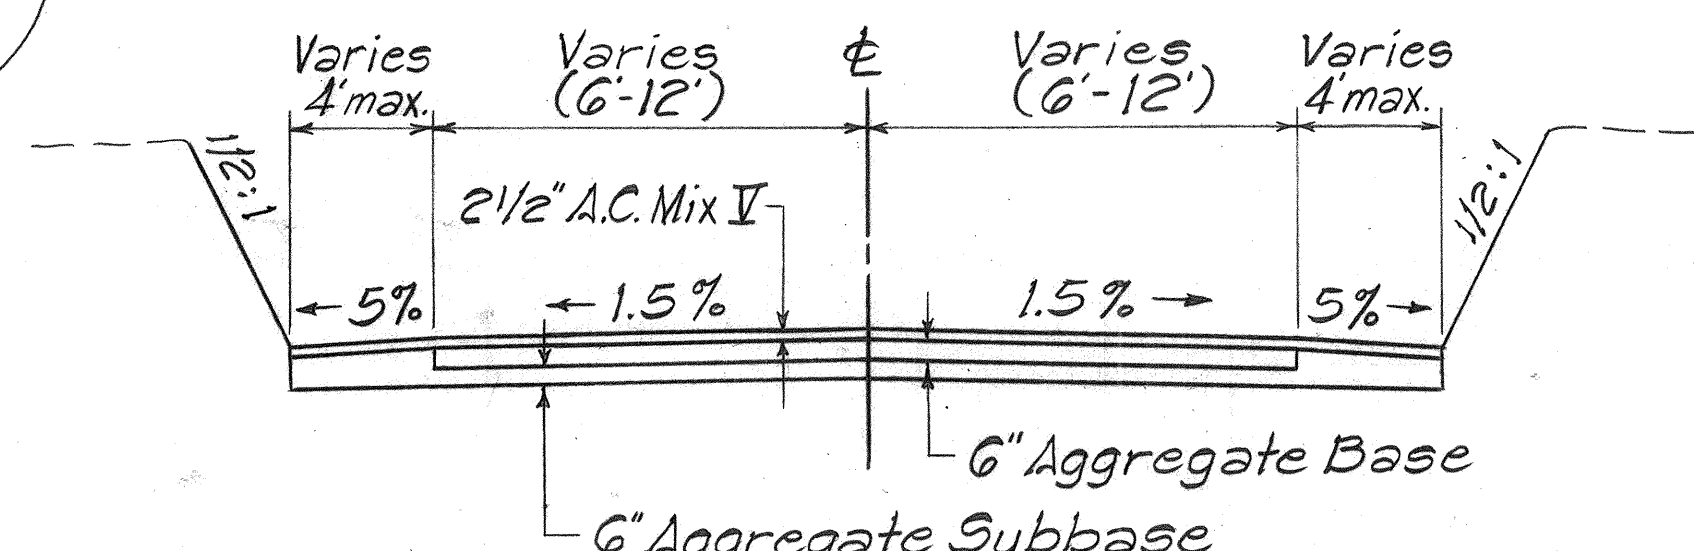


FED. ROAD DIST. NO.	STATE	FED. AID PROJ. NO.	FISCAL YEAR	SHEET NO.	TOTAL SHEETS
HAWAII	HAW.	F-011-2(17)			

DATE	BY	FINAL SURVEY	PLOTTED	NOTE BOOK	AREAS CHECKED


DATE	BY	ORIGINAL SURVEY	PLOTTED	NOTE BOOK	AREAS CHECKED

PP 45-48

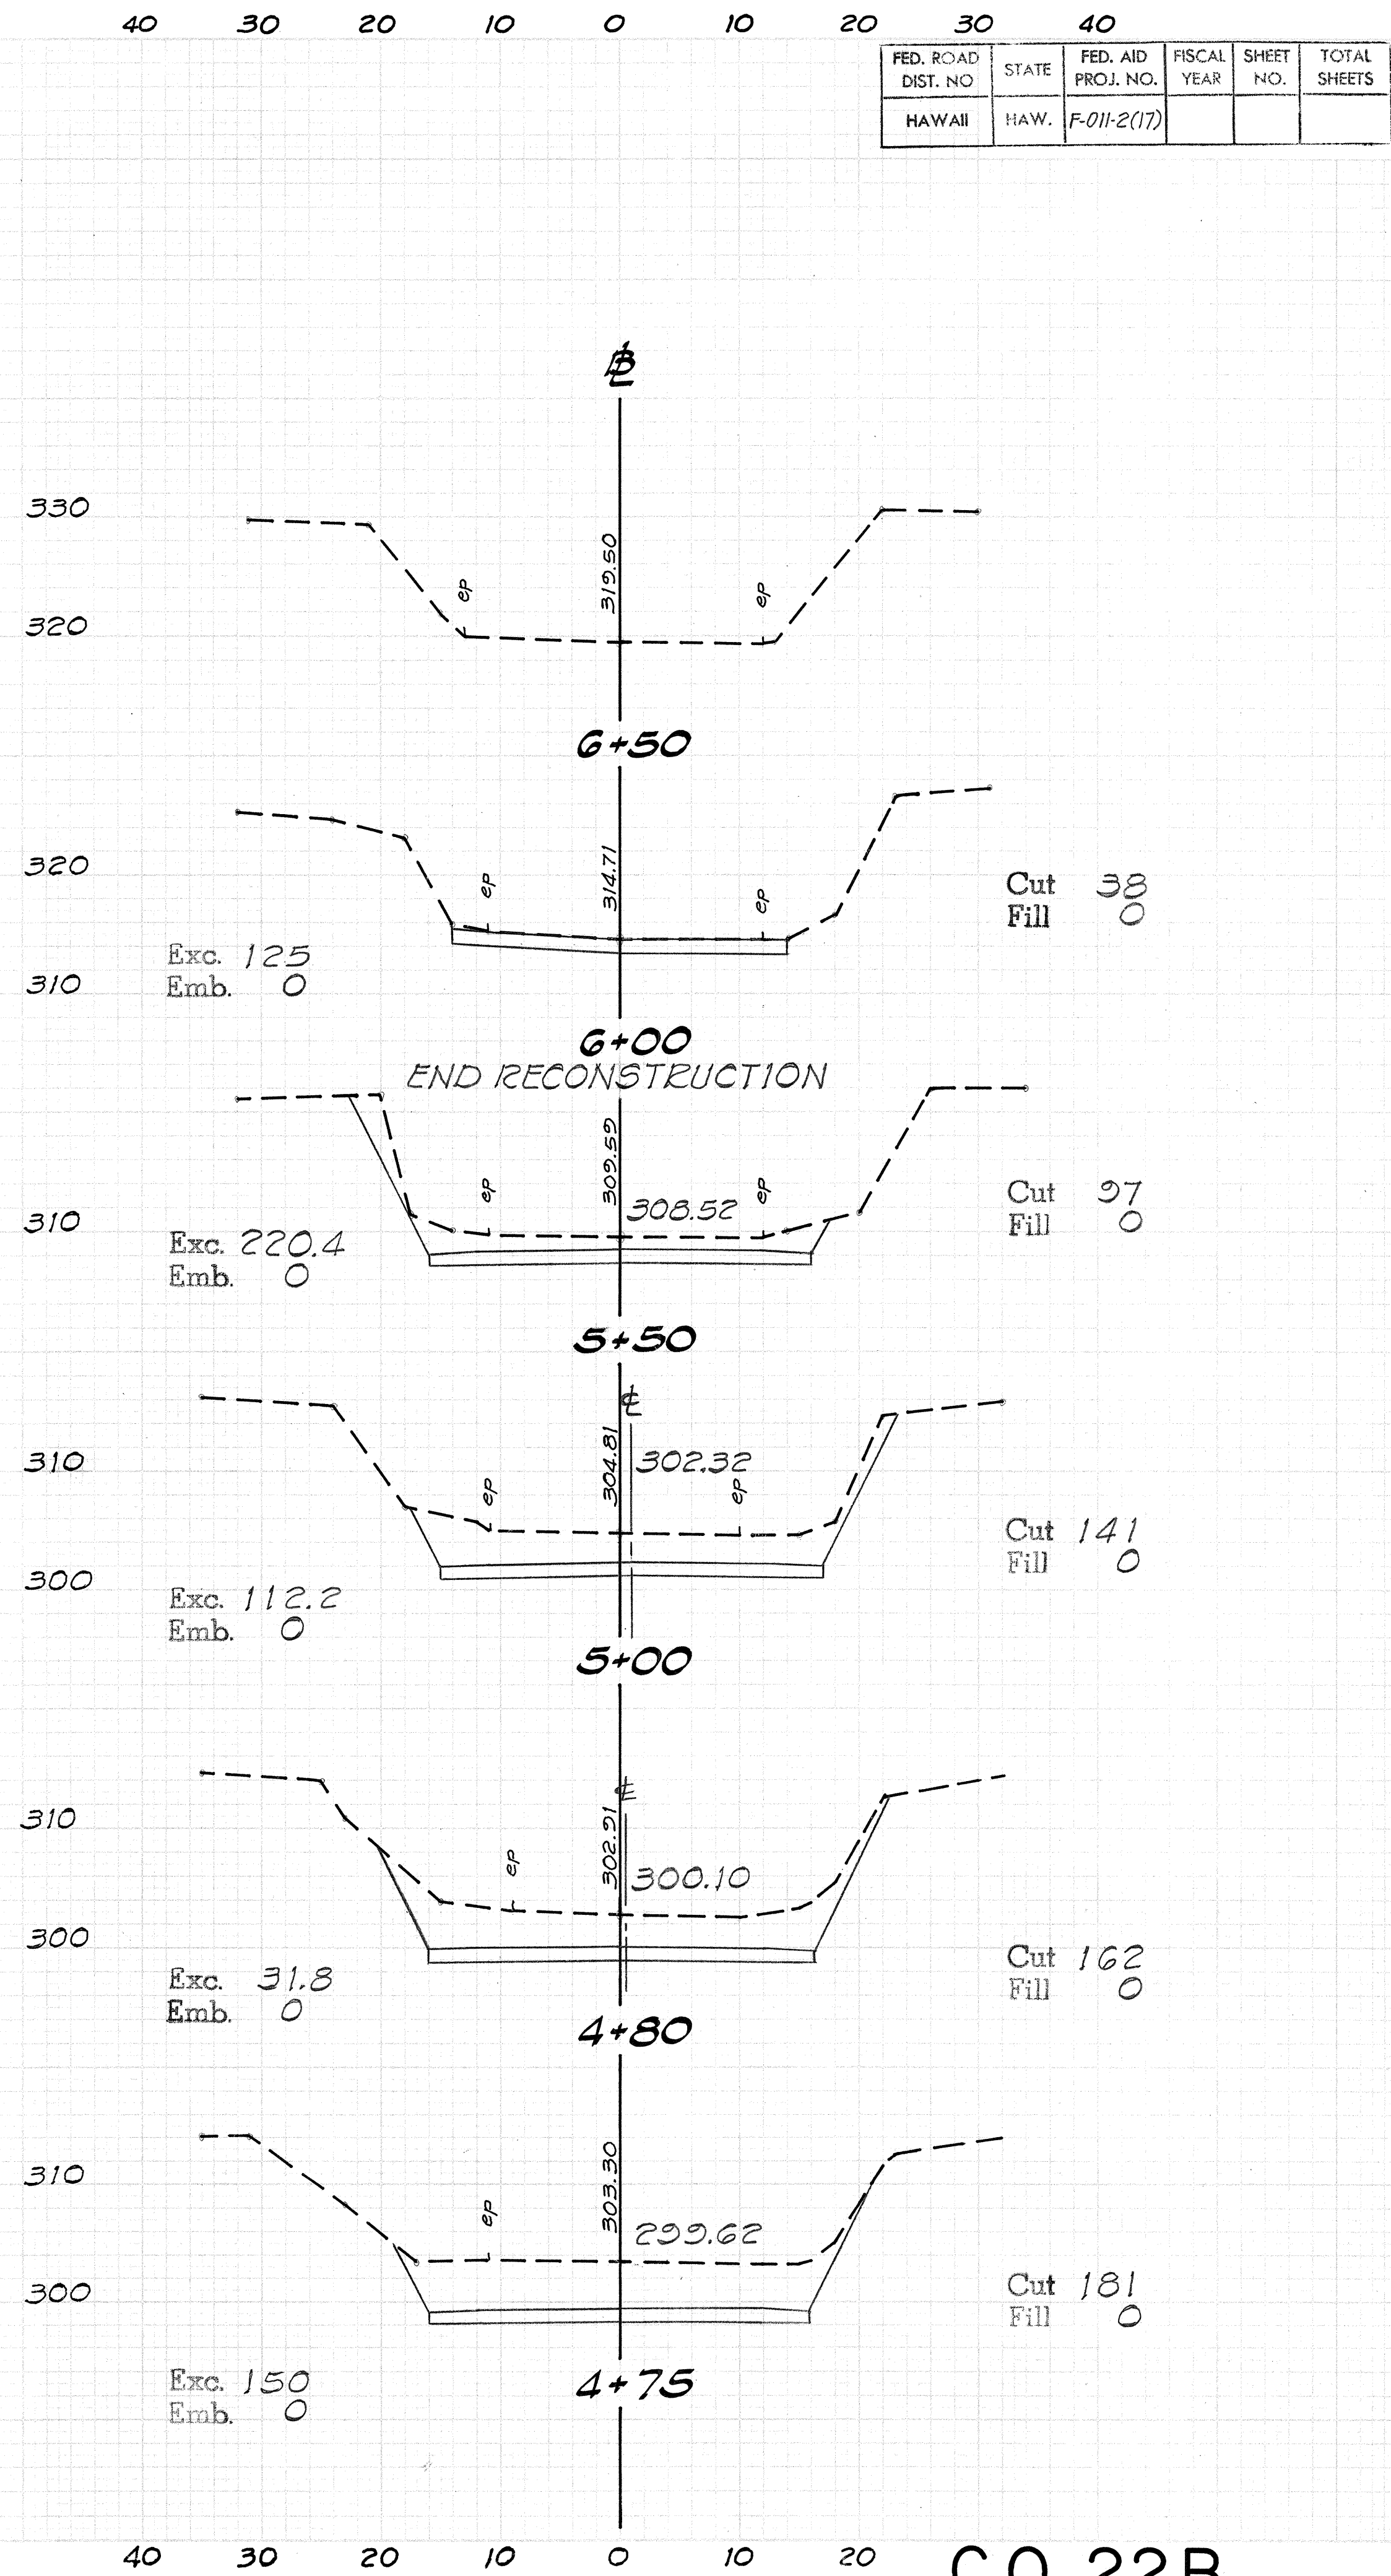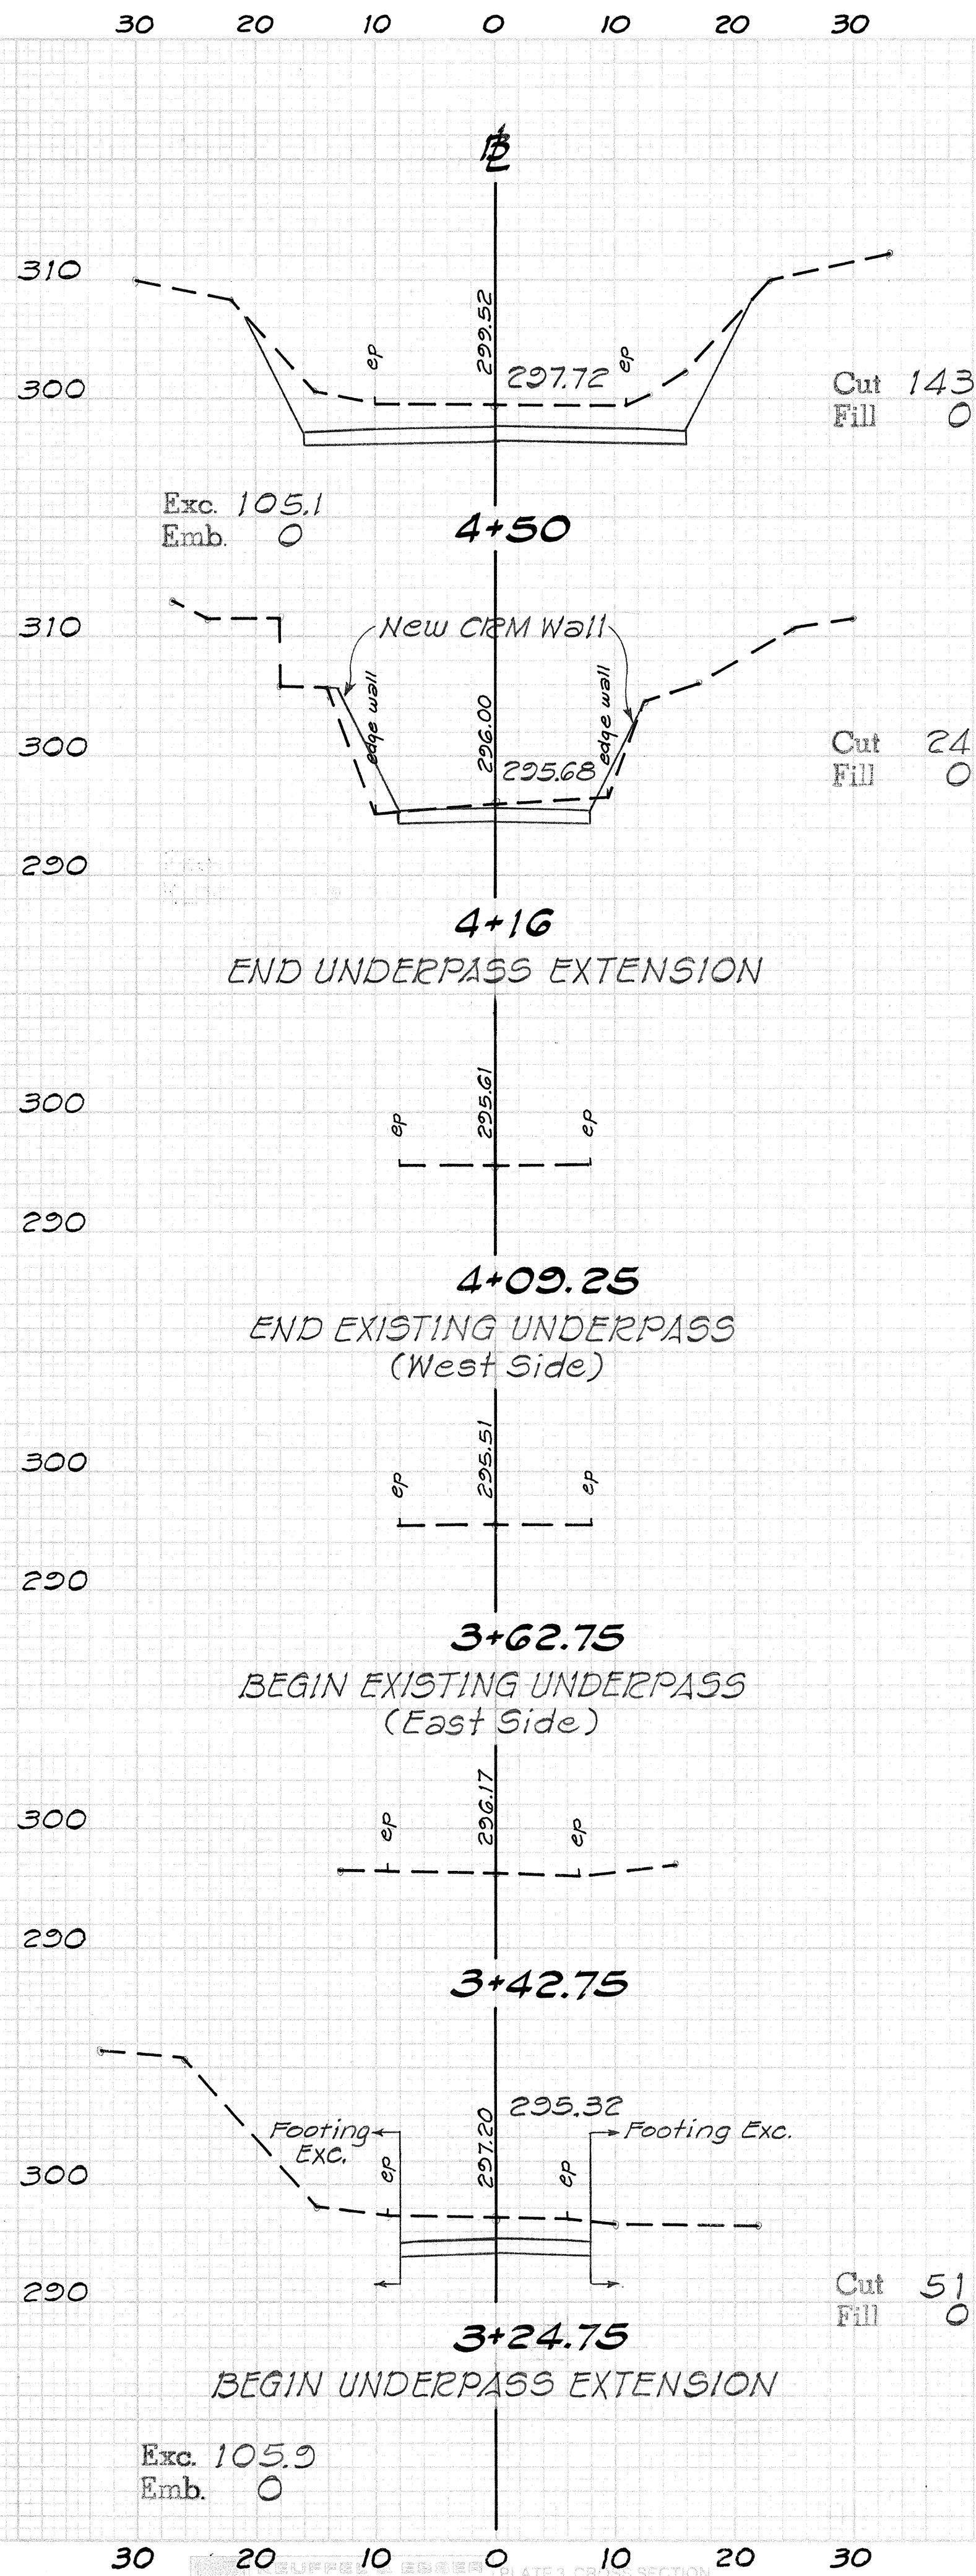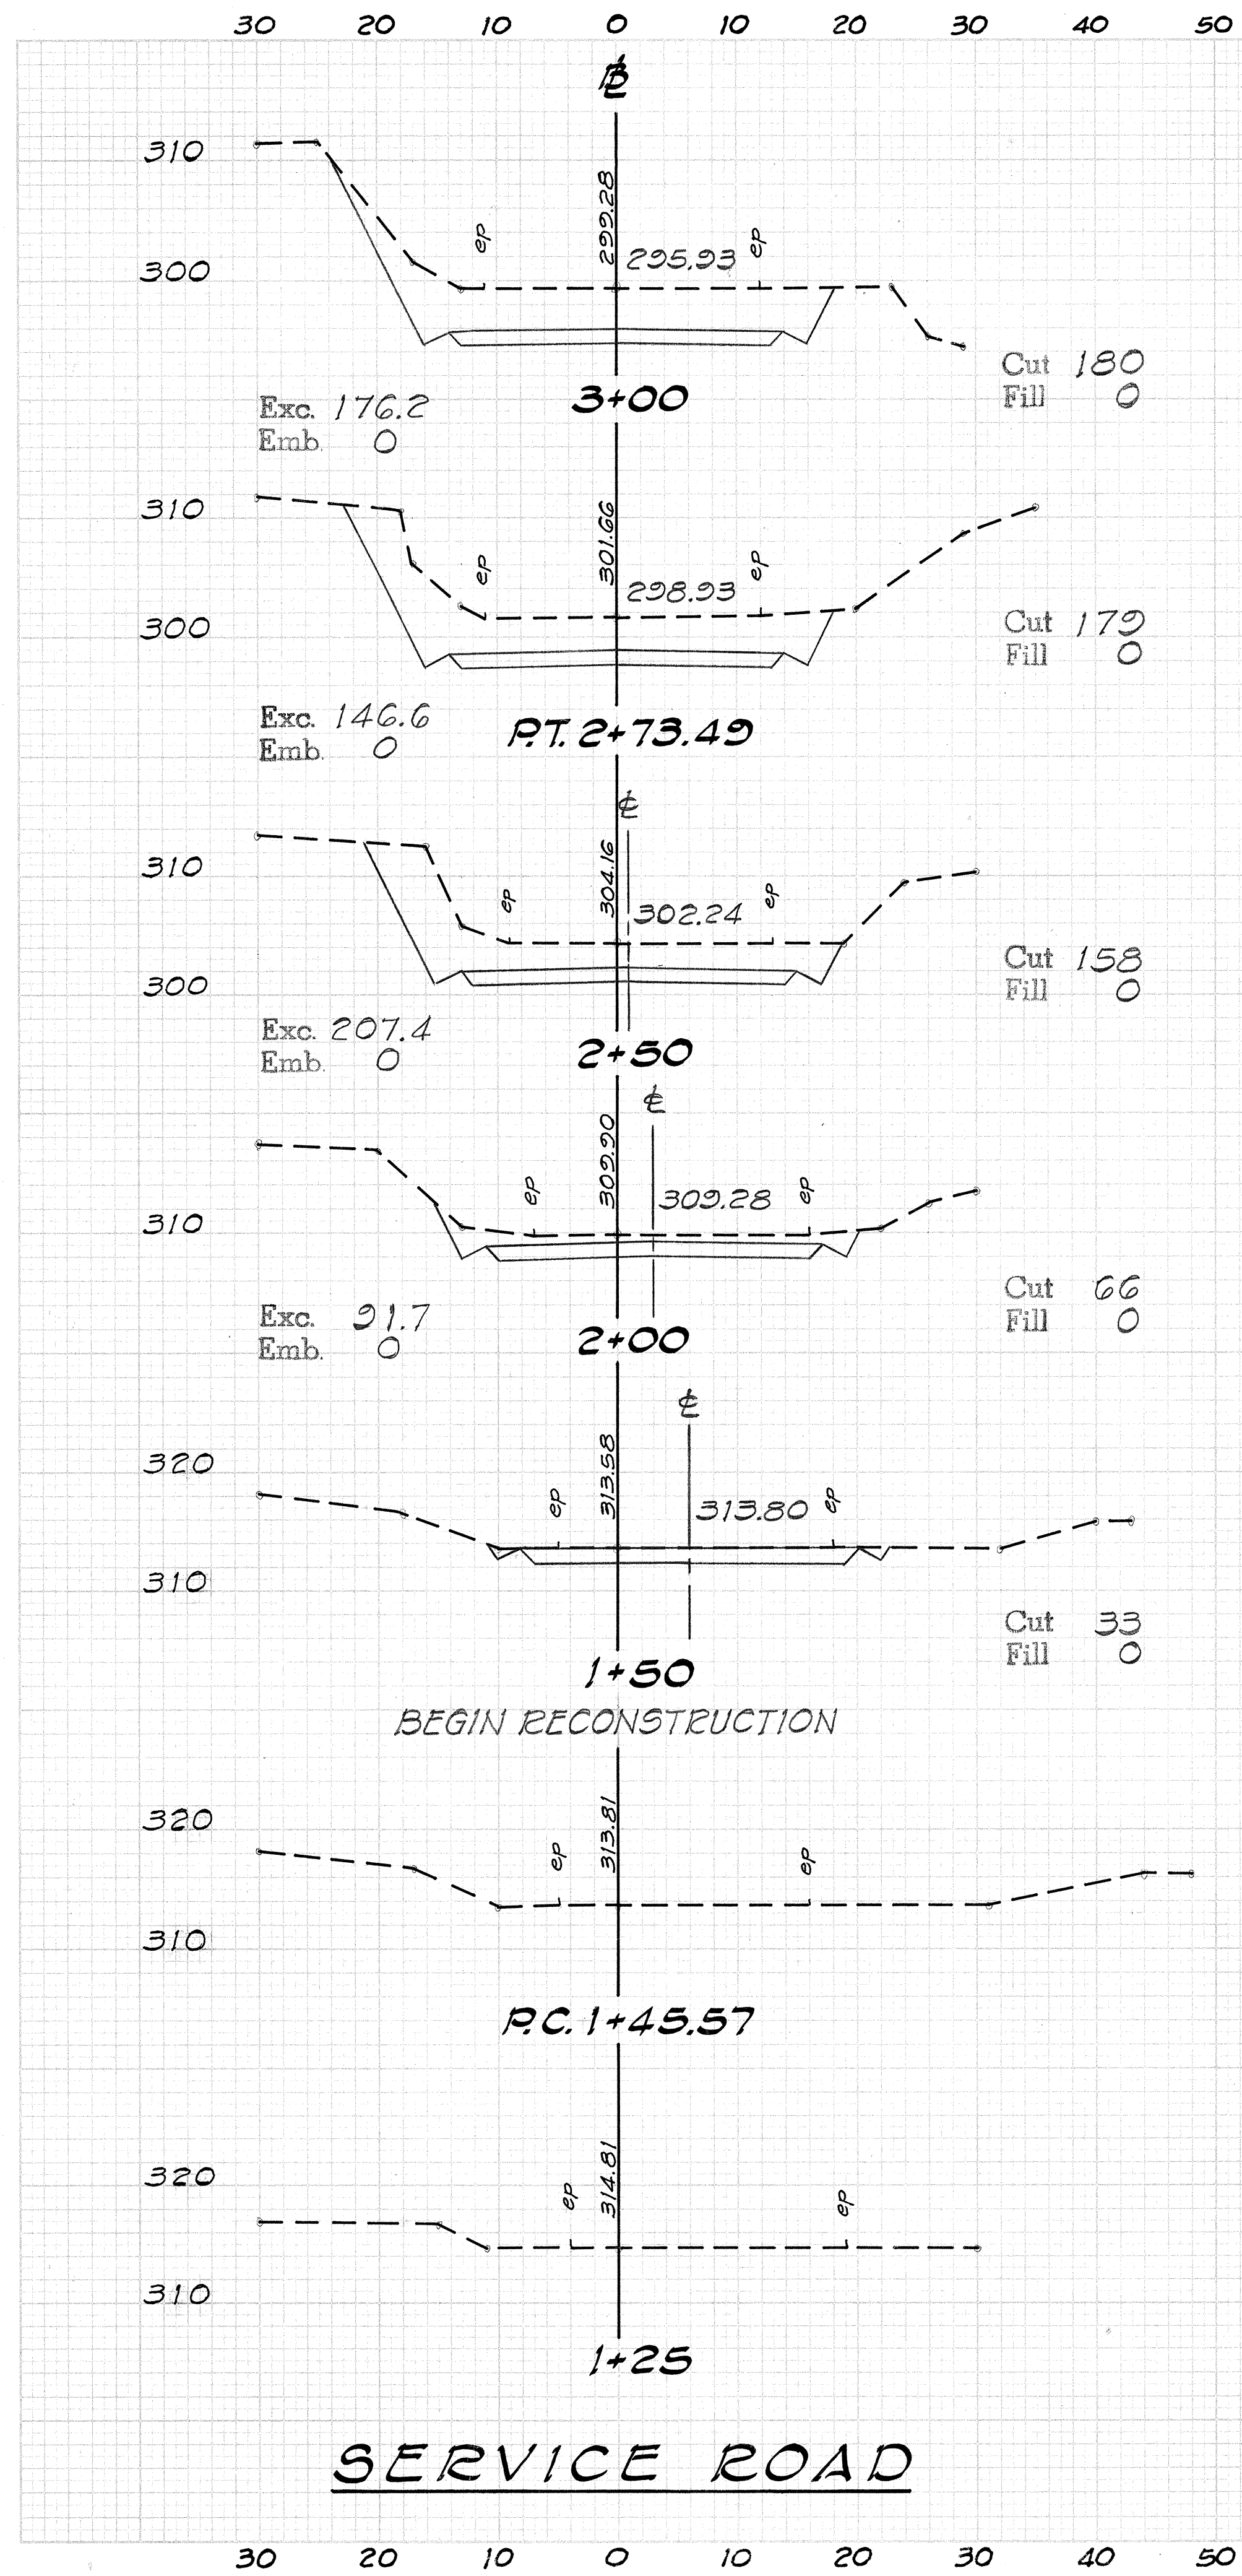

C.O. 22B

FED. ROAD DIST. NO.	STATE	FED. AID PROJ. NO.	FISCAL YEAR	SHEET NO.	TOTAL SHEETS
HAWAII	HAW.	F-011-2(17)	1986	23	142

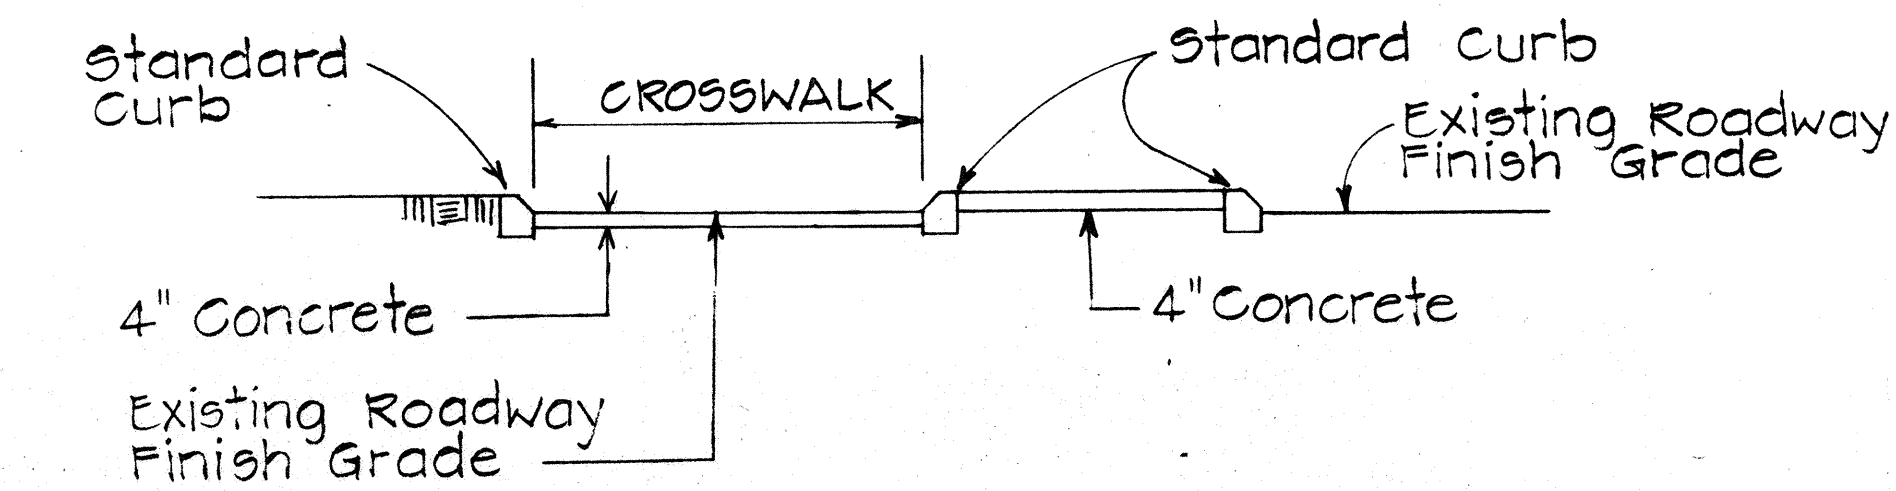


SECTION "A-A"

Use at Median Nose Crossings


Scale: 1"=5'

For Additional Details, See Type "C" Wheel Chair Ramp

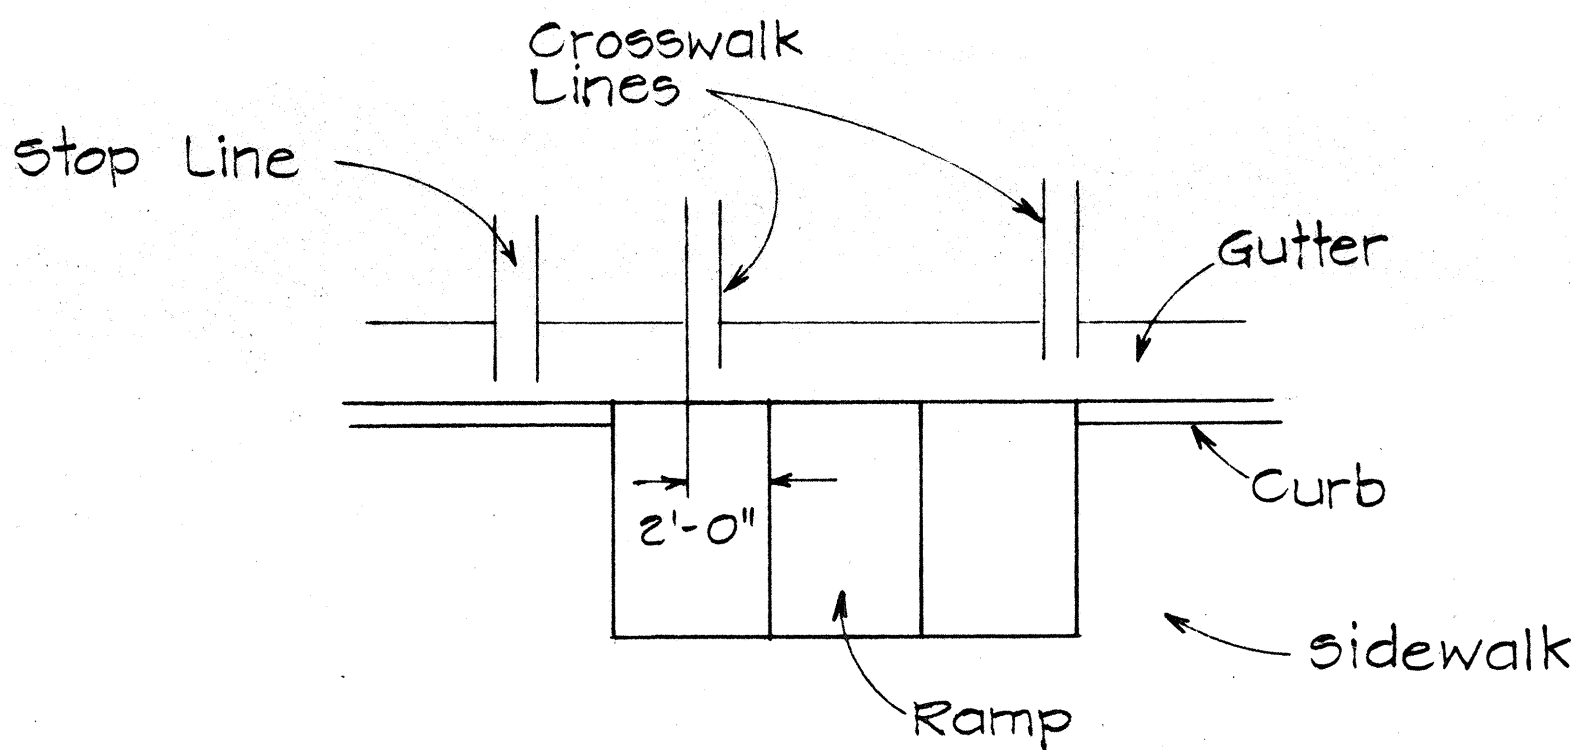

TYPICAL INSTALLATION AT CROSSWALKS

Scale: 1"=5'

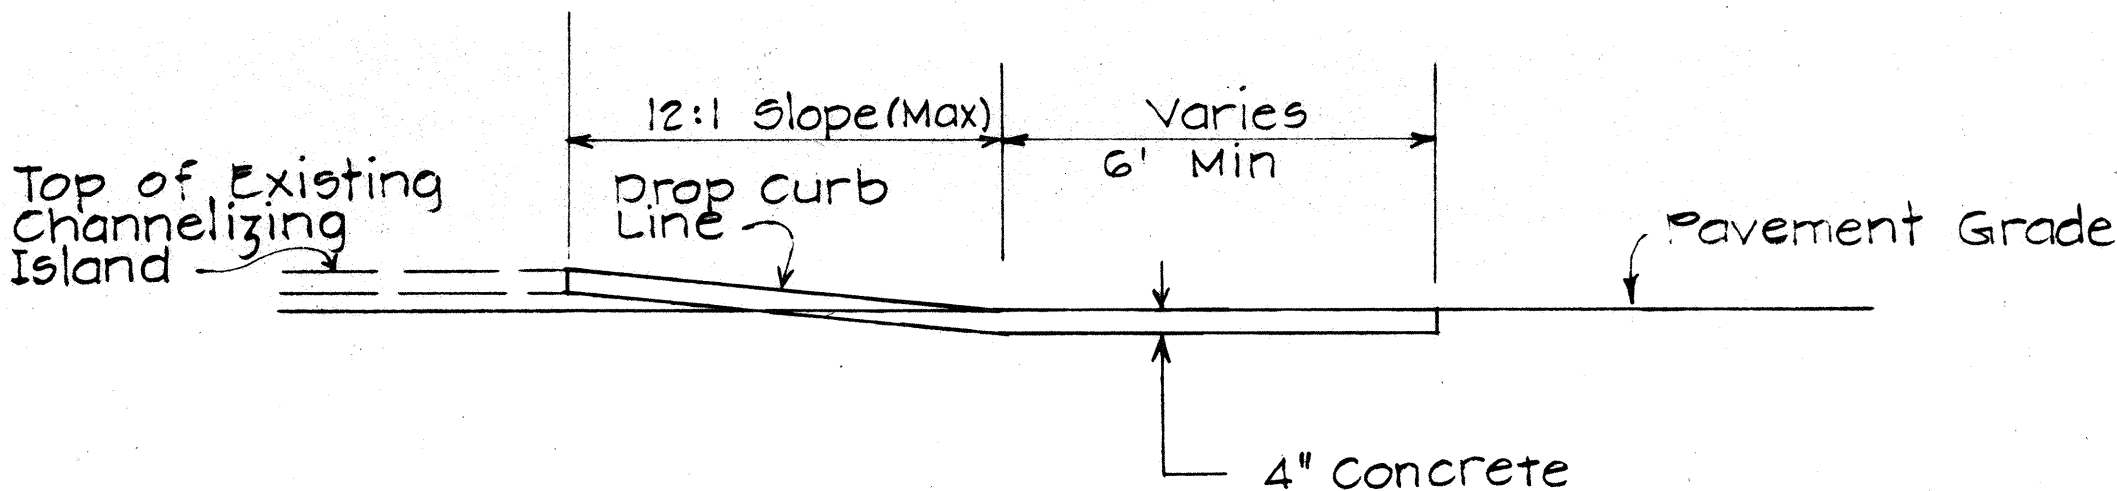

SECTION "B-B"

TYPE "B" MODIFIED WHEEL CHAIR RAMP


Use at Intersection of 2 Crosswalks On Channelizing Island

Scale: 3/8"=1'

For Additional Details See Type "B" Wheelchair Ramp

NOTES

1. When necessary by existing physical conditions, alternate Wheel Chair Ramps may be used subject to Engineers approval.
2. Subject to field conditions, the Engineer shall determine final location of Wheel Chair Ramp.
3. Where necessary pullboxes, handholes manholes etc. shall be adjusted to match Wheel Chair Ramp grade. Adjustments shall be considered incidental to Wheel Chair Ramp construction, unless otherwise noted.

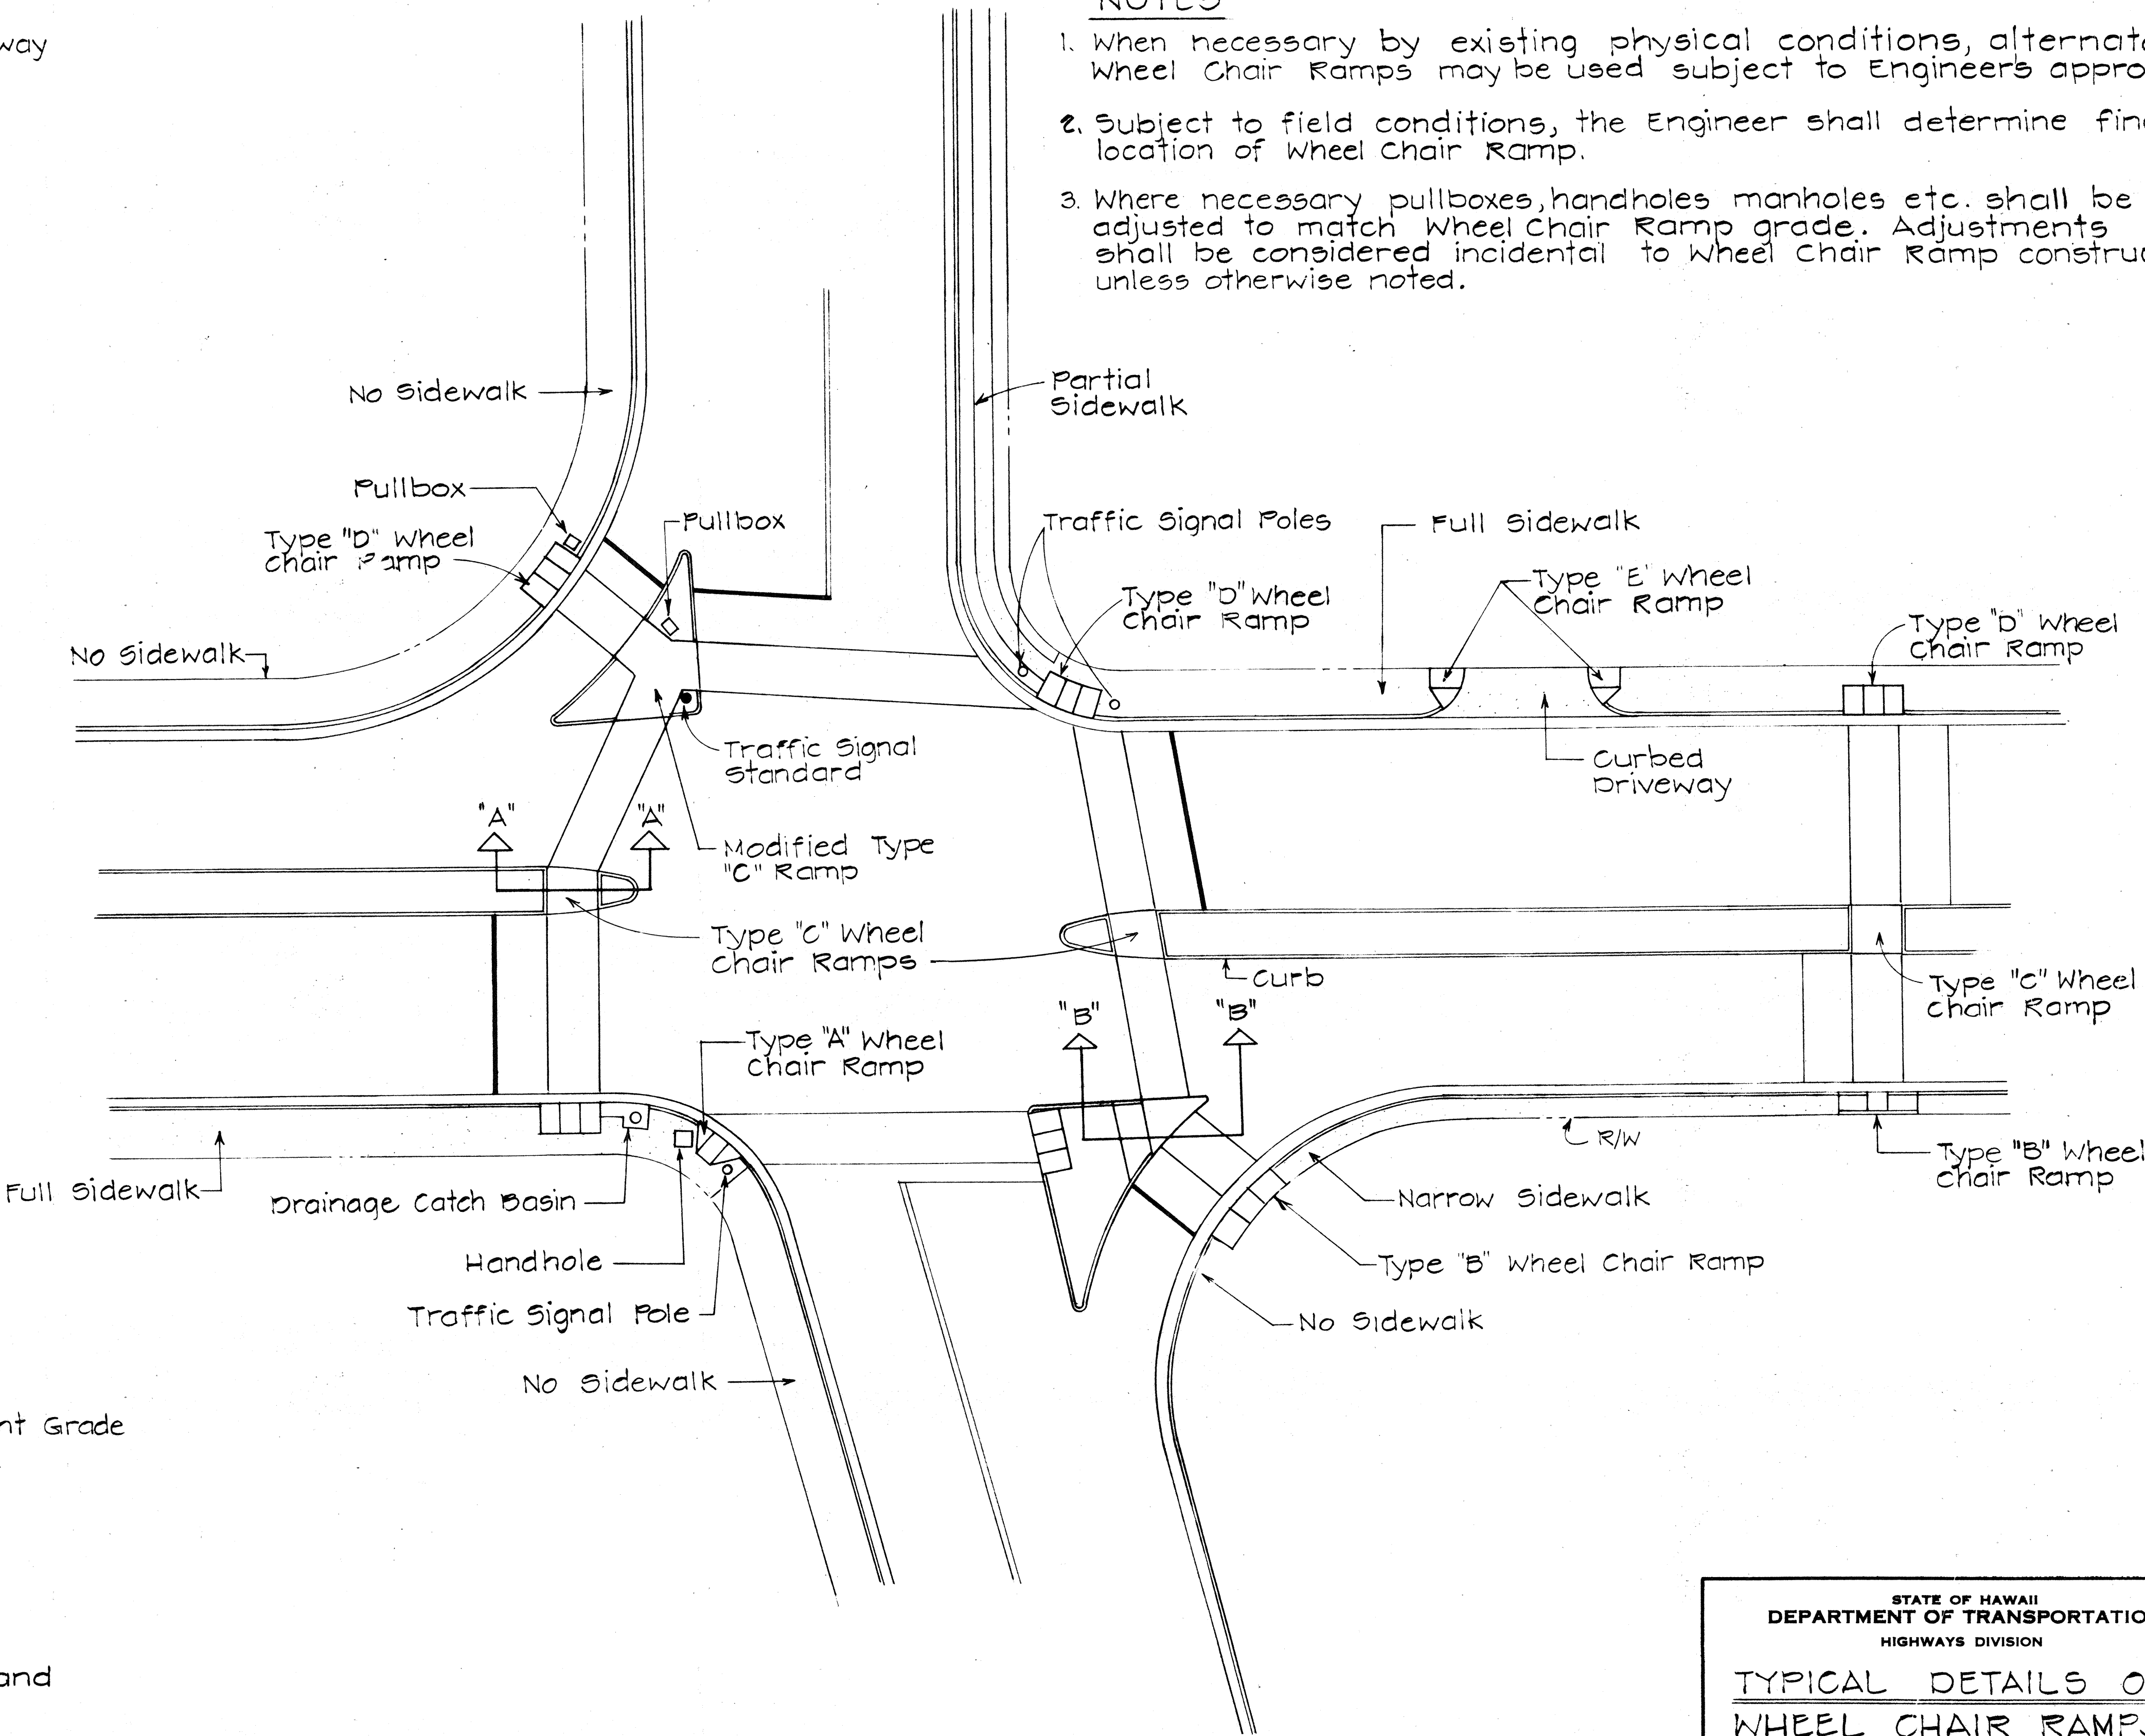

TYPICAL WHEEL CHAIR RAMPS



Scale: 1"=20'

STATE OF HAWAII
DEPARTMENT OF TRANSPORTATION
HIGHWAYS DIVISION


TYPICAL DETAILS OF WHEEL CHAIR RAMPS

Scale: As Shown May, 1978
SHEET NO. OF SHEETS


FED. ROAD DIST. NO.	STATE	FED. AID PROJ. NO.	FISCAL YEAR	SHEET NO.	TOTAL SHEETS
HAWAII	HAW.	F-011-2(17)	1986	24	142

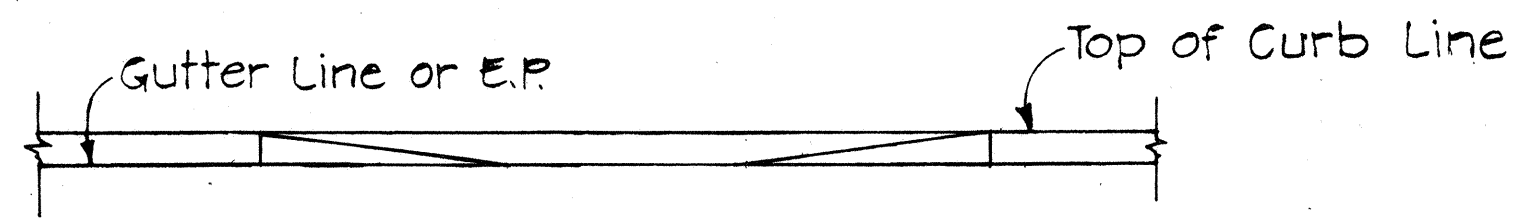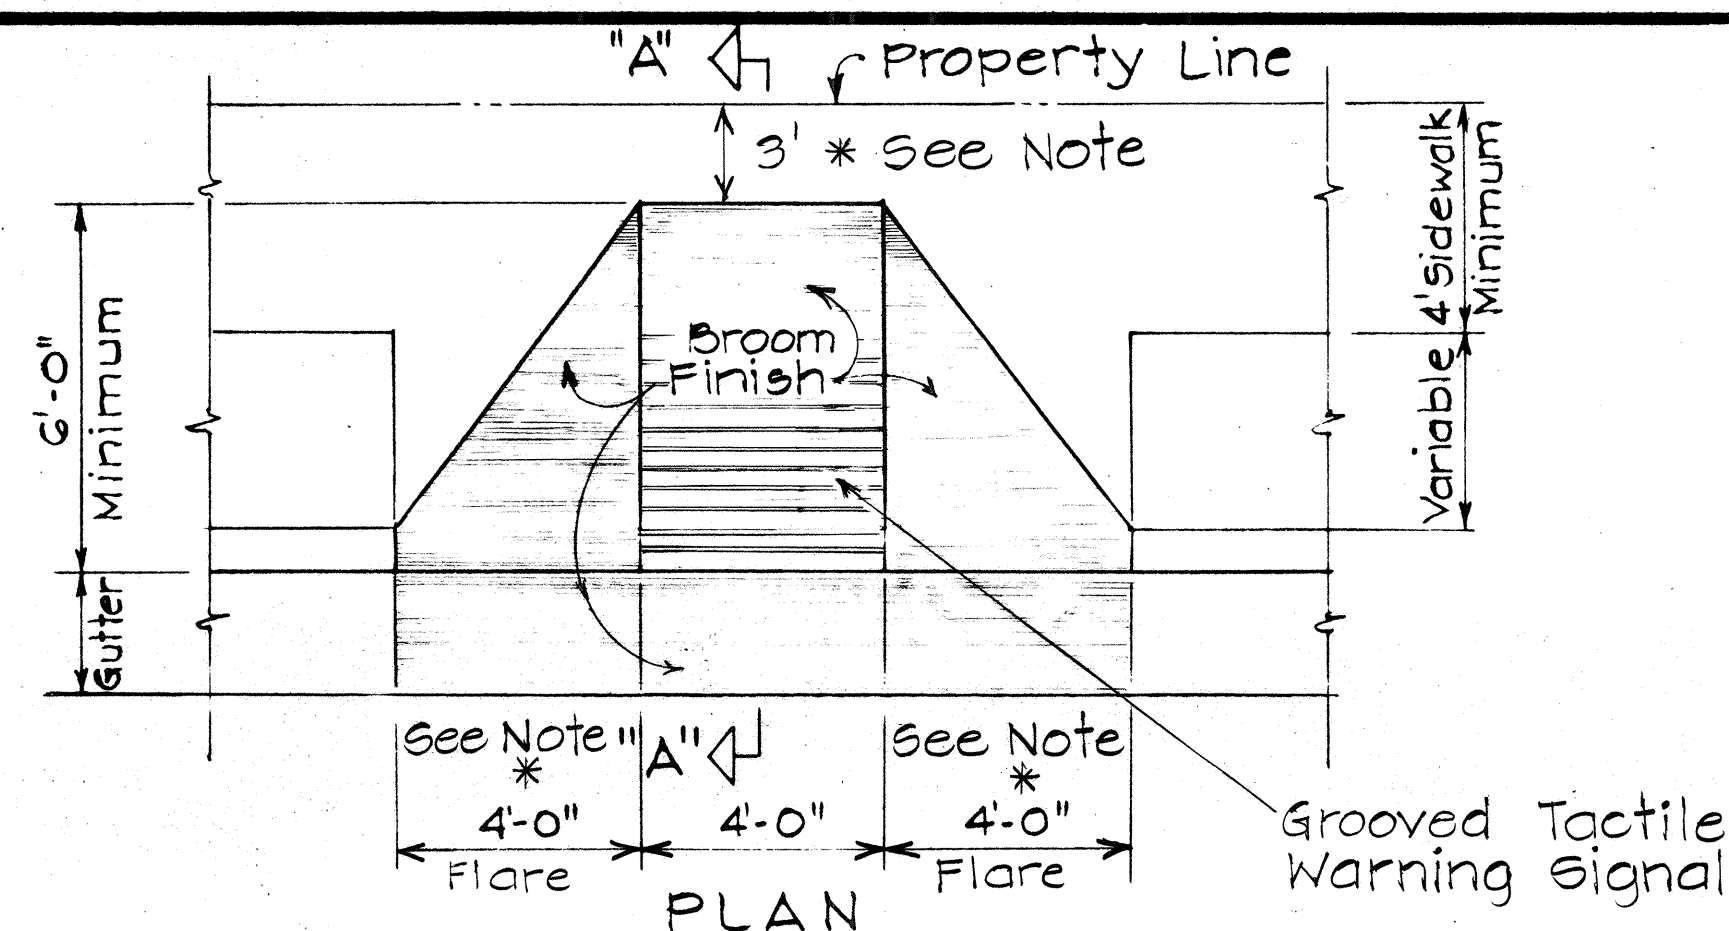



ELEVATION
* Where dimension is less than 3', Flare width shall be 3'

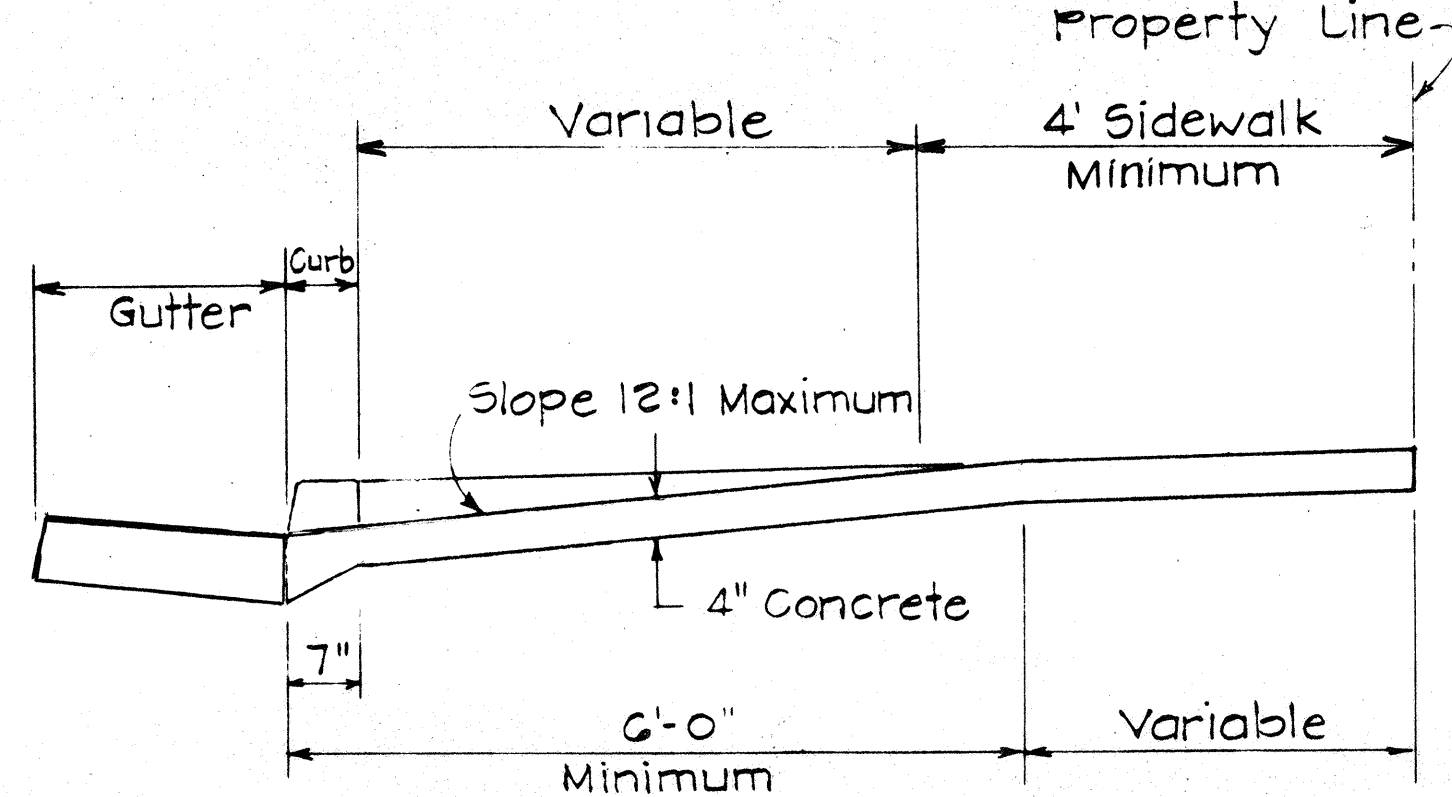




SECTION "A-A"
WHEELCHAIR RAMP - TYPE "A"
USE WHERE OBSTRUCTIONS EXIST

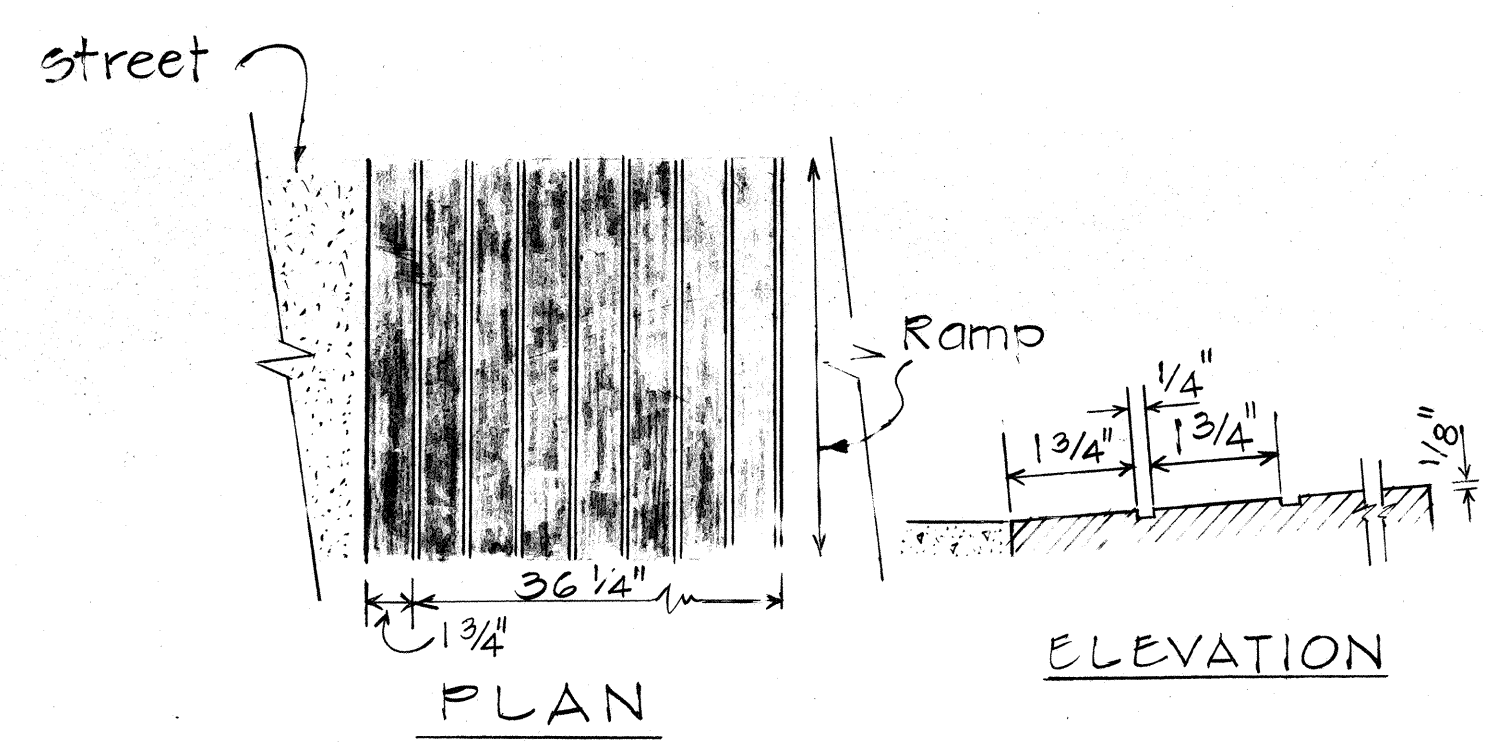



GROOVED TACTILE WARNING SIGNAL

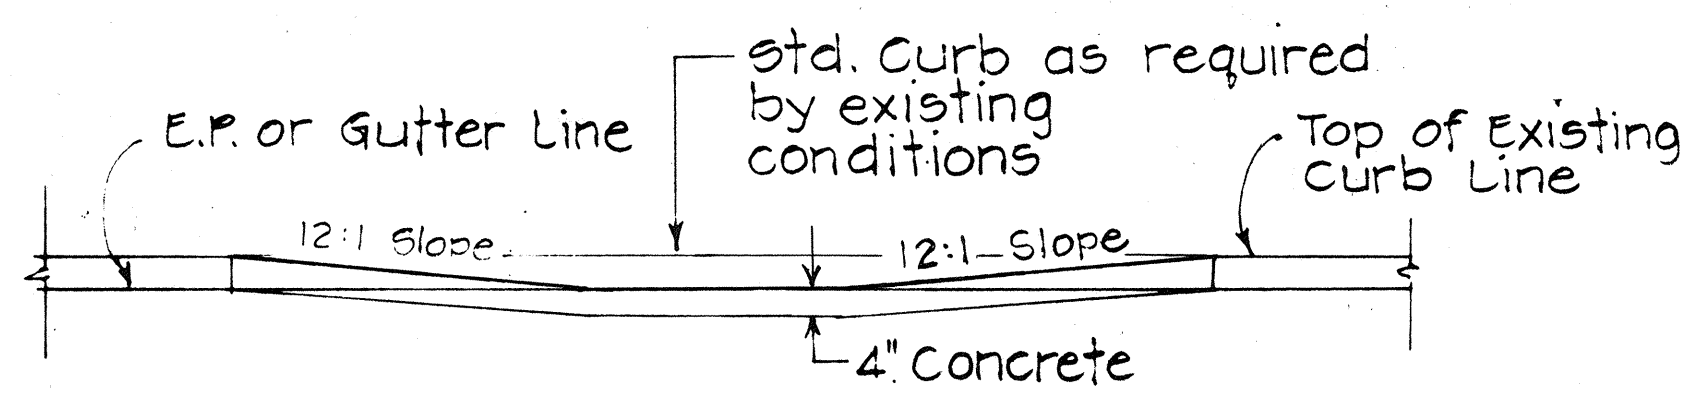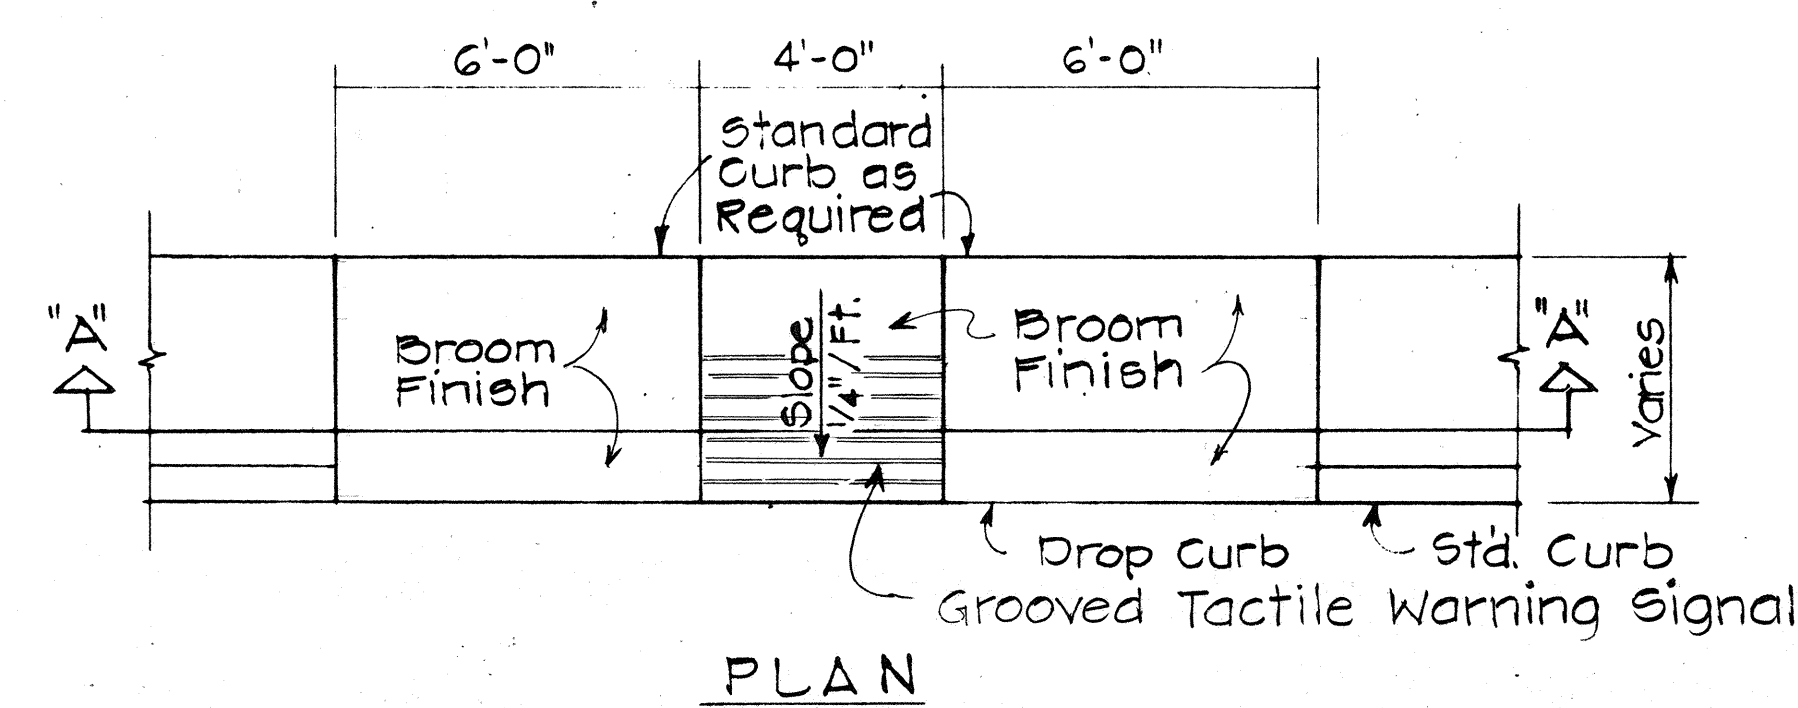


ELEVATION SECTION "A-A"
WHEELCHAIR RAMP - TYPE "B"
USE AT SIDEWALKS WITH LESS THAN 6'-0" WIDTH

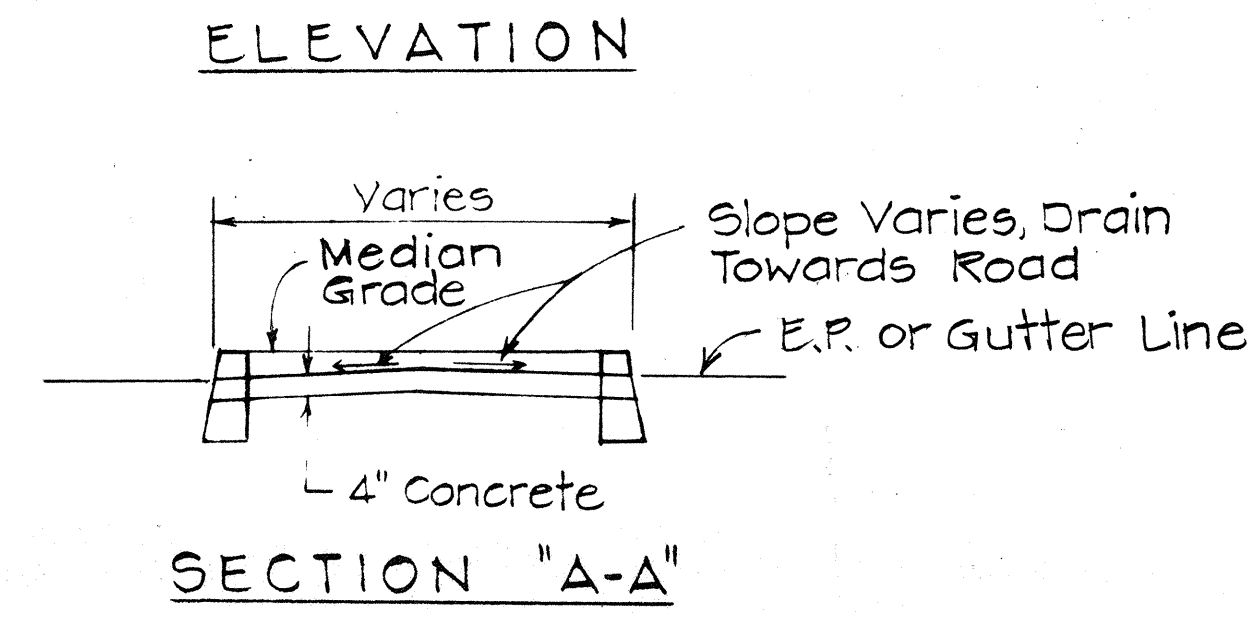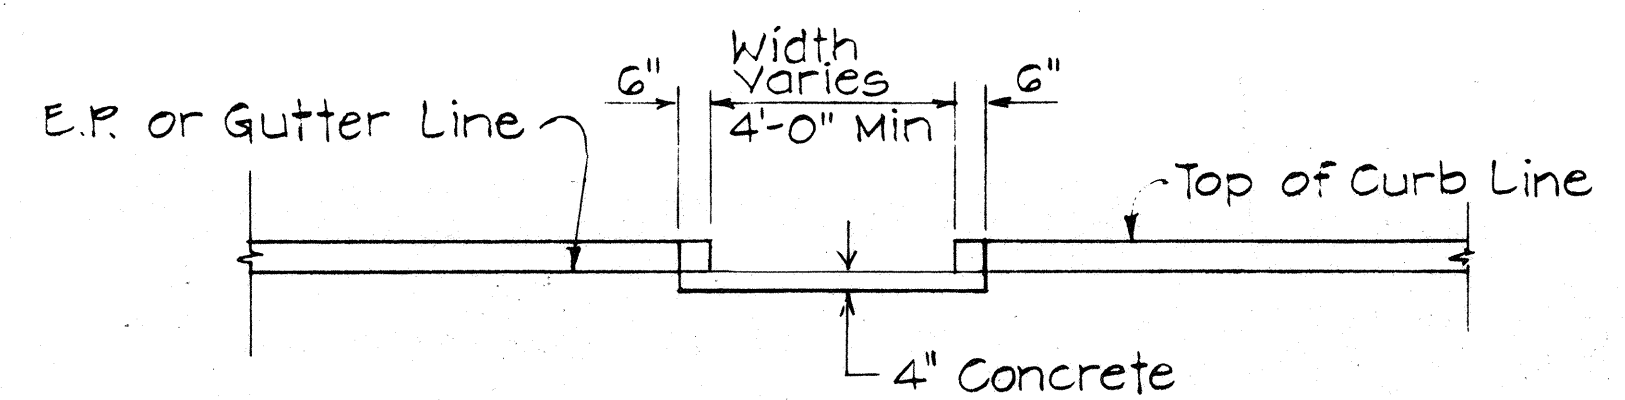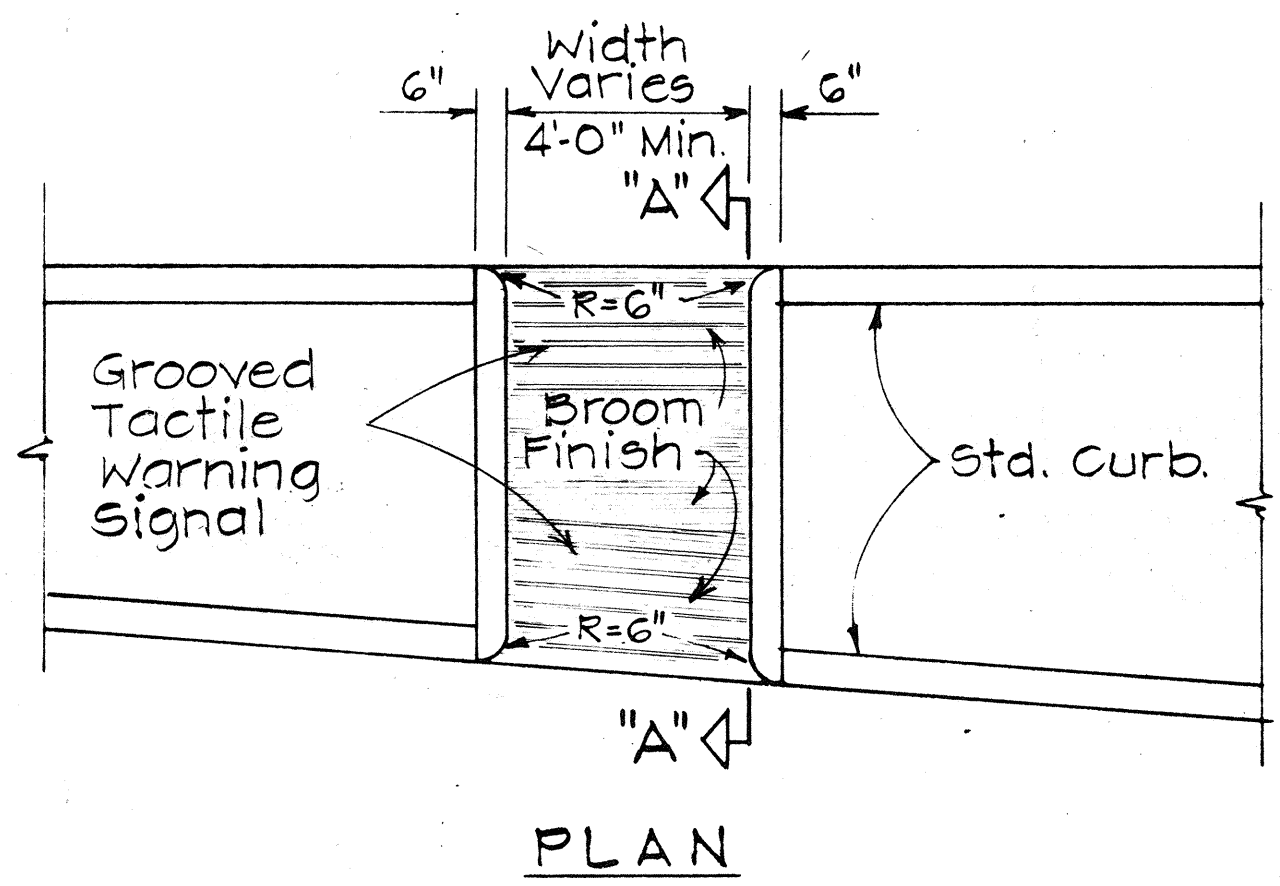

SECTION "A-A"
WHEELCHAIR RAMP - TYPE "C"
USE AT MEDIAN CROSSINGS, ISLANDS

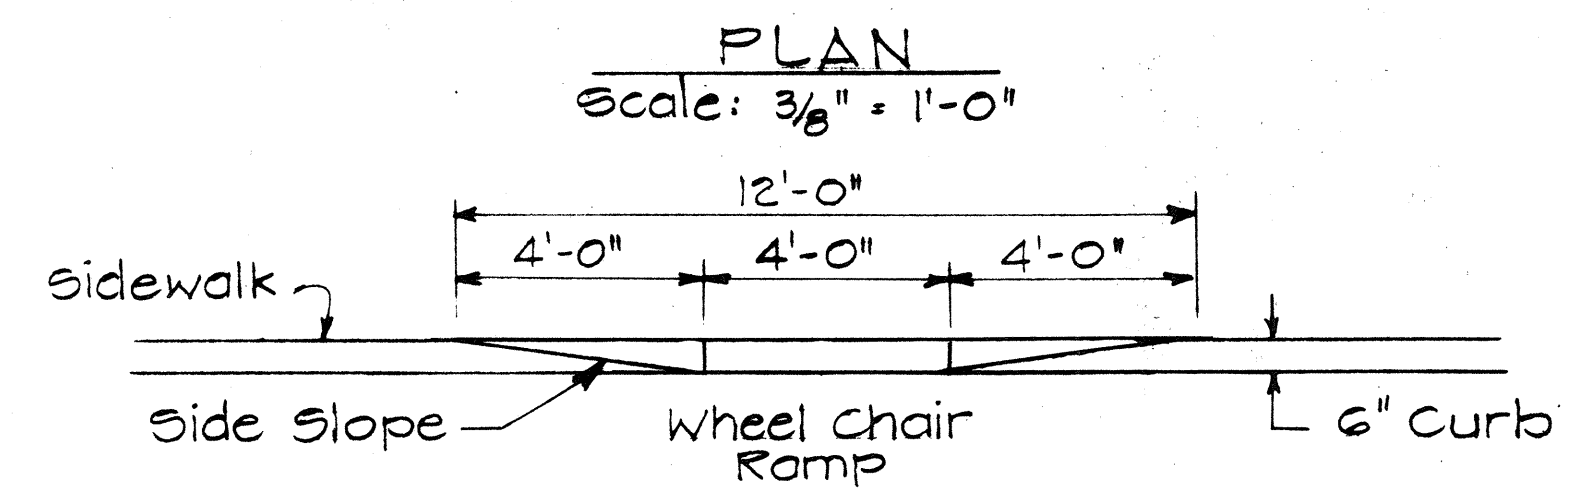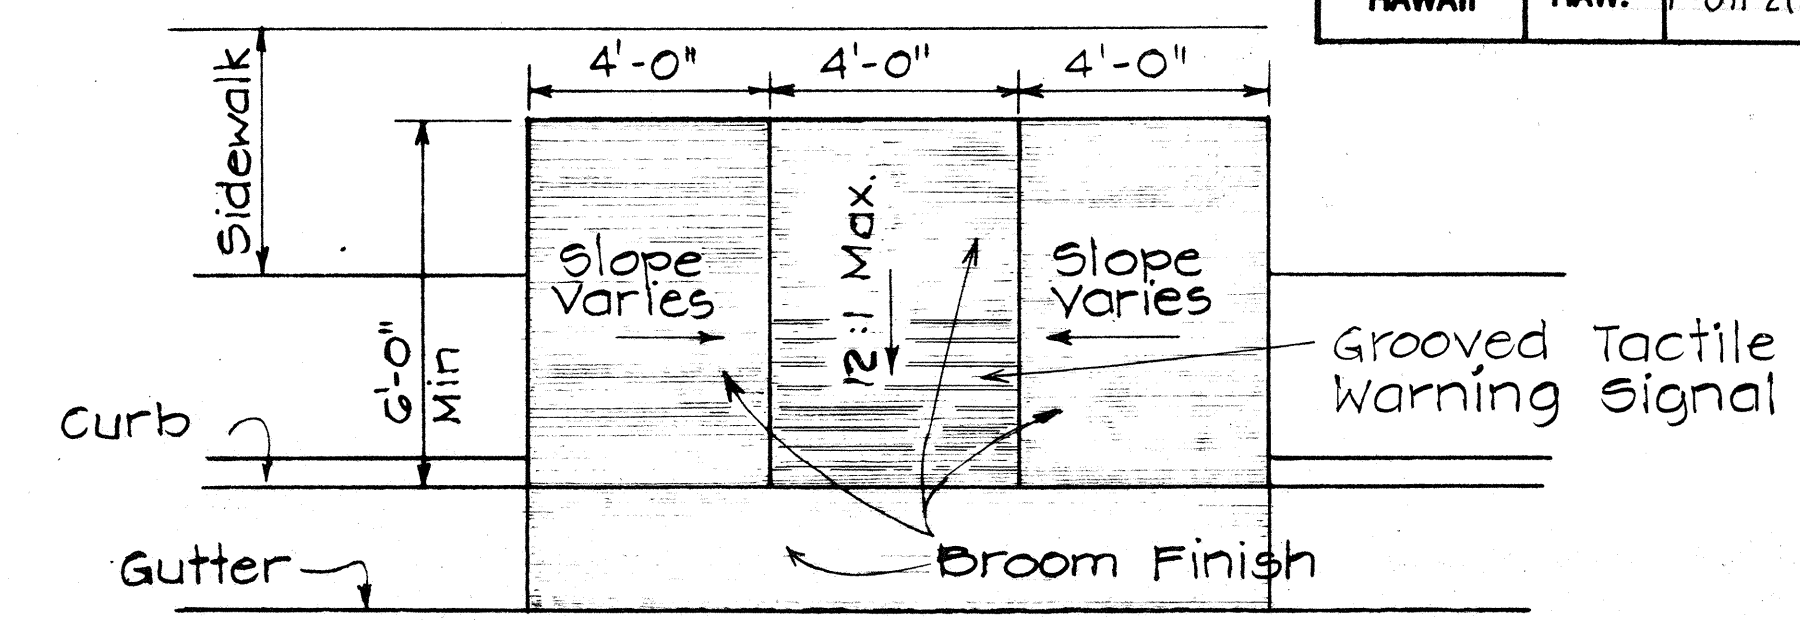

ELEVATION
Scale: 3/8" = 1'-0"
WHEELCHAIR RAMP - TYPE "D"
USE WHEN IDEAL CONDITIONS EXIST

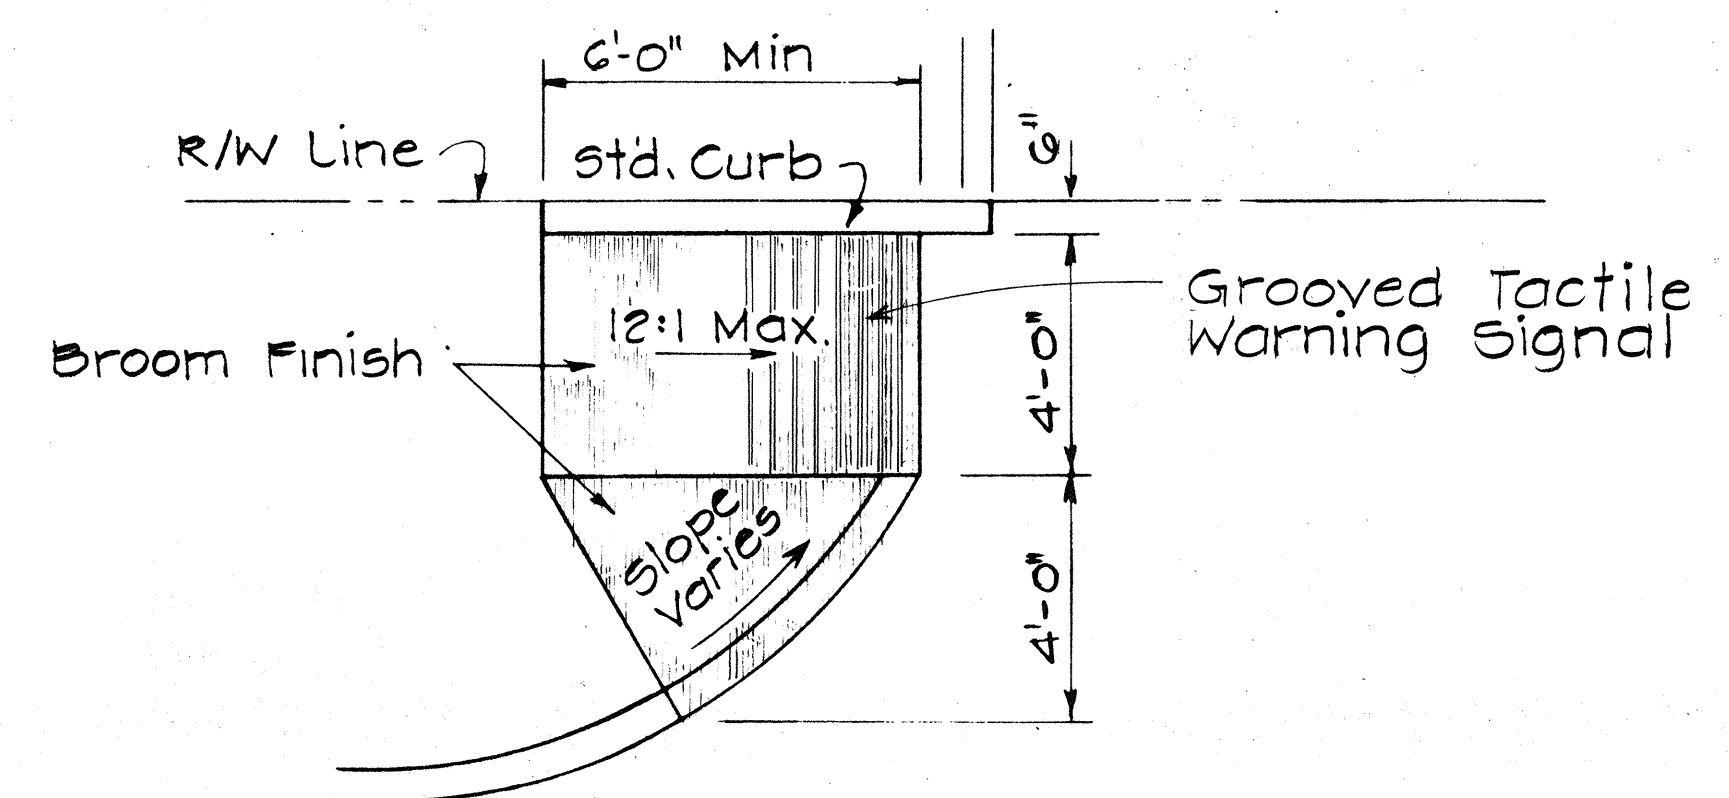


WHEELCHAIR RAMP - TYPE "E"
USE AT CURBED DRIVEWAYS
Scale: 3/8" = 1'-0"

STATE OF HAWAII
DEPARTMENT OF TRANSPORTATION
HIGHWAYS DIVISION

TYPICAL DETAILS OF WHEEL CHAIR RAMPS

Scale: As Shown May, 1978
SHEET NO. OF SHEETS

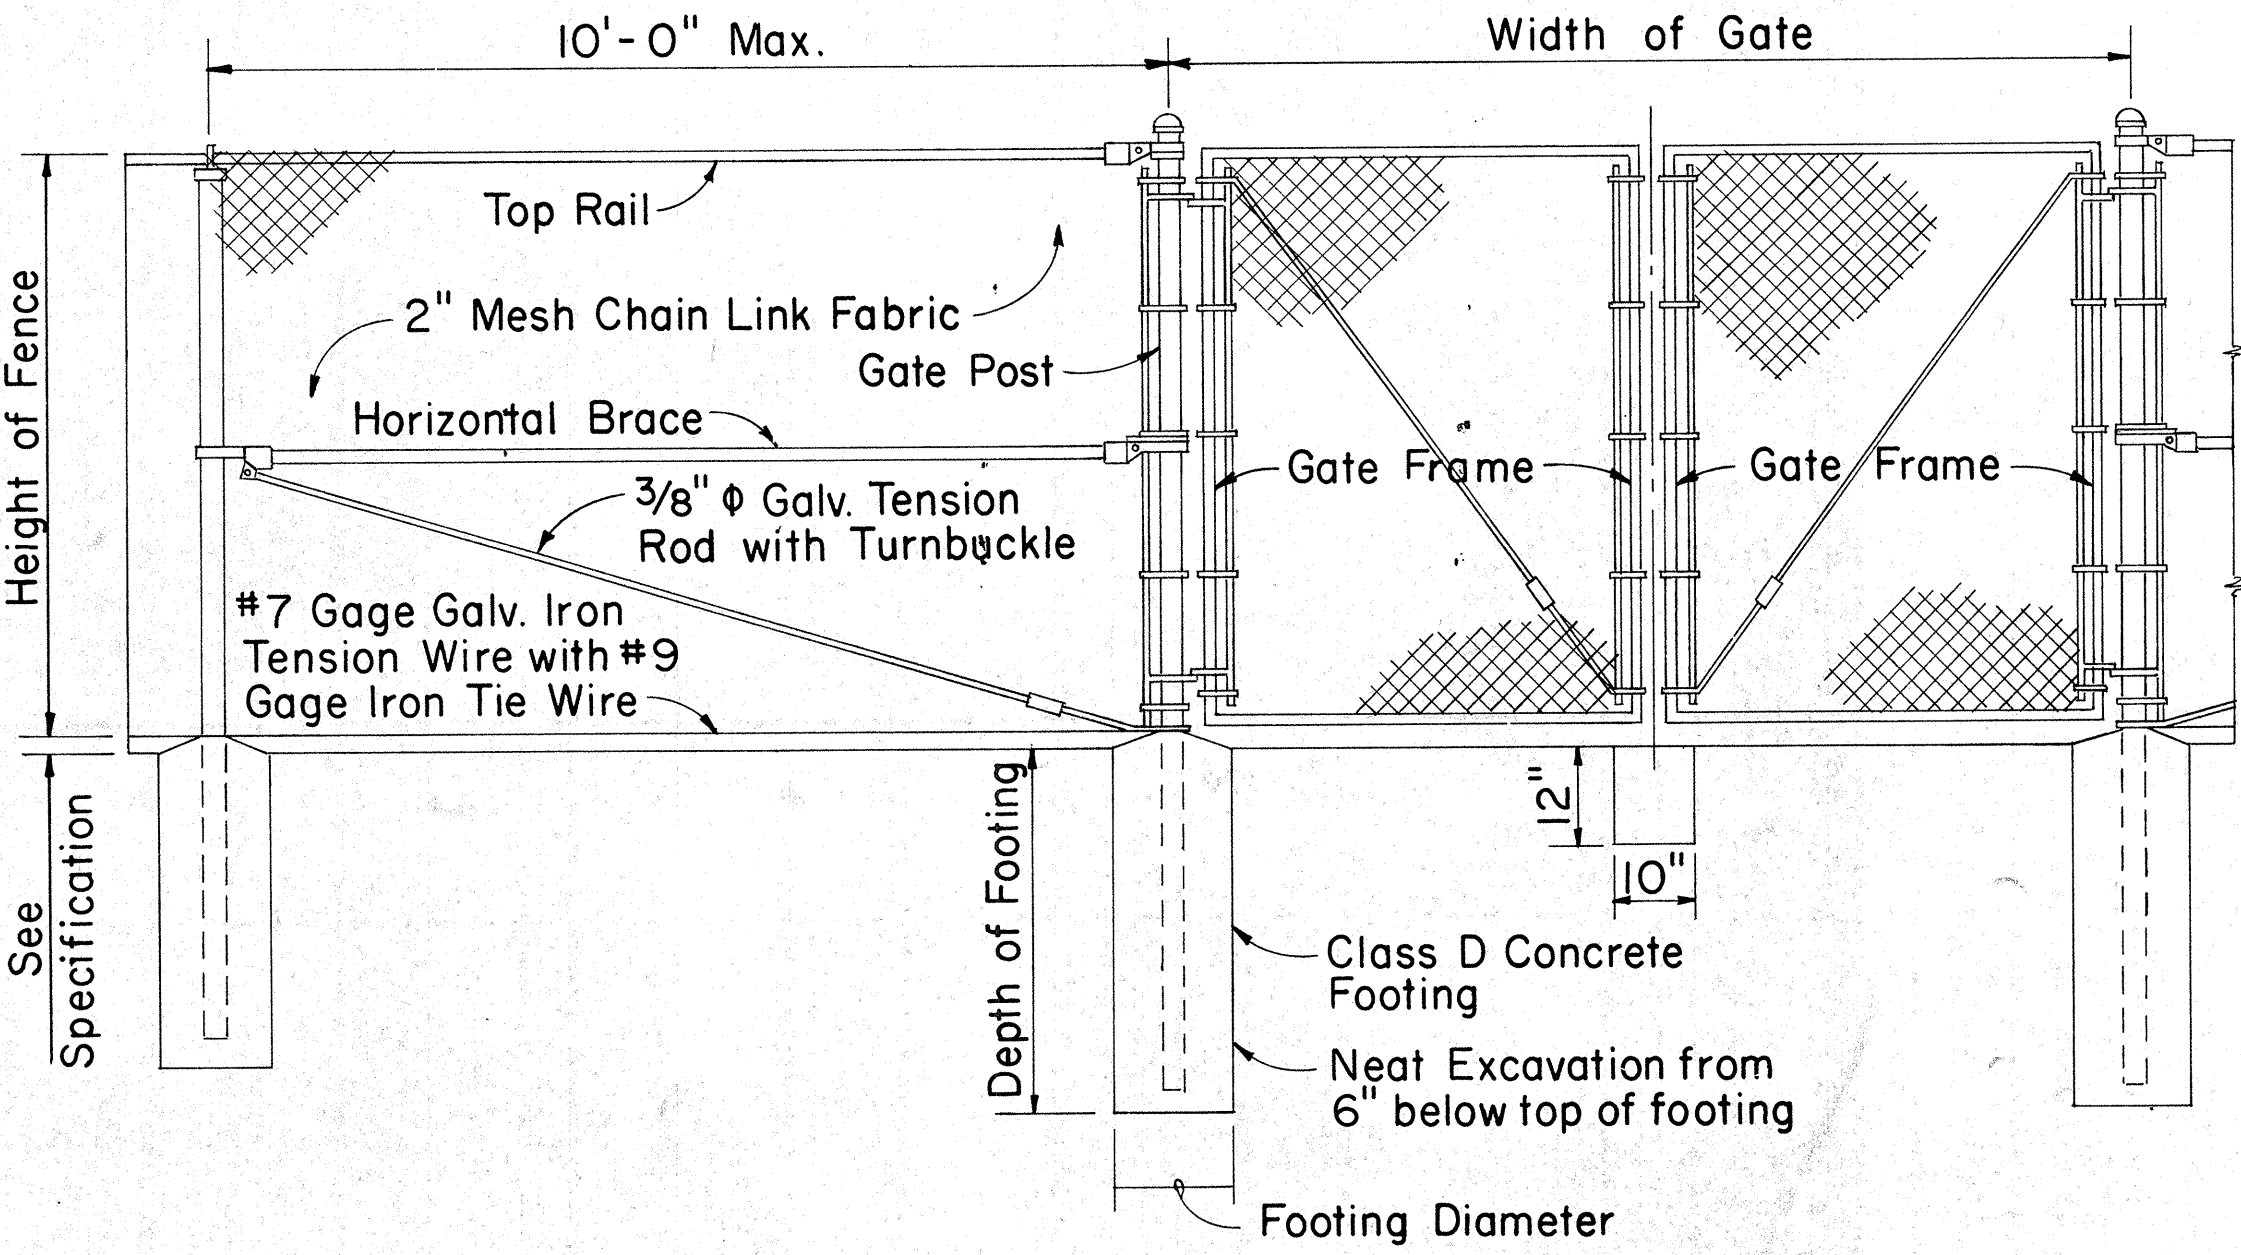


LINE POST

GATE POST

GATE POST

DETAIL OF CHAIN LINK GATE

- NOTE: 1. Gate fork latch and lock, flush plate and anchor, and plunger shall be installed with Gates, and shall be considered as incidental to Chain Link Fence Gate.
 2. Gate frames shall be mitered and welded at corners.
 3. Fence detail not shown shall be in accordance with the Standard Specifications.

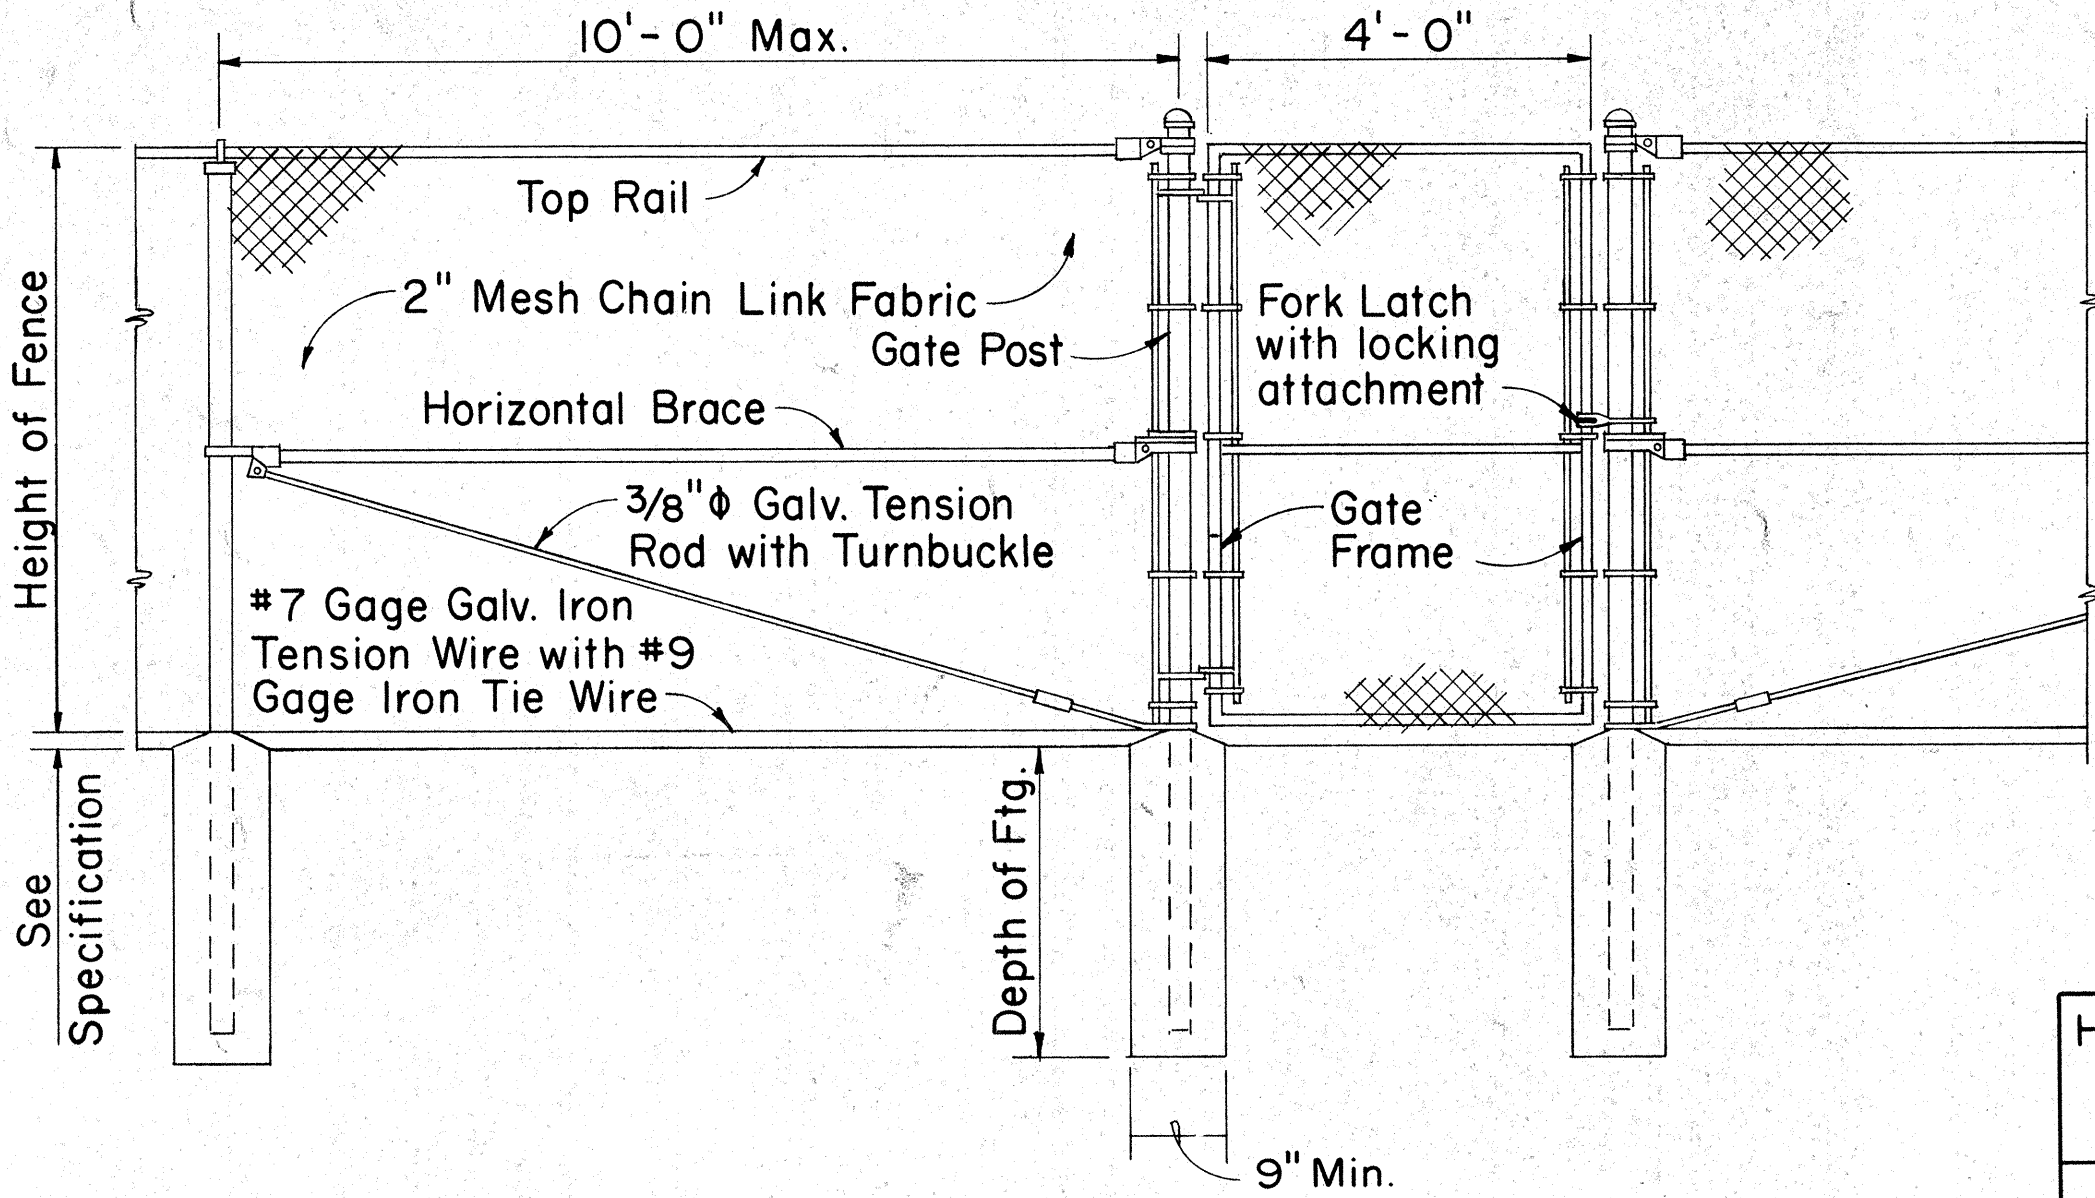


LINE POST

GATE POST

GATE POST

DETAIL OF 4 FT. CHAIN LINK GATE

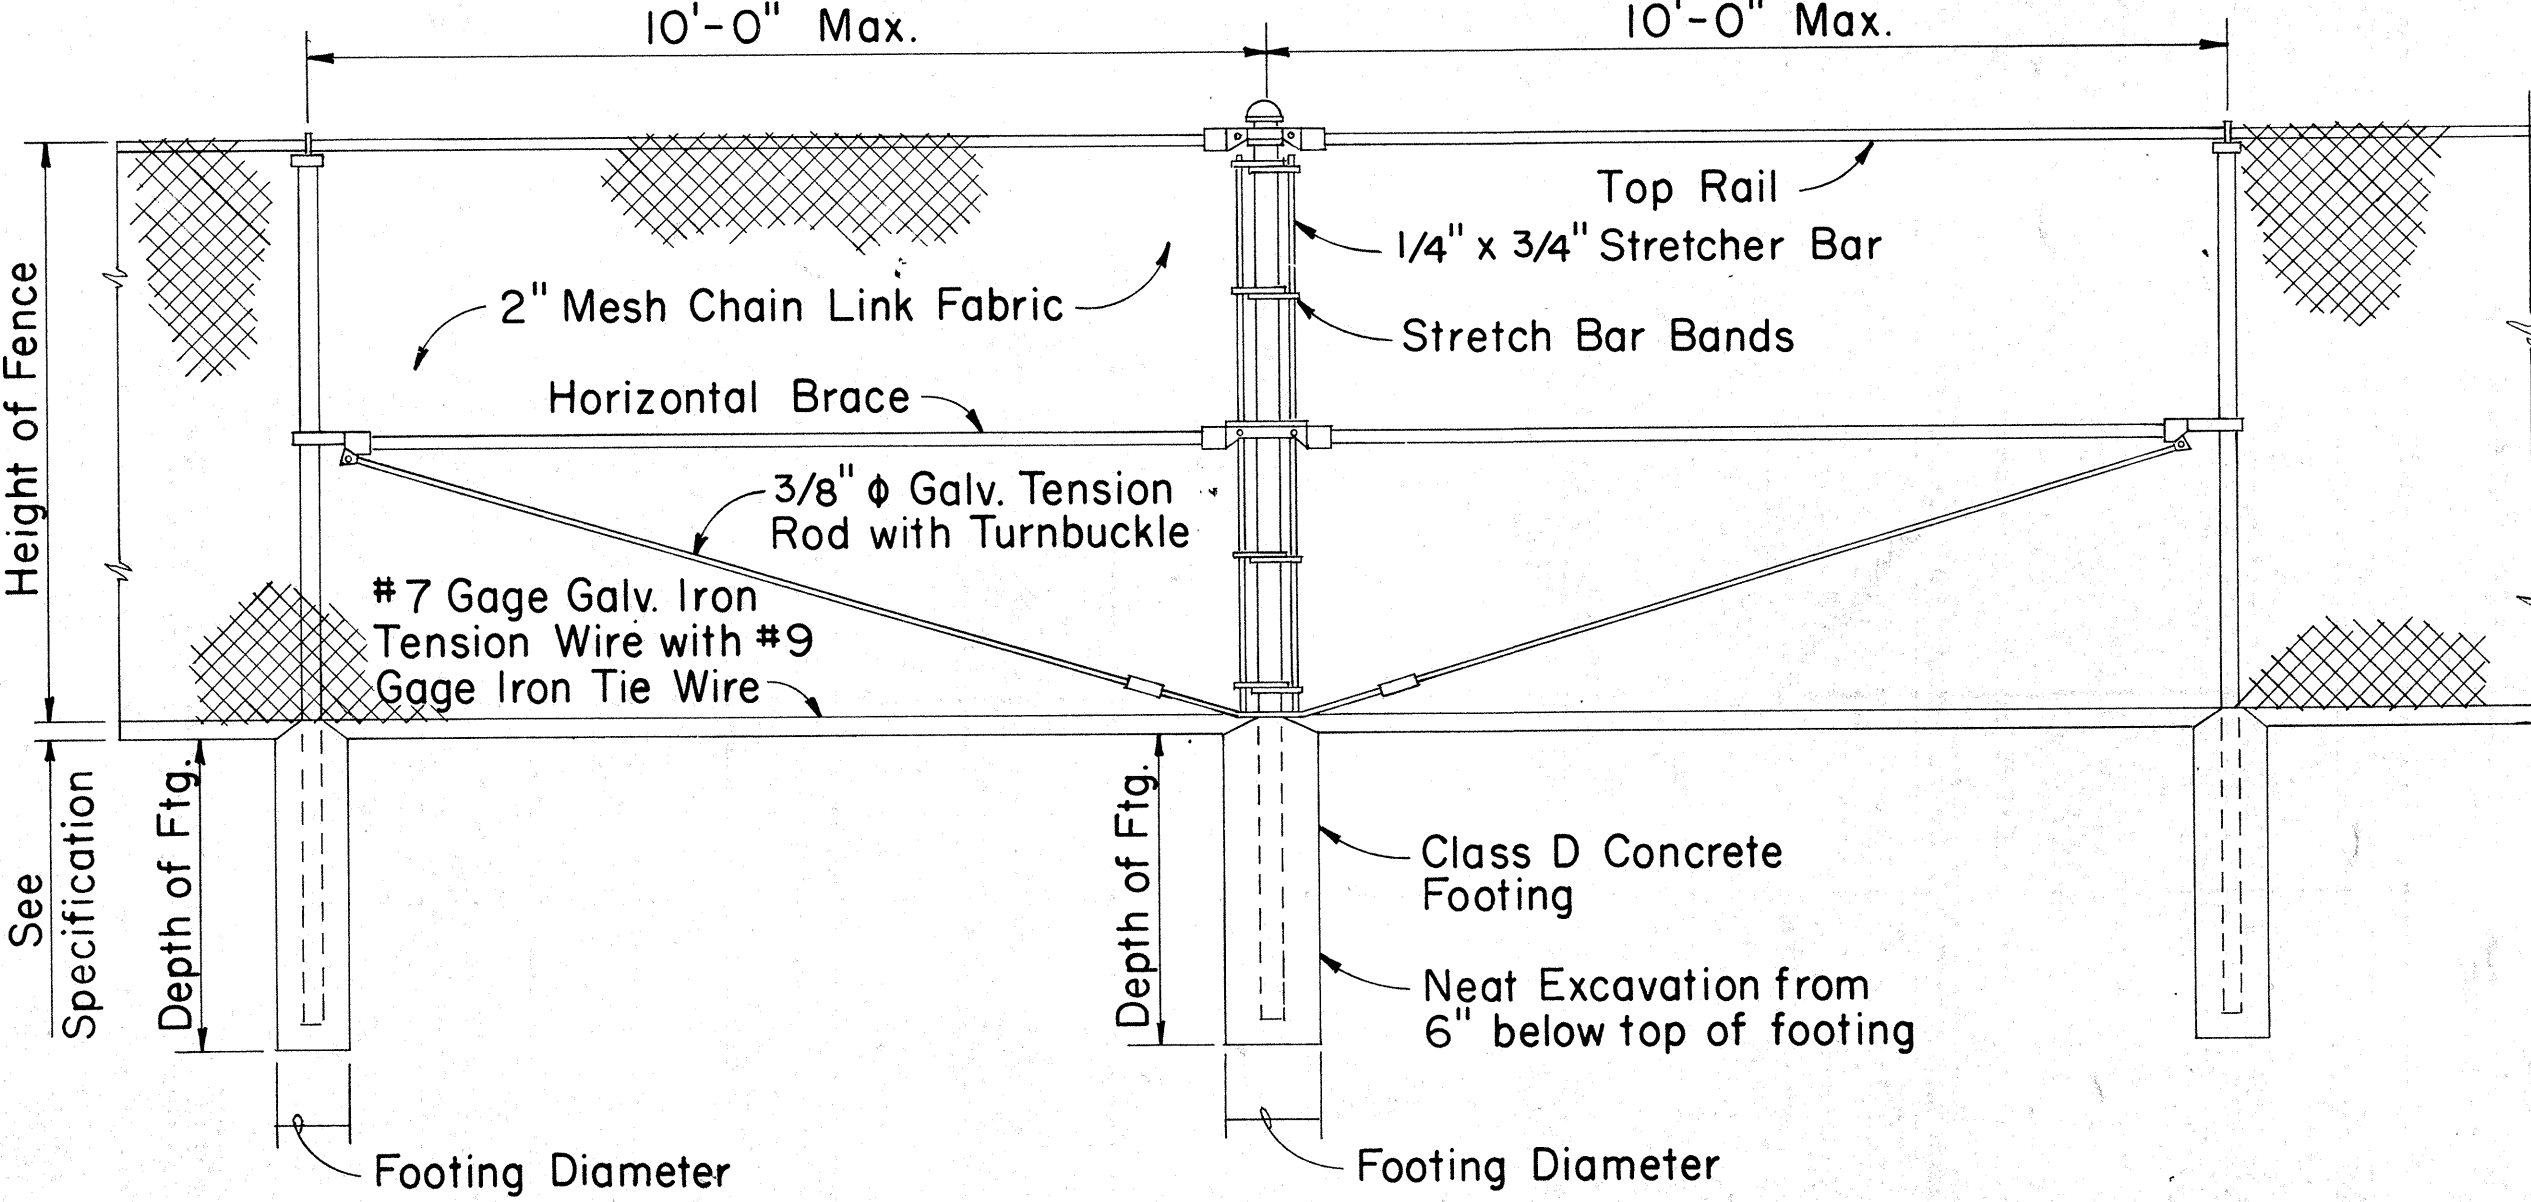


LINE POST

PULL POST

LINE POST


TYPICAL SECTION
(WITH CONCRETE FOOTING)

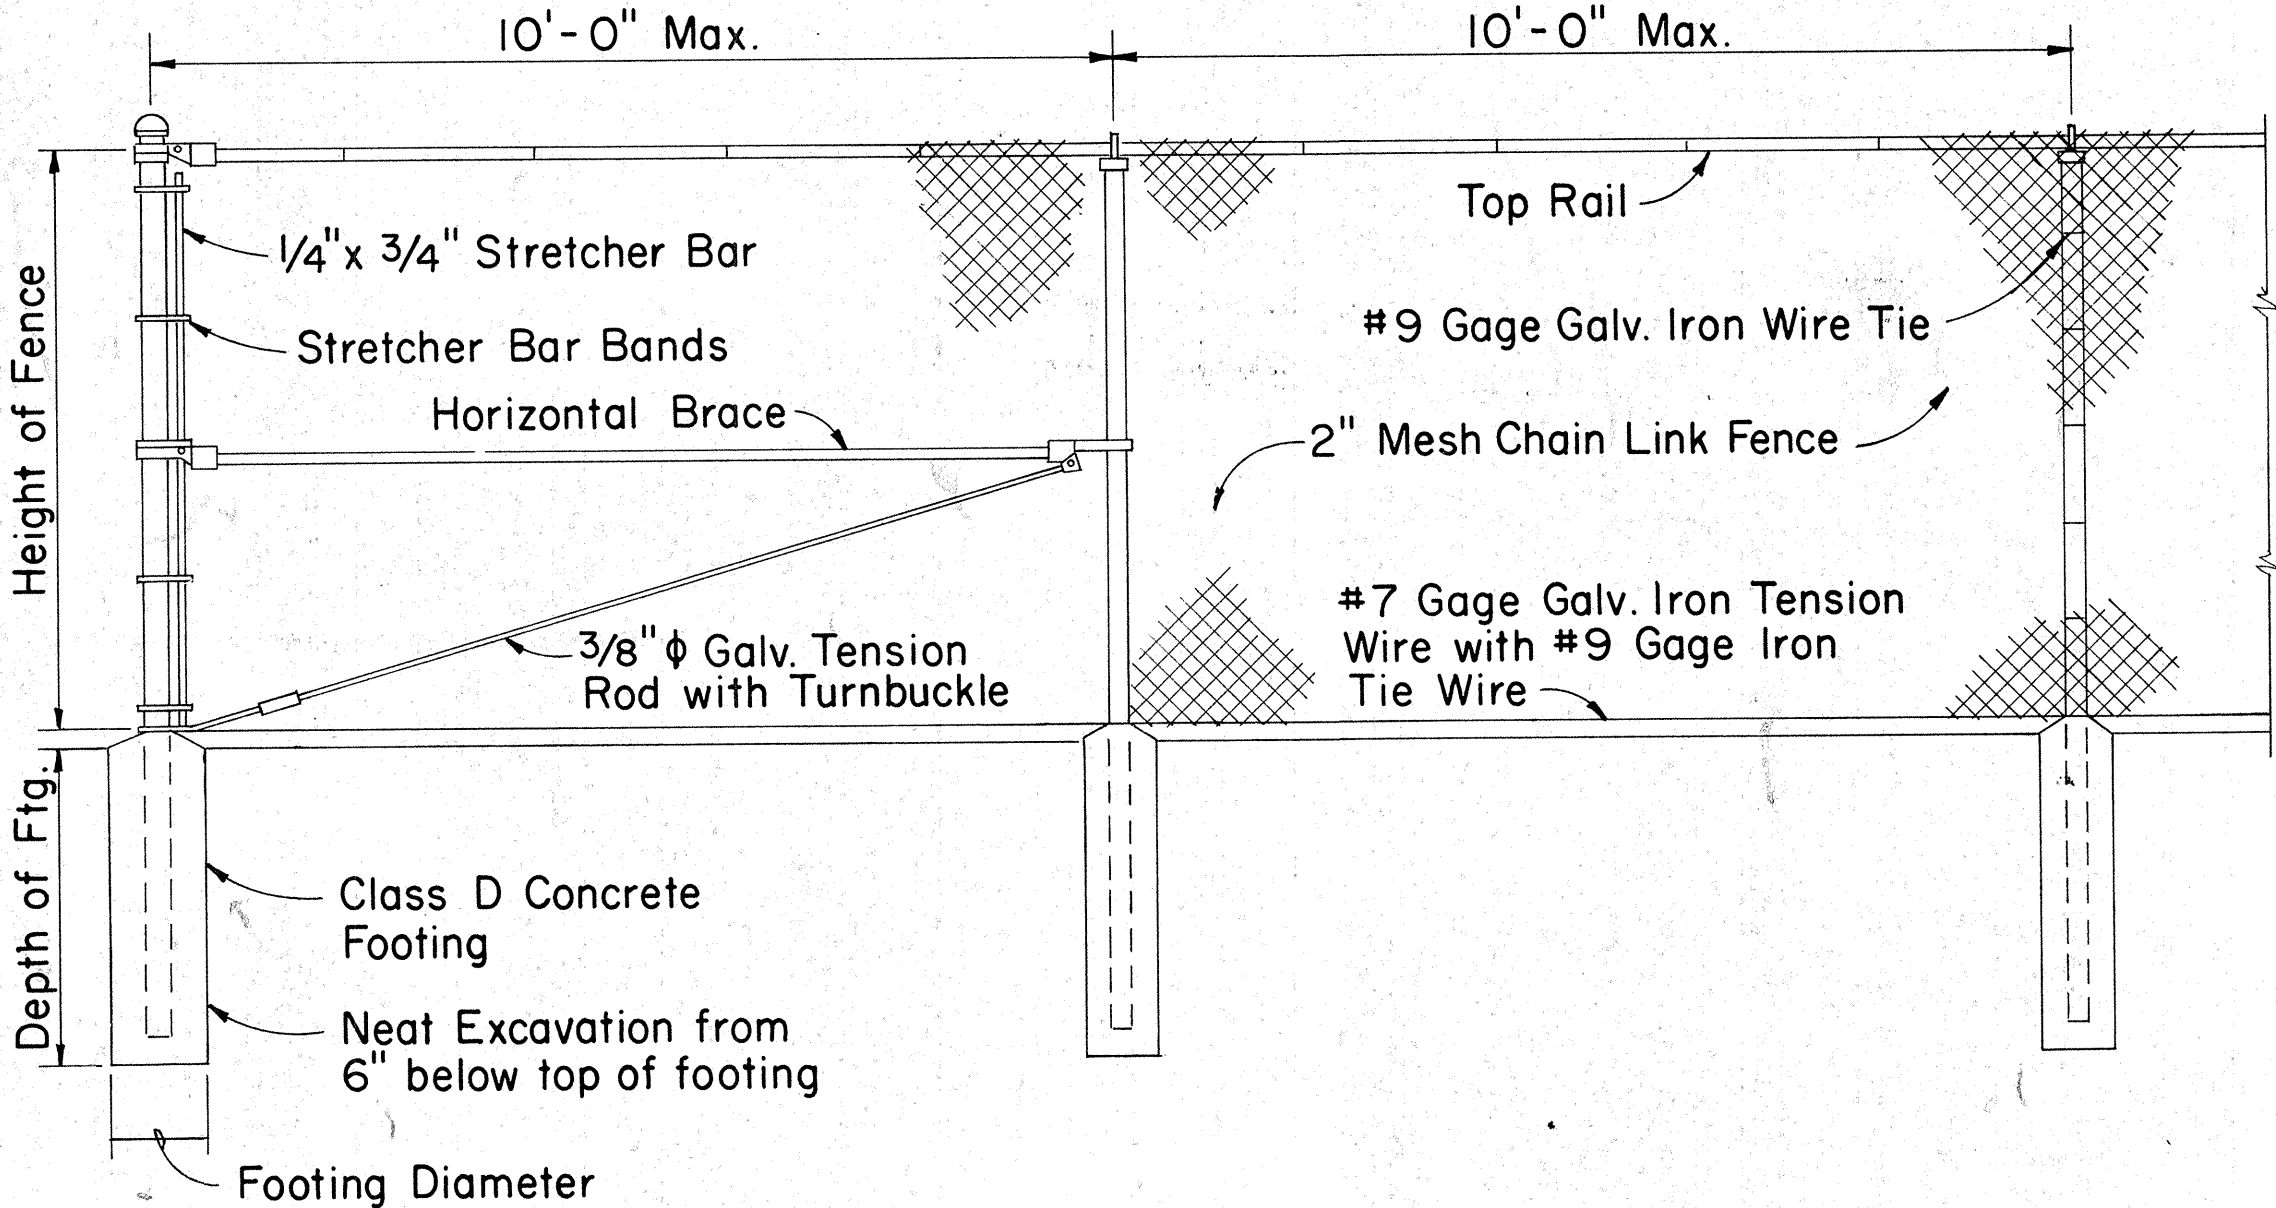

END POST

LINE POST

LINE POST

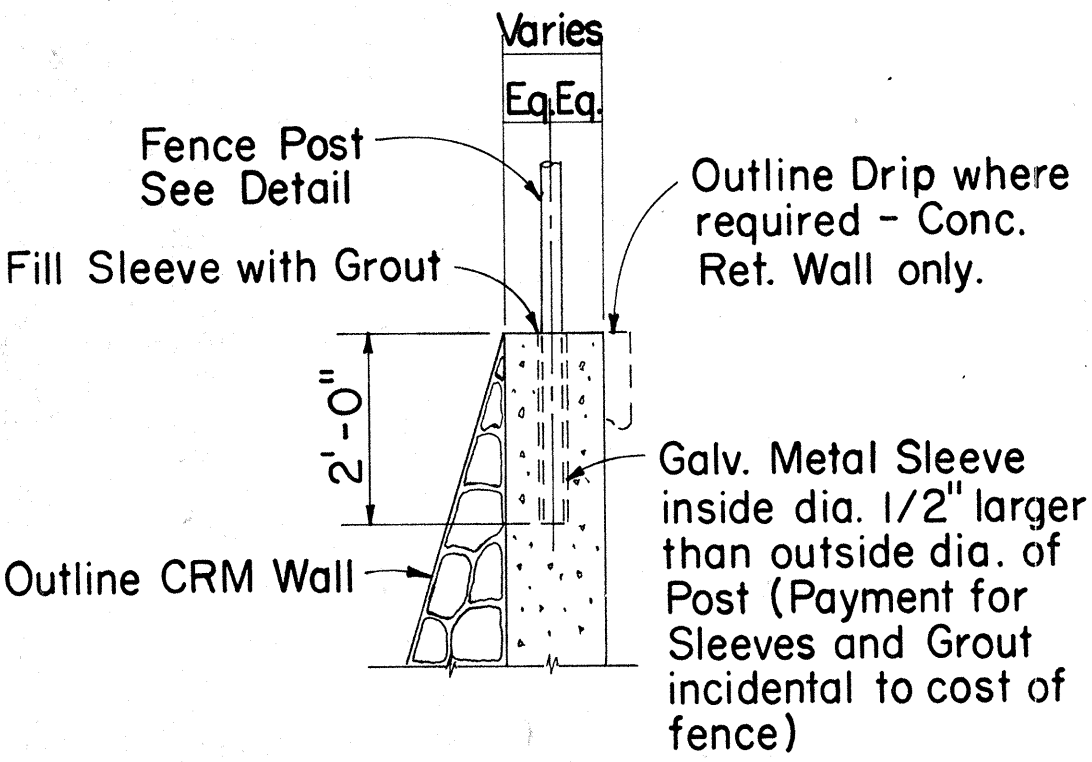

TYPICAL SECTION
(ON CRM & CONC. RET. WALL)

CHAIN LINK FENCE DETAILS

Height of Fence	Minimum Depth of Footing		Minimum Footing Diameter	
	Line Post	Corner, Pull, End and Gate Posts	Line Post	Corner, Pull and End Posts
3'	2'-0"	2'-6"	8"	8"
4'	2'-6"	2'-6"	8"	8"
5'	3'-0"	3'-0"	8"	8"
6'	3'-0"	3'-0"	8"	9"

NO	REVISION	APPROVED BY	DATE

APPROVAL RECOMMENDED:
 HIGHWAY DESIGN ENGINEER 12-4-69
 DATE

APPROVED:
 ASSISTANT CHIEF, ENGINEERING 12-10-69
 DATE



STATE OF HAWAII
 DEPARTMENT OF TRANSPORTATION
 HIGHWAYS DIVISION

STANDARD DETAILS

CHAIN LINK FENCE
 (WITH TOPRAIL)

Scale: 1/2" = 1'-0" Date:


FED. ROAD DIST. NO.	STATE	FED. AID PROJ. NO.	FISCAL YEAR	SHEET NO.	TOTAL SHEETS
HAWAII	HAW.	F-011-2(17)	1986	27	142

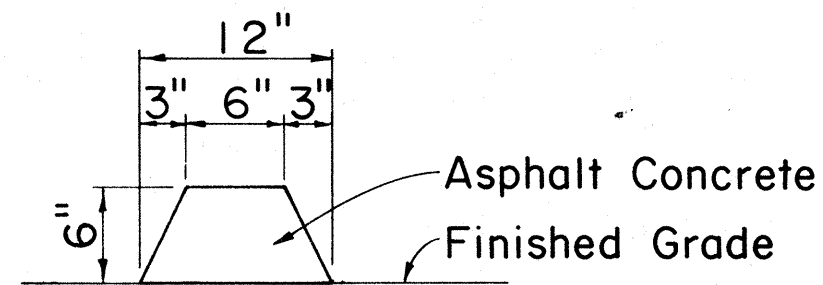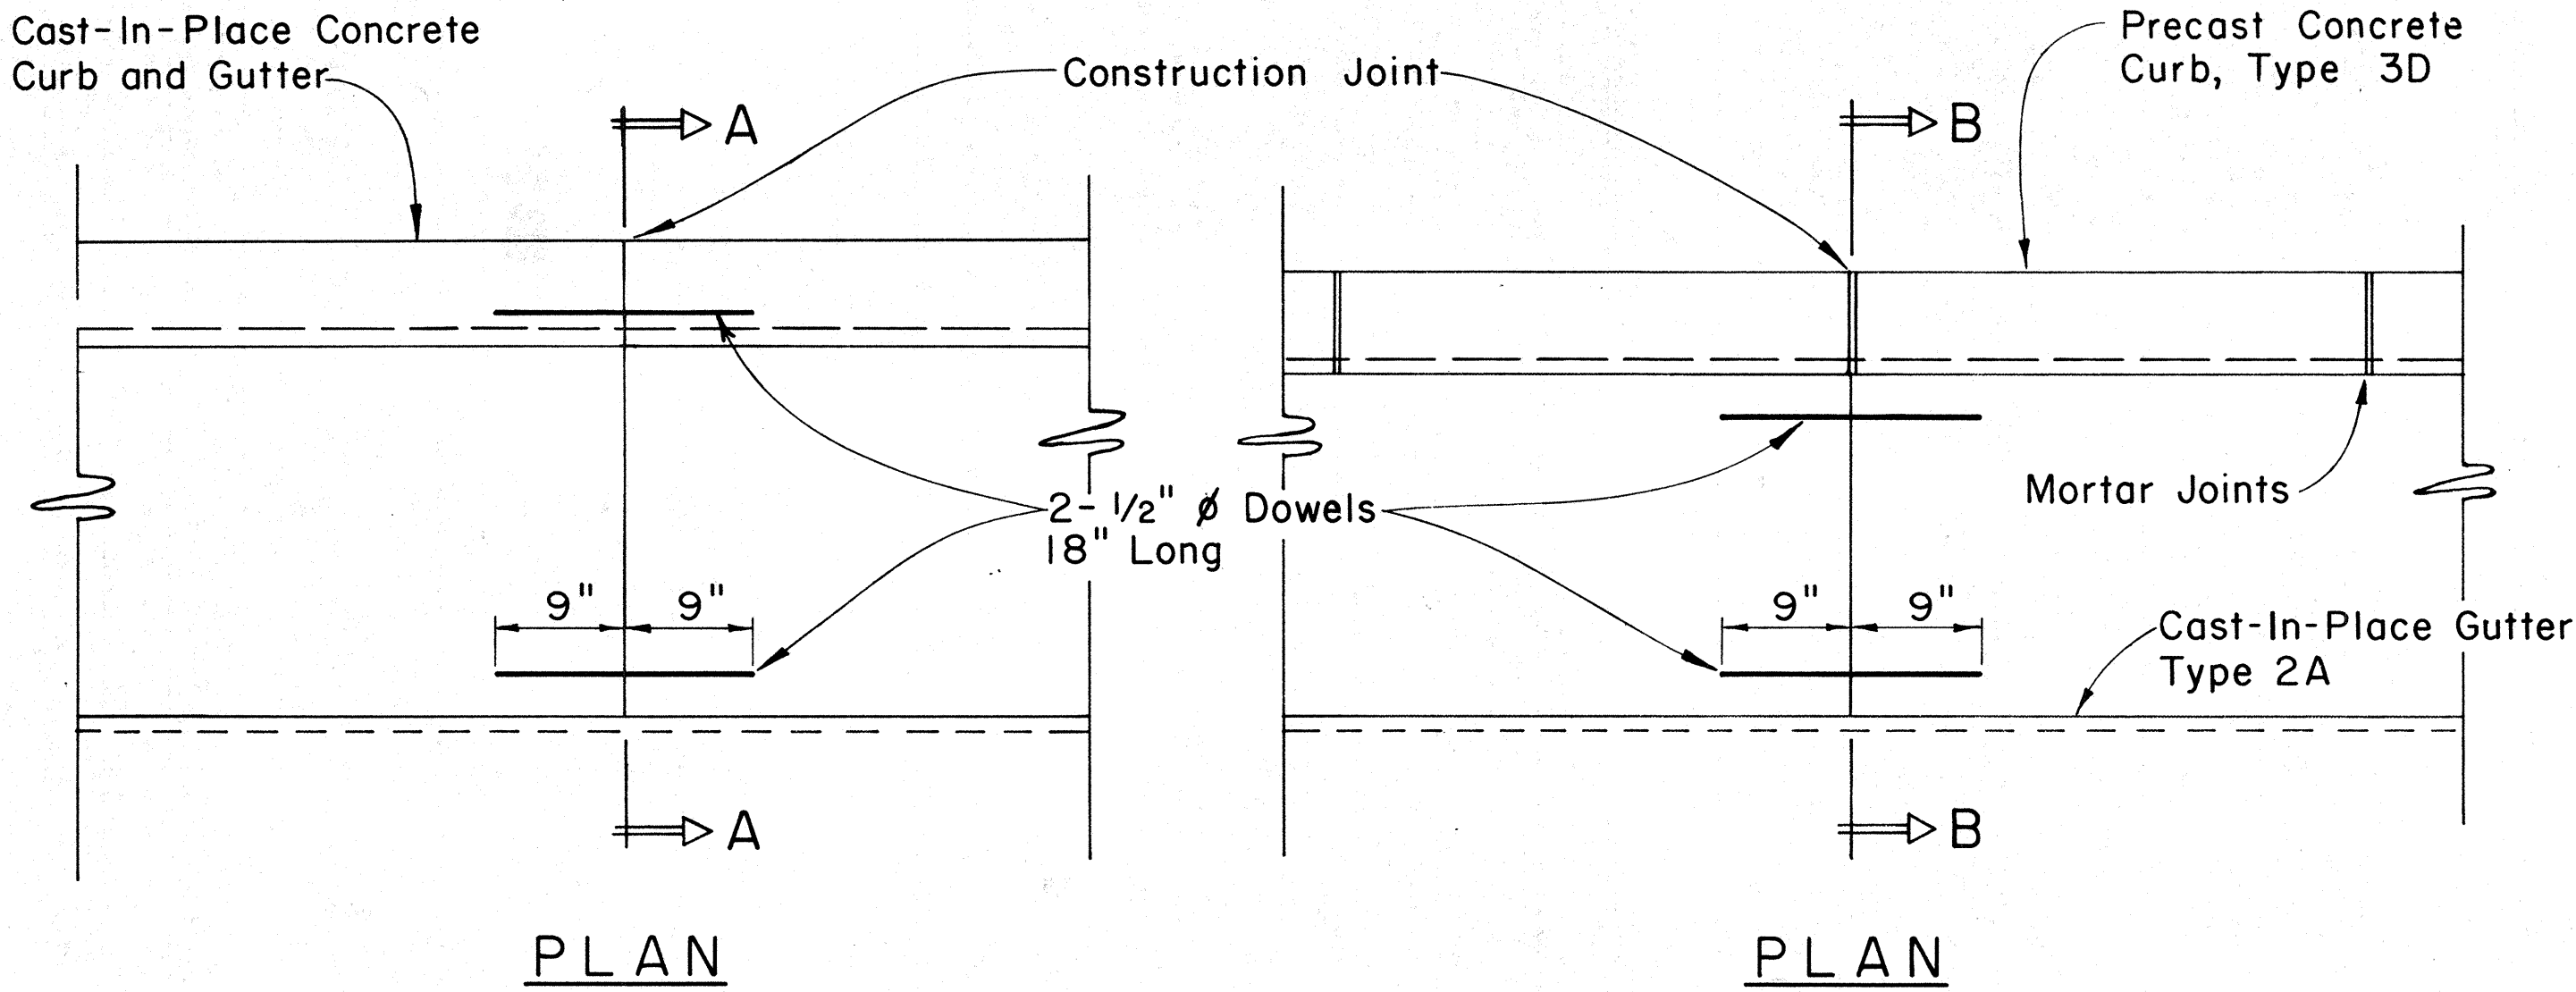


CURB, TYPE 6

BITUMINOUS CURB

Scale: 1 1/2" = 1'-0"

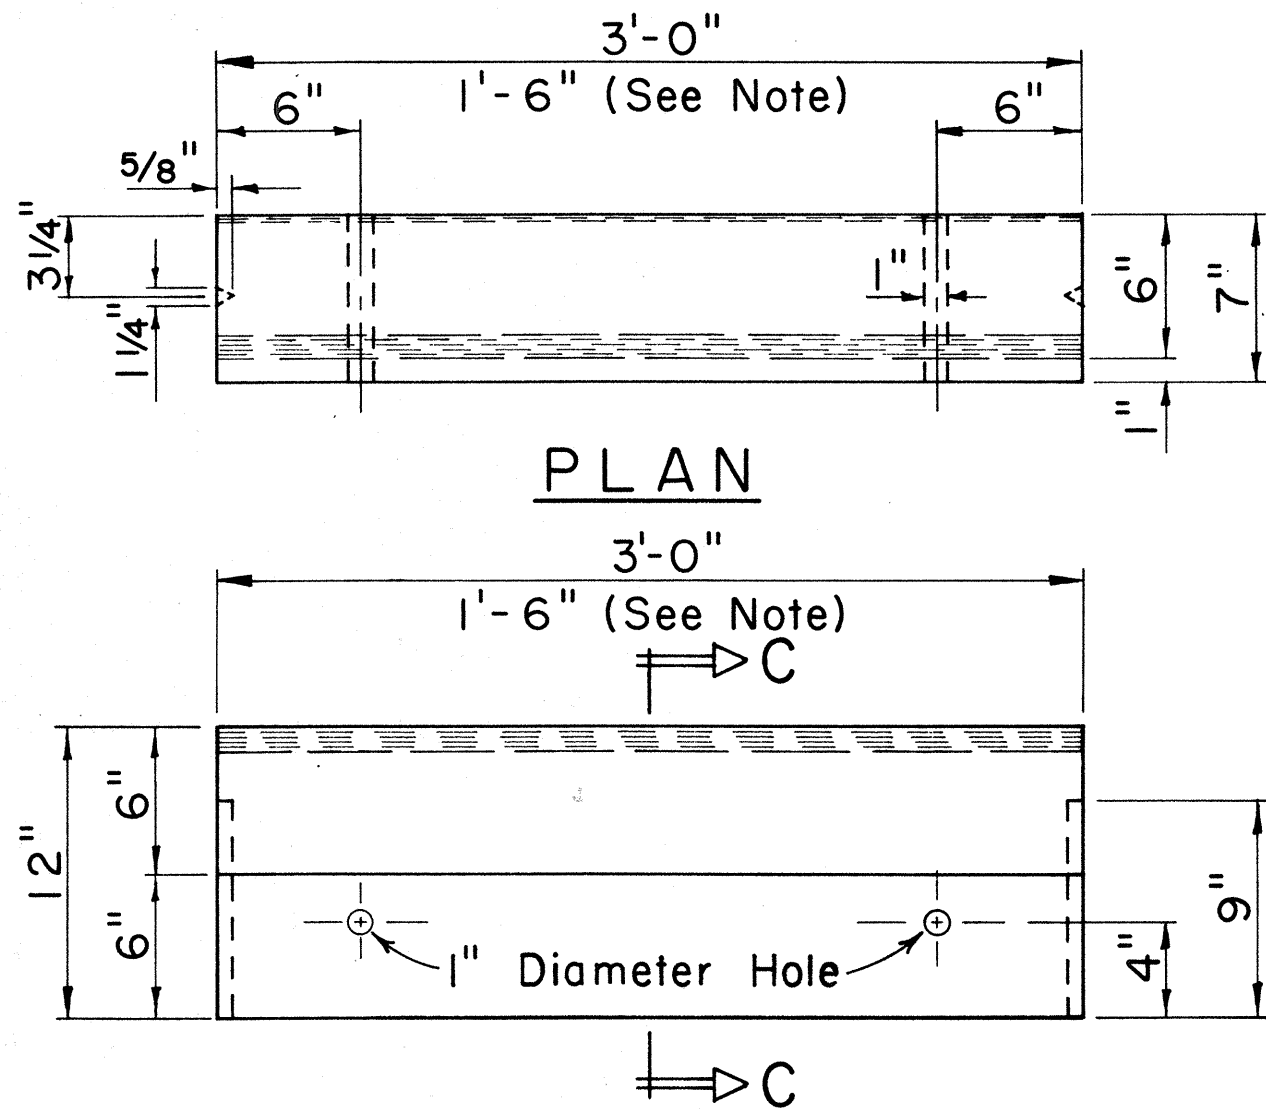

- NOTES**
1. Cast-In-Place P.C.C. Gutters shall be longitudinally broom finished.
 2. Curb, Type 2A, Curb & Gutter, Type 2AG, and Curb & Gutter, Type 2AGM are to be used only for reconstructing short segments of existing curbs and/or gutters of the same type.
 3. The top of all types of concrete curbs, including driveway curbs shall be longitudinally broom finished.

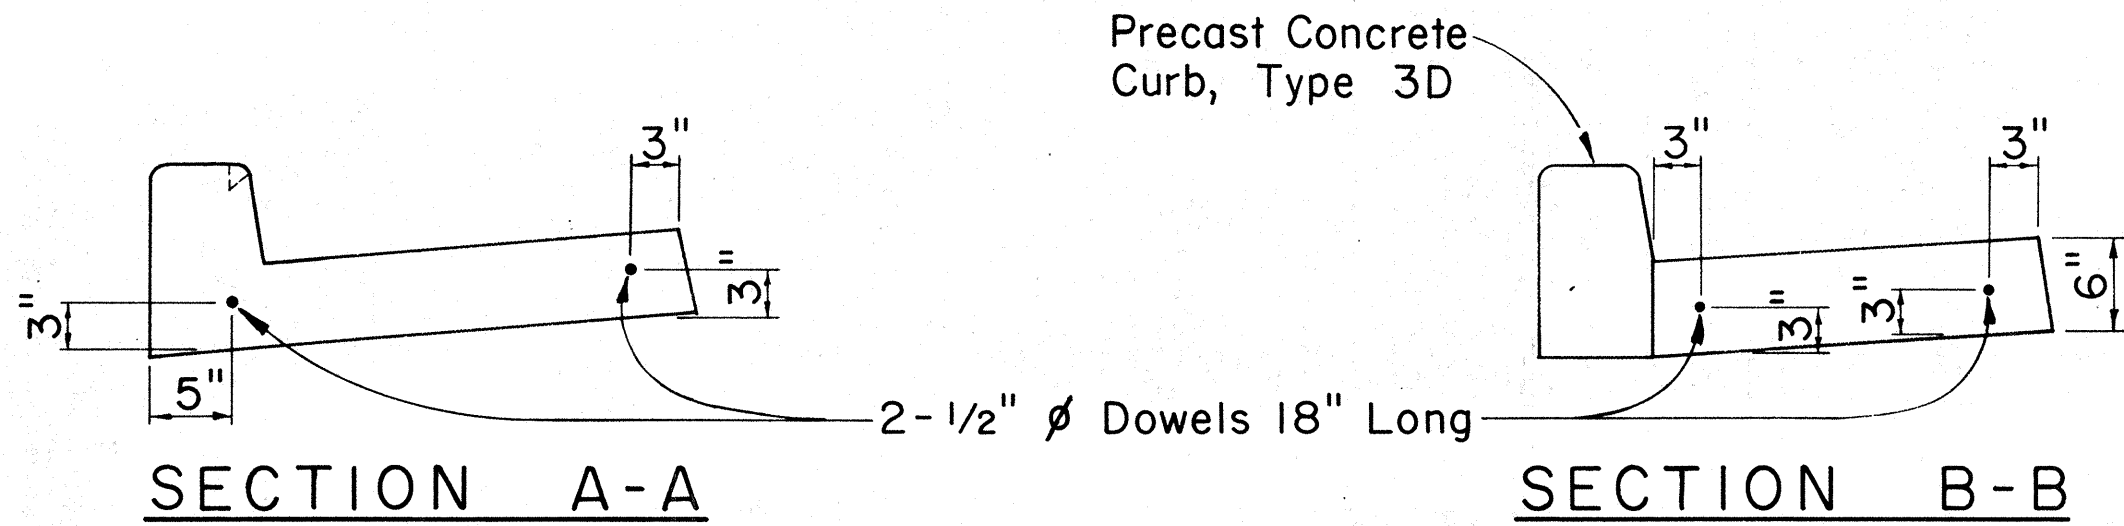


CAST-IN-PLACE CURB & GUTTER

CAST-IN-PLACE GUTTER

CONSTRUCTION JOINT DETAIL

Scale: 1" = 1'-0"

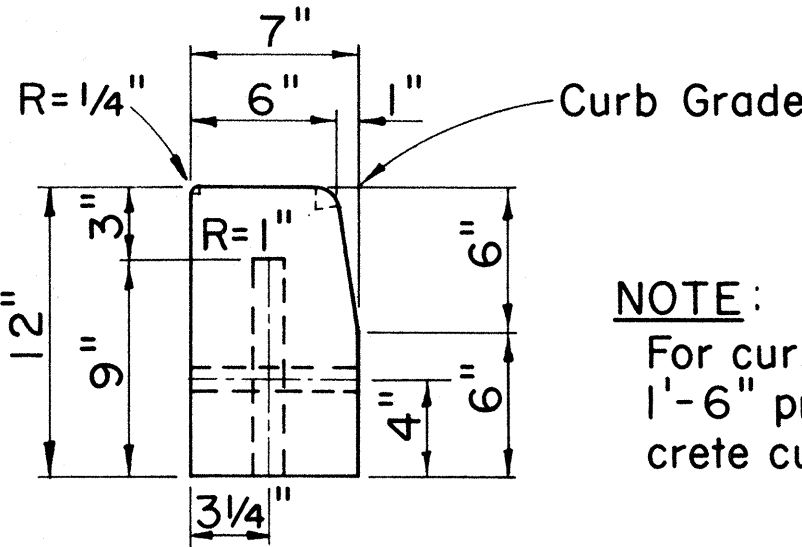


NOTE:

For curb returns use 1'-6" pre-cast concrete curbs.


CURB, TYPE 3D

PRE-CAST CONC. CURB


Scale: 1 1/2" = 1'-0"

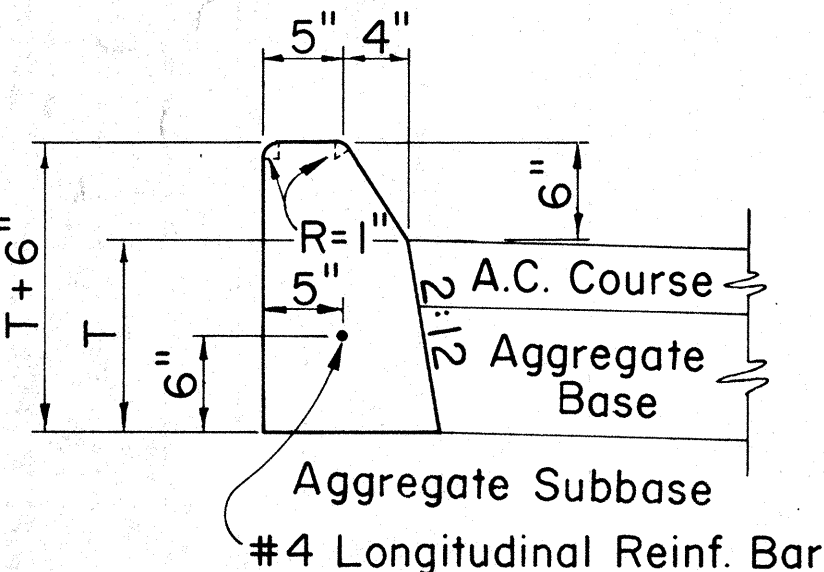


CURB, TYPE 2A

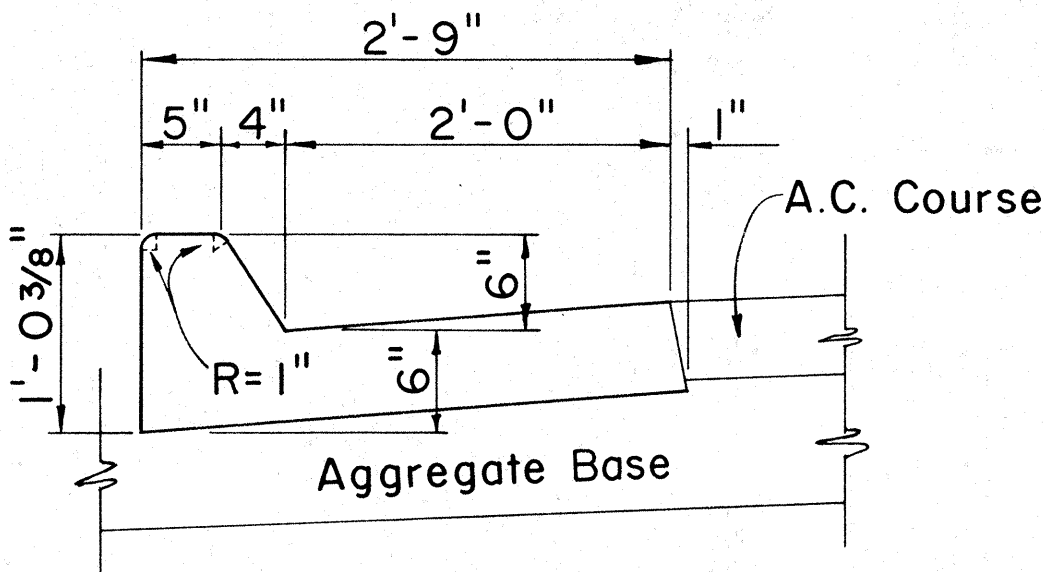


CURB & GUTTER, TYPE 2AG

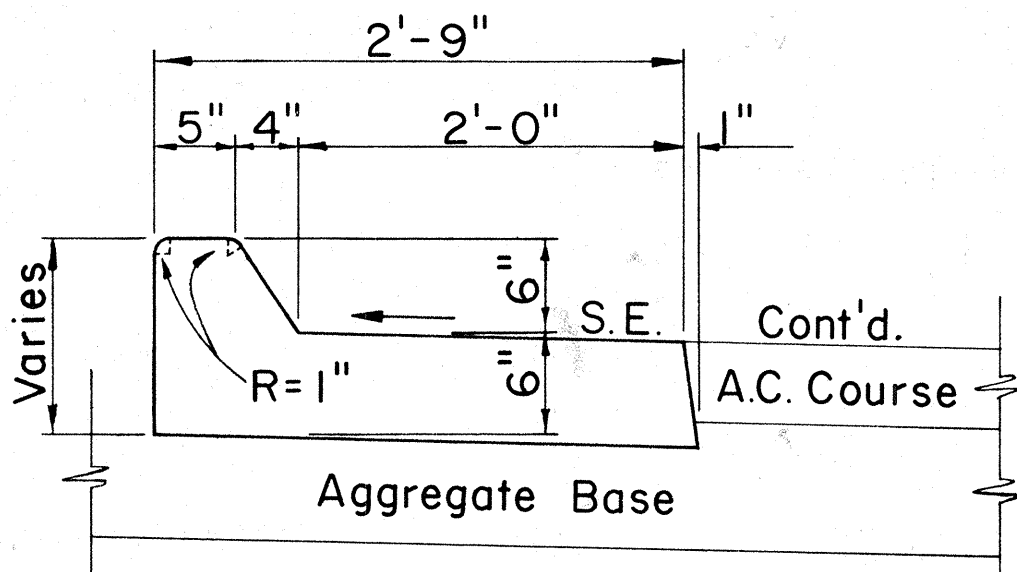


CURB & GUTTER, TYPE 2AGM

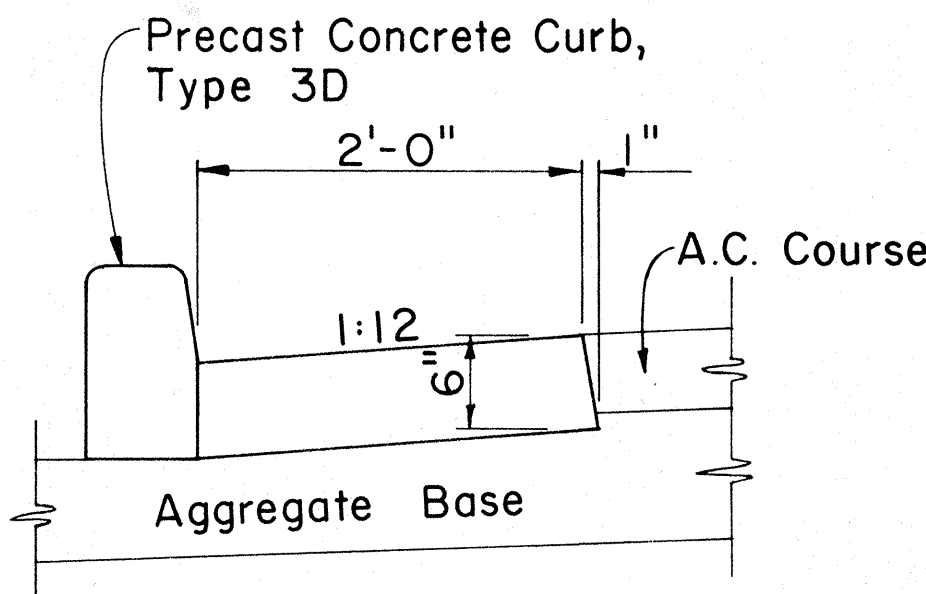

GUTTER, TYPE 2A

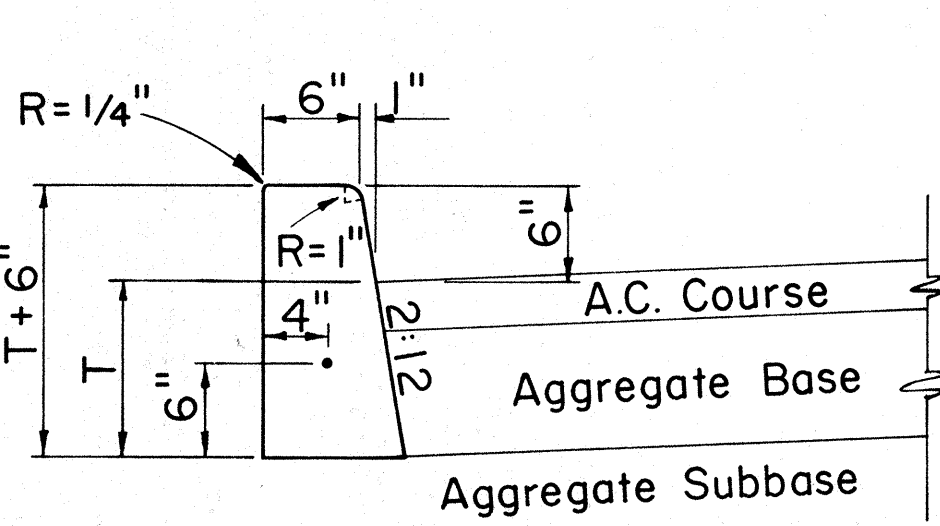

CURB, TYPE 2D

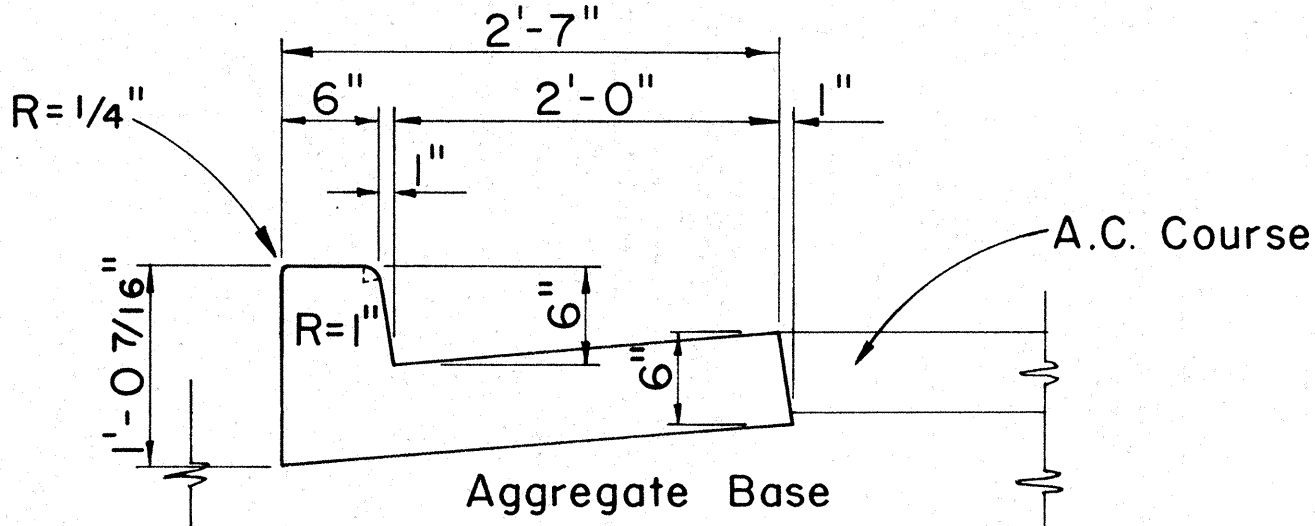

CURB & GUTTER, TYPE 2DG

CAST-IN-PLACE CONCRETE CURBS AND/OR GUTTERS

Scale: 1" = 1'-0"

APPROVAL RECOMMENDED:

M. Hironaka 12-4-82
HIGHWAY DESIGN ENGINEER DATE

APPROVED:

John J. Zaleski 12-10-89
ASSISTANT CHIEF, ENGINEERING DATE

NO.	REVISION	APPROVED BY	DATE
1	Add Notes, Deleted Gutter, Type 2G	<i>[Signature]</i>	11-26-84

STATE OF HAWAII
DEPARTMENT OF TRANSPORTATION
HIGHWAYS DIVISION

STANDARD DETAILS


TYPICAL DETAILS OF CURB AND/OR GUTTERS

Scale: As Shown

SHEET No. OF SHEETS DD 609.1

DATE	12-4-82
SURVEY PLOTTED BY	
ORIGINAL PLAN	
DRAWN BY	
TRACED BY	
NOTED BY	
CHECKED BY	
NO.	


FED. ROAD DIST. NO.	STATE	FED. AID PROJ. NO.	FISCAL YEAR	SHEET NO.	TOTAL SHEETS
HAWAII	HAW.	F-011-2(17)	1986	28	142

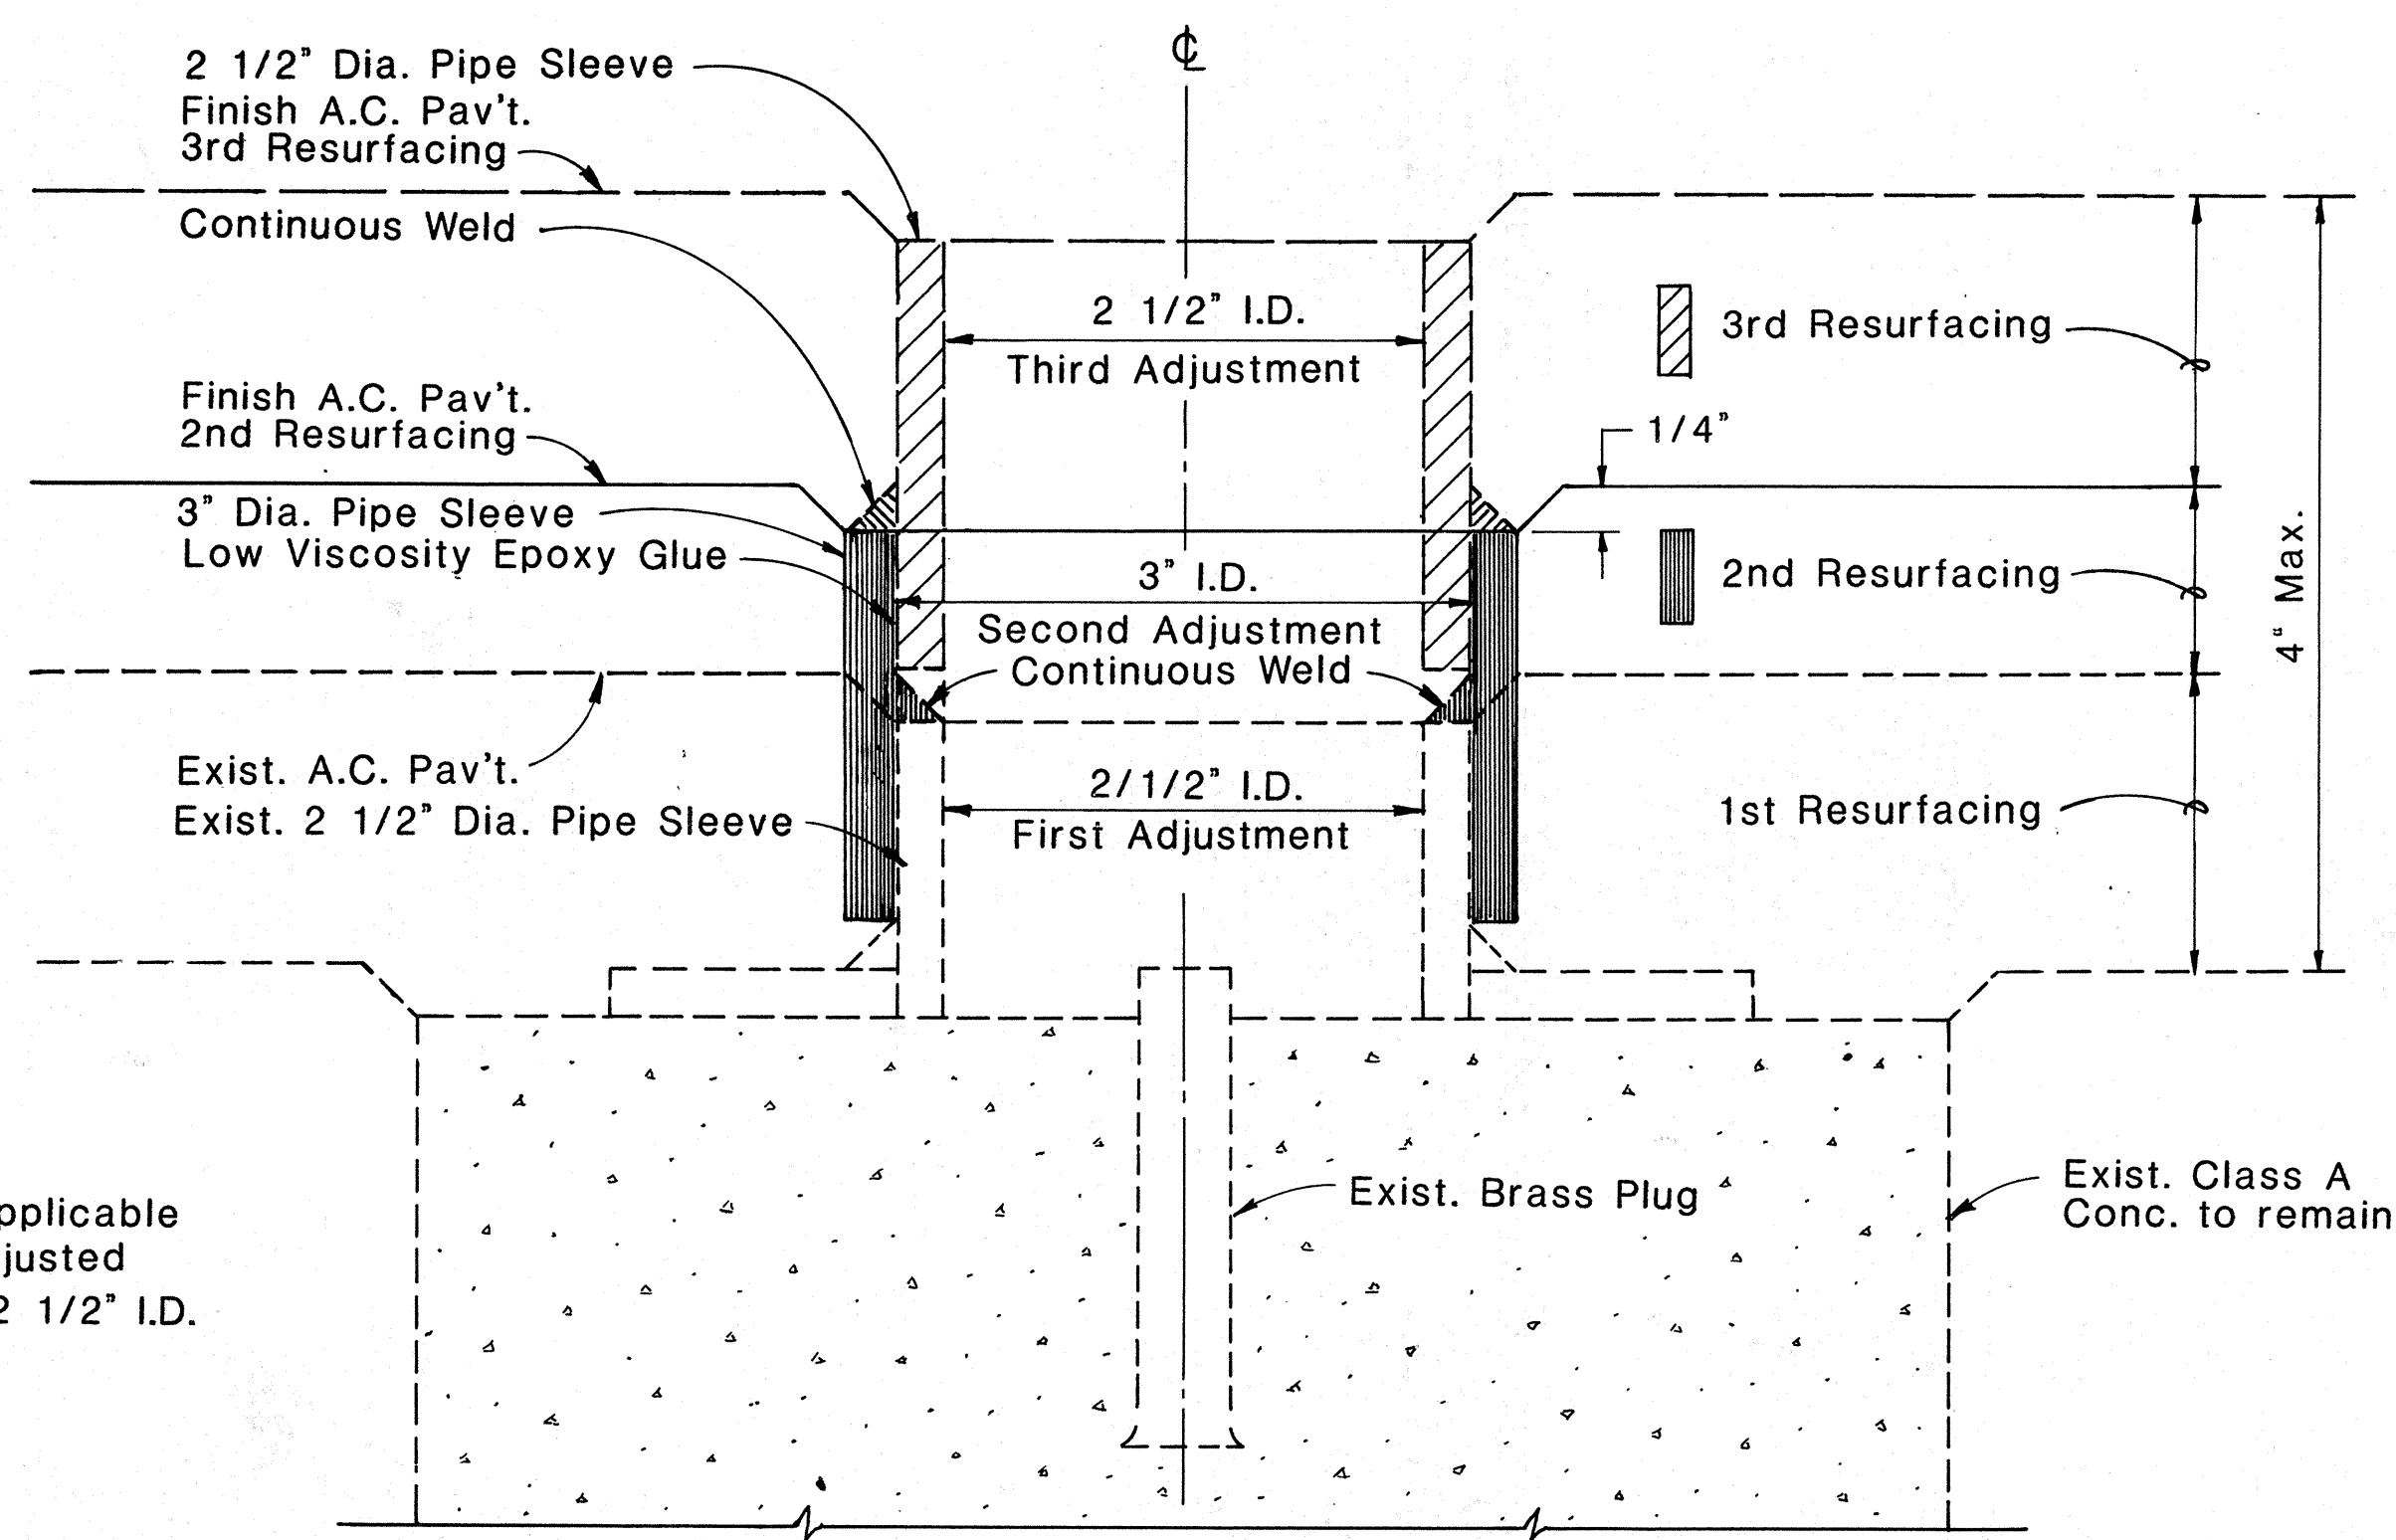

NOTE:
This detail is applicable only if initial adjusted pipe sleeve is 2 1/2" I.D.


DETAIL FOR CENTERLINE MONUMENT (2ND & 3RD) ADJUSTMENTS

FULL SIZE

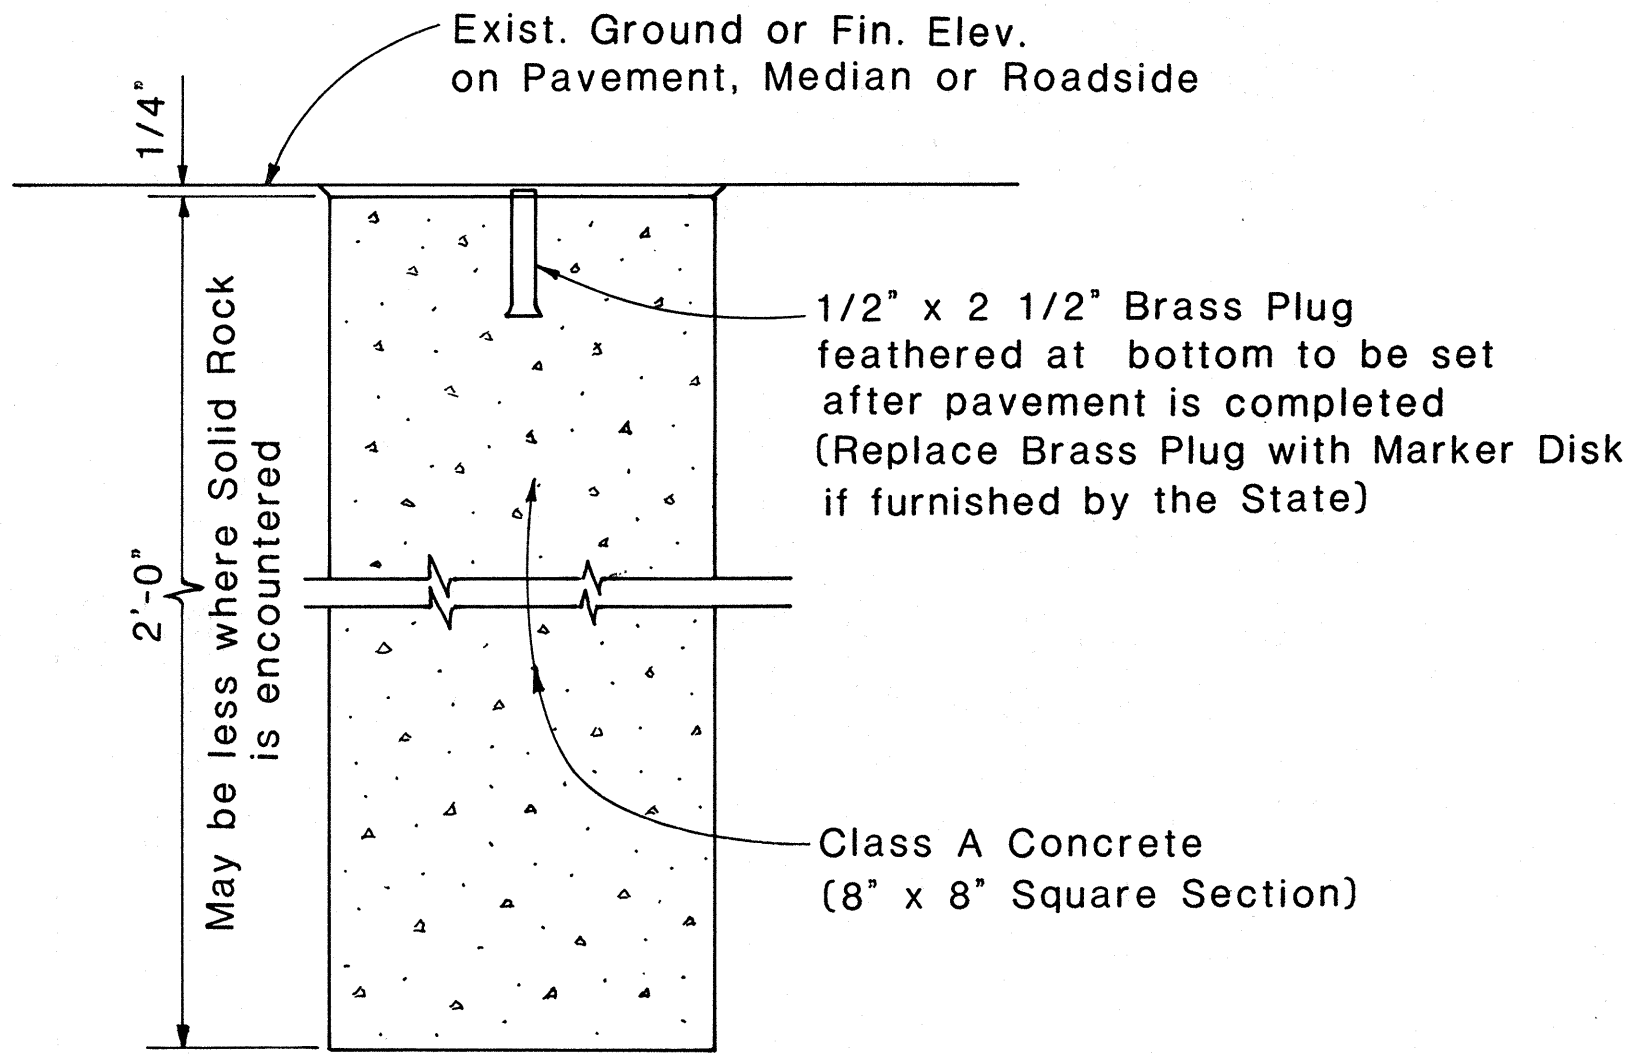


DETAIL FOR CENTERLINE & REFERENCE SURVEY MONUMENT

Scale: 1 1/2" = 1'-0"

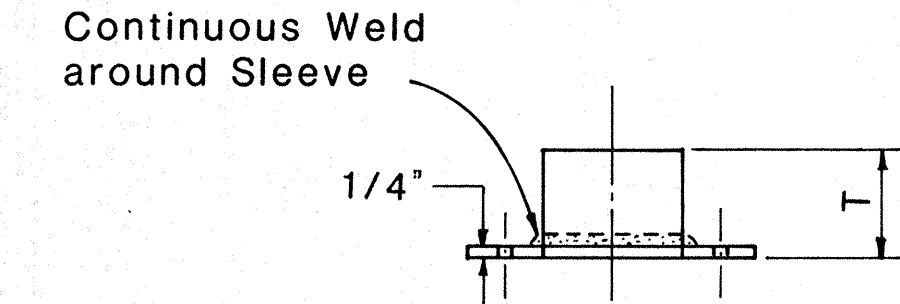


T = New Resurfacing Thickness

PIPE SLEEVE & PLATE ELEVATION

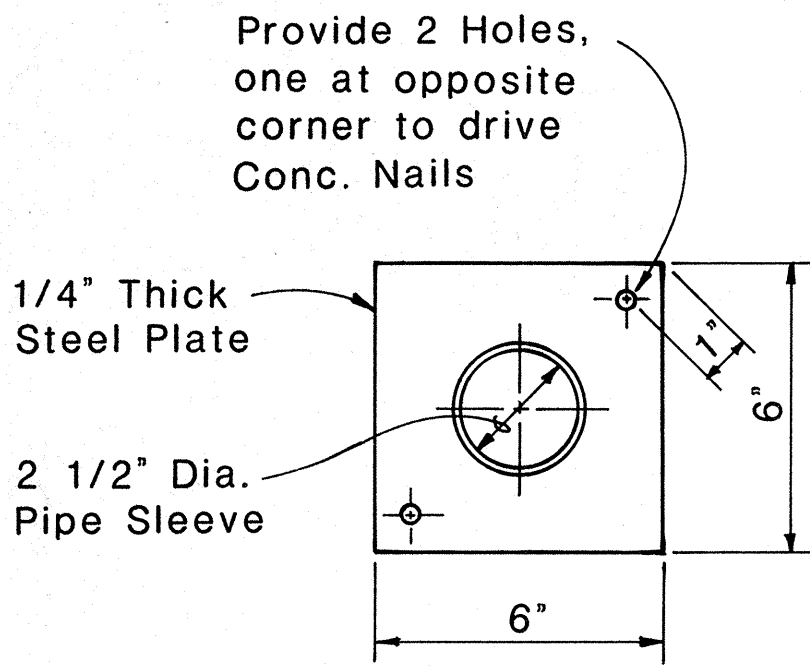

PIPE SLEEVE & PLATE PLAN

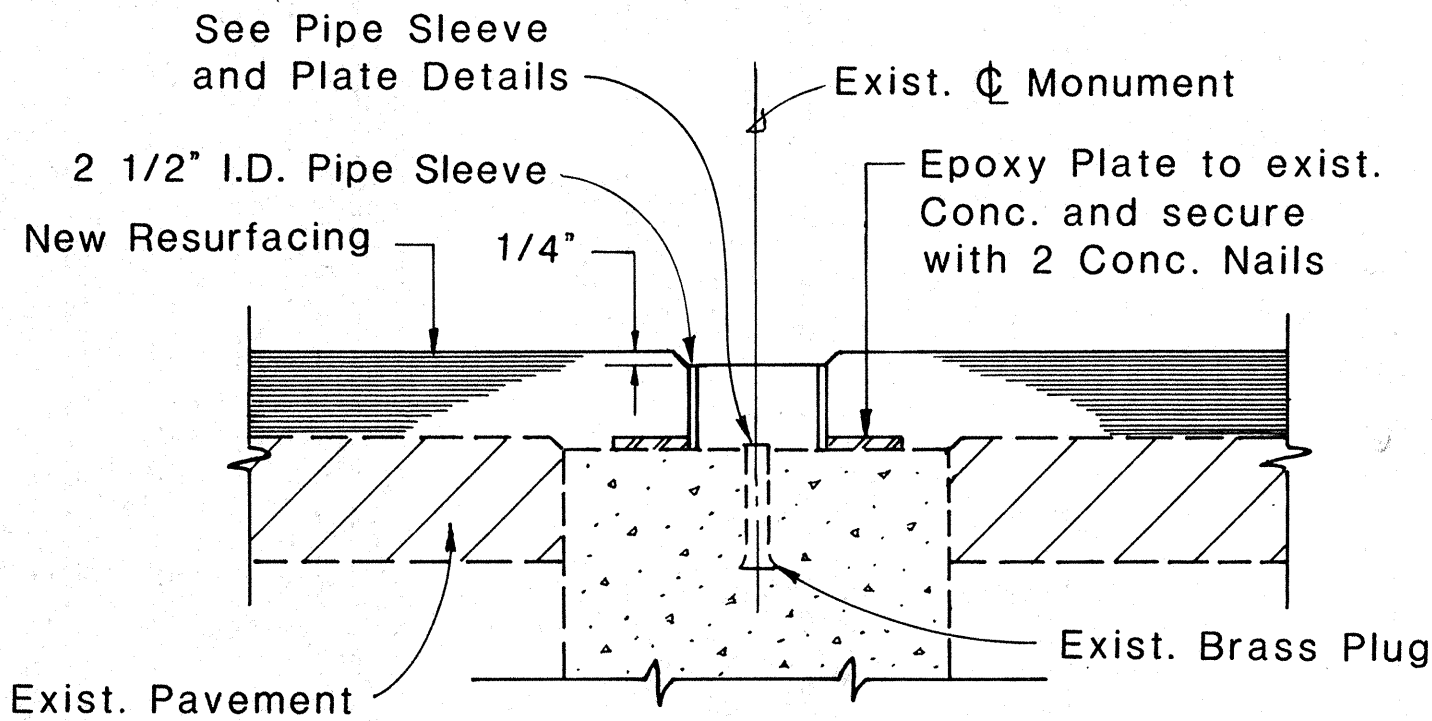

SECTION THRU MONUMENT

NOTE

These Adjustment Details also apply to Centerline Monuments utilized as Stationline Reference Points.

DETAILS FOR ADJUSTED CENTERLINE MONUMENT

Scale: 3" = 1'-0"

APPROVAL RECOMMENDED:

Mike Minna 6-20-83
HIGHWAY DESIGN ENGINEER DATE











APPROVED:
S. Fujiyama 6-22-83
ASSISTANT CHIEF, ENGINEERING DATE

NO.	REVISION	APPROVED	
		BY	DATE
1	Delete Note No. 1	<i>MD</i>	11-19-84

STATE OF HAWAII DEPARTMENT OF TRANSPORTATION HIGHWAYS DIVISION	
STANDARD DETAILS	
CENTERLINE AND REFERENCE SURVEY MONUMENT	
Scale: As Shown	Date: May, 1983

SHEET No. OF SHEETS DD613.1

FED. ROAD DIST. NO.	STATE	FED. AID PROJ. NO.	FISCAL YEAR	SHEET NO.	TOTAL SHEETS
HAWAII	HAWAII	F-011-2(17)	1986	30	142

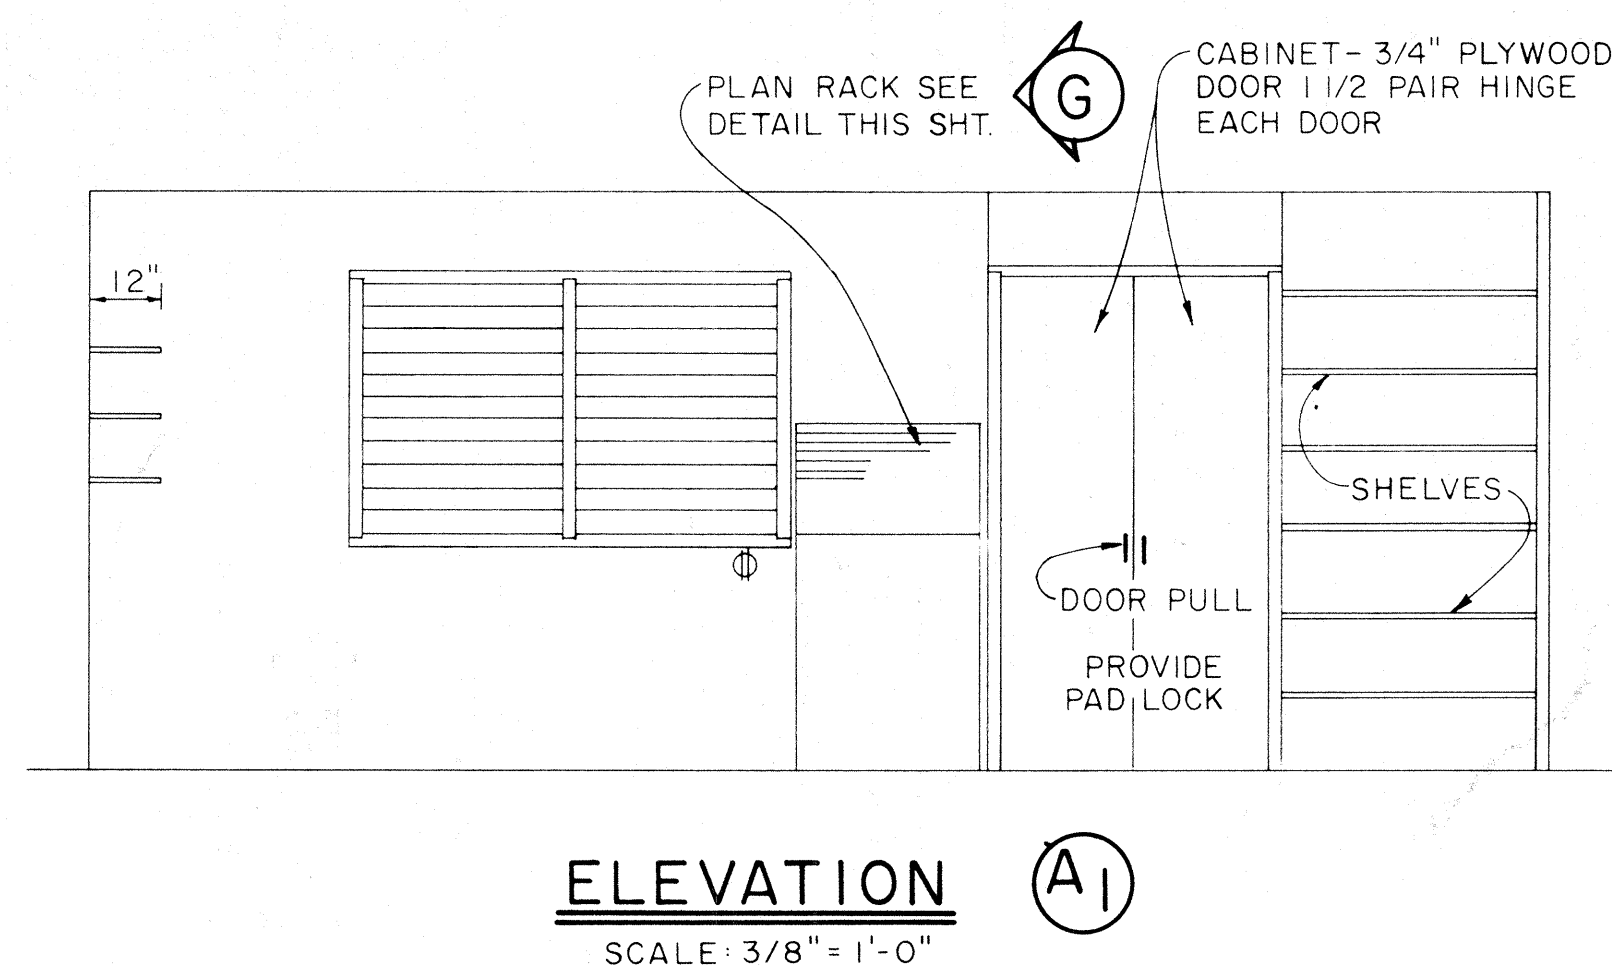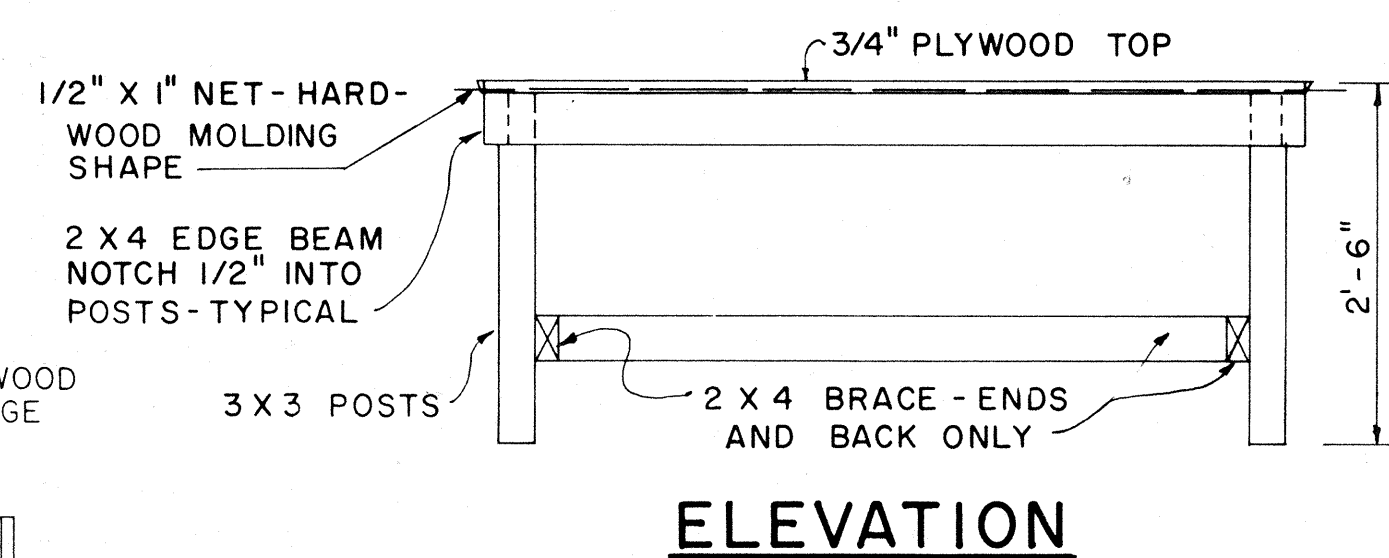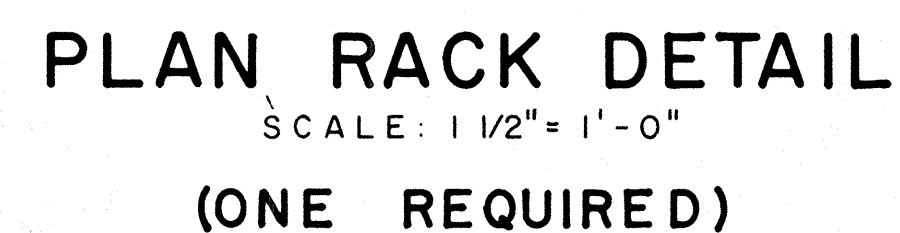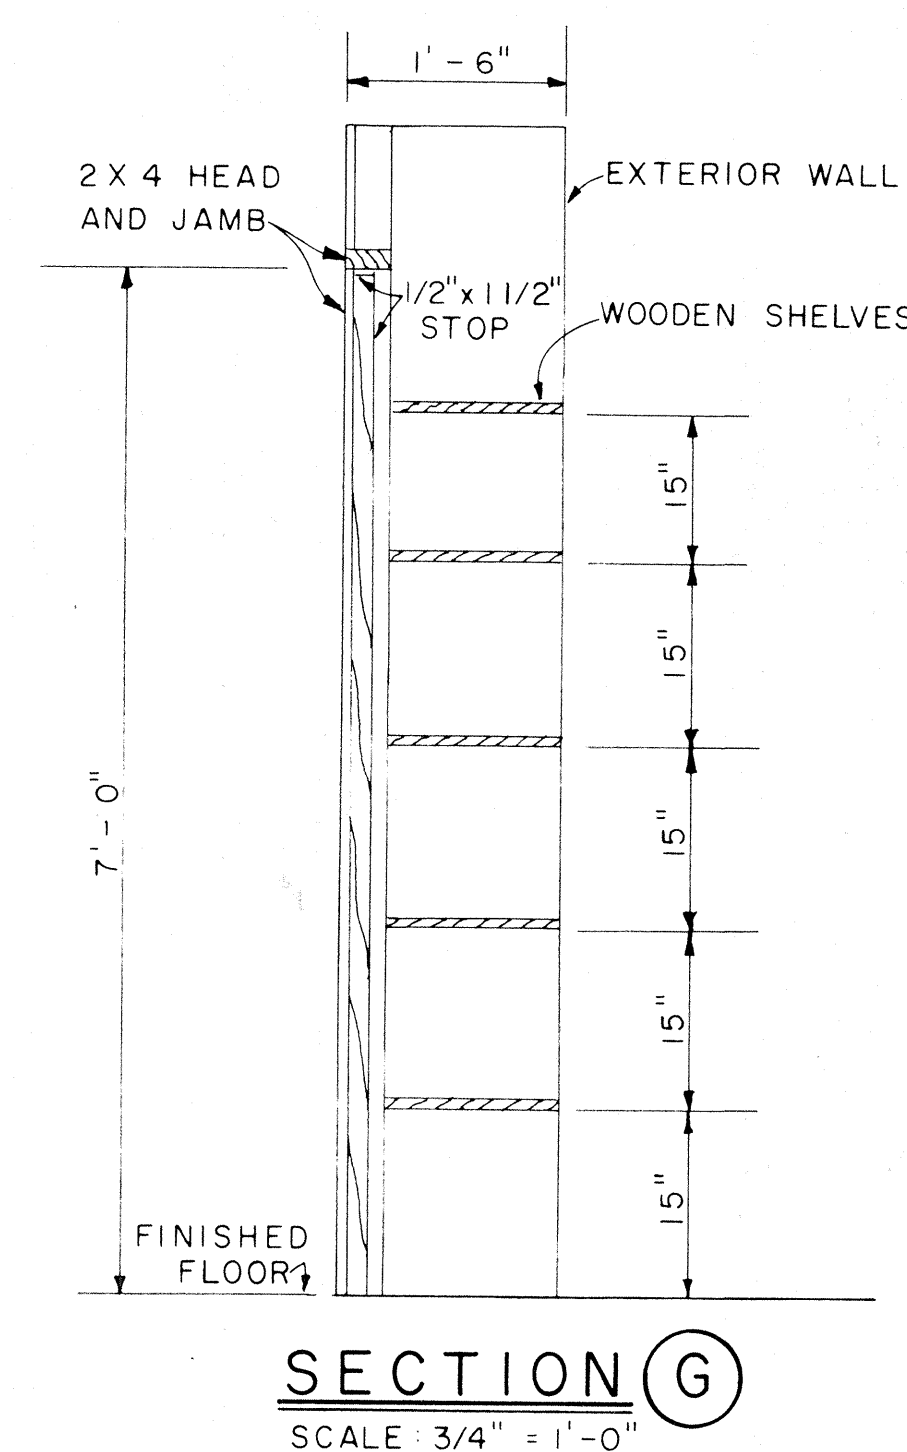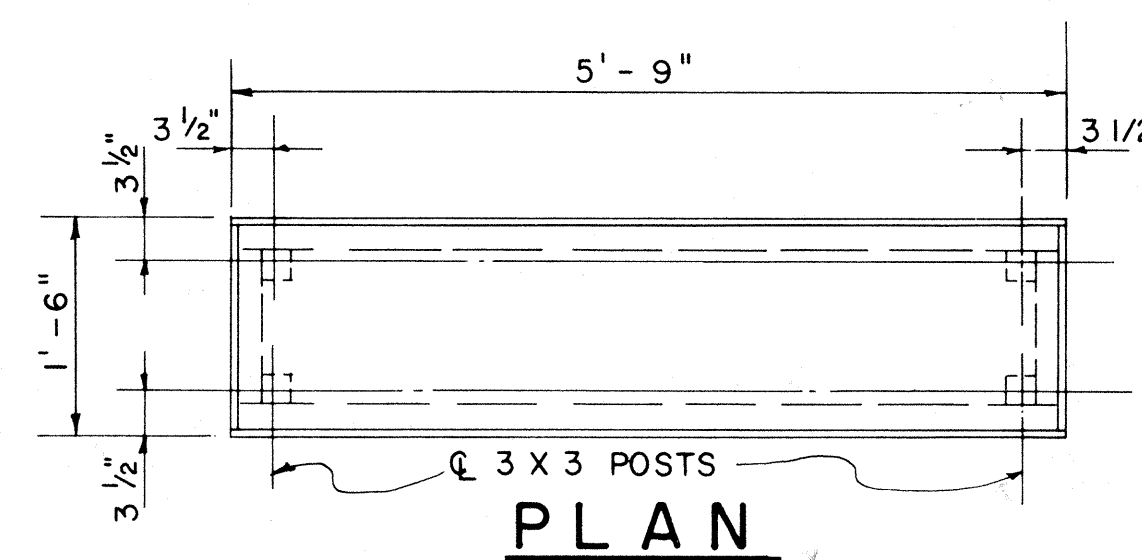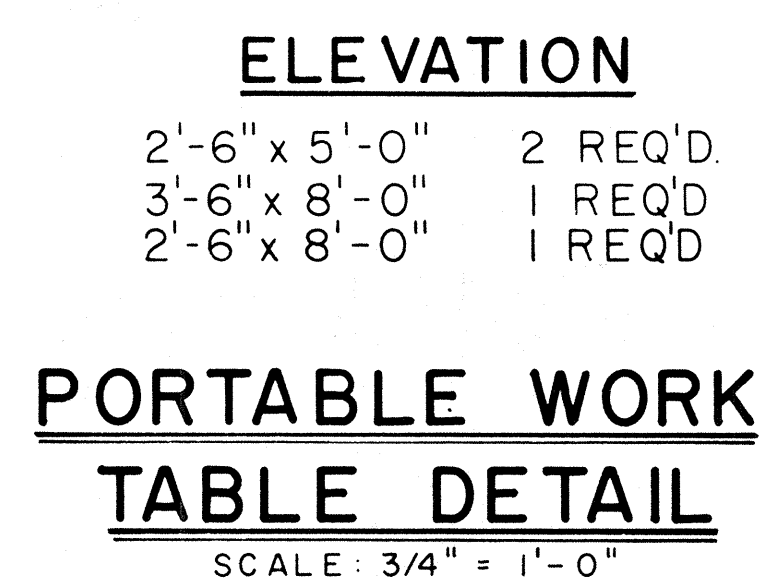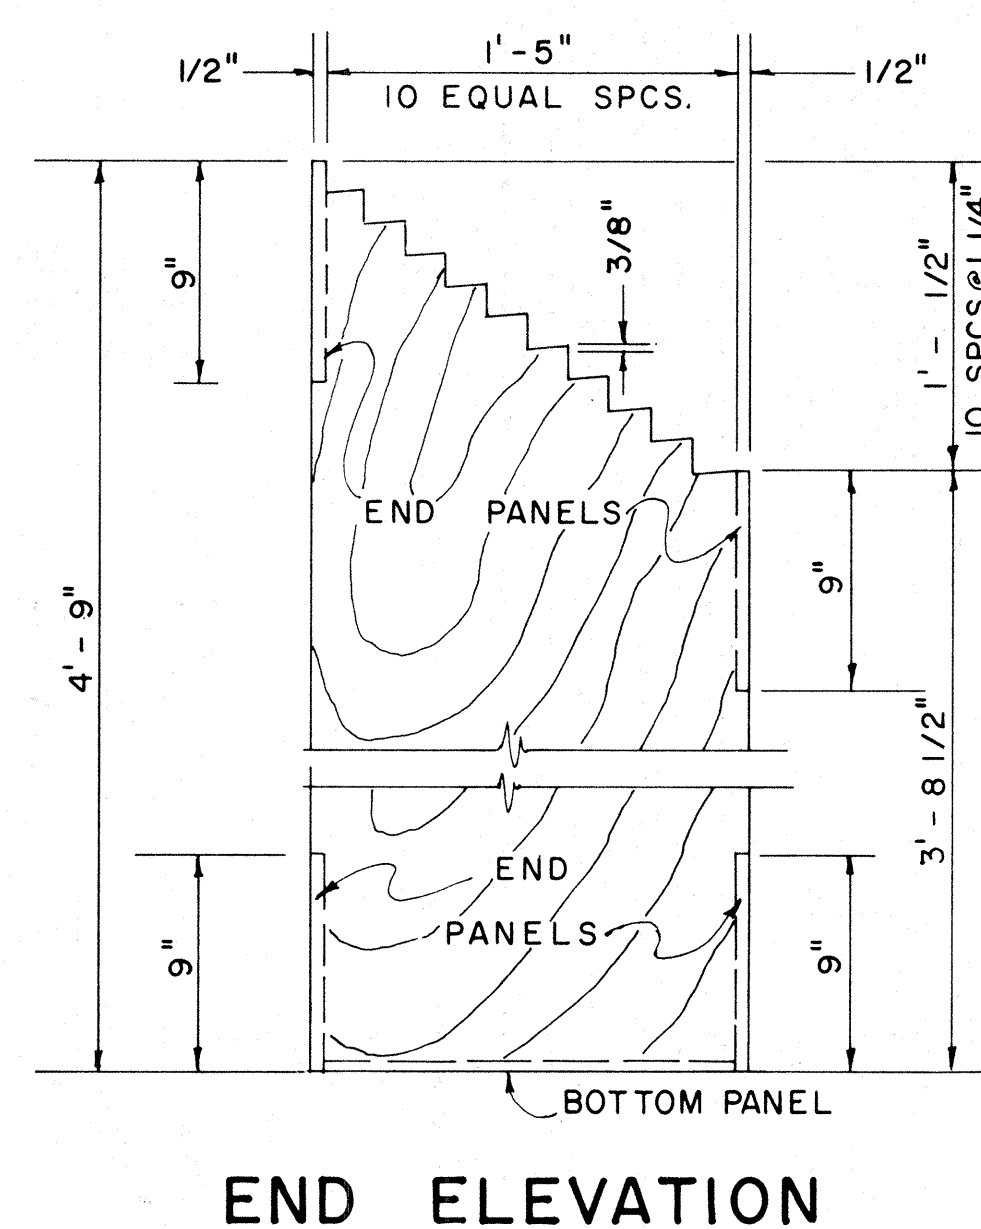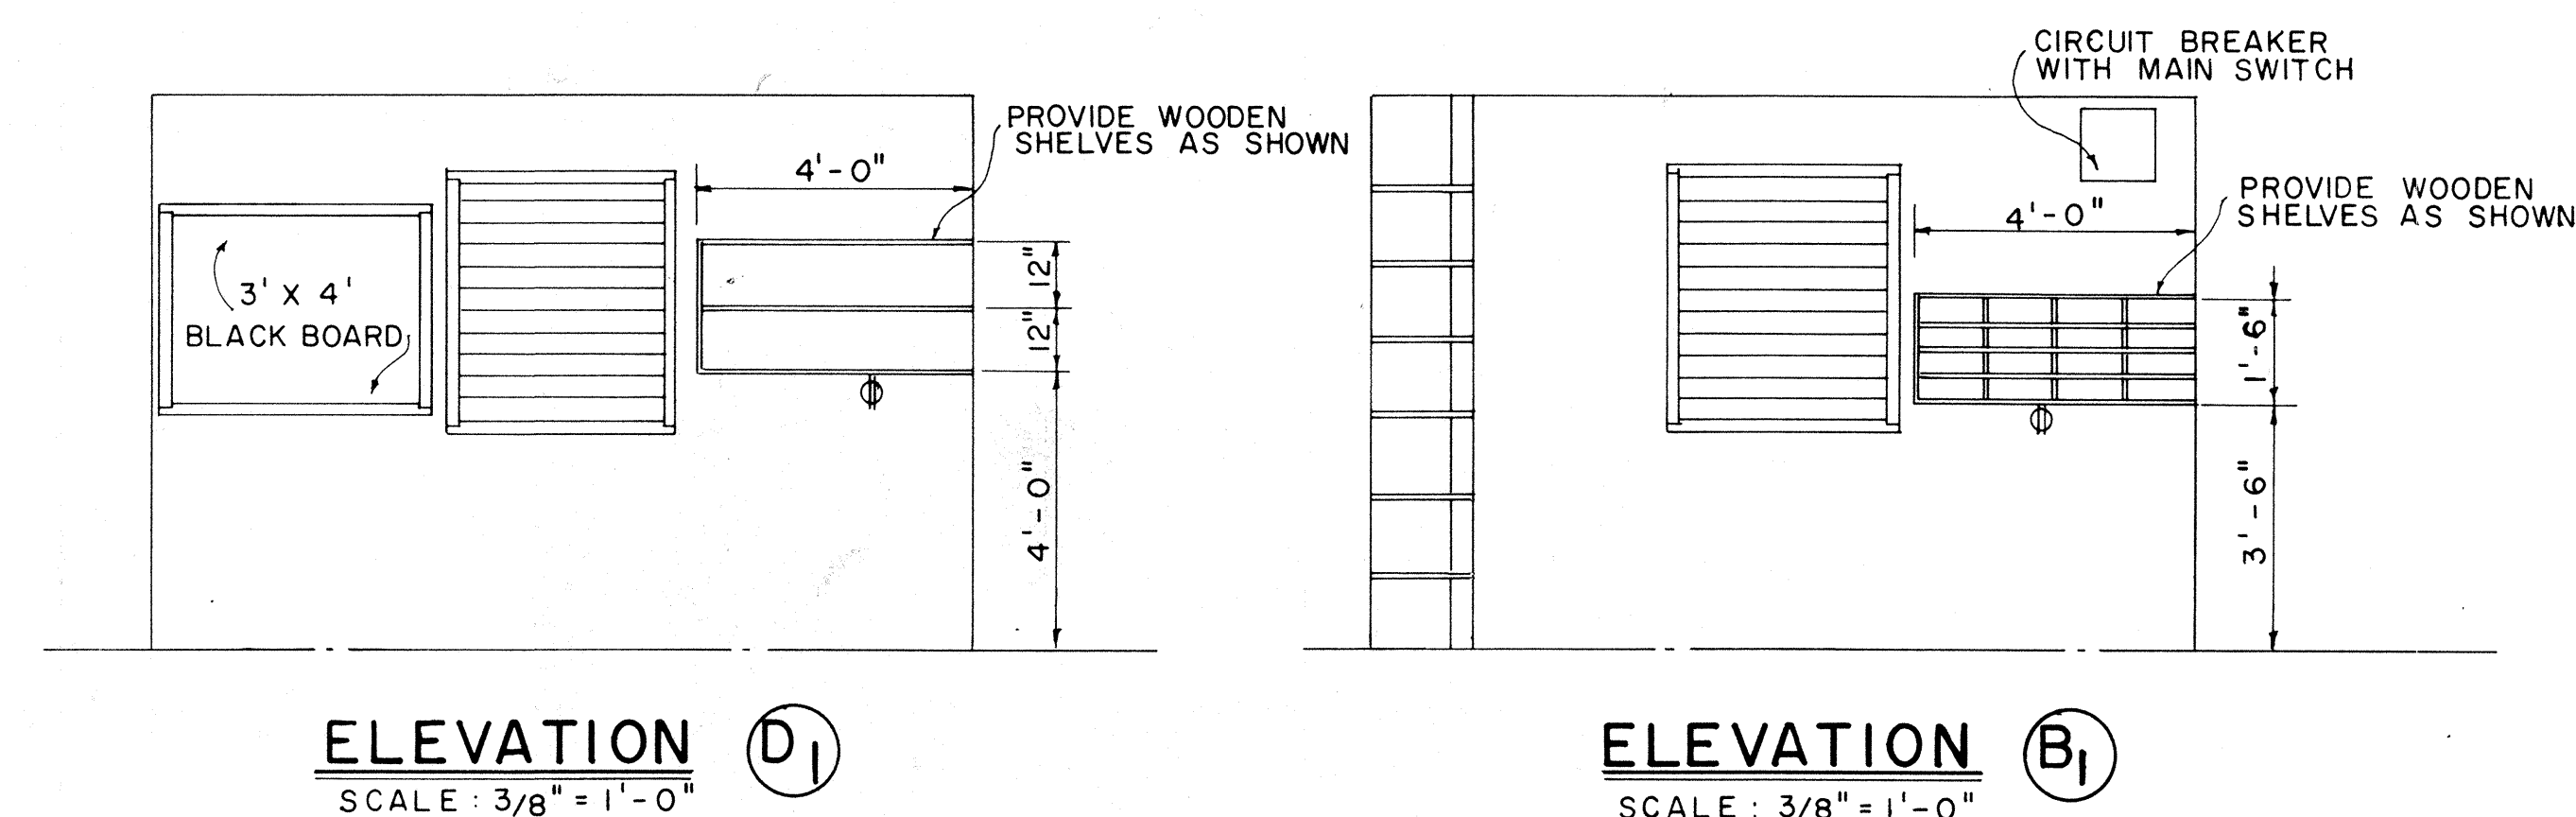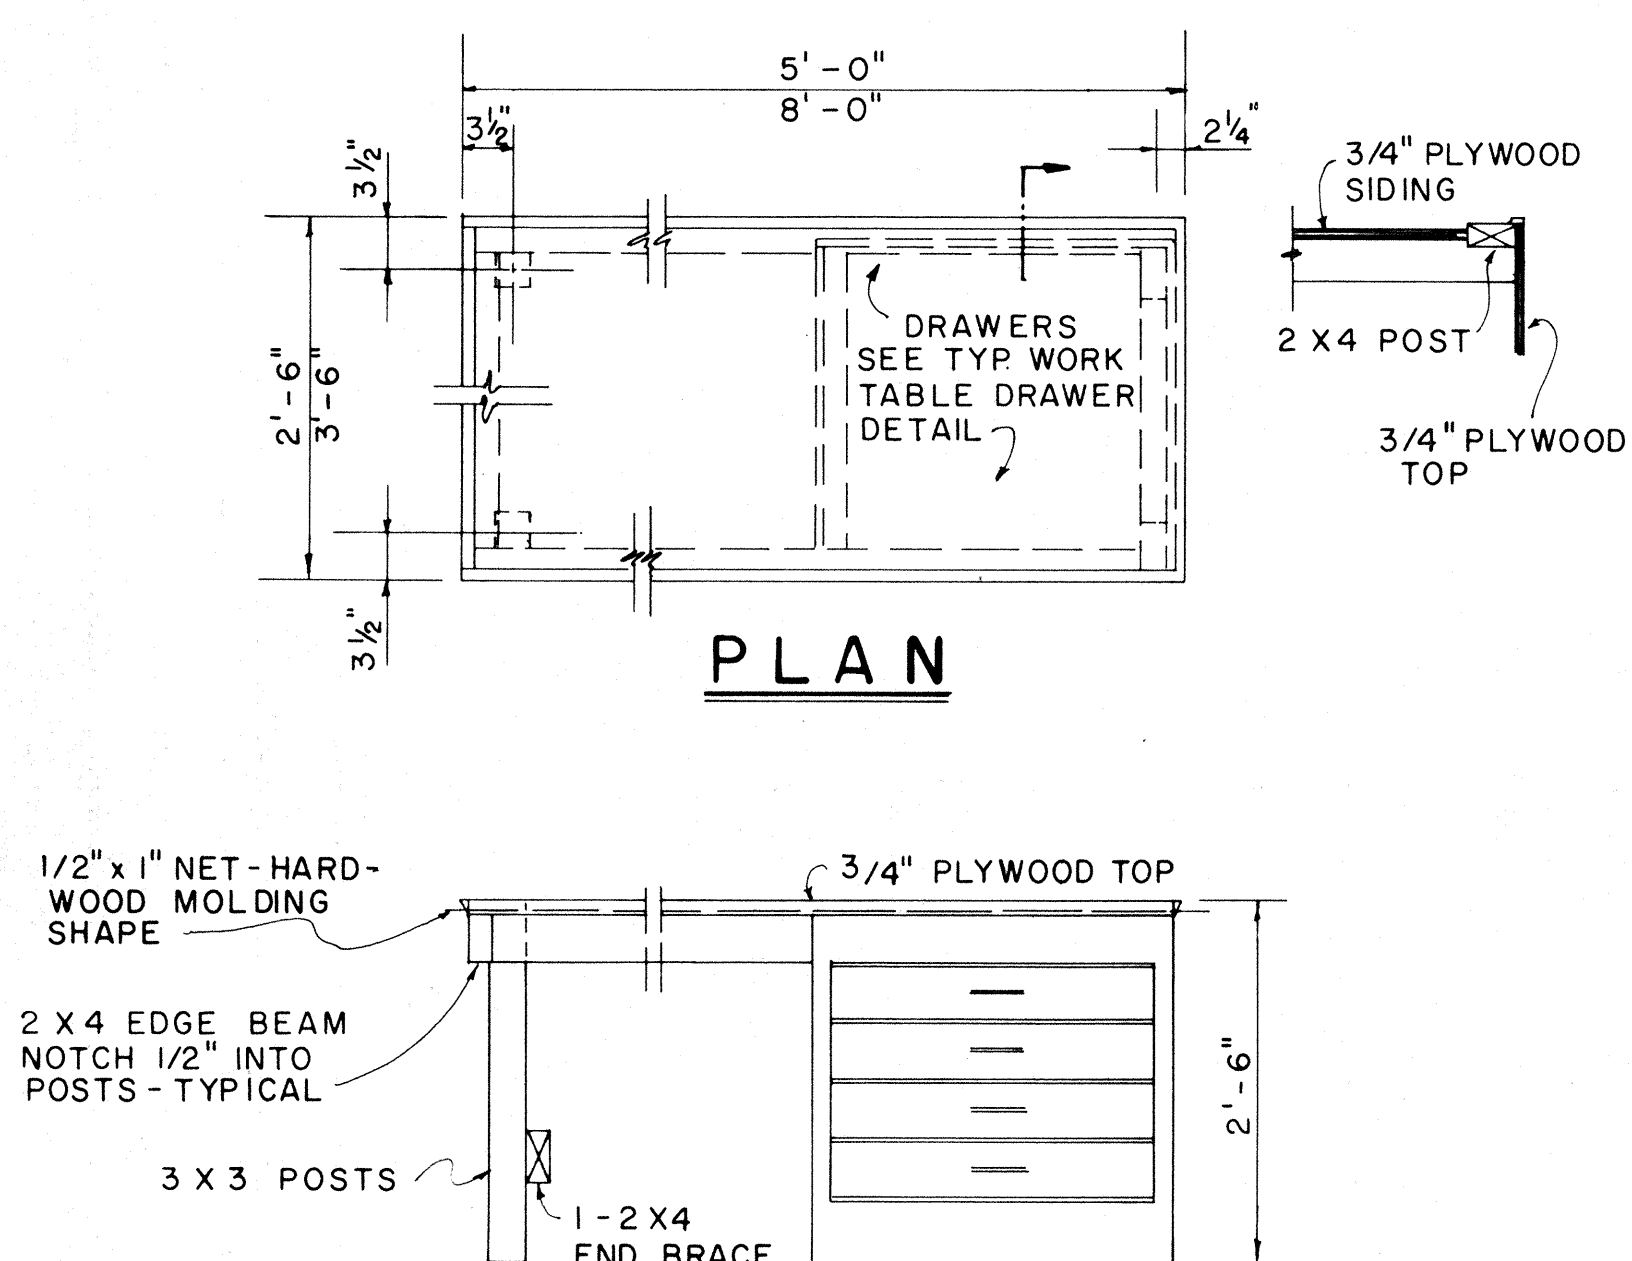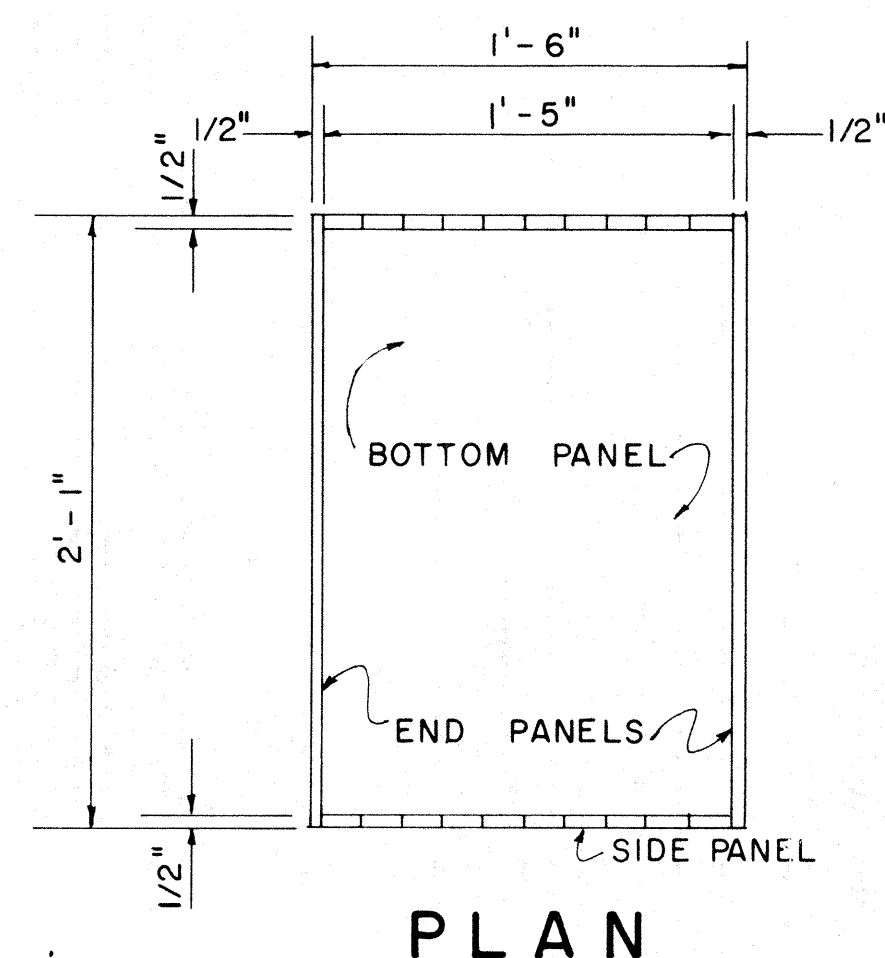

**1'-6" x 5'-9" PORTABLE
WORK TABLE DETAIL**
SCALE: 3/4" = 1'-0"

APPROVAL RECOMMENDED.
M. H. H. H. H. 12-4-69
HIGHWAY DESIGN ENGINEER DATE

APPROVED
Walter E. Zalski
ASSISTANT CHIEF, ENGINEERING

12-10-69
DATE

NO.	REVISION	APPROVED BY	DATE



STATE OF HAWAII
DEPARTMENT OF TRANSPORTATION
HIGHWAYS DIVISION

FIELD OFFICE


Scale : As Noted

ORIGINAL PLAN	SURVEY PLOTTED BY _____ DATE _____	
	DRAWN BY _____	_____
NOTE BOOK	TRACED BY _____	_____
	DESIGNED BY _____	_____
	QUANTITIES BY _____	_____
	CHECKED BY _____	_____
No. _____	_____	


FED. ROAD DIST. NO.	STATE	FED. AID PROJ. NO.	FISCAL YEAR	SHEET NO.	TOTAL SHEETS
HAWAII	HAW.	F-011-2(17)	1986	31	142

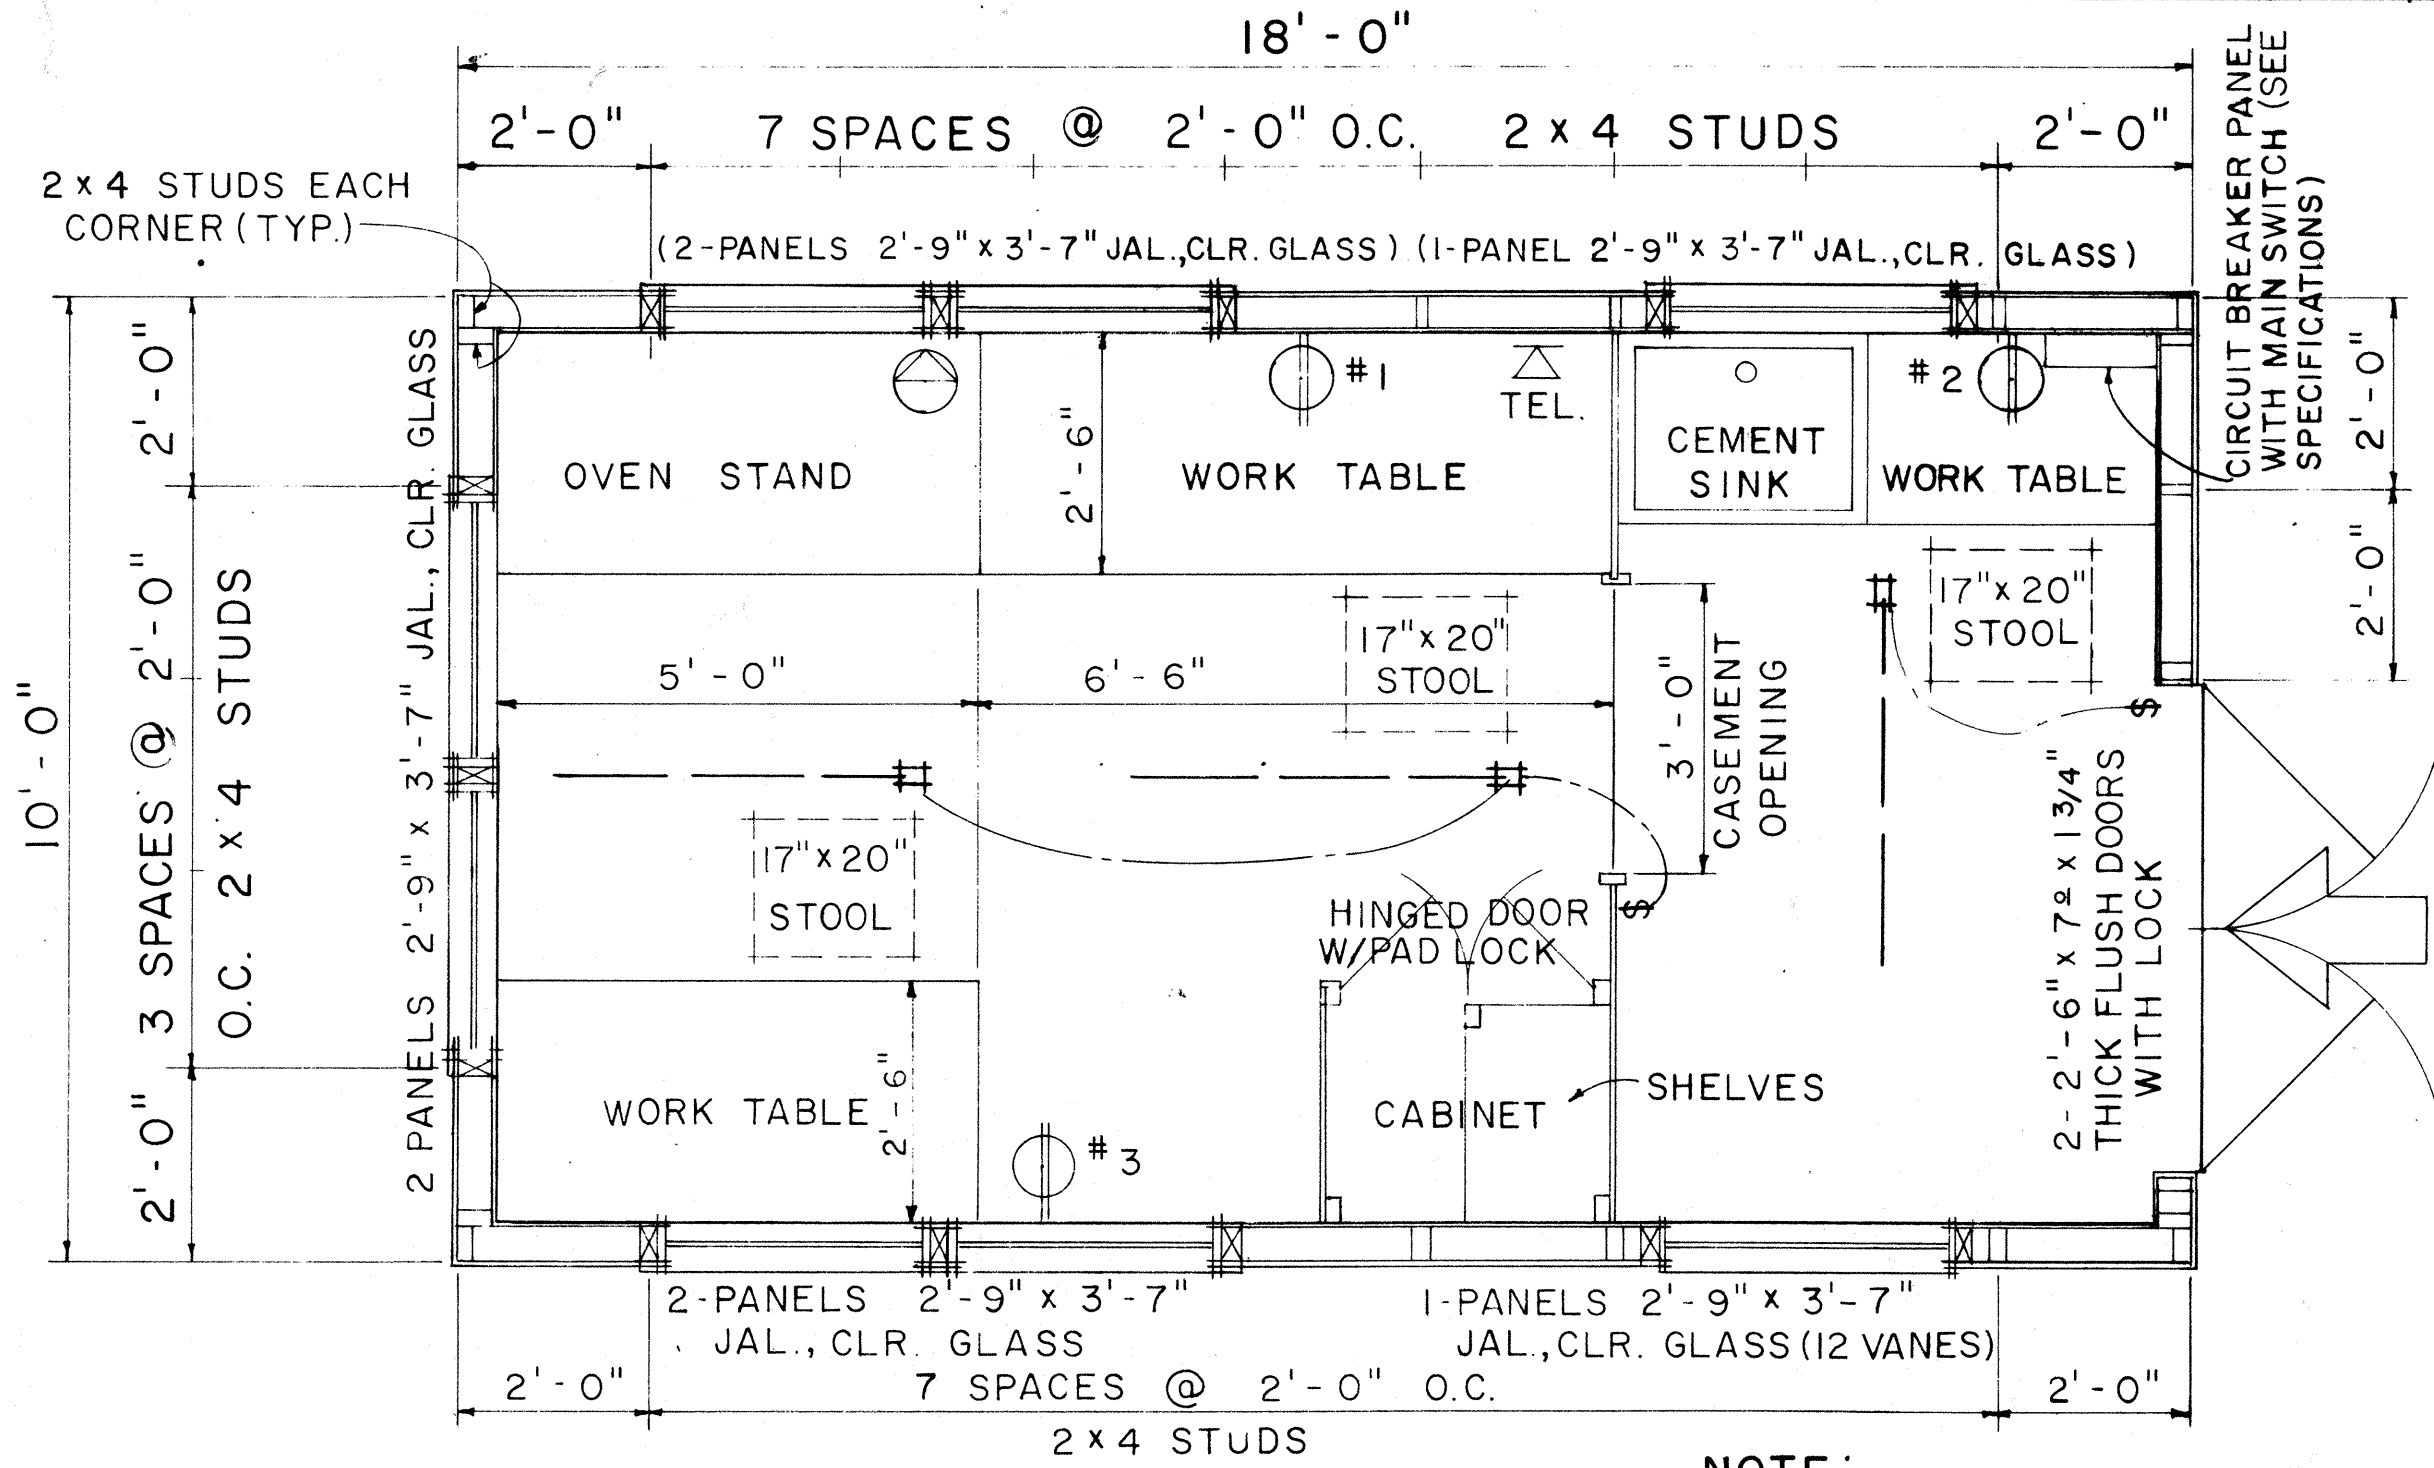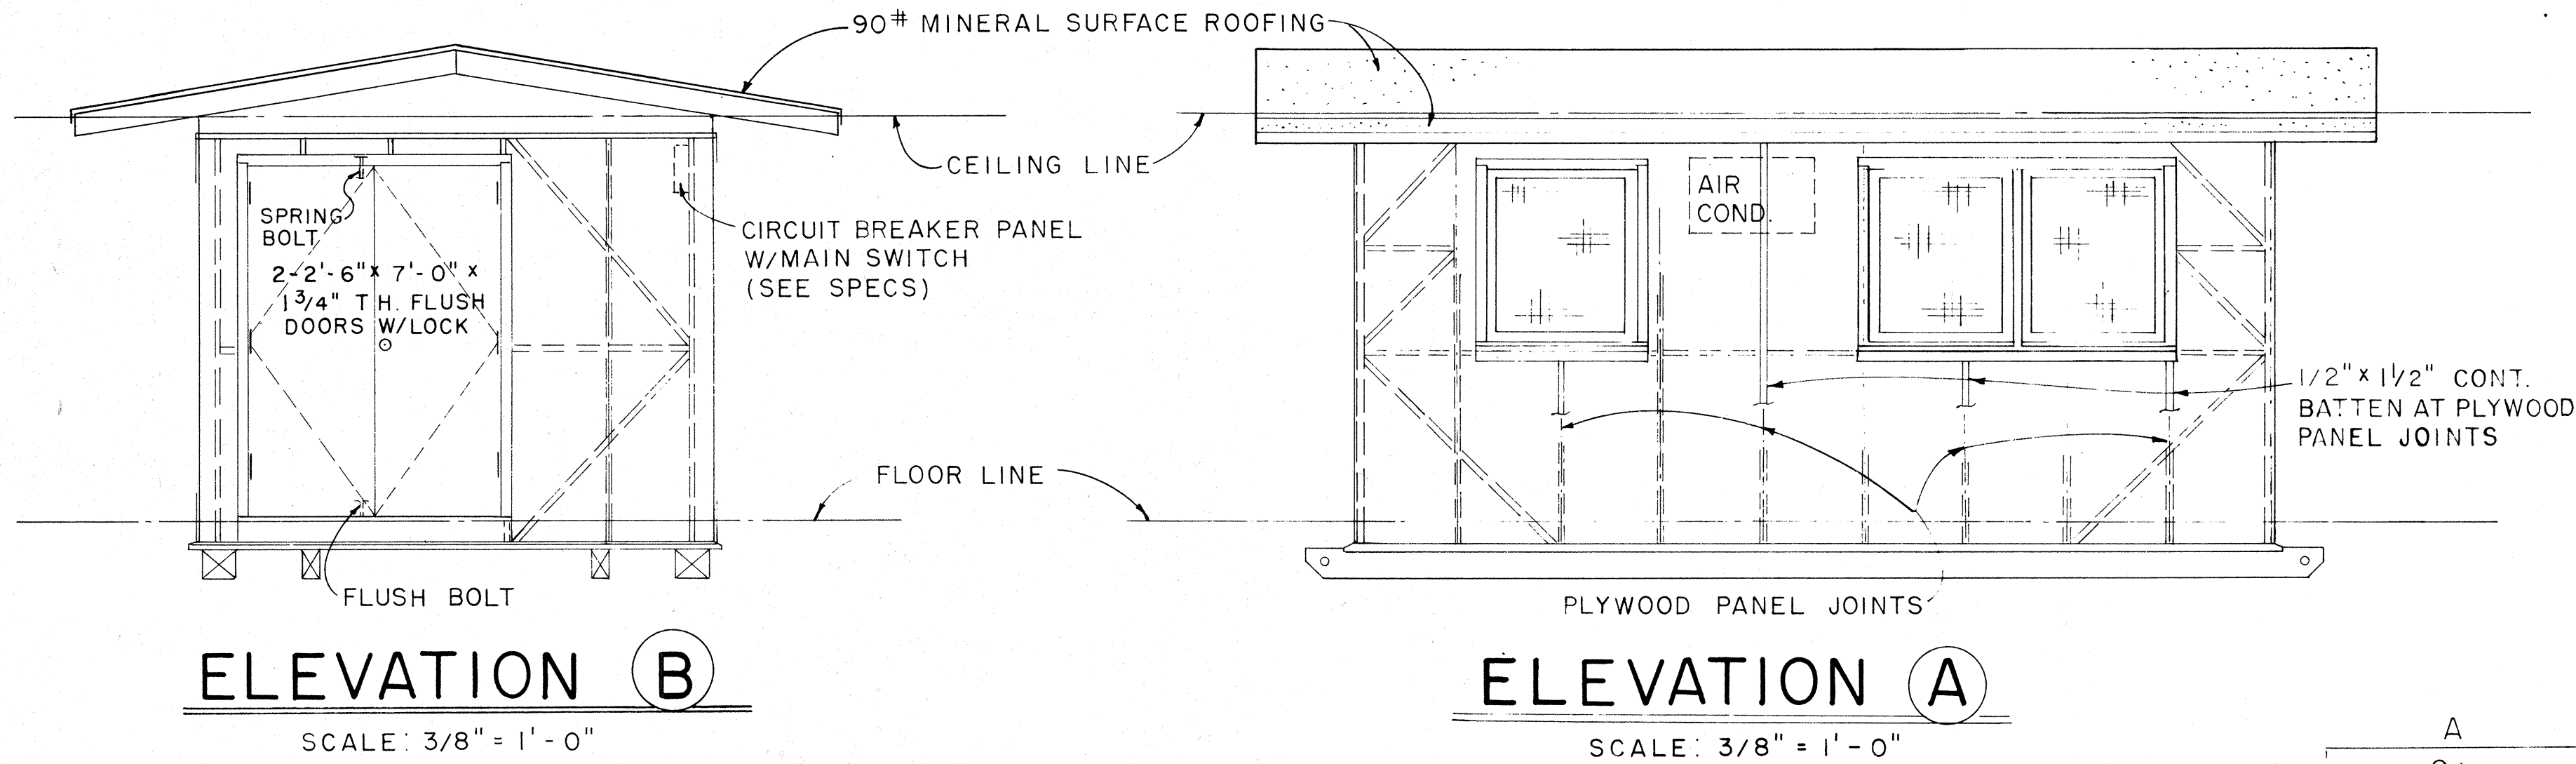

- NOTE:
1. FLUORESCENT FIXTURE SHALL BE 48", 2 LAMP, 40 WATT, RAPID START.
 2. TELEPHONE AND WALL OUTLET 4'-0" ABOVE FLOOR.

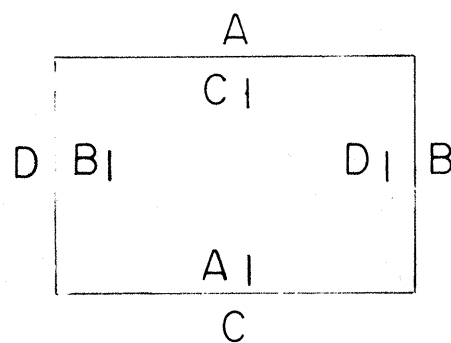


EXTERIOR & INTERIOR KEY

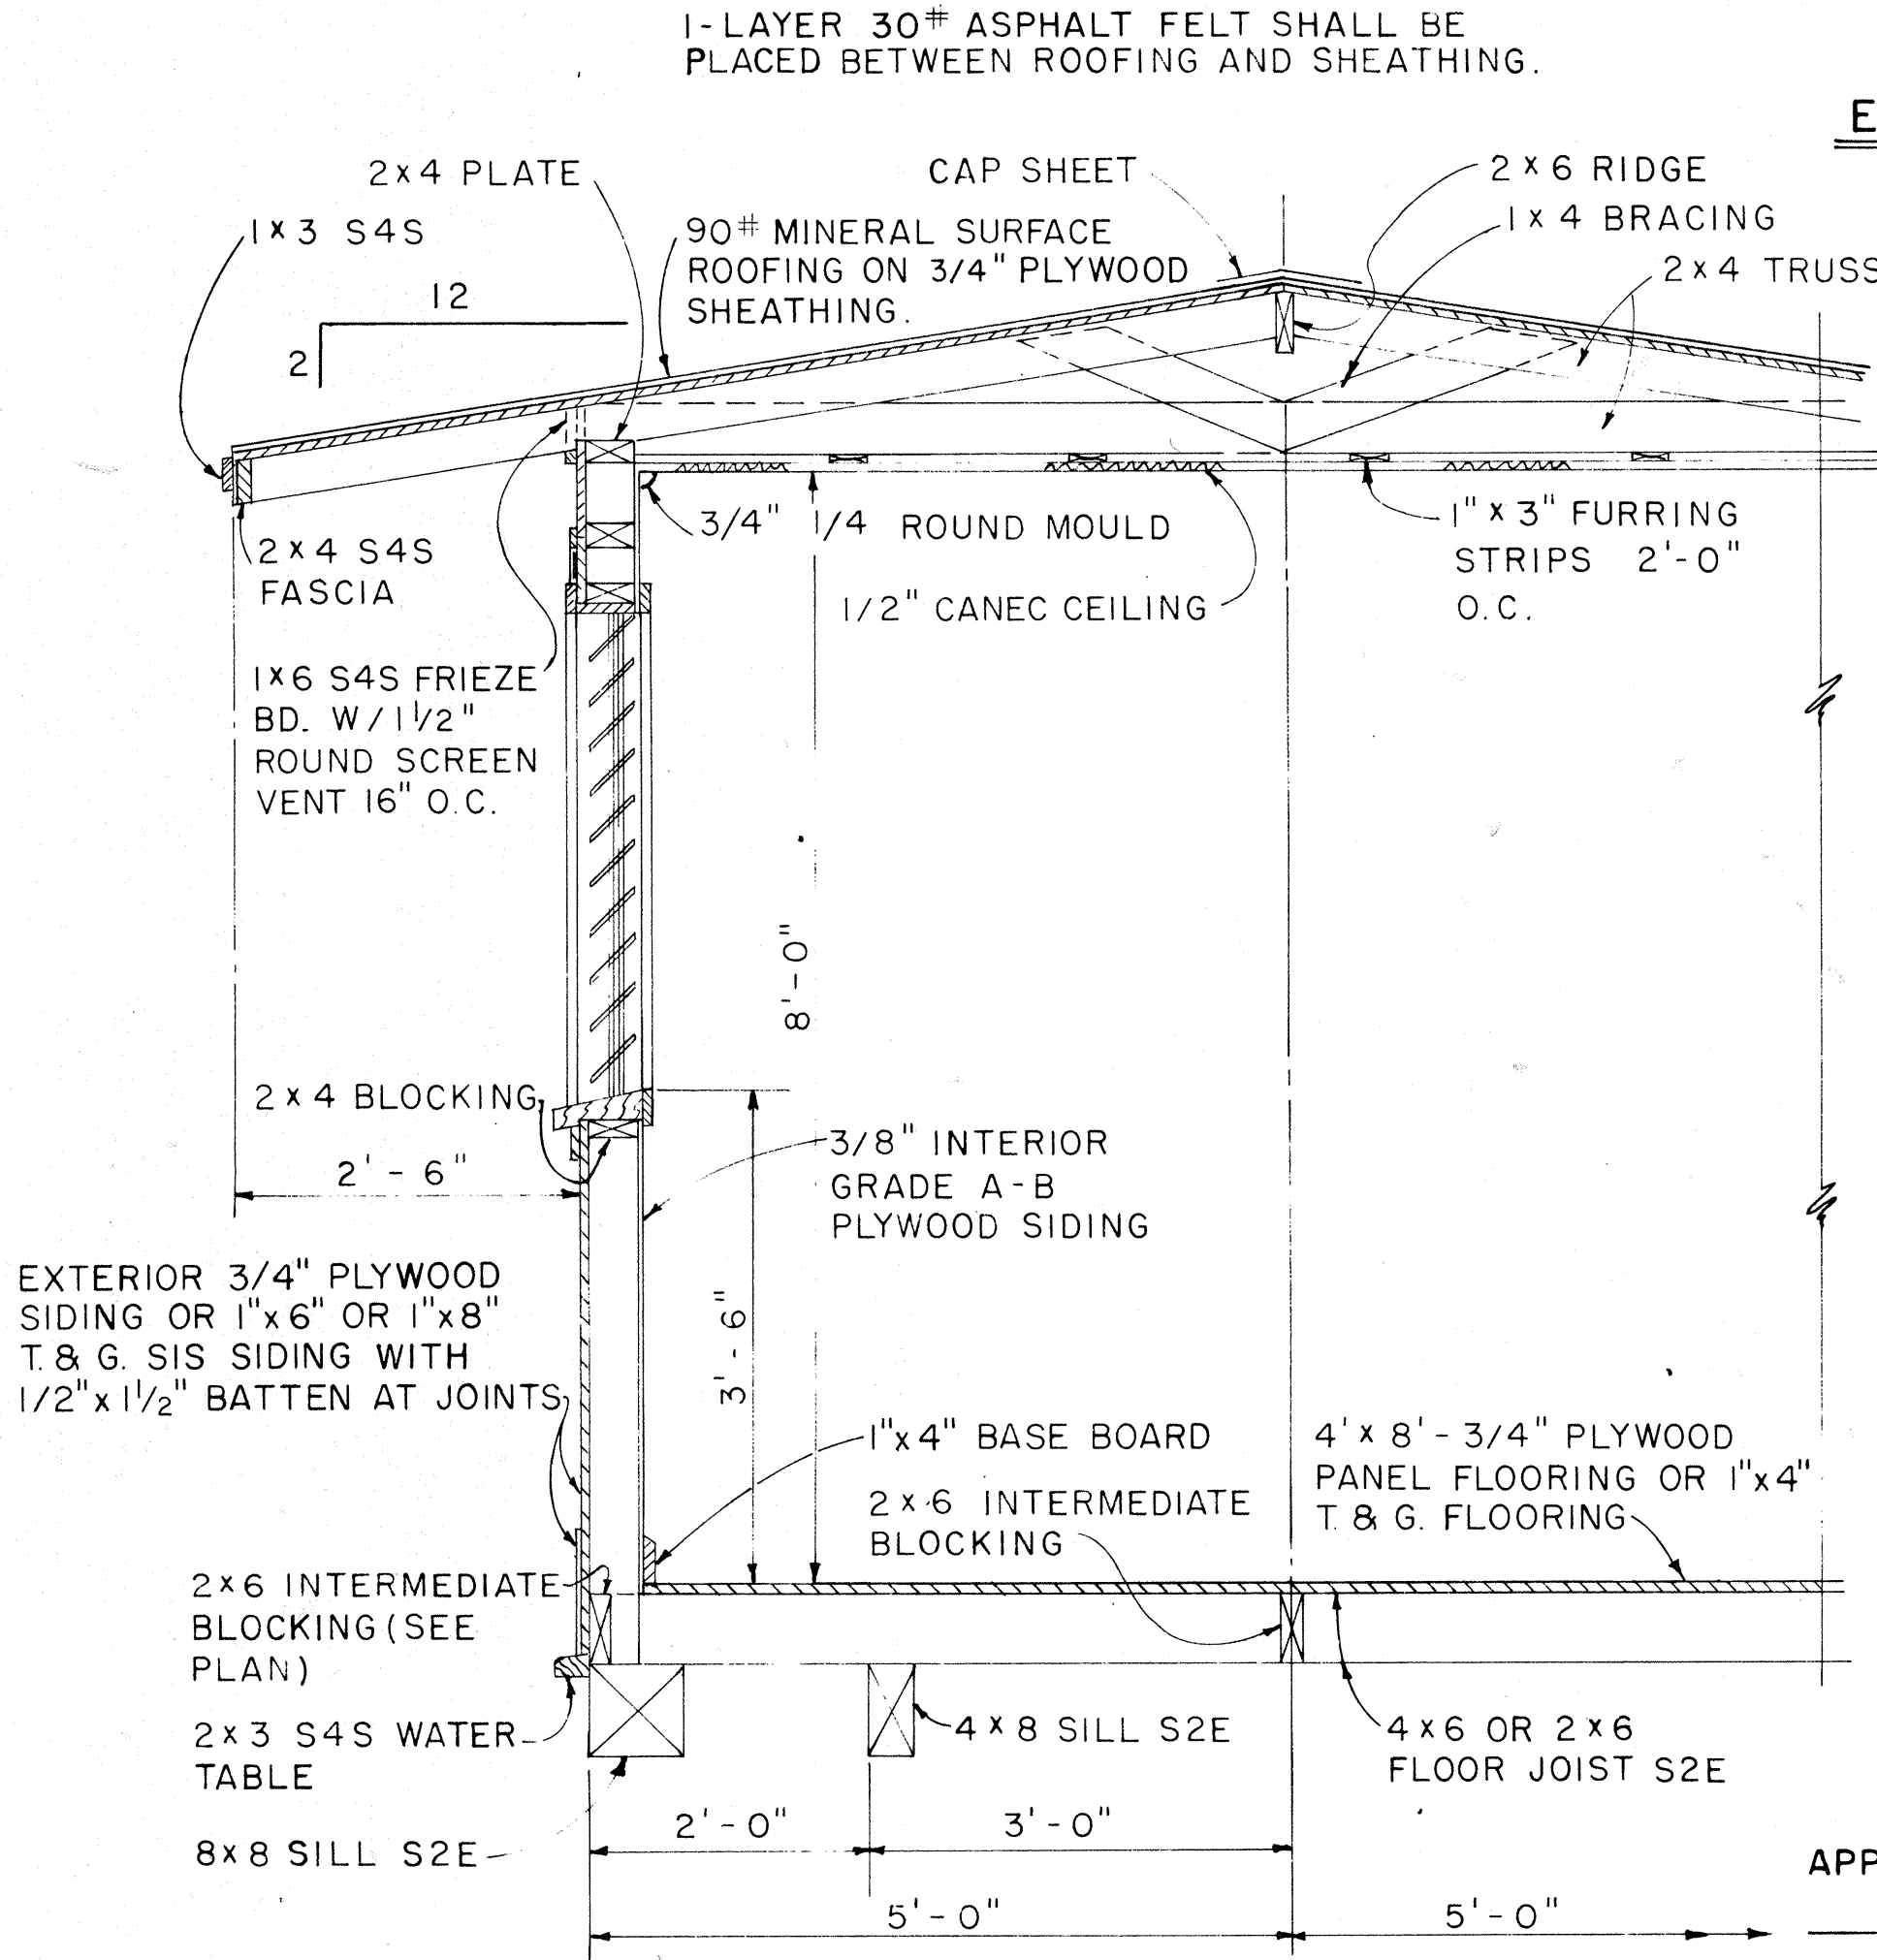

NOTE:
ALL 3/4" PLYWOOD SHALL BE EXTERIOR GRADE A-C OR BETTER.

APPROVAL RECOMMENDED:
HIGHWAY DESIGN ENGINEER
DATE: 12-4-69

APPROVED:
ASSISTANT CHIEF, ENGINEERING
DATE: 12-10-69

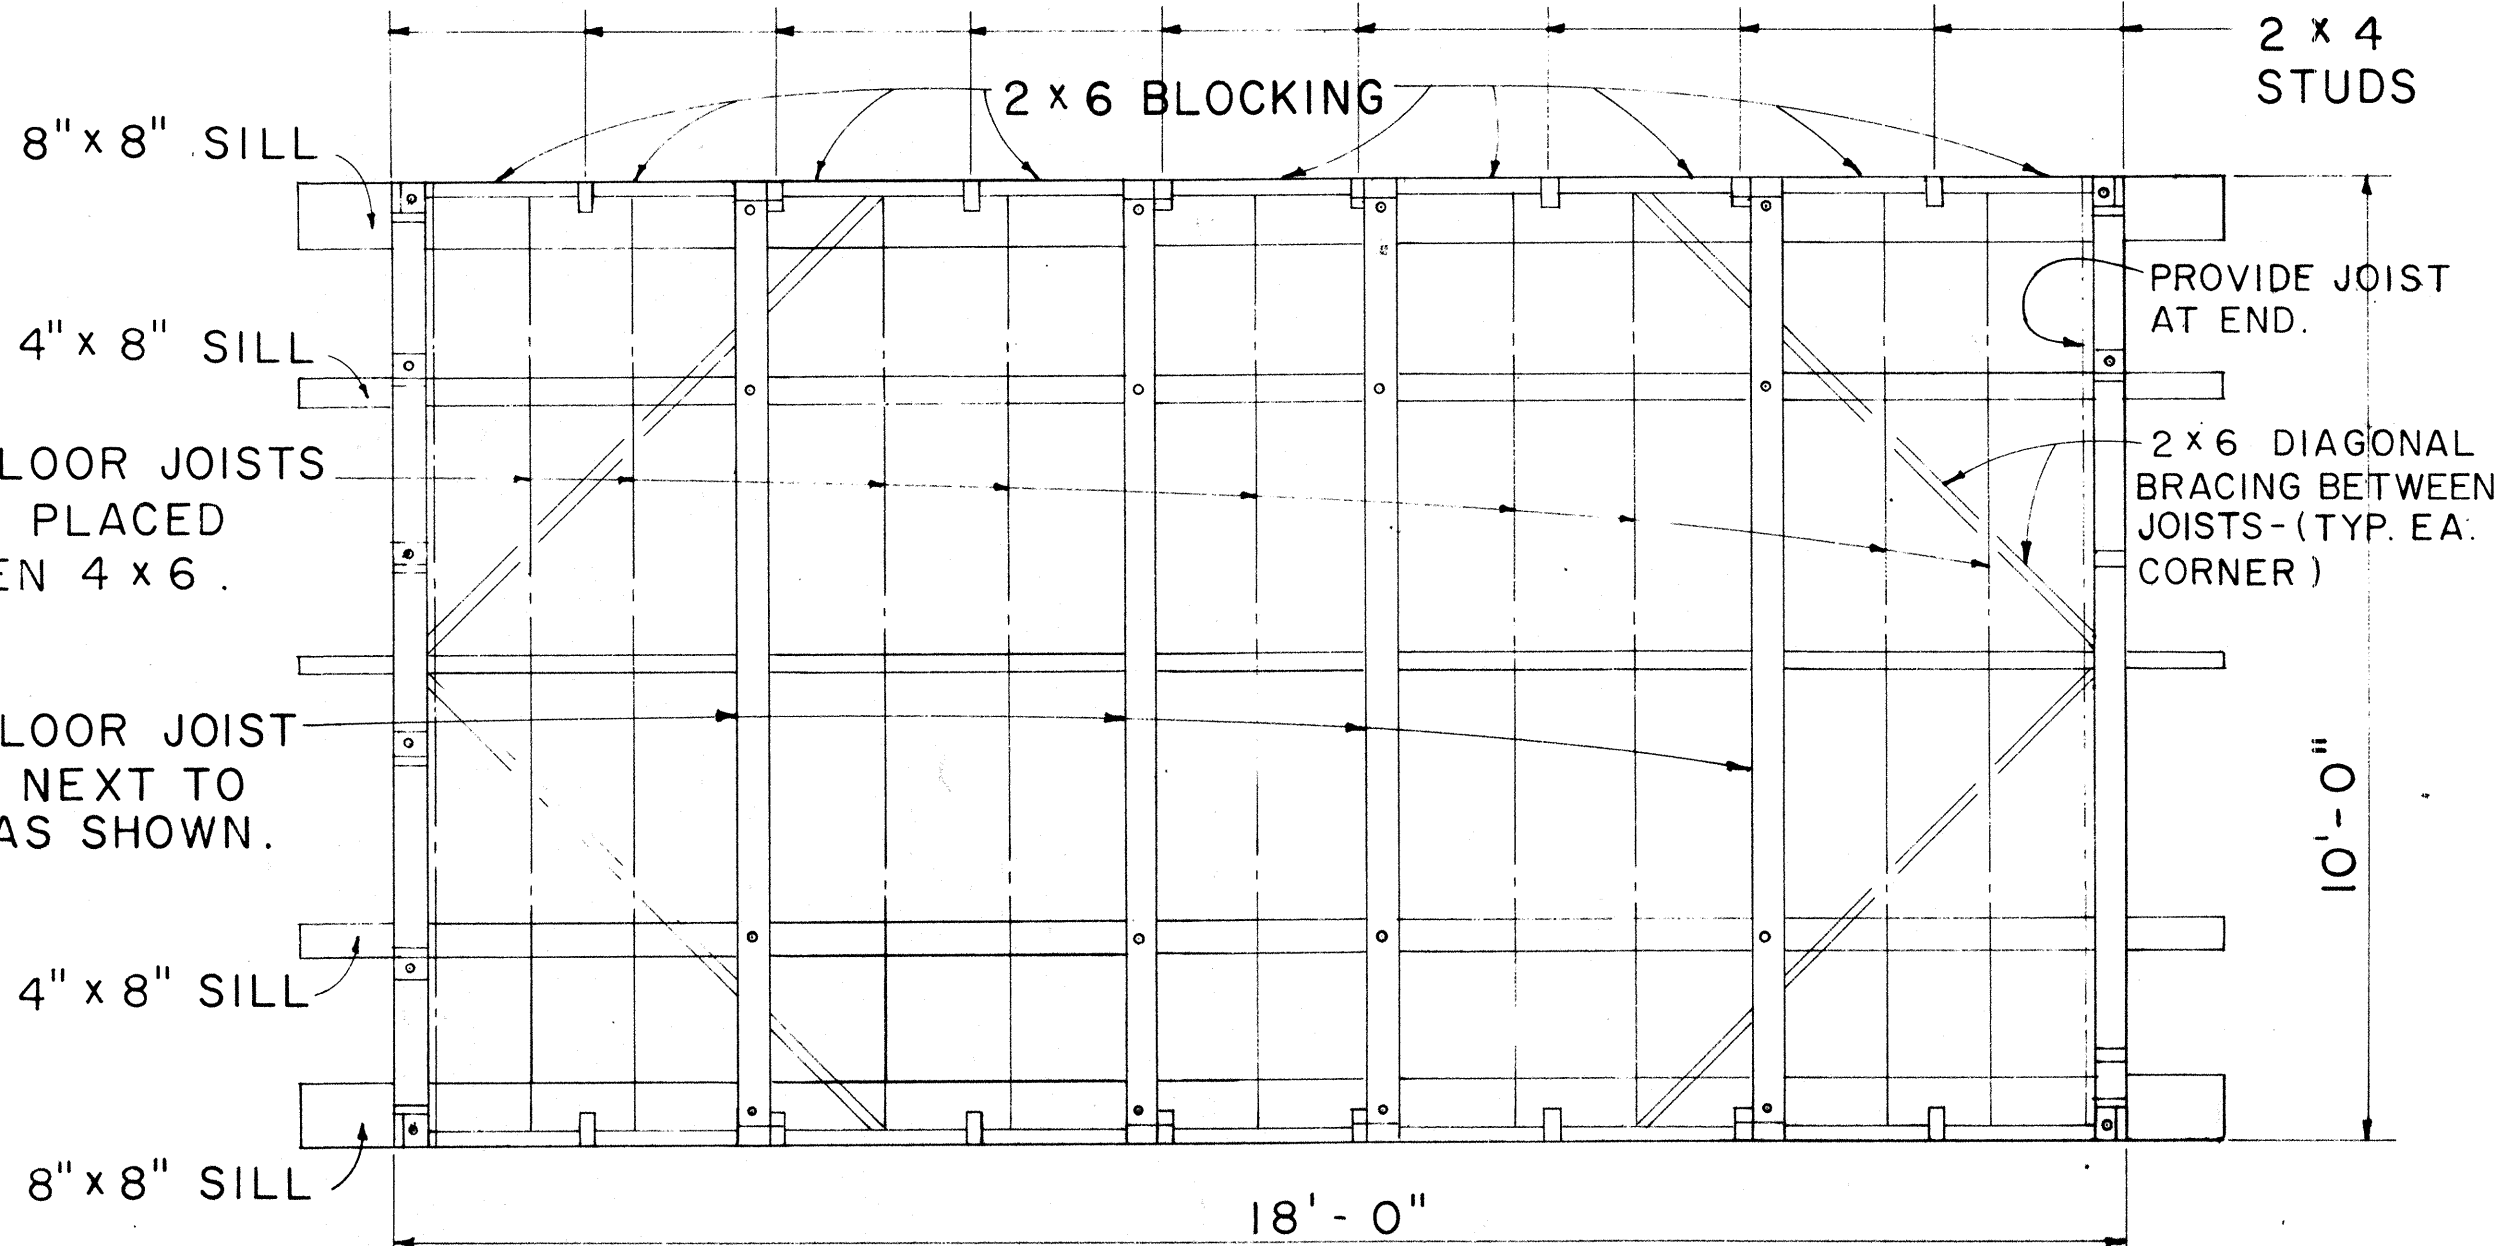


NO.	REVISION	APPROVED BY	DATE

STATE OF HAWAII
DEPARTMENT OF TRANSPORTATION
HIGHWAYS DIVISION

PROJECT SITE LABORATORY


Scale: As Noted

FED. ROAD DIST. NO.	STATE	FED. AID PROJ. NO.	FISCAL YEAR	SHEET NO.	TOTAL SHEETS
HAWAII	HAW.	F-011-2(17)	1986	32	142

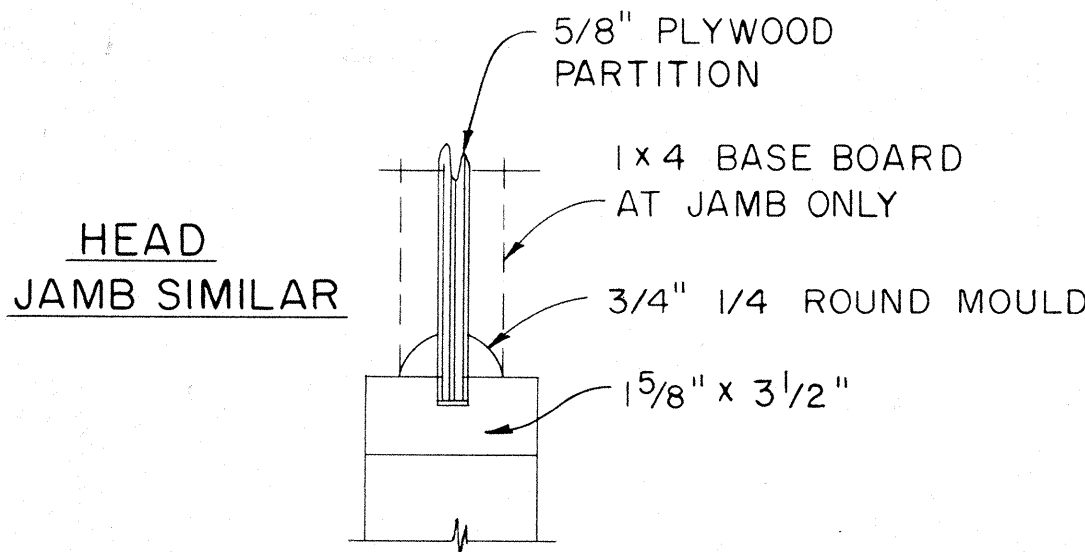


CASEMENT DETAIL

SCALE: 3" = 1'-0"

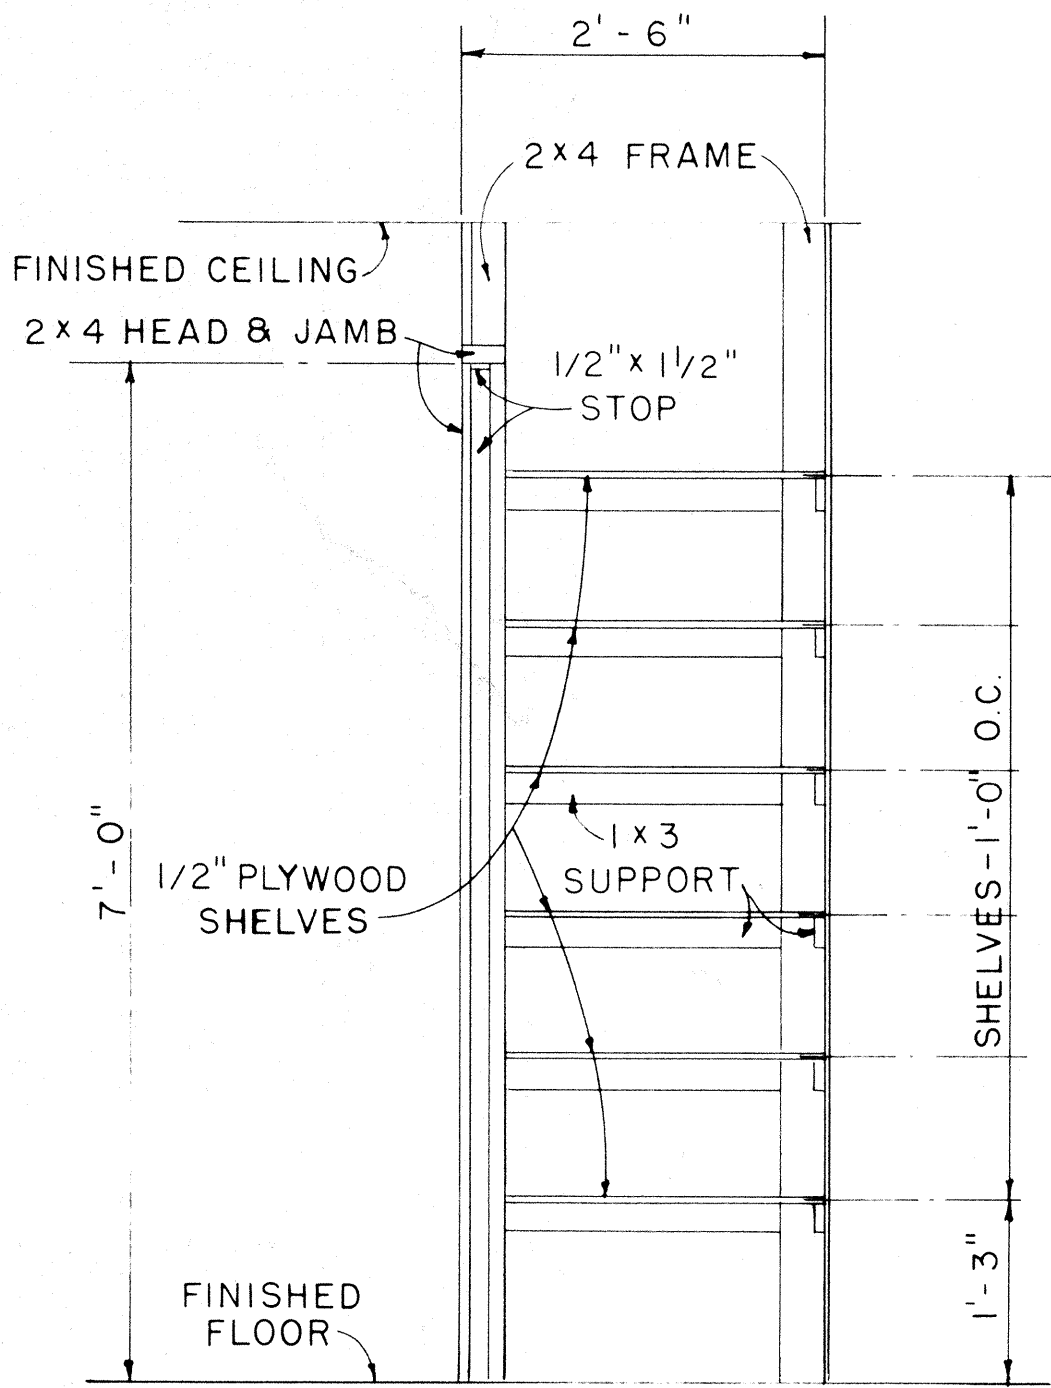


CABINET DETAIL

SCALE: 3/4" = 1'-0"

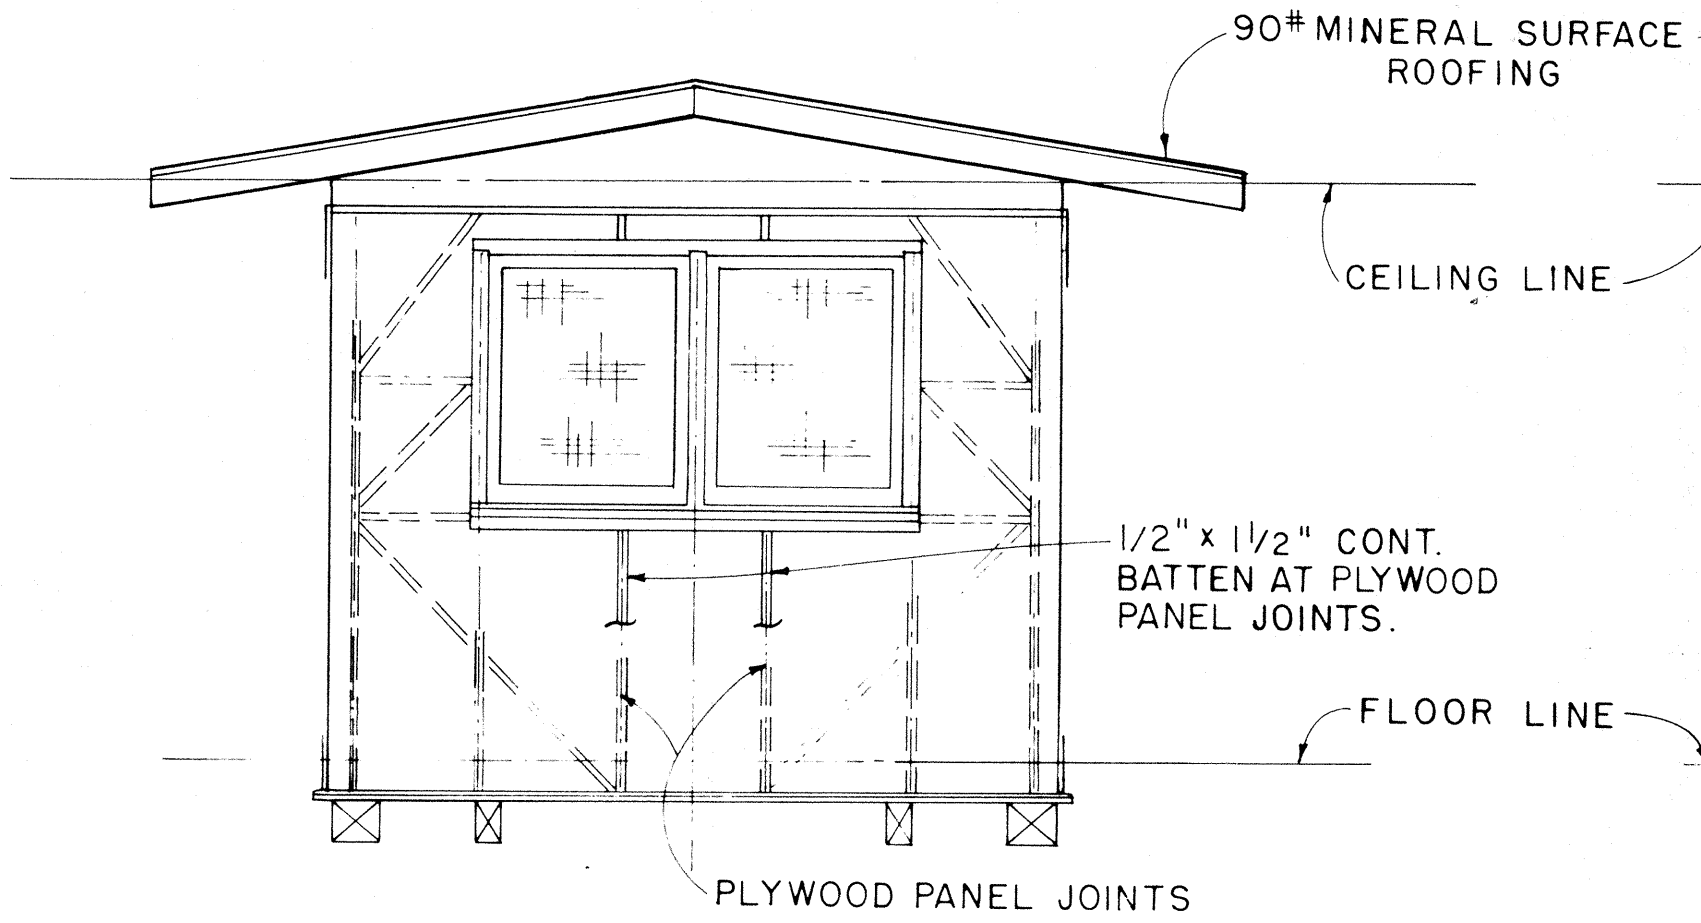


ELEVATION D

SCALE: 3/8" = 1'-0"

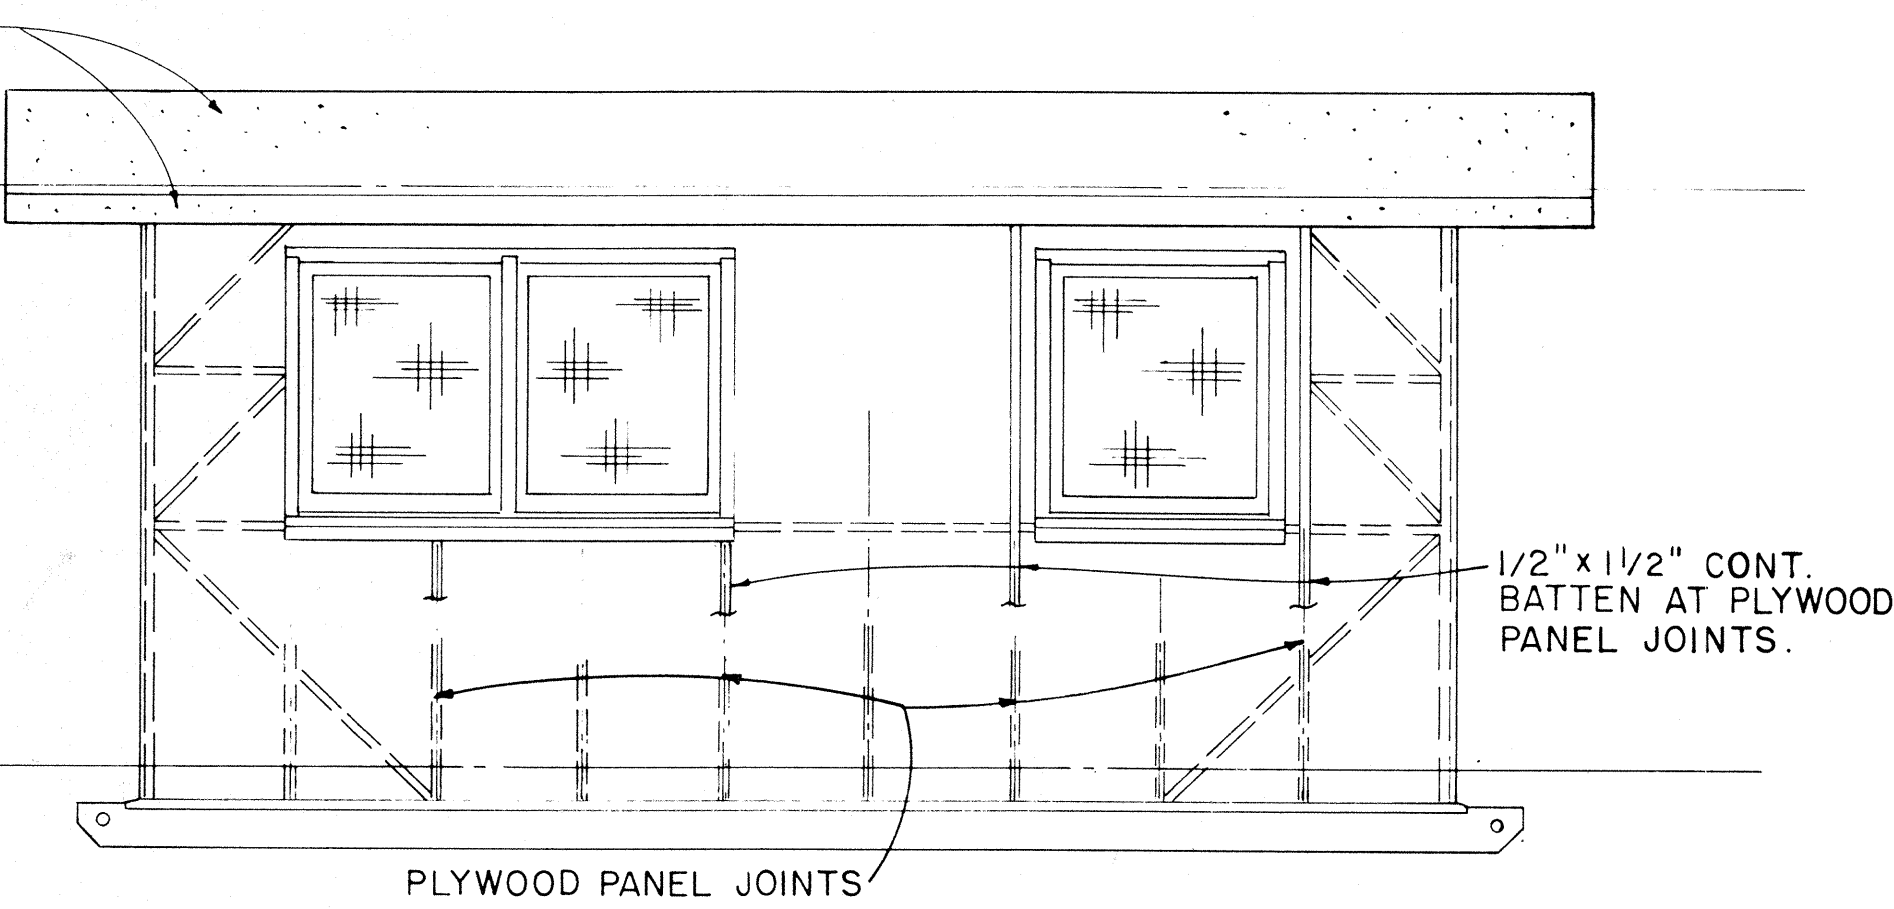


ELEVATION C

SCALE: 3/8" = 1'-0"

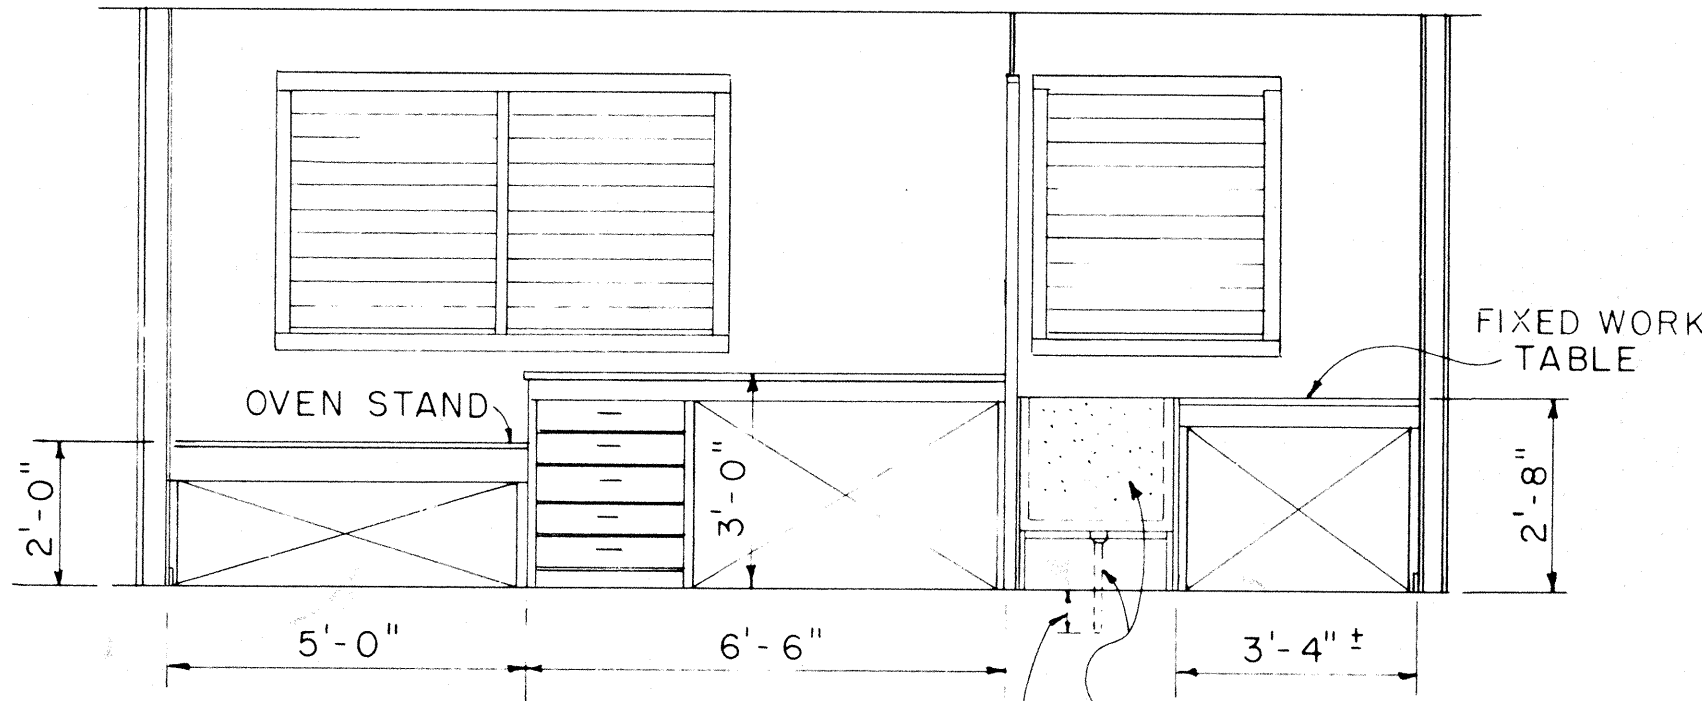

ELEVATION C1

SCALE: 3/8" = 1'-0"

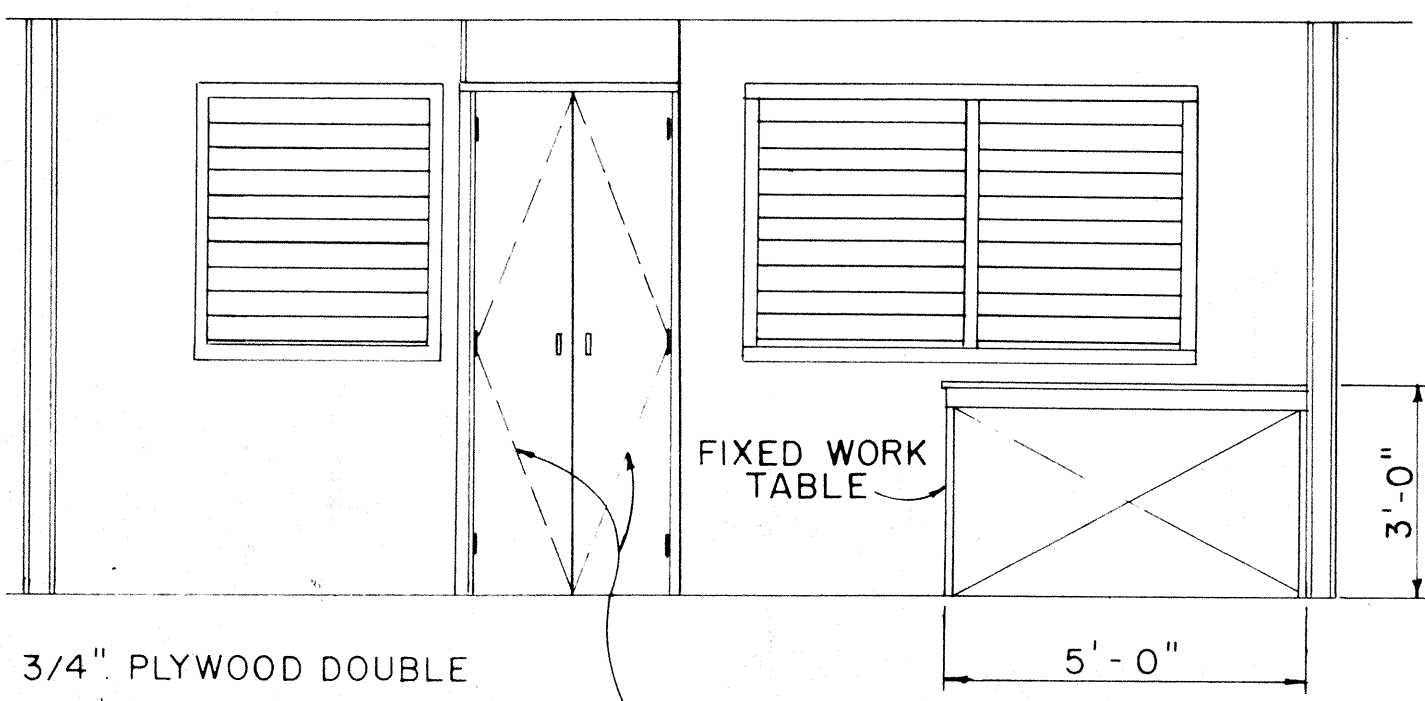

ELEVATION A1

SCALE: 3/8" = 1'-0"

ORIGINAL PLAN	DATE
DESIGNED BY	
DRAWN BY	
CHECKED BY	
NOTED BY	
NO.	

APPROVAL RECOMMENDED:
HIGHWAY DESIGN ENGINEER
12-4-69
DATE

APPROVED:
ASSISTANT CHIEF, ENGINEERING
12-10-69
DATE


NO.	REVISION	APPROVED BY	DATE

STATE OF HAWAII
DEPARTMENT OF TRANSPORTATION
HIGHWAYS DIVISION


PROJECT SITE LABORATORY

Scale: As Noted


FED. ROAD DIST. NO.	STATE	FED. AID PROJ. NO.	FISCAL YEAR	SHEET NO.	TOTAL SHEETS
HAWAII	HAWAII	F-011-2(17)	1986	33	142

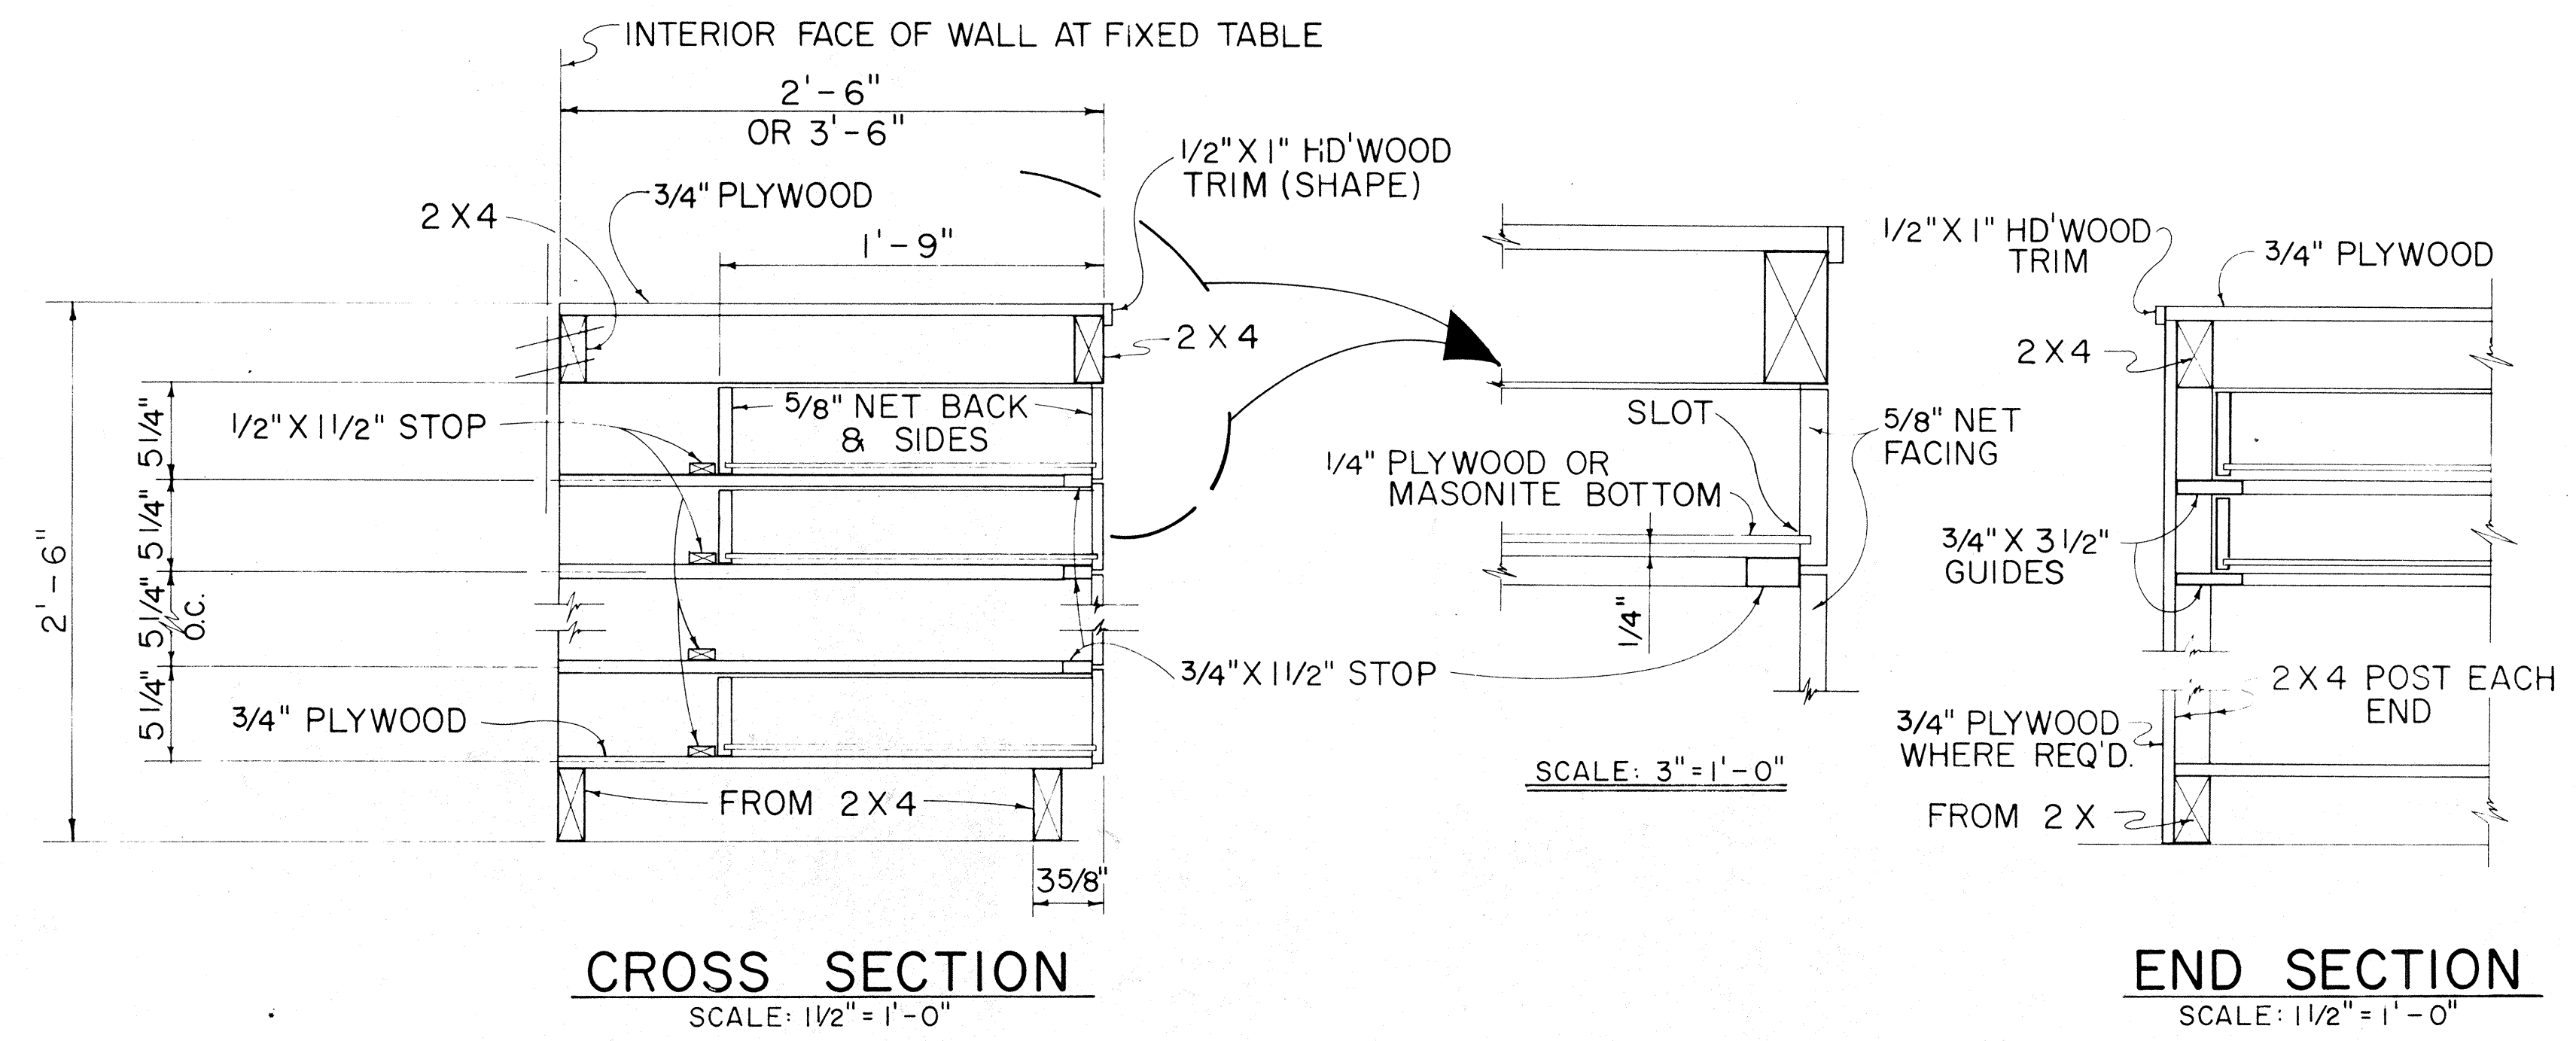


TYPICAL WORK TABLE DRAWER DETAIL

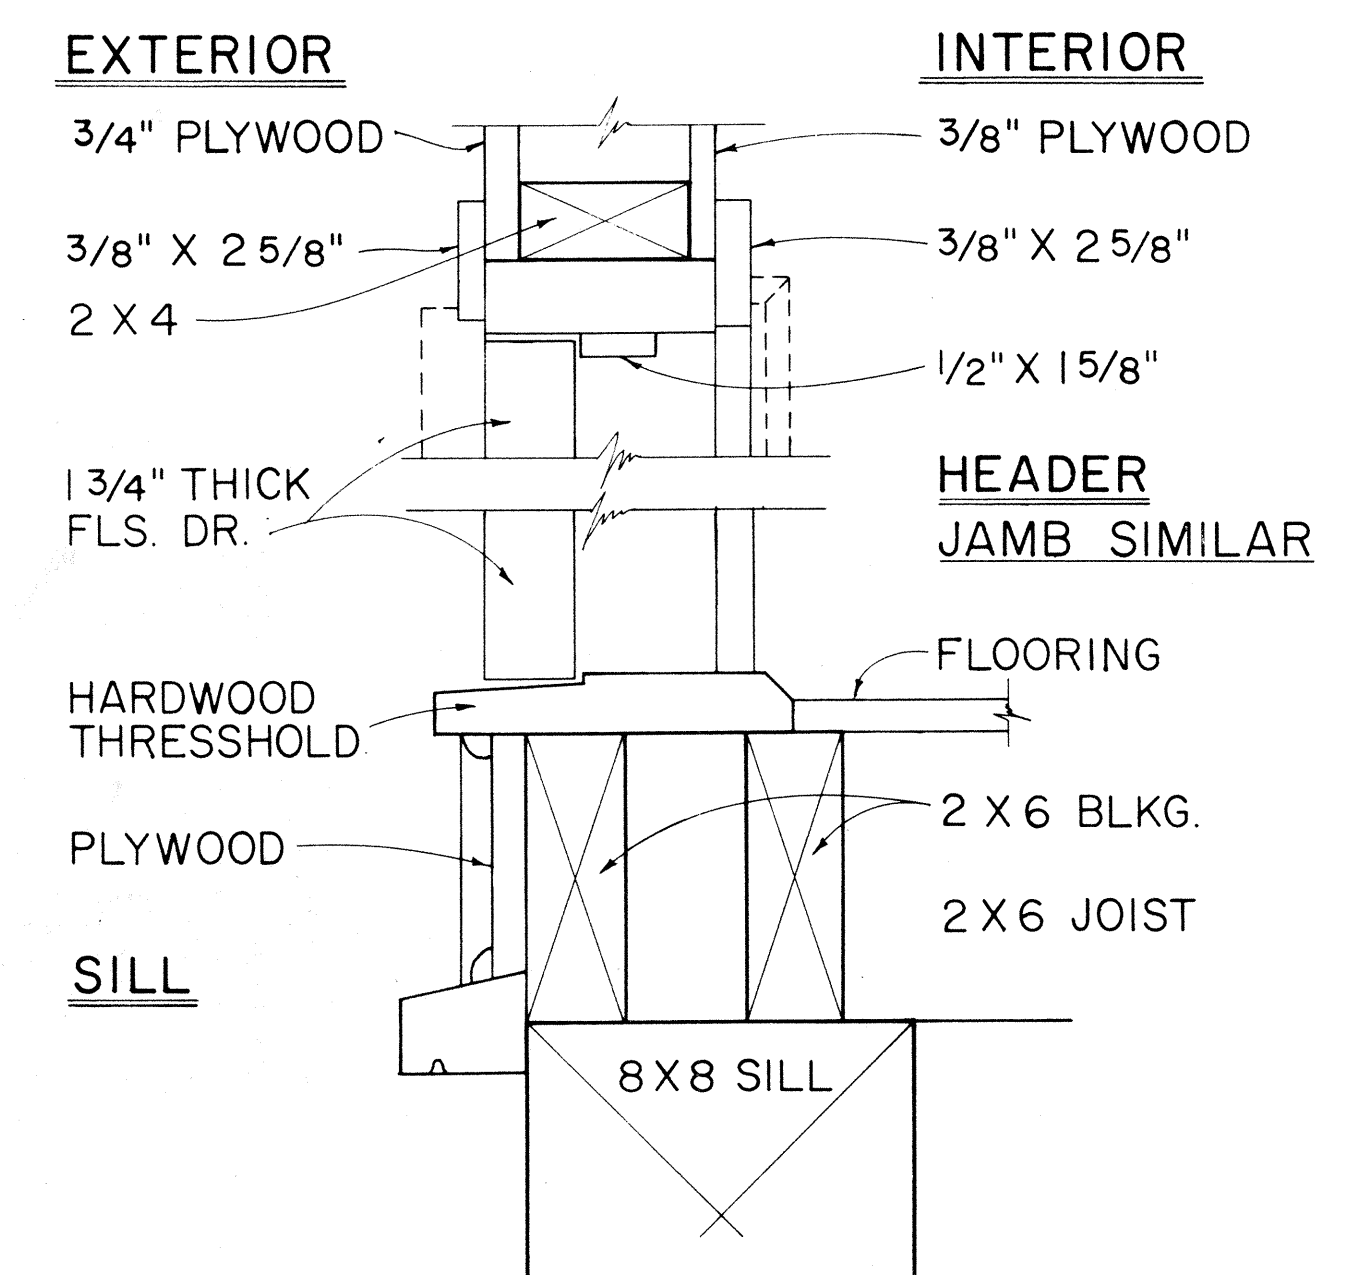


TYP. SWING OUT DOOR
TYPICAL SINGLE OR DOUBLE EXTERIOR DOOR DETAIL

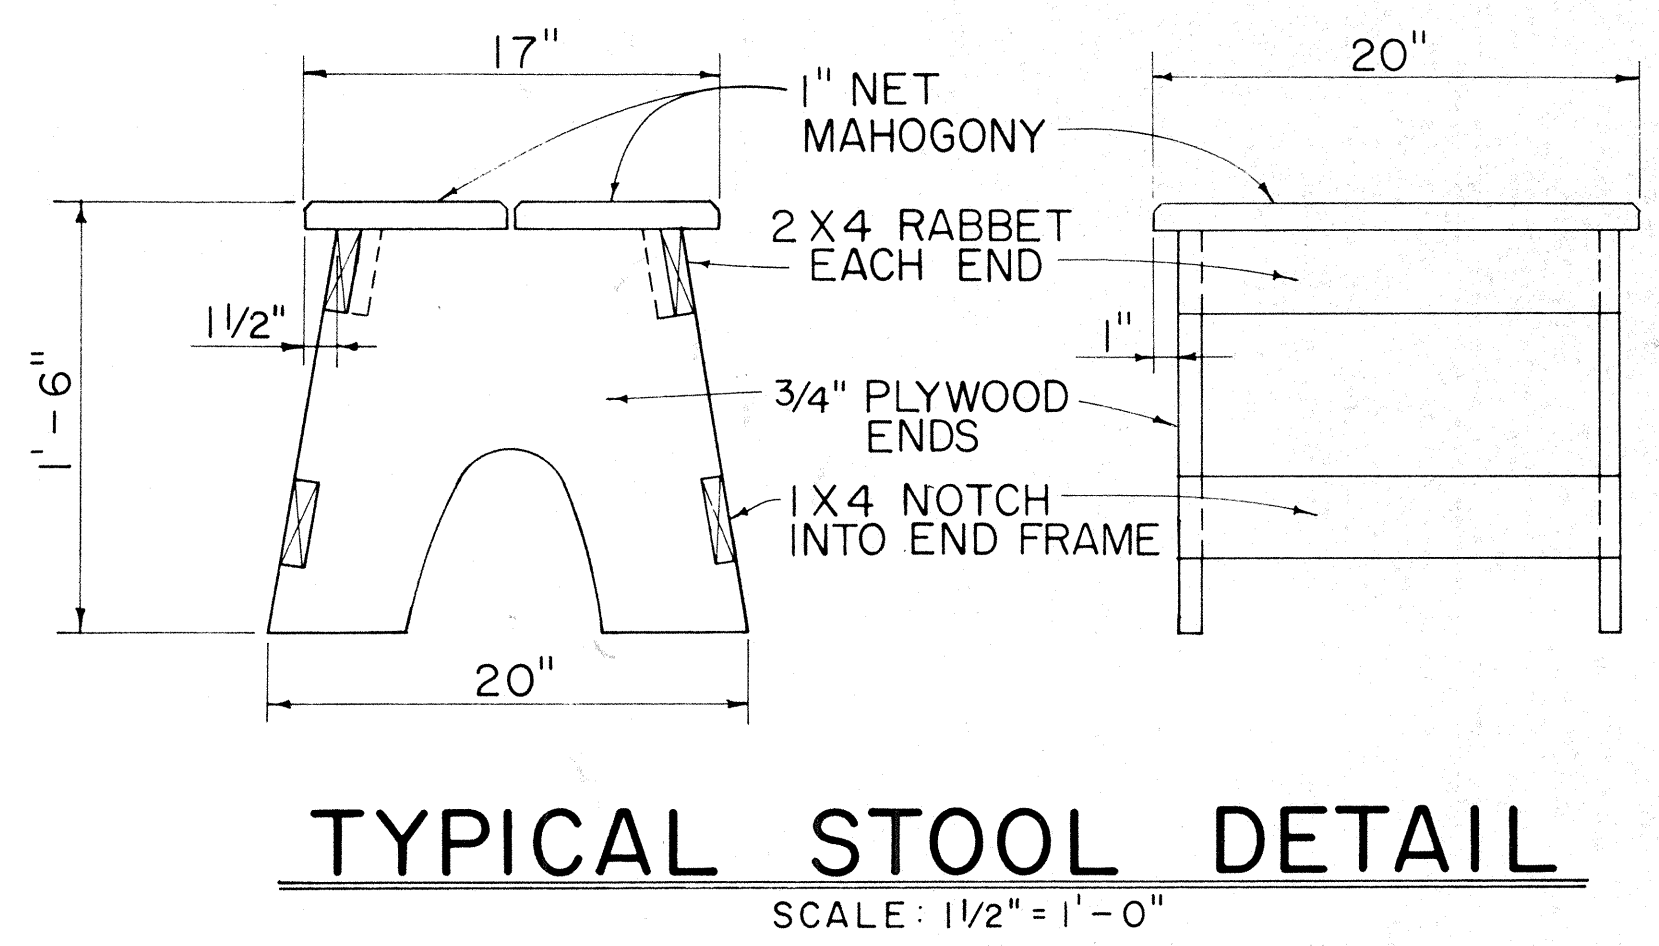

NOTE: CONTRACTOR MAY WITH THE APPROVAL OF THE ENGINEER FURNISH THE FIELD OFFICE OR PROJECT SITE LABORATORY WITH STOOLS OTHER THAN THE TYPE SHOWN IN THE DETAIL.

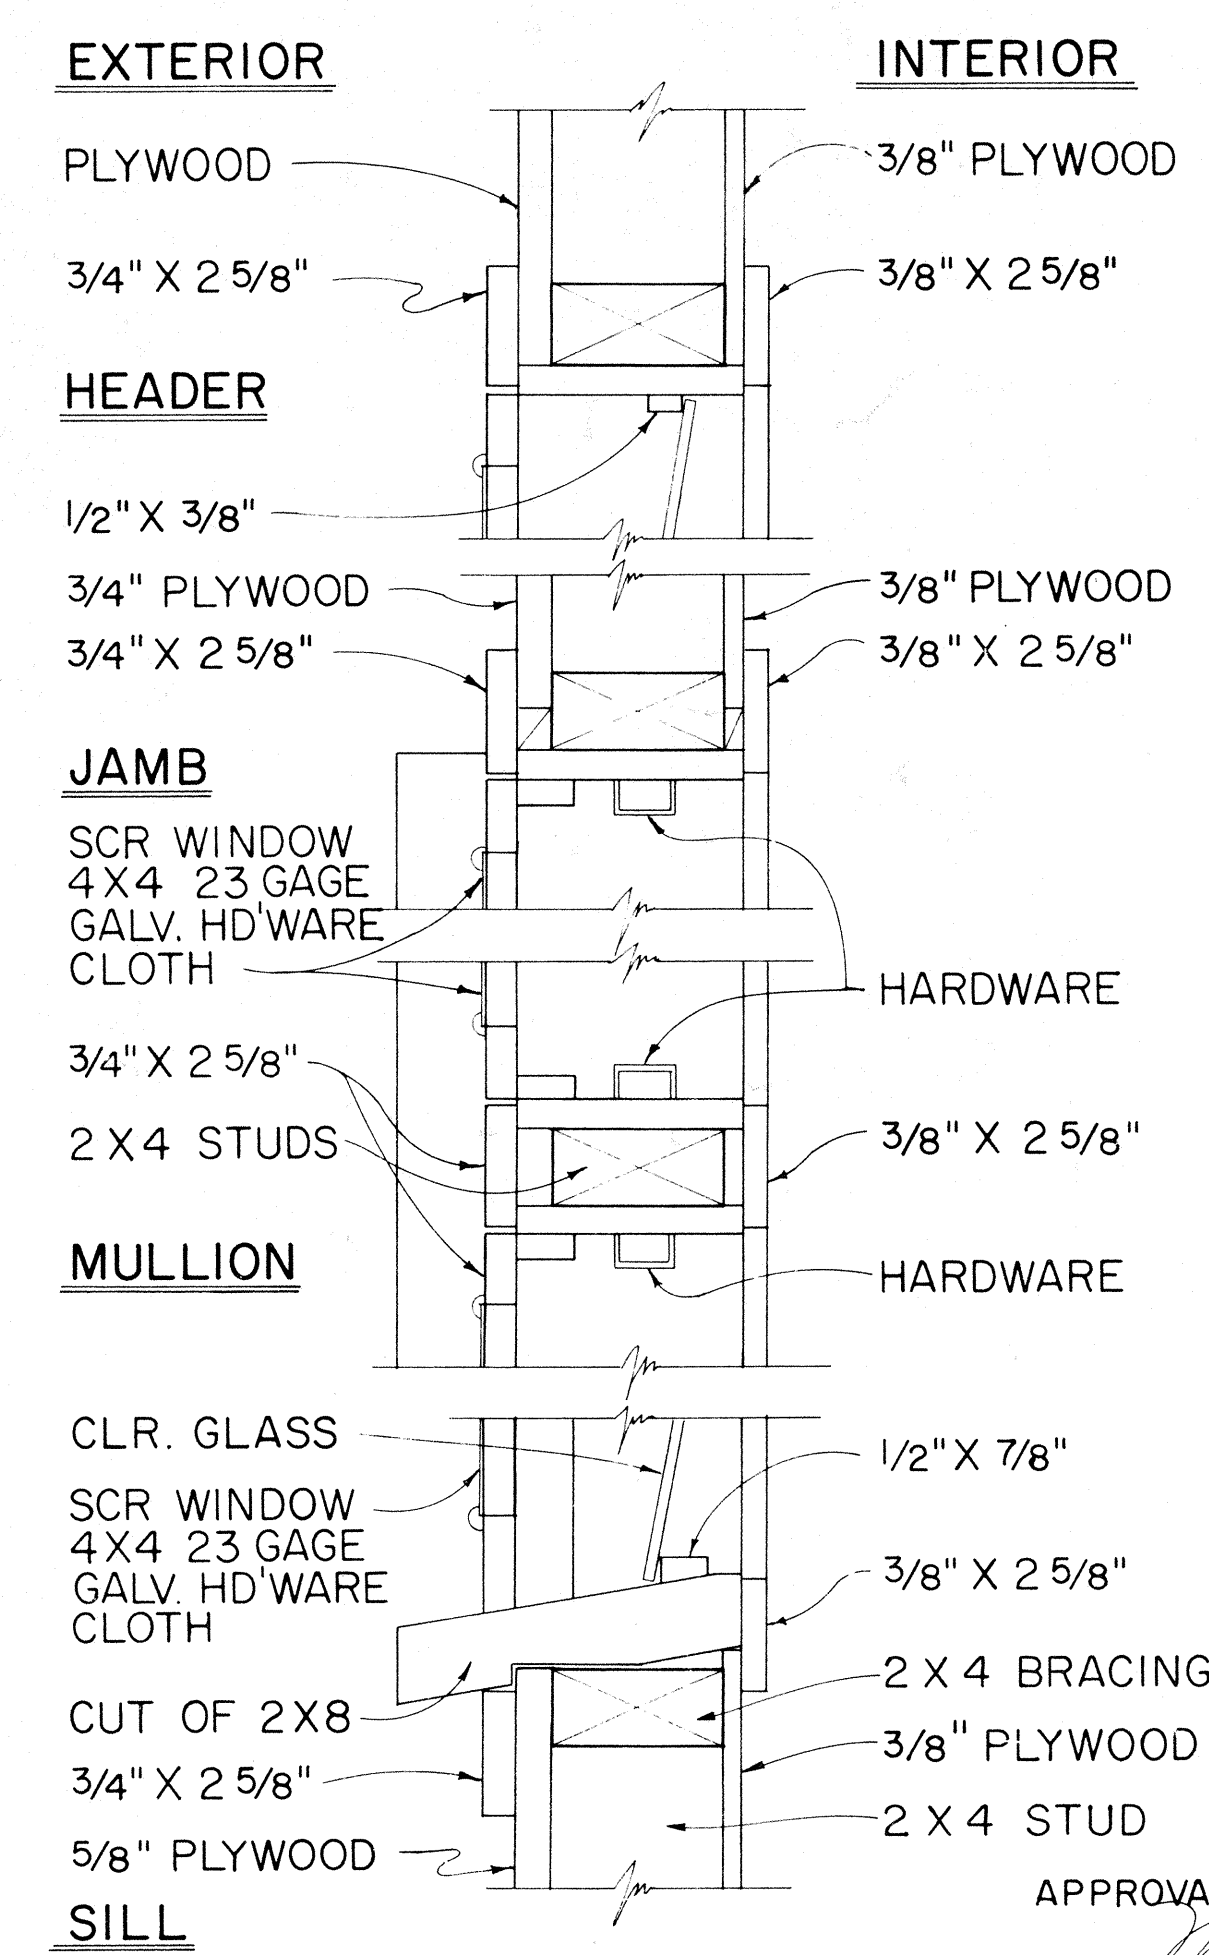

TYPICAL DETAIL JALOUSIES WINDOWS

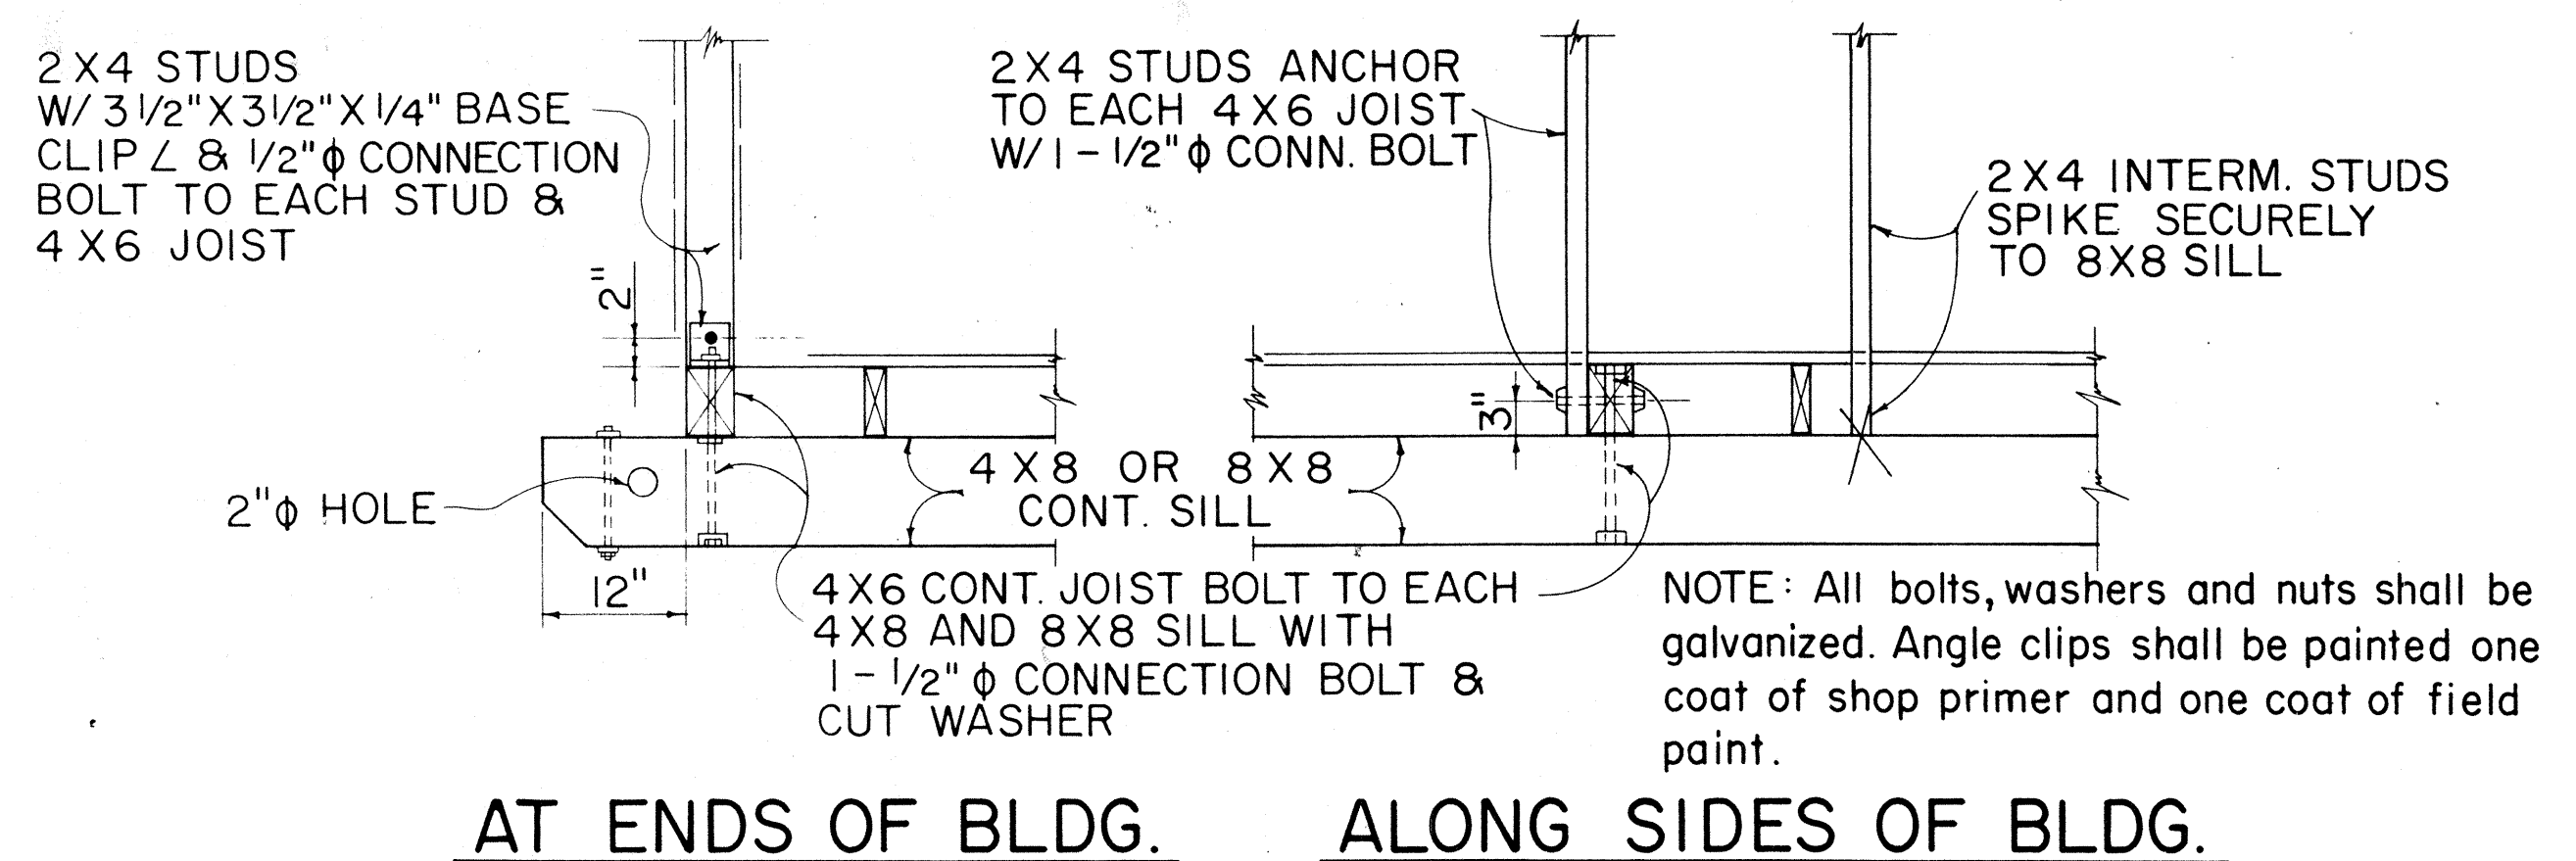

TYPICAL 2 X 4 STUD & 4 X 6 FLOOR JOIST BASE CONNECTION DETAILS

APPROVAL RECOMMENDED:
HIGHWAY DESIGN ENGINEER
DATE 12-4-69

APPROVED:
ASSISTANT CHIEF, ENGINEERING
DATE 12-10-69

NO.	REVISION	APPROVED BY	DATE

STATE OF HAWAII
DEPARTMENT OF TRANSPORTATION
HIGHWAYS DIVISION

FIELD OFFICE
&
PROJECT SITE LABORATORY


Scale: As Noted

SHEET No. OF SHEETS DD 636.5


FED. ROAD DIST. NO.	STATE	FED. AID PROJ. NO.	FISCAL YEAR	SHEET NO.	TOTAL SHEETS
HAWAII	HAW.	F-011-2(17)	1986	34	142

GENERAL NOTES

1. Both of the alternate type posts may be used on any one project however, only one type of post shall be used in any single run of guardrail.
2. All hardware, posts and blocks shall be galvanized. No punching, drilling or cutting will be permitted after galvanizing.
3. Connection details for bent plate post and block shall be similar to the details shown for structural shape post, and block.
4. Where conditions require, special post lengths in increments of 6 inches may be specified.
5. For details of rail elements, bolts and nuts, see sheet DT 501.
6. All fasteners, posts, blocks and rail elements shall conform to the latest edition and amendments of "A Guide to Standardized Highway Barrier Rail Hardware," a report prepared and approved by the AASHTO-AGC-ARTBA Joint Cooperative Committee.

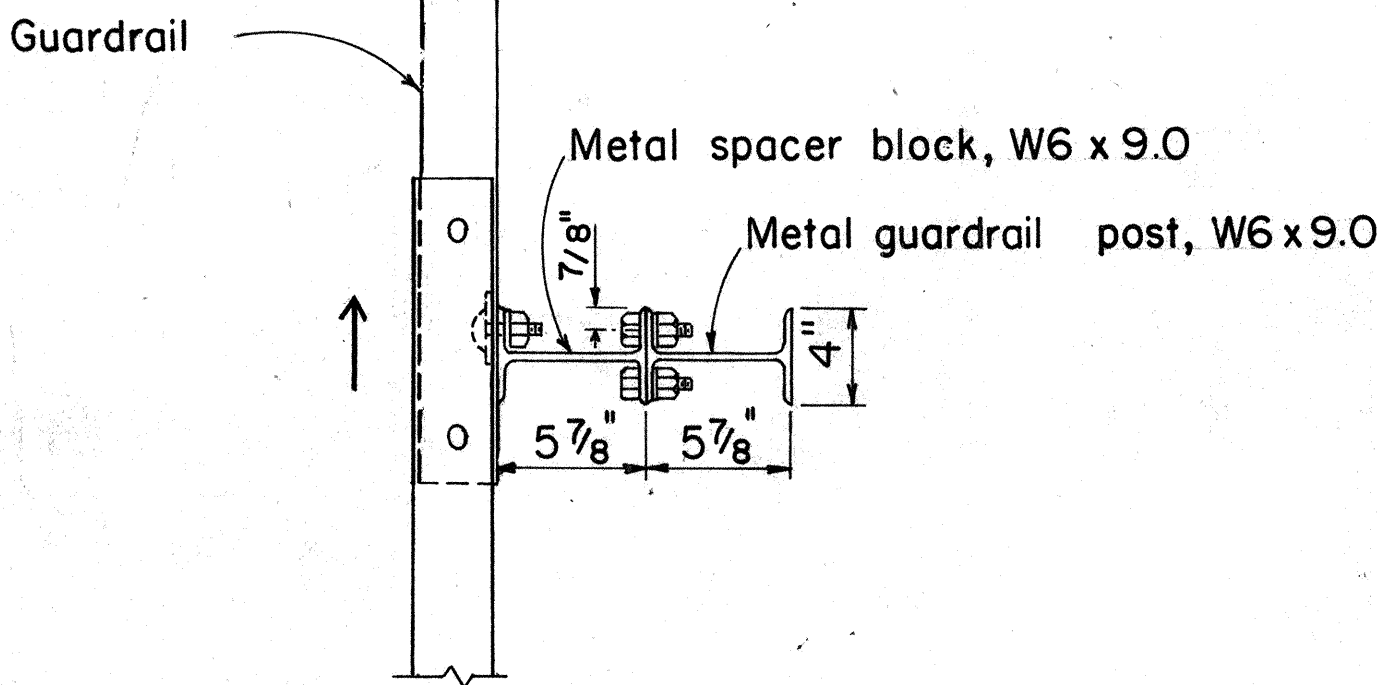


PLAN

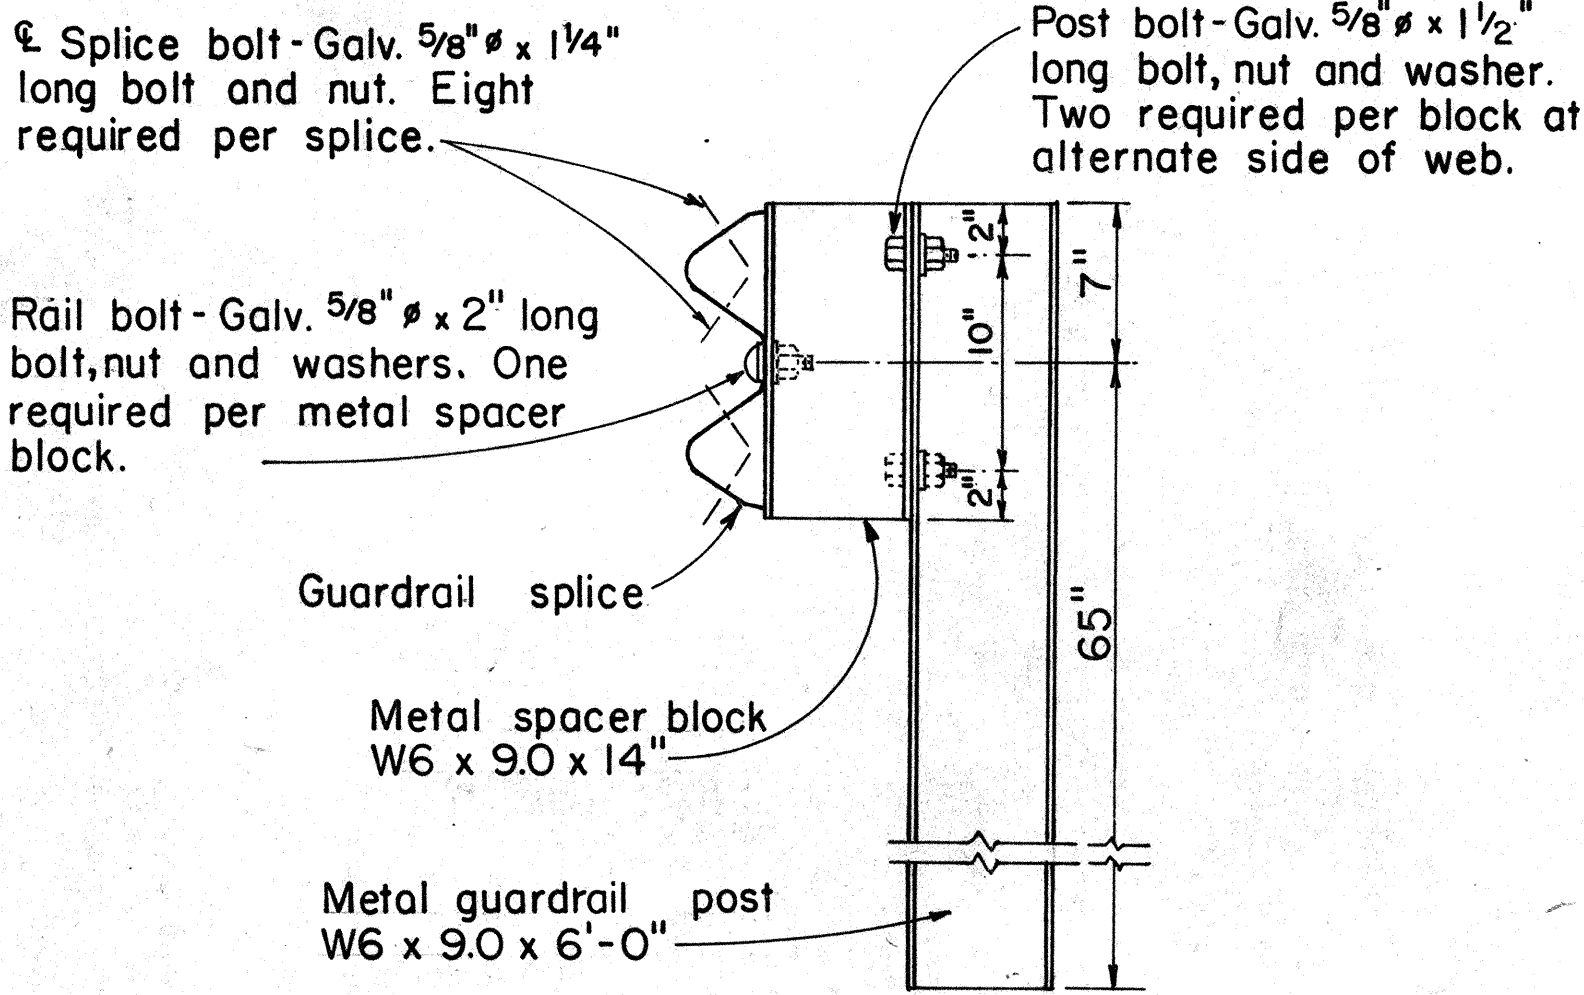

ELEVATION

SINGLE METAL GUARDRAIL ON METAL POST WITH METAL SPACER BLOCK

SCALE: 1 1/2" = 1'-0"

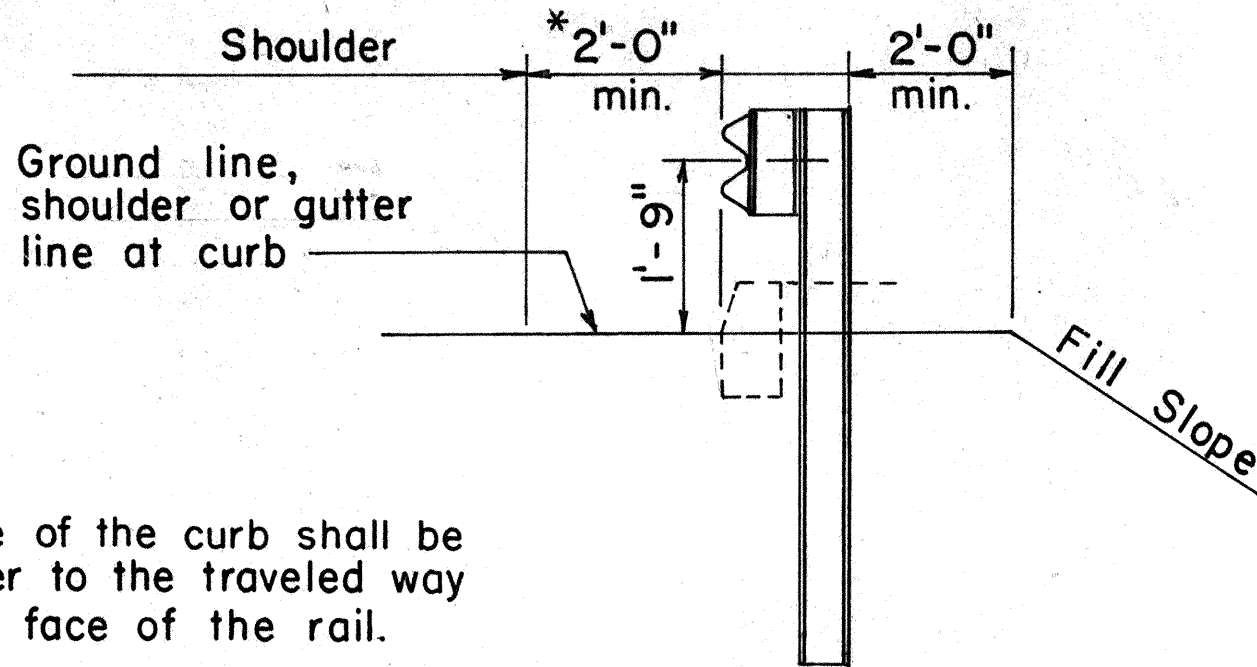


AT SHOULDER SECTION

TYPICAL METAL GUARDRAIL DETAIL

SCALE: 1/2" = 1'-0"

Note:
The face of the curb shall be no closer to the traveled way than the face of the rail.

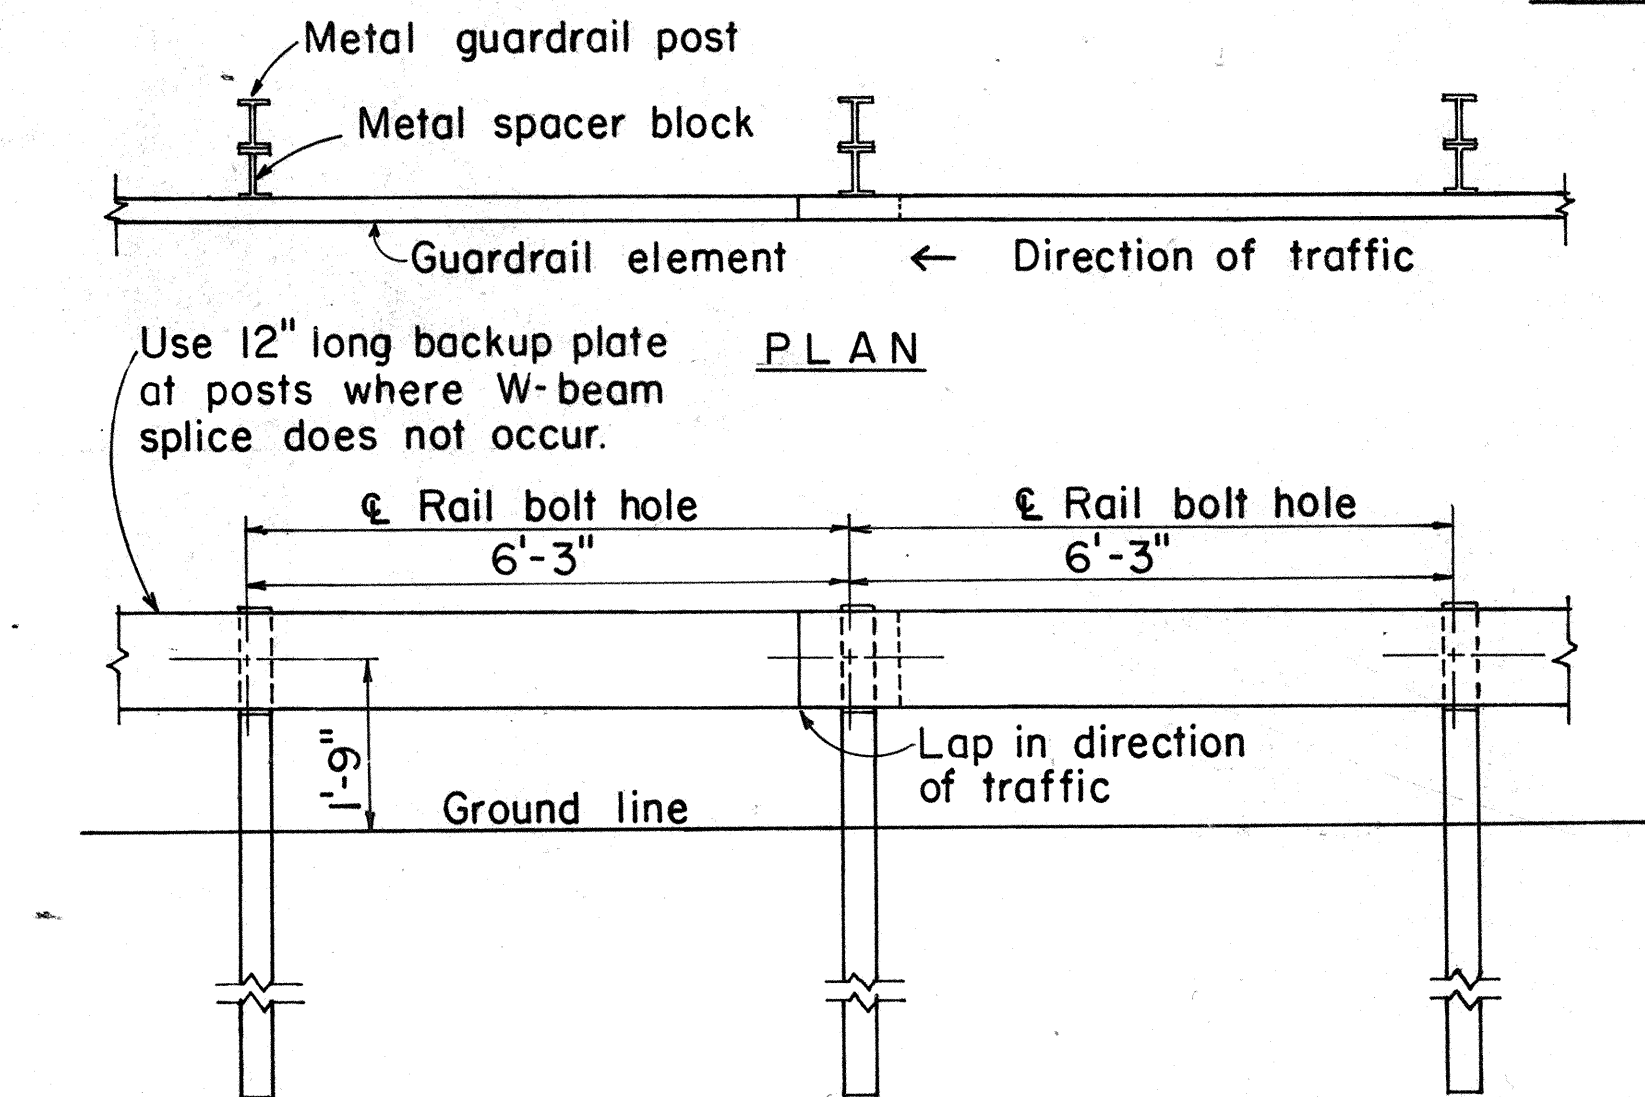


PLAN


ELEVATION

METAL GUARDRAIL ON METAL POST WITH METAL SPACER BLOCK

SCALE: 1/2" = 1'-0"

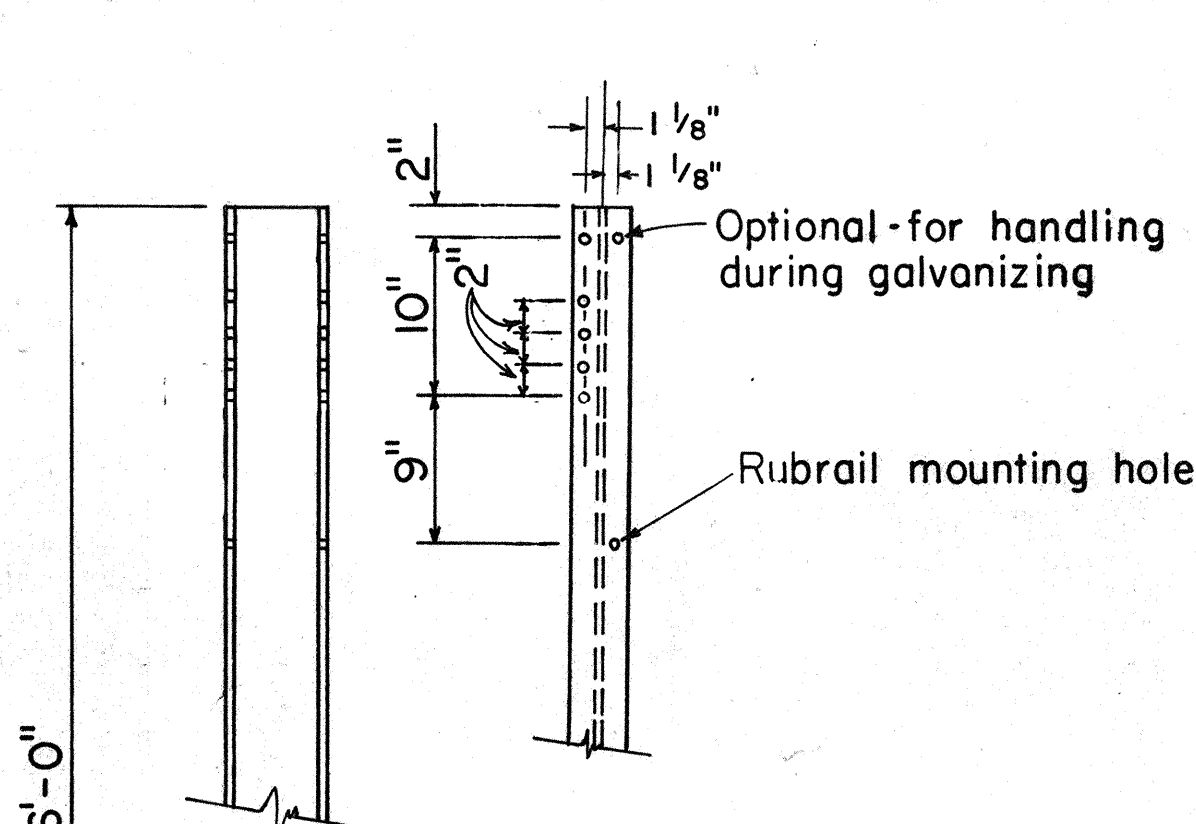


NOTE:
All holes 13/16 inch diameter. Bolt hole pattern is symmetrical with respect to the vertical axis of the post.

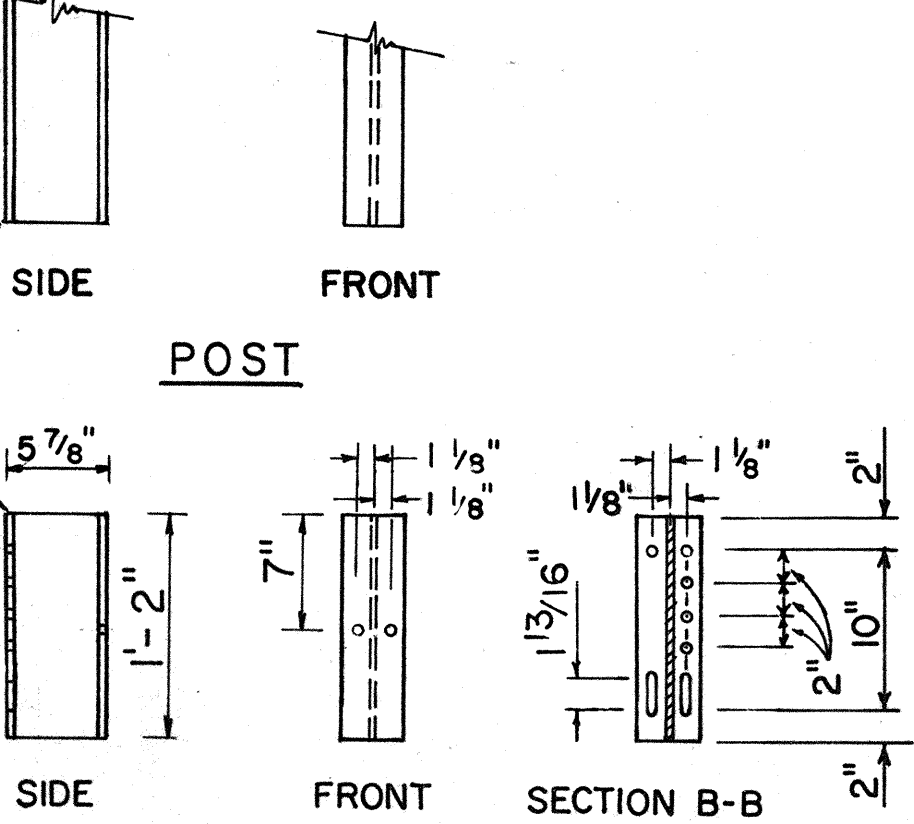


BLOCK

STRUCTURAL SHAPE POST AND BLOCK


SCALE: 1" = 1'-0"

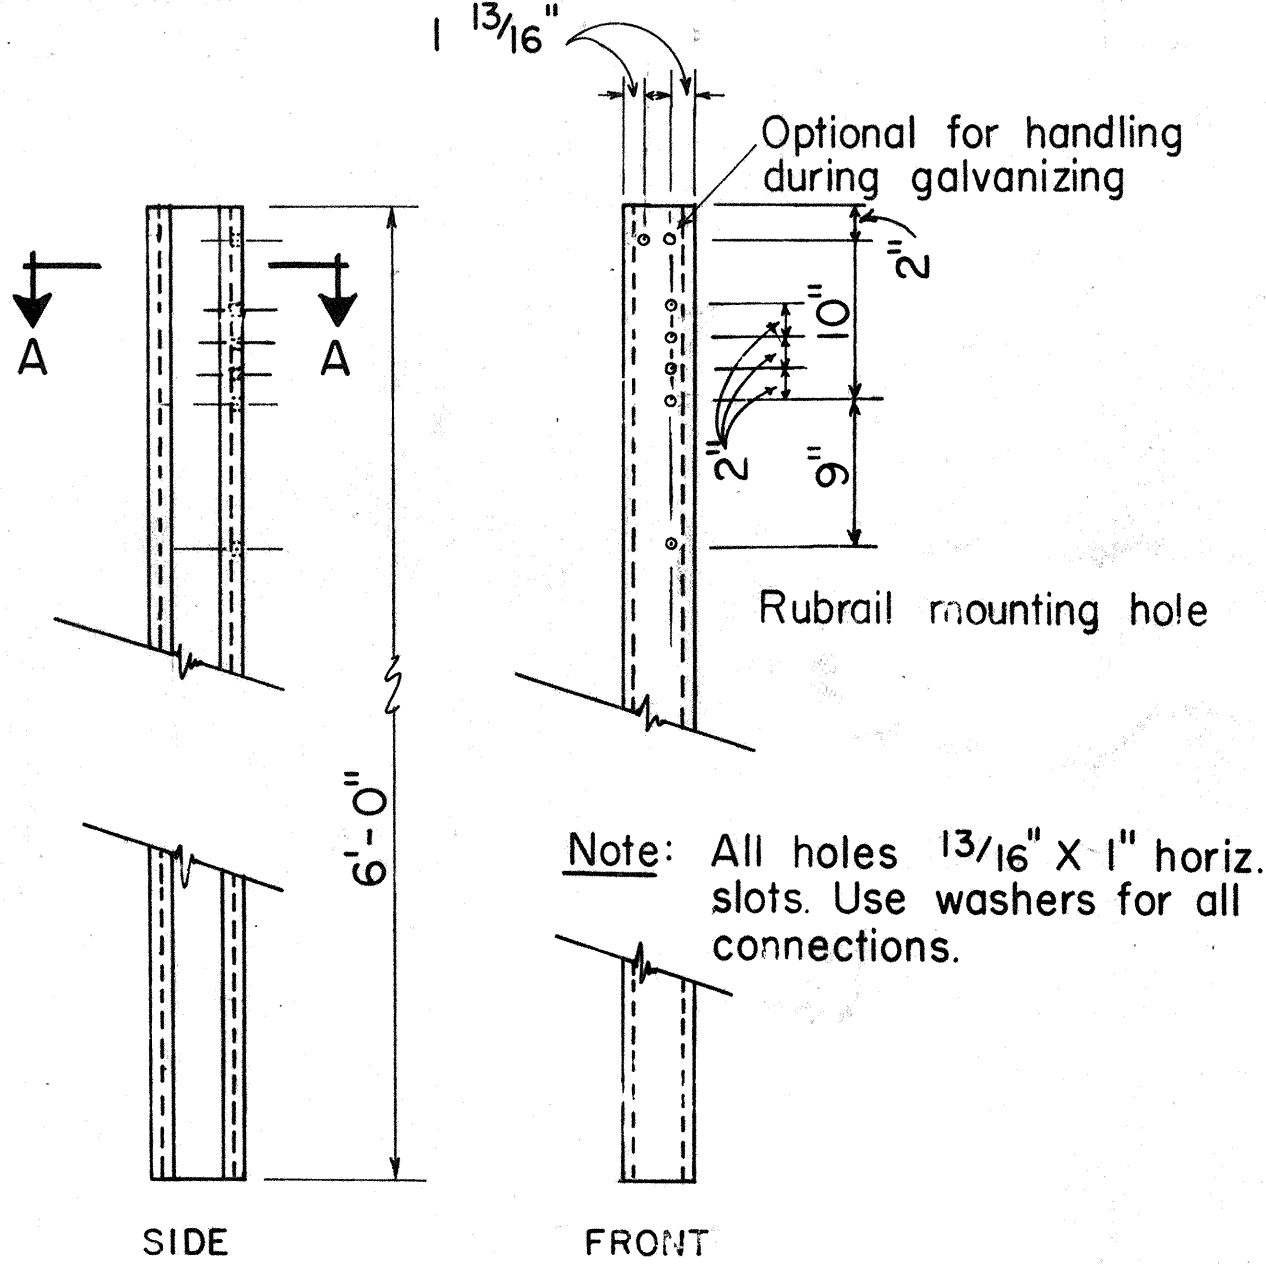

POST

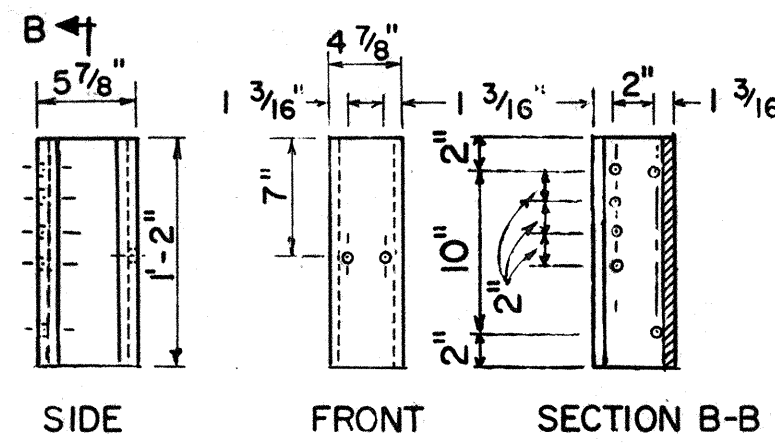


BLOCK

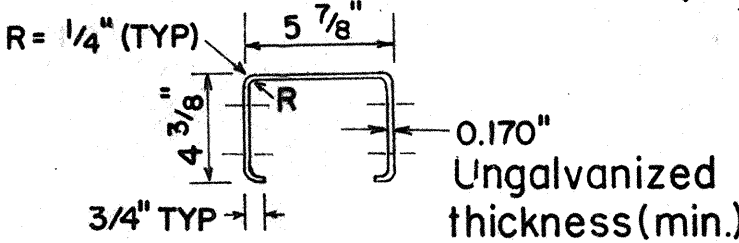

SECTION A-A
N.T.S.

BENT PLATE POST AND BLOCK

SCALE: 1" = 1'-0"

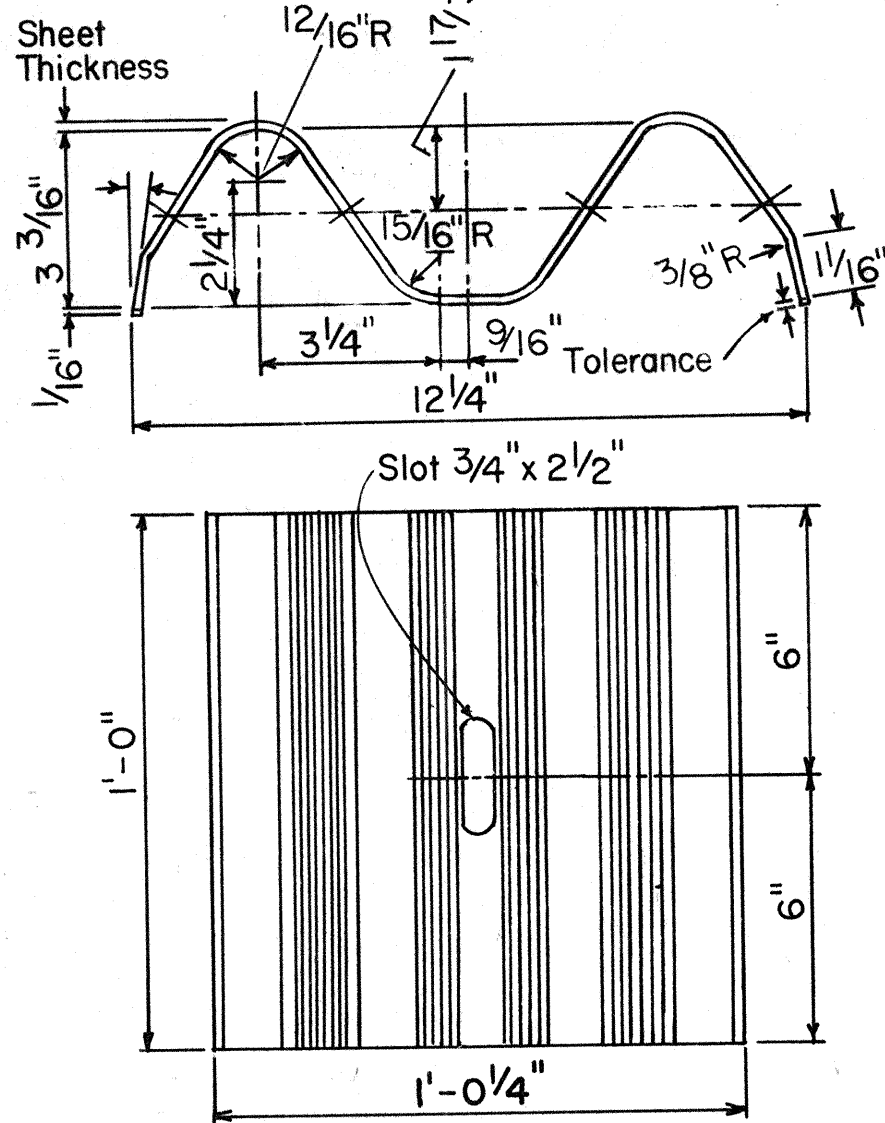

BACK-UP-PLATE
N.T.S.

APPROVAL RECOMMENDED:
Erich Tanaka
TRAFFIC ENGINEER
9/1/82
DATE

APPROVED:
Robert Zaleski
ASSISTANT CHIEF, ENGINEERING
9/22/82
DATE

NO.	REVISION	APPROVED BY	DATE
1	Supersedes sht. DT 500 approved 12/30/69.	H.P.	9/22/82
2	Added General Notes No. 6	J.D.	9-28-83
3	Added details for adjusting guardrail height and added Back-up Plate	E.T.	9/18/85

STATE OF HAWAII
DEPARTMENT OF TRANSPORTATION
HIGHWAYS DIVISION


STANDARD DETAILS
METAL GUARDRAIL

Scale: As Shown
SHEET No. 34 OF SHEETS DT 500

July, 1982


DATE	_____
SURVEY PLOTTED BY	_____
DRAWN BY	_____
TRACED BY	_____
NOTED BY	_____
CHECKED BY	_____
ORIGINAL PLAN	_____
NOTE BOOK	_____
No.	_____

FED. ROAD DIST. NO.	STATE	FED. AID PROJ. NO.	FISCAL YEAR	SHEET NO.	TOTAL SHEETS
HAWAII	HAW.	F-011-2 (17)	1986	35	142


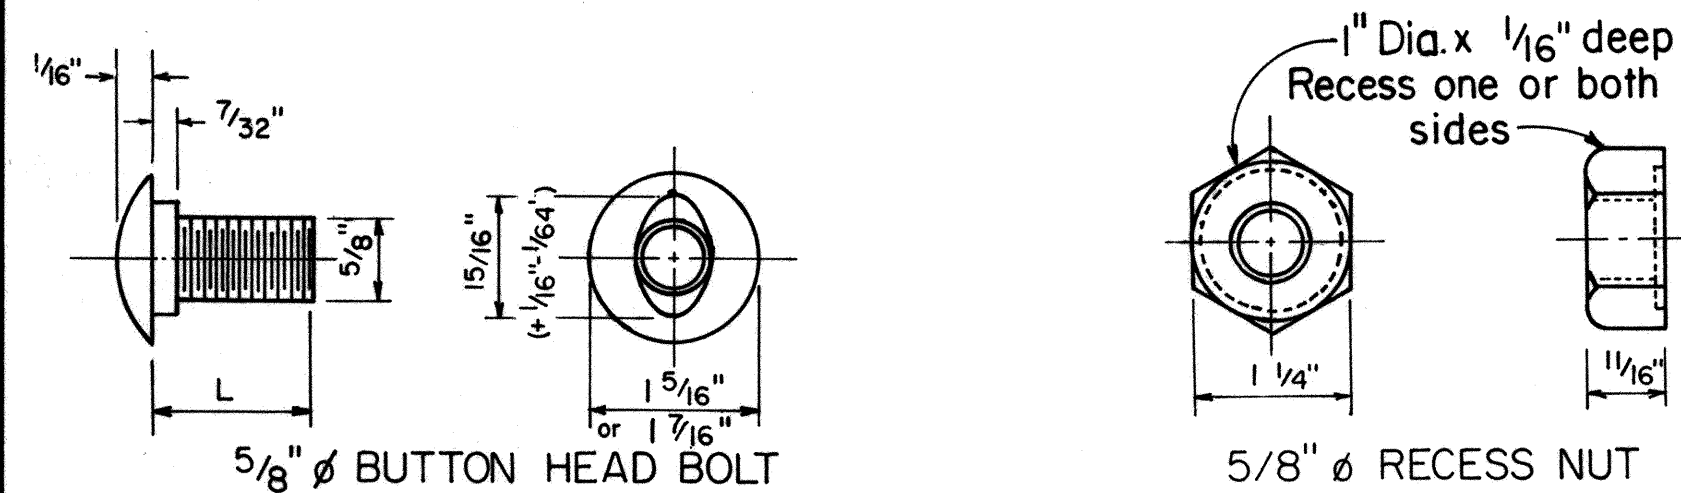


L	Thread Length	Intended Use
1 1/4"	Full length thread	Splice rail elements
2"	1 1/2" min. thread len.	Fasten rails to posts



**5/8" BUTTON HEAD BOLT
AND RECESS NUT**
Scale: N.T.S.

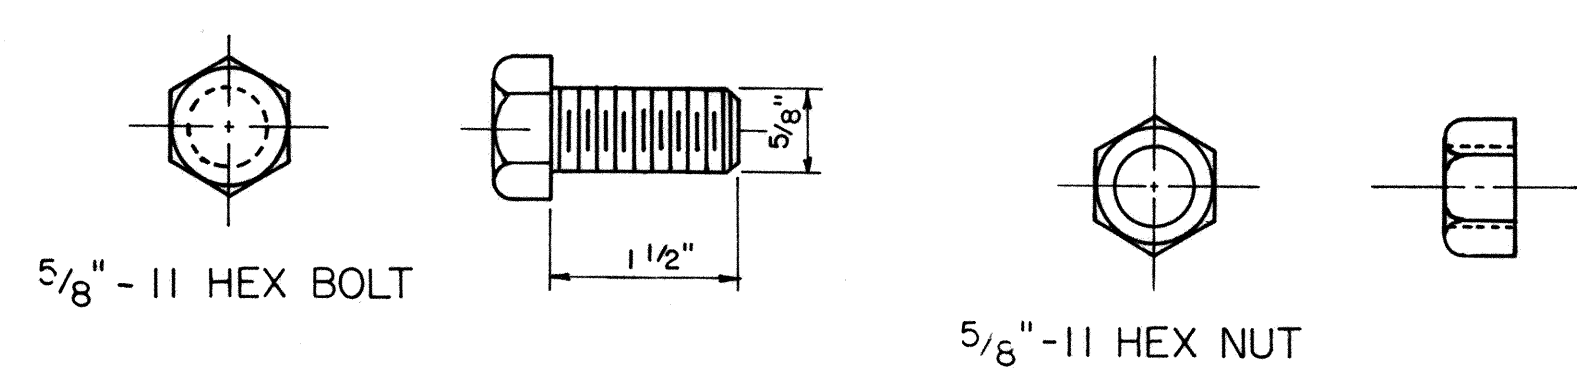


5/8" HEX POST BOLT AND NUT
Scale: N.T.S.

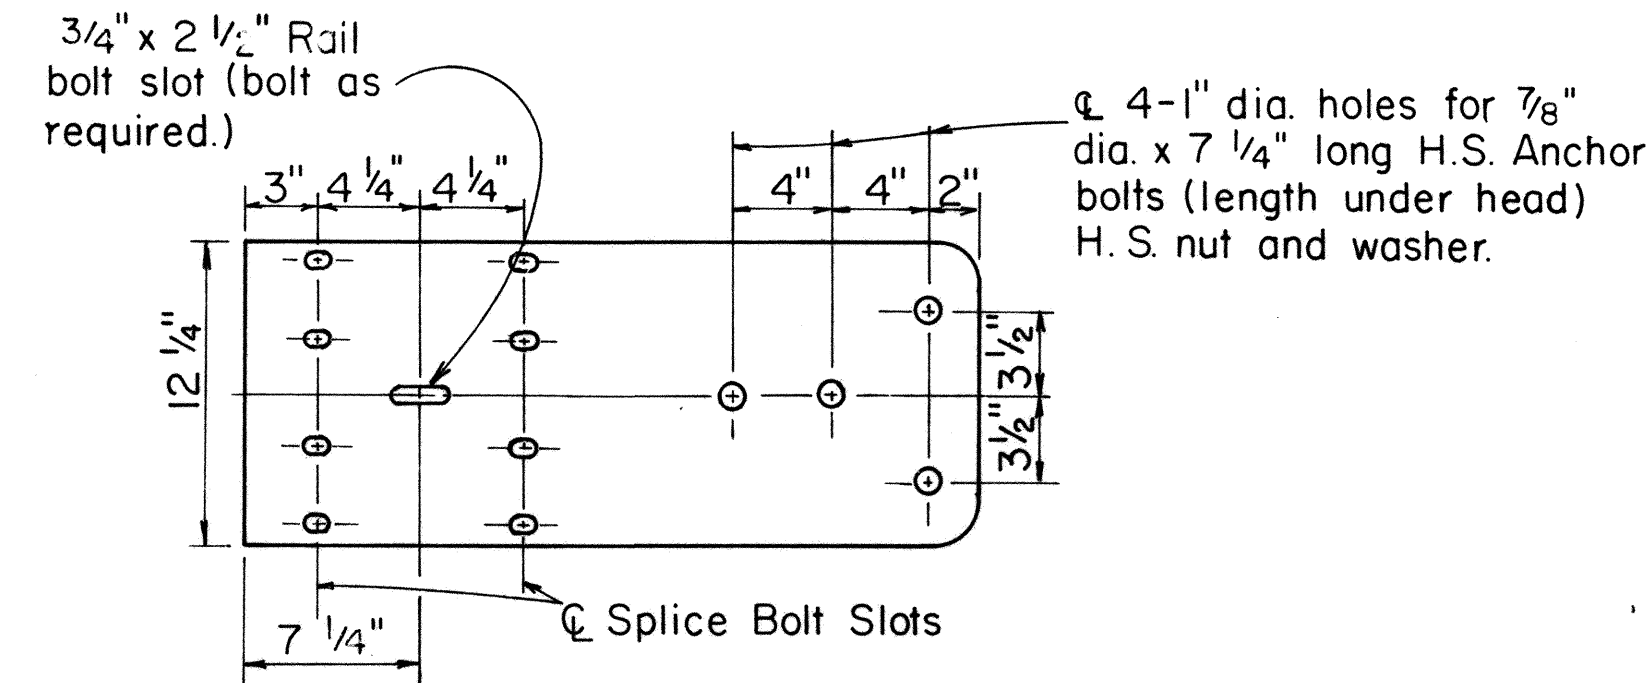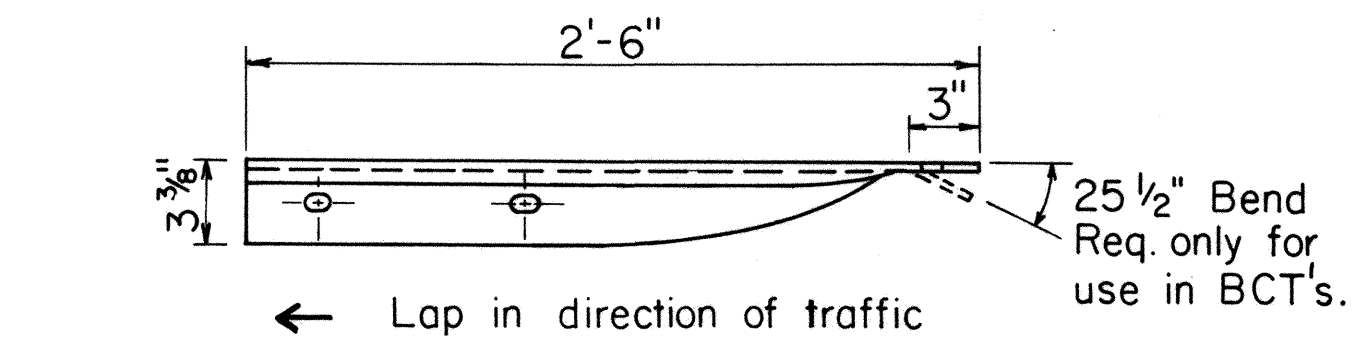


W BEAM TERMINAL CONNECTOR
Scale: 1 1/2" = 1'-0"

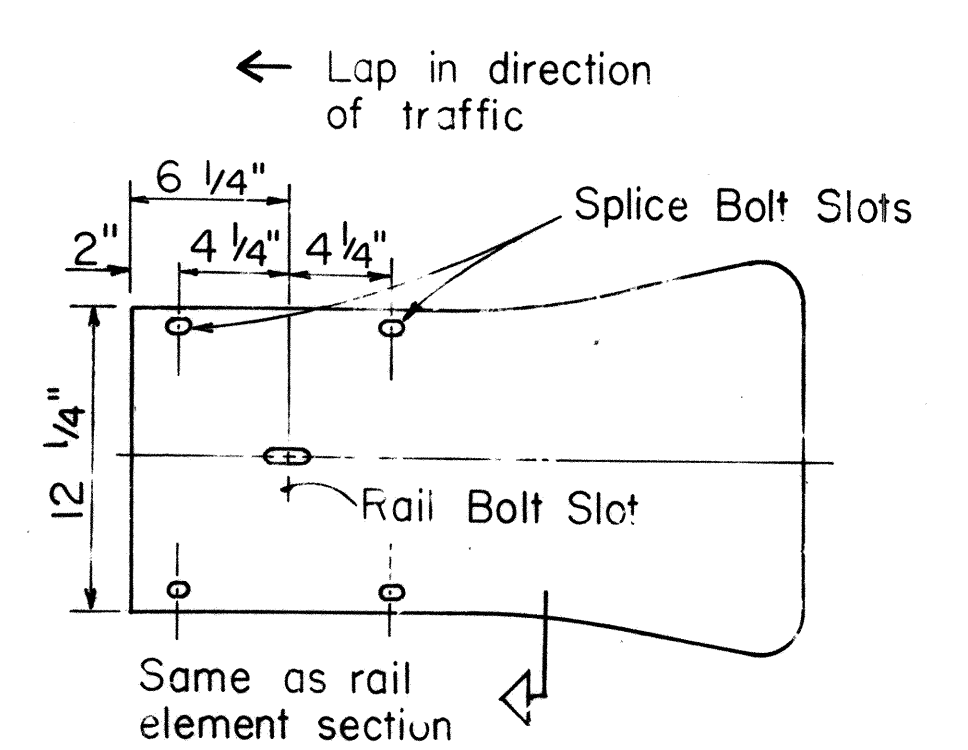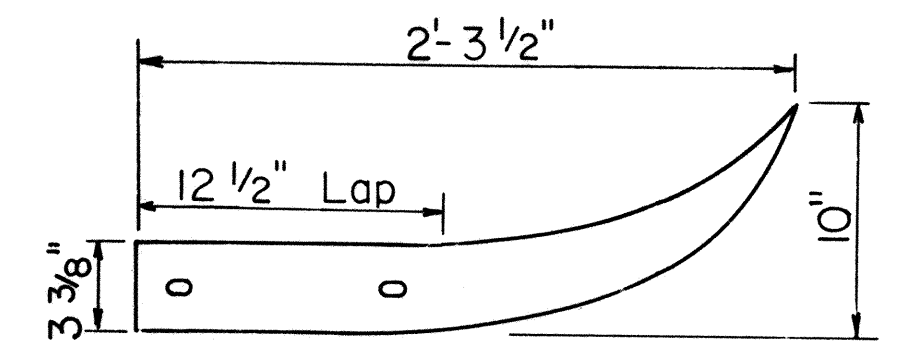


W BEAM END SECTION (FLARED)
Scale: 1 1/2" = 1'-0"

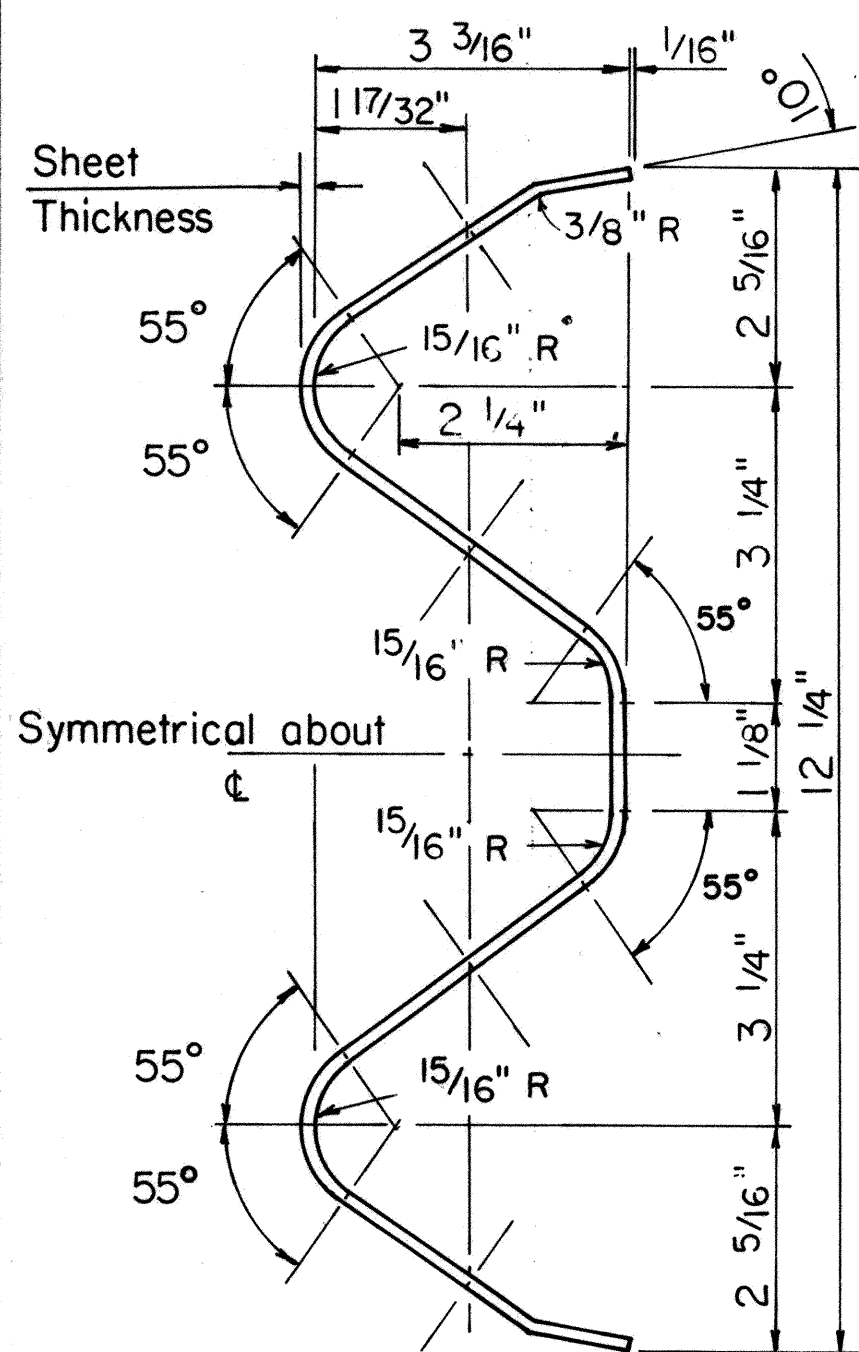


RAIL ELEMENT SECTION
Scale: 6" = 1'-0"

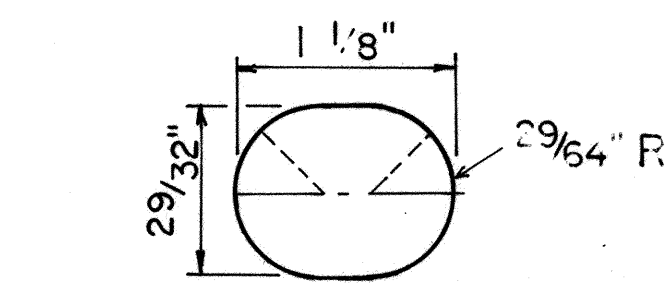

SPLICE BOLT SLOT

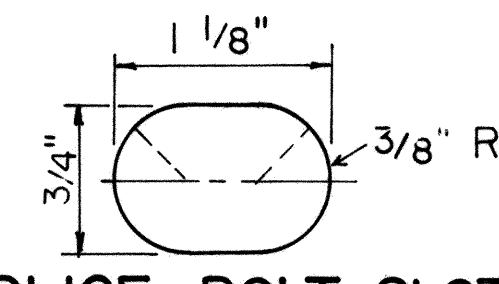


**SPLICE BOLT SLOT
FOR ALL ENDS**

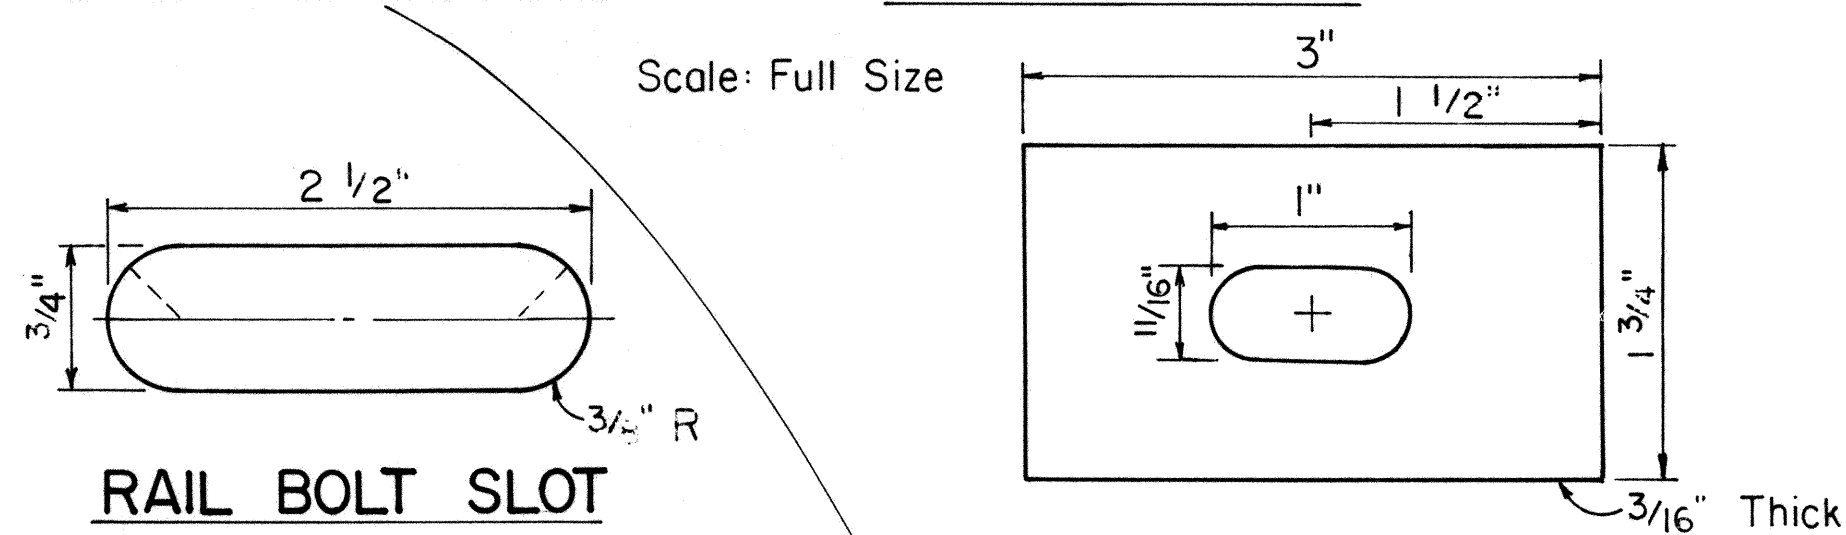


RAIL BOLT SLOT




RAIL BOLT WASHER

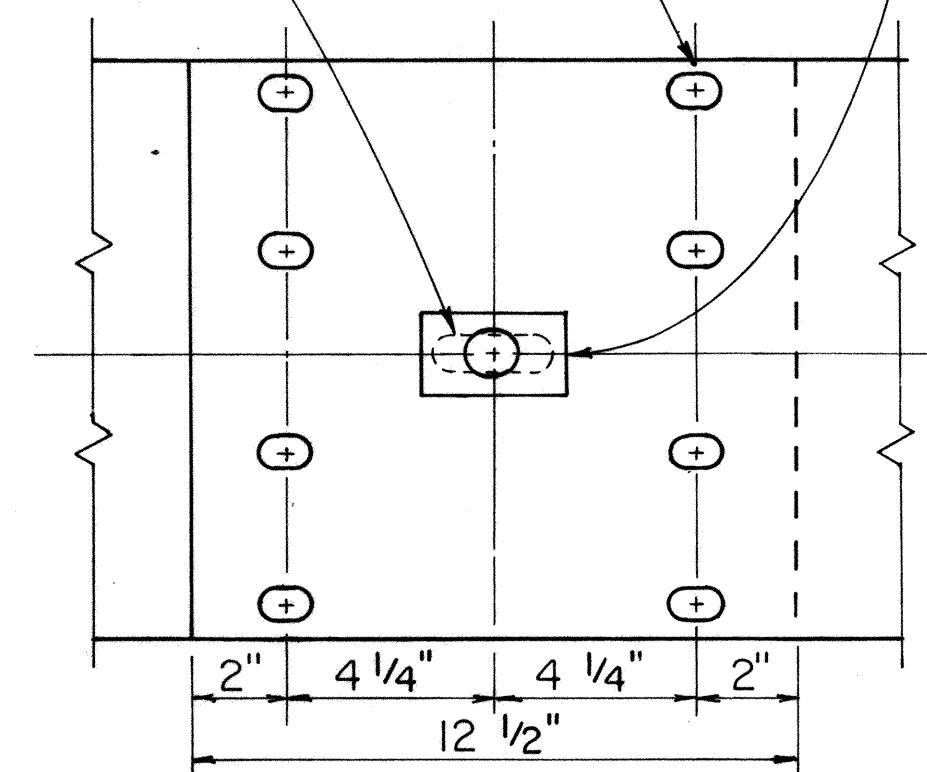

RAIL SPLICE
Scale: 3" = 1'-0"

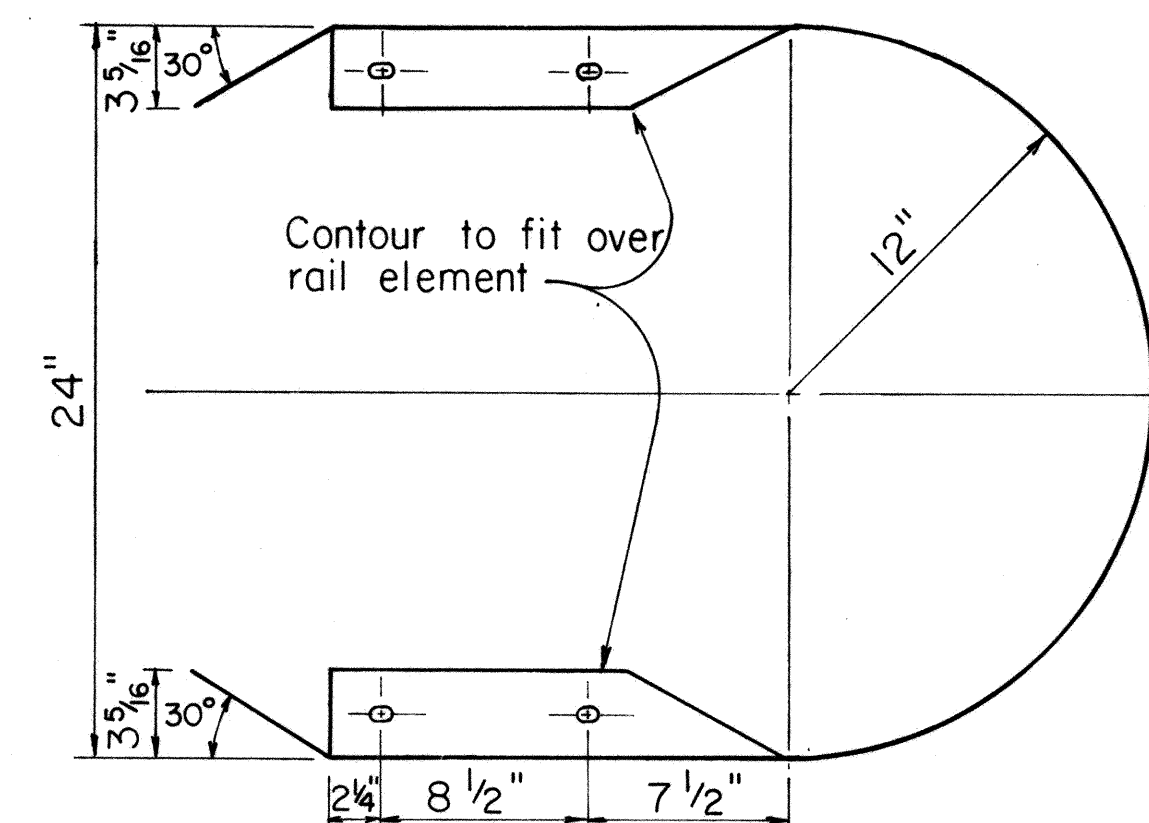

W BEAM END SECTION (BUFFER)
Scale: 1 1/2" = 1'-0"

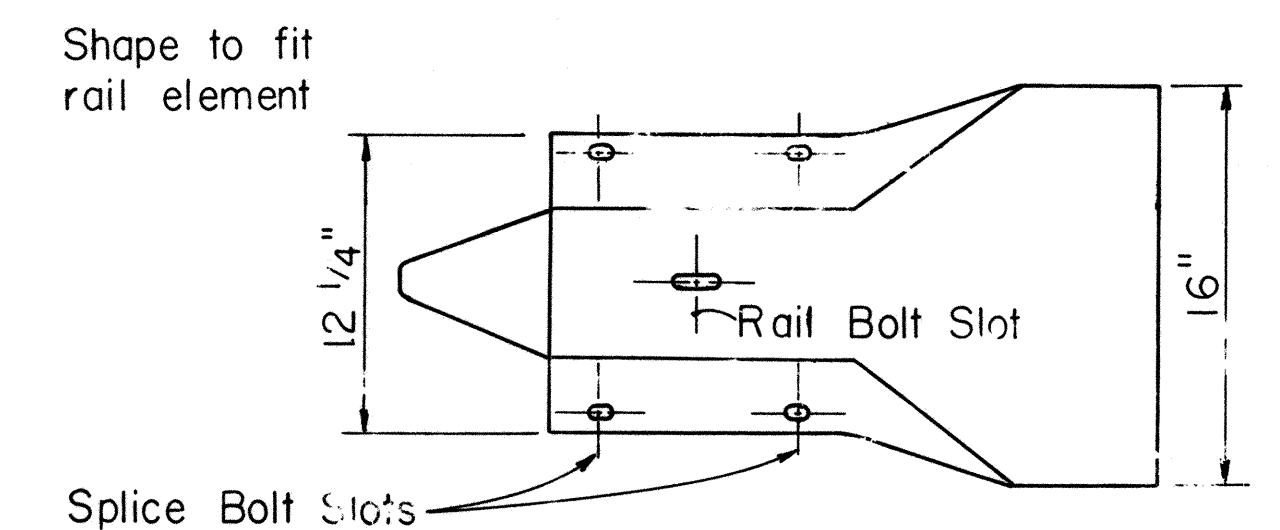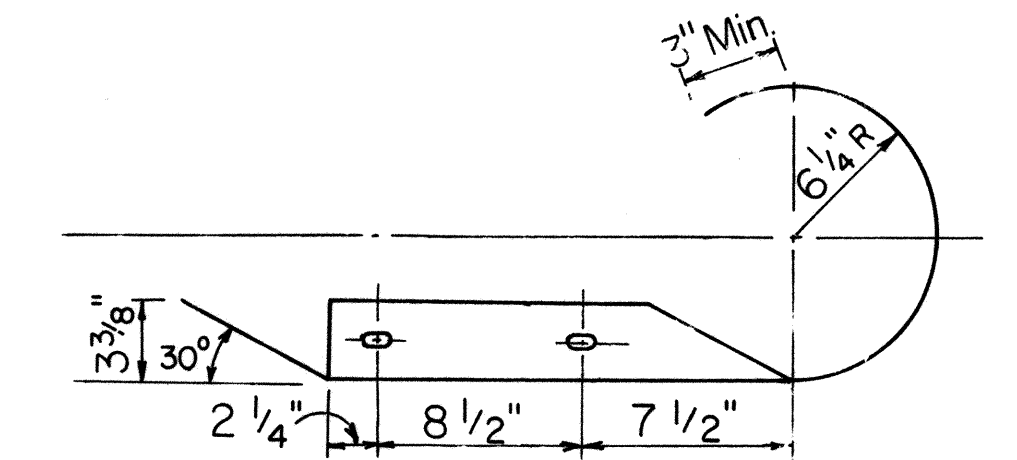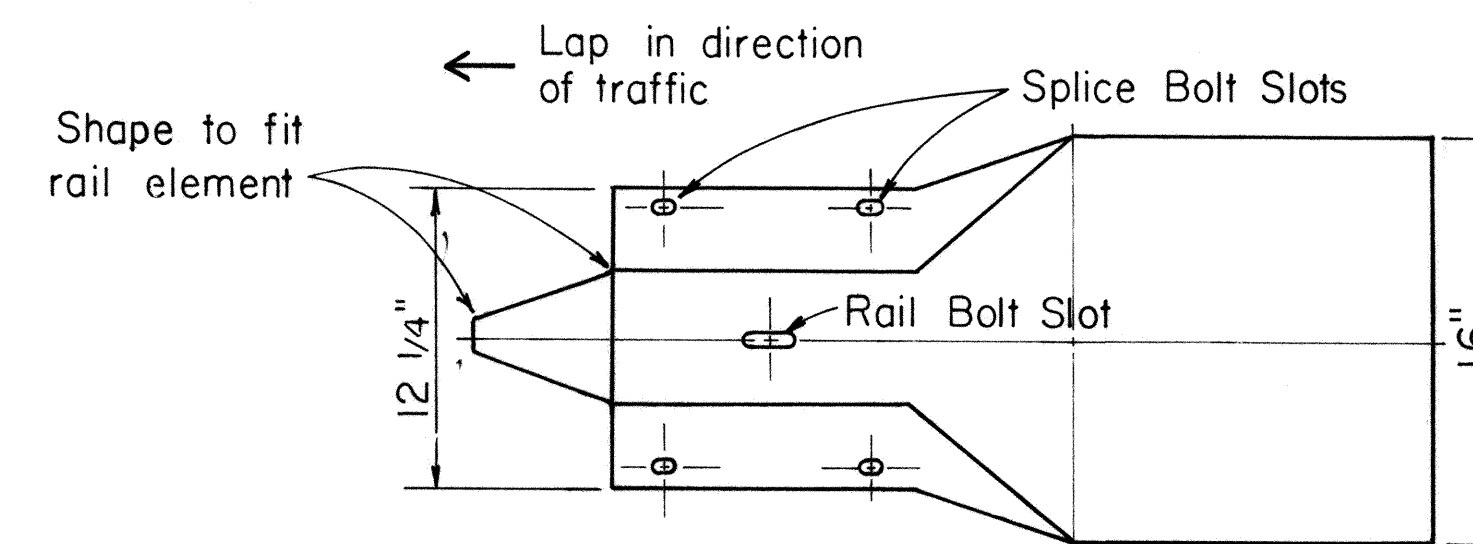

W BEAM END SECTION (ROUNDED)
Scale: 1 1/2" = 1'-0"

APPROVAL RECOMMENDED:
Erich Tanaka 9/20/82
TRAFFIC ENGINEER DATE

APPROVED:
Harold S. S. S. 9/22/82
ASSISTANT CHIEF, ENGINEERING DATE







NO.	REVISION	APPROVED BY	DATE
1	Supersedes sht. DT 501 approved 12/30/69	H.T.	9/22/82

STATE OF HAWAII
DEPARTMENT OF TRANSPORTATION
HIGHWAYS DIVISION
STANDARD DETAILS
METAL GUARDRAIL
Scale: As Noted July, 1982
SHEET No. OF SHEETS DT 501

DATE	
SURVEY PLOTTED BY	
DRAWN BY	
TRACED BY	
NOTED BY	
CHECKED BY	
ORIGINAL PLAN	
NOTE BOOK	
No.	

FED. ROAD DIST. NO.	STATE	FED. AID PROJ. NO.	FISCAL YEAR	SHEET NO.	TOTAL SHEETS
HAWAII	HAW.	F-011-2(17)	1986	36	142

NOTE:
 1. Metal guard rail connection to structures requires End Post Connection. See structure plans.
 2. For detail of Breakaway Cable Terminal (BCT) See Sheet No. DT 519

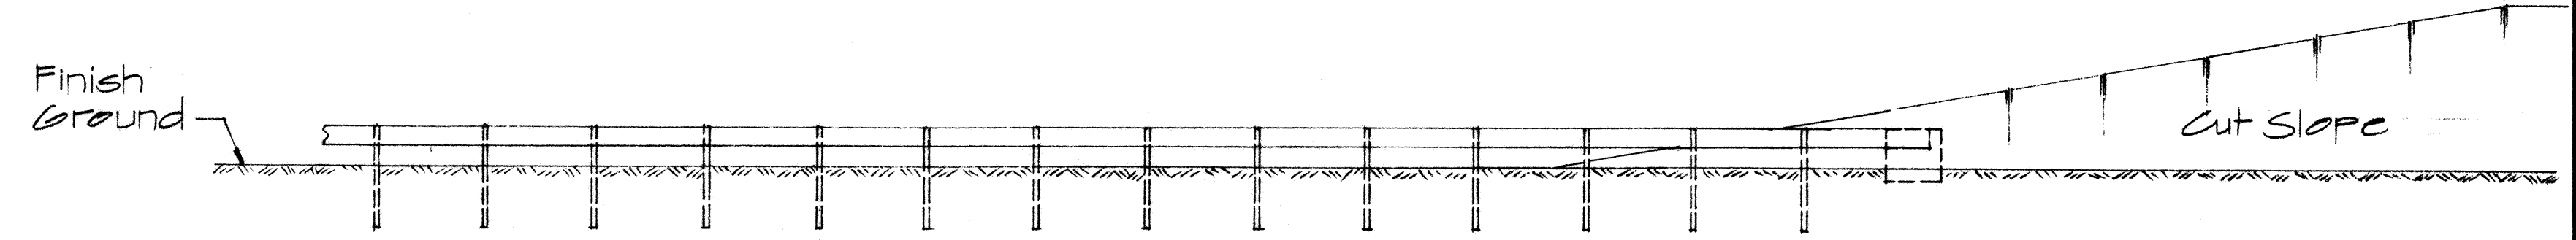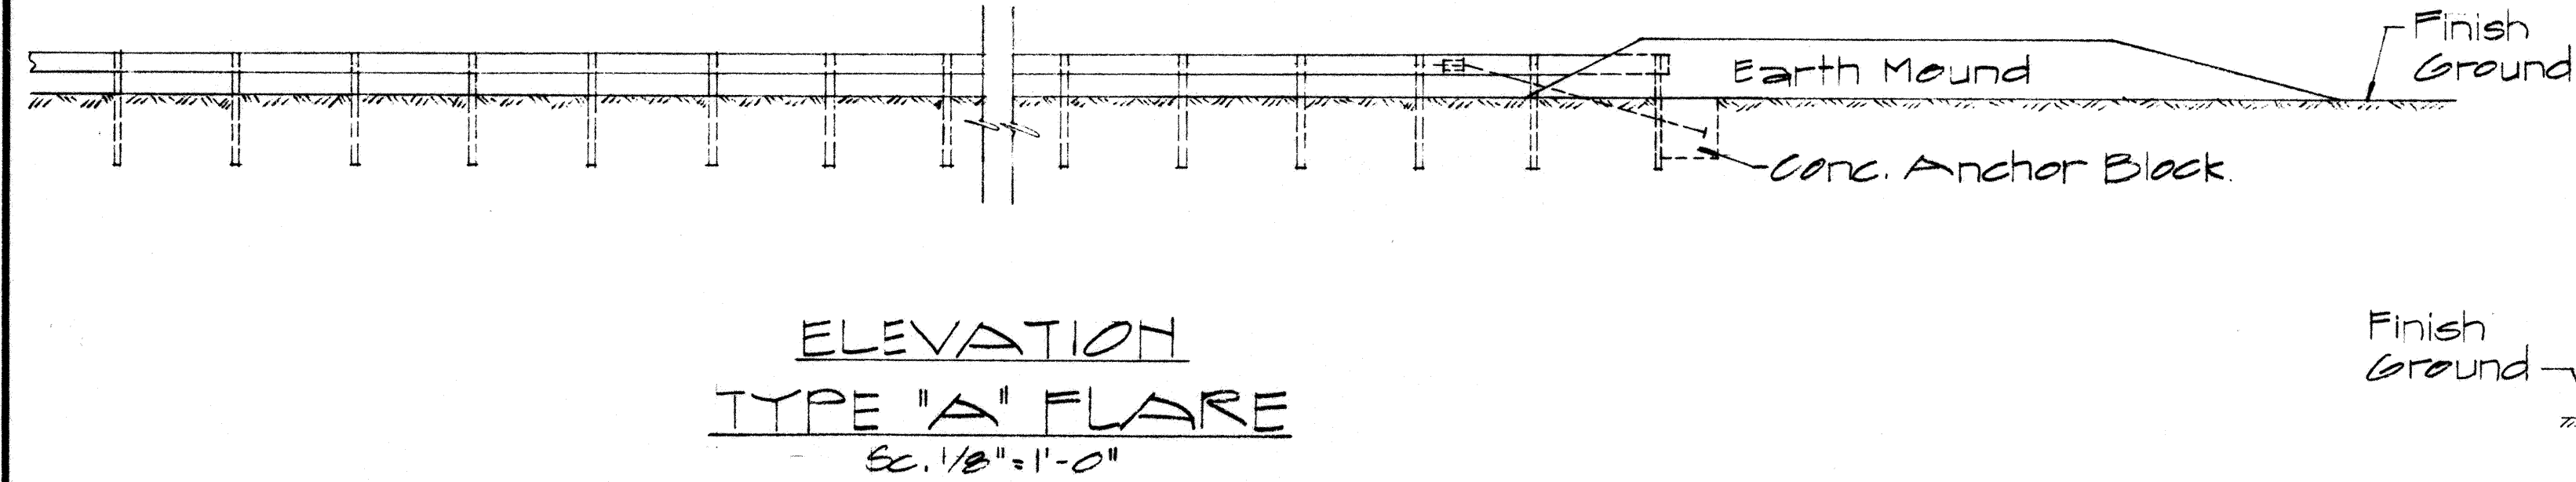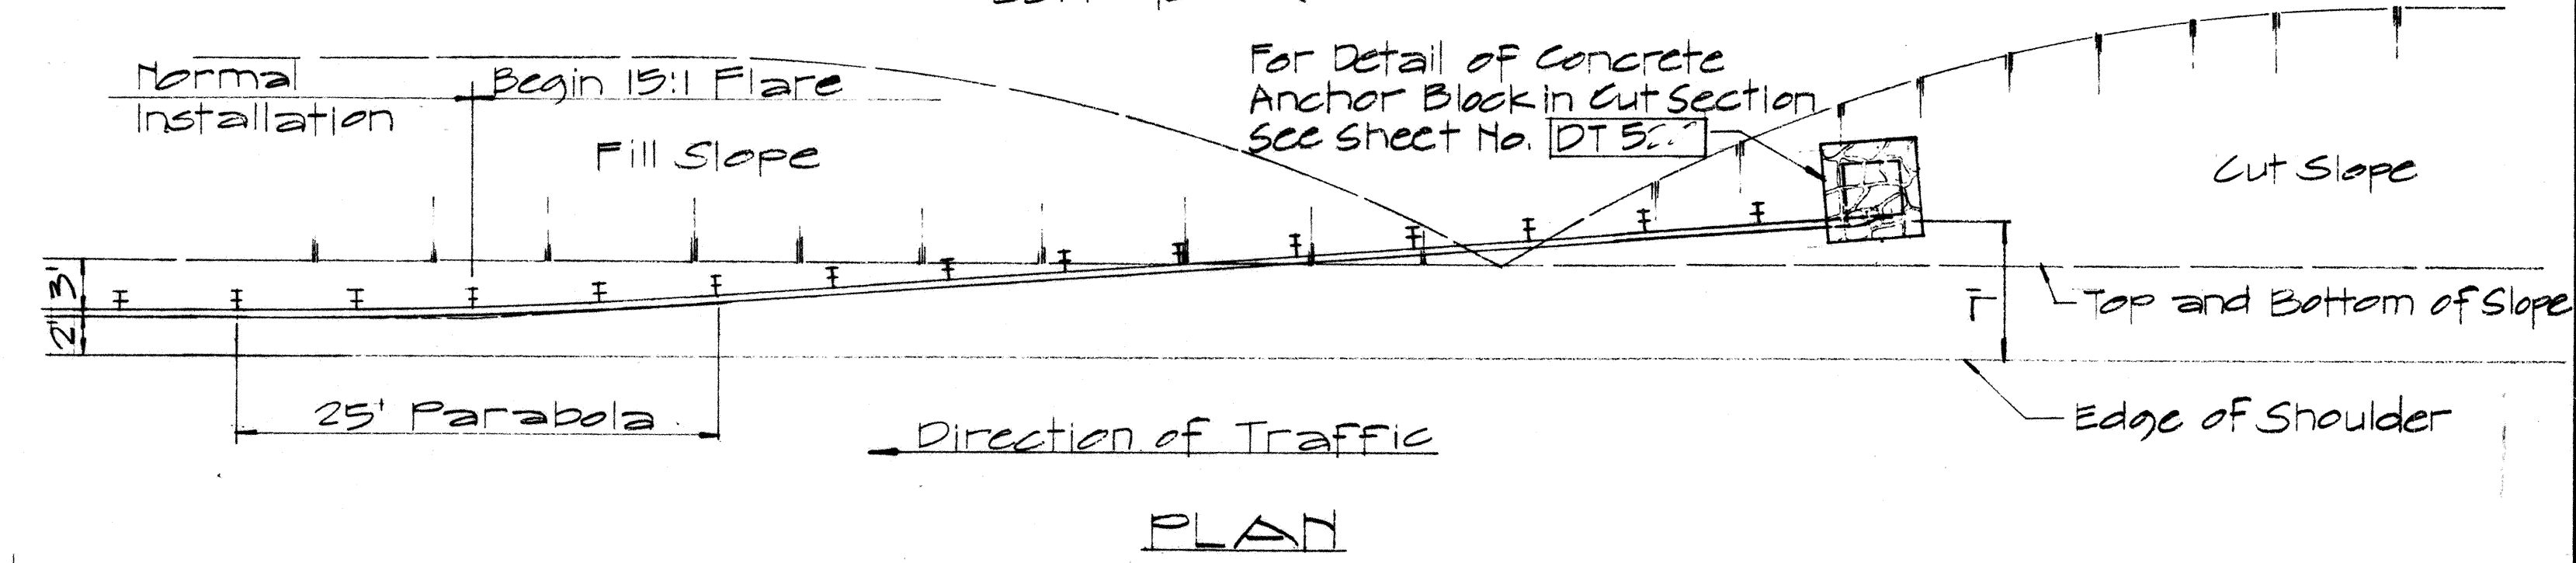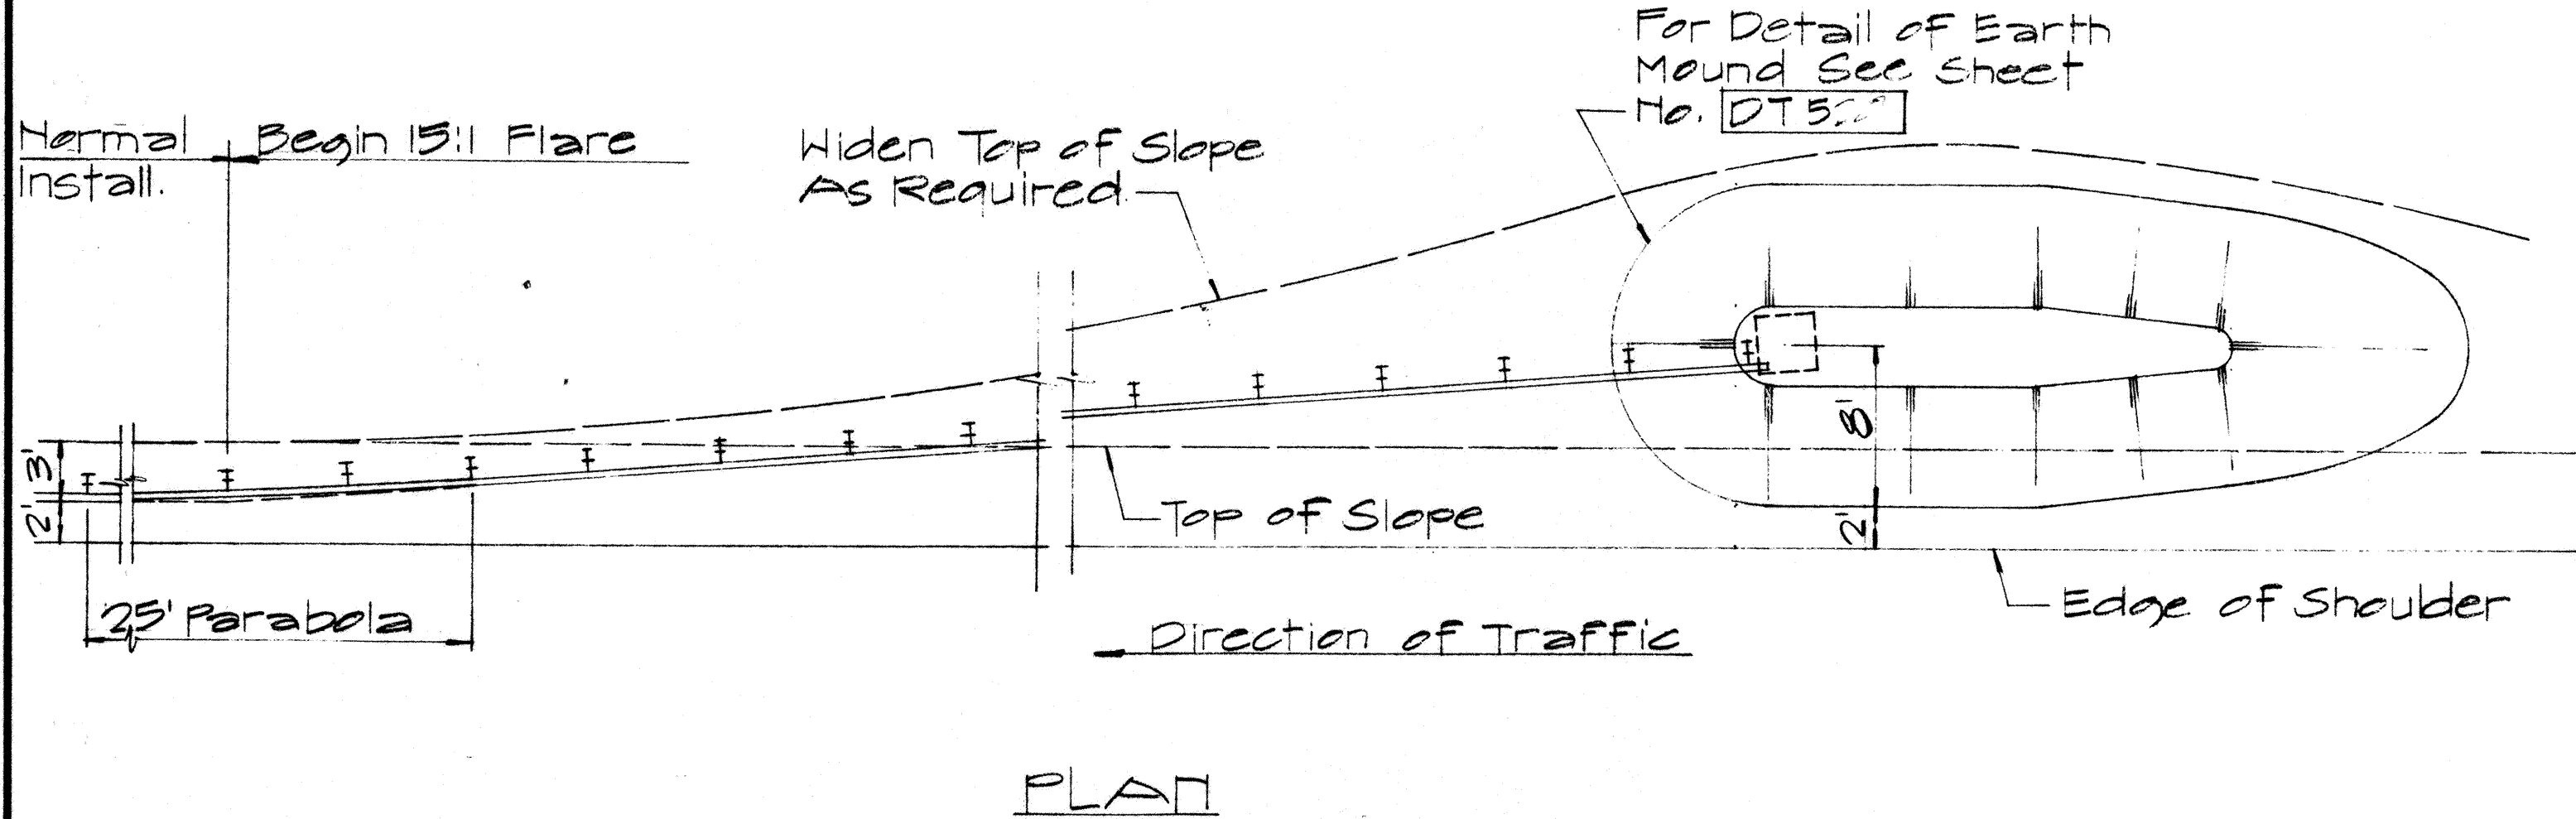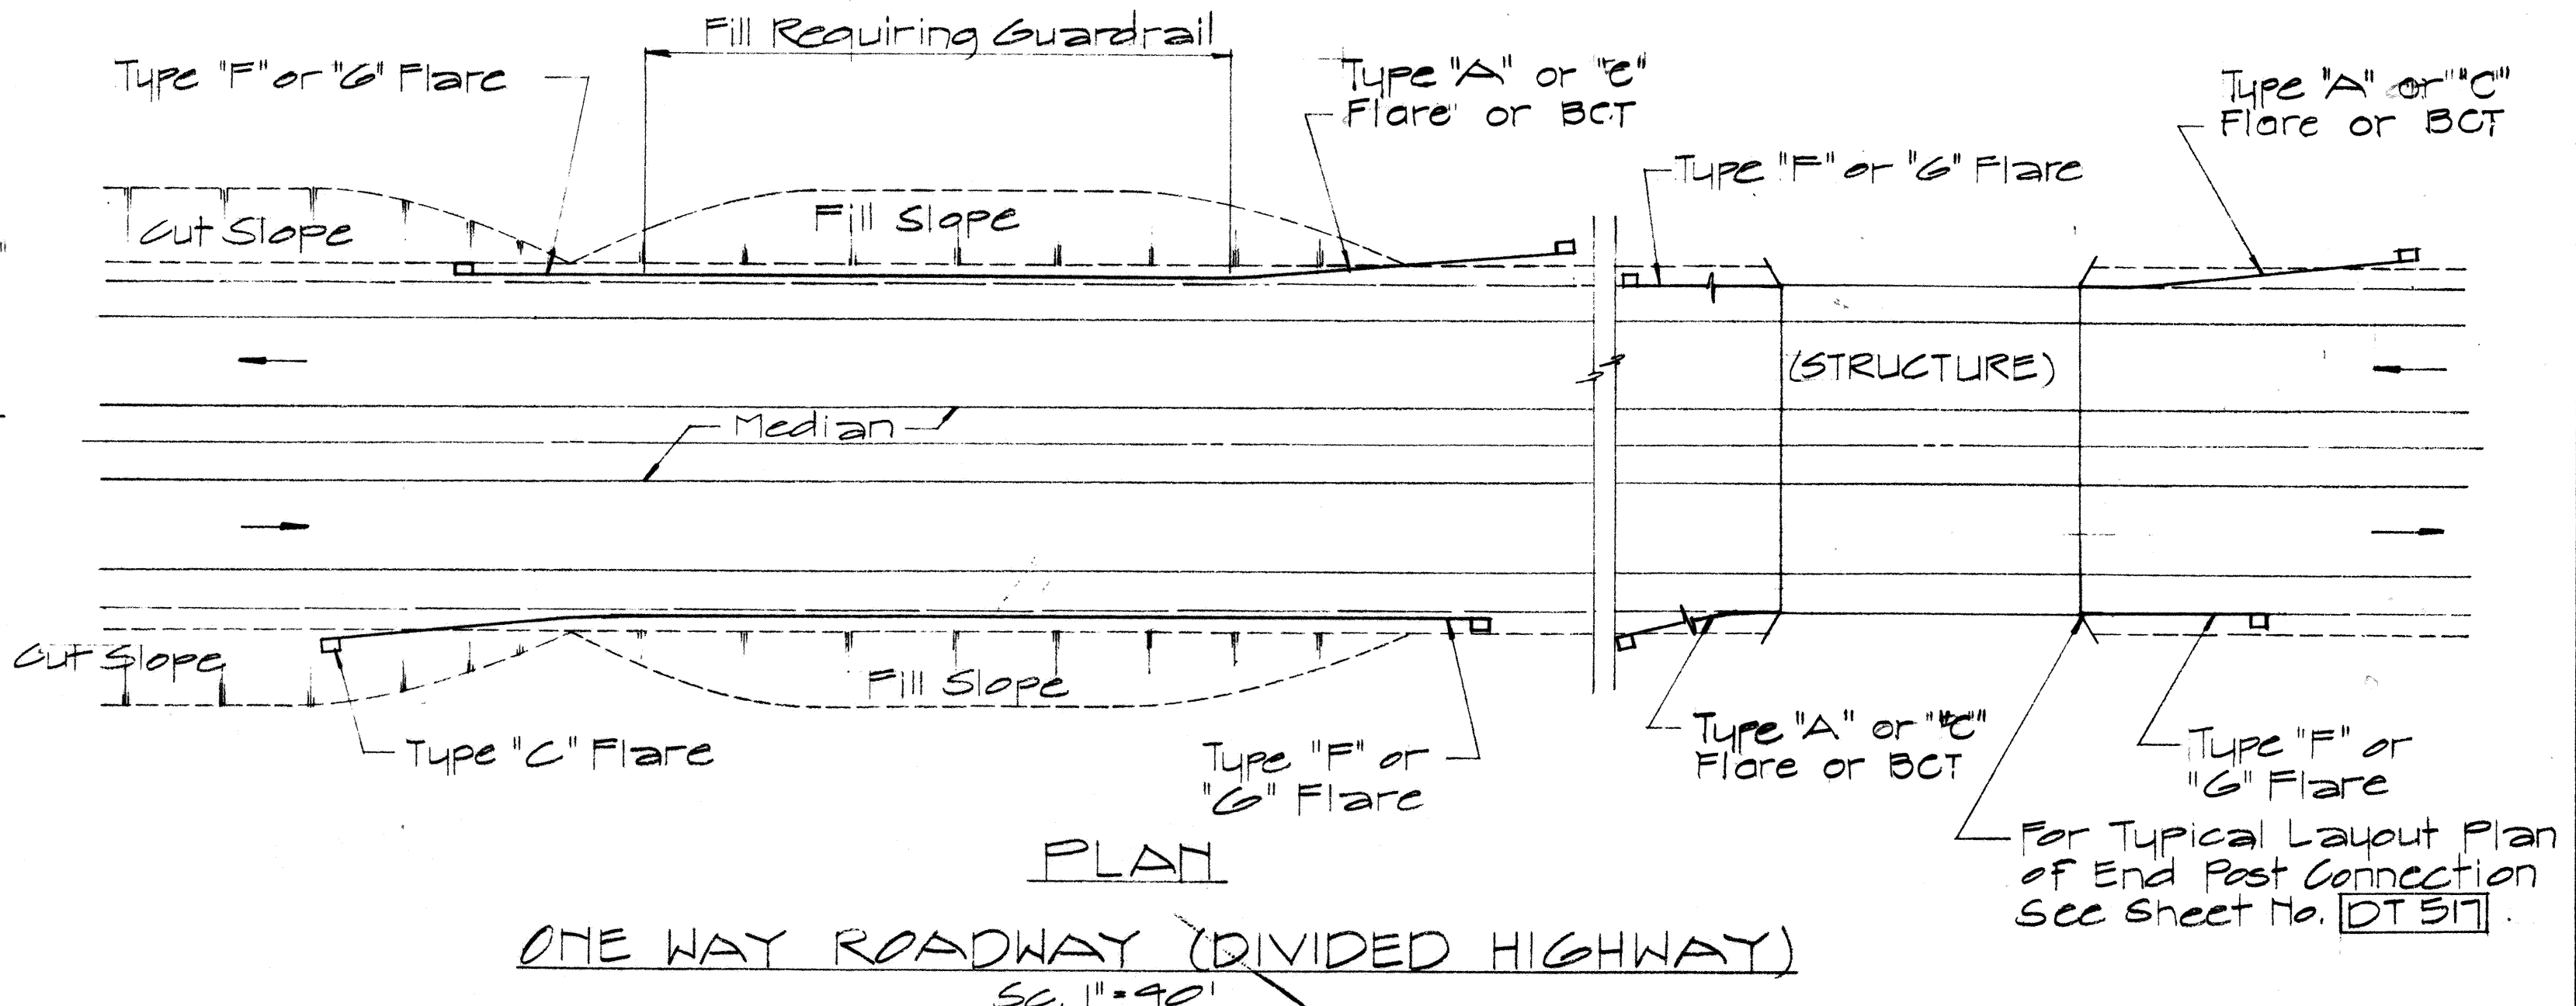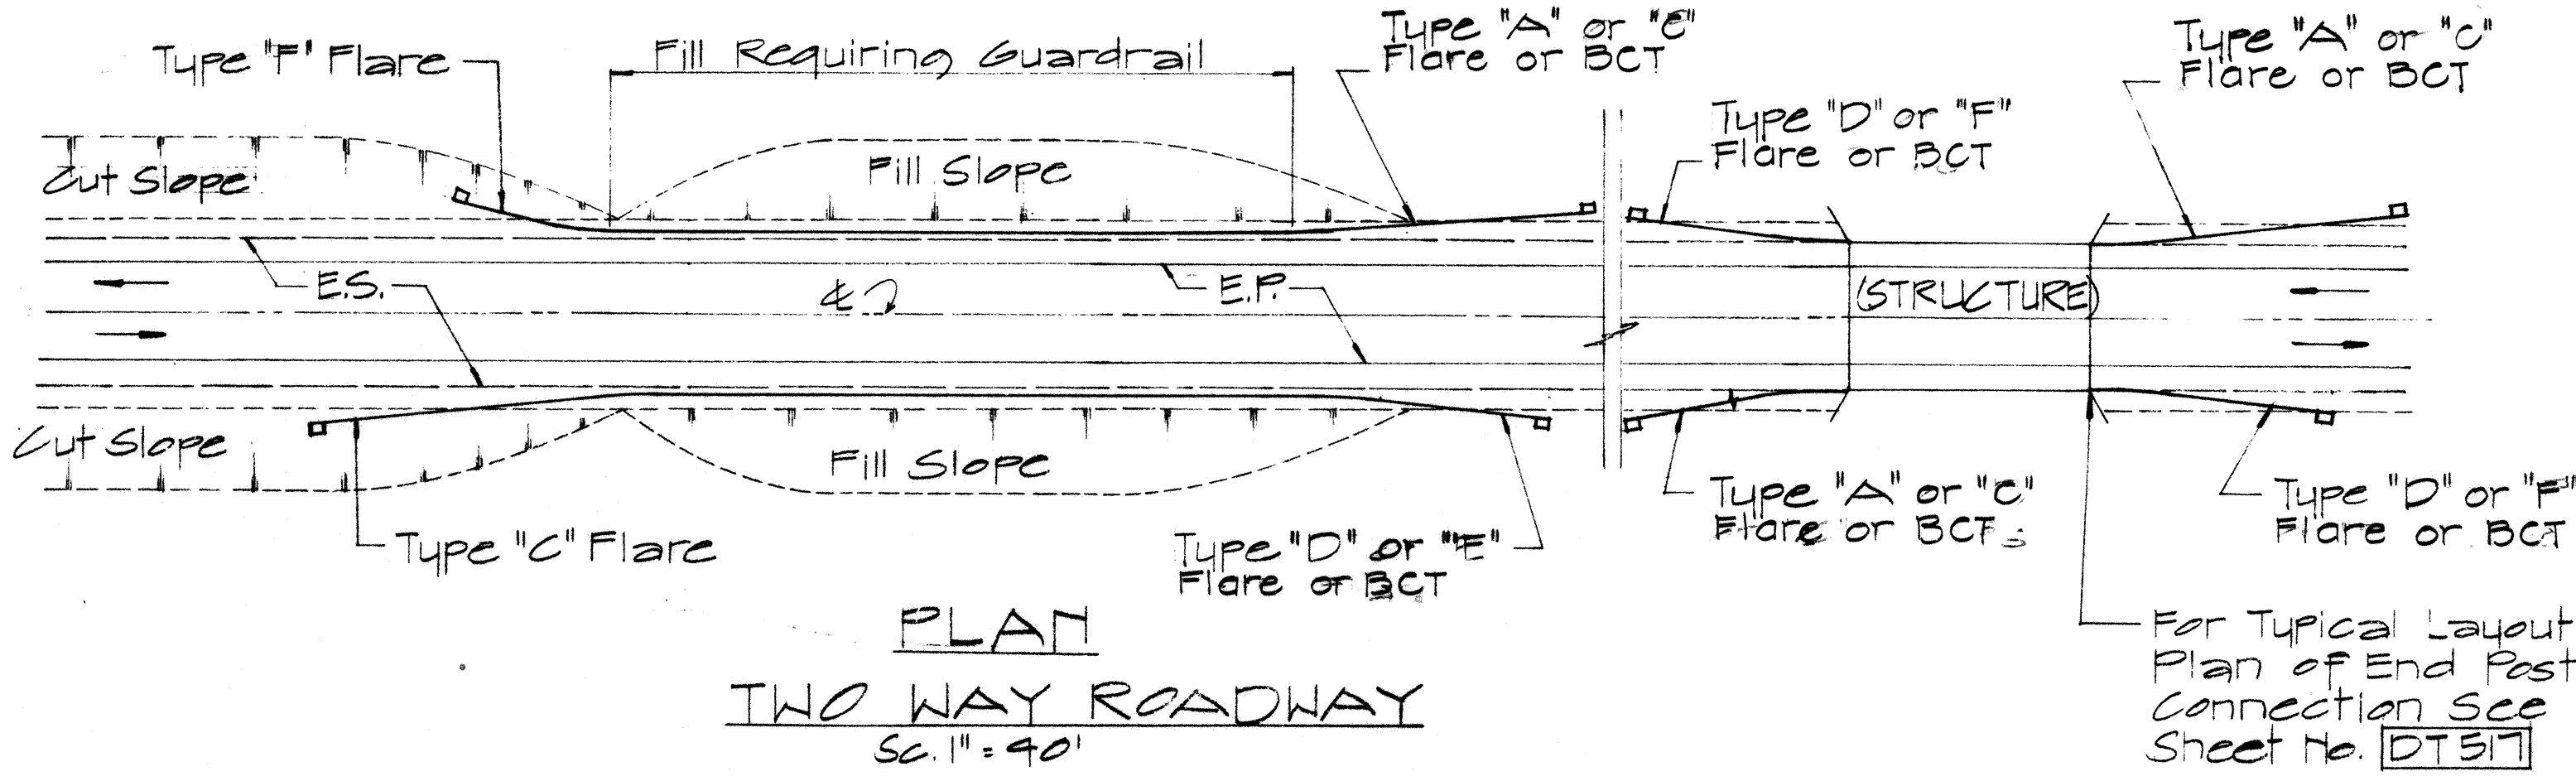

APPROVAL RECOMMENDED:
Erich Tanaka 12/23/69
 TRAFFIC ENGINEER DATE

APPROVED
W. B. Z. Z. Z. 12-30-69
 ASSISTANT CHIEF, ENGINEERING DATE

NO.	REVISION	APPROVED BY	DATE
1	Delete Type "B" Flare and Type "E" Flare	H.J.	6/15/88

STATE OF HAWAII
 DEPARTMENT OF TRANSPORTATION
 HIGHWAYS DIVISION


**STANDARD DETAILS
 OF APPROACH END
 FLARE - ONE & TWO
 WAY ROADWAY**

Sc. As Noted April 1969


SHEET No. OF SHEETS DT 516

DATE
 SURVEY PLOTTED BY
 DRAWN BY
 CHECKED BY
 ORIGINAL PLAN
 NOTE BOOK
 No.


FED. ROAD DIST. NO.	STATE	FED. AID PROJ. NO.	FISCAL YEAR	SHEET NO.	TOTAL SHEETS
HAWAII	HAW.	F-011-2(17)	1986	37	142

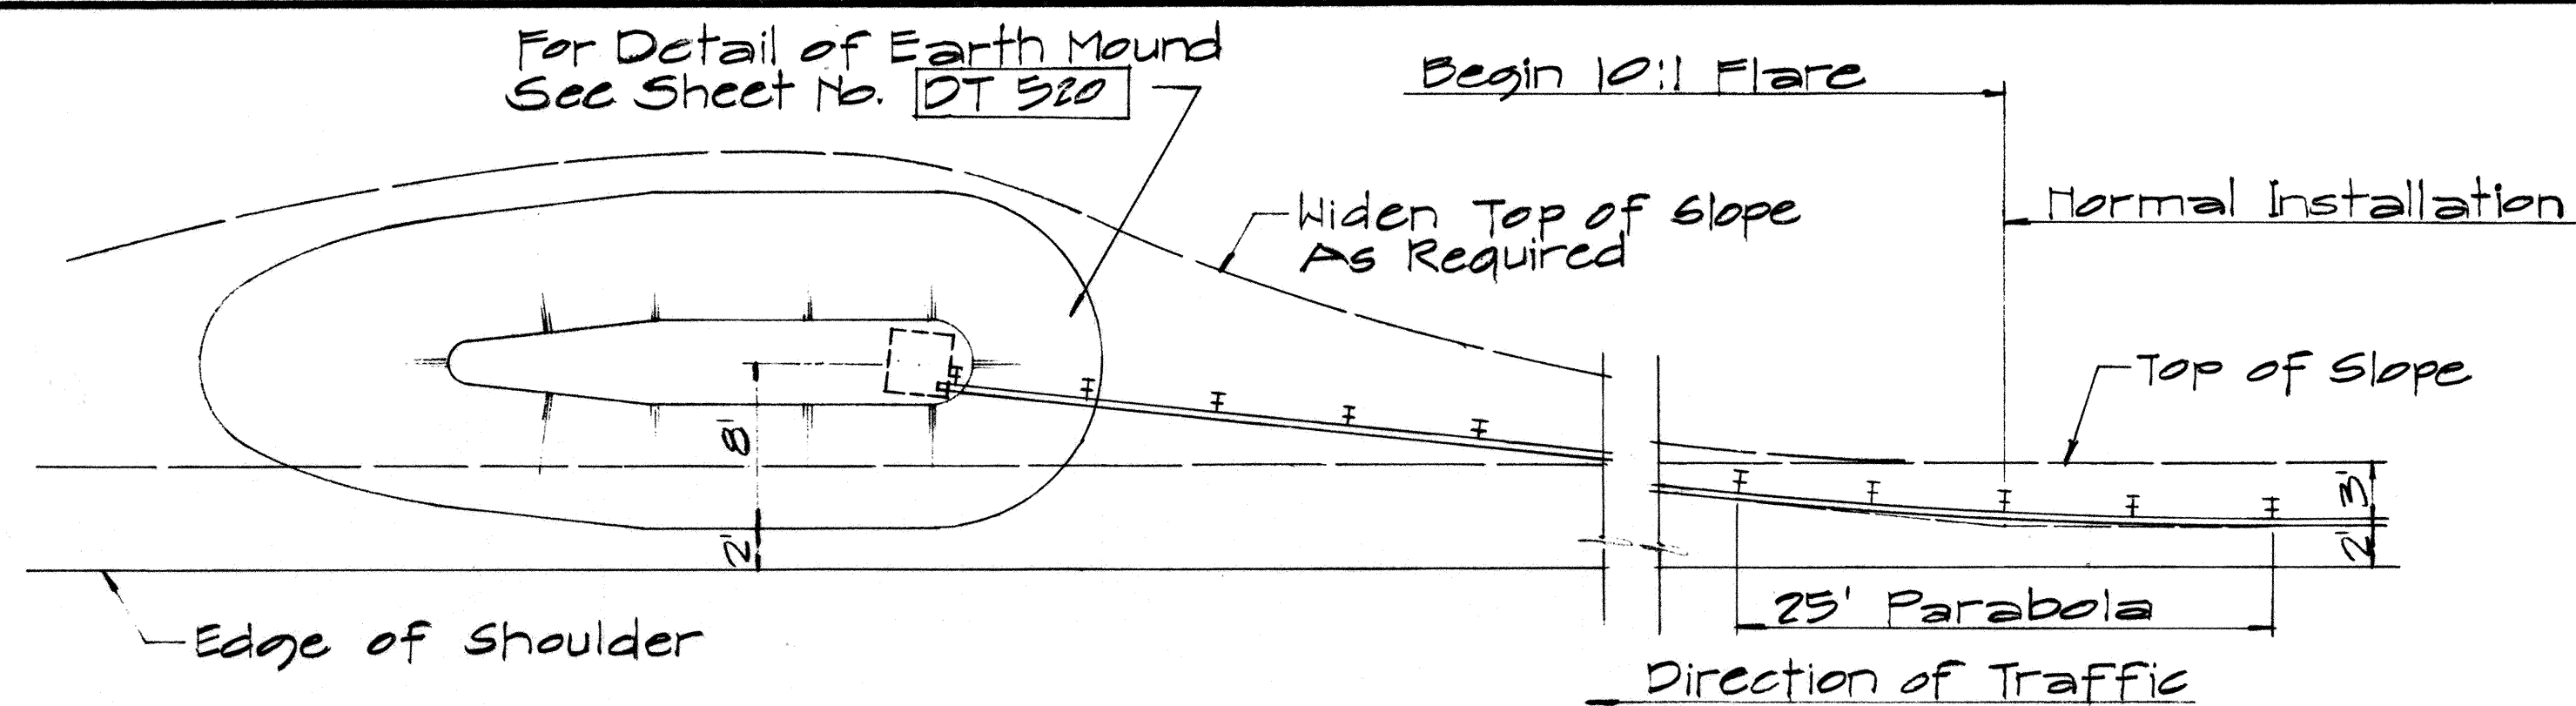


PLAN

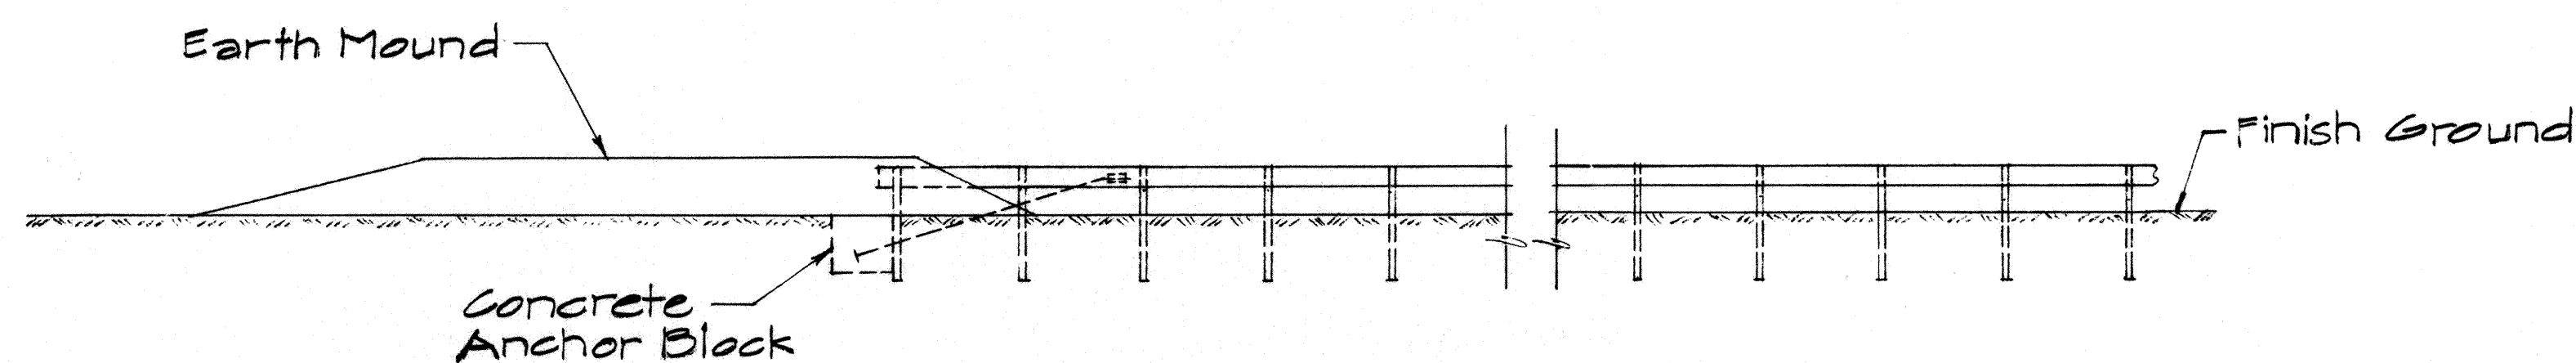


ELEVATION
TYPE "D" FLARE
Sc. 1/8" = 1'-0"

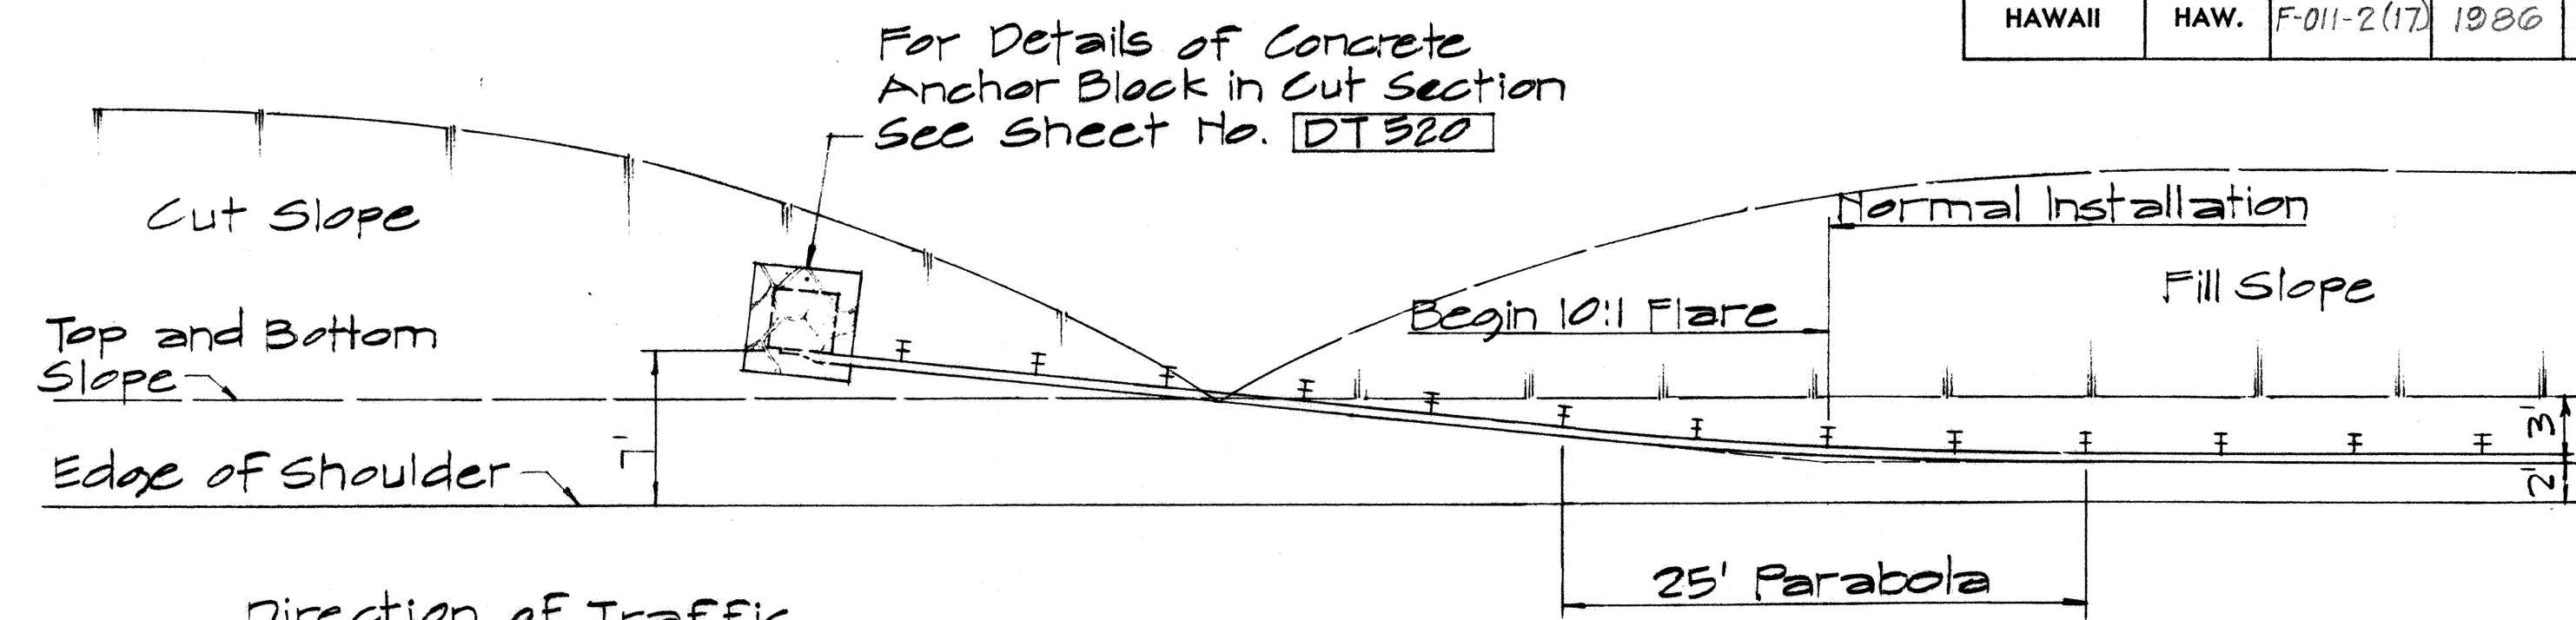


PLAN

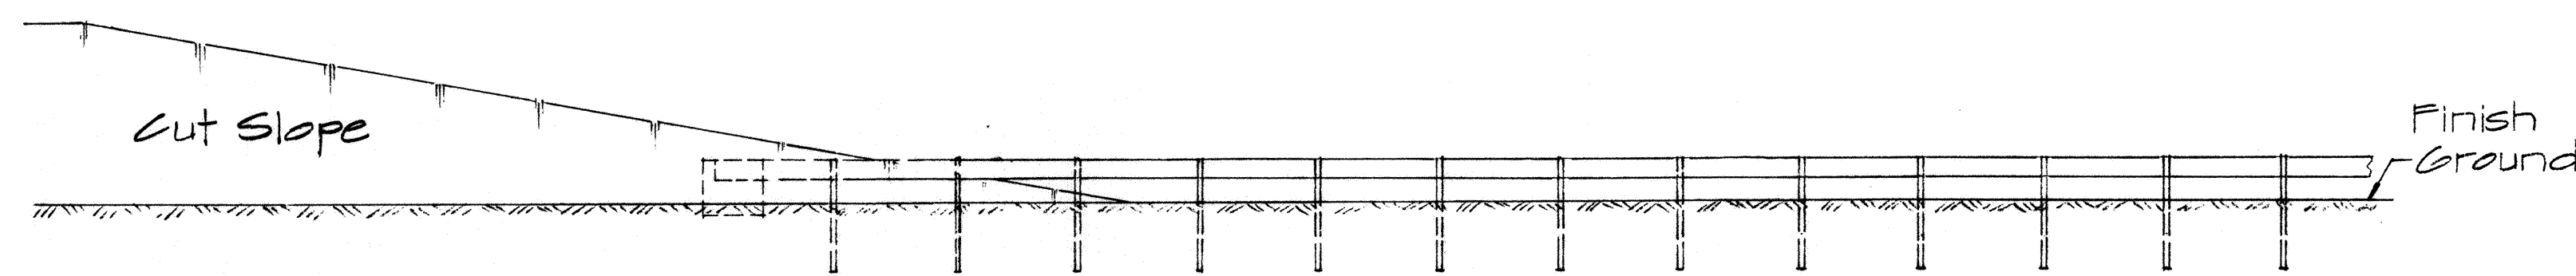

ELEVATION
TYPE "F" FLARE
Sc. 1/8" = 1'-0"

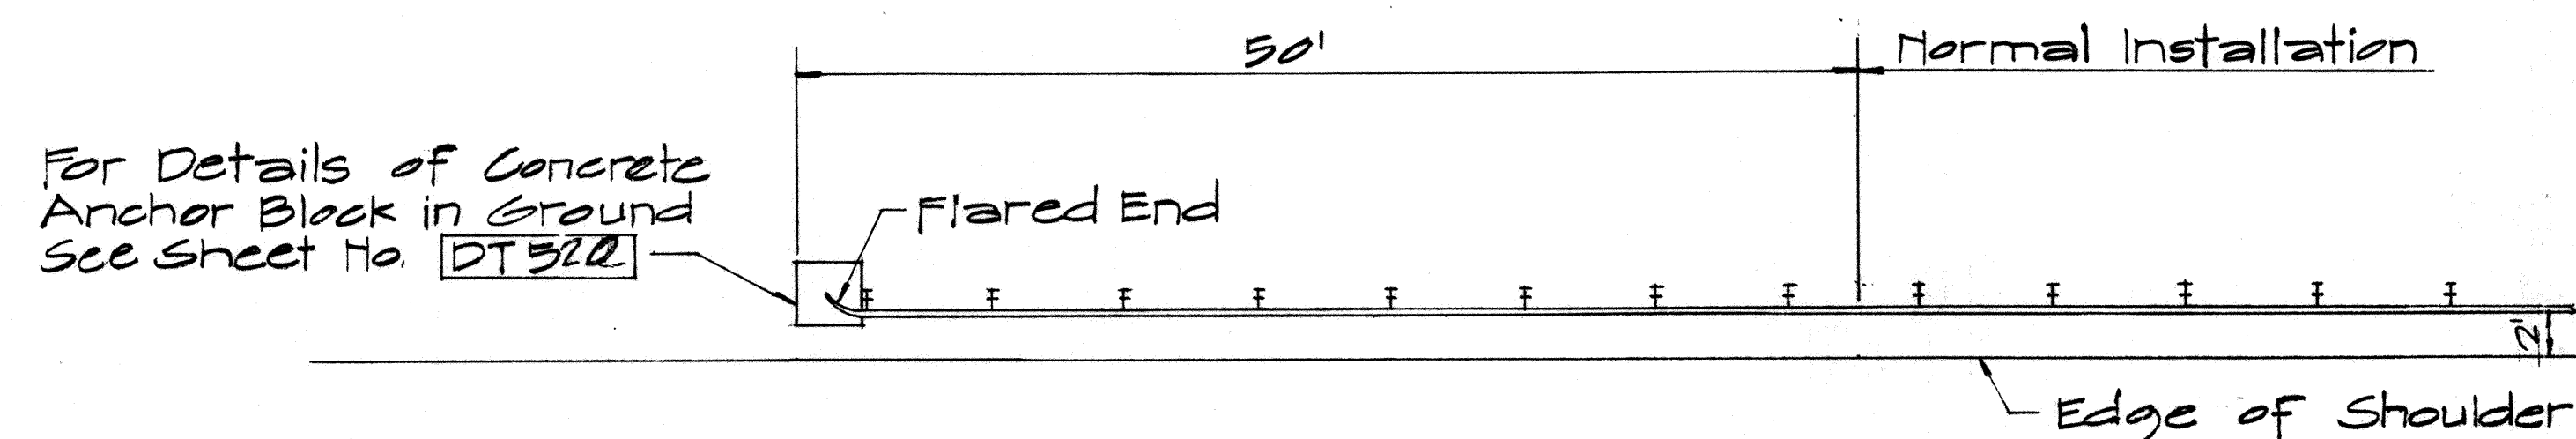


PLAN

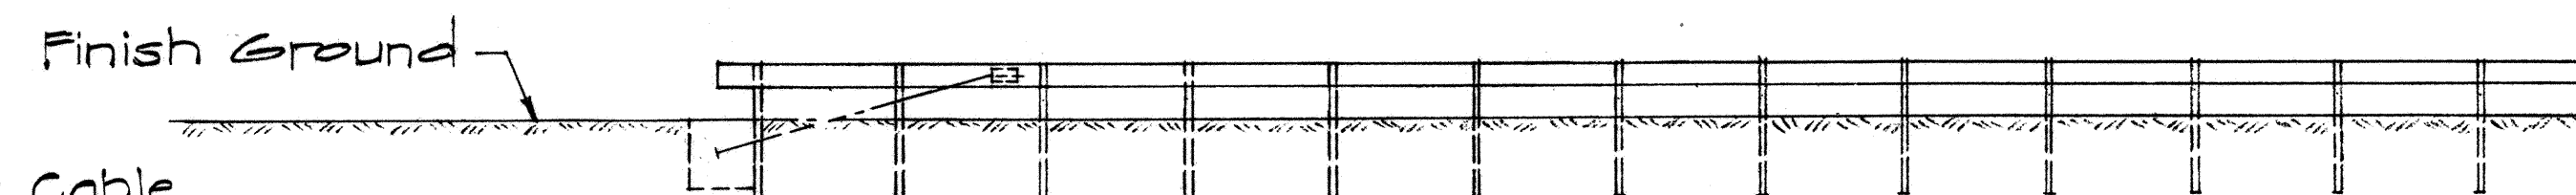

ELEVATION
TYPE "G" FLARE
Sc. 1/8" = 1'-0"

NOTE:
For detail of Breakaway Cable Terminal (BCT) See Sheet No. DT 517

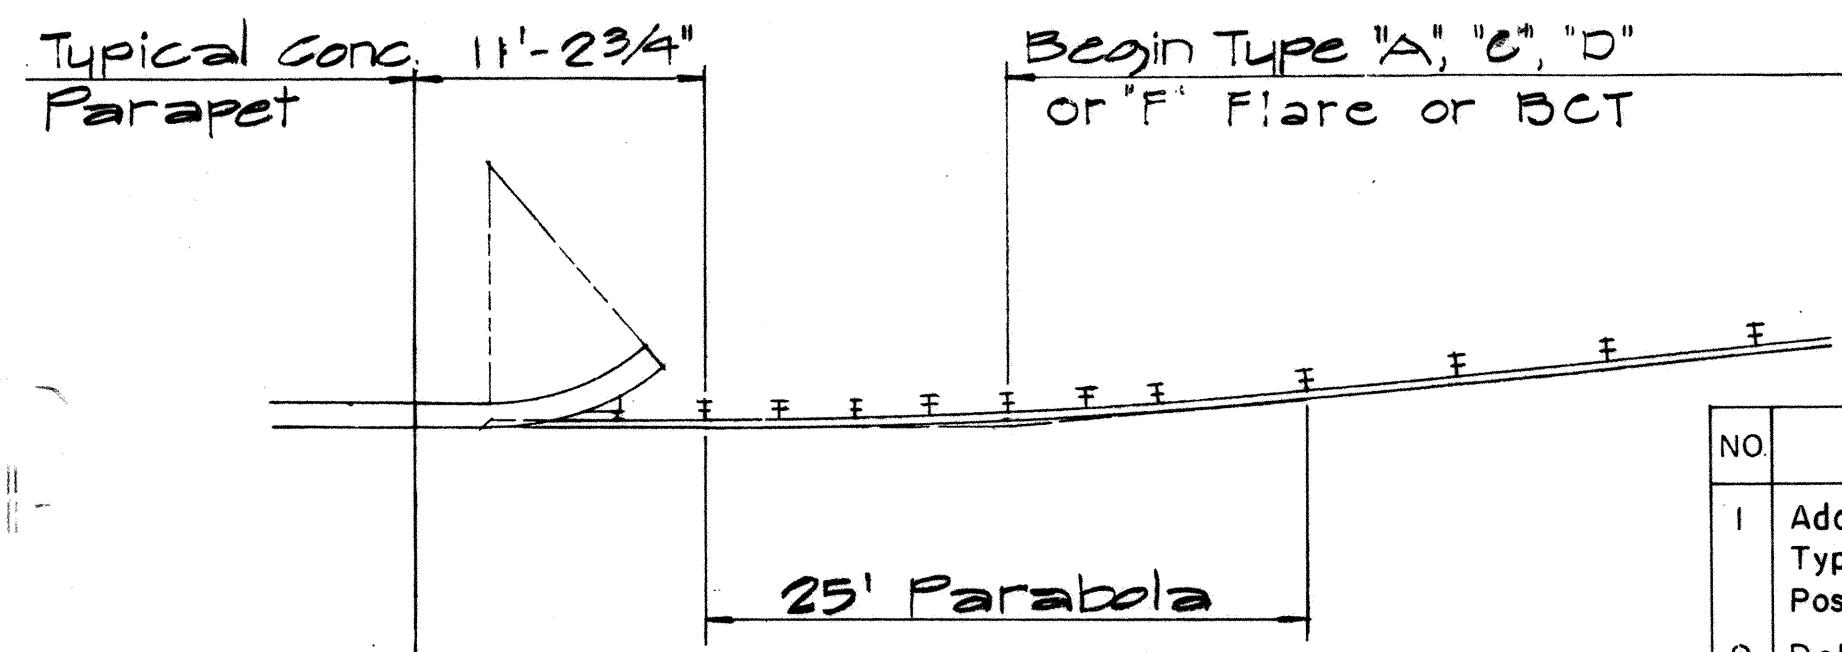

TYPICAL LAYOUT PLAN OF
END POST CONNECTION
Sc. 1/8" = 1'-0"

APPROVAL RECOMMENDED:
Euske Tanaka 12/29/69
TRAFFIC ENGINEER DATE

APPROVED:
Wm. J. Sal 12-30-69
ASSISTANT CHIEF, ENGINEERING DATE

NO.	REVISION	APPROVED BY	DATE
1	Additional Posts Added to Typical Layout Plan Of End Post Connection	H.C.	4-12-72
2	Delete Type "B" Flare and Type "E" Flare	H.C.	6-15-78

STATE OF HAWAII
DEPARTMENT OF TRANSPORTATION
HIGHWAYS DIVISION

STANDARD DETAILS
TRAILING END
FLARE - ONE & TWO
WAY ROADWAY


Scale: As Noted April 1969

SHEET No. OF SHEETS DT 517

FED. ROAD DIST. NO.	STATE	FED. AID PROJ. NO.	FISCAL YEAR	SHEET NO.	TOTAL SHEETS
HAWAII	HAW.	F-011-2(17)	1986	38	142


NOTES:

- Anchor Plate and Anchor Cable Assembly (Standard Swaged Fitting and Stud). See Standard Detail Sheet No. DT 520.
- Other Anchor Cable Assemblies may be used. Minimum breaking strength of assembly should be 40,000 lbs.
- Second Terminal Post does not require holes to accommodate Anchor Cable.
- Slip Base Load shall be controlled with a Calibrated Torque Wrench - Torque 155 - 170 ft. lbs.
- Concrete shall be Class A.
- B.C.T. Hardware has been superseded by "A Guide Standardized Highway Barrier Rail Hardware," A report prepared and approved by the AASHTO-AGC-ARTBA joint cooperation committee. All hardware shall conform to above mentioned publication and as revised from time to time.

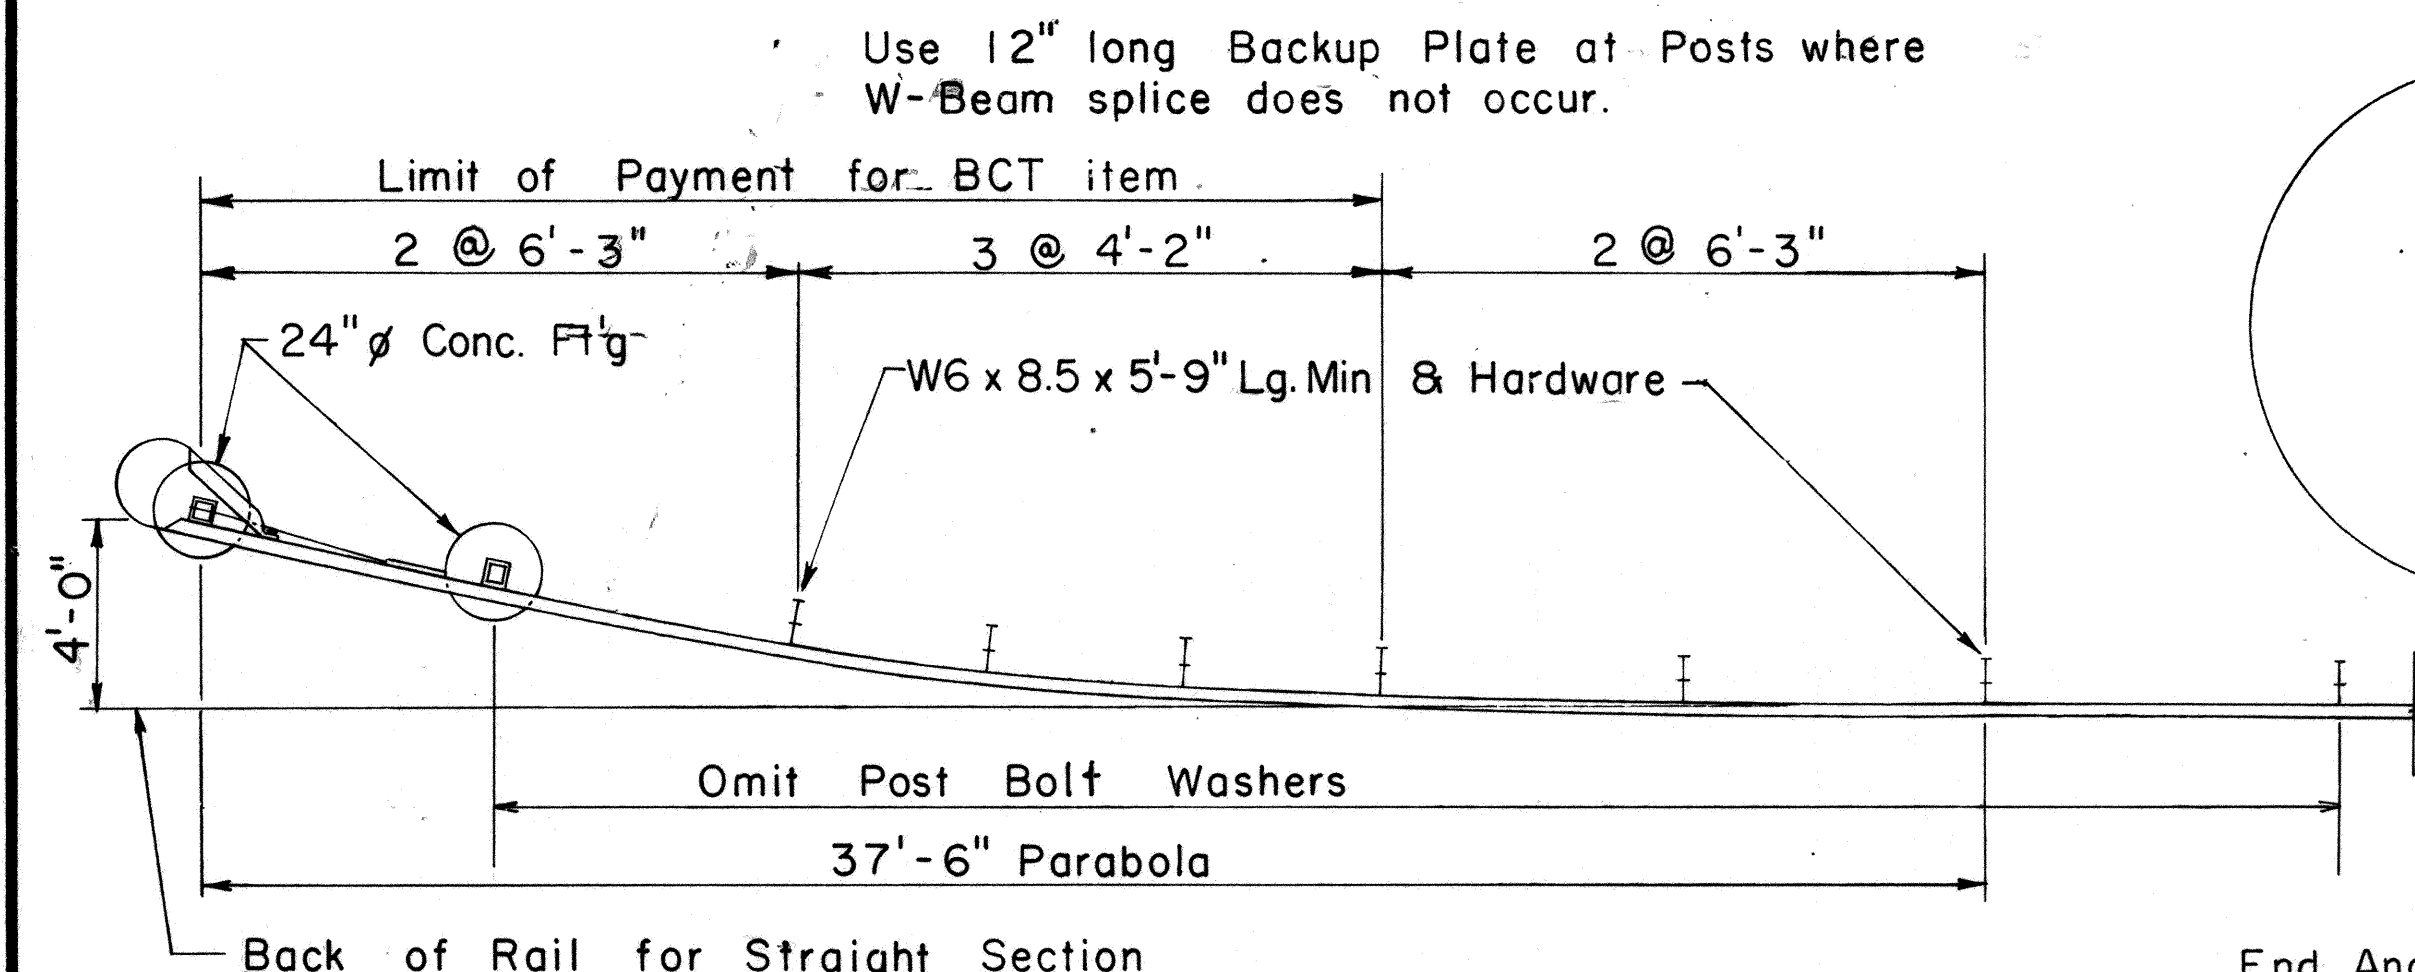


PLAN

Scale: 1/4" = 1'-0"

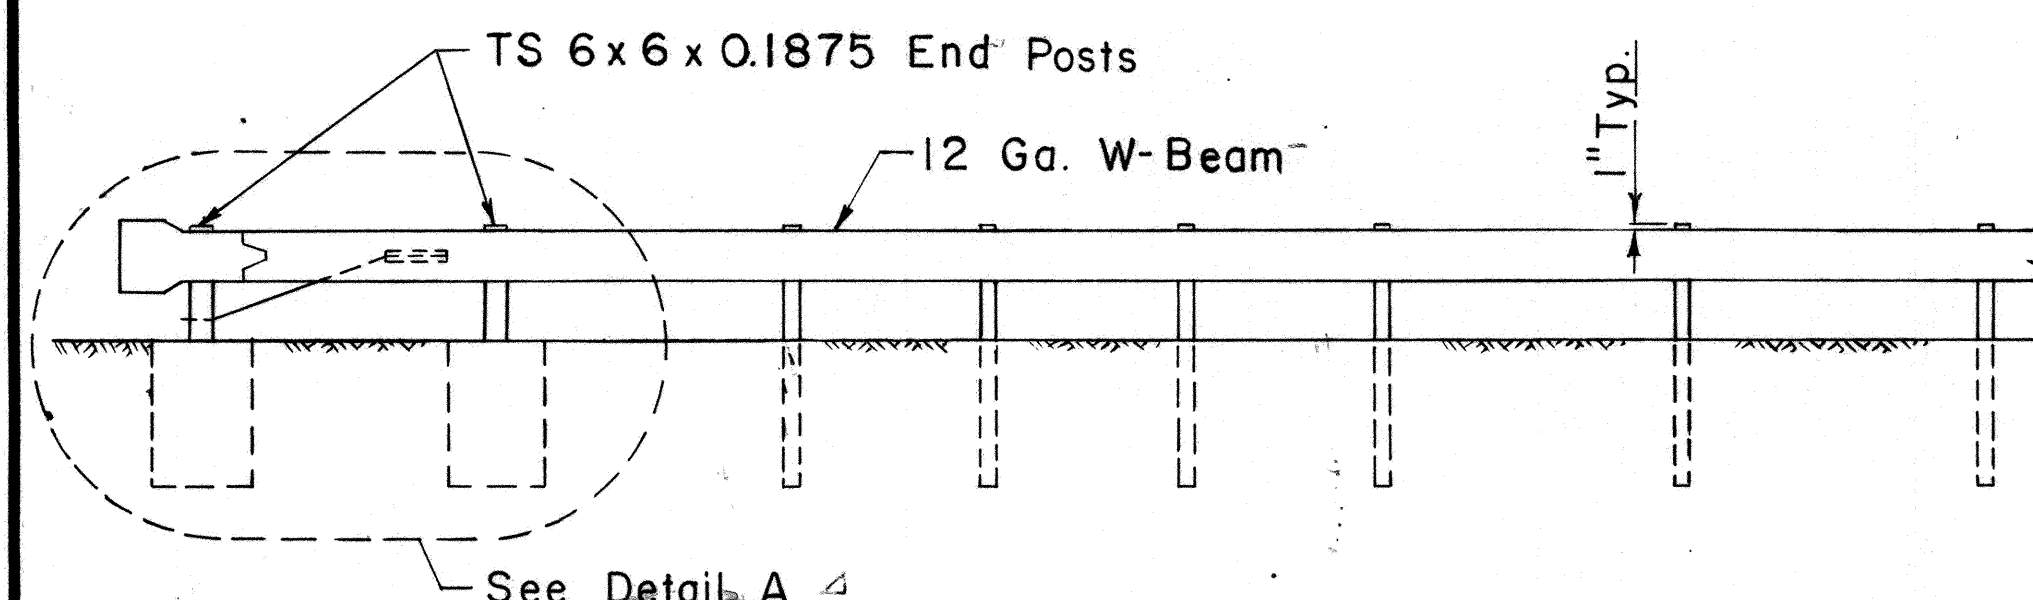

ELEVATION


Scale: 1/4" = 1'-0"

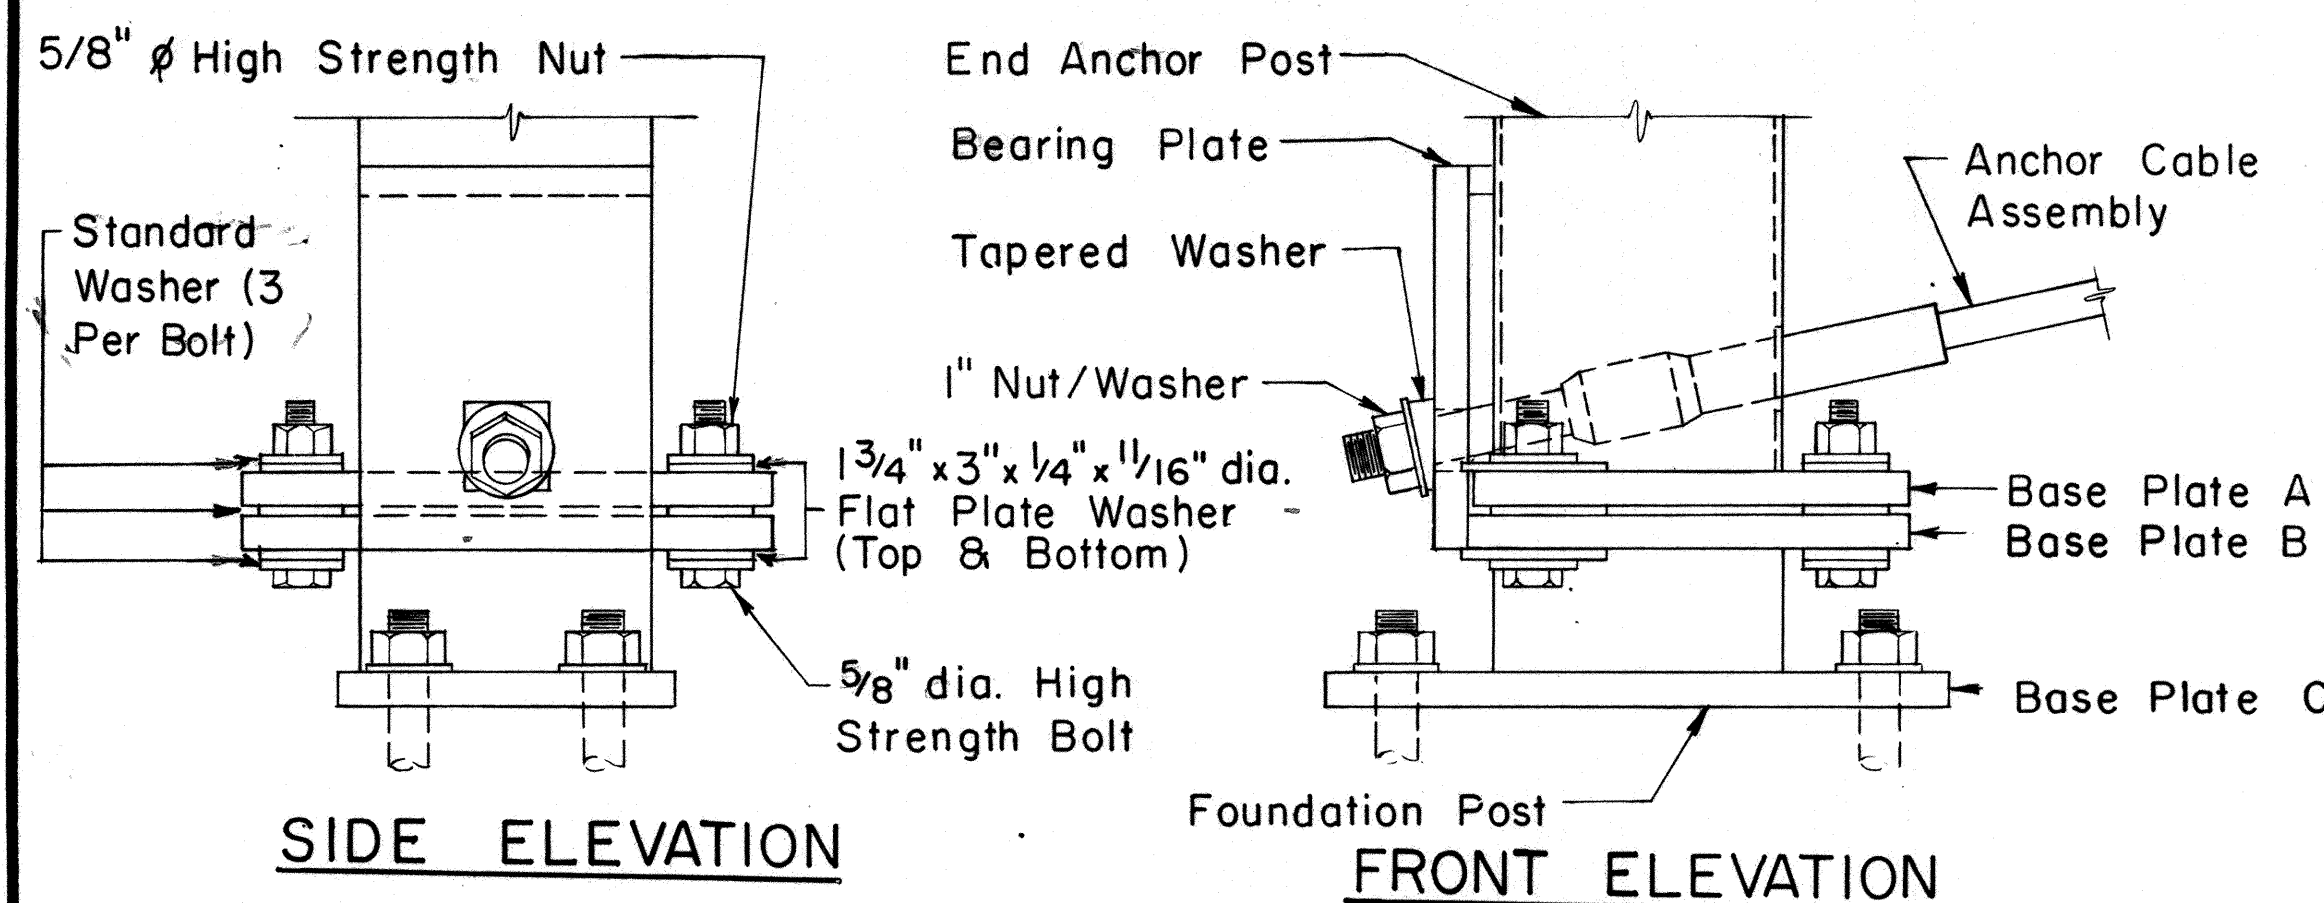

SIDE ELEVATION


DETAIL B

FRONT ELEVATION

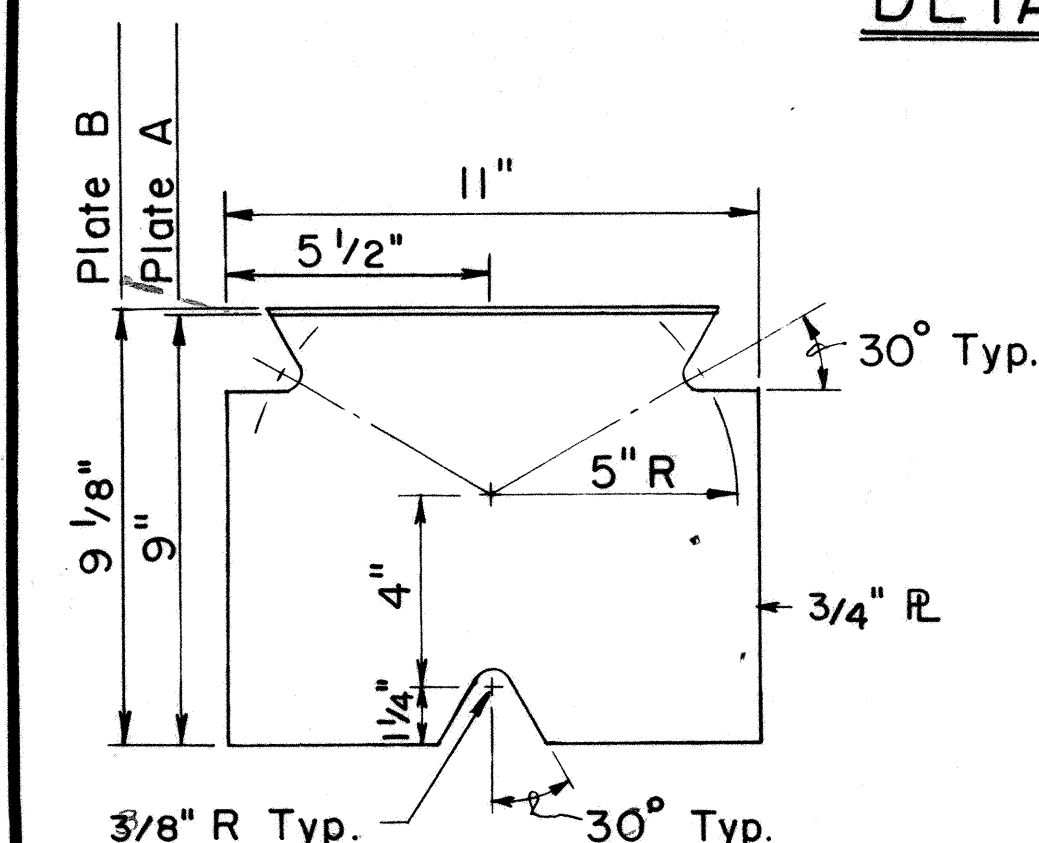


BASE PLATES A & B

Scale: 3" = 1'-0"

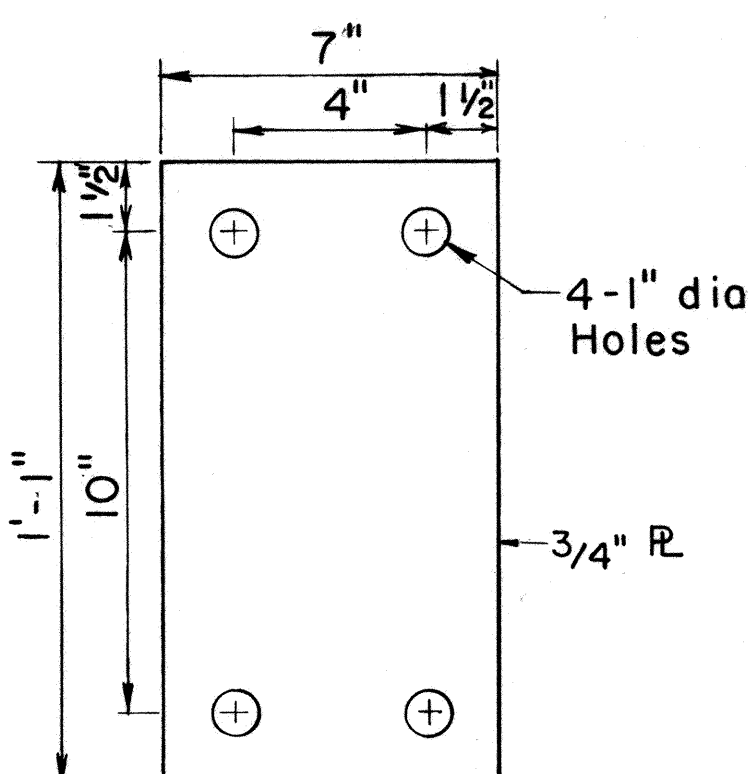


BASE PLATE C

Scale: 3" = 1'-0"

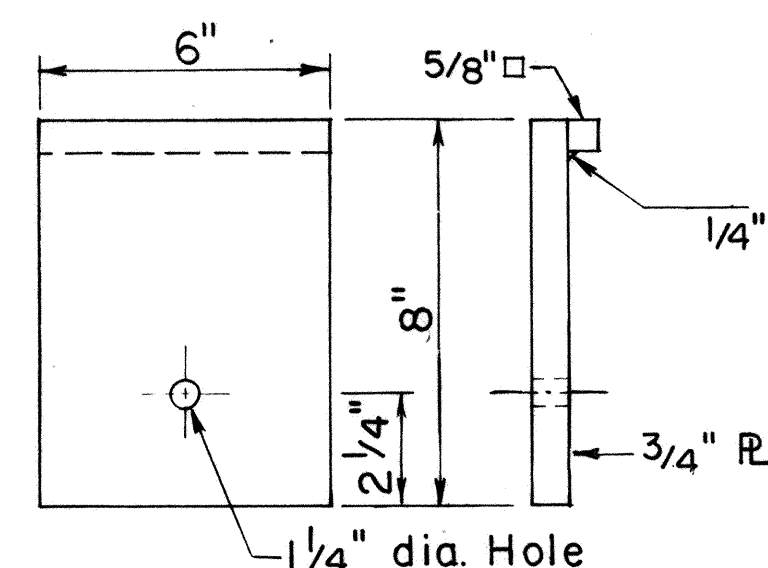


BEARING PLATE

Scale: 3" = 1'-0"

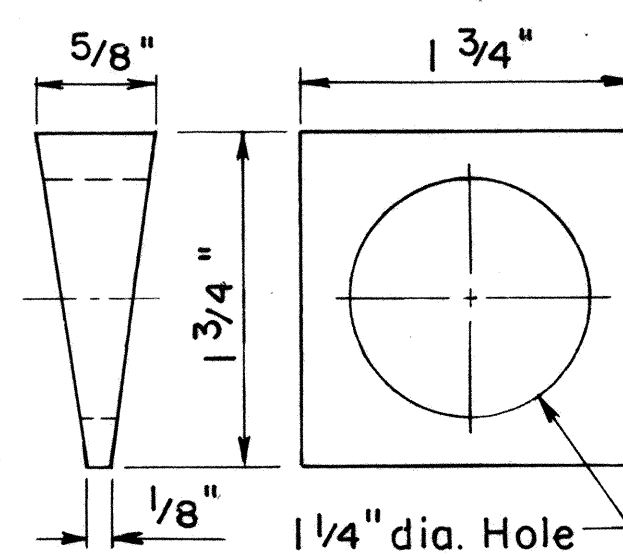


TAPERED WASHER

Scale: Full Size

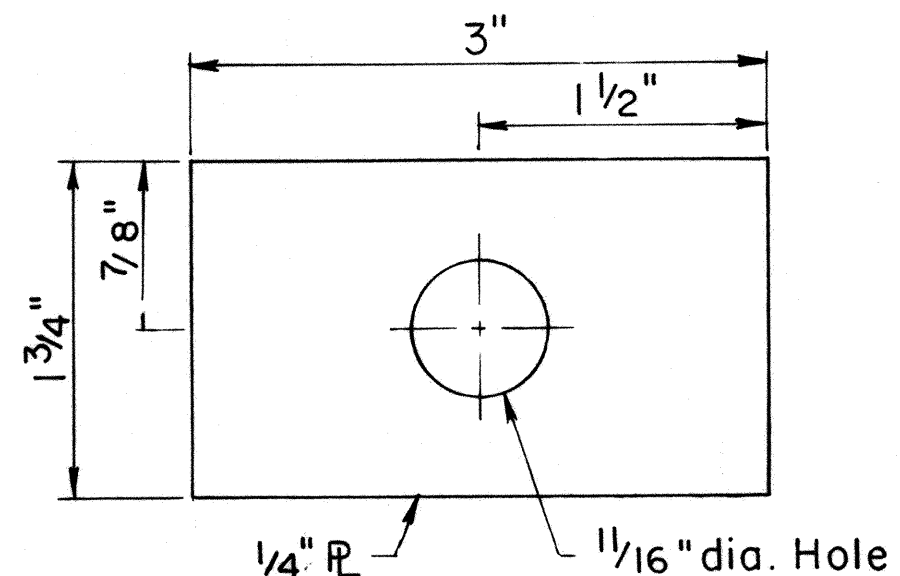


FLAT PLATE WASHER

Scale: Full Size

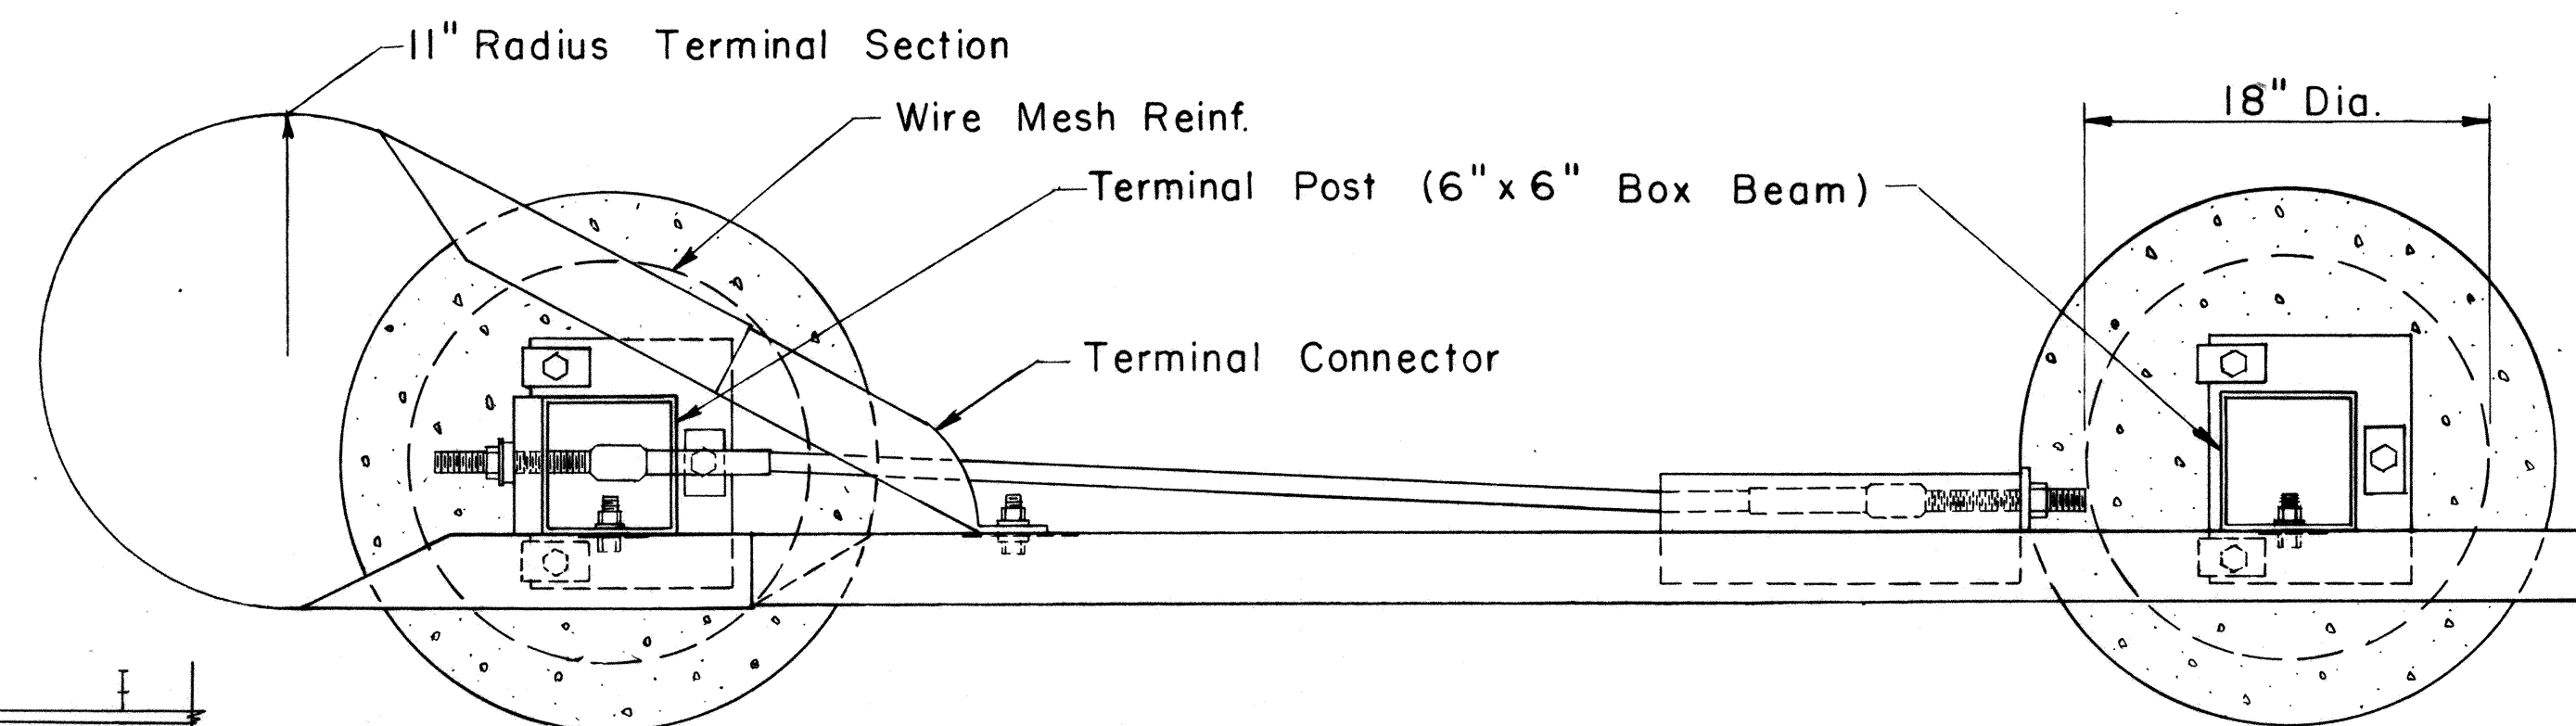


PLAN

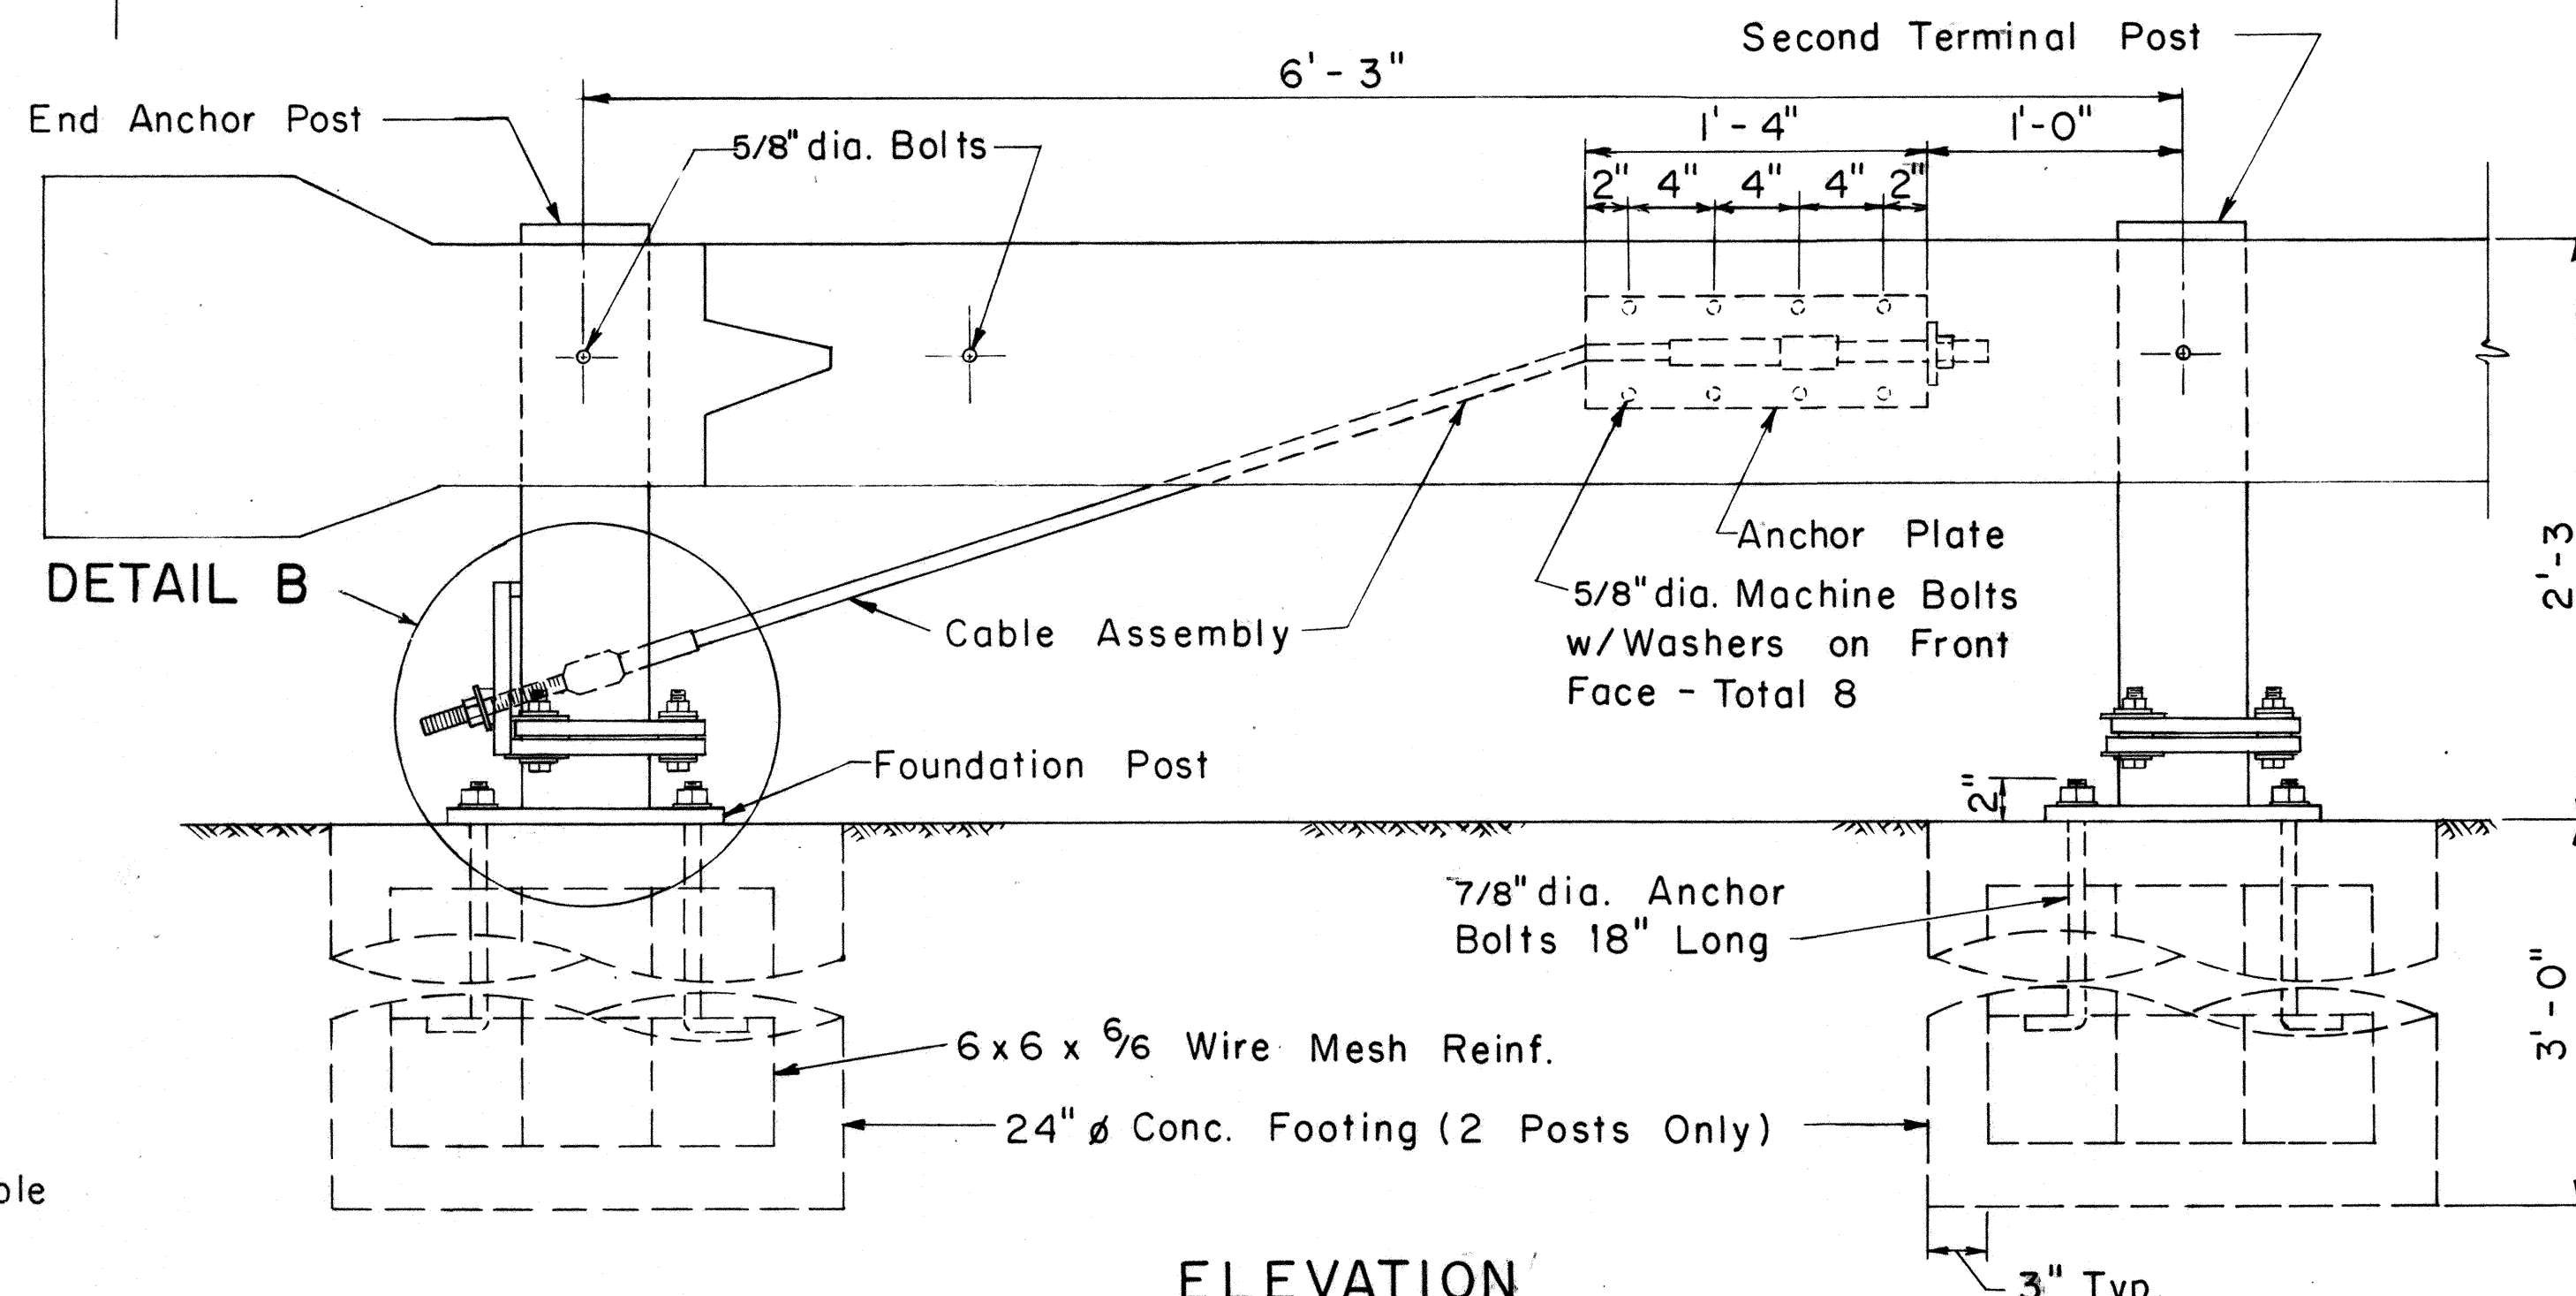

ELEVATION

DETAIL A

Scale: 1/2" = 1'-0"

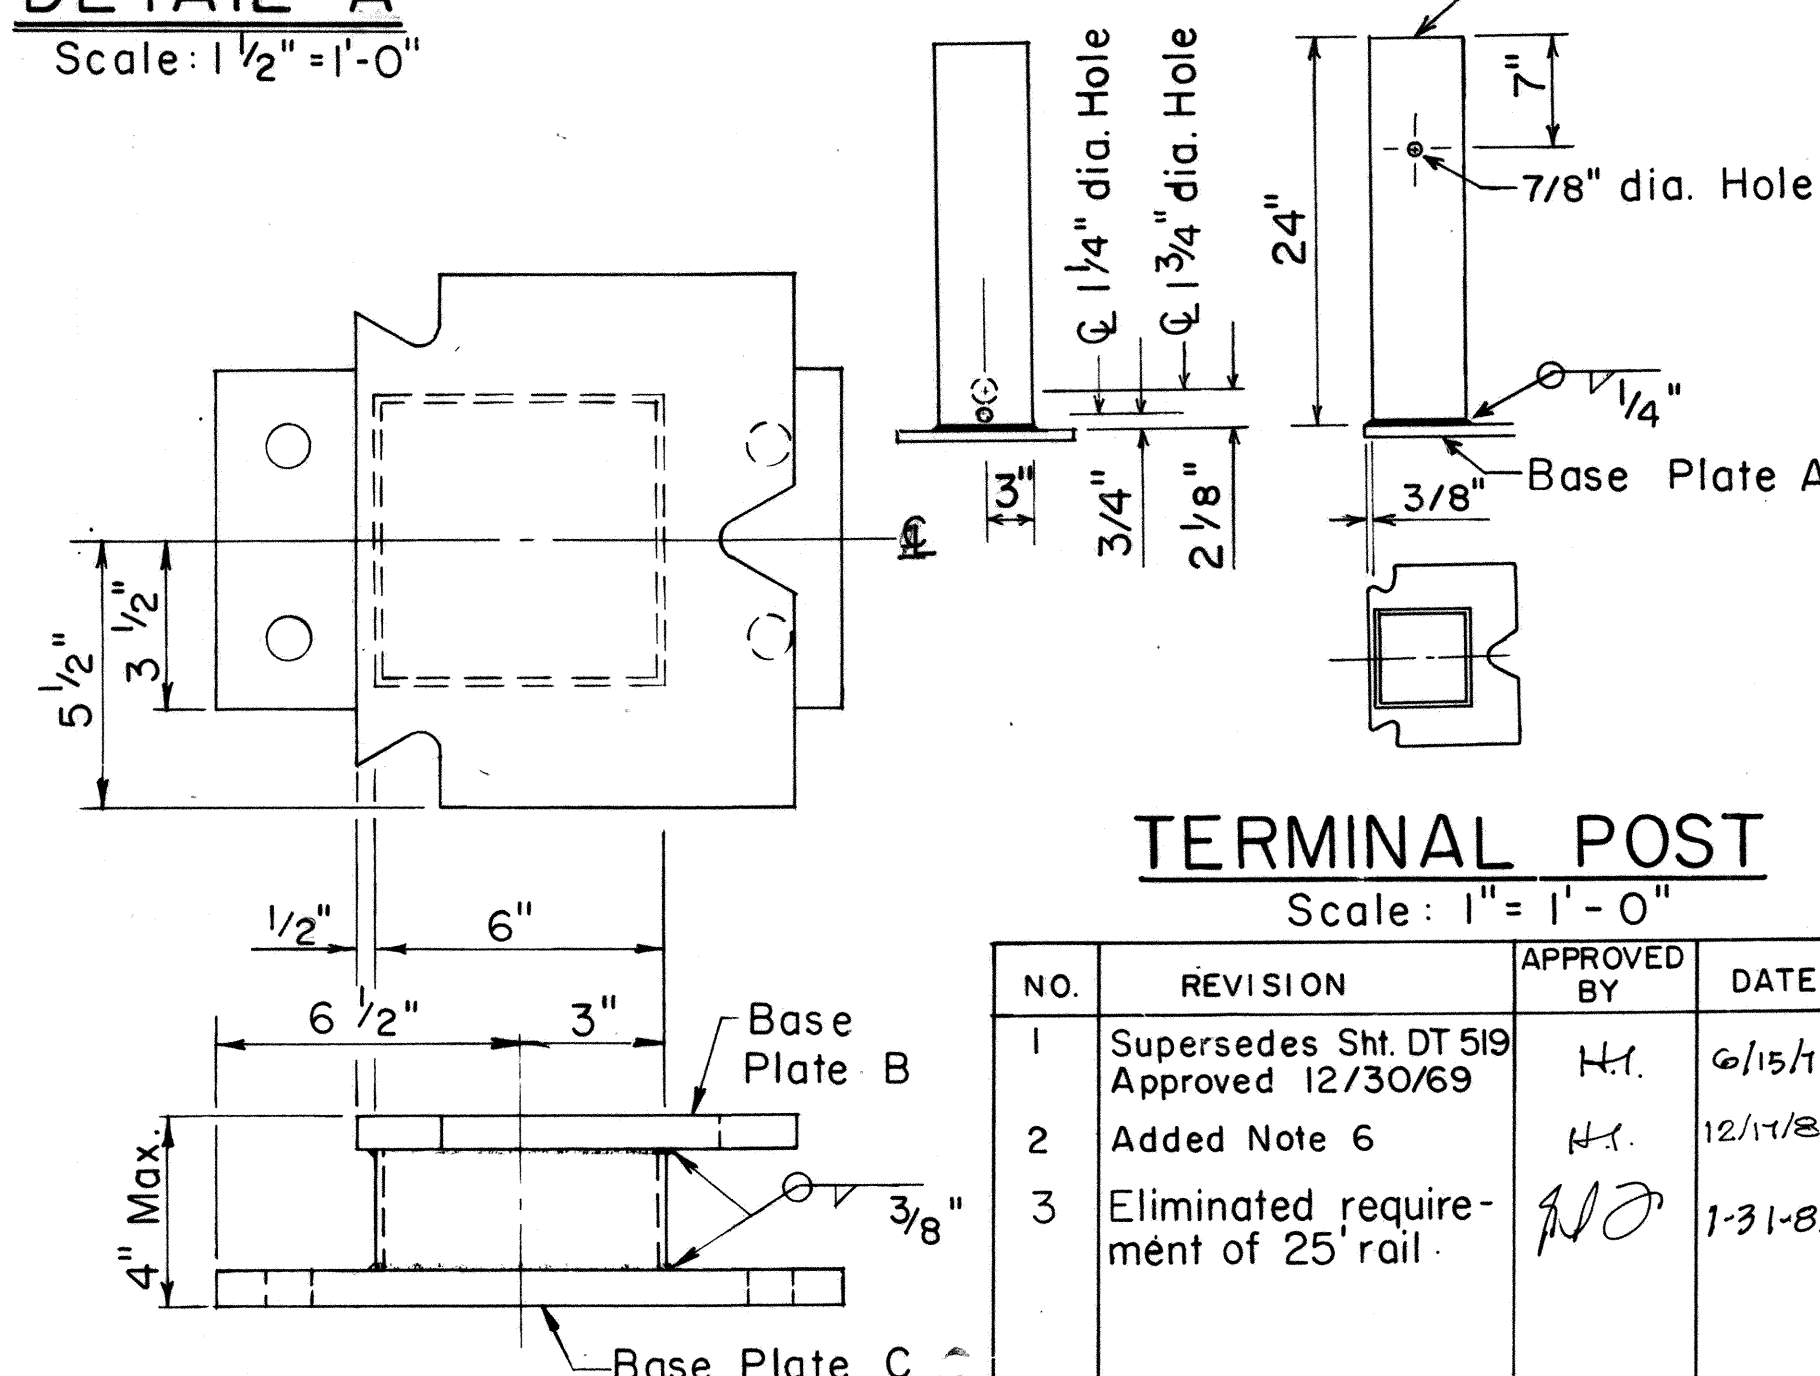

TERMINAL POST

Scale: 1" = 1'-0"

NO.	REVISION	APPROVED BY	DATE
1	Supersedes Sht. DT 519 Approved 12/30/69	H.I.	6/15/78
2	Added Note 6	H.I.	12/1/80
3	Eliminated requirement of 25' rail	NO	1-31-85

APPROVAL RECOMMENDED:

Erich Tanaka
TRAFFIC ENGINEER
6/14/78
DATE

APPROVED:

Shibor Zakeishi
ASSISTANT CHIEF, ENGINEERING
6/15/78
DATE

STATE OF HAWAII
DEPARTMENT OF TRANSPORTATION
HIGHWAYS DIVISION

STANDARD DETAIL

BREAKAWAY CABLE TERMINAL (BCT)

Scale: As Shown Date: June 1978

SHEET No. OF SHEETS DT 519

