


FED. ROAD DIST. NO.	STATE	FED. AID PROJ. NO.	FISCAL YEAR	SHEET NO.	TOTAL SHEETS
HAWAII	HAW.	F-011-2(17)	1986	12	142

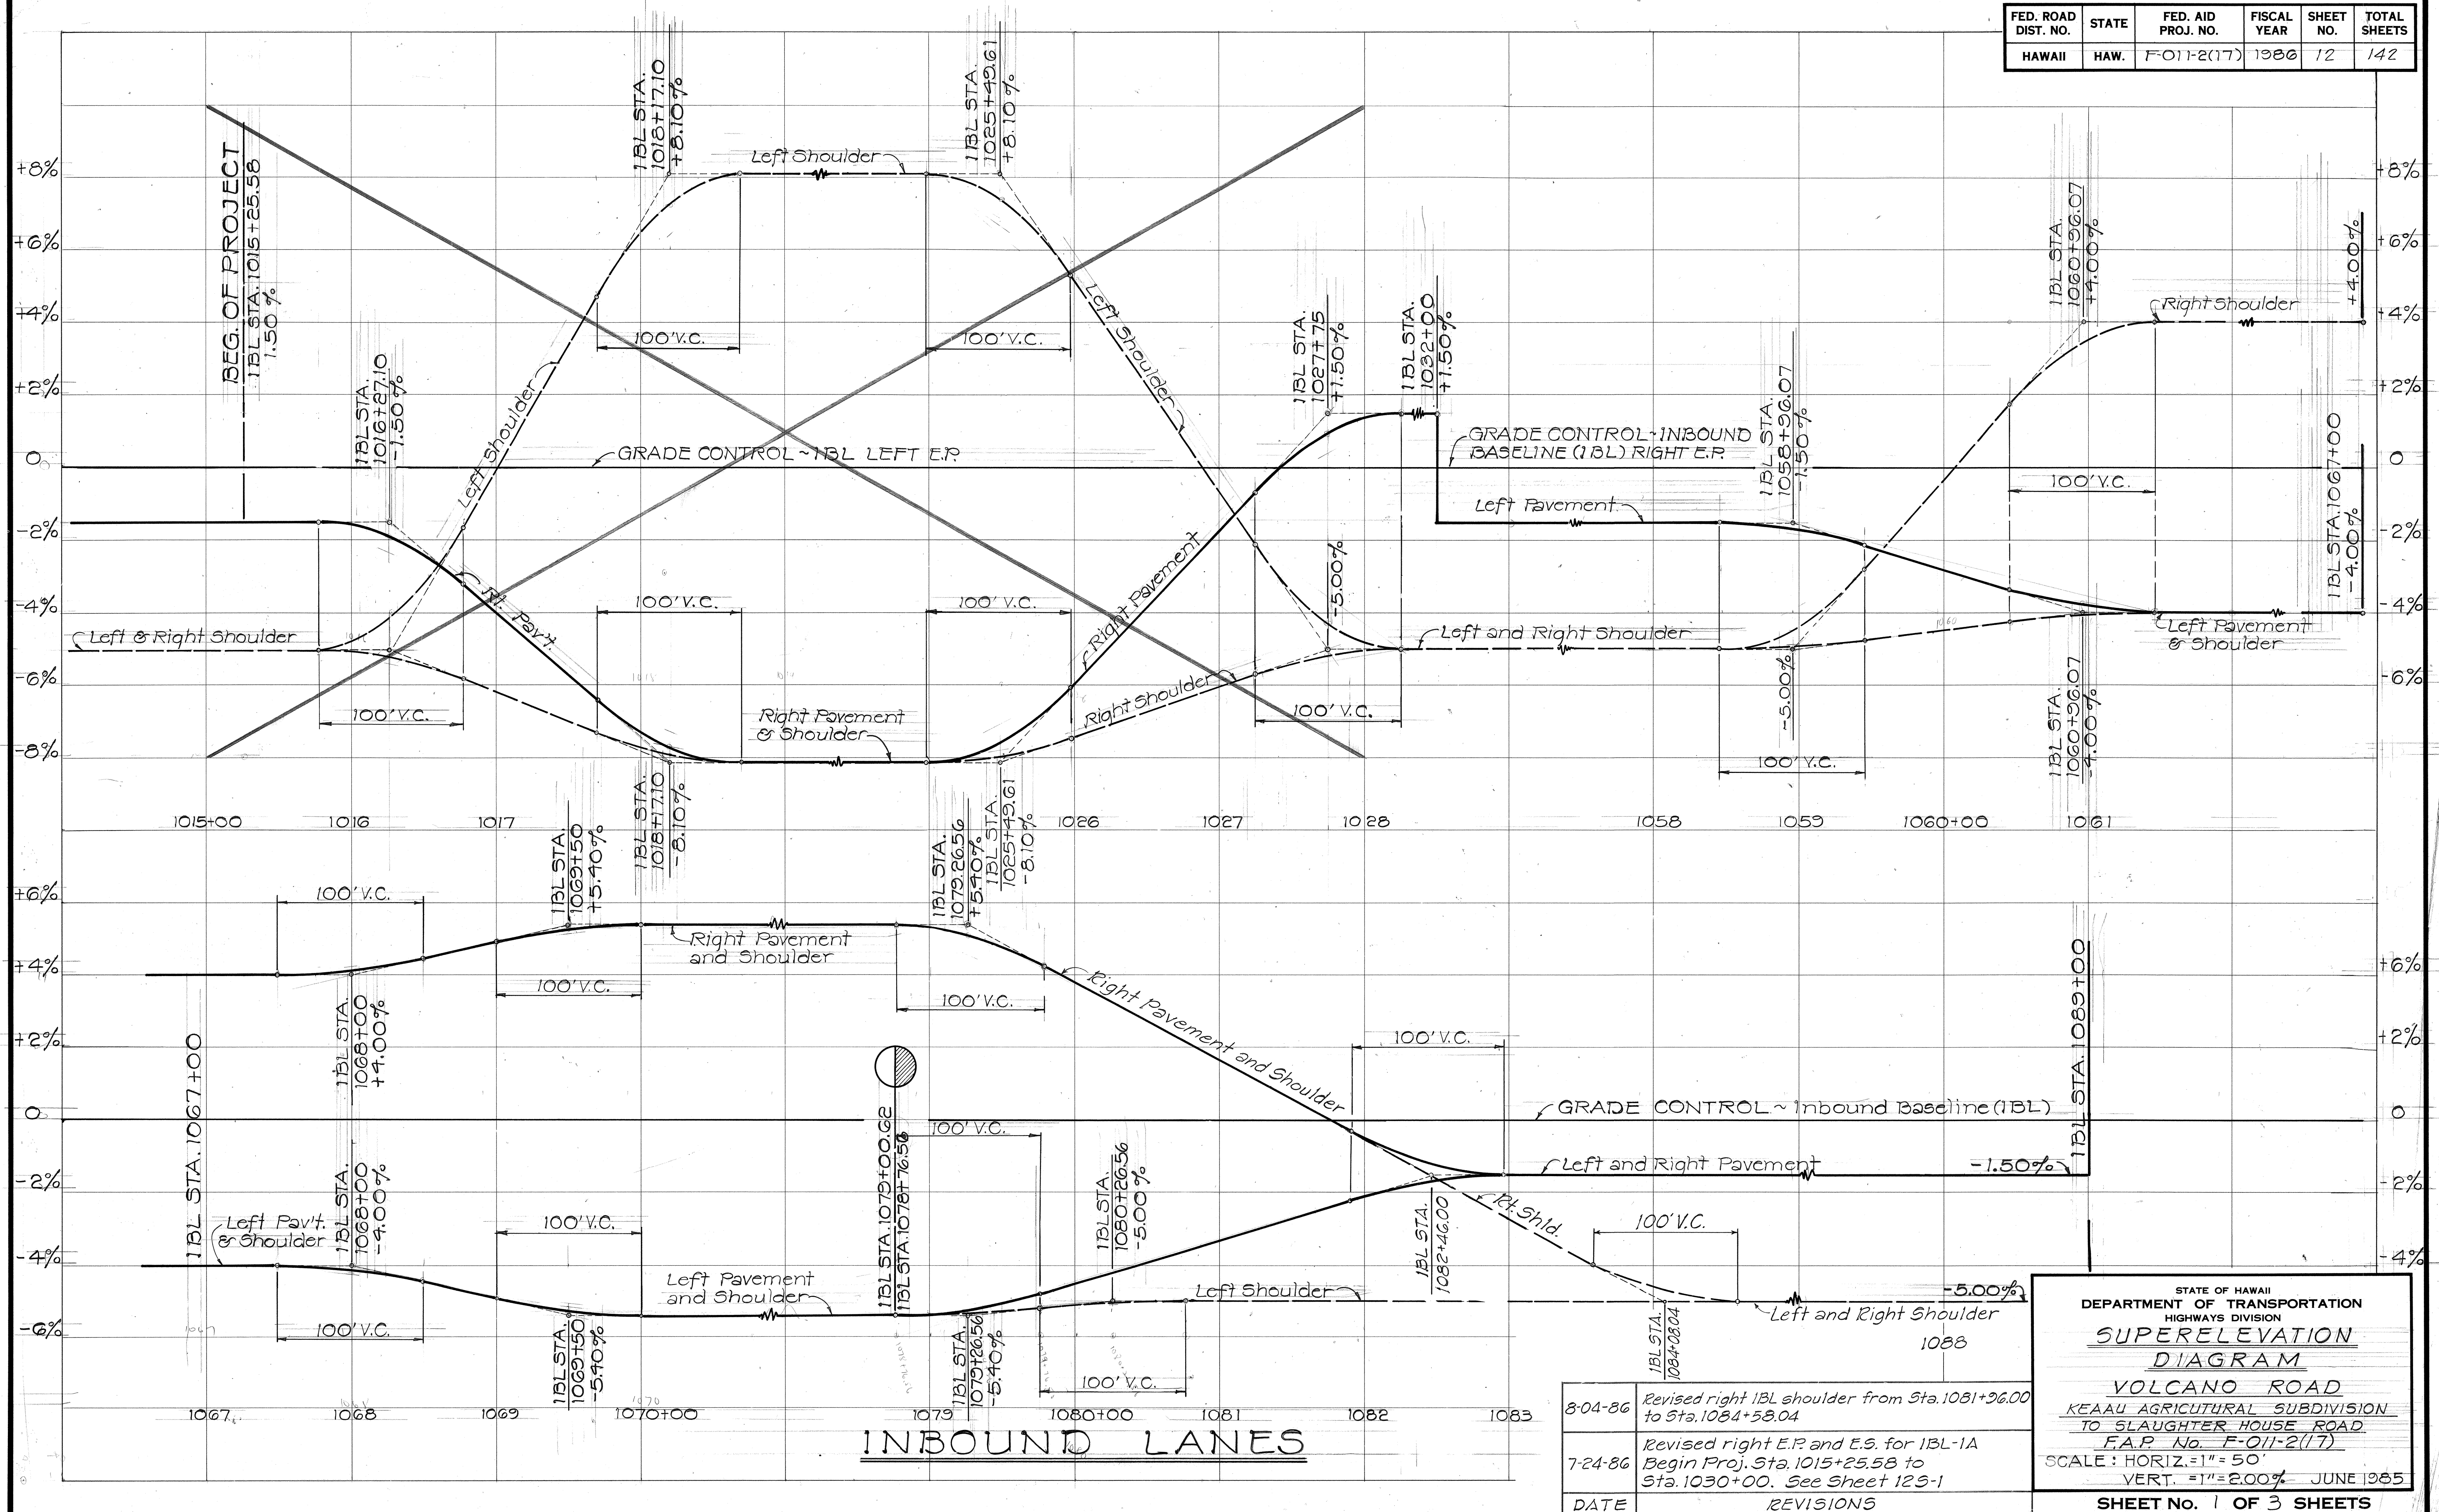

8-04-86	Revised right IBL shoulder from Sta. 1081+26.00 to Sta. 1084+58.04
7-24-86	Revised right E.P. and E.S. for IBL-1A Begin Proj. Sta. 1015+25.58 to Sta. 1030+00. See Sheet 129-1
DATE	REVISIONS

STATE OF HAWAII
DEPARTMENT OF TRANSPORTATION
HIGHWAYS DIVISION
SUPERELEVATION
DIAGRAM
VOLCANO ROAD
KEAAU AGRICULTURAL SUBDIVISION
TO SLAUGHTER HOUSE ROAD
F.A.P. No. F-011-2(17)
SCALE: HORIZ.=1"= 50'
VERT. =1"= 2.00% JUNE 1985
SHEET NO. 1 OF 3 SHEETS

FED. ROAD DIST. NO.	STATE	FED. AID PROJ. NO.	FISCAL YEAR	SHEET NO.	TOTAL SHEETS
HAWAII	HAW.	F-011-2(17)			



INBOUND LANE - 1-A


ORIGINAL PLAN	DATE
SURVEY PLOTTED BY	
DRAWN BY	
DESIGNED BY	
QUANTITIES BY	
CHECKED BY	

7-24-86	REVISED RIGHT E.P. FROM STA. 1028+50 TO 1030+00
DATE	REVISIONS




STATE OF HAWAII
DEPARTMENT OF TRANSPORTATION
HIGHWAYS DIVISION
**SUPERELEVATION
DIAGRAM**
VOLCANO ROAD
KEAAU AGRICULTURAL SUBDIVISION
TO SLAUGHTER HOUSE ROAD
FAP No. F-011-2(17)
Scale: Horz: 1"=50'
Vert: 1"=2.00% Date: June 1986
SHEET NO. OF SHEETS

C.O. 12 S-1


FED. ROAD DIST. NO.	STATE	FED. AID PROJ. NO.	FISCAL YEAR	SHEET NO.	TOTAL SHEETS
HAWAII	HAW.	F-011-2(17)	1986	13	142

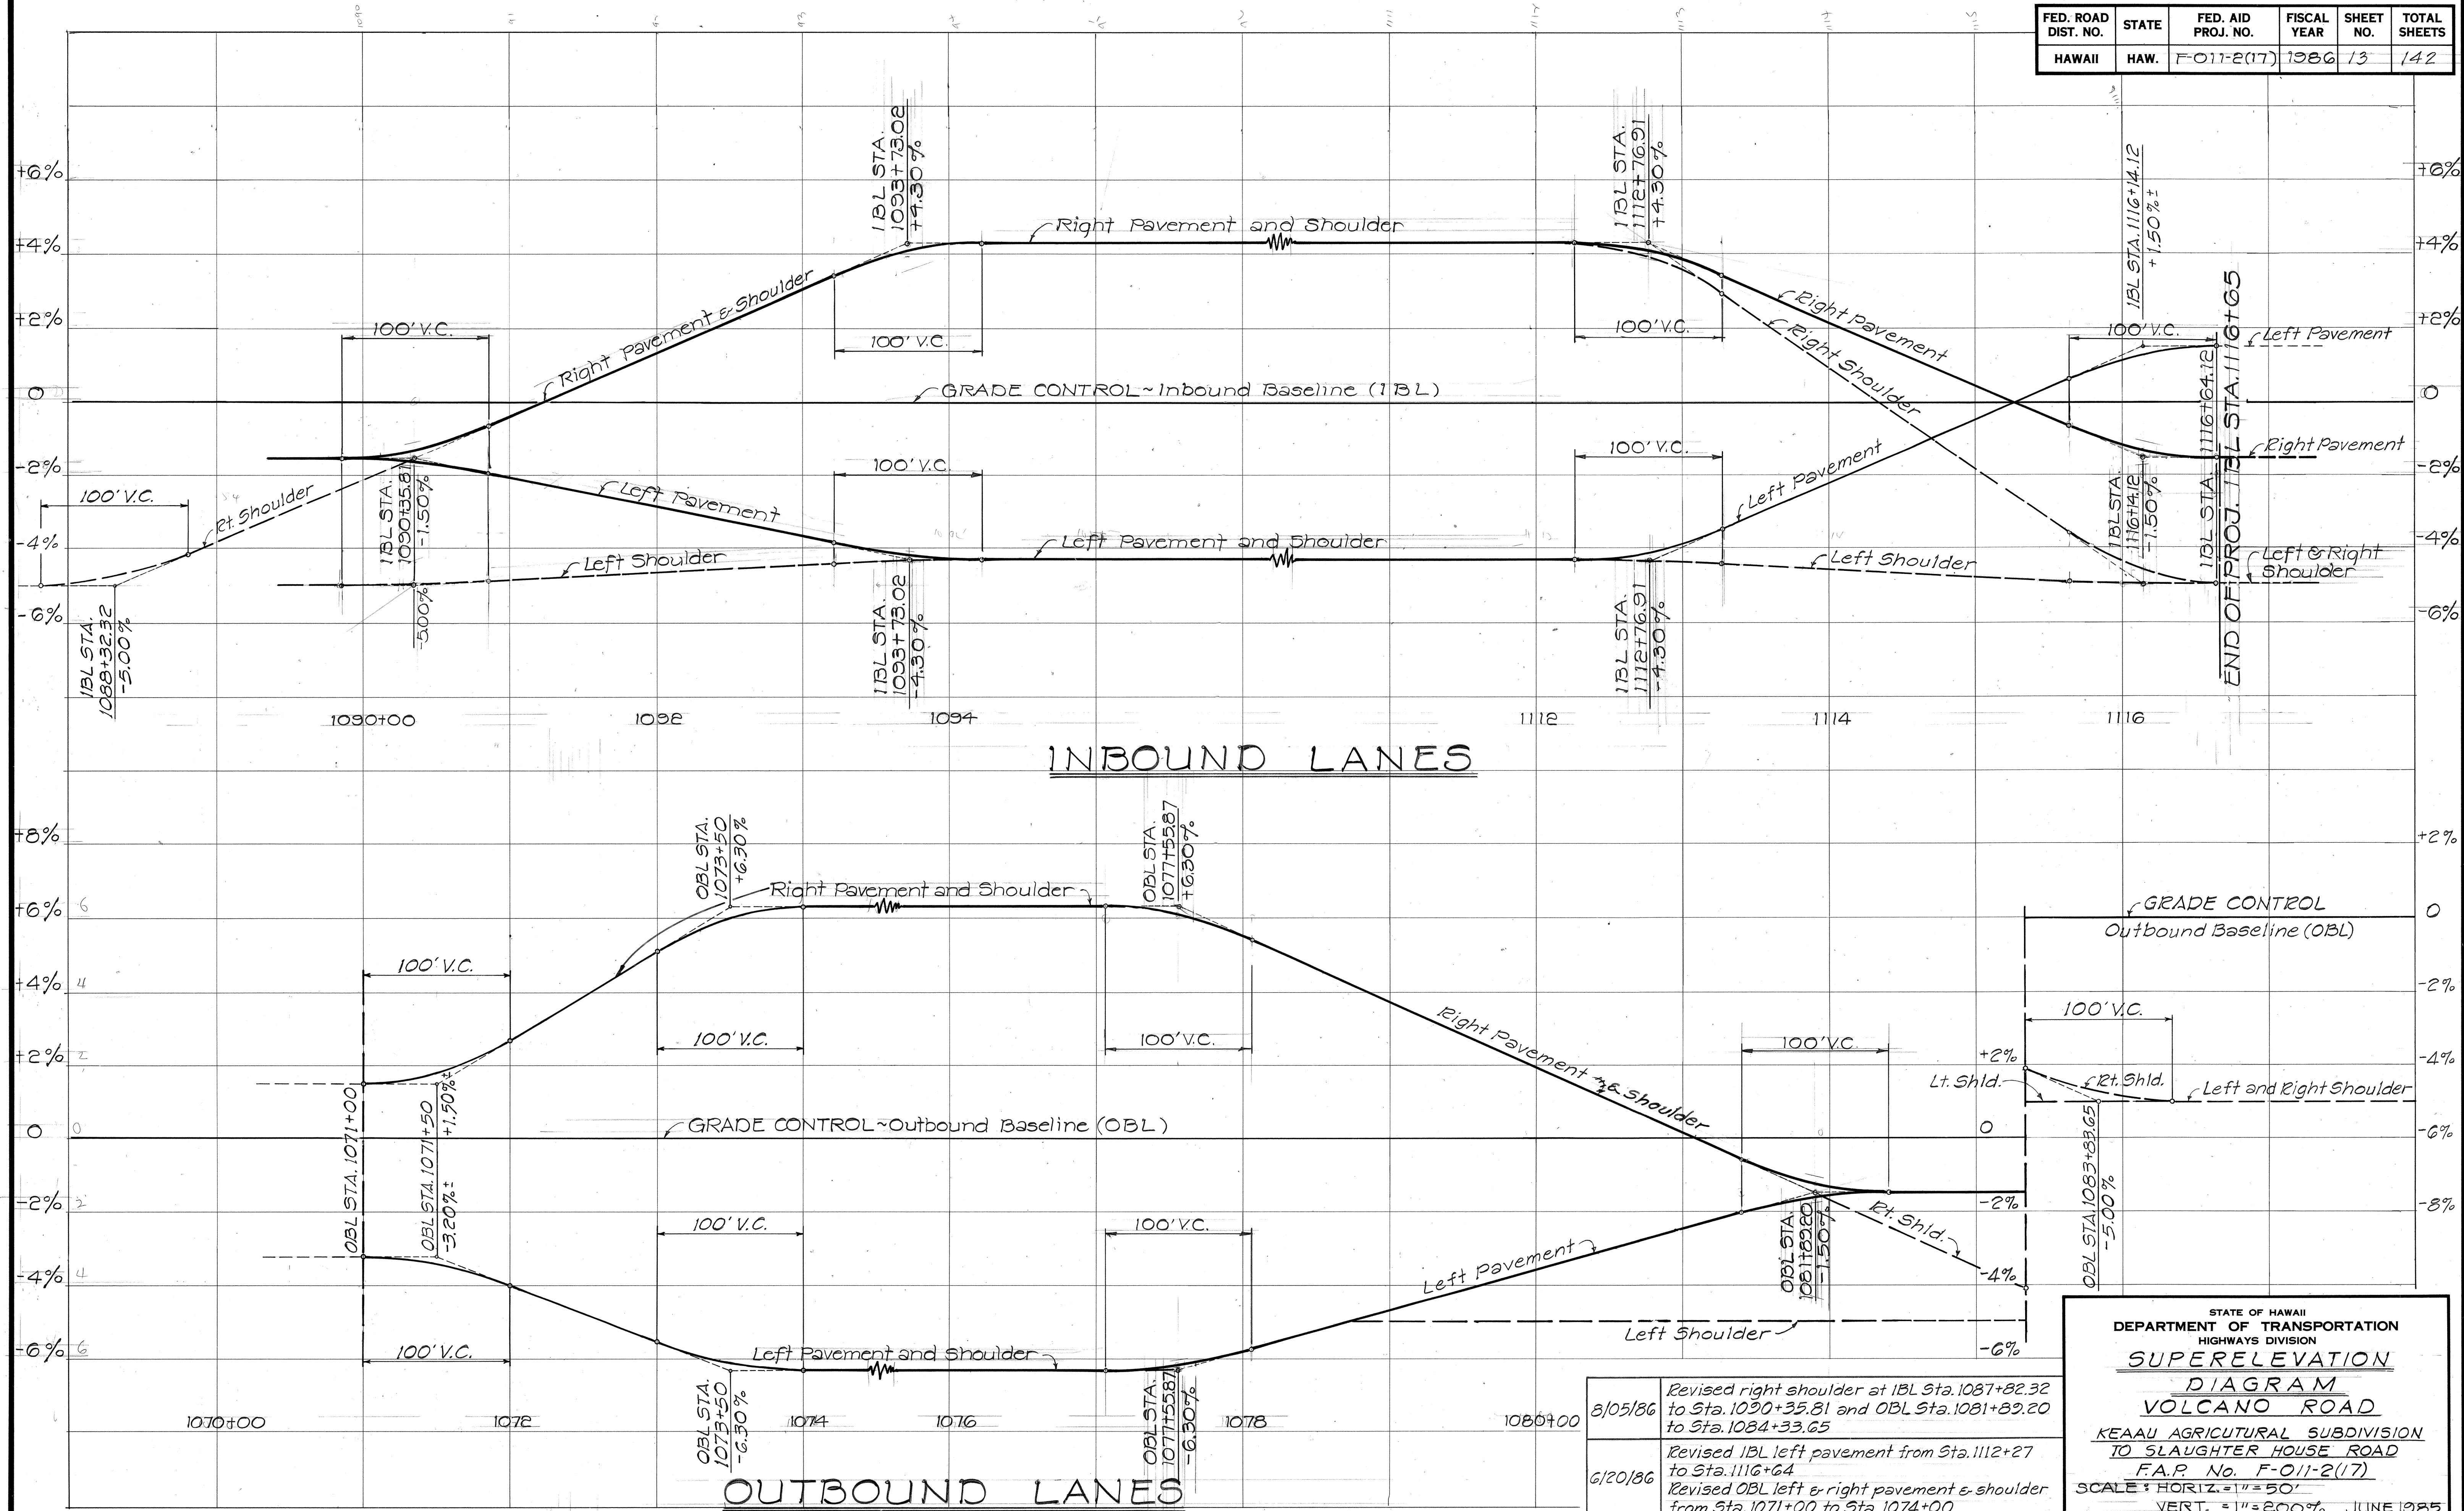


FED. ROAD DIST. NO.	STATE	FED. AID PROJ. NO.	FISCAL YEAR	SHEET NO.	TOTAL SHEETS
HAWAII	HAW.	F-011-2(17)	1986	14	142

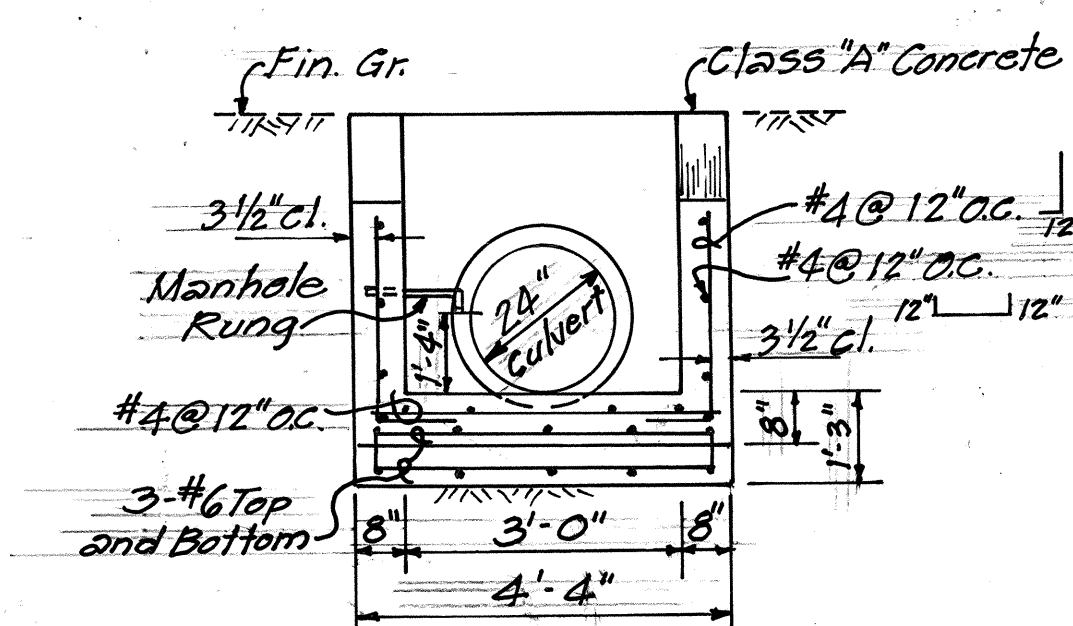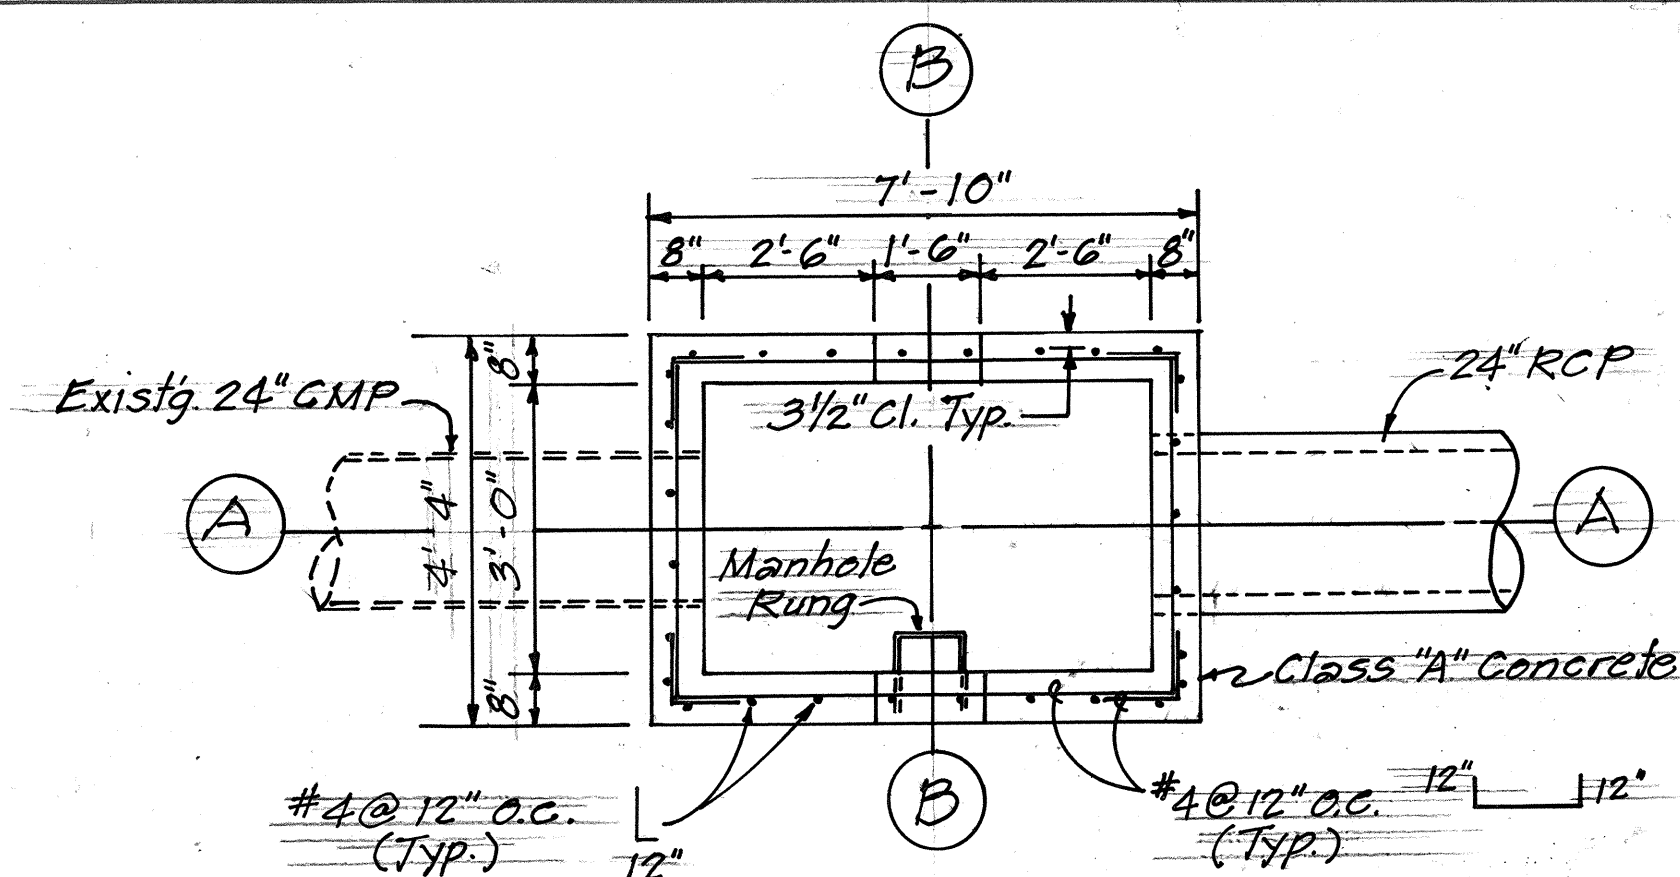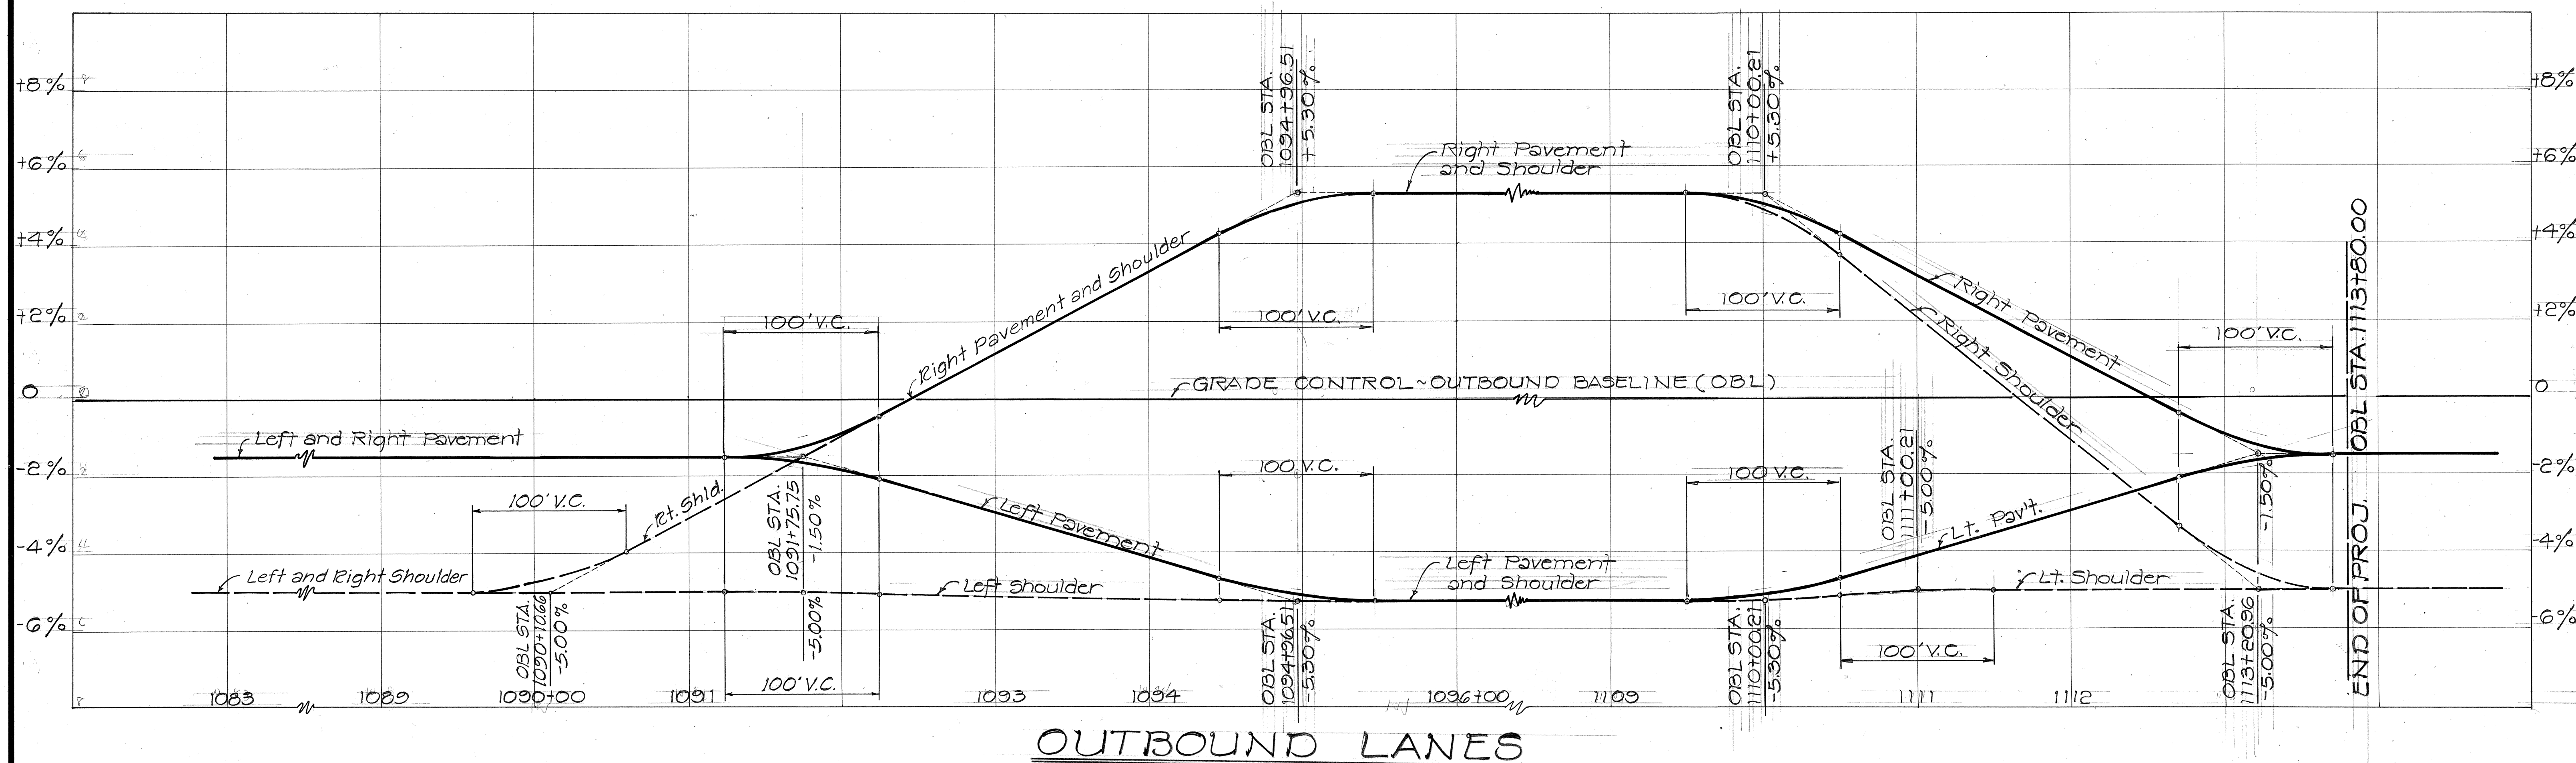

NOTE: For Additional Reinforcing Around the Culverts See Sht. 58 for Detail C.C.O. NO. 17

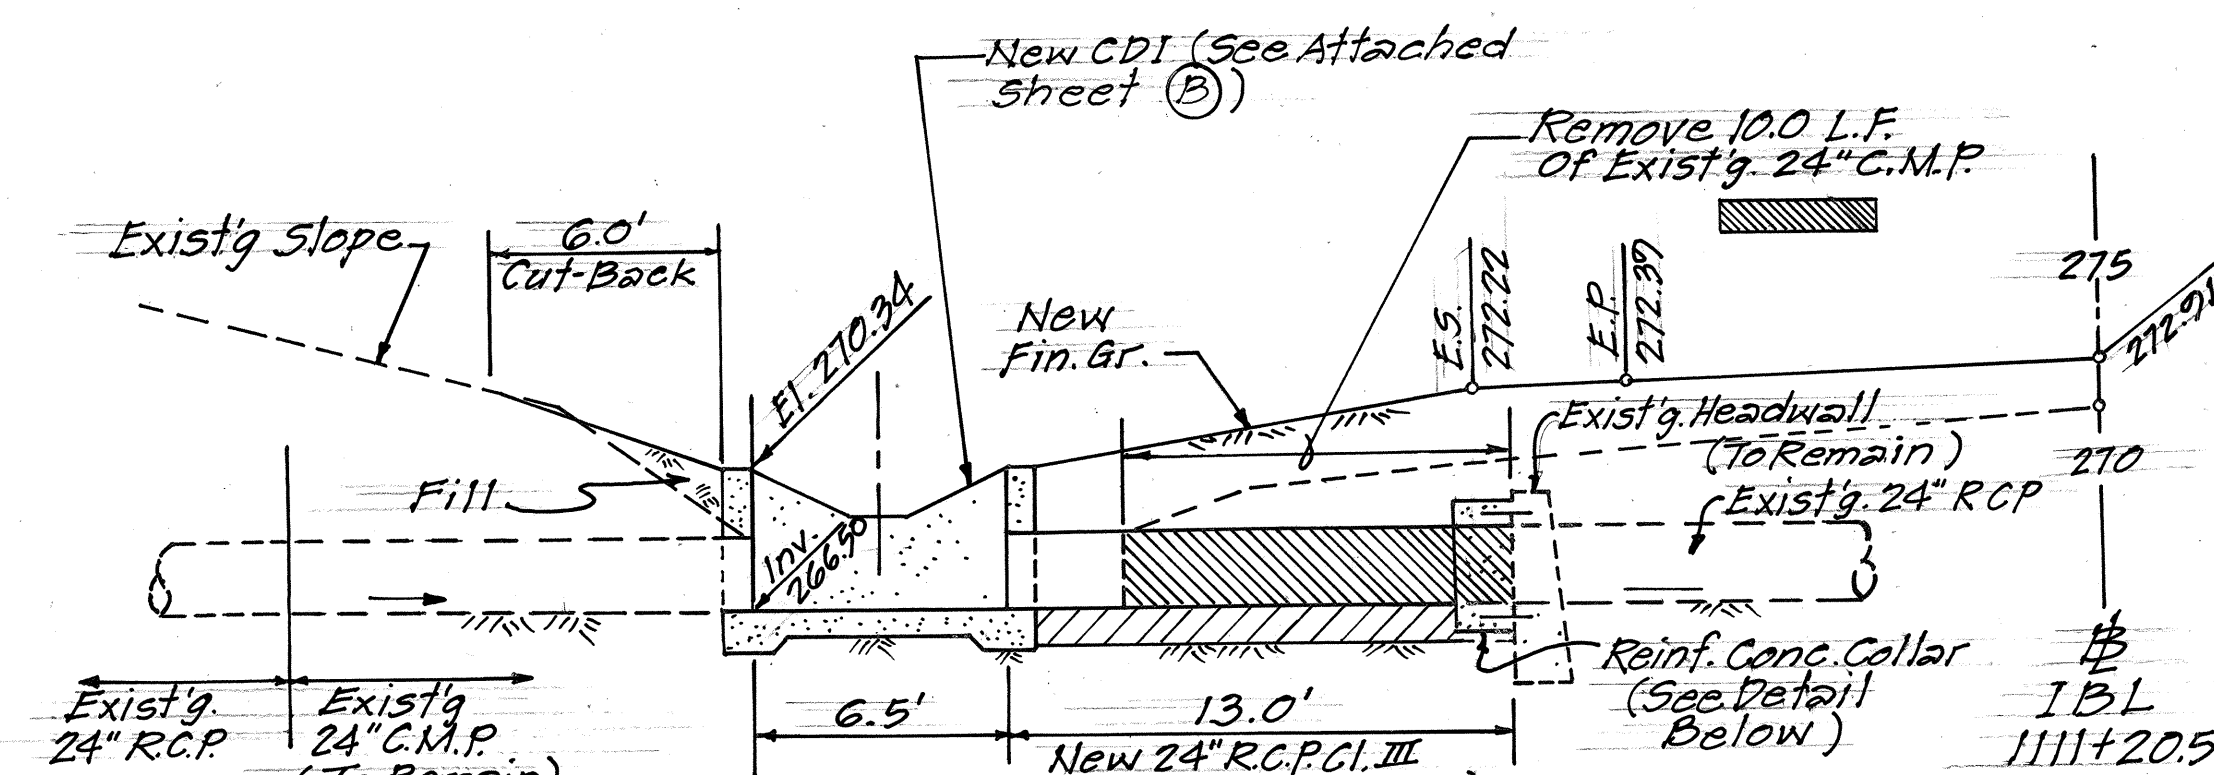

SECTION @ I.B.L. STA. 1111+20.5 LT.
SCALE: 1" = 5.0'

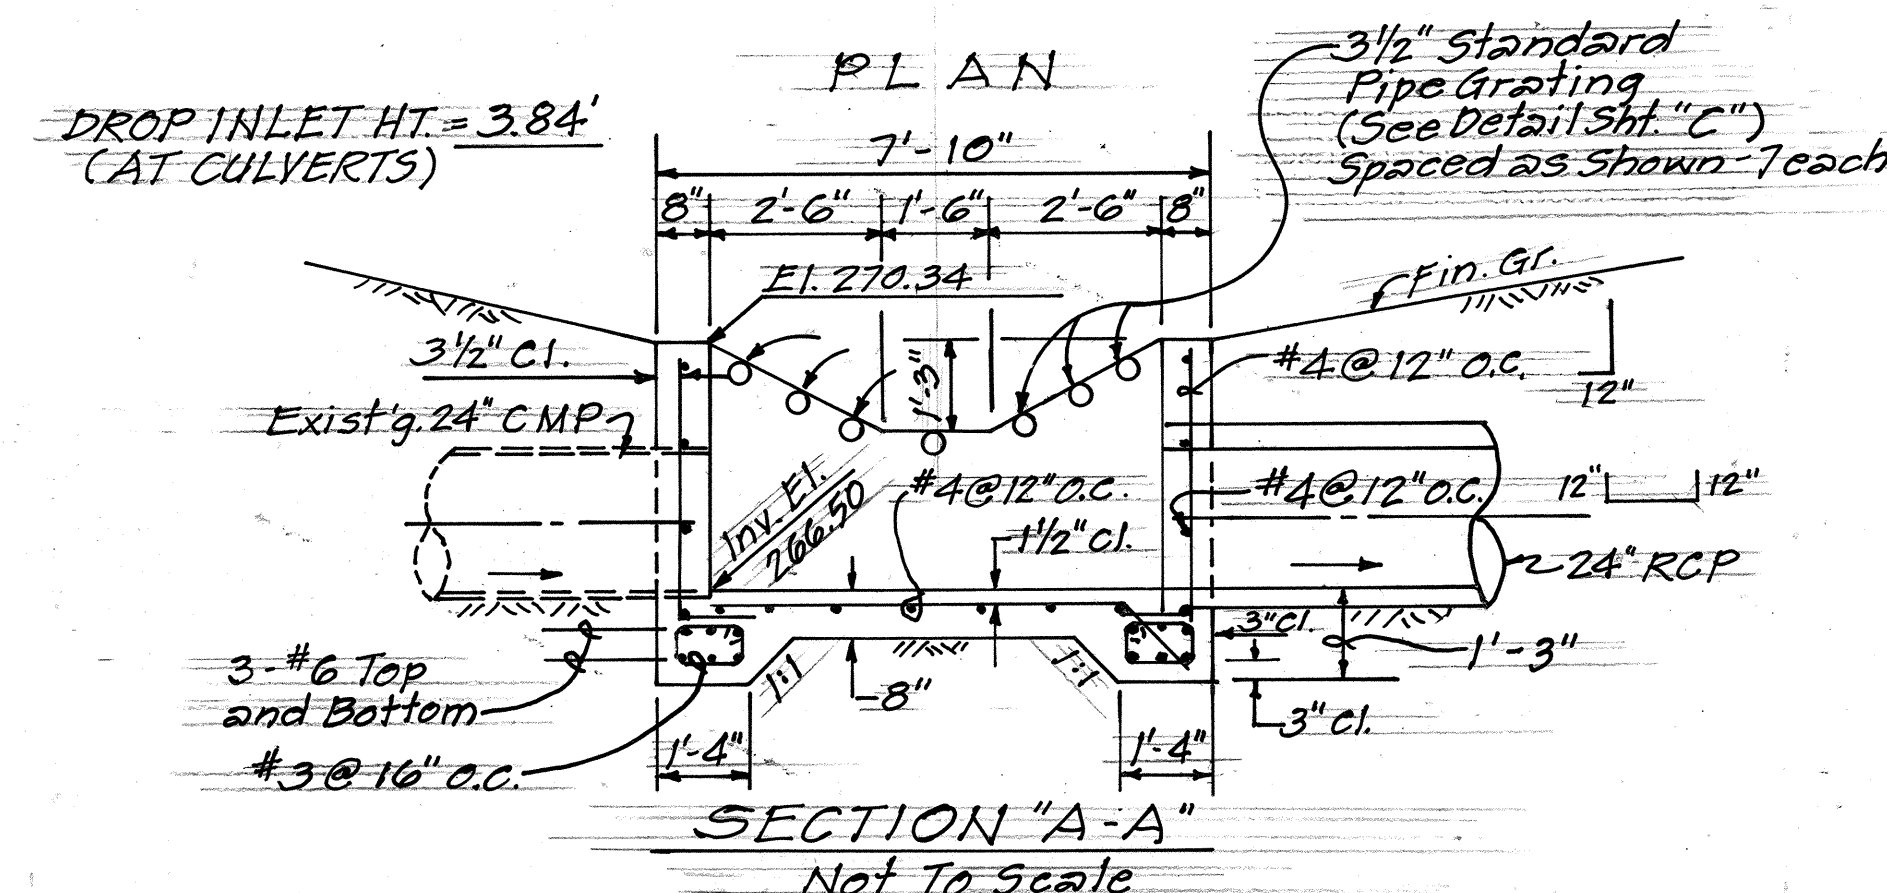

SECTION "B-B"
DROP INLET @ I.B.L. STA. 1111+20.5 LT.
Not To Scale

NOTE: This Tracing/Detail Prepared During "As-Built"

8/05/86	Revised right OBL shoulder from Sta. 1089+60.66 to Sta. 1091+75.75
DATE	REVISIONS

STATE OF HAWAII
DEPARTMENT OF TRANSPORTATION
HIGHWAYS DIVISION
**SUPERELEVATION
DIAGRAM**
VOLCANO ROAD
KEAAU AGRICULTURAL SUBDIVISION
TO SLAUGHTER HOUSE ROAD
F.A.P. No. F-011-2(17)
SCALE: HORIZ. 1" = 50'
VERT. 1" = 2.00'
JUNE 1985
SHEET NO. 3 OF 3 SHEETS