

FED. ROAD DIST. NO.	STATE	PROJ. NO.	FISCAL YEAR	SHEET NO.	TOTAL SHEETS
HAWAII	HAW.	11C-01-89 12J-01-89	1990	3	4

GENERAL NOTES

1. New pole locations shall be staked by the Contractor and approved by the Engineer prior to excavation. Adjustment of pole locations in the field may be required to clear underground and aerial utility lines.
2. Contractor shall notify the Project Engineer from Dept. of Transportation, State Highways Division, 72 hours in advance before commencing work, phone 935-3347.
3. Contractor shall be responsible for coordinating and informing Hawaii Electric Light Co. of light pole location on site for installation of HELCO secondary cables.
4. Final acceptance and inspection will be undertaken only after all work has been completed.
5. Contractor shall at his expense keep the project and surrounding area from dust nuisance and shall be responsible for cleanup and removal of all silt and debris generated by the excavation work and deposited and accumulated within ditches, drain pipes and on public roadways.
6. All existing utilities whether or not shown on plans shall be protected at all times during construction and any damages to them shall be repaired and paid for by the contractor. Contractor's attention is called to Section 107.21, 'Contractor's Responsibility for Utility Property and Services,' of the 'Hawaii Standard Specifications for Road and Bridge Construction'.
7. Secondary Aerial Cables to new poles will be furnished and installed by HELCO.
8. Contractor shall procure all permits and pay any necessary fees for the lawful prosecution of the work. Costs are incidental to the various items of work.
9. Removal of existing signs shall be incidental to Item No. 626.0100-Flashing School Speed Limit Sign.

STATE OF HAWAII

DEPARTMENT OF TRANSPORTATION

HIGHWAYS DIVISION

FLASHING LIGHT DETAILS

HAWAII BELT ROAD

Flashing Warning Lights at Hookena School





Proj. no. 11C-01-89

Scale: As Noted

Date: March 1990

SHEET NO. 1 OF 1 SHEETS

3

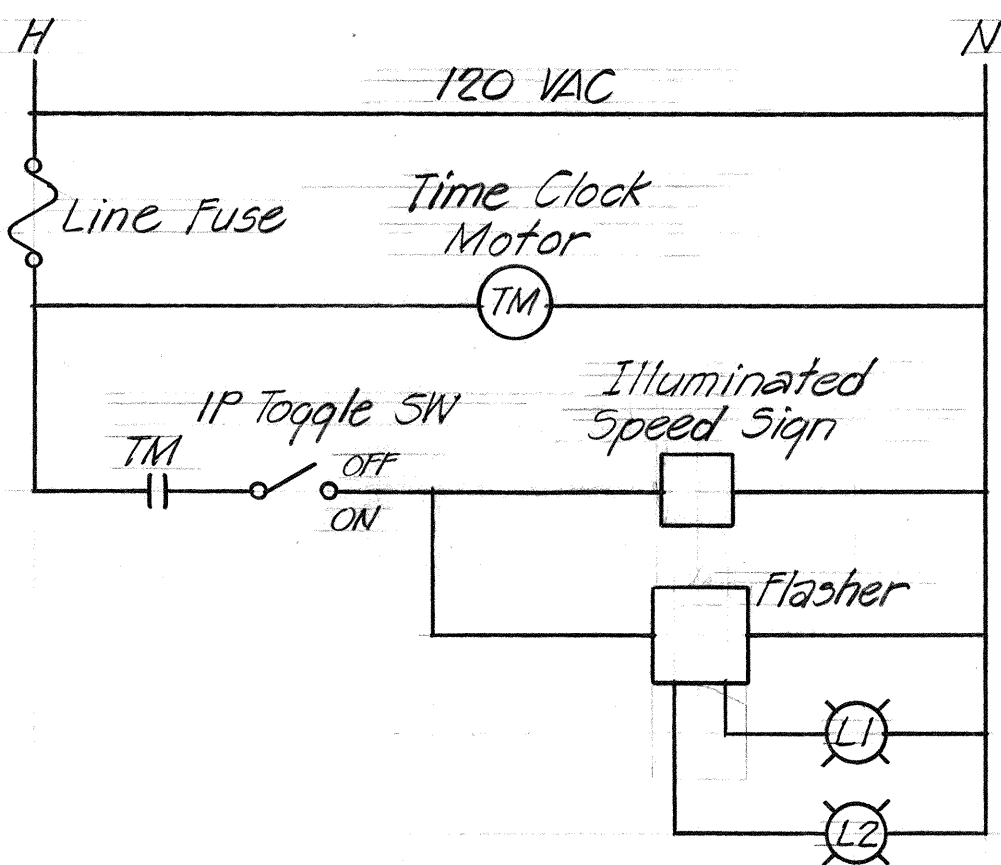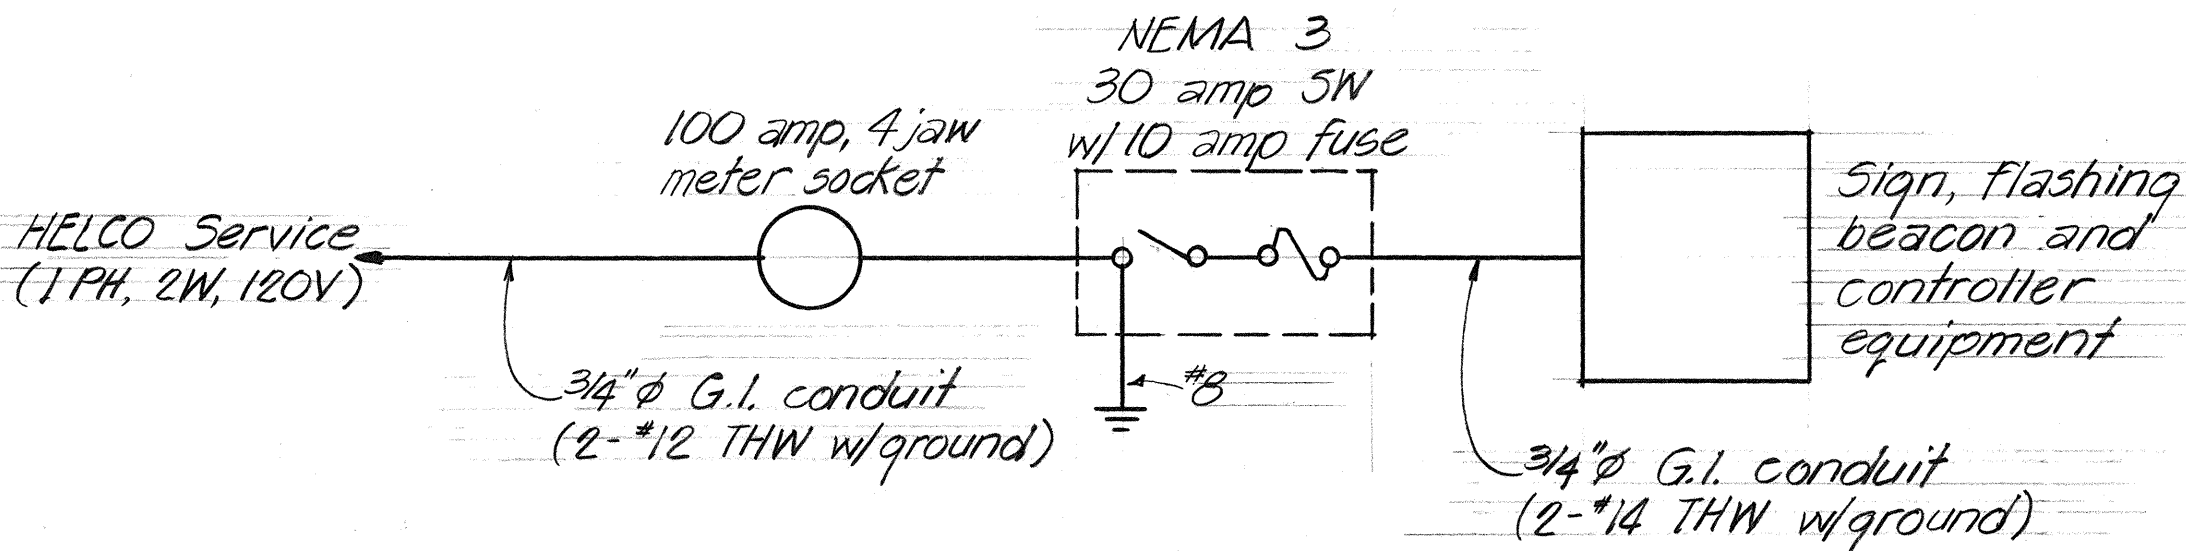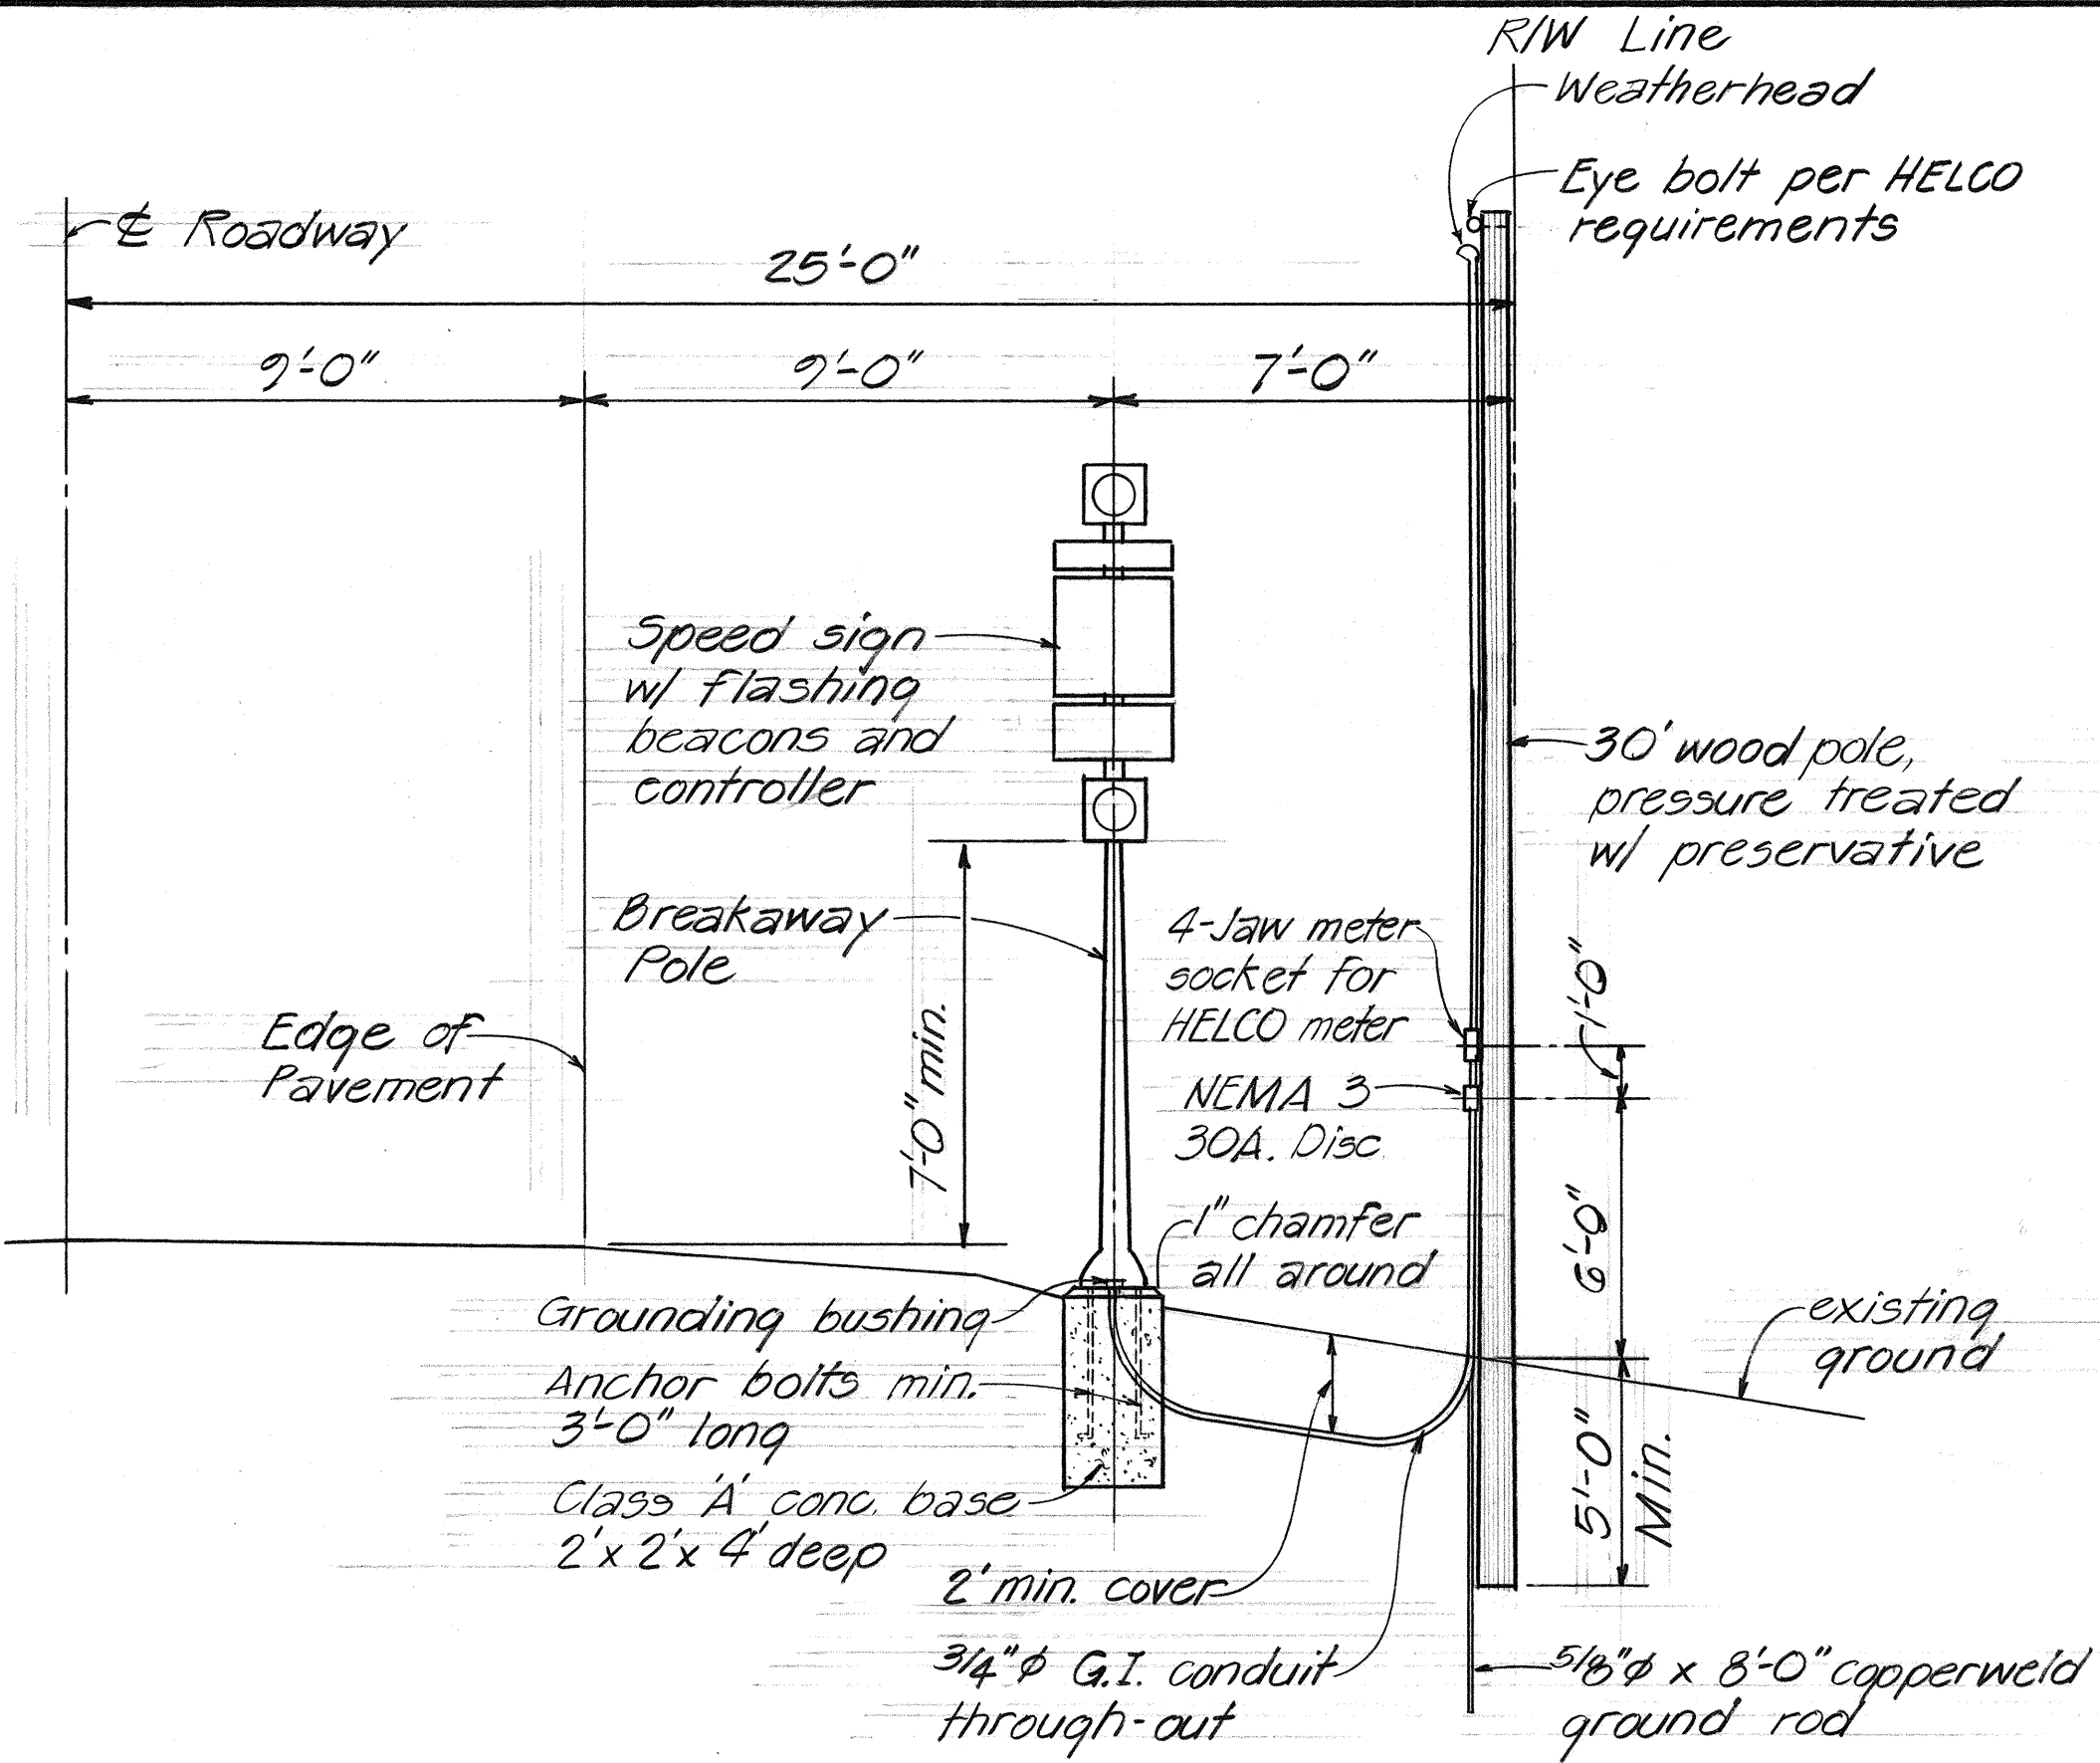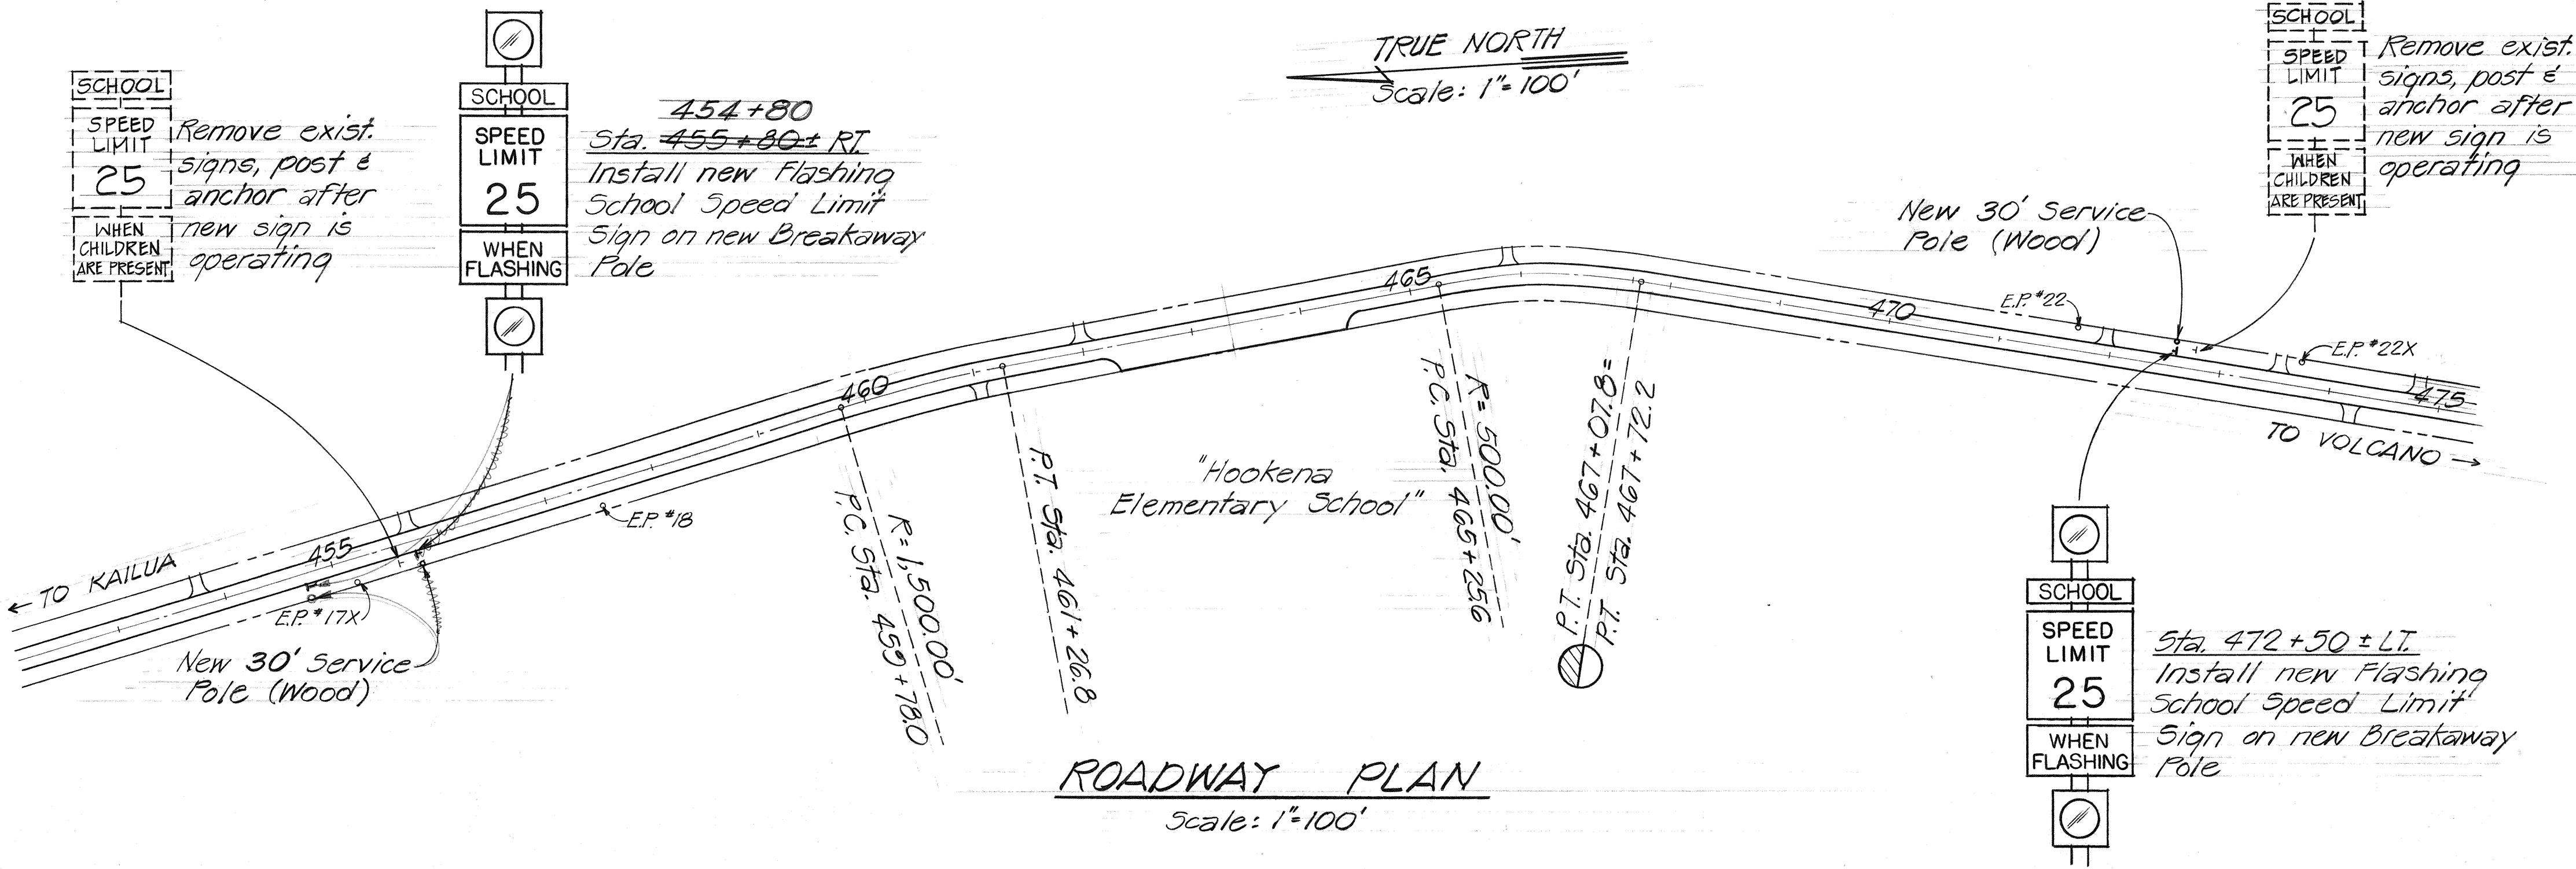

SURVEY PLOTTED BY	DATE
DRAWN BY	
TRACED BY	
CHECKED BY	
NO.	