

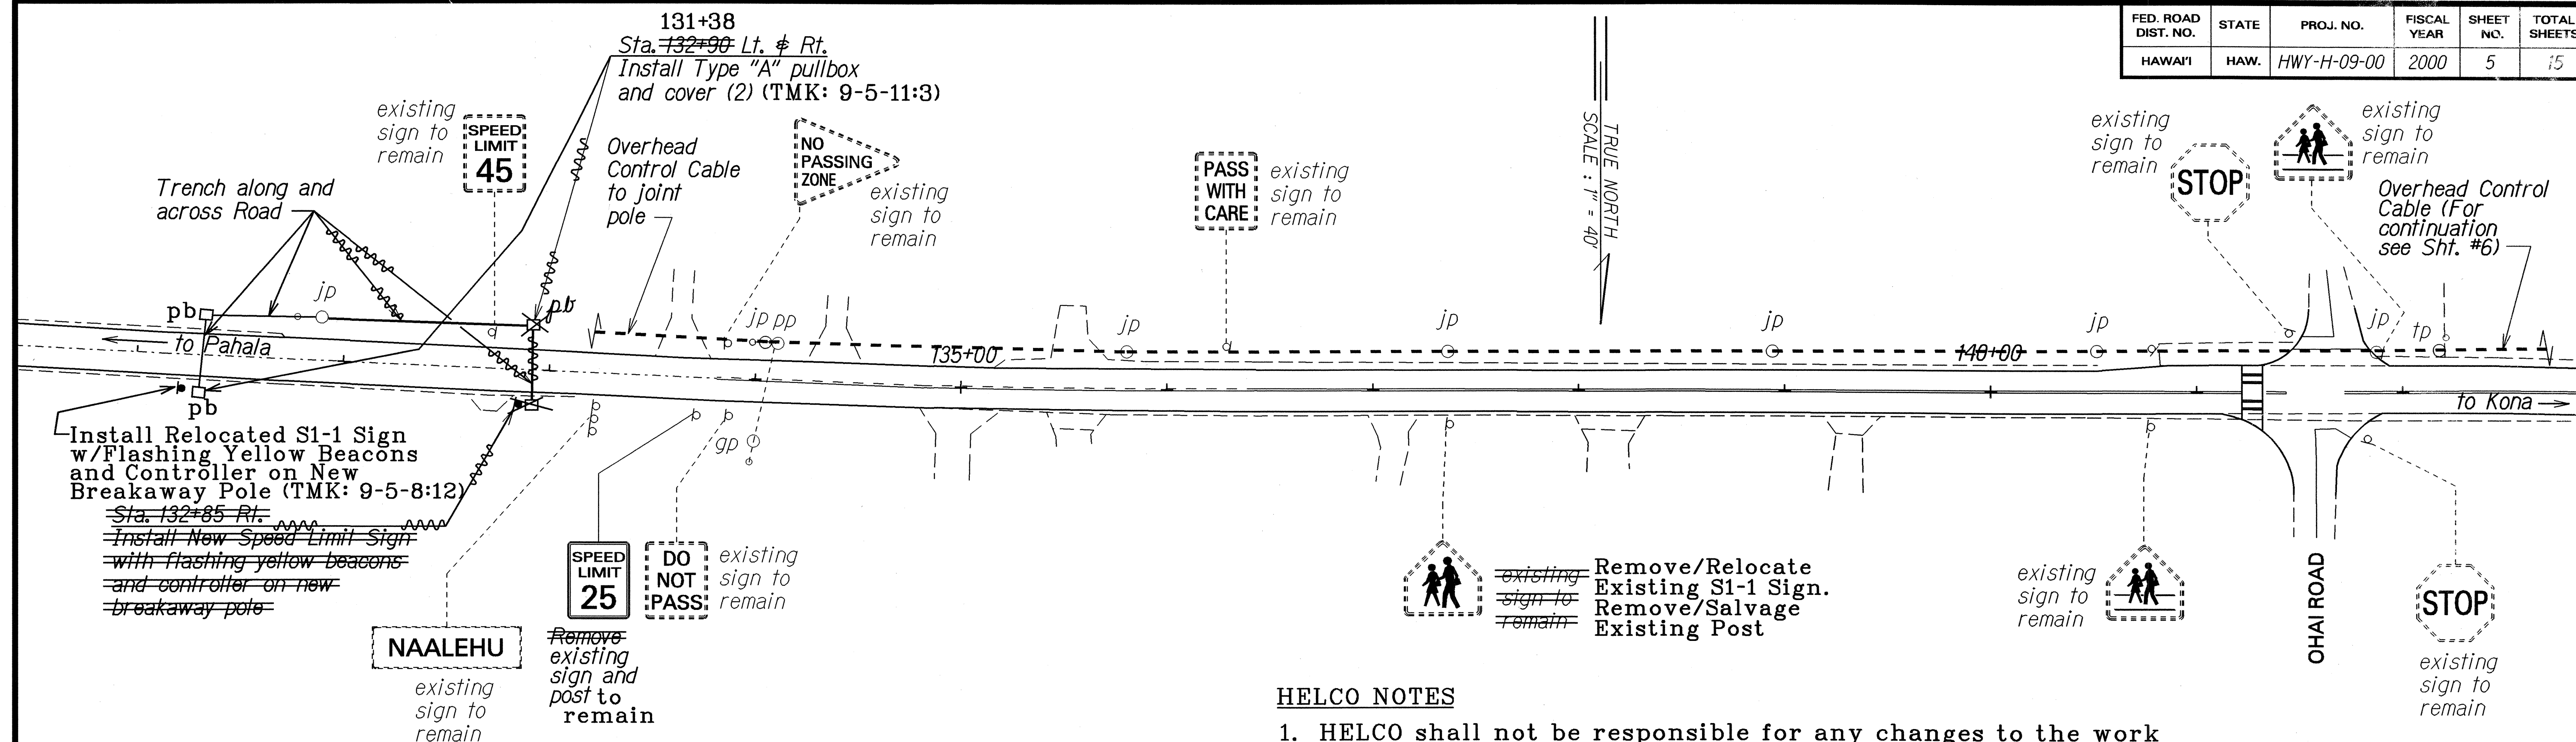


FED. ROAD DIST. NO.	STATE	PROJ. NO.	FISCAL YEAR	SHEET NO.	TOTAL SHEETS
HAWAII	HAW.	HWY-H-09-00	2000	5	15

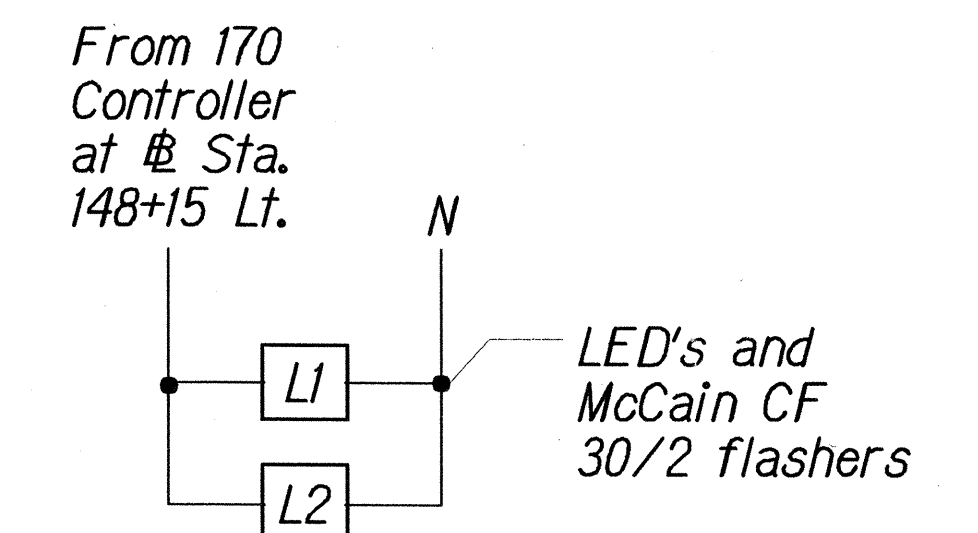

HELCO NOTES

- HELCO shall not be responsible for any changes to the work being performed.
- Electrical installation shall comply with:
 - HELCO's Electrical Service Installation Manual
 - Current National Electrical Code
 - HELCO's Project Drawing No. 01-B-306 and specifications
- Consult with HELCO's Engineering Department for any questions or clarifications regarding the electrical installation.

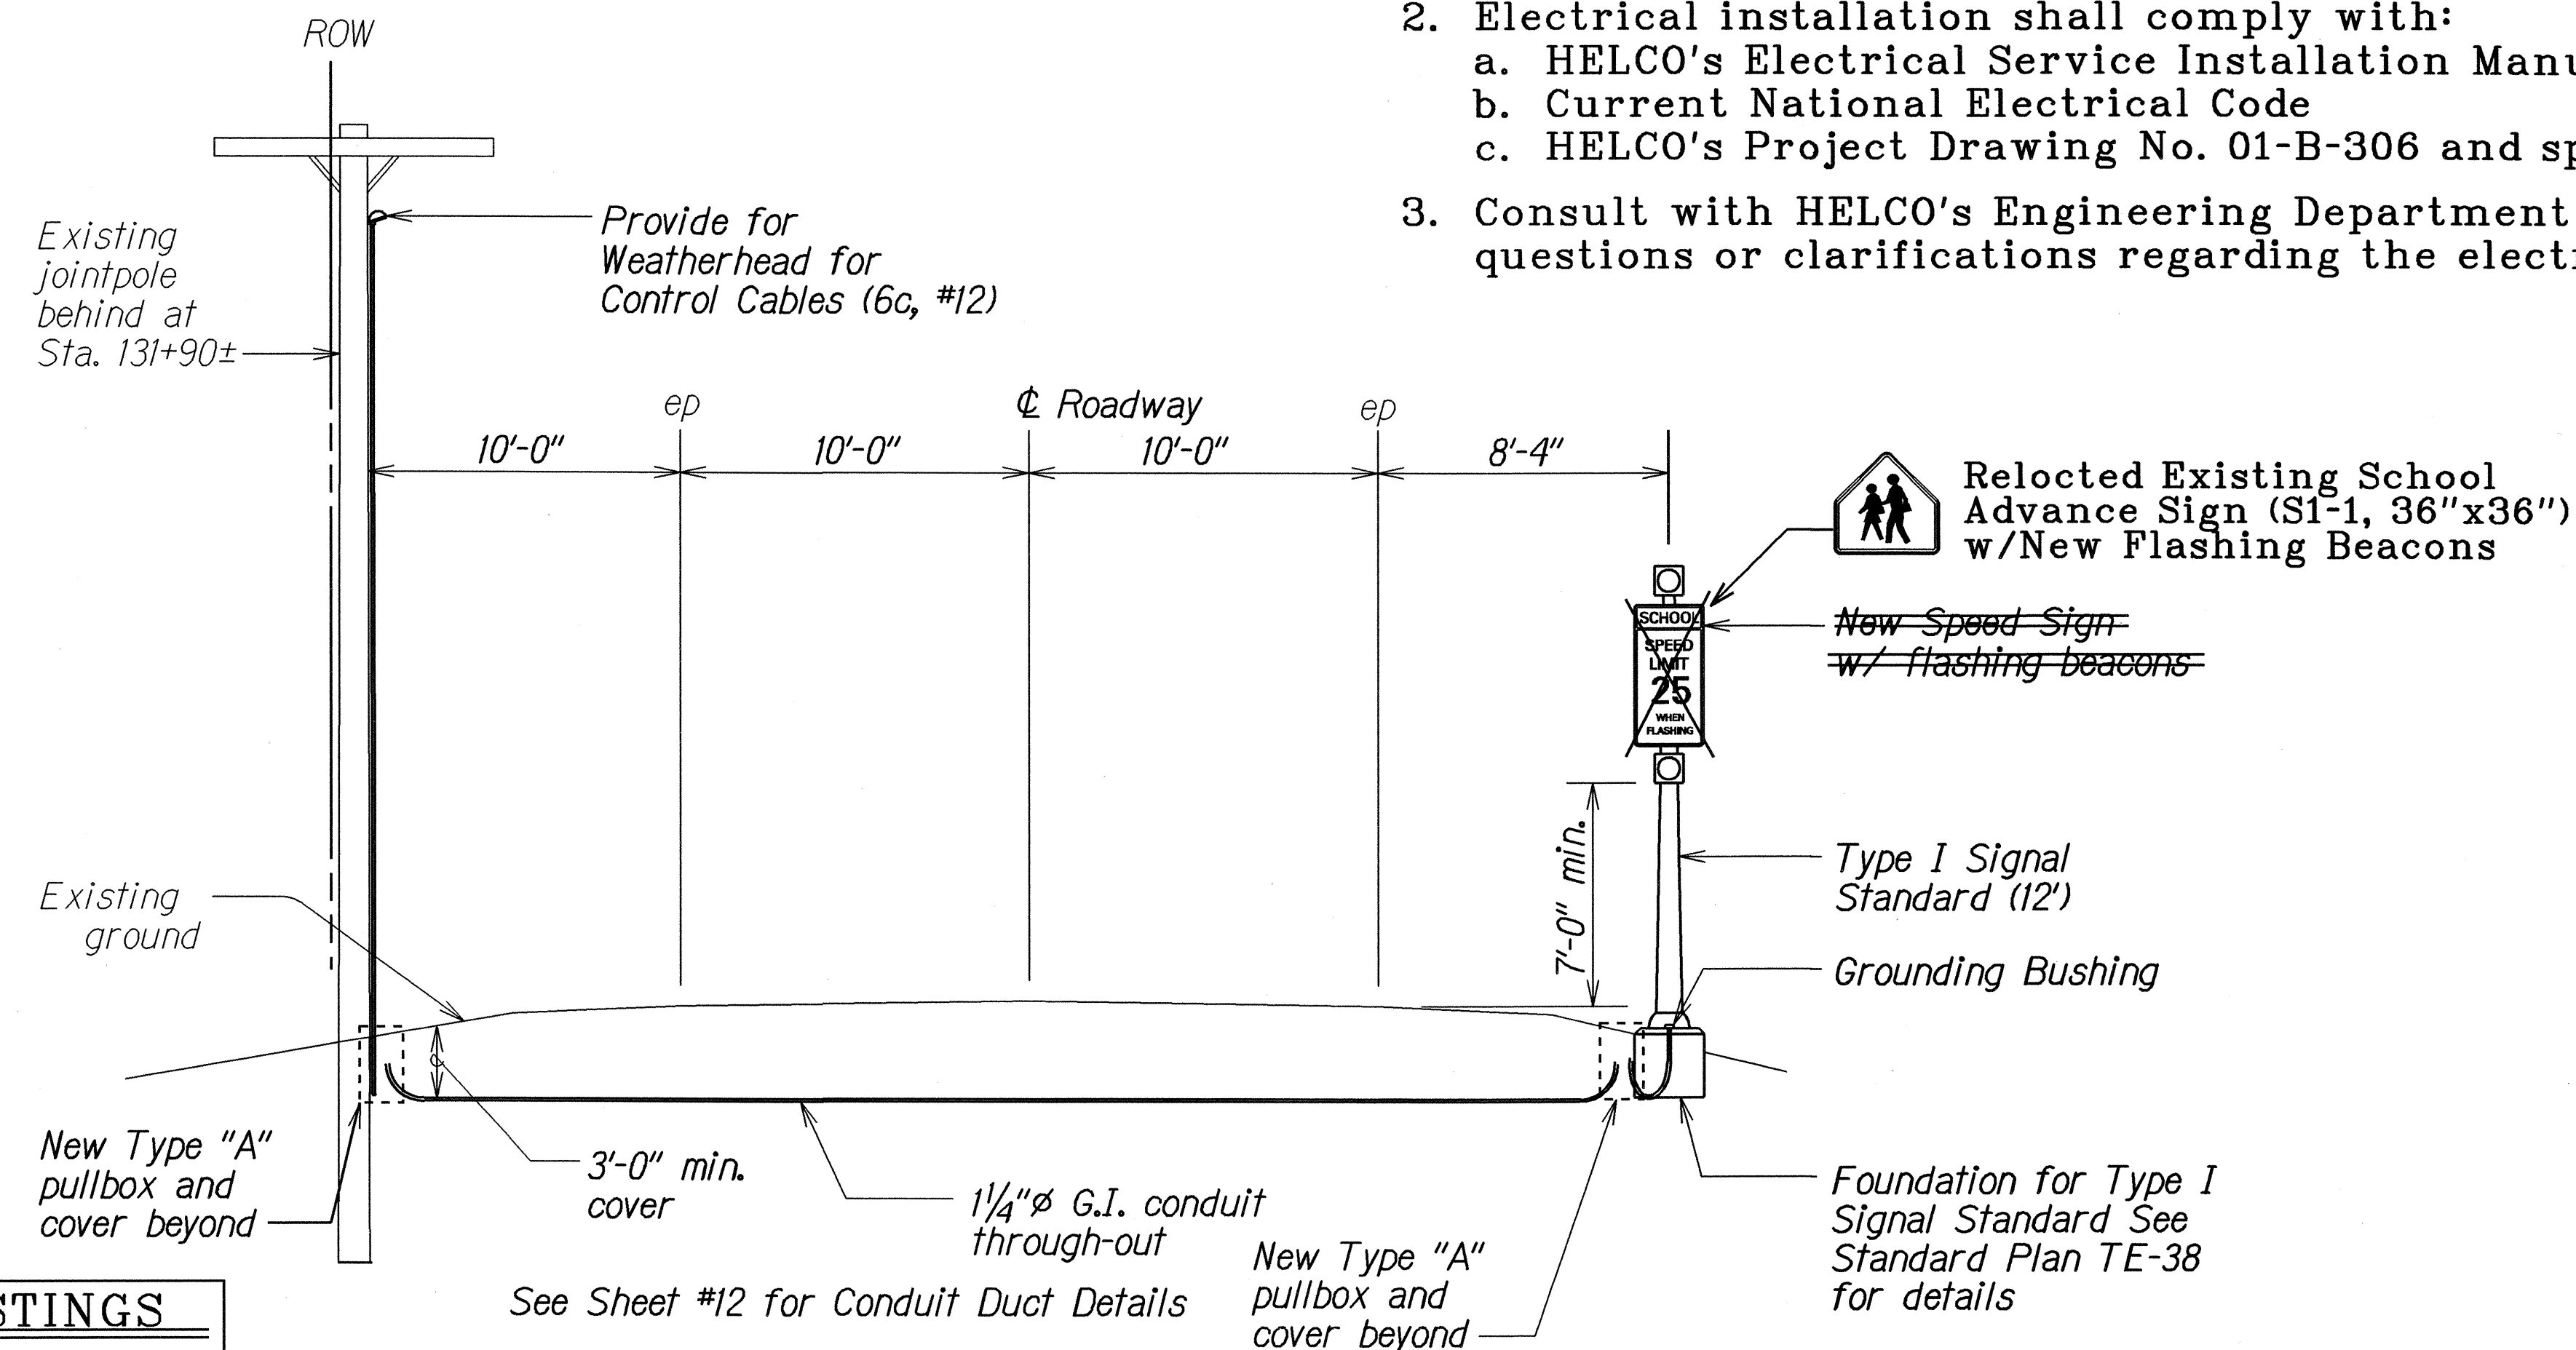

CONTROLLER SCHEMATIC
Scale: None

LEGEND FOR AS-BUILT POSTINGS	
	Squiggly line for as-built deletion
	Double line for as-built deletion
Roadway	Text for as-built posting

SECTION AT STA. 132+85
Scale: None

Note:
Section looking West


STATE OF HAWAII
DEPARTMENT OF TRANSPORTATION
HIGHWAYS DIVISION

PLAN AND DETAILS-SITE #2A

FLASHING WARNING LIGHTS
VARIOUS HIGHWAY LOCATIONS
PROJ. NO. HWY-H-09-00
Scale: Noted
Date: April, 2000



SHEET No. 1 OF 1 SHEETS

FED. ROAD DIST. NO.	STATE	PROJ. NO.	FISCAL YEAR	SHEET NO.	TOTAL SHEETS
HAWAII	HAW.	HWY-H-09-00	2000	6	15

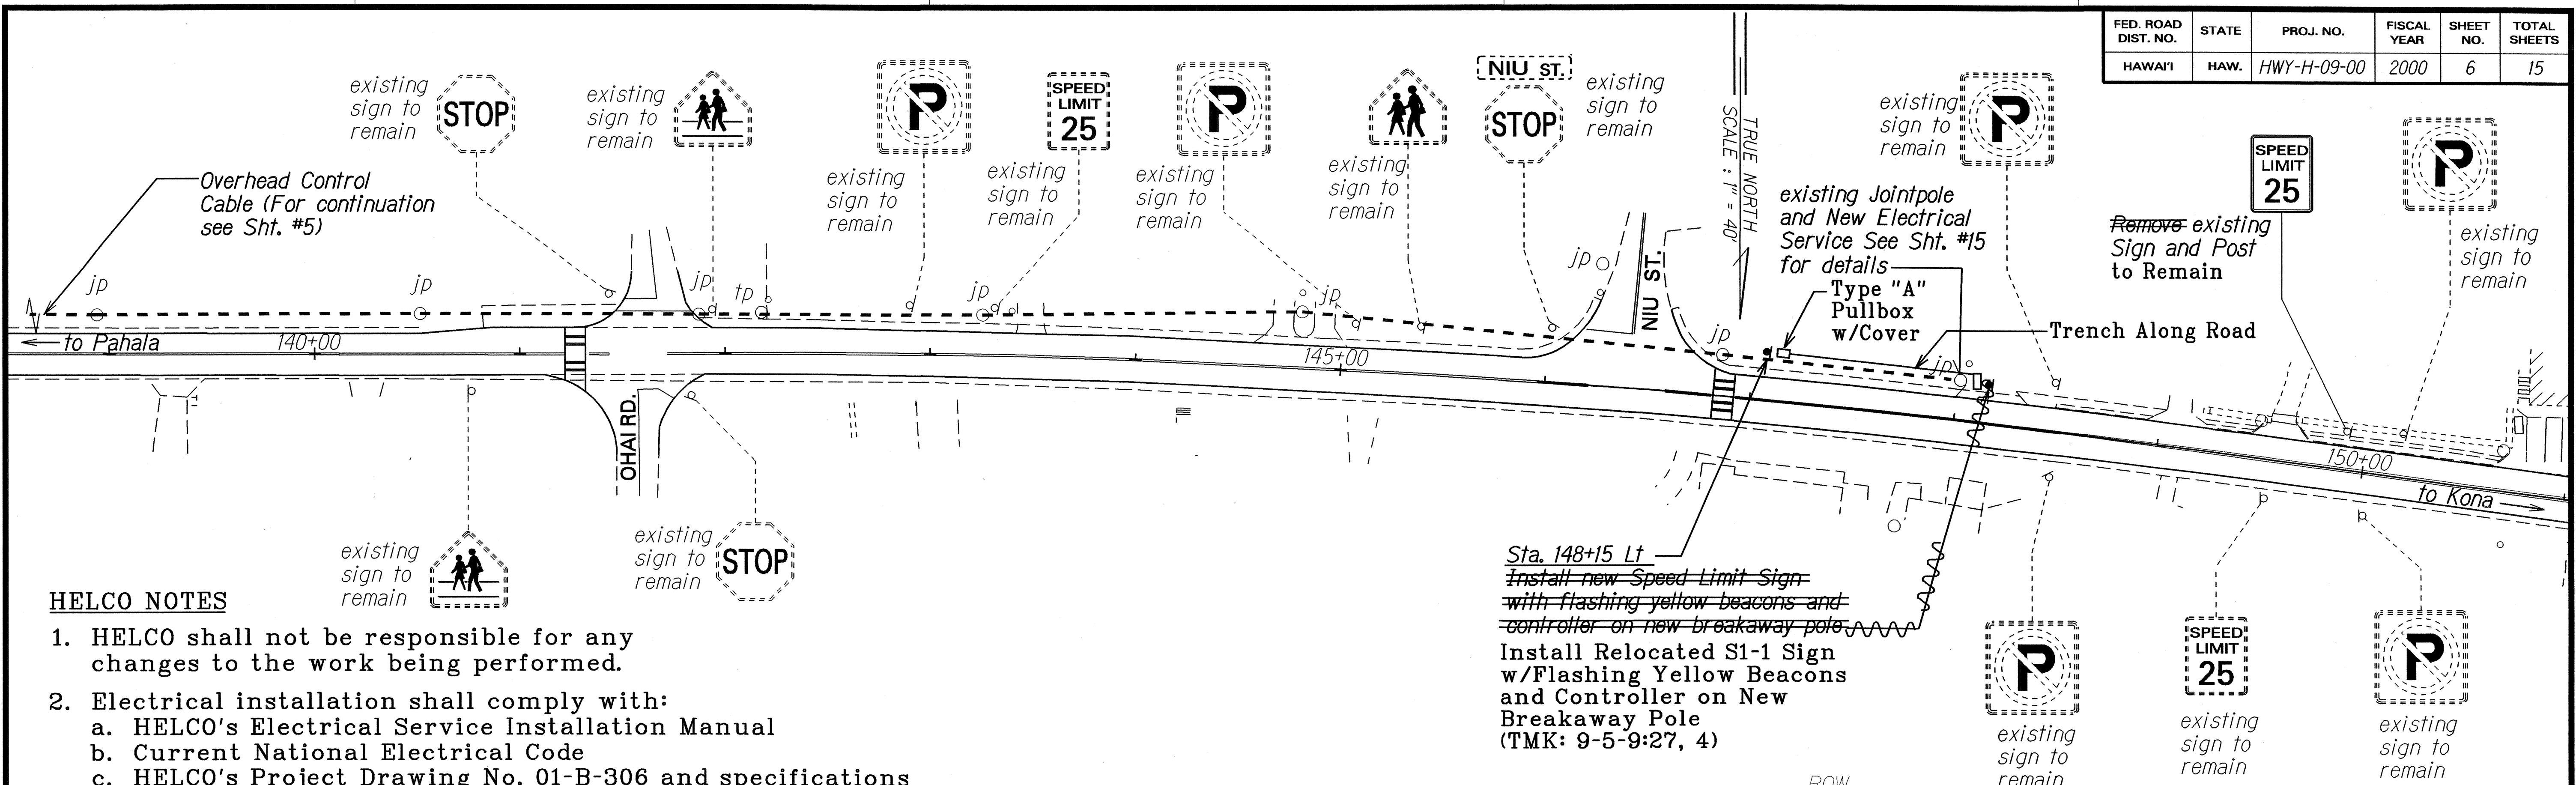


HELCO NOTES

- HELCO shall not be responsible for any changes to the work being performed.
- Electrical installation shall comply with:
 - HELCO's Electrical Service Installation Manual
 - Current National Electrical Code
 - HELCO's Project Drawing No. 01-B-306 and specifications
- Consult with HELCO's Engineering Department for any questions or clarifications regarding the electrical installation.

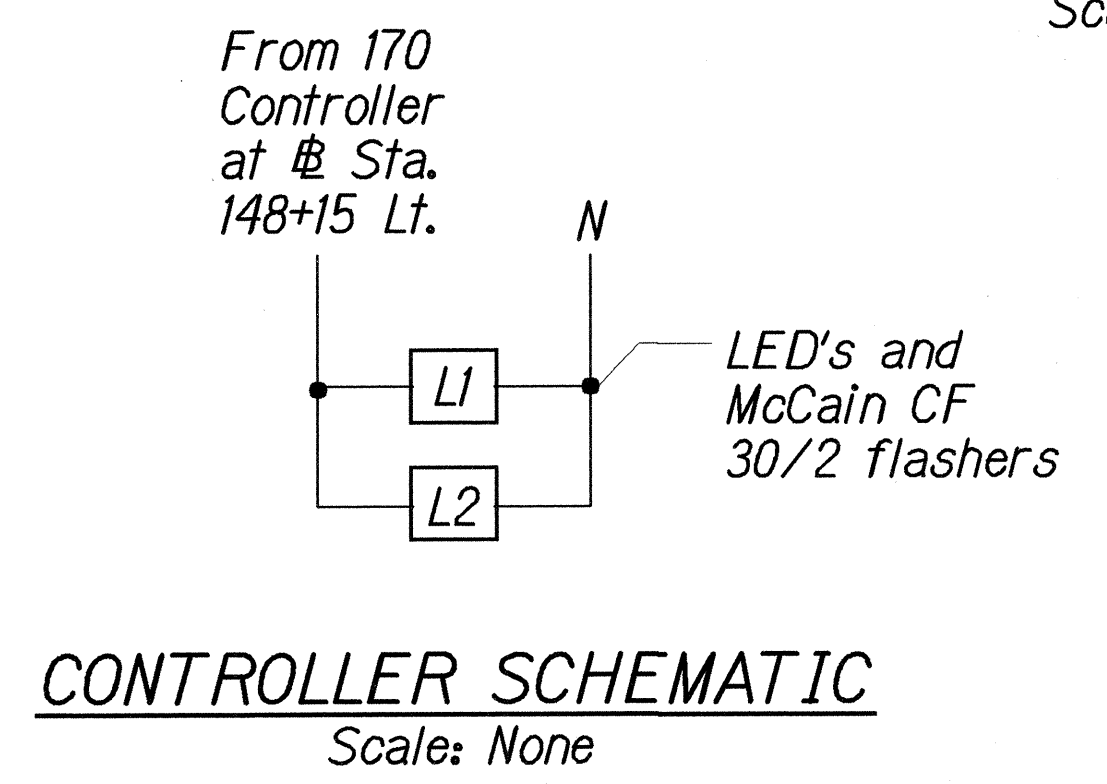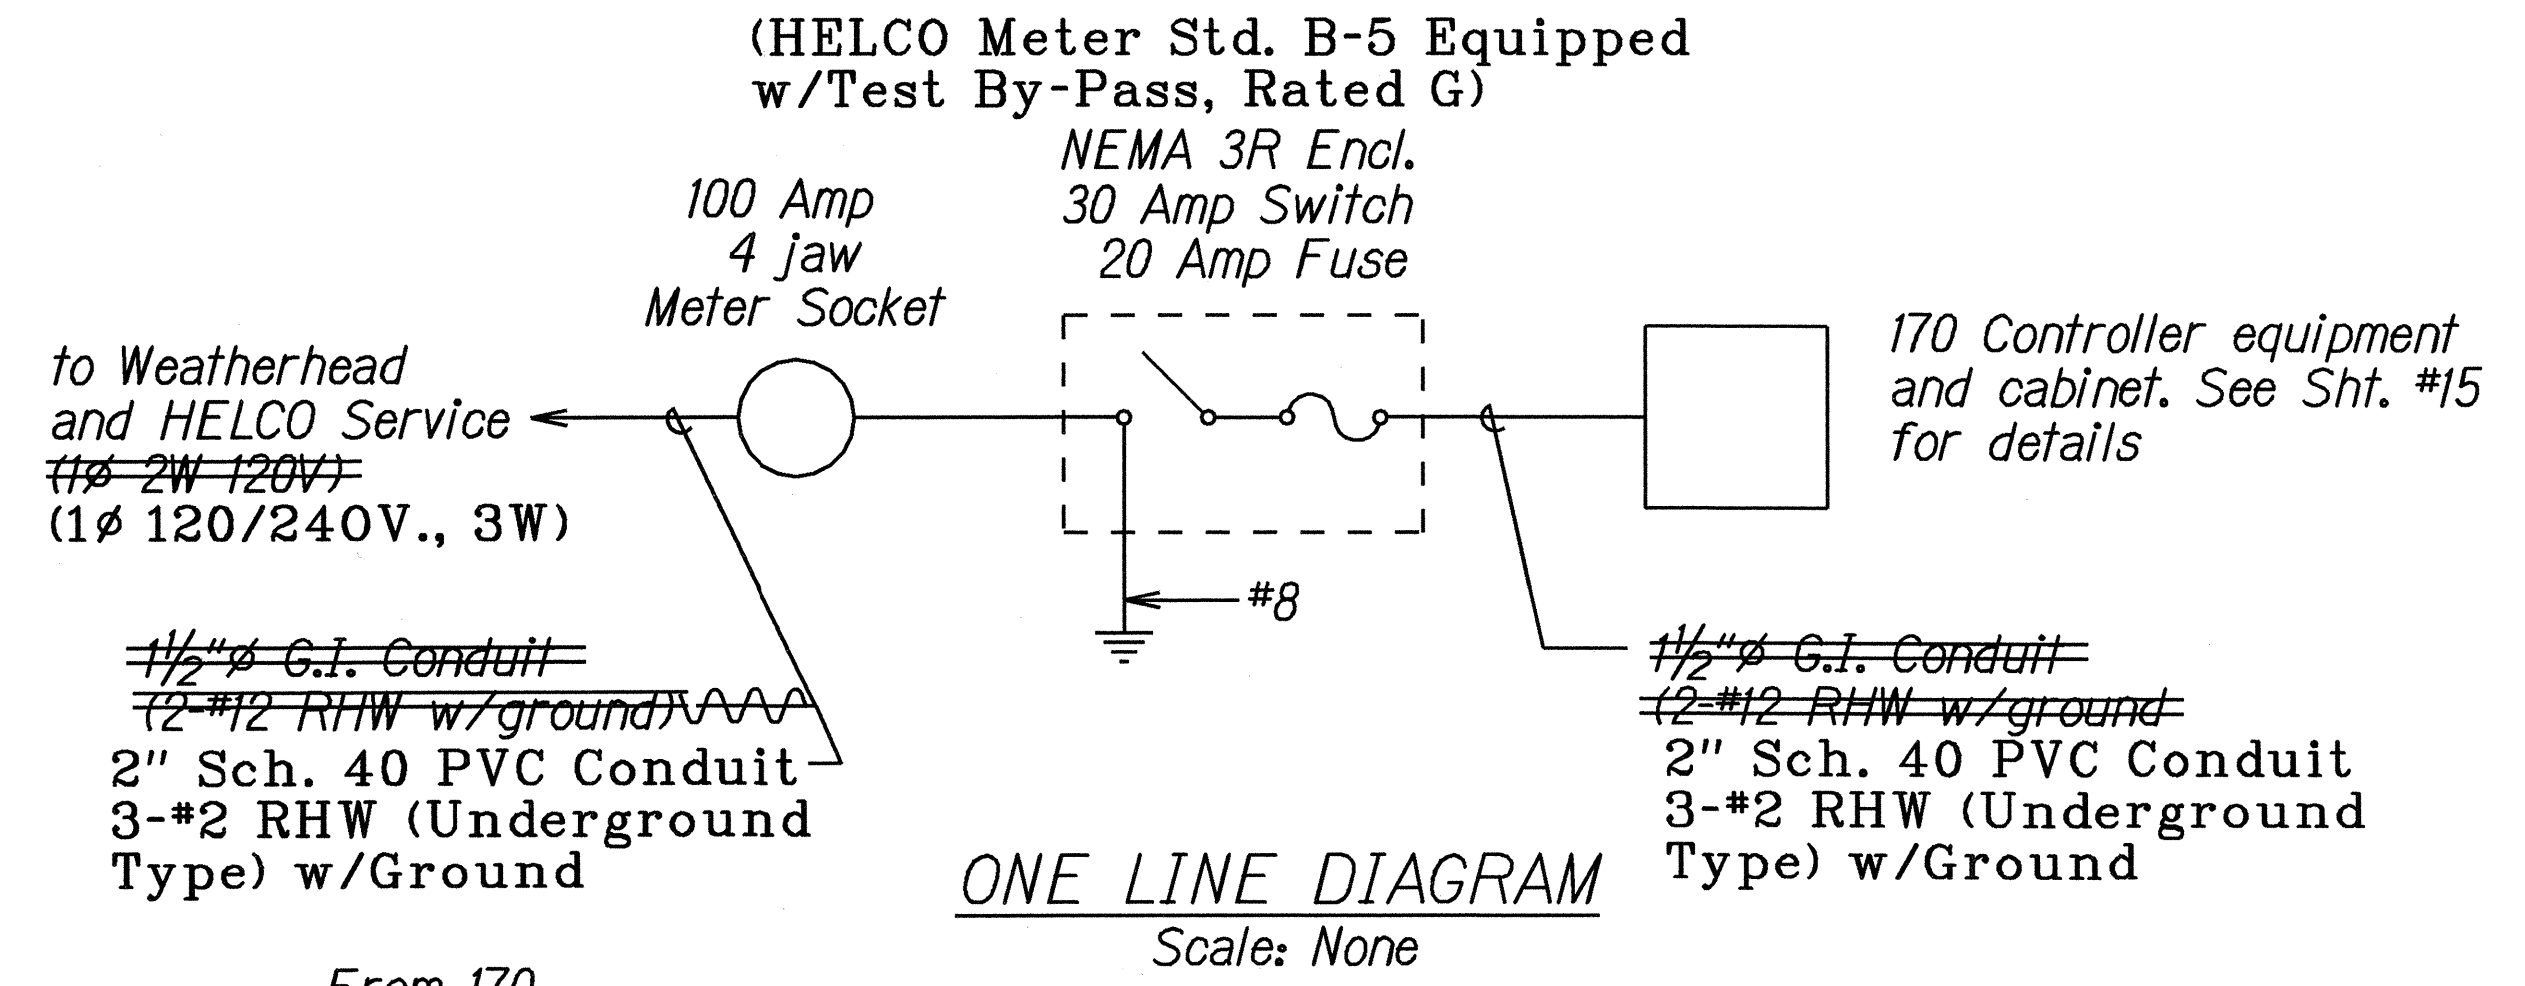

LEGEND FOR AS-BUILT POSTINGS

	Squiggly line for as-built deletion
	Double line for as-built deletion
Roadway	Text for as-built posting

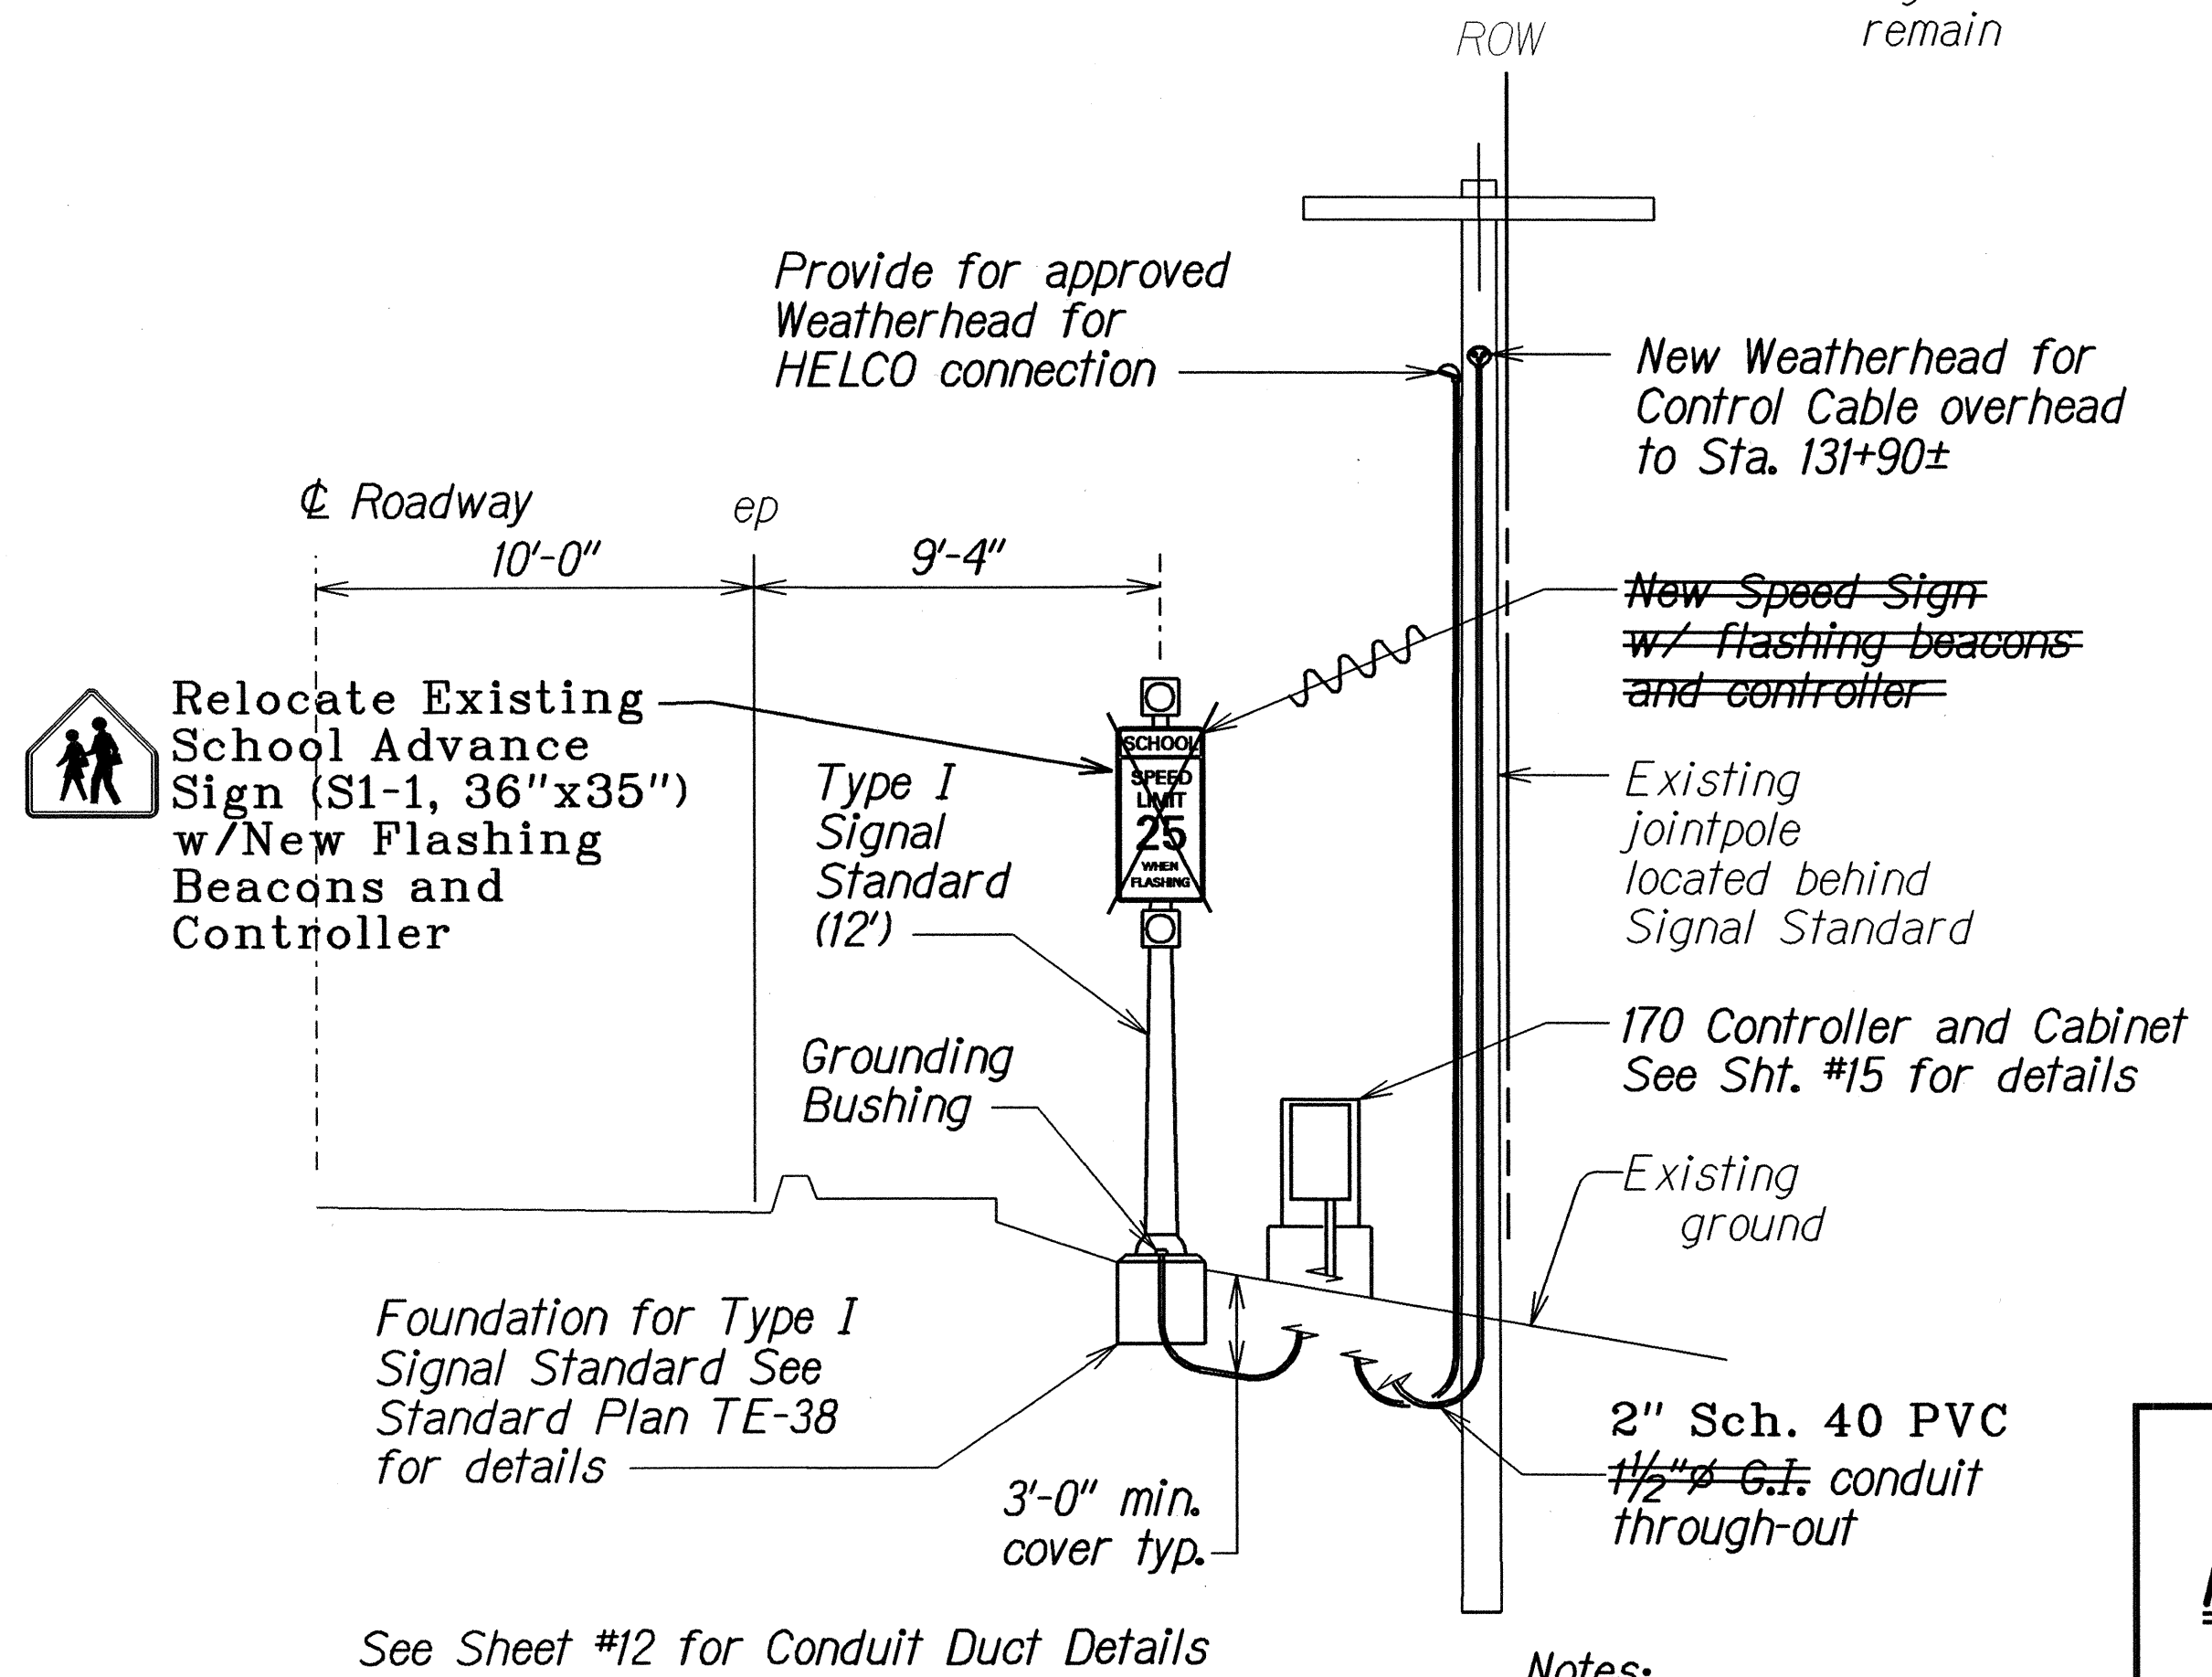

- Notes:**
- Section looking East
 - No work shall encroach into existing sidewalk

STATE OF HAWAII
DEPARTMENT OF TRANSPORTATION
HIGHWAYS DIVISION

PLAN AND DETAILS-SITE #2B

**FLASHING WARNING LIGHTS
VARIOUS HIGHWAY LOCATIONS**

PROJ. NO. HWY-H-09-00

Scale: Noted Date: April, 2000

SHEET No. 1 OF 1 SHEETS