

INDEX TO DRAWINGS	
SHEET NO.	DESCRIPTION
1	TITLE SHEET
2	STANDARD PLANS SUMMARY
3	GENERAL AND SIGN NOTES
4	PLAN AND DETAILS-SITE #1
5	PLANS AND DETAILS-SITE #2A
6	PLANS AND DETAILS-SITE #2B
7	PLAN AND DETAILS-SITE #3
8	PLANS-SITE #4
9	DETAILS-SITE #4
10	PLAN AND DETAILS-SITE #5
11	QUANTITY SCHEDULES
12	TRENCHING DETAILS
13	PULLBOX AND COVER DETAILS
14	DETAILS
15	CONTROLLER ASSEMBLY FOUNDATION

STATE OF HAWAI'I

DEPARTMENT OF TRANSPORTATION

HIGHWAYS DIVISION

HONOLULU, HAWAI'I

"AS-BUILT"

PLANS FOR

FLASHING WARNING LIGHTS








AT VARIOUS HIGHWAY LOCATIONS

PROJECT NO. HWY-H-09-00

DISTRICTS OF SOUTH KOHALA, NORTH KONA, SOUTH KONA AND KA'U

ISLAND OF HAWAI'I

FED. ROAD DIST. NO.	STATE	PROJ. NO.	FISCAL YEAR	SHEET NO.	TOTAL SHEETS
HAWAI'I	HAW.	HWY-H-09-00	2000	1	15

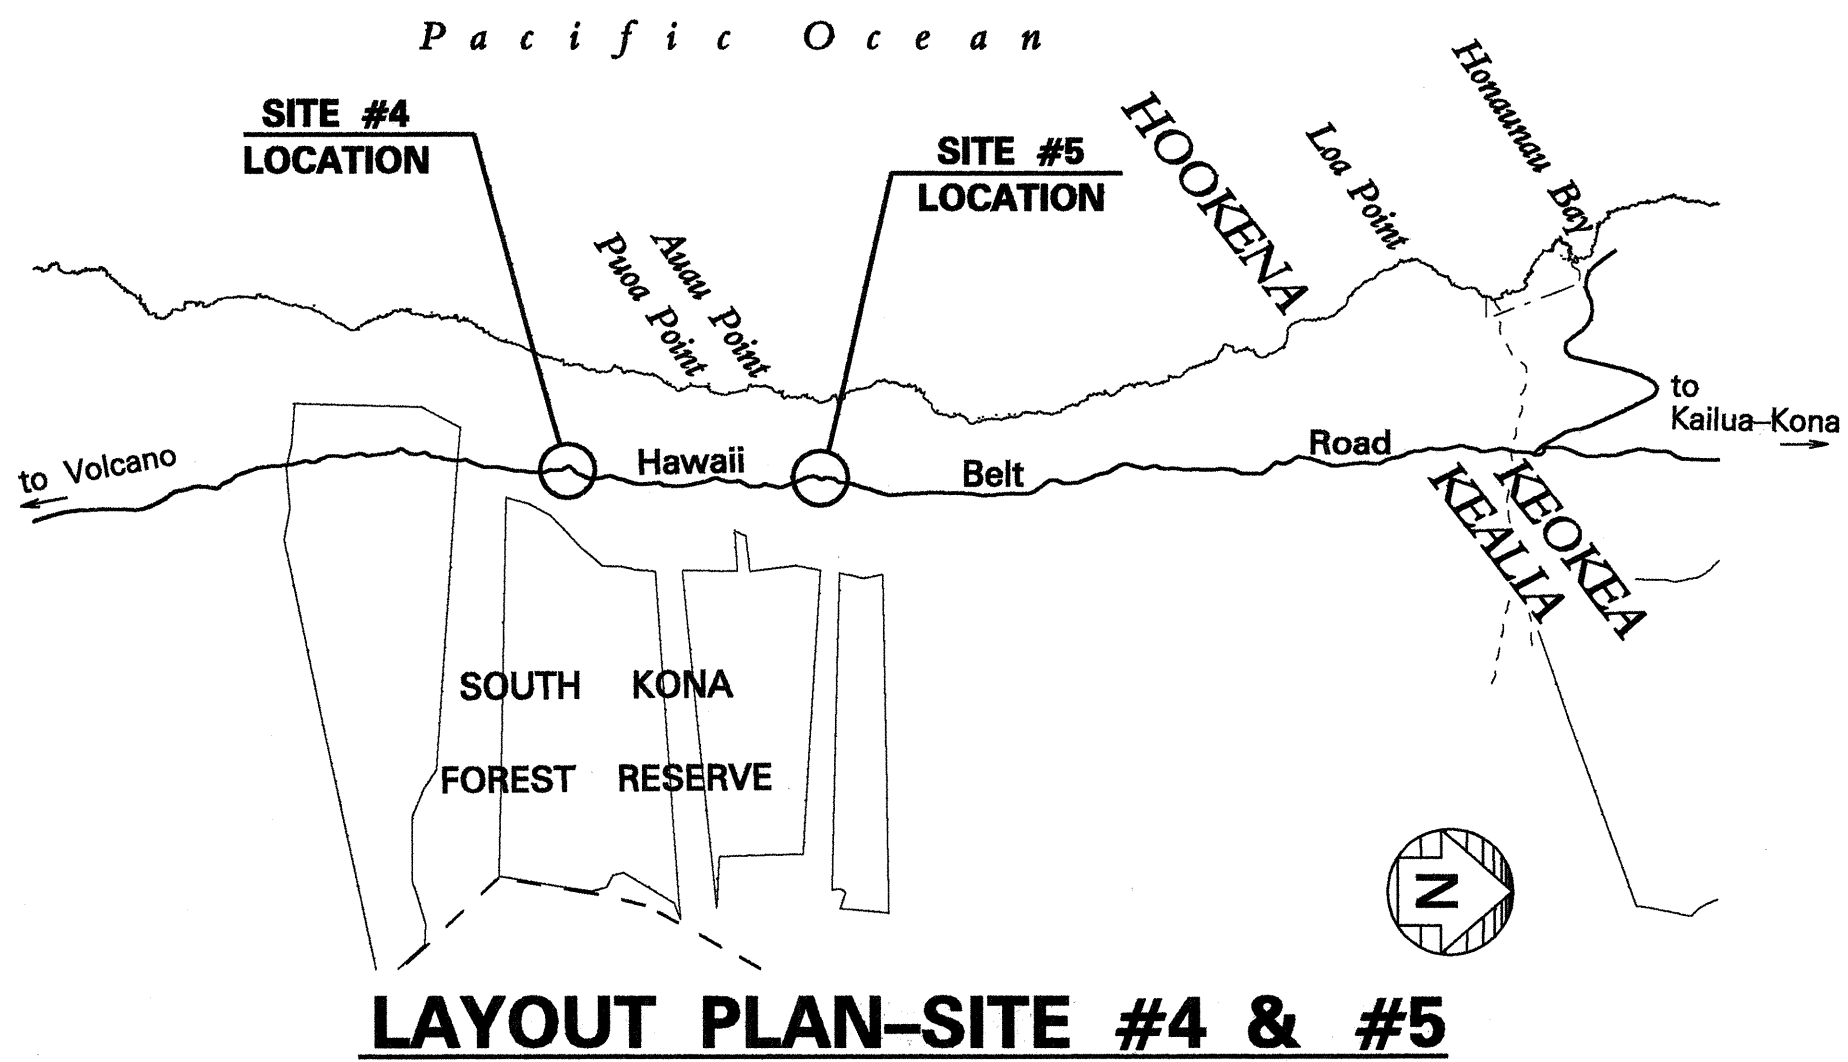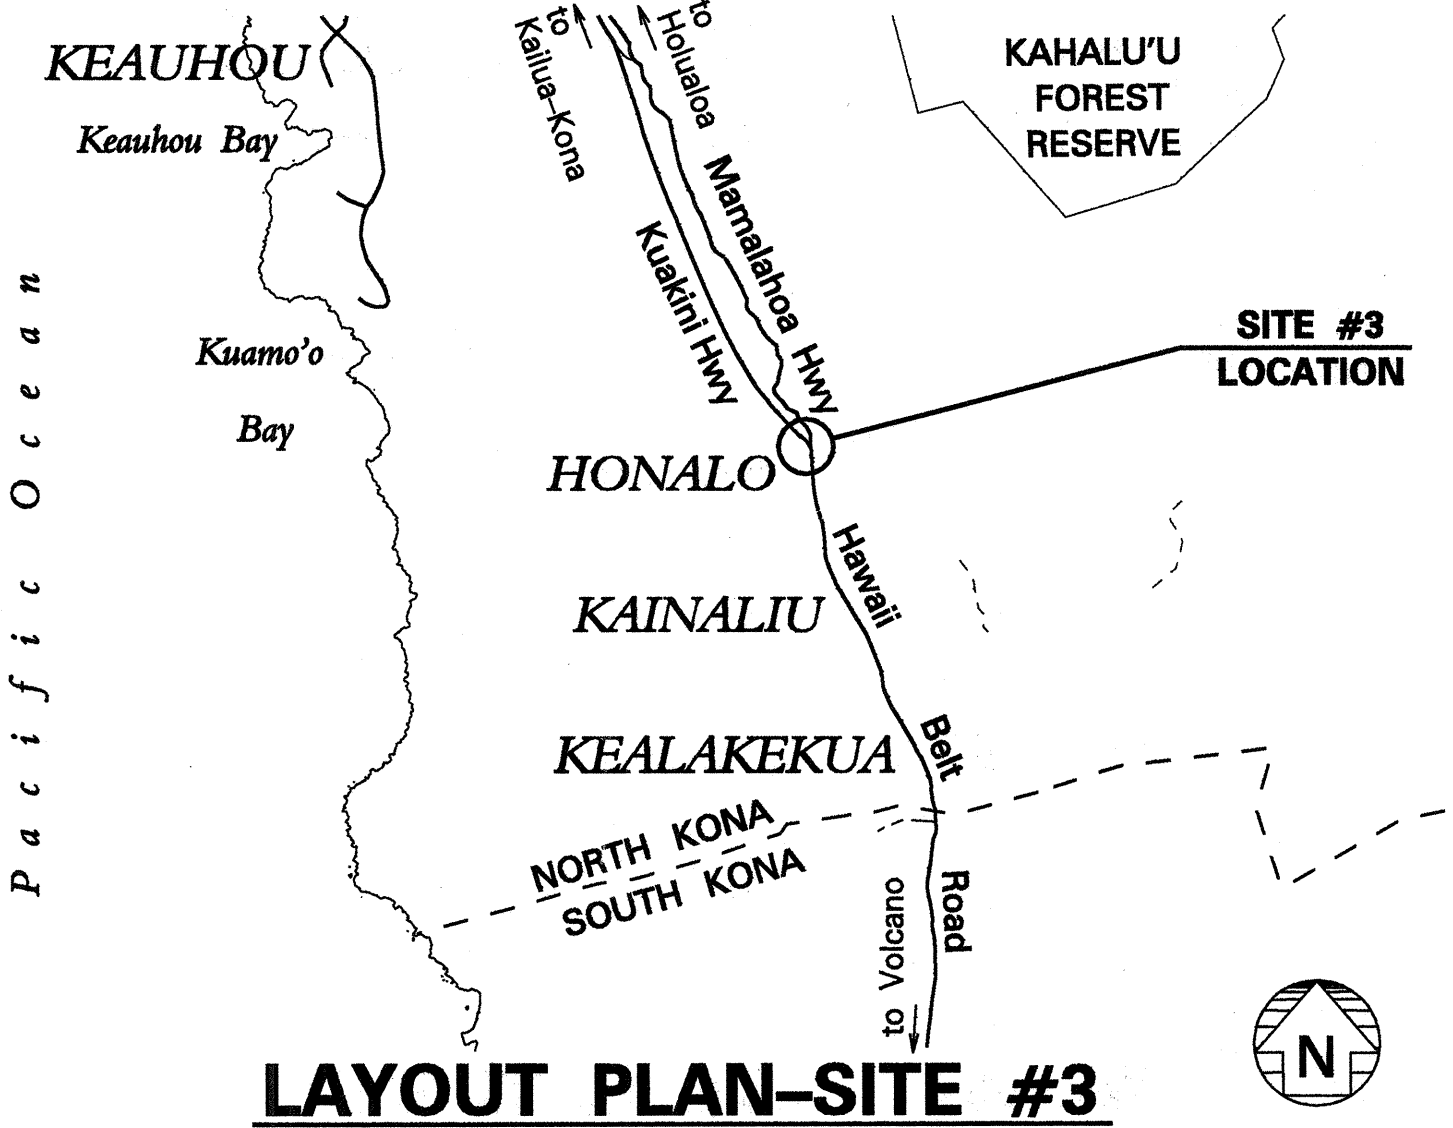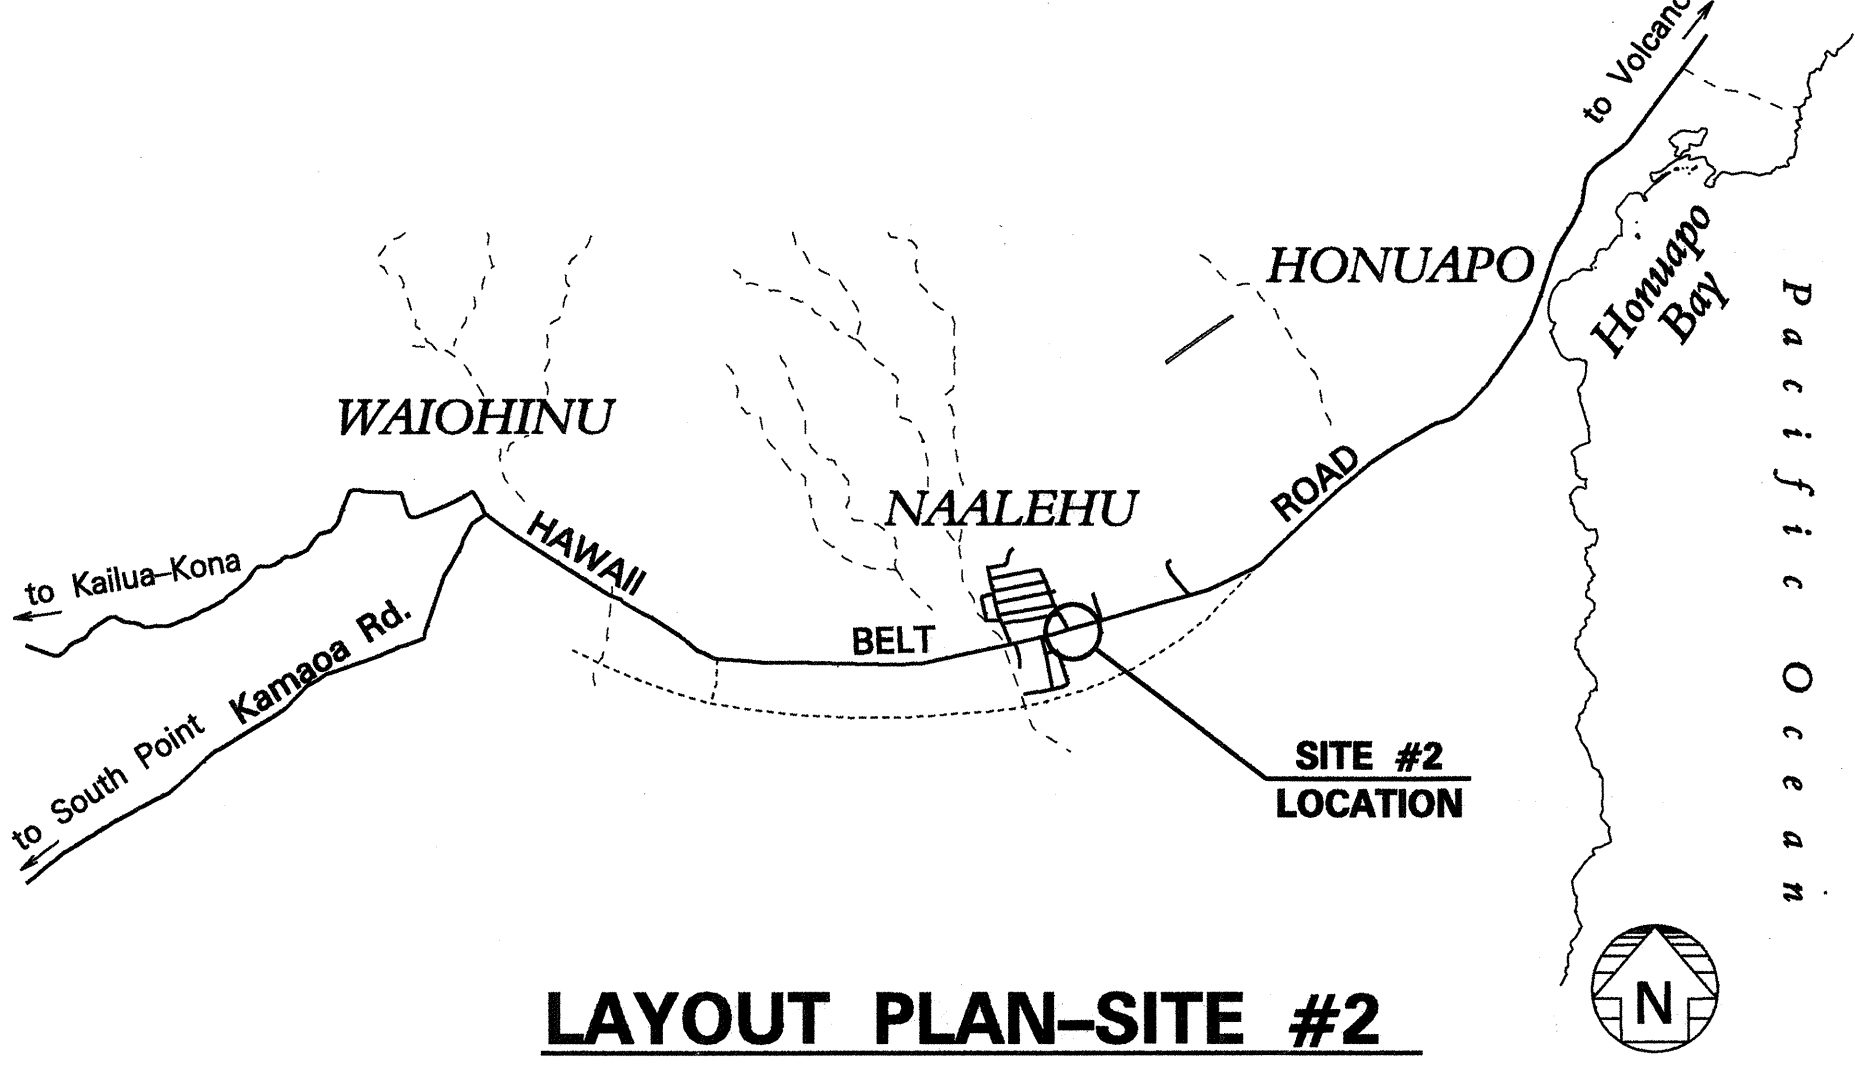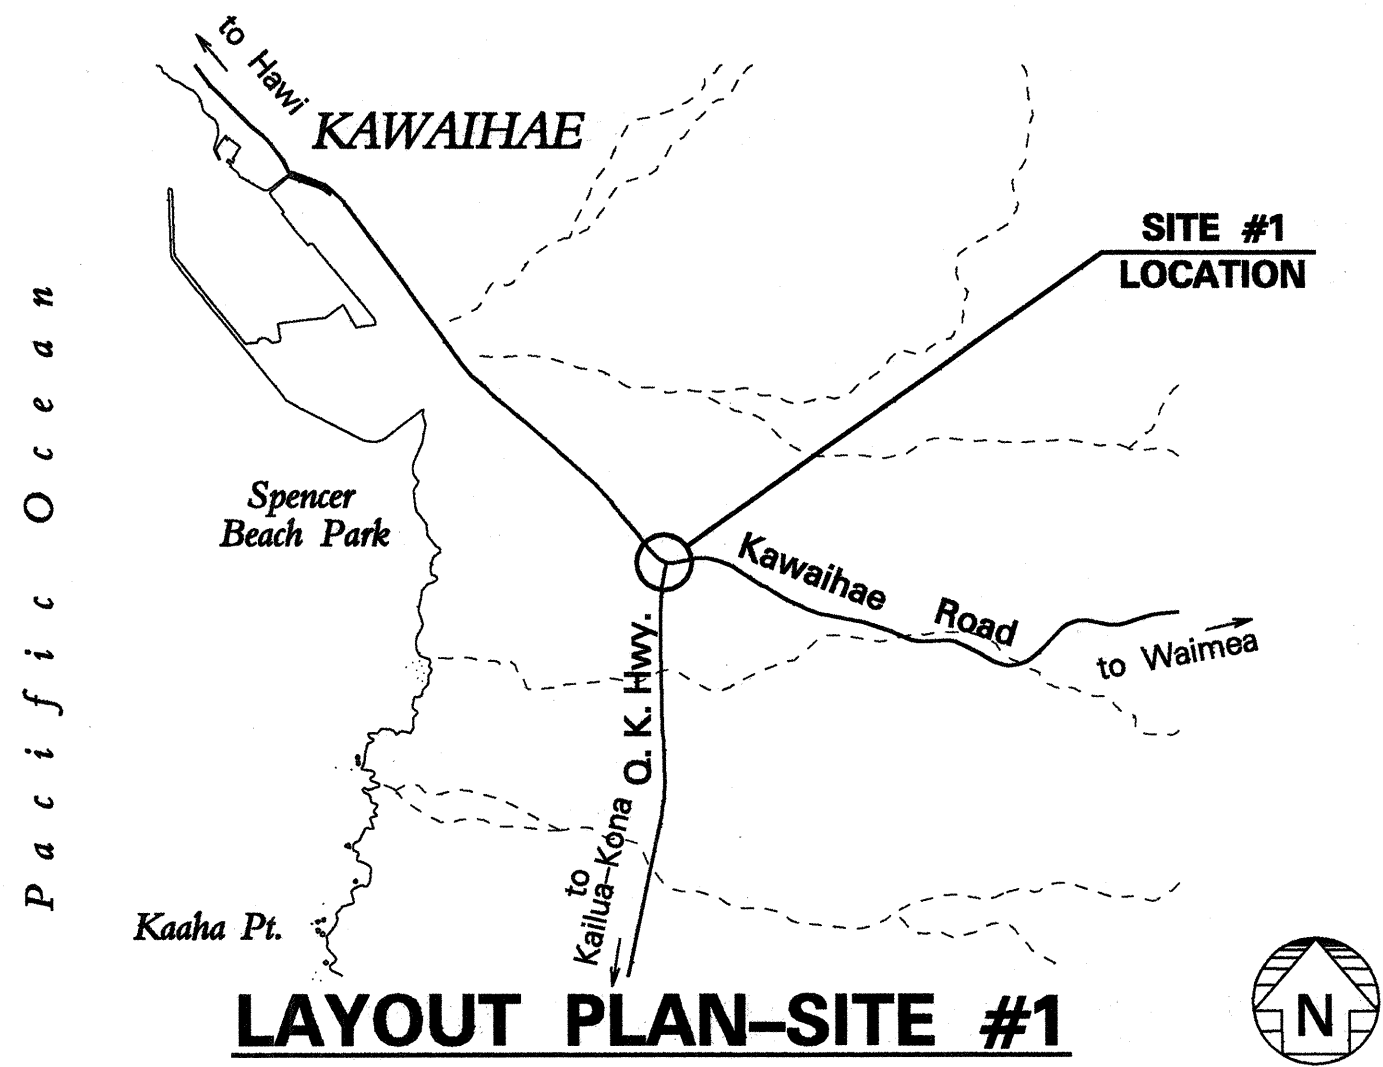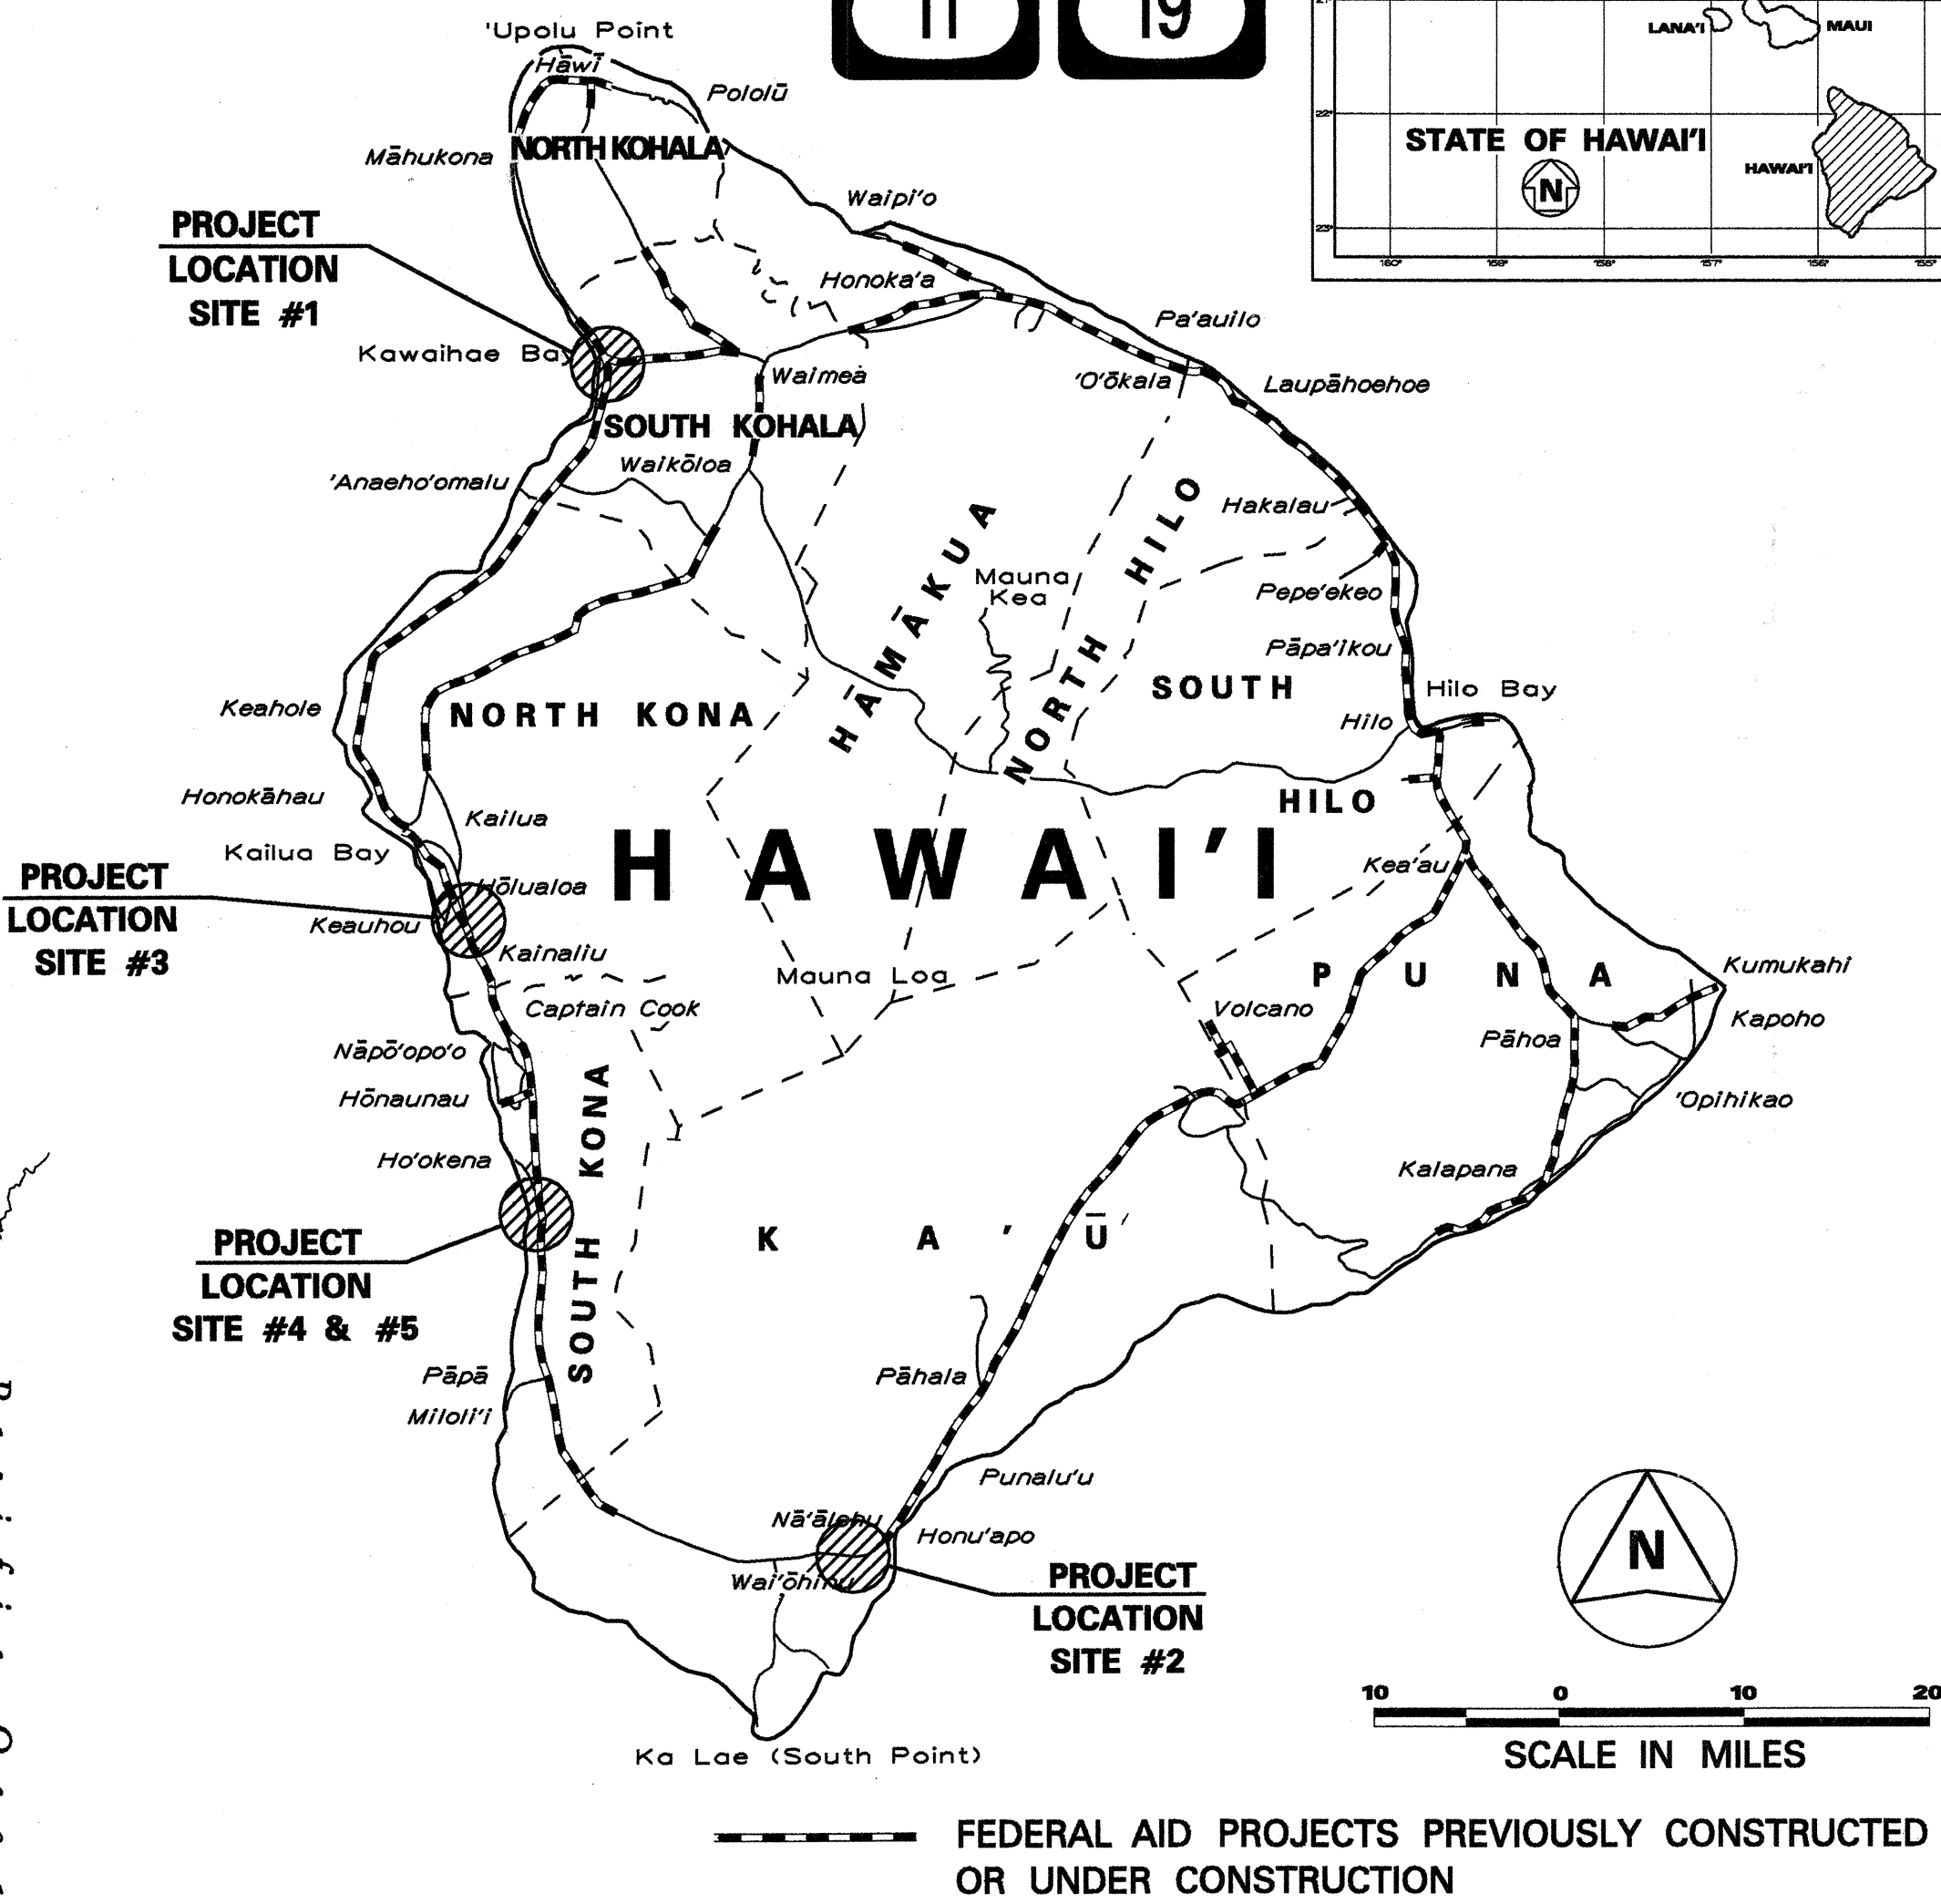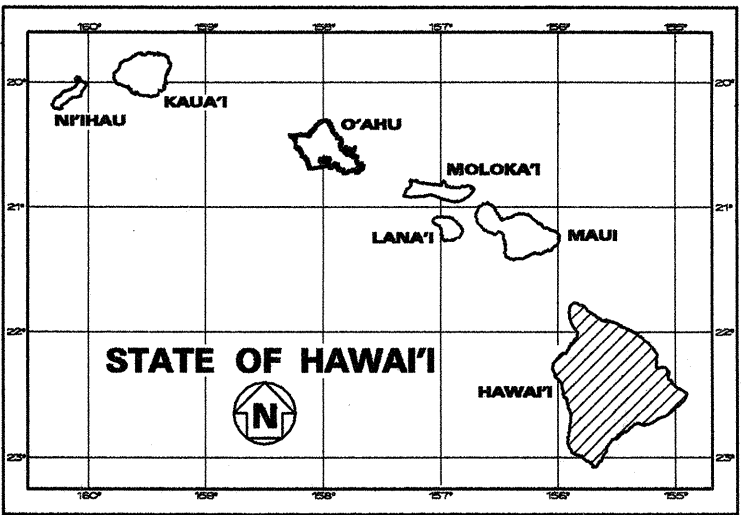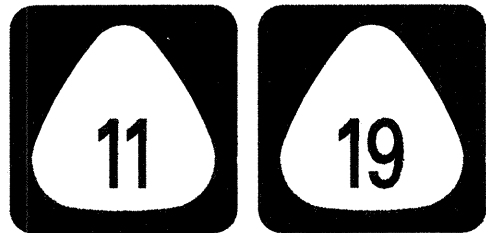

- SITE #1 - Rte. 19: Q.K. HWY. / KAWAIHAE ROAD INTERSECTION -
MILE POST 67.04 TO MILE POST 67.24
- SITE #2 - Rte. 11: NAALEHU SCHOOL -
MILE POST 63.36 - MILE POST 63.93
- SITE #3 - Rte. 11: HONALO -
MILE POST 113.92 TO MILE POST 114.08
- SITE #4 - Rte. 11: LAVA FLOW #3, NORTH END -
MILEPOST 93.31 TO MILE POST 93.48
- SITE #5 - Rte. 11: LAVA FLOW #2, SOUTH END -
MILE POST 96.42 TO 96.59

CHANGES MADE DURING CONSTRUCTION HAVE BEEN INCORPORATED ON THESE PLANS EXCEPT CHANGES IN THE ORIGINAL THEORETICAL QUANTITIES. FOR ACTUAL QUANTITIES, REFER TO PROJECT LEDGER AND/OR COMPUTATION BOOK.

3/7/00

DEPARTMENT OF TRANSPORTATION

STATE OF HAWAII

APPROVED:

5/17/00

DIR. OF TRANSPORTATION

DATE

HAWAII DISTRICT

DESIGNED BY

ROBERT TAIRA

933-8866

APR., 2000

PHONE

P.S. & E. BY

DATE