


WDRC-12(1)

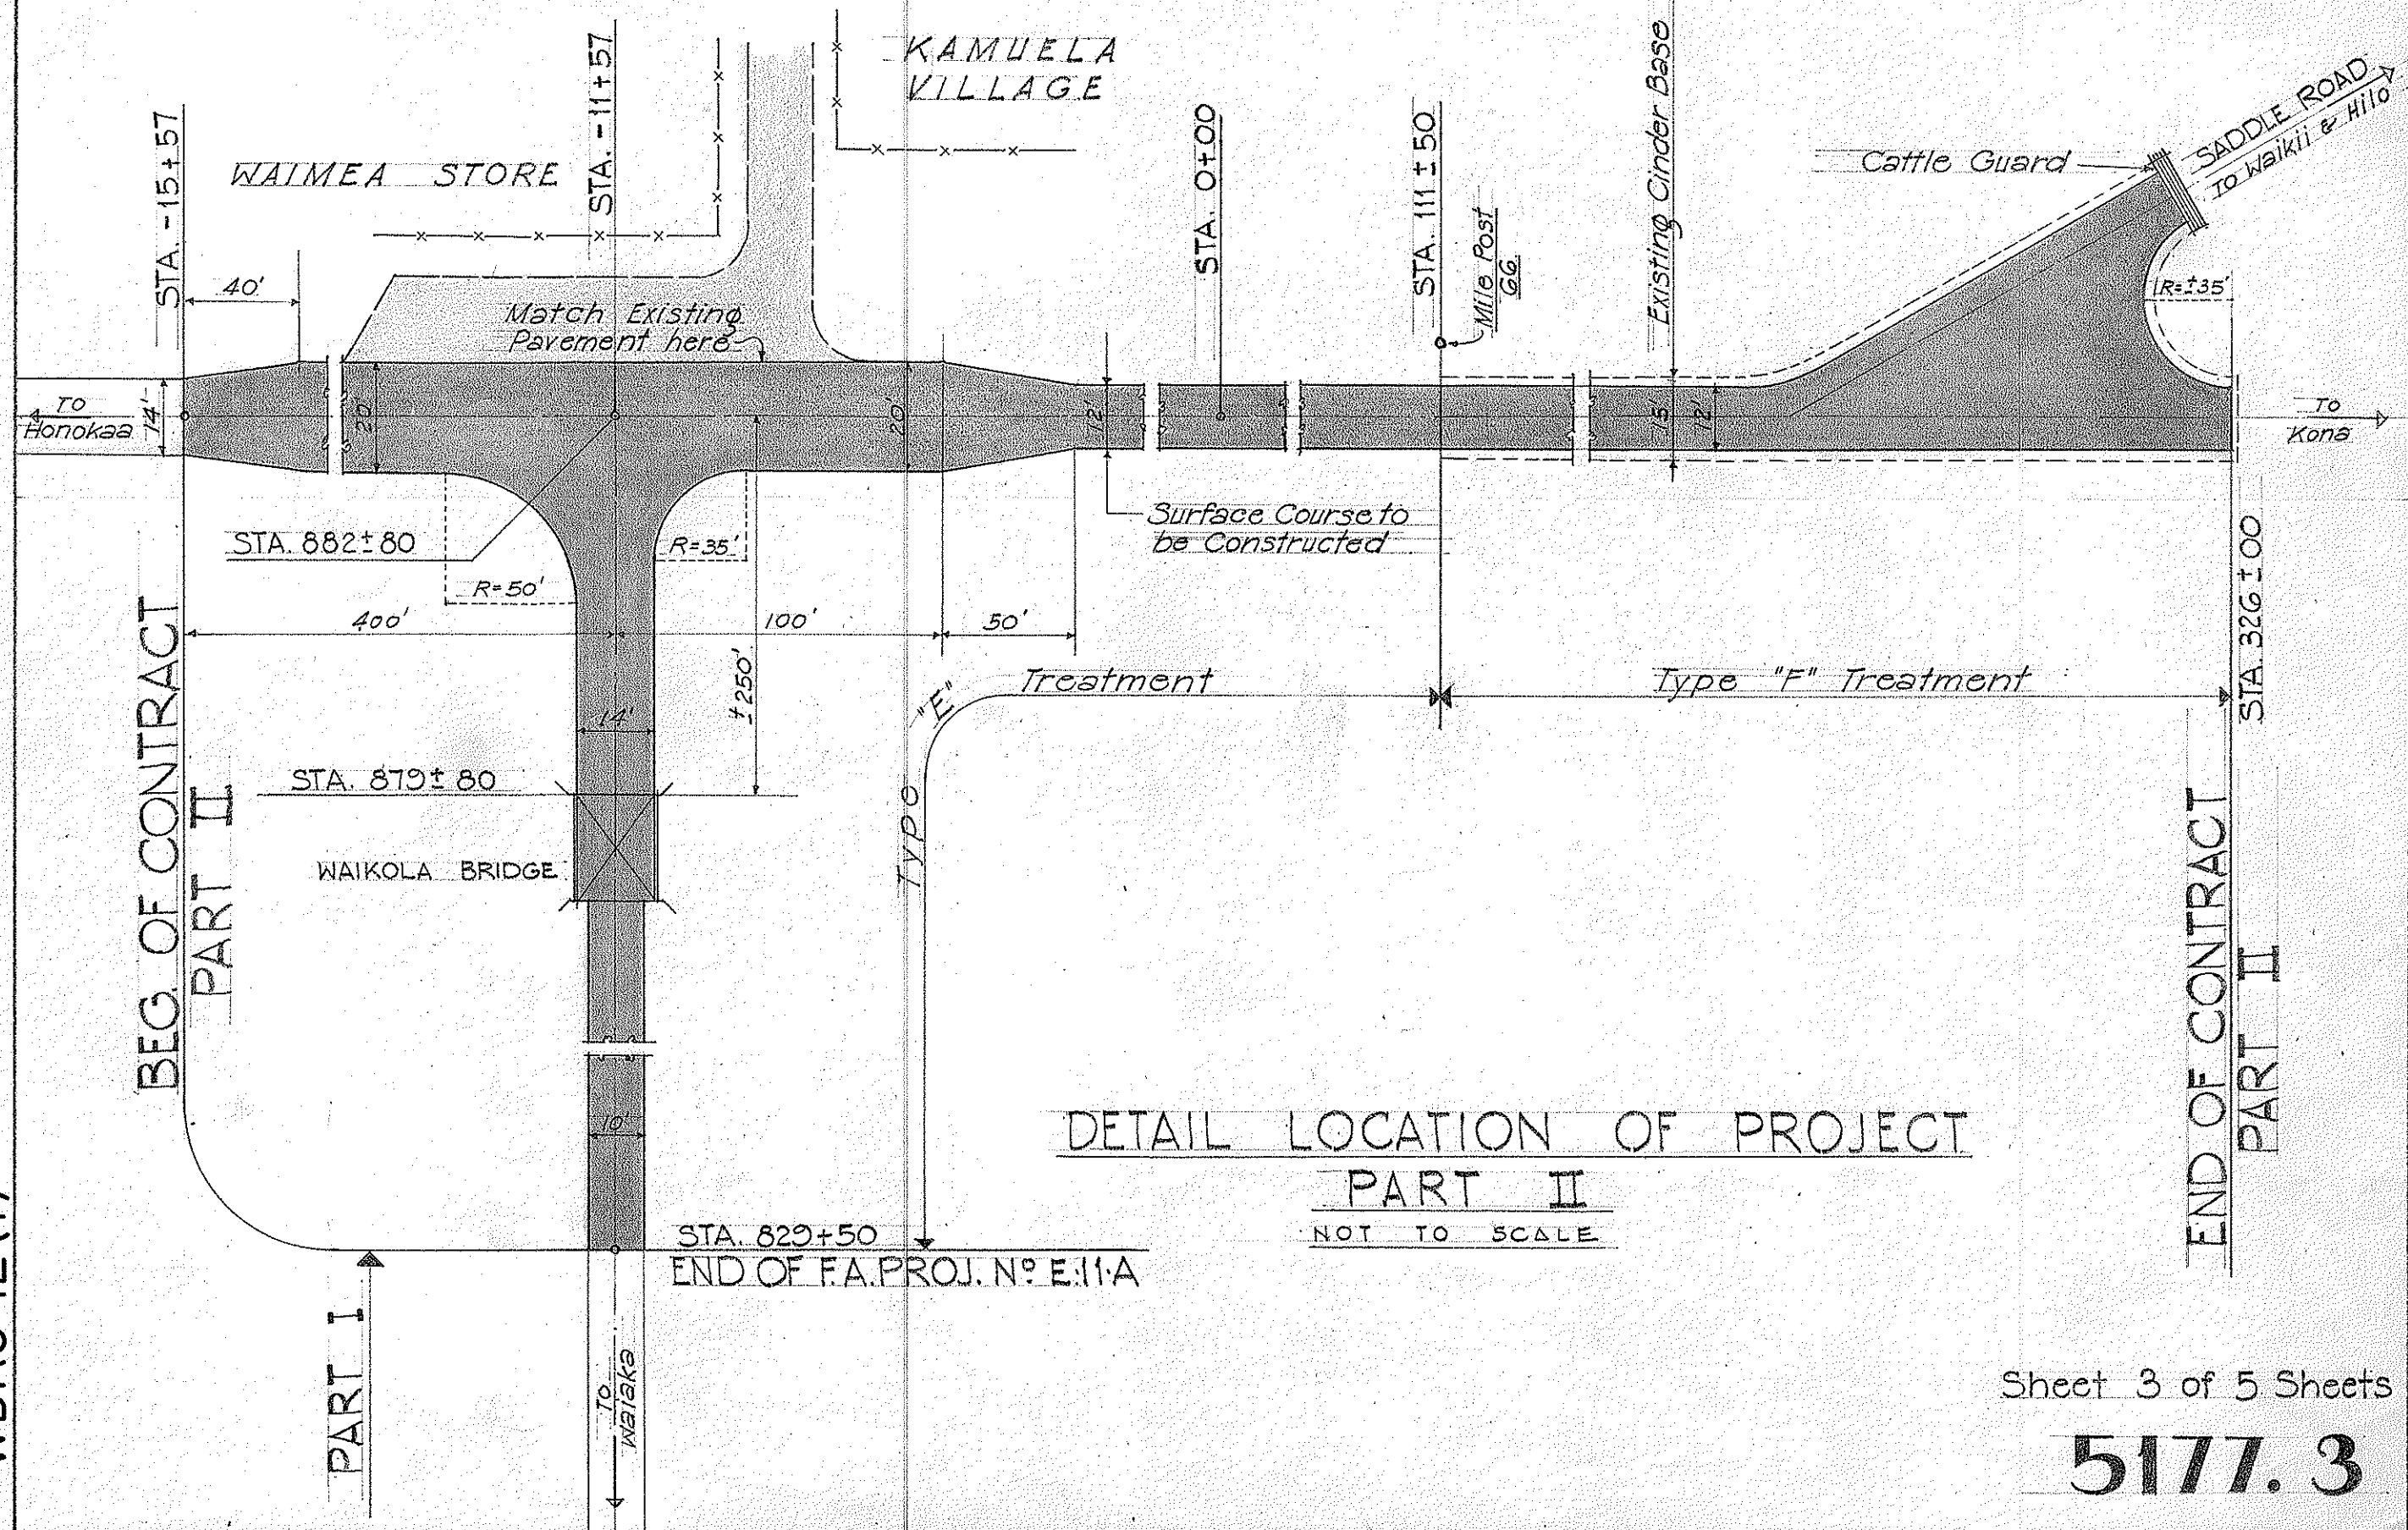

DETAIL LOCATION OF PROJECT
PART II
NOT TO SCALE

Sheet 3 of 5 Sheets

5177.3