



FED. ROAD DIST. NO.	STATE	PROJ. NO.	FISCAL YEAR	SHEET NO.	TOTAL SHEETS
HAWAII	HAW.	12D-01-20M 250A-01-20M	1990	3	14

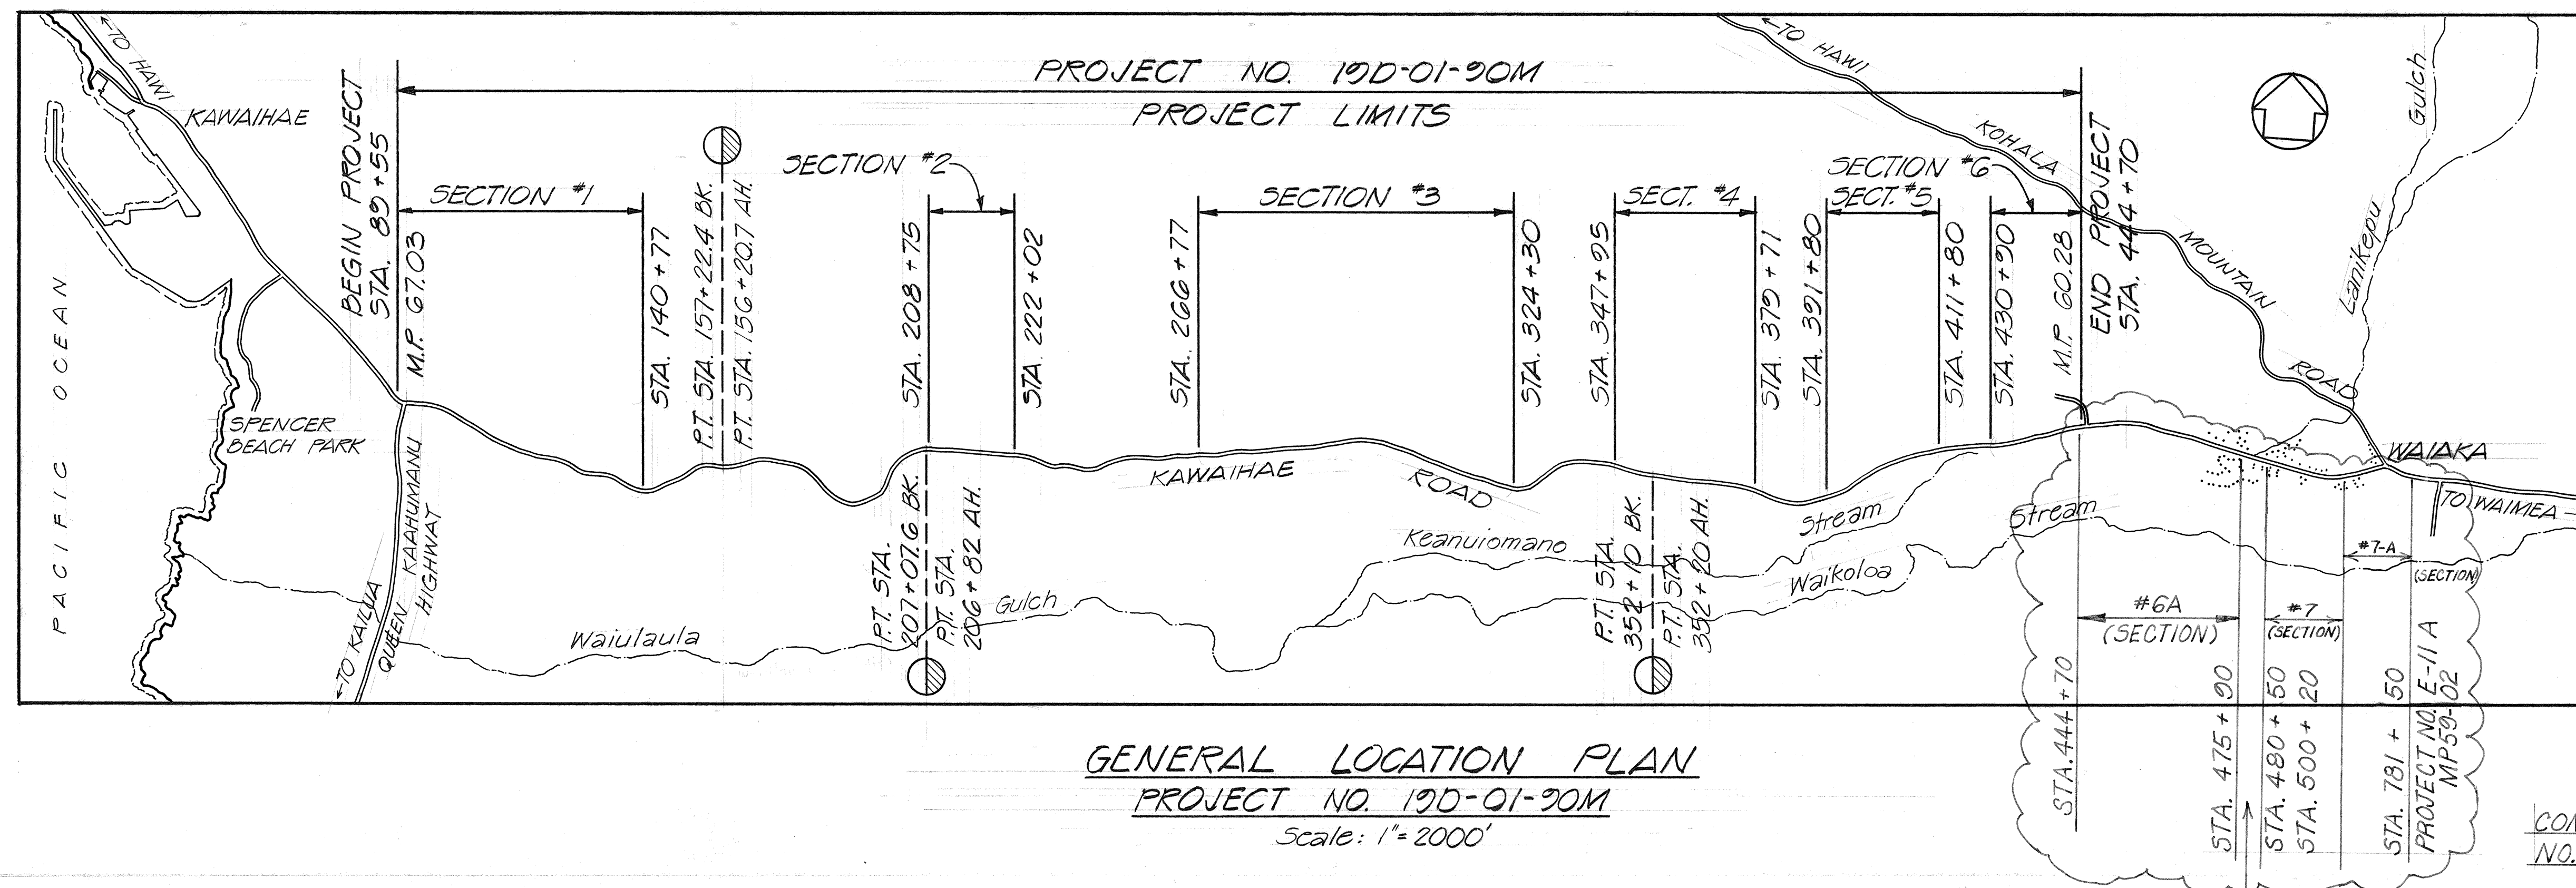

CONTRACT CHANGE ORDER
NO.1

EXCEPTION TO
PAVING

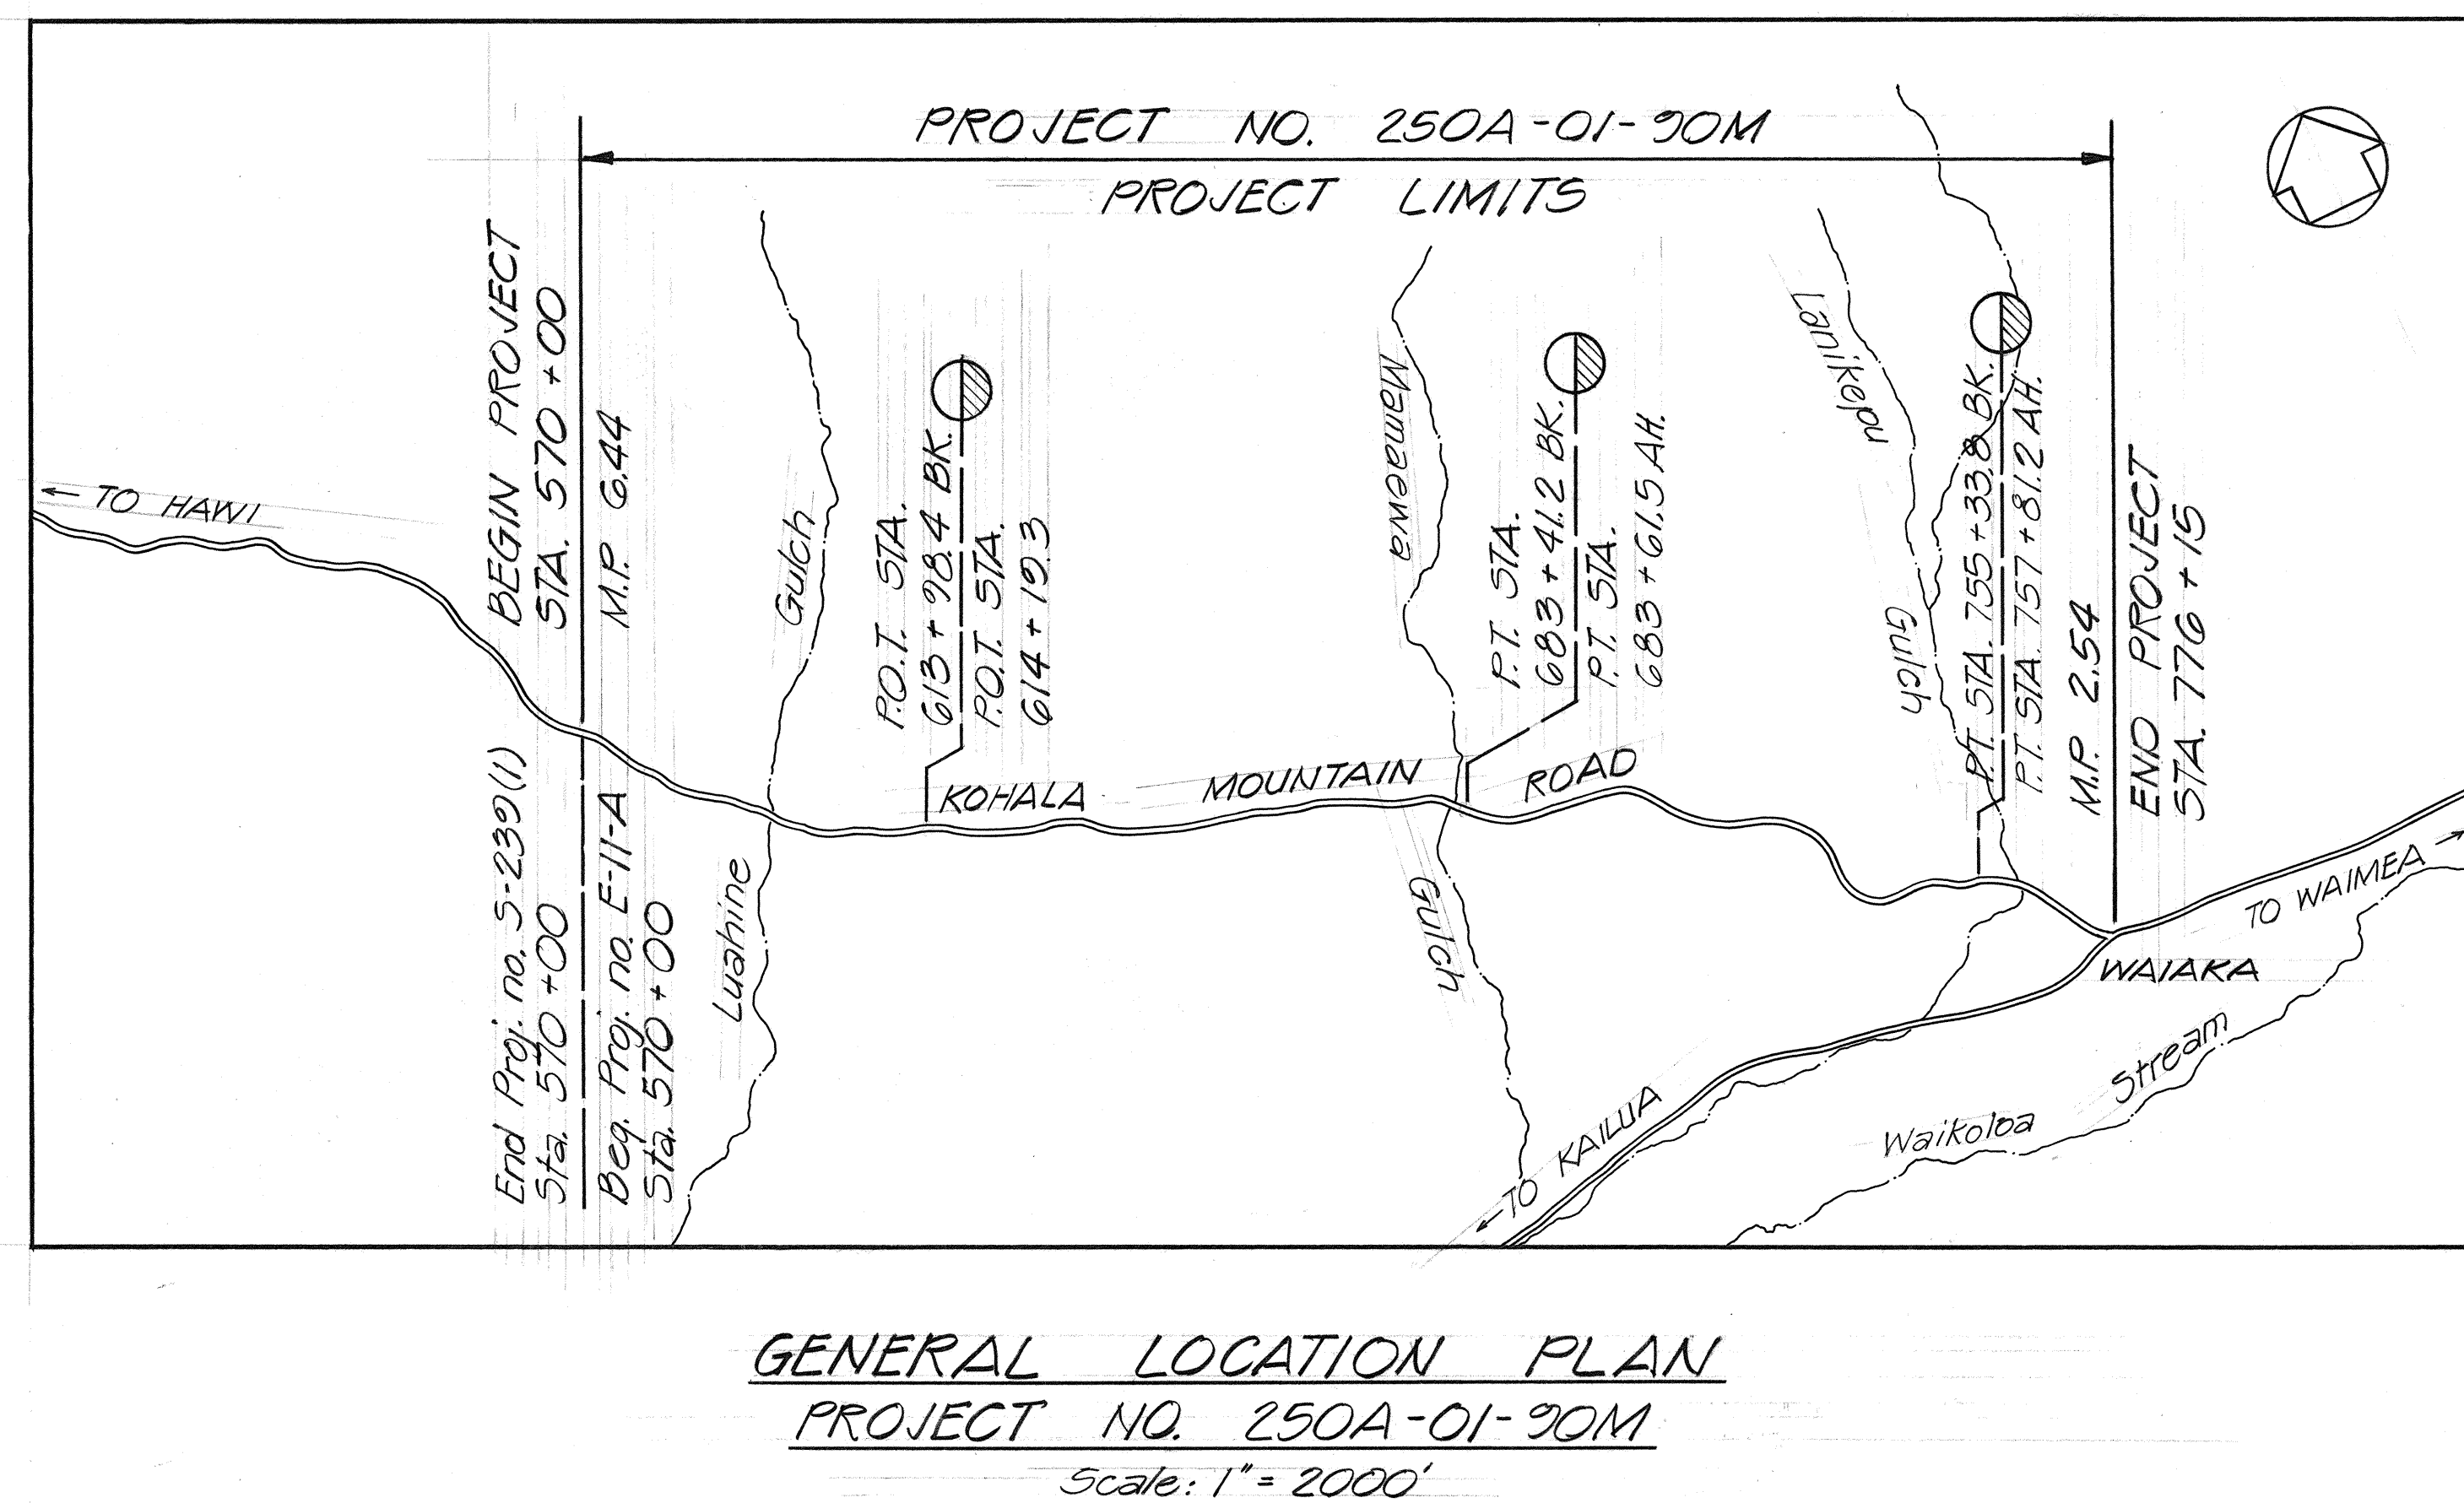

GENERAL LOCATION PLAN
PROJECT NO. 250A-01-90M
Scale: 1" = 2000'

STATE OF HAWAII
DEPARTMENT OF TRANSPORTATION
HIGHWAYS DIVISION

GENERAL LOCATION PLANS

KAWAIHAE ROAD RESURFACING
Proj. no. 190-01-20M

KOHALA MOUNTAIN ROAD RESURFACING
Proj. no. 250A-01-20M

Scale: As Noted Date: Sept. 1989

SHEET NO. 1 OF 1 SHEETS

AS-BUILT

1

ORIGINAL PLAN	SURVEY PLOTTED BY _____ DATE _____
NOTE BOOK	DRAWN BY _____
	TRACED BY _____
	DESIGNED BY _____
	QUANTITIES BY _____
No. _____	CHECKED BY _____