|           | INDEX TO DRAWINGS                 |
|-----------|-----------------------------------|
| SHEET NO. | DESCRIPTION                       |
|           | TITLE SHEET                       |
| 2         | STANDARD PLANS SUMMARY            |
| 3         | GENERAL LOCATION PLANS            |
| 4-8       | PLANS - PROJ. NO. 19D - 01 - 90M  |
| 9-14      | PLANS - PROJ. NO. 250A - 01 - 90M |
|           |                                   |
|           |                                   |
STATE OF HAWAII

TRANSPORTATION DEPARTMENT OF


HIGHWAYS DIVISION HONOLULU, HAWAII AS-BUILT PLANS FOR

RESURFACING KAWAIHAE ROAD KAAHUMANU TOWARDS HIGHWAY QUEEN WAIMEA PROJ. NO. 19D-01-90M

> DISTRICT OF SOUTH KOHALA ISLAND OF HAWAII

KOHALA MOUNTAIN ROAD RESURFACING BRIDGE TOWARDS HAWI WAIAKA PROJ. NO. 250A - 01 - 90M

> DISTRICT OF SOUTH KOHALA ISLAND OF HAWAII

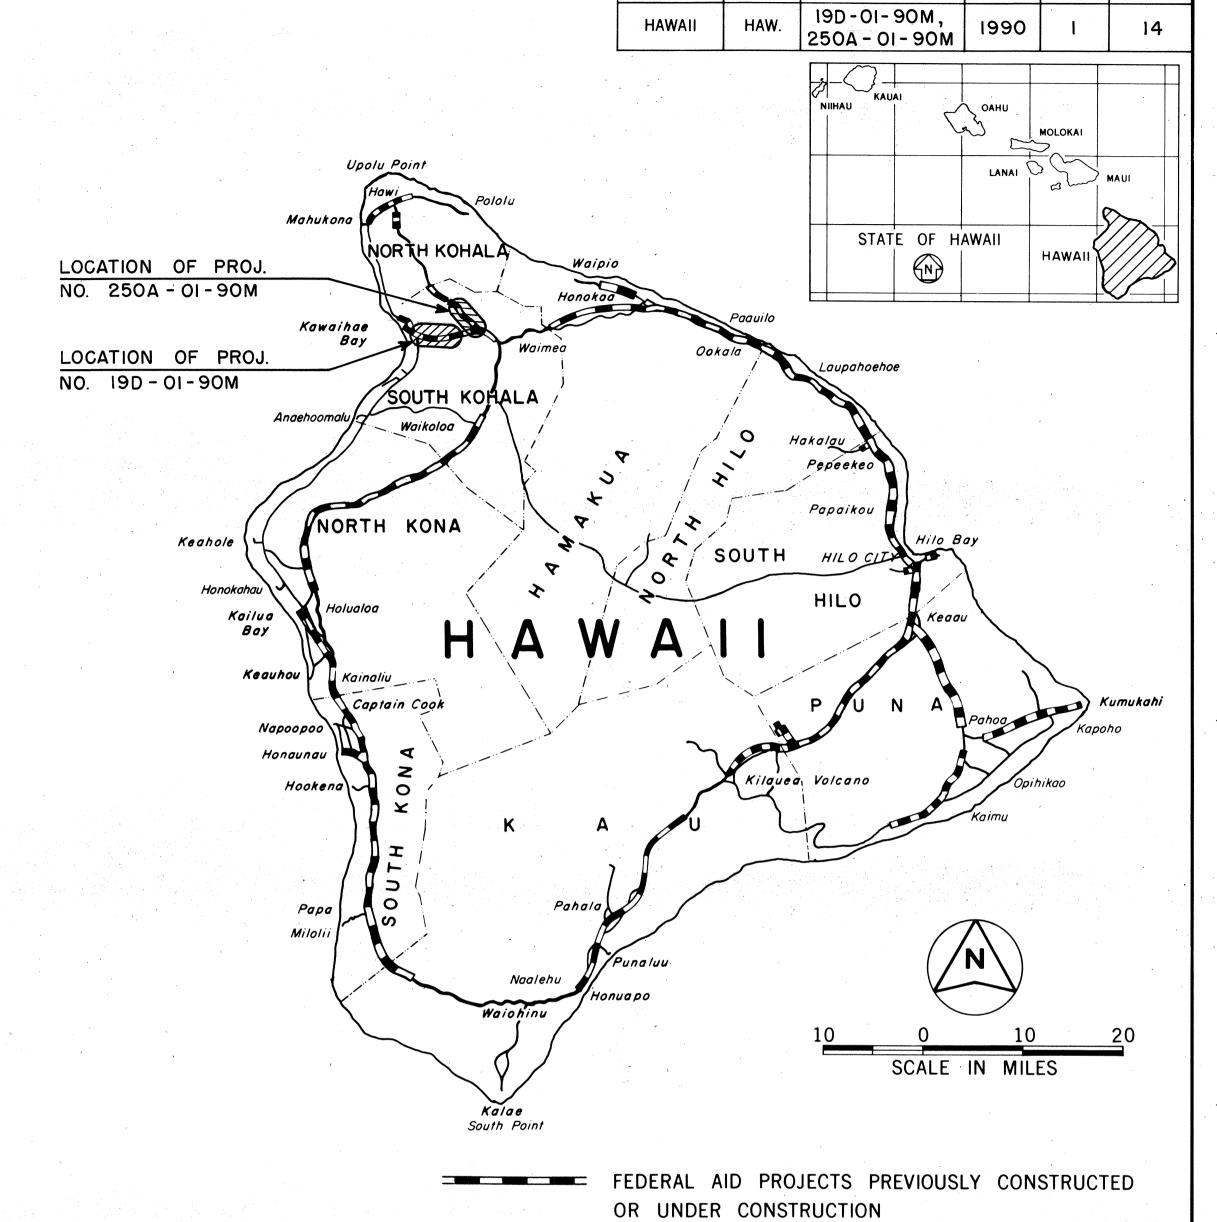

FED. ROAD DIST. NO.

STATE

PROJ. NO.

FISCAL SHEET YEAR NO.

CHANGES MADE DURING CONSTRUCTION HAVE BEEN INCORPORATED ON THESE PLANS EXCEPT CHANGES IN THE ORIGINAL THEORETICAL QUANTITIES. FOR ACTUAL QUANTITIES, REFER TO PROJECT LEDGER AND/OR COMPUTATION BOOK.

RESIDENT ENGINEER DATE

> DEPARTMENT OF TRANSPORTATION STATE OF HAWAII APPROVED:

MARCH, 19 8 DATE 4125 PHONE TAKAESU P. S. & E. BY HAWAII DISTRICT DESIGNED BY