


FED. ROAD DIST. NO.	STATE	PROJ. NO.	FISCAL YEAR	SHEET NO.	TOTAL SHEETS
HAWAII	HAW.	240A-01-83M	1983	3	10

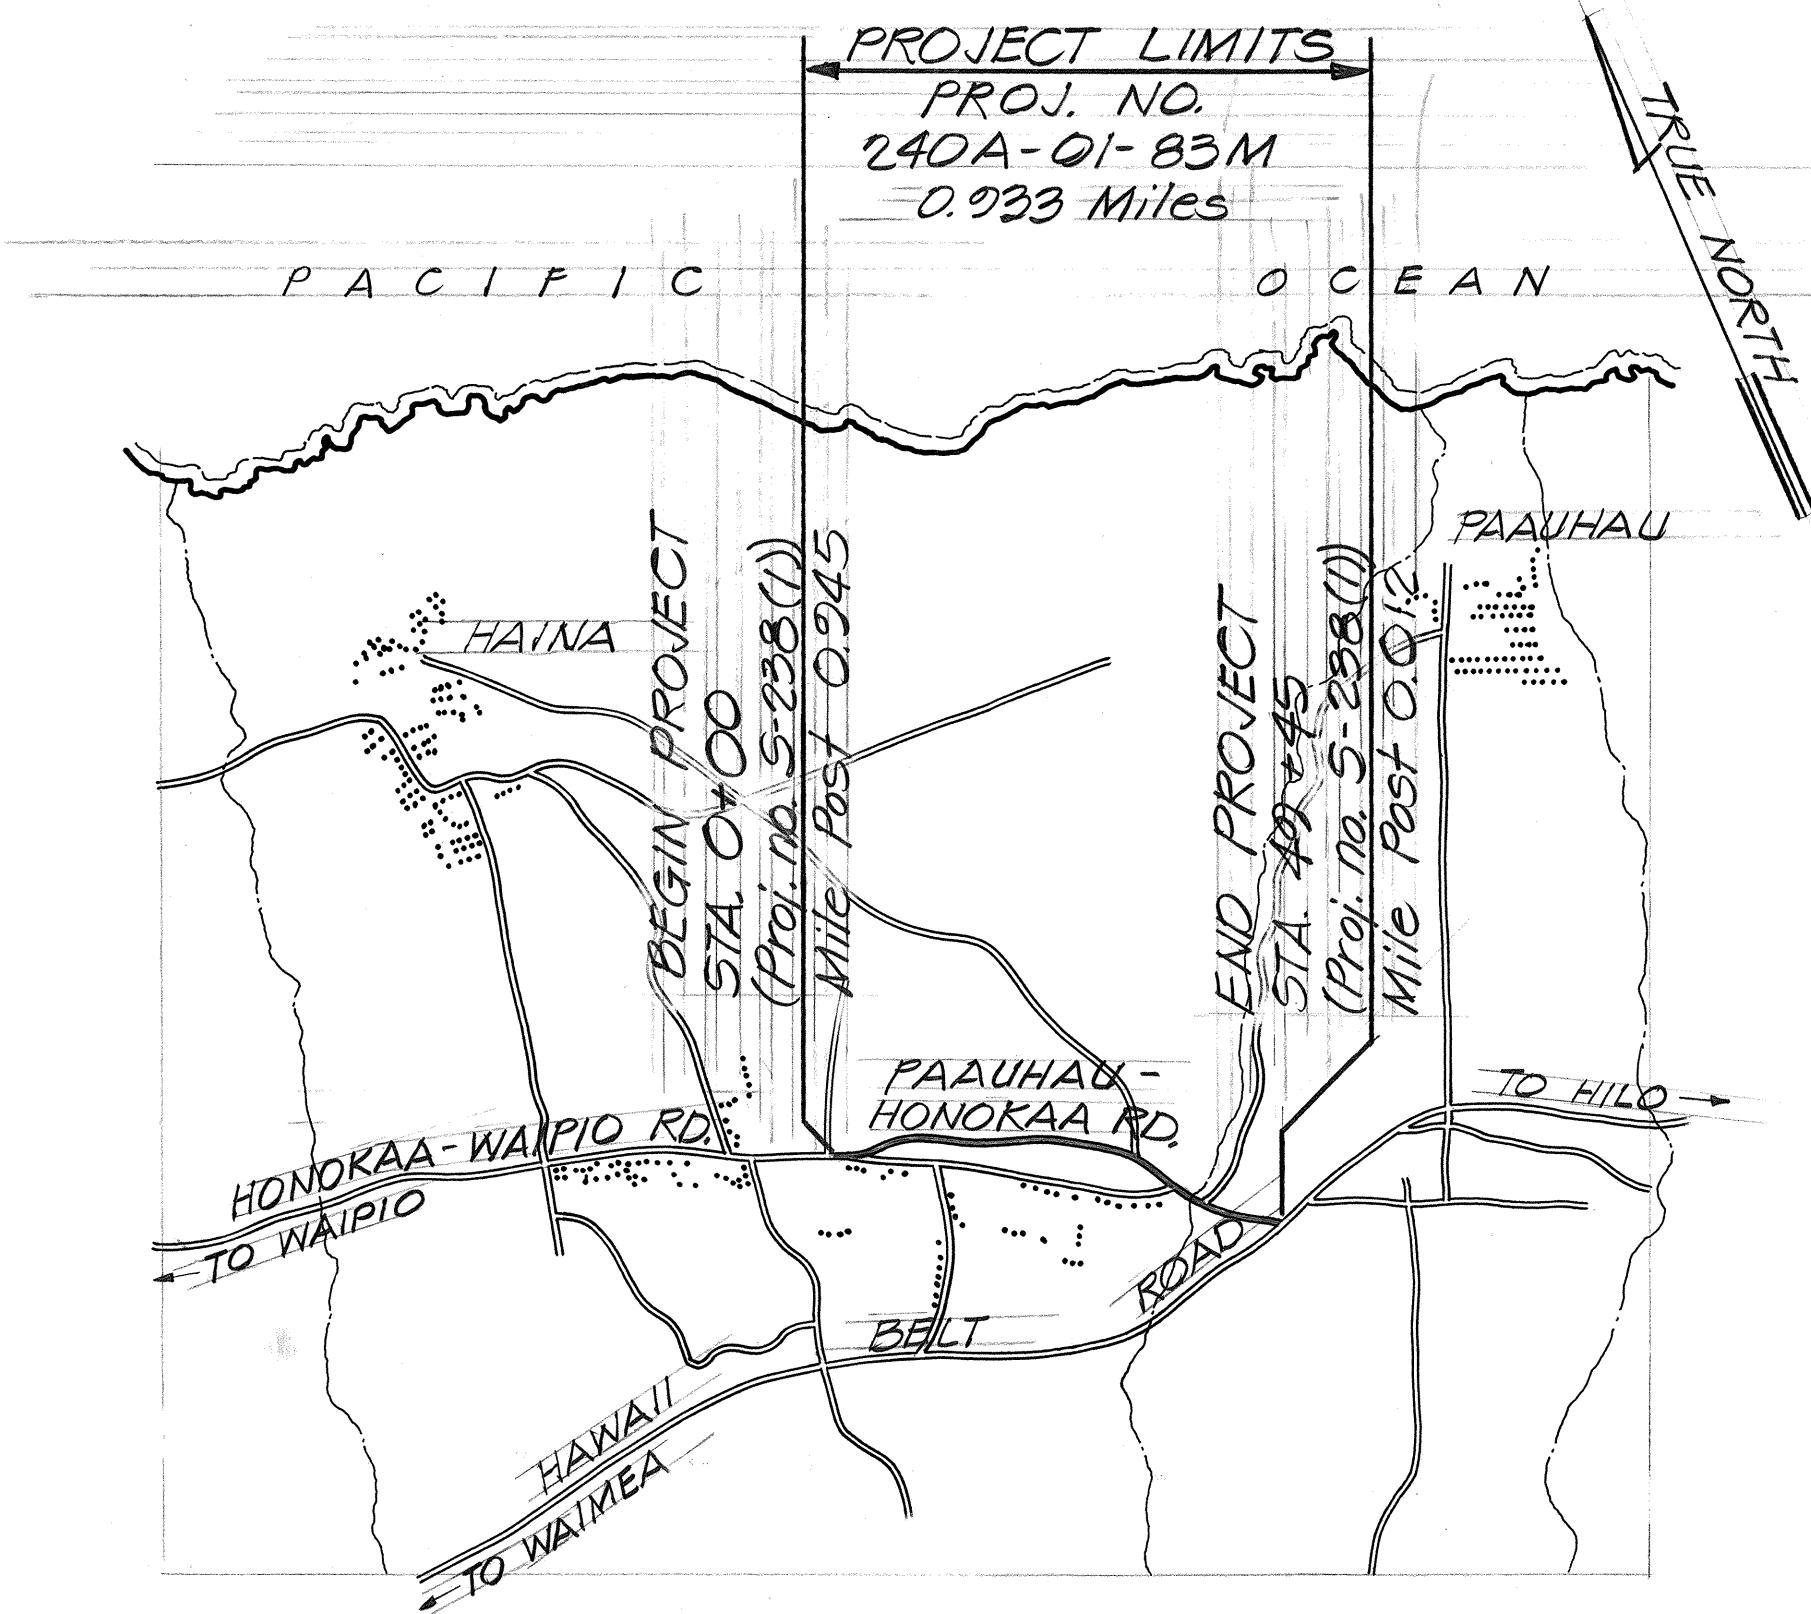

PAAUHAU - HONOKAA ROAD
PROJECT NO. 240A-01-83M
Scale: 1" = 2000'

PROJECT DESCRIPTION

This project begins at Station 0+00 of Project No. S-238(1) (Mile Post 0.945) and ends at Station 49+30 of Project No. S-238(1) (Mile Post 0.012), a distance of 0.933 miles. The work consists of resurfacing existing pavement, installing pavement markers and recovering and reconstructing existing centerline monuments.

PAVEMENT MARKER SCHEDULE						
STATION		DESCRIPTION	TYPE			
FROM	TO		D	H	J	
		Proj. no. S-238(1)				
0+00	0+25	No Passing - Both Sides	2			
0+25	0+60	Open				
0+60	4+30	No Passing - Both Sides	19			
4+30	4+70	Open				
4+70	8+66	No Passing - Both Sides	18			
8+66	17+61	No Passing L - Passing R	27	27	96	
17+61	22+71	Passing - Both Sides	13		48	
22+71	32+01	Passing L - No Passing R	23	24	96	
32+01	32+58	Open				
32+58	37+90	No Passing - Both Sides	26			
37+90	38+40	Open				
38+40	42+70	No Passing - Both Sides	22			
42+70	43+55	Open				
43+55	48+95	No Passing - Both Sides	26			
TOTALS			174	47	236	

RECONSTRUCTION OF & AND REFERENCE SURVEY MONUMENTS	
PROJ. NO. (EXIST.)	LOCATION
S-238(1)	S.T. Sta. 11+21.12
	P.O.T. Sta. 20+00
"	T.S. Sta. 28+79.93
"	S.T. Sta. 36+44.63
"	T.S. Sta. 36+97.64
"	S.T. Sta. 43+15.77
TOTAL	
5	

RECOVERY OF & AND REFERENCE SURVEY MONUMENTS	
PROJ. NO. (EXIST.)	LOCATION
S-238(1)	T.S. Sta. 0+00
"	S.T.S. Sta. 5+66.41
TOTAL	
2	

VALVE BOX SCHEDULE (CCO*1)	
PROJ. NO.	LOCATION
S-238(1)	0+25 R.L.
TOTAL	1

STATE OF HAWAII
DEPARTMENT OF TRANSPORTATION
HIGHWAYS DIVISION

GENERAL LOCATION PLAN

PAAUHAU - HONOKAA ROAD
Ohelo Street to Hawaii Belt Road
Proj. No. 240A-01-83M

Scale: As Noted Date: July 1982

SHEET NO. 1 OF 1 SHEETS

SURVEY PLOTTED BY	DATE
DRAWN BY	
TRACED BY	
CHECKED BY	
QUANTITIES BY	
NOTED BY	
NO.	