


FED. ROAD DIST. NO.	STATE	FED. AID PROJ. NO.	FISCAL YEAR	SHEET NO.	TOTAL SHEETS
HAWAII	HAW.	CMAQ-0100(62)	2004	47	86

T.M.K.: 3RD DIV.
5-3-10:56
NEW HALAULA SCHOOL

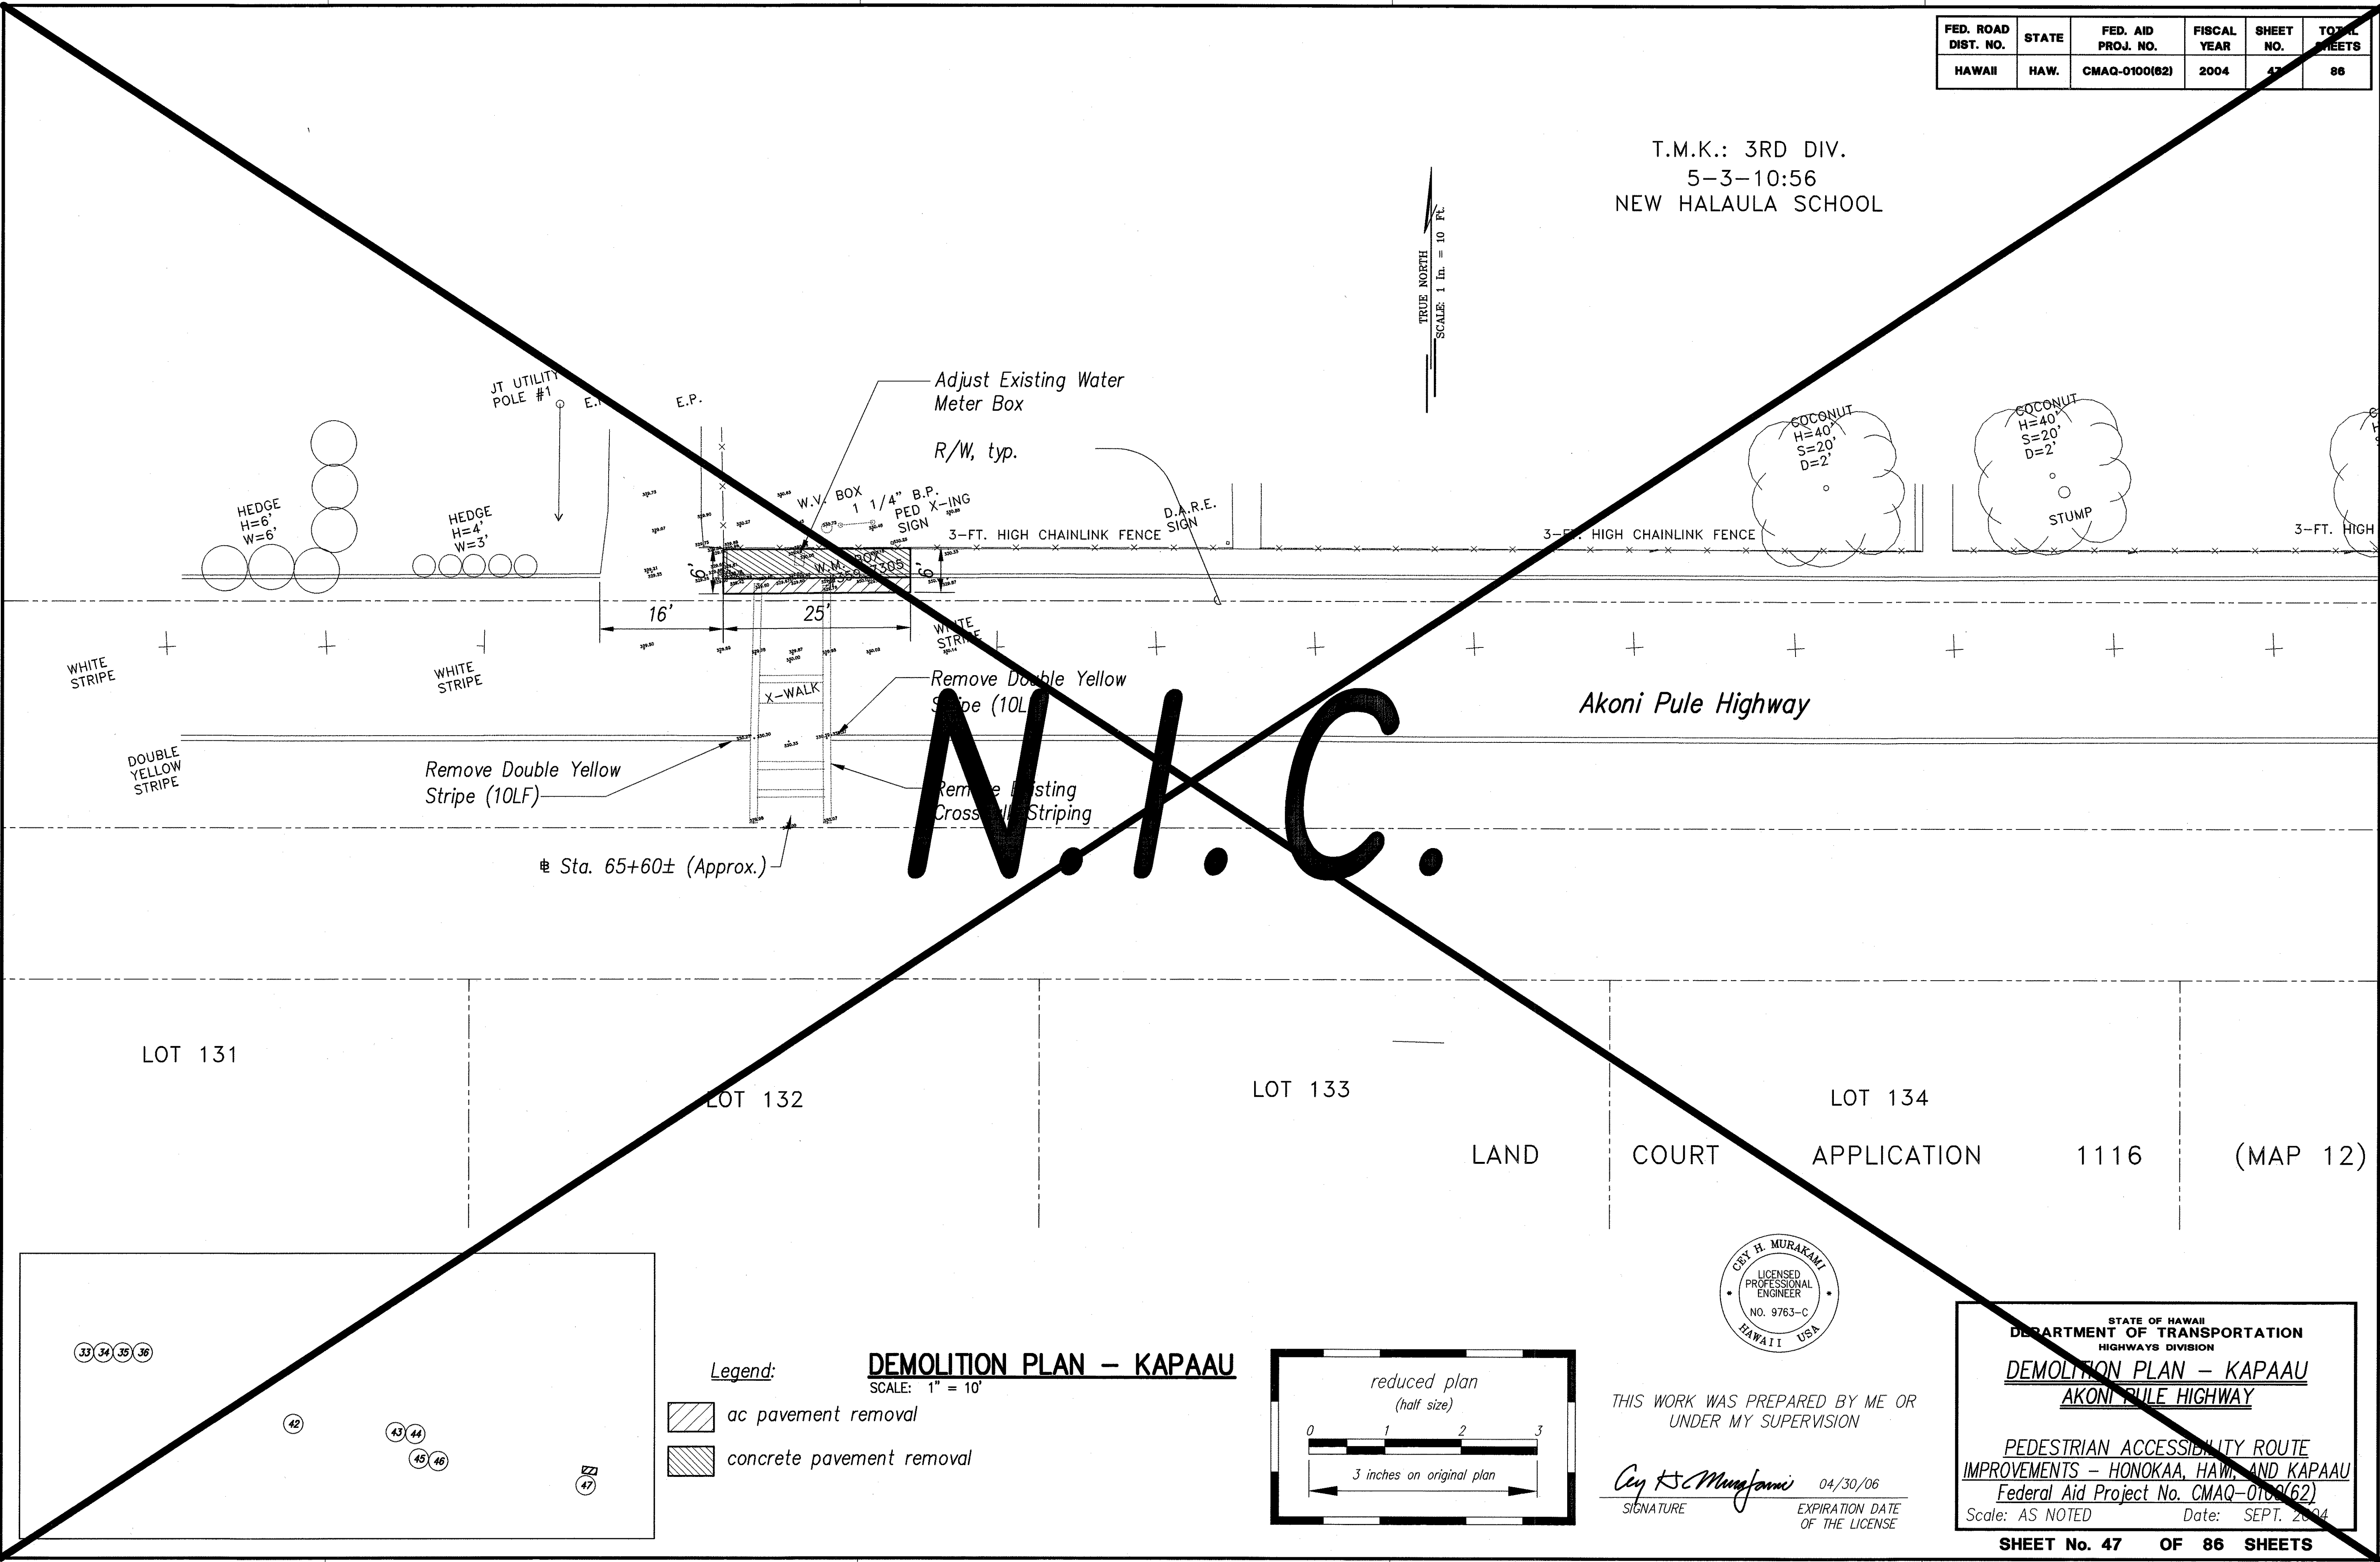



ORIGINAL PLAN	DATE
DESIGNED BY	9/2004
DRAWN BY	9/2004
CHECKED BY	9/2004
APPROVED BY	9/2004
NO.	

I:\2000\2000-070-000 PROJECT POINT - PEDESTRIAN ACCESSIBILITY\G DRAWINGS\PLAN\G-010021_KAPAAU.DWG 04/26/02 10:12 JCH

Legend:

- ac pavement removal
- concrete pavement removal

DEMOLITION PLAN - KAPAAU
SCALE: 1" = 10'

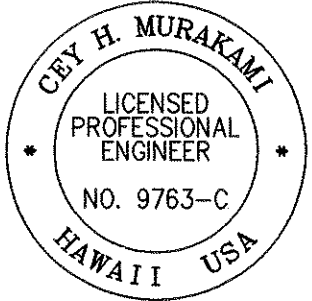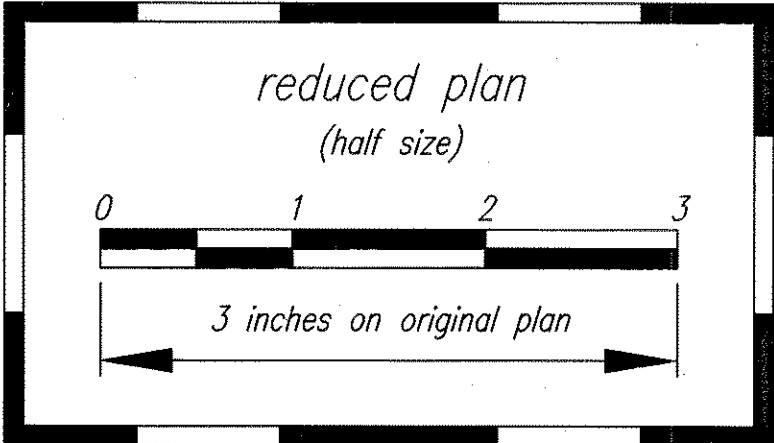

THIS WORK WAS PREPARED BY ME OR
UNDER MY SUPERVISION

Cey H. Murakami 04/30/06
SIGNATURE EXPIRATION DATE
OF THE LICENSE

STATE OF HAWAII
DEPARTMENT OF TRANSPORTATION
HIGHWAYS DIVISION
DEMOLITION PLAN - KAPAAU
AKONI PULE HIGHWAY

PEDESTRIAN ACCESSIBILITY ROUTE
IMPROVEMENTS - HONOKAA, HAWAII AND KAPAAU
Federal Aid Project No. CMAQ-0100(62)
Scale: AS NOTED Date: SEPT. 2004

SHEET No. 47 OF 86 SHEETS