




FED. ROAD DIST. NO.	STATE	FED. AID PROJ. NO.	FISCAL YEAR	SHEET NO.	TOTAL SHEETS
HAWAII	HAW.	CMAQ-0100(62)	2004	65	86

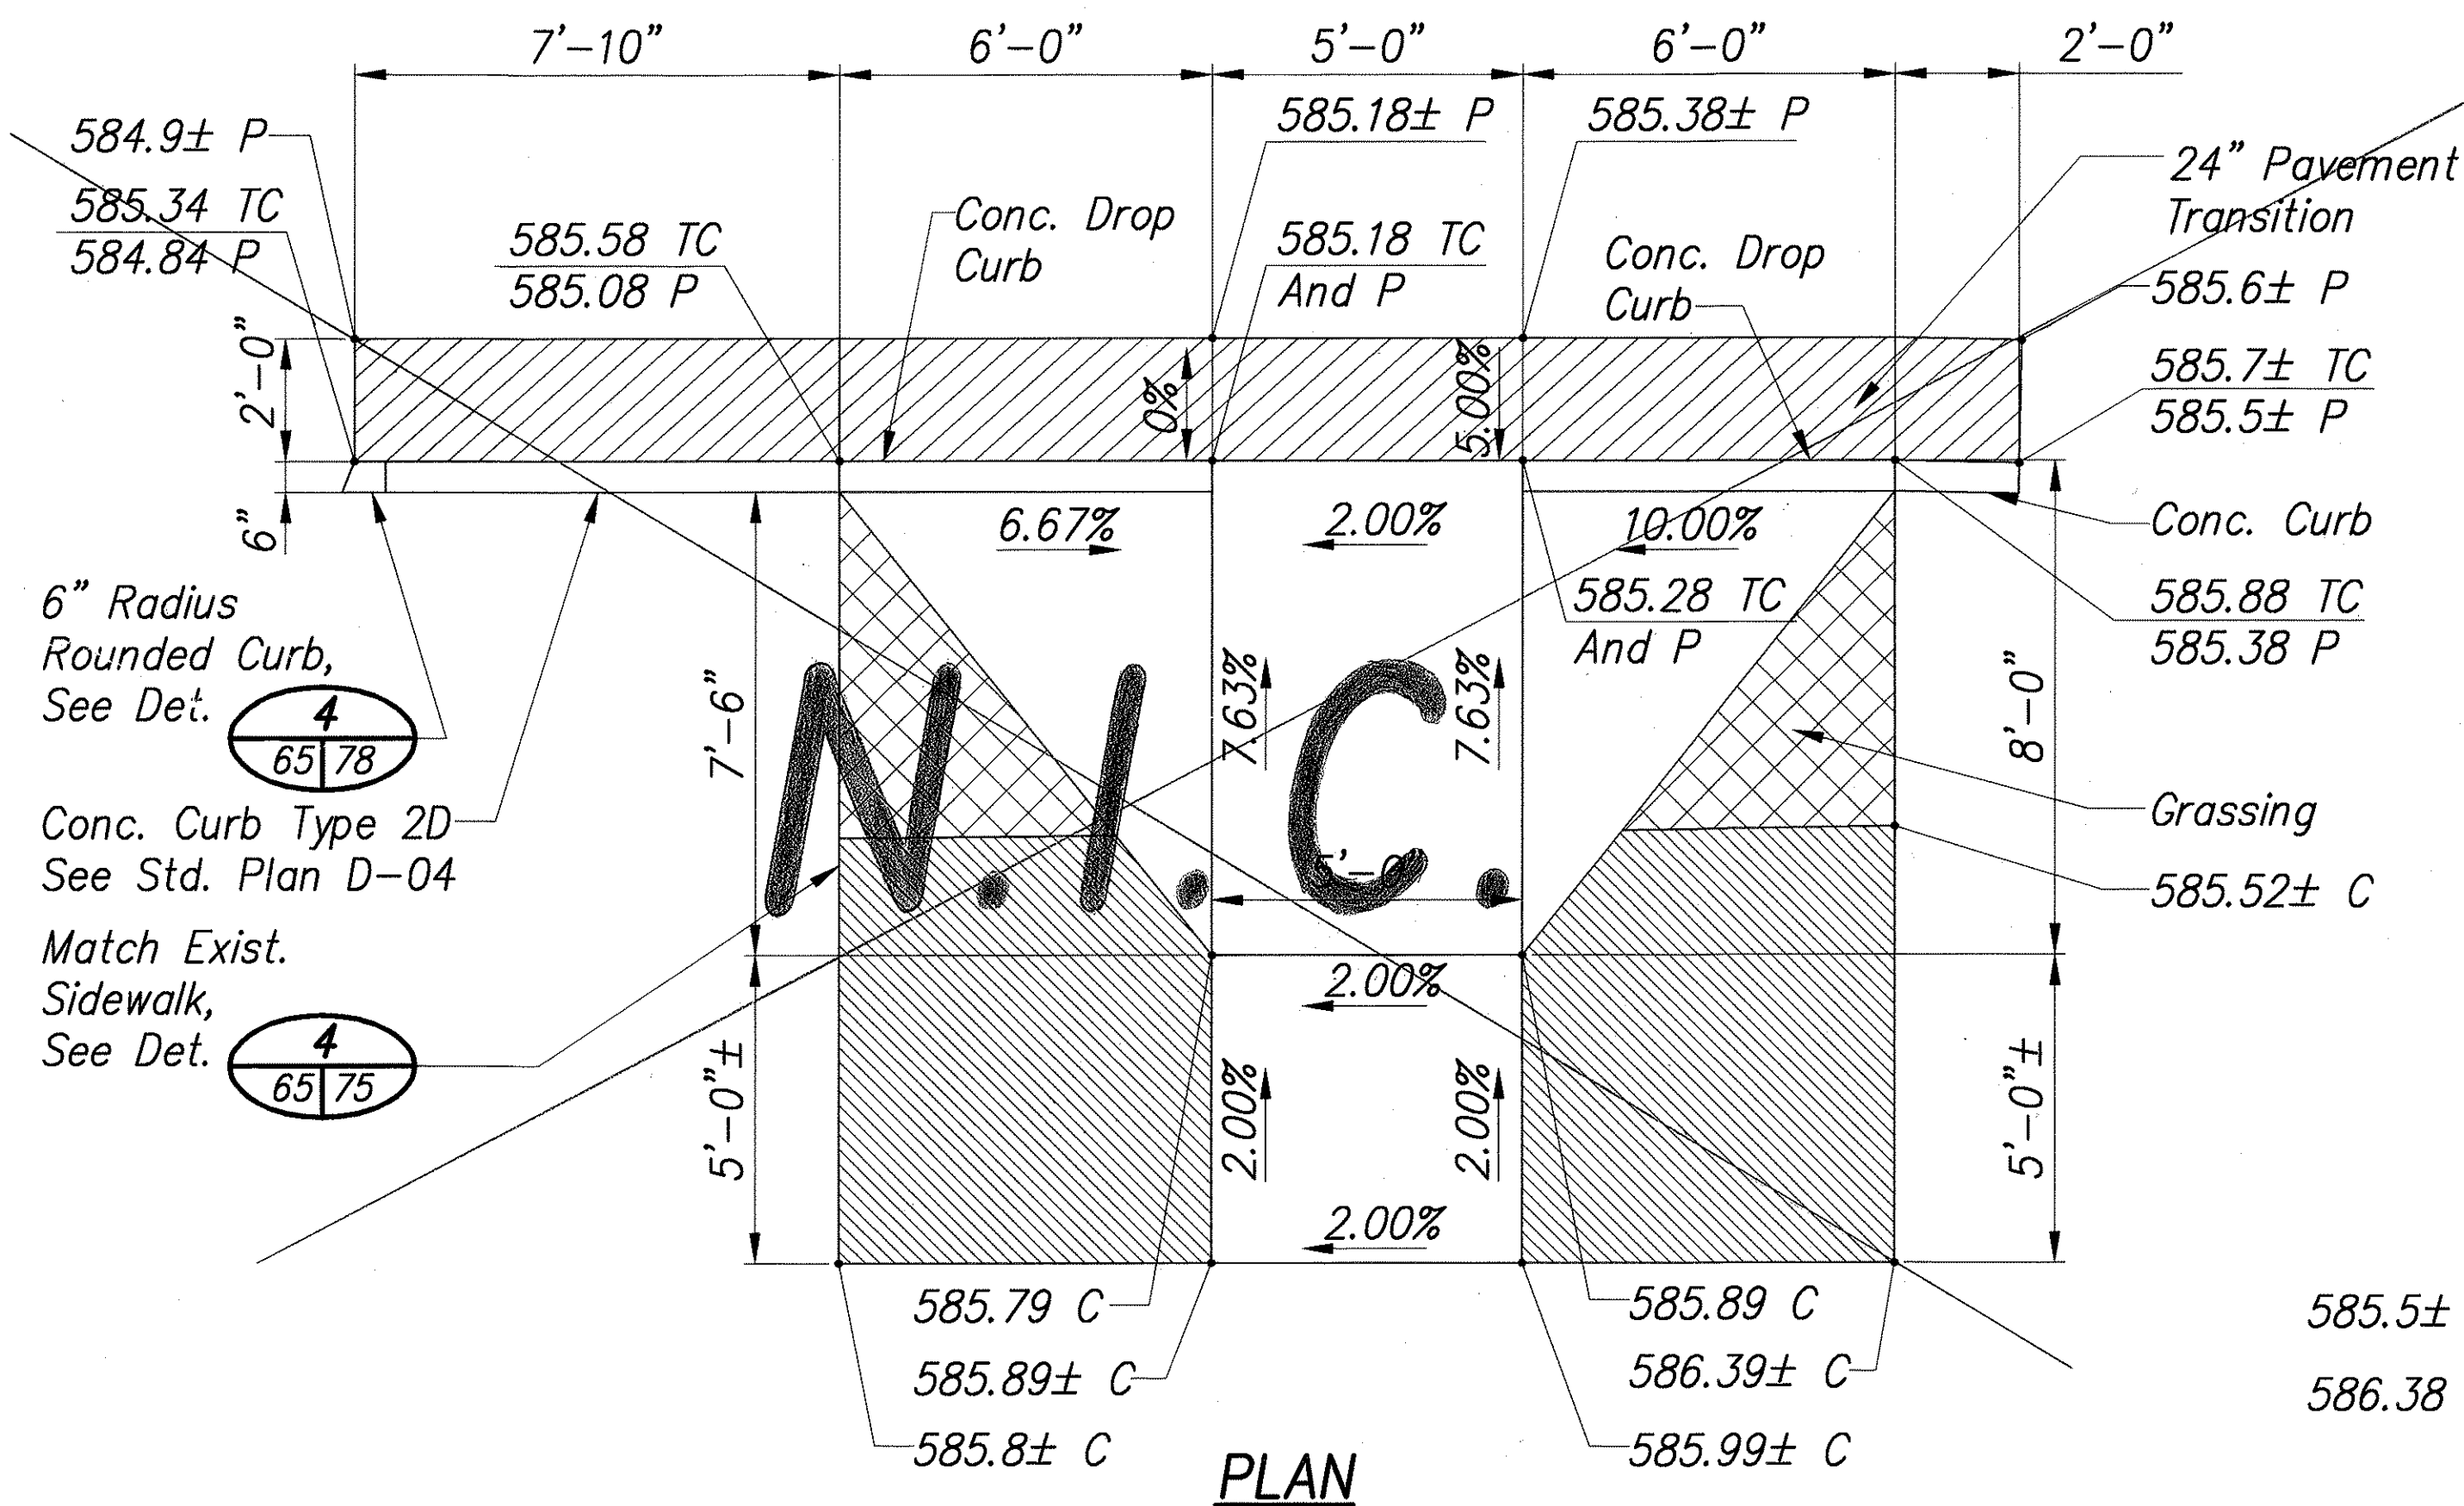


CURB RAMP DETAIL 1
SCALE: 3/8"=1'-0" 37/65

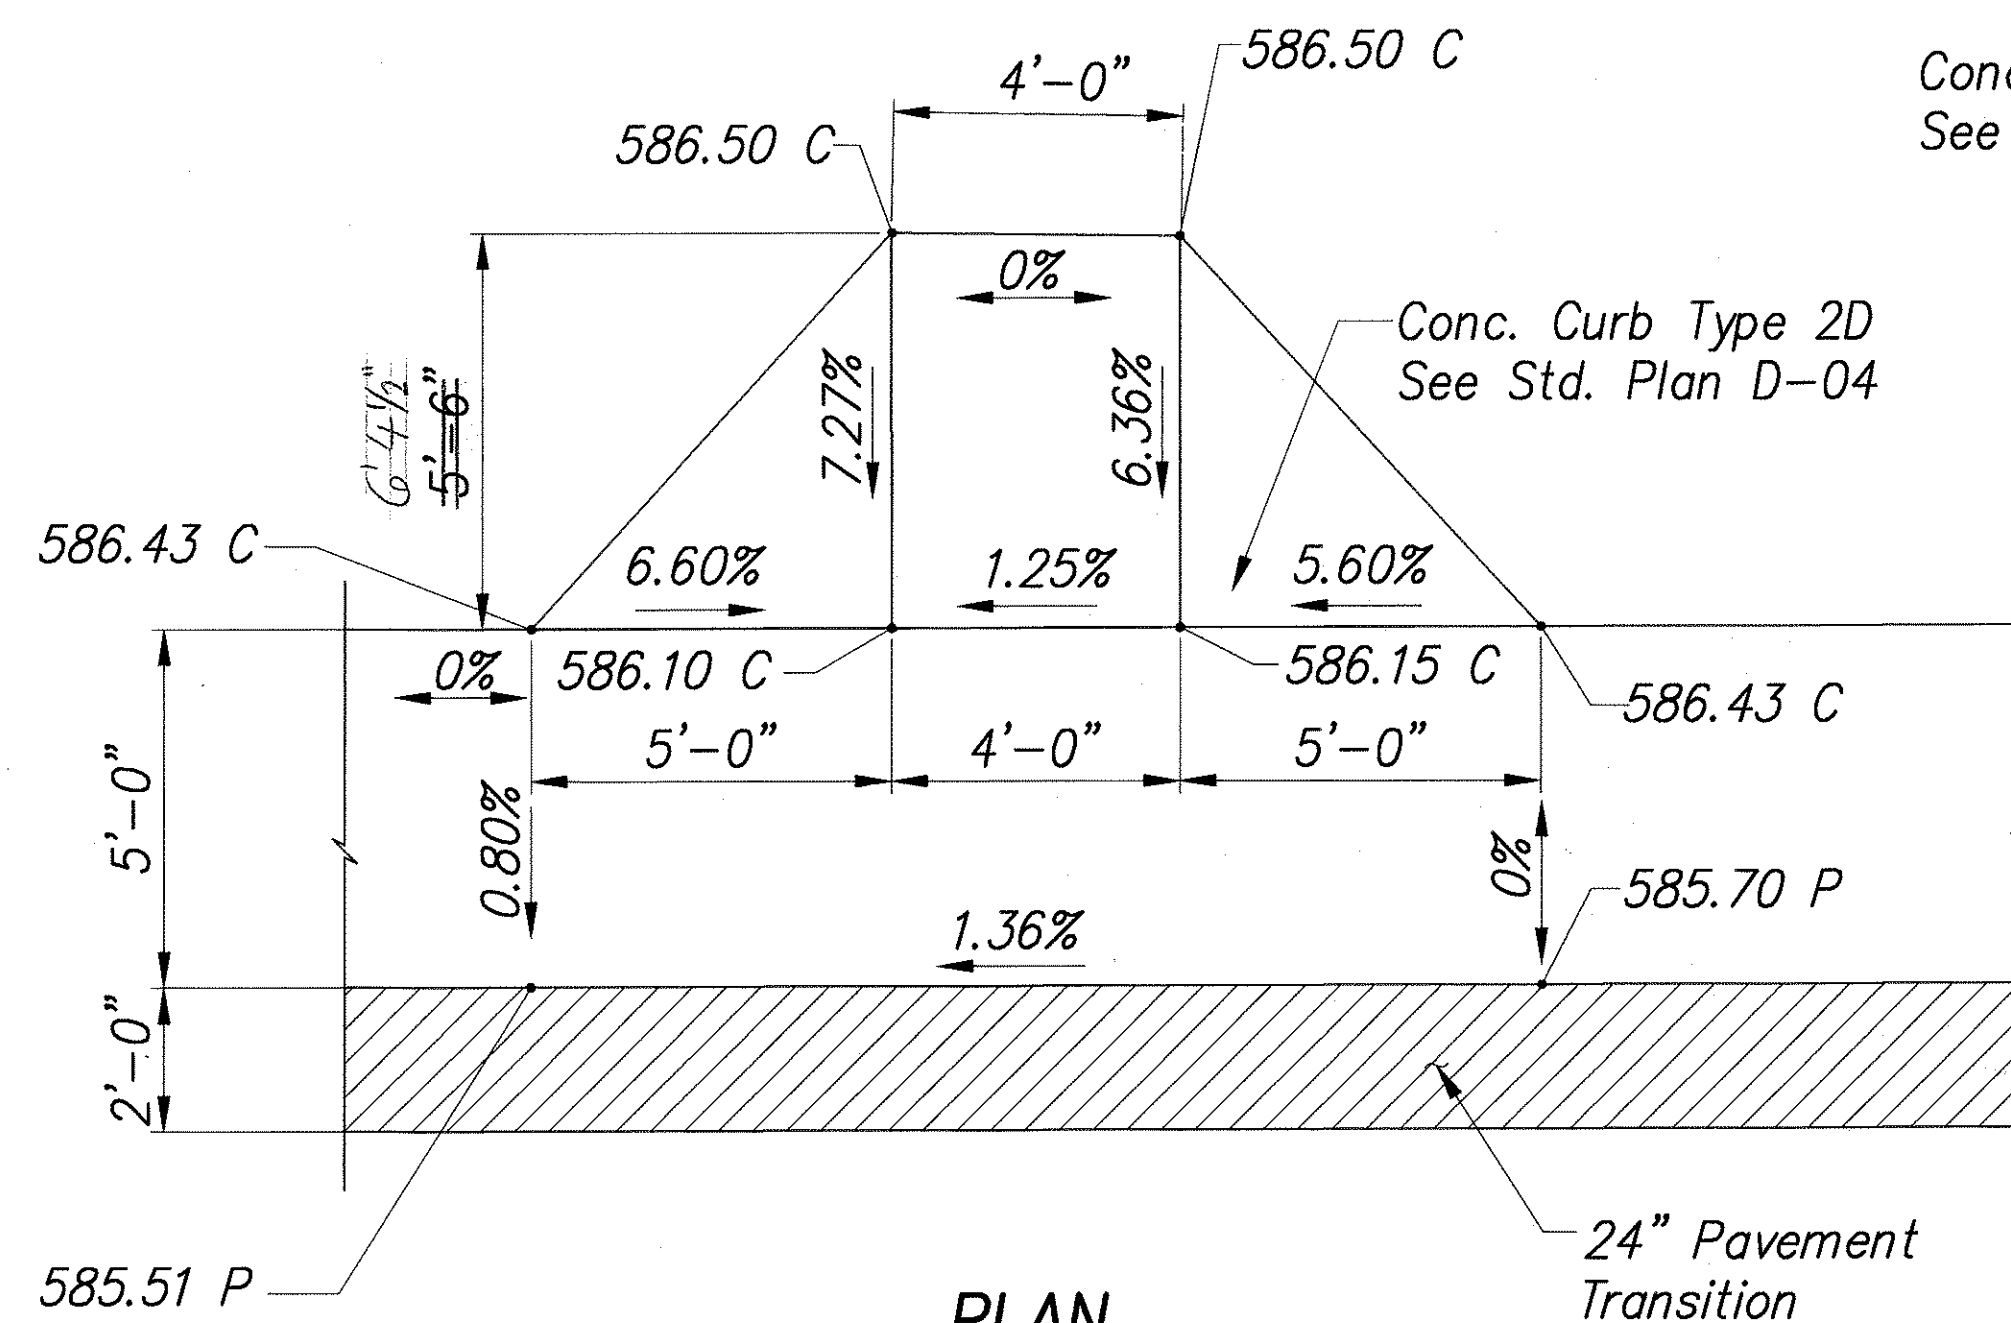

CURB RAMP DETAIL 3
SCALE: 3/8"=1'-0" 37/65

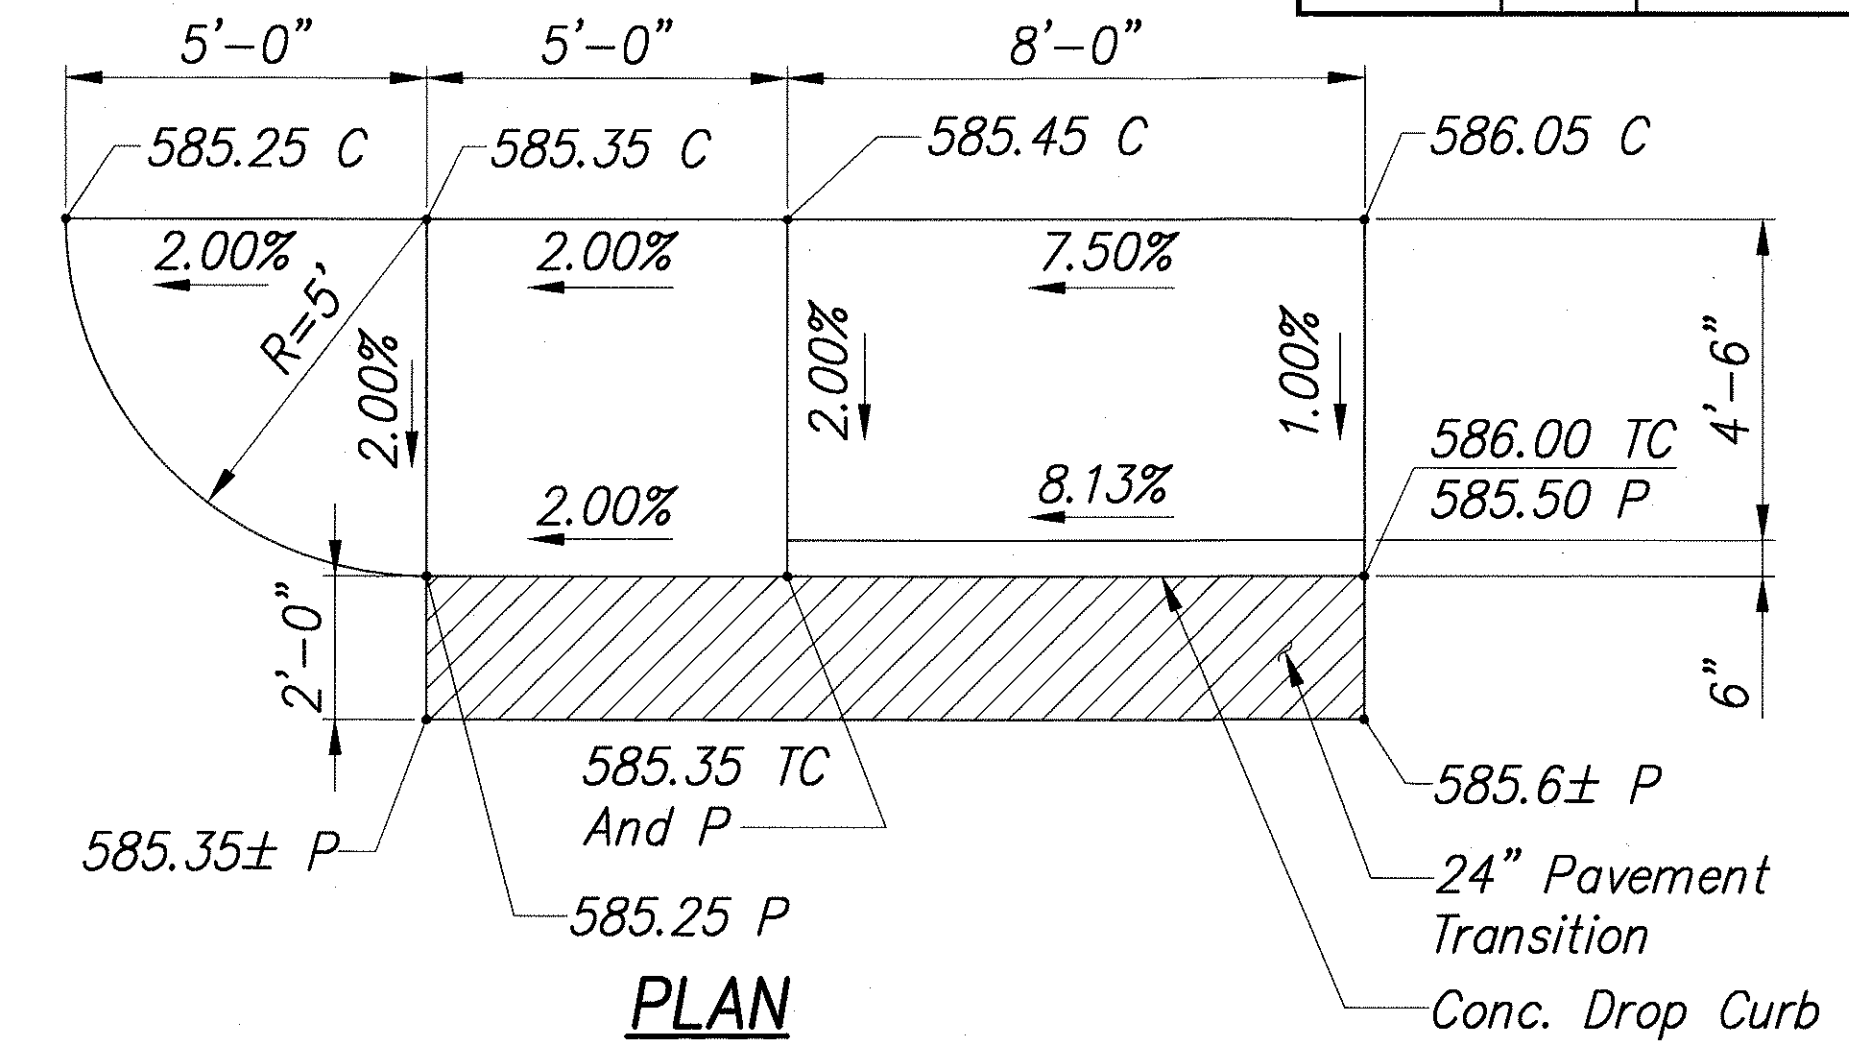


CURB RAMP DETAIL 2
SCALE: 3/8"=1'-0" 37/65

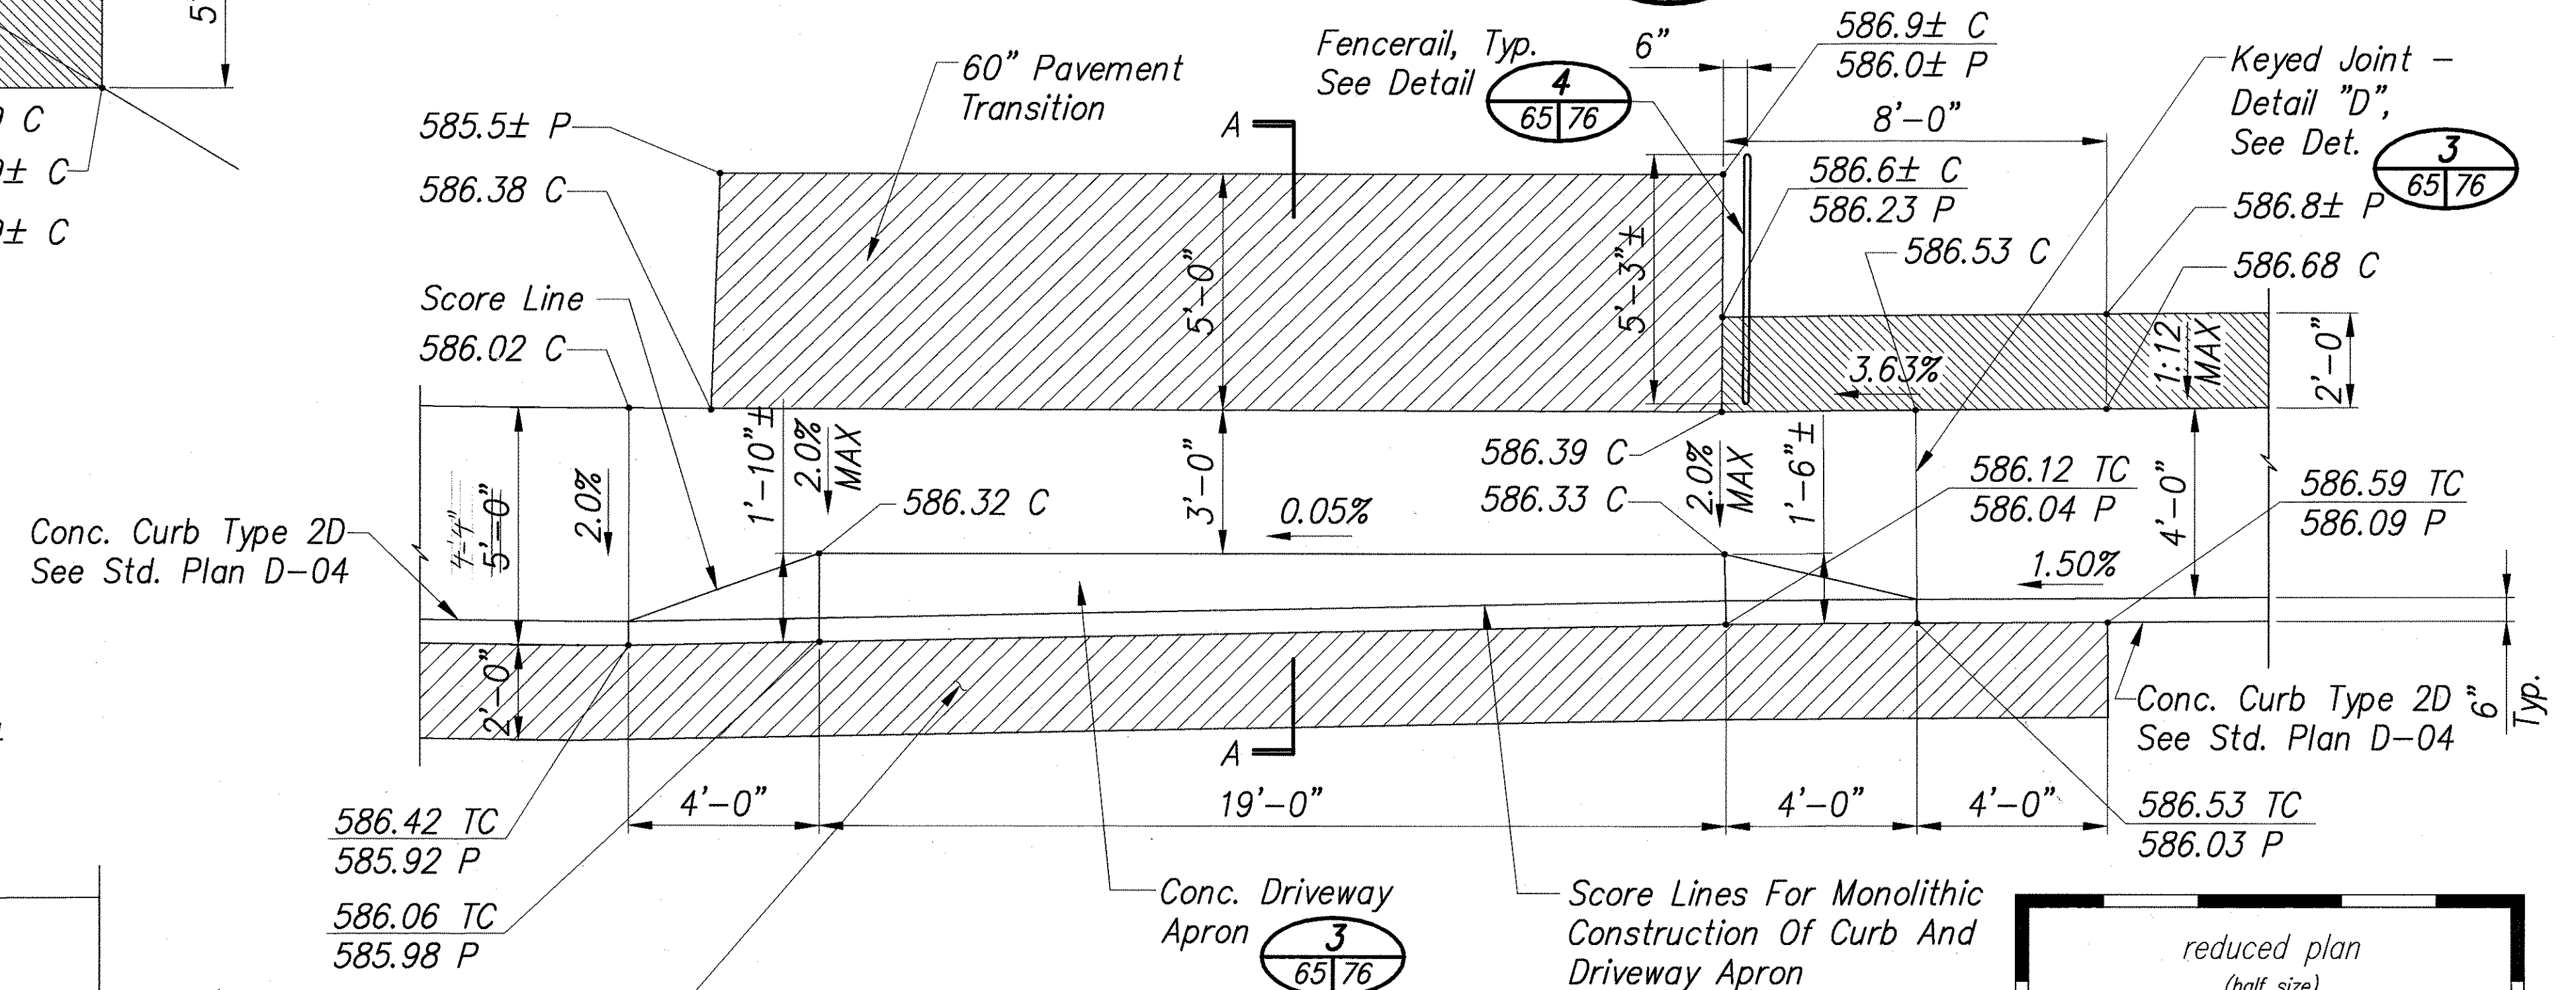

CONCRETE DRIVEWAY APRON DETAIL 4
SCALE: 3/8"=1'-0" 38/65


Note:
1. For extension to existing driveway, scoring and finish shall match existing scoring and finish.

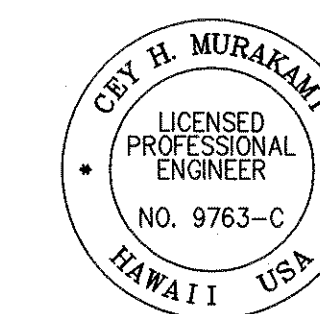

THIS WORK WAS PREPARED BY ME OR UNDER MY SUPERVISION

Cey H. Murakami 04/30/06
SIGNATURE EXPIRATION DATE OF THE LICENSE

"AS-BUILT"

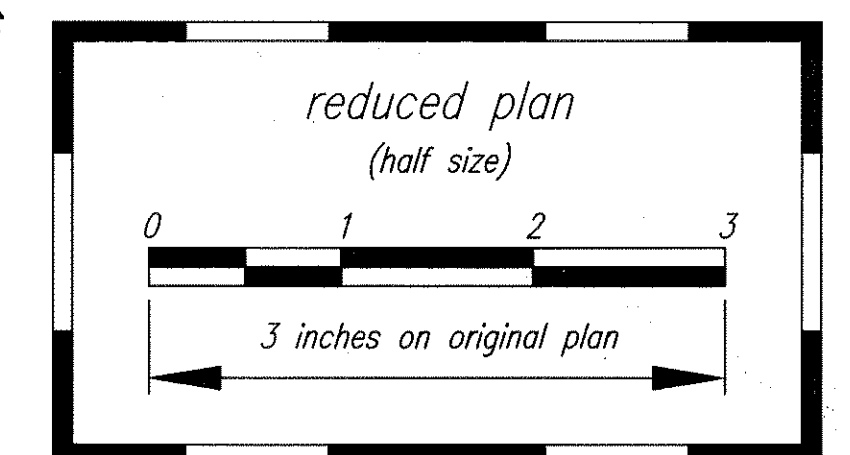

STATE OF HAWAII
DEPARTMENT OF TRANSPORTATION
HIGHWAYS DIVISION







HAWAII - RAMP DETAILS-2

PEDESTRIAN ACCESSIBILITY ROUTE
IMPROVEMENTS - HONOKAA, HAWAII, AND KAPAAU
Federal Aid Project No. CMAQ-0100(62)

Scale: AS NOTED Date: SEPT. 2004

SHEET No. 65 OF 86 SHEETS

FED. ROAD DIST. NO.	STATE	FED. AID PROJ. NO.	FISCAL YEAR	SHEET NO.	TOTAL SHEETS
HAWAII	HAW.	CMAQ-0100(62)	2004	66	86

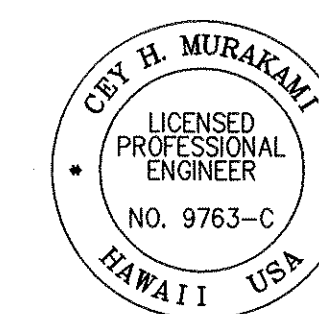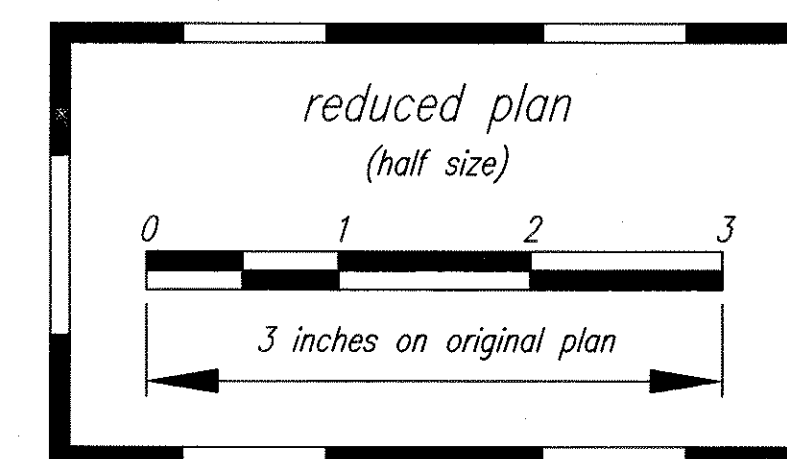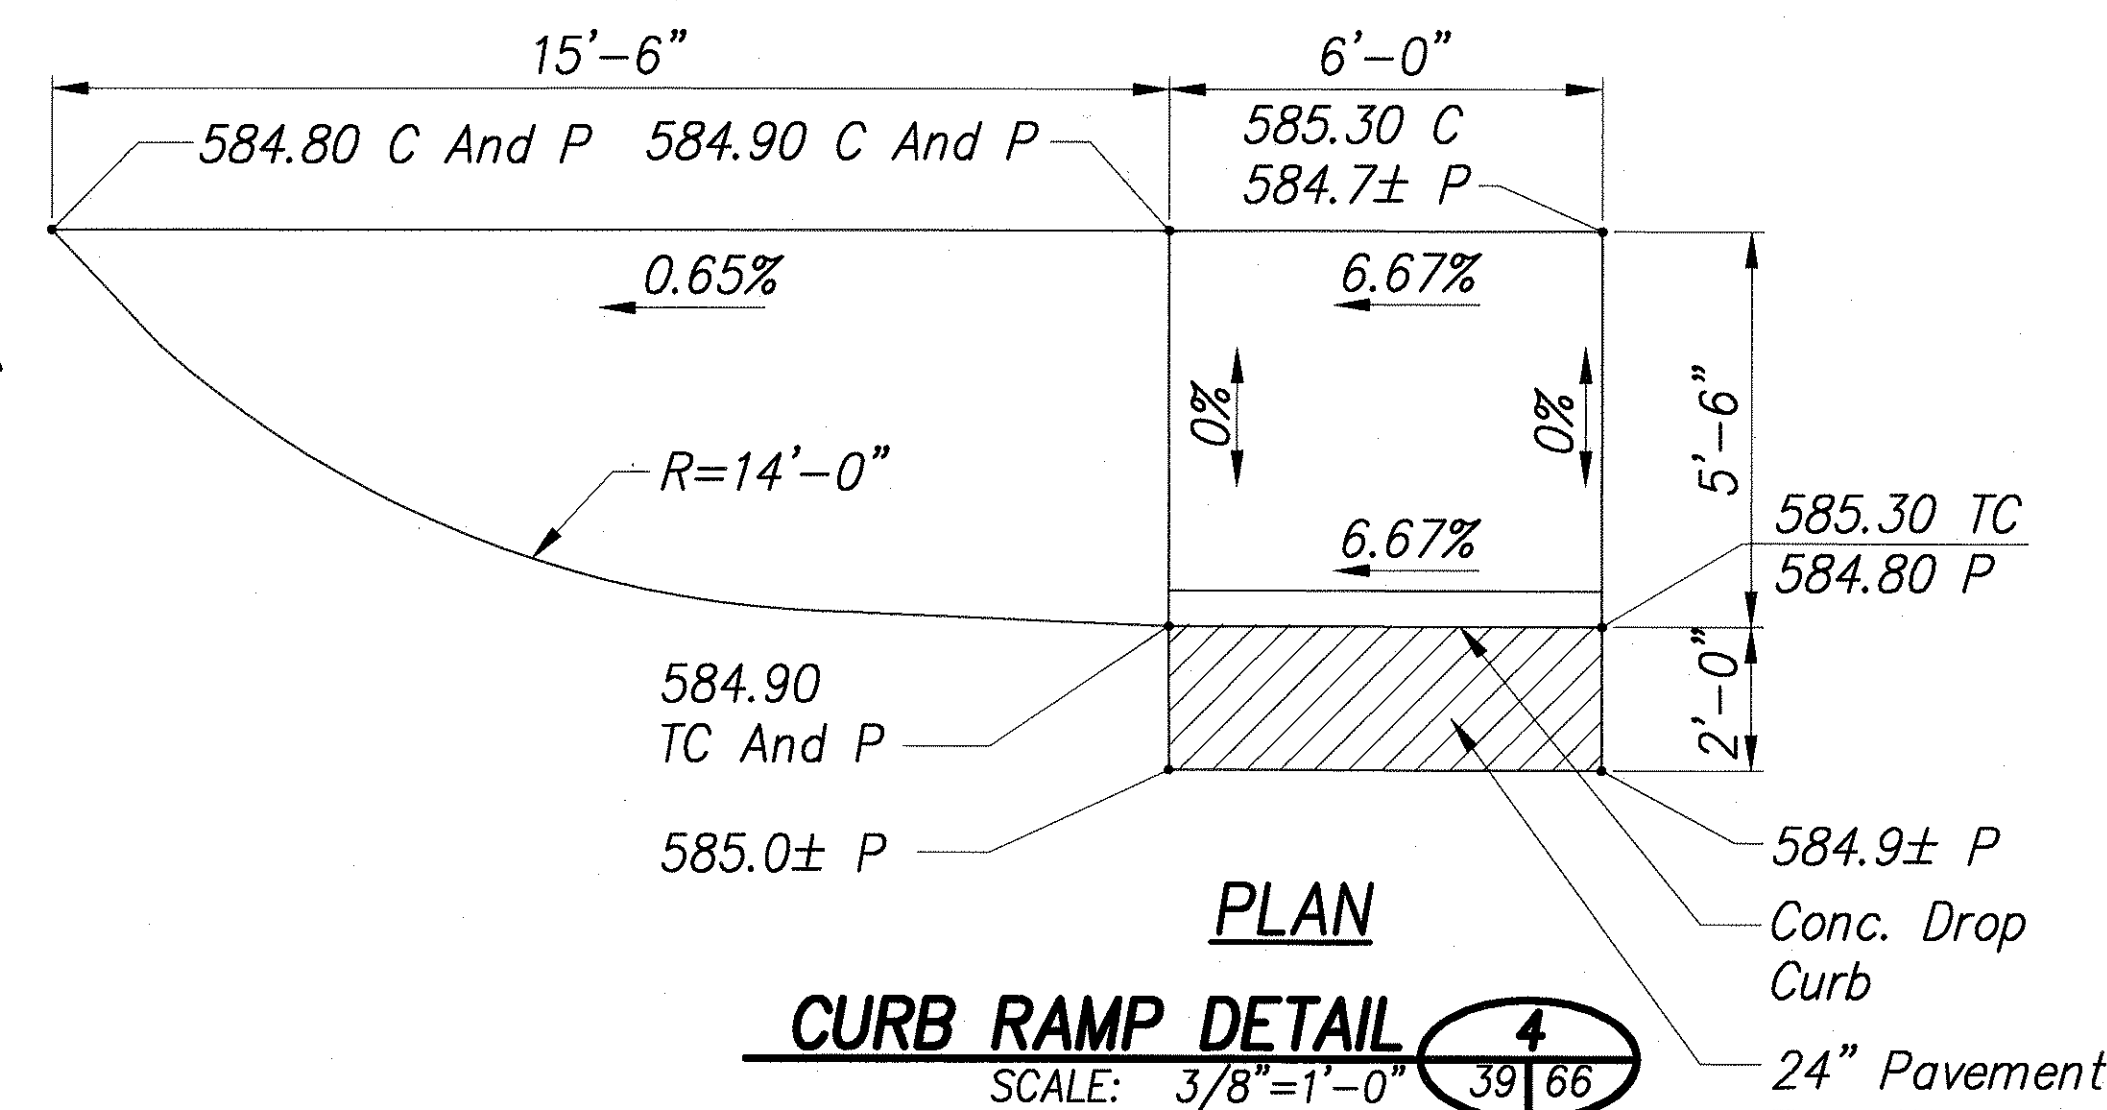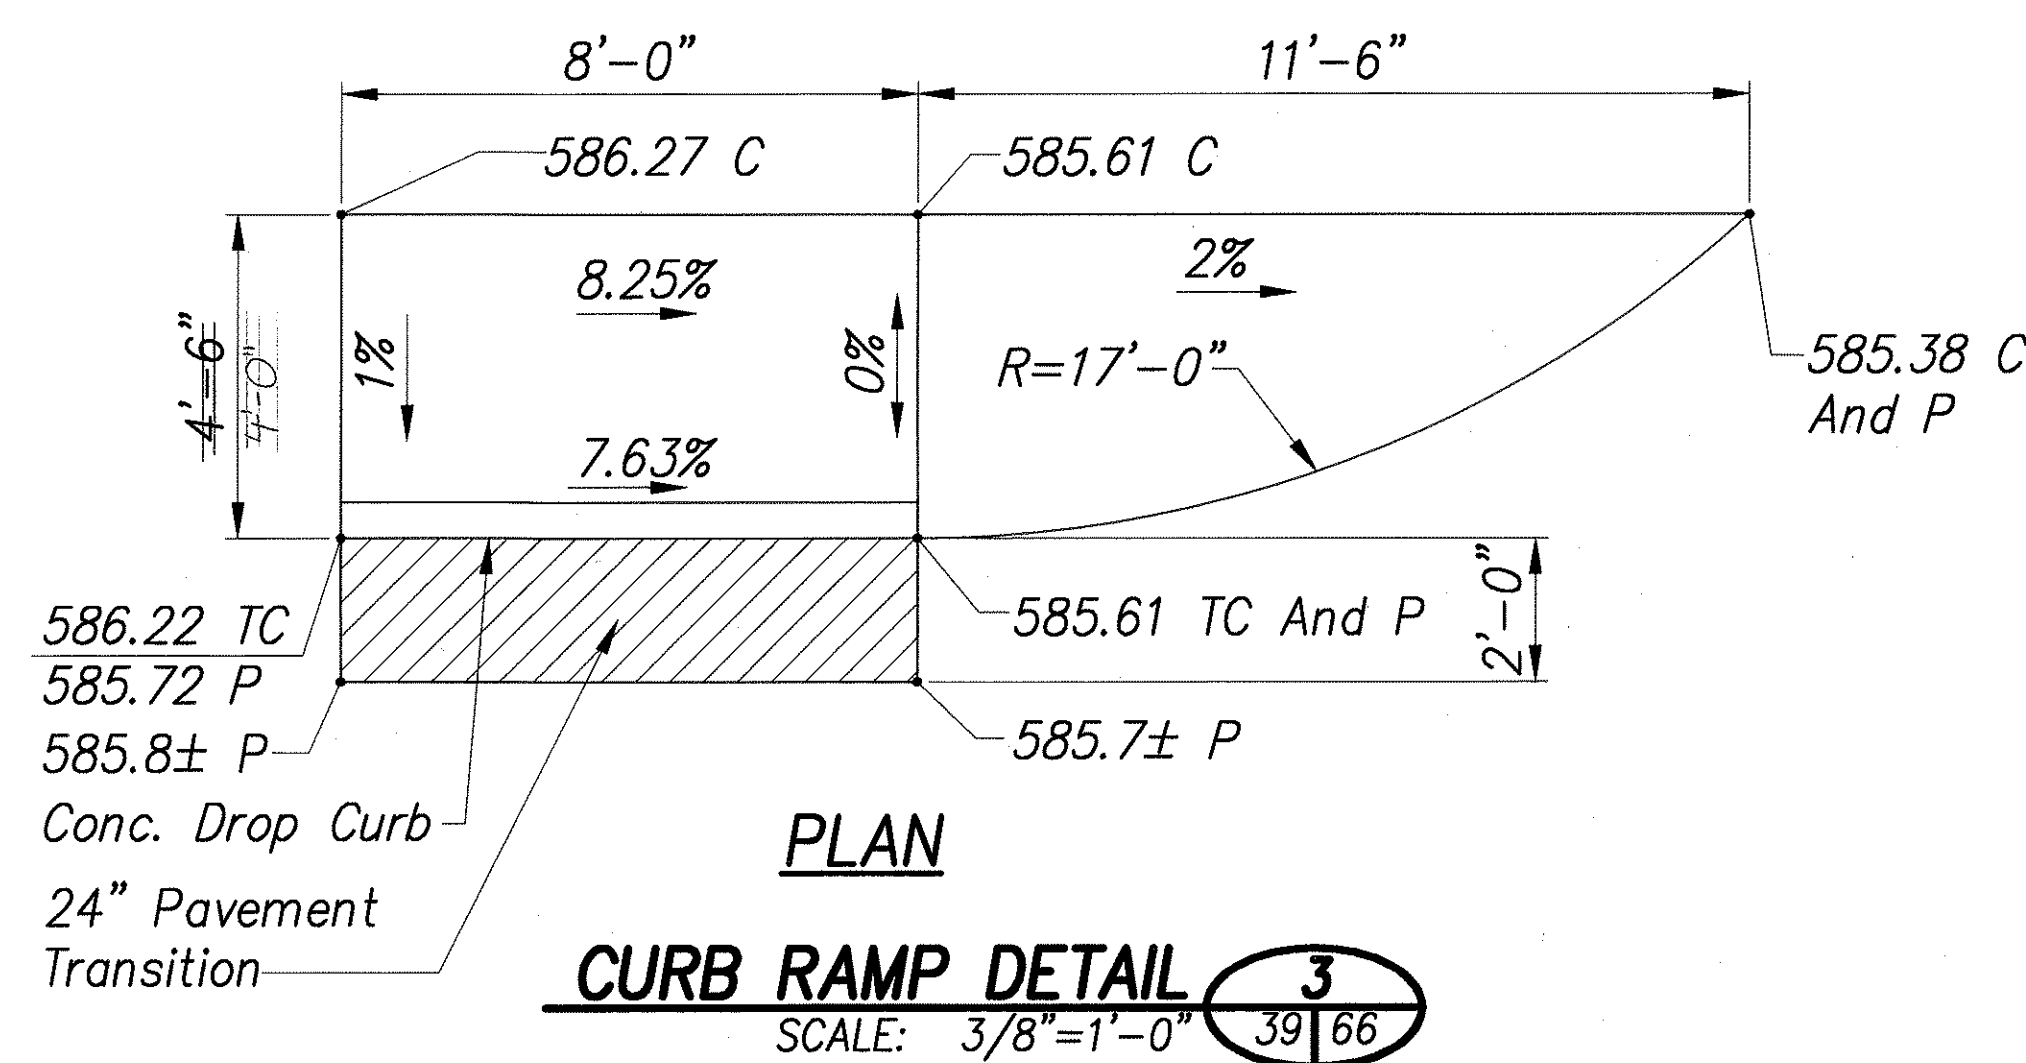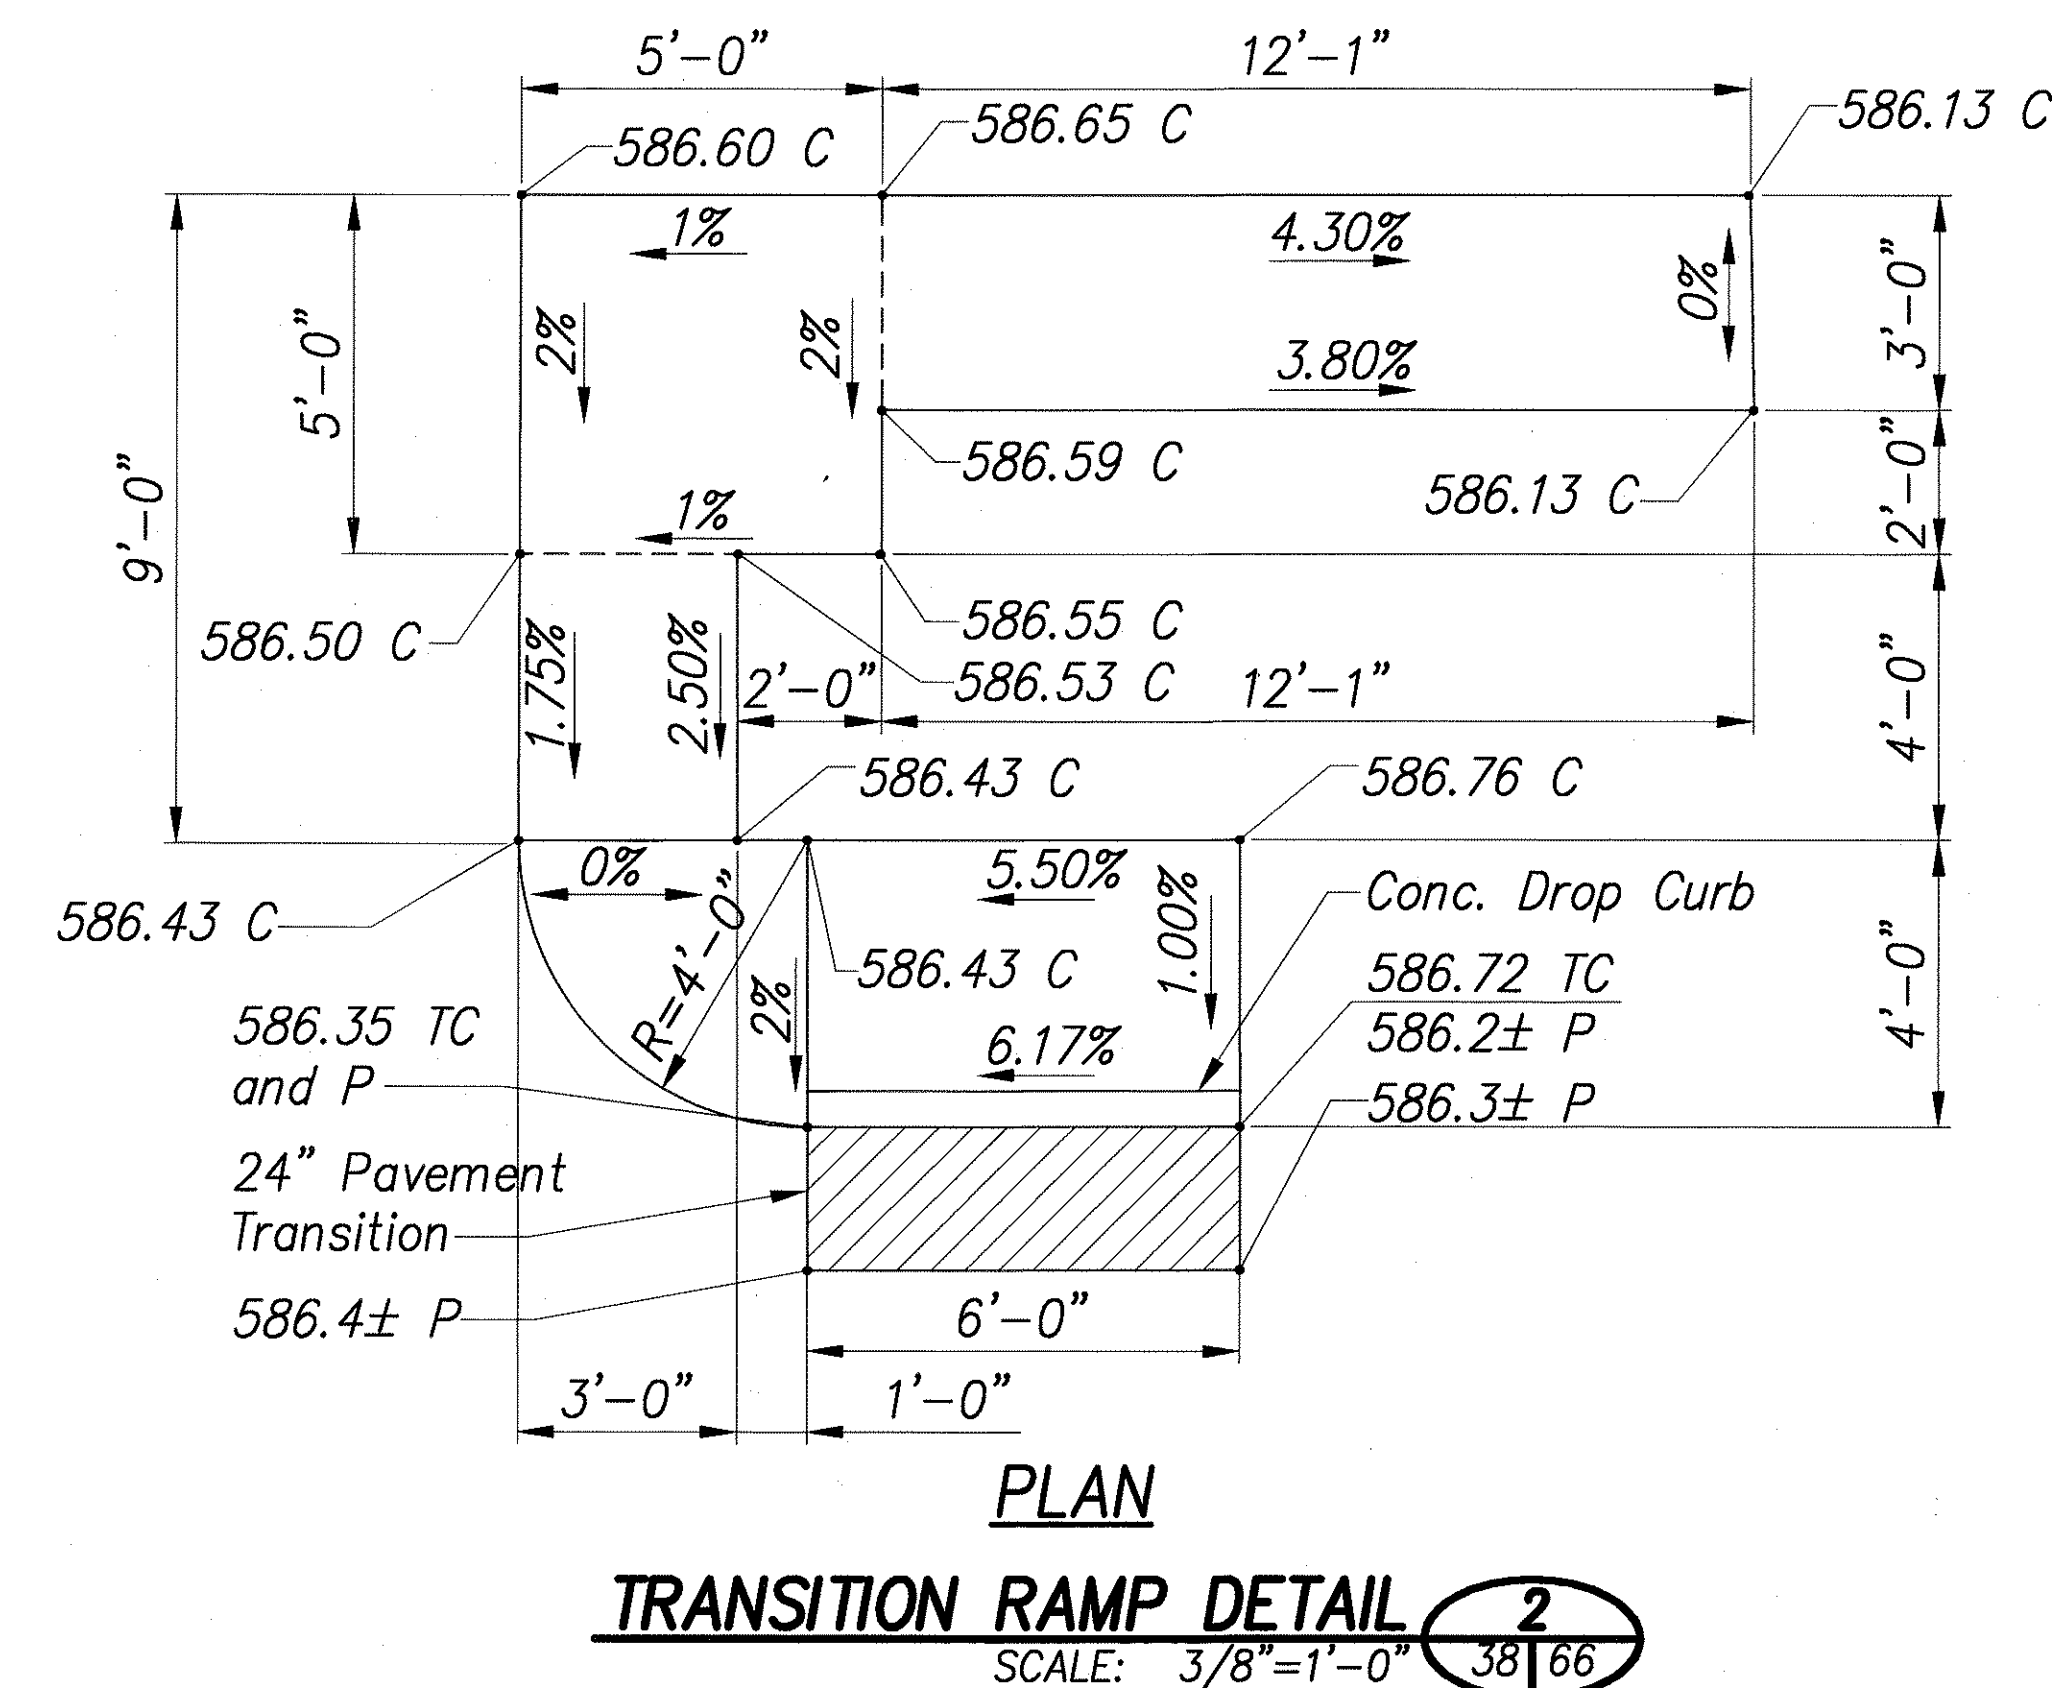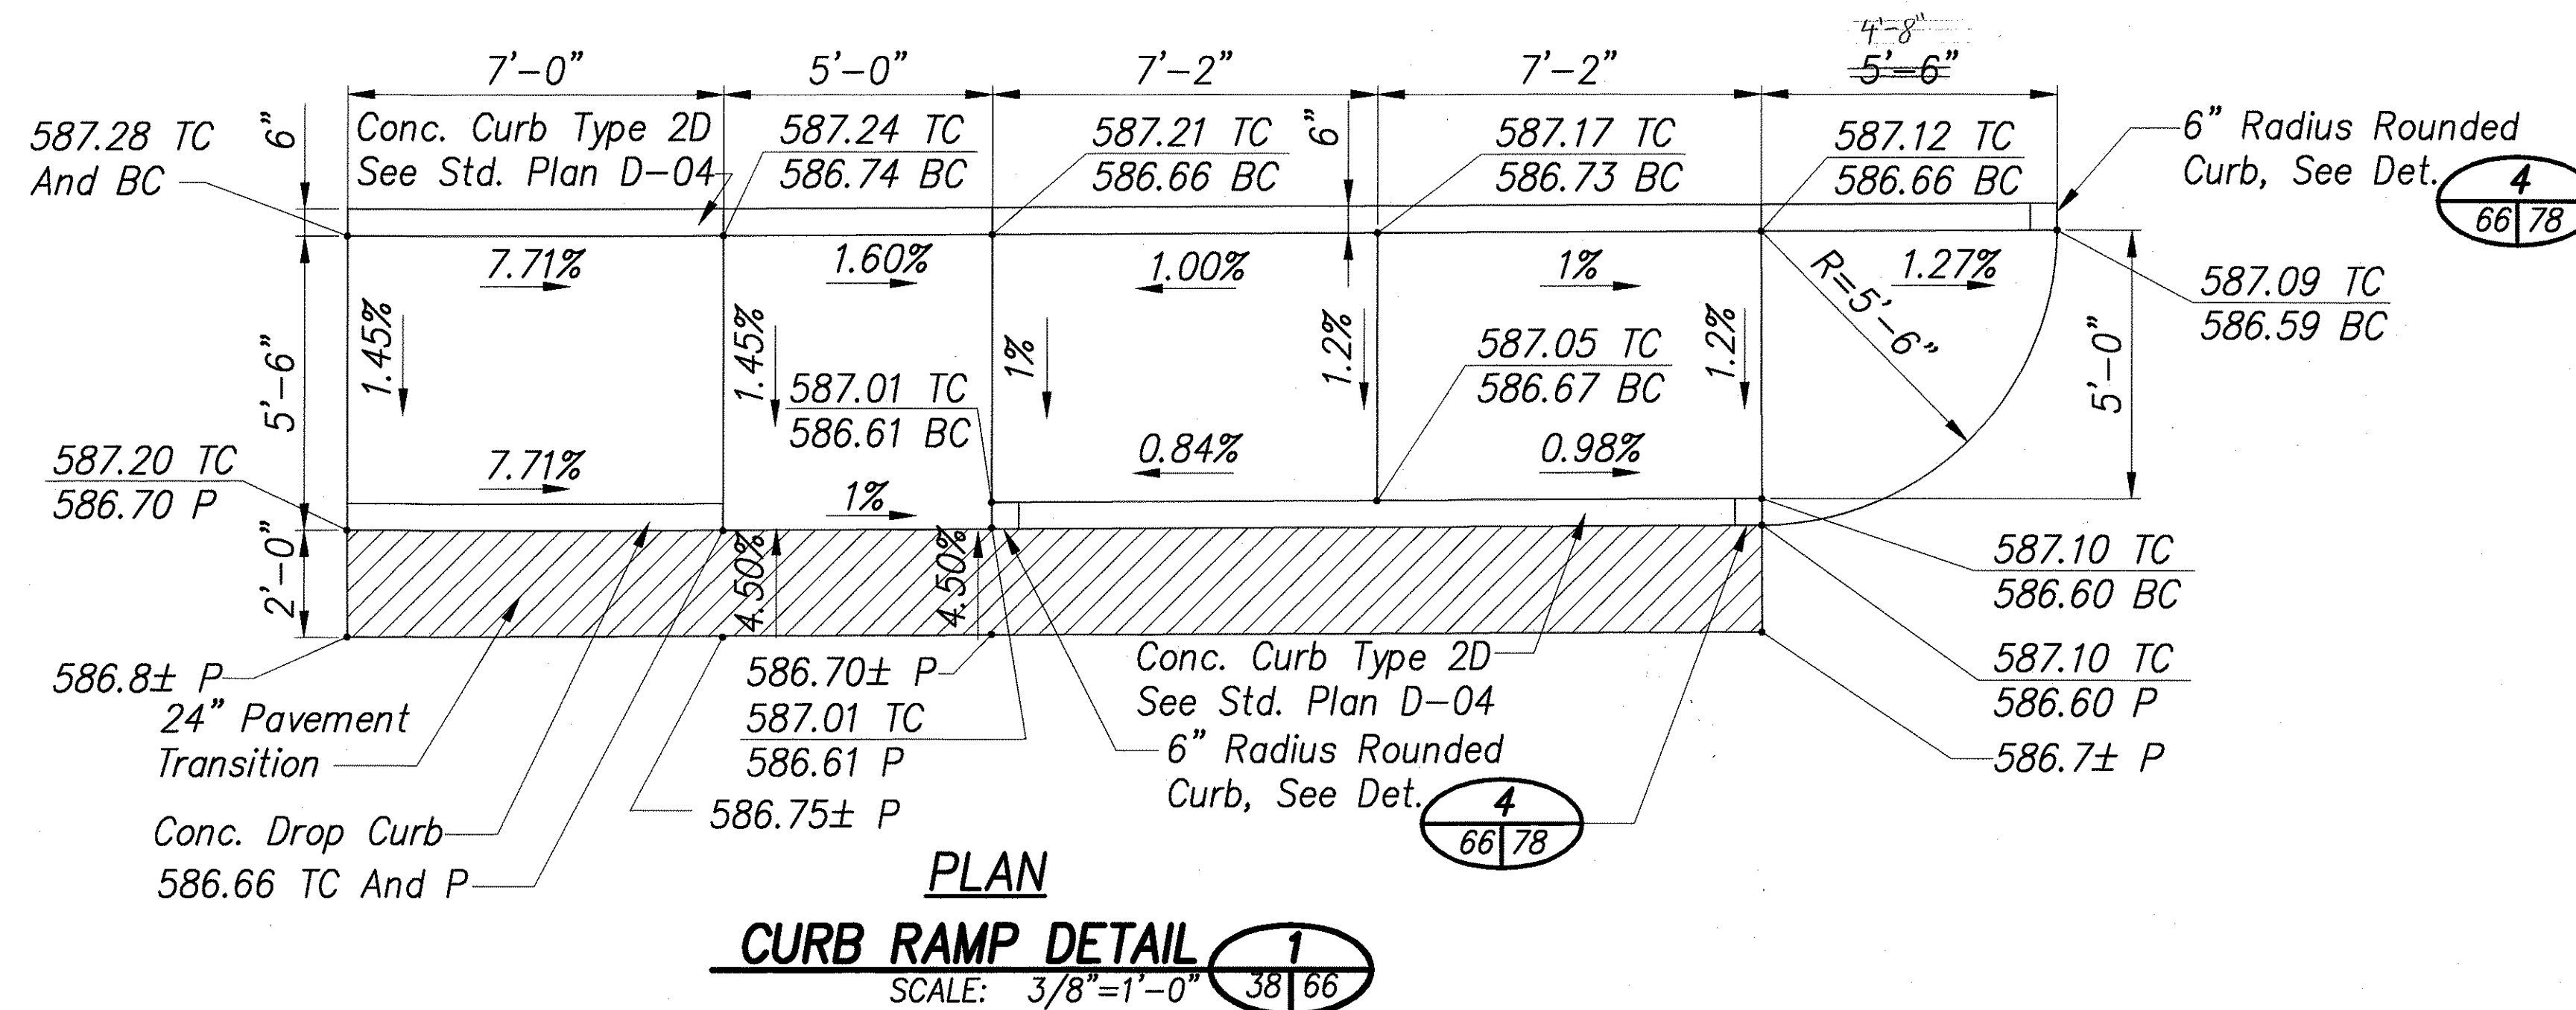

THIS WORK WAS PREPARED BY ME OR UNDER MY SUPERVISION

Cry H. Murakami 04/30/06
SIGNATURE EXPIRATION DATE OF THE LICENSE

"AS-BUILT"

STATE OF HAWAII
DEPARTMENT OF TRANSPORTATION
HIGHWAYS DIVISION

HAWAII - RAMP DETAILS-3





PEDESTRIAN ACCESSIBILITY ROUTE
IMPROVEMENTS - HONOKAA, HAWAII, AND KAPAAU
Federal Aid Project No. CMAQ-0100(62)
Scale: AS NOTED Date: SEPT. 2004

SHEET No. 66 OF 86 SHEETS

ORIGINAL PLAN	DATE	9/2004
NOTE BOOK	DRAWN BY	DL
	DESIGNED BY	CM
	QUANTITIES BY	TC
	CHECKED BY	RS


I:\2000\2000_070.000 PROJECT POINT - PEDESTRIAN ACCESSIBILITY\G-DT0013 HAWAII RAMP DETAILS 66.DWG 05/15/02 20:01 MTM

FED. ROAD DIST. NO.	STATE	FED. AID PROJ. NO.	FISCAL YEAR	SHEET NO.	TOTAL SHEETS
HAWAII	HAW.	CMAQ-0100(62)	2004	67	86

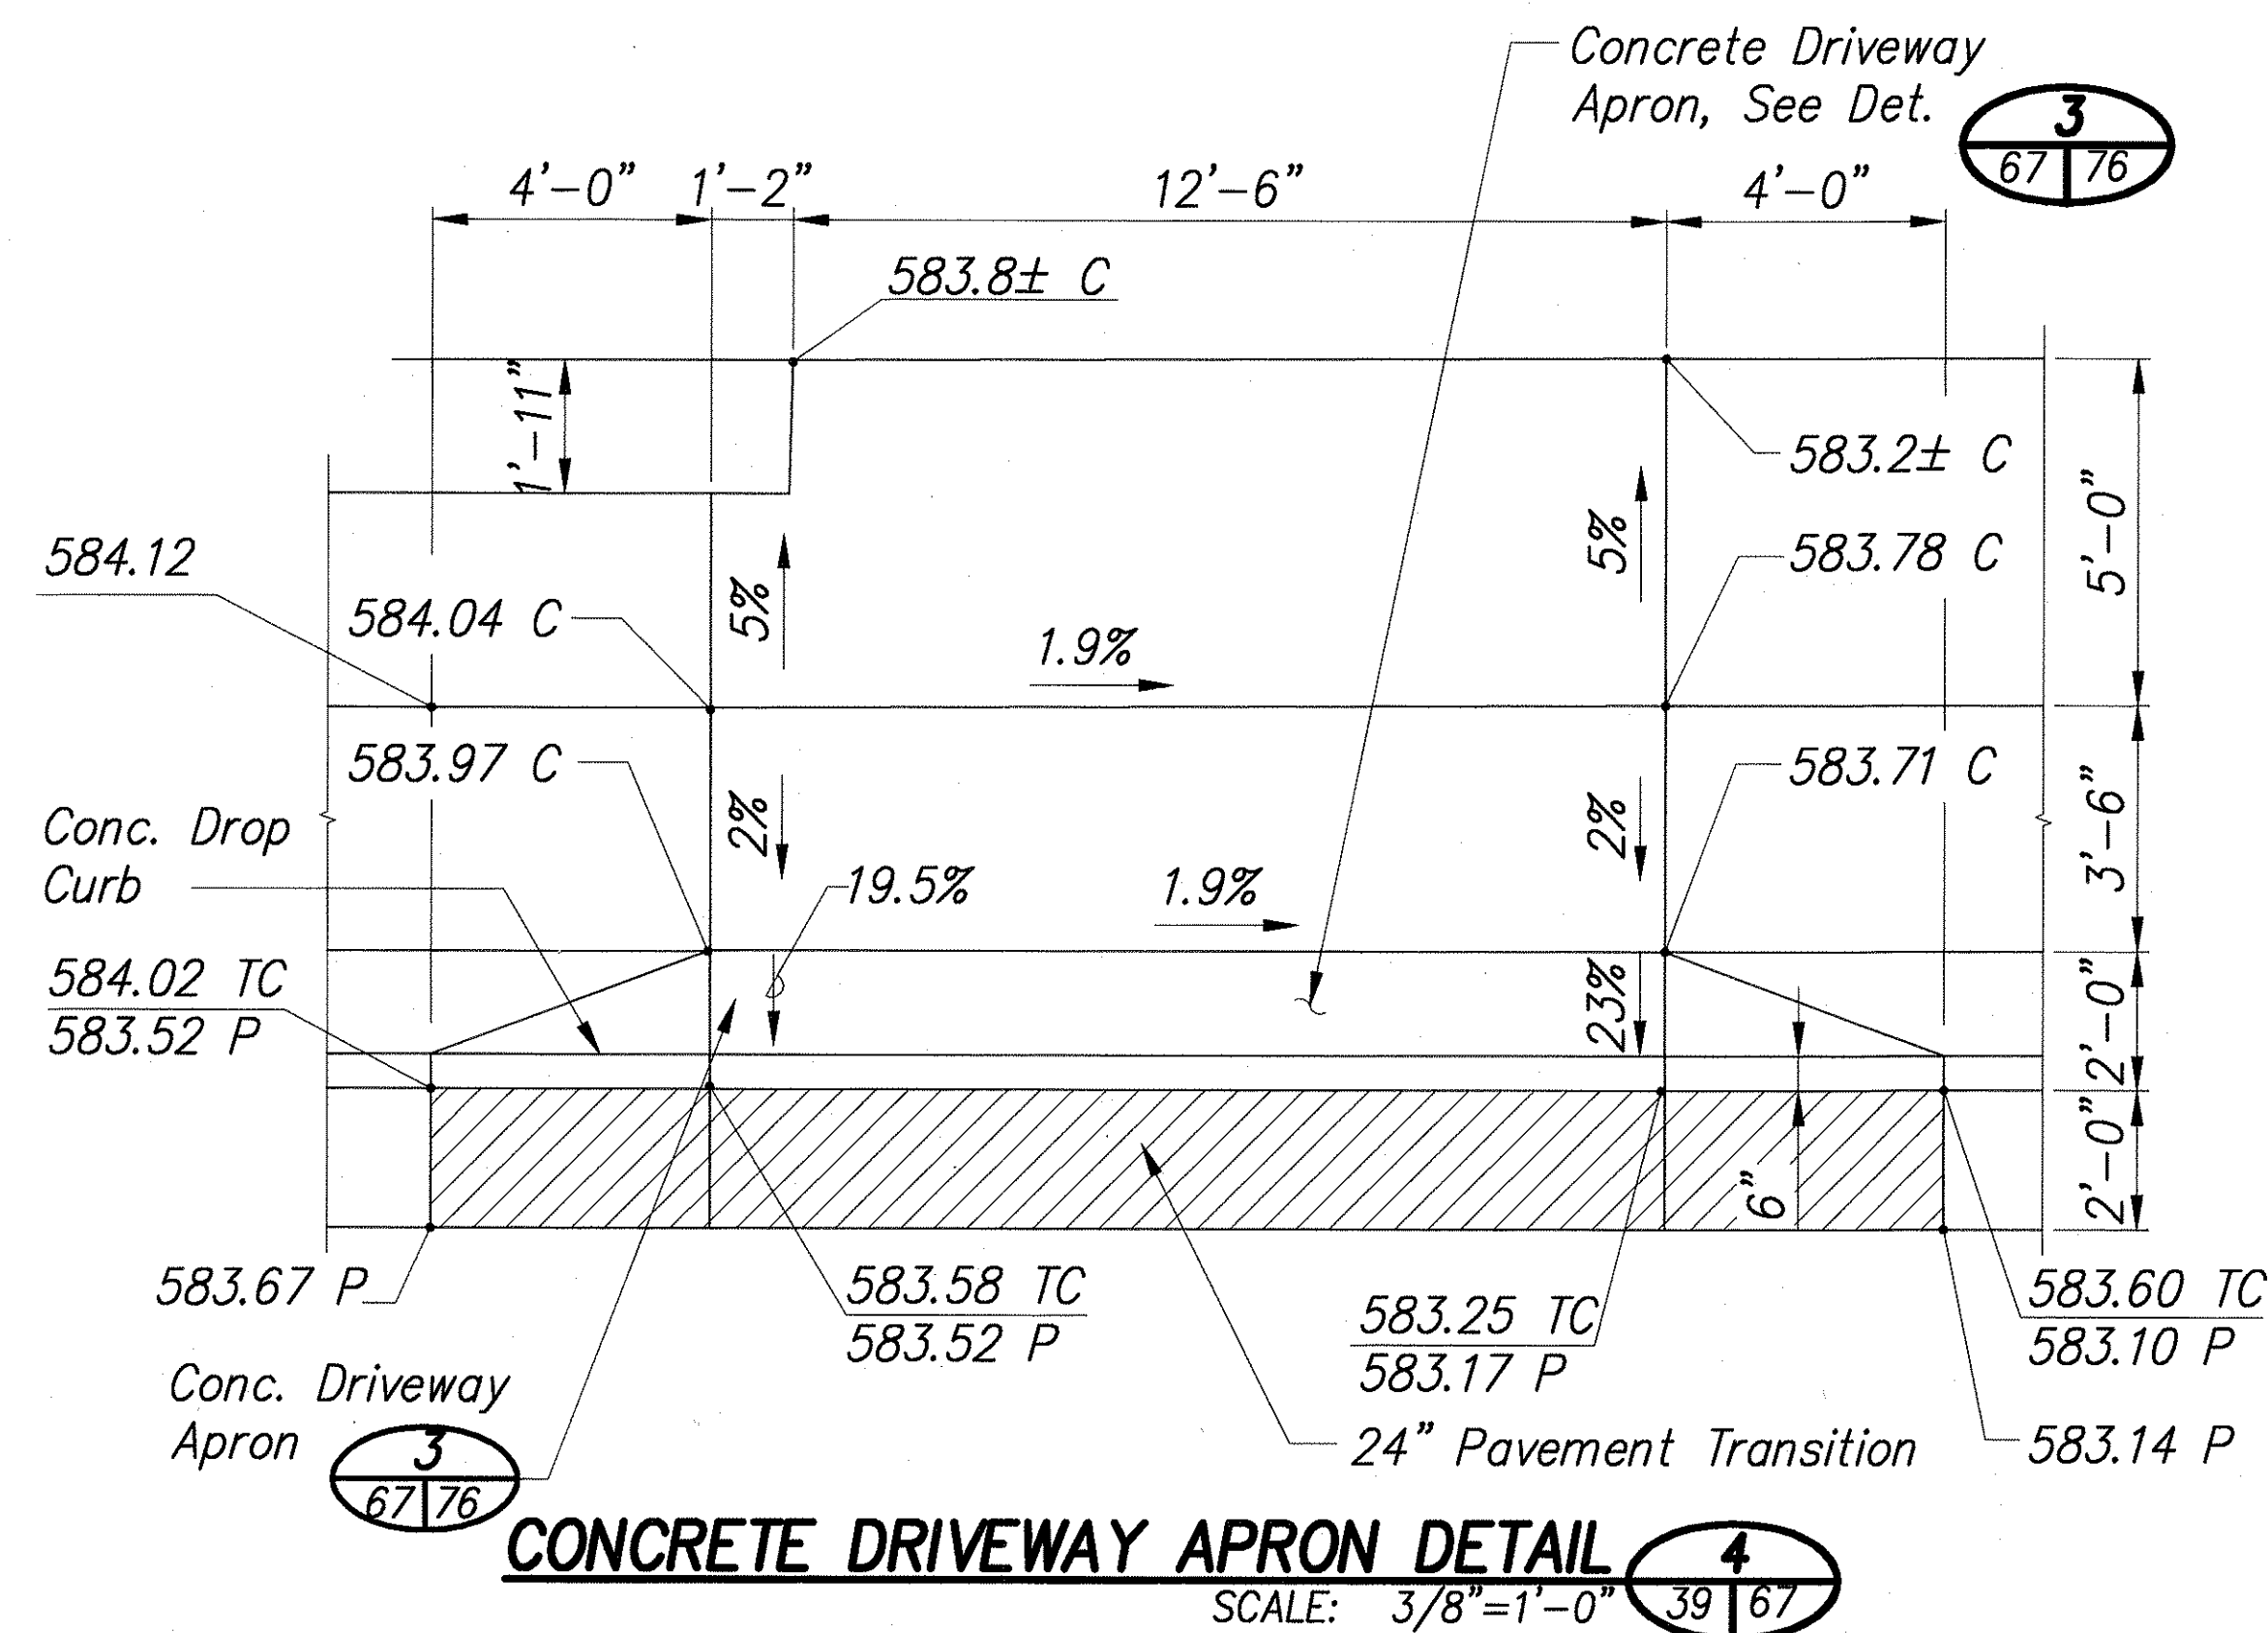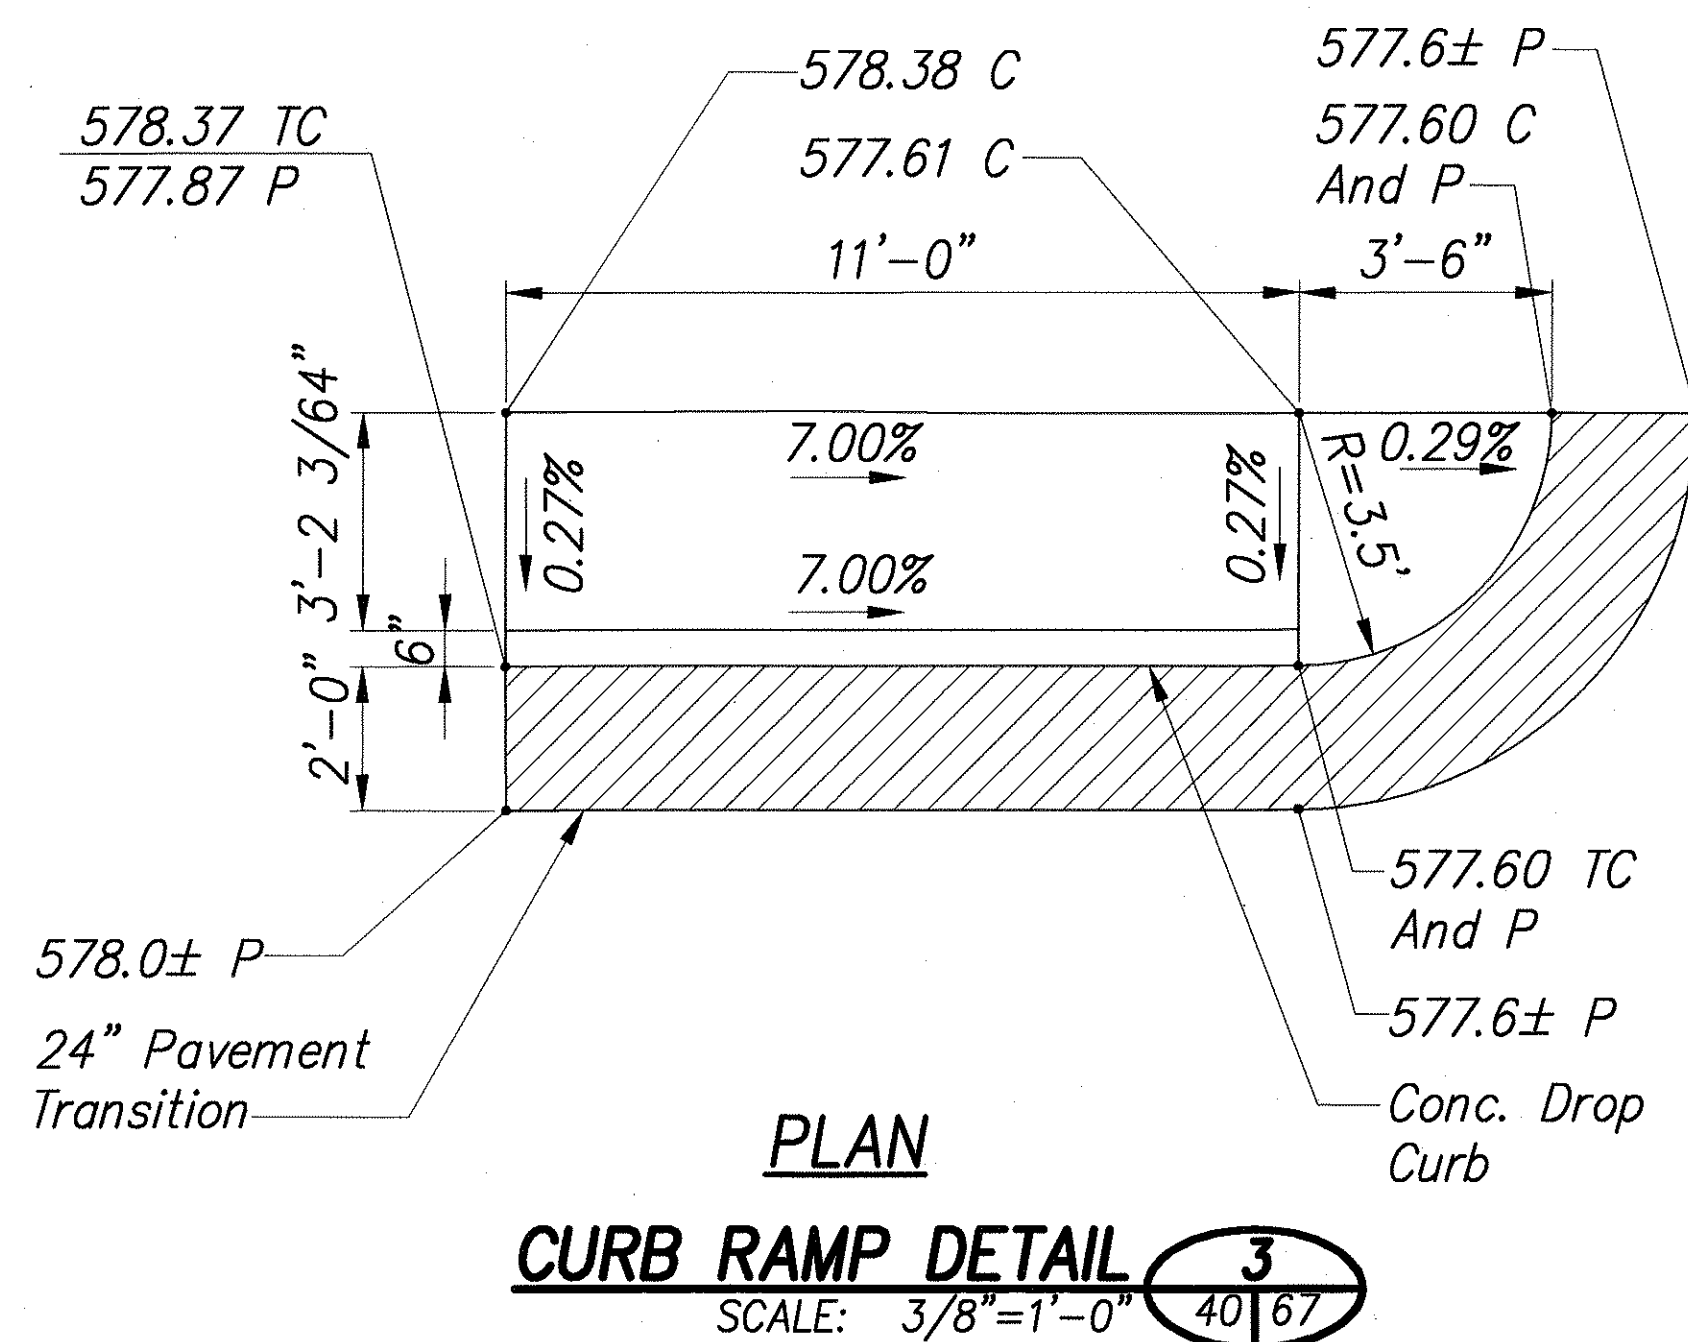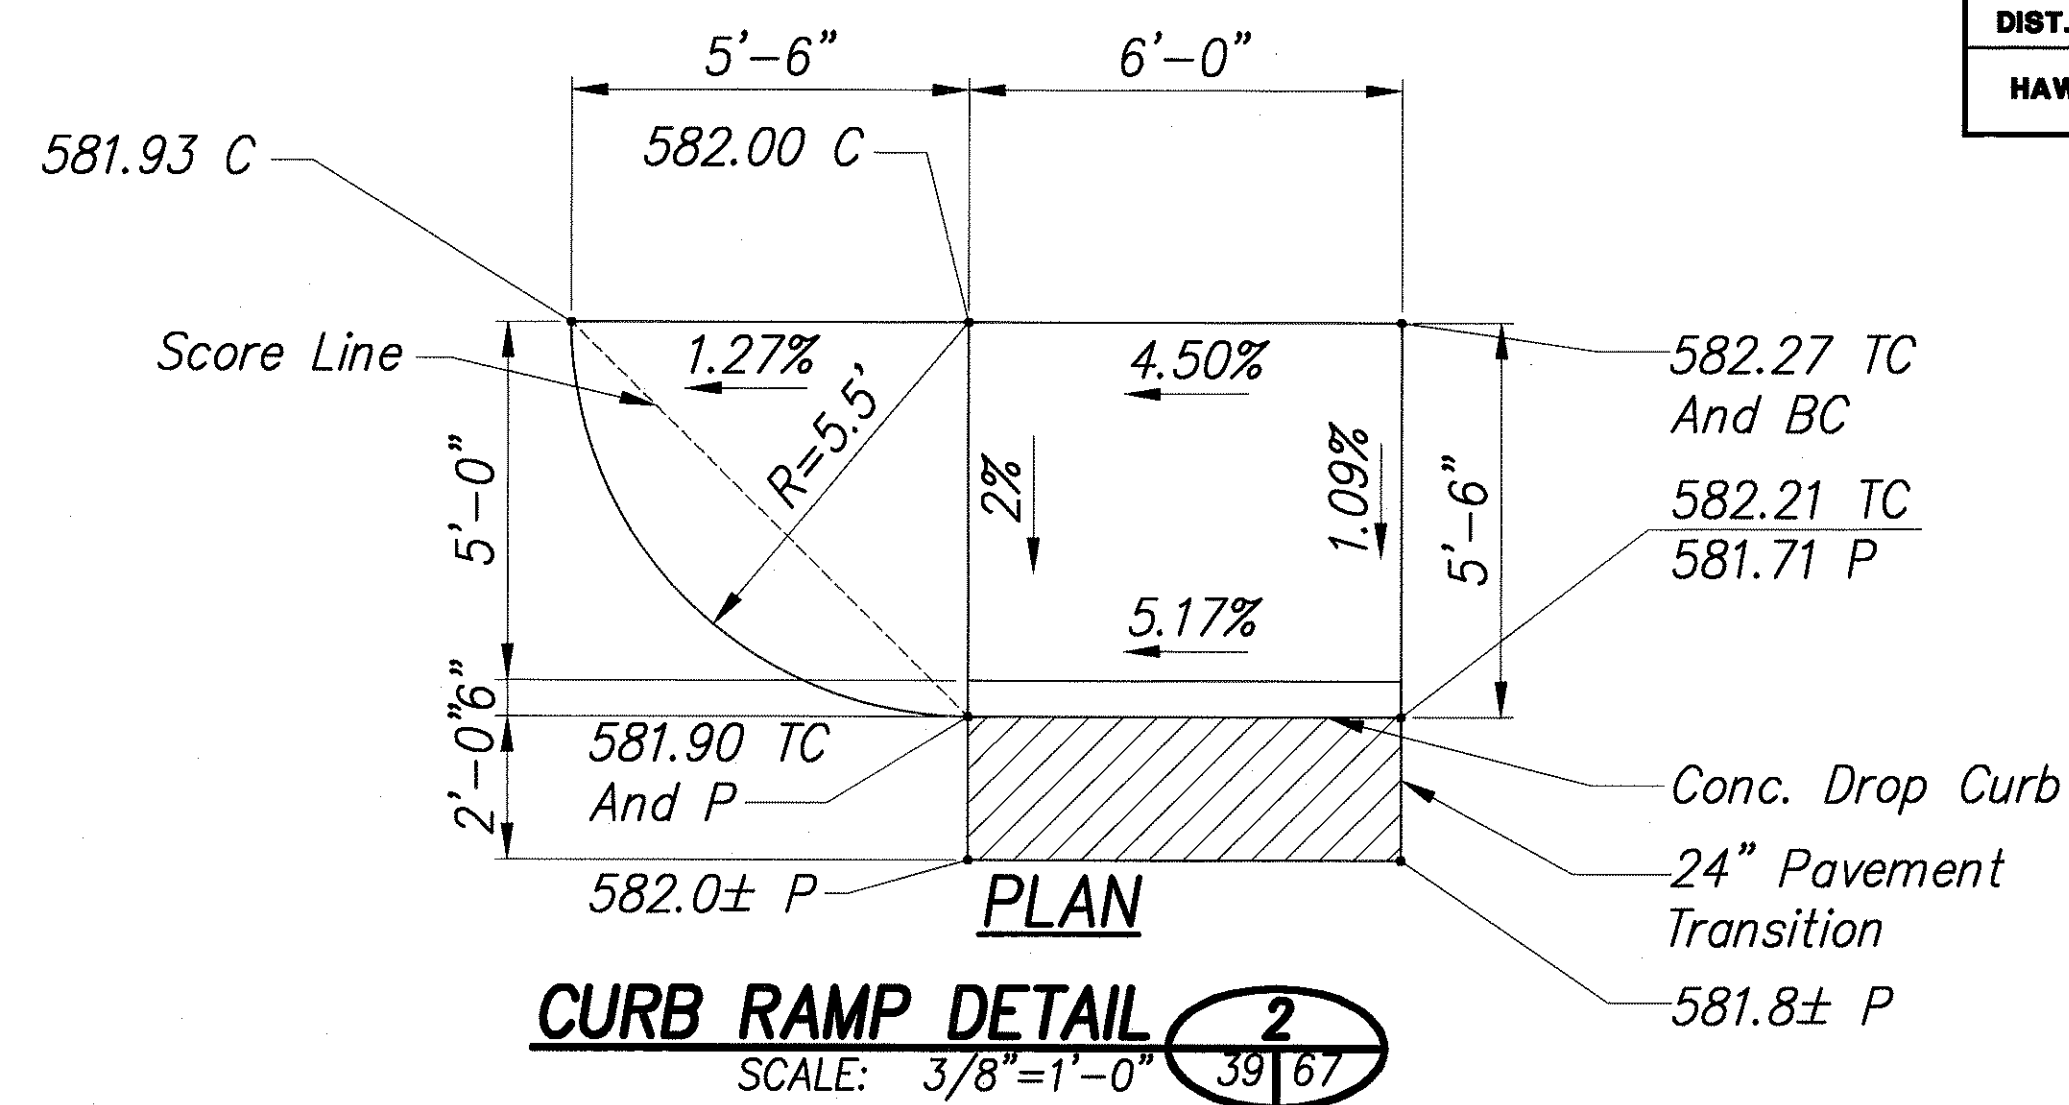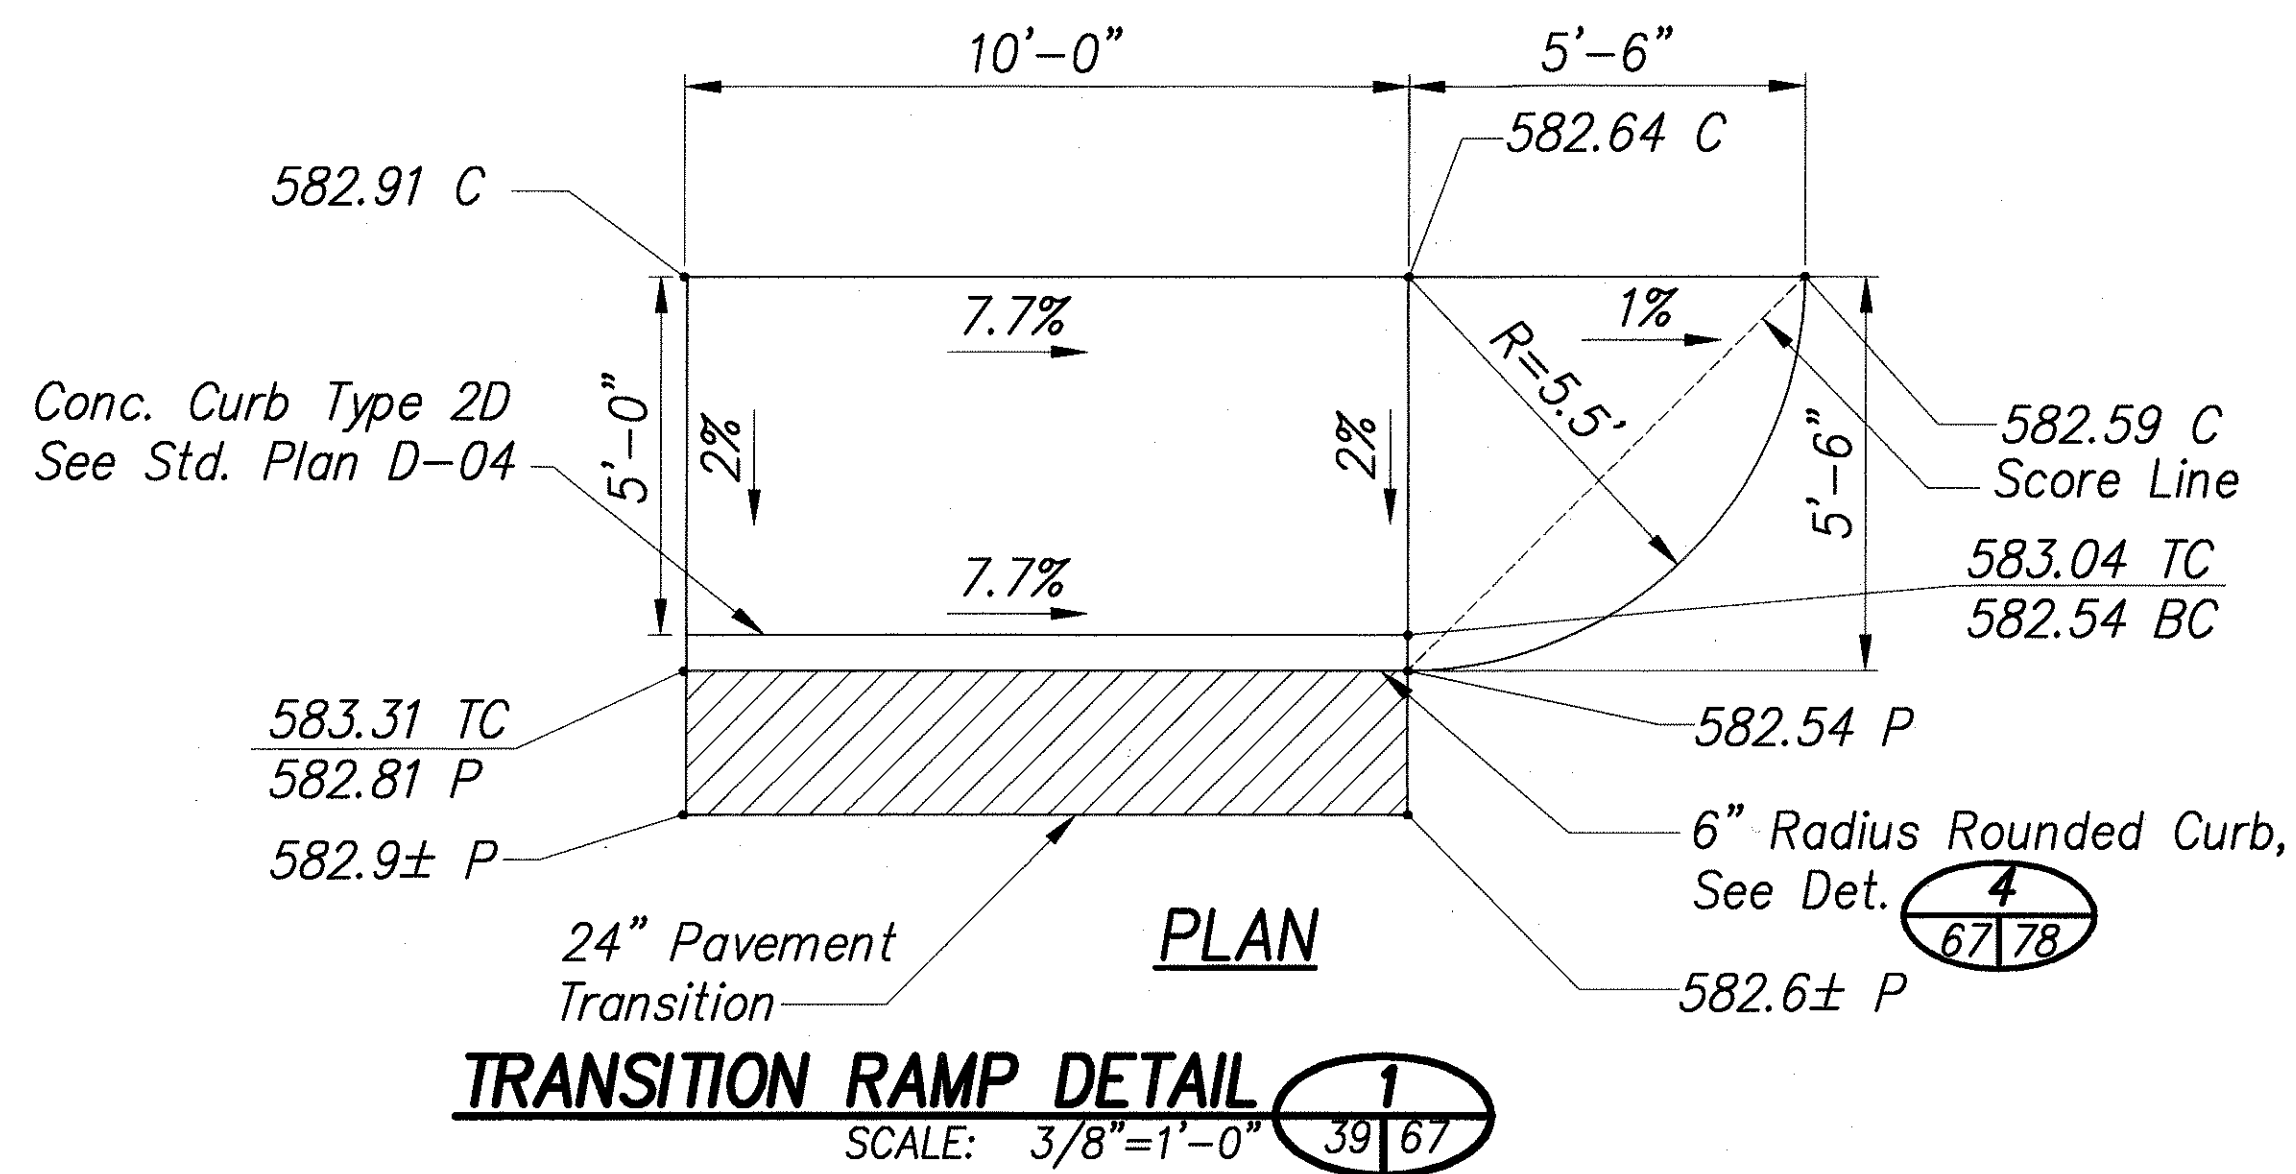


ORIGINAL PLAN	DATE
DRAWN BY	9/2004
TRACED BY	9/2004
DESIGNED BY	9/2004
CHECKED BY	9/2004
ES	9/2004

I:\2000\2000_070.000 PROJECT POINT - PEDESTRIAN ACCESSIBILITY\DRAWINGS DETAILS\C-010014 HAWI RAMP DETAILS 67.DWG 05/15/02 20:04 MTM

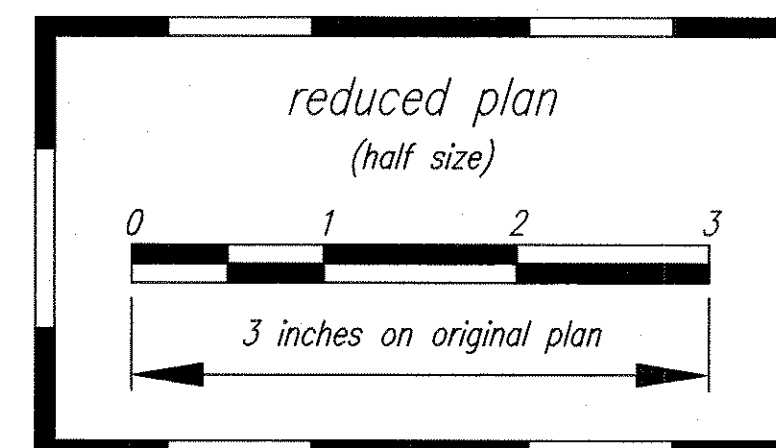

THIS WORK WAS PREPARED BY ME OR UNDER MY SUPERVISION

Cey H. Murakami 04/30/06
SIGNATURE EXPIRATION DATE OF THE LICENSE

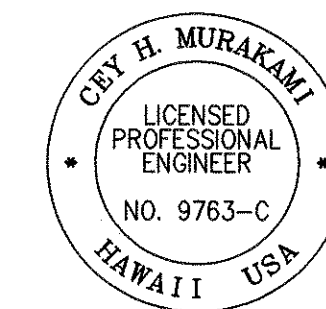

STATE OF HAWAII
DEPARTMENT OF TRANSPORTATION
HIGHWAYS DIVISION

HAWI - RAMP DETAILS-4

PEDESTRIAN ACCESSIBILITY ROUTE
IMPROVEMENTS - HONOKAA, HAWI, AND KAPAAU
Federal Aid Project No. CMAQ-0100(62)
Scale: AS NOTED Date: SEPT. 2004

SHEET No. 67 OF 86 SHEETS