

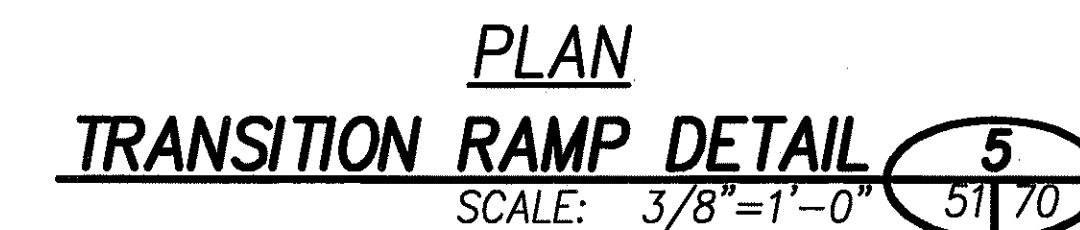
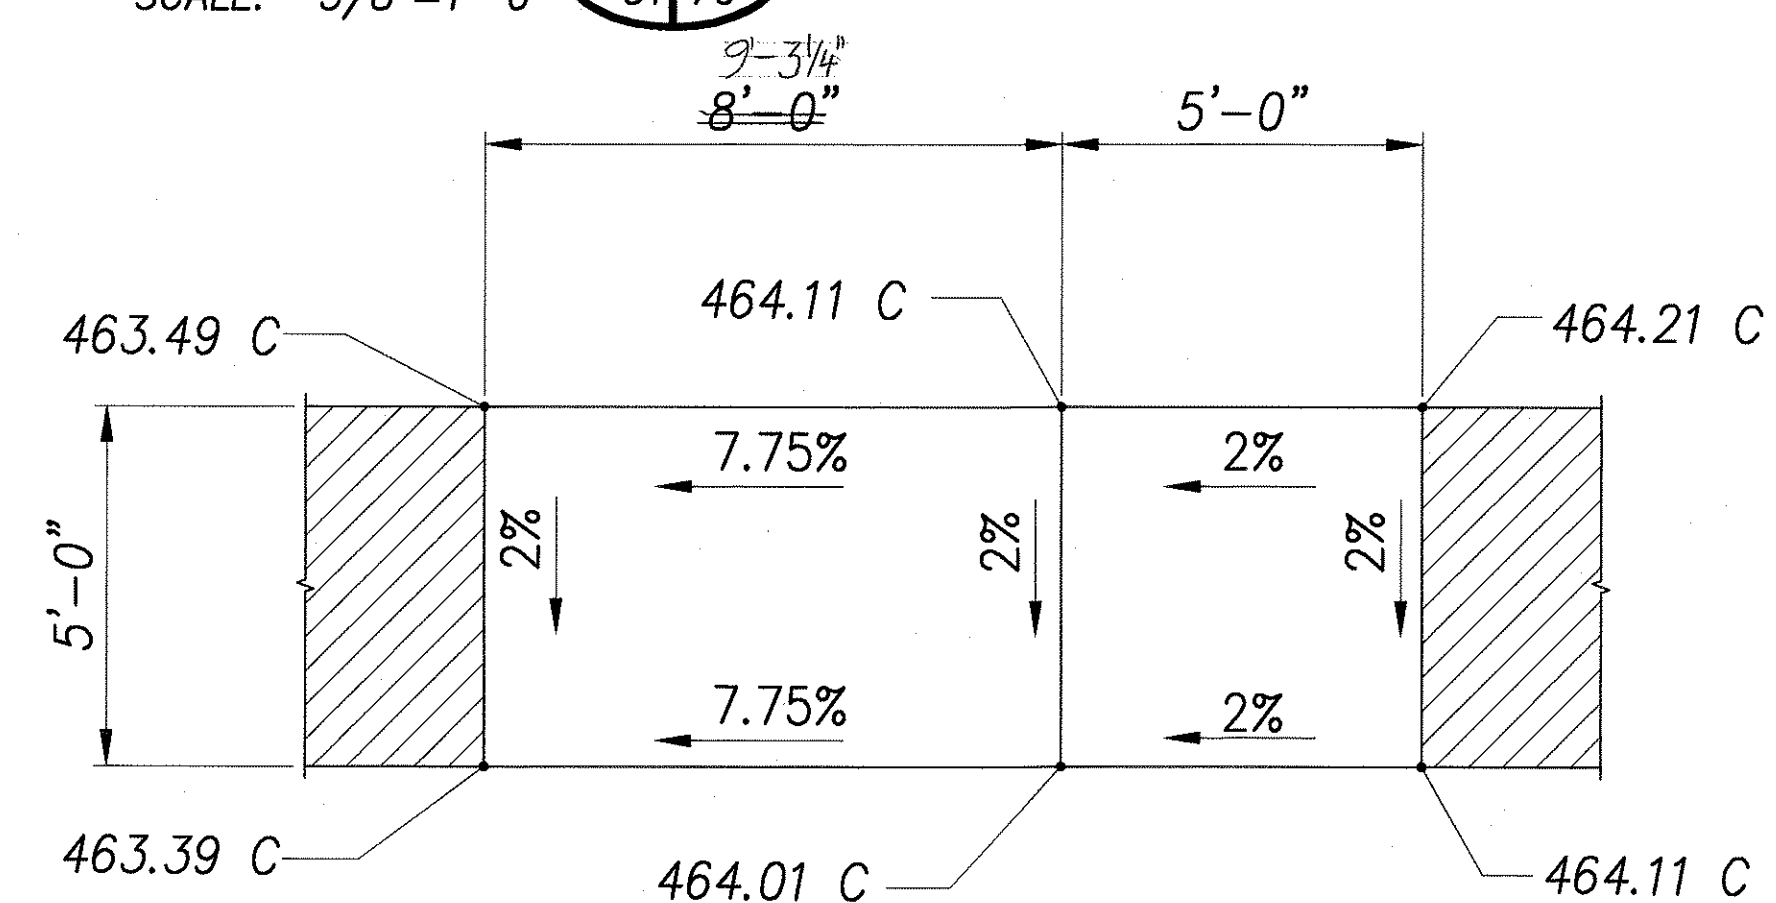
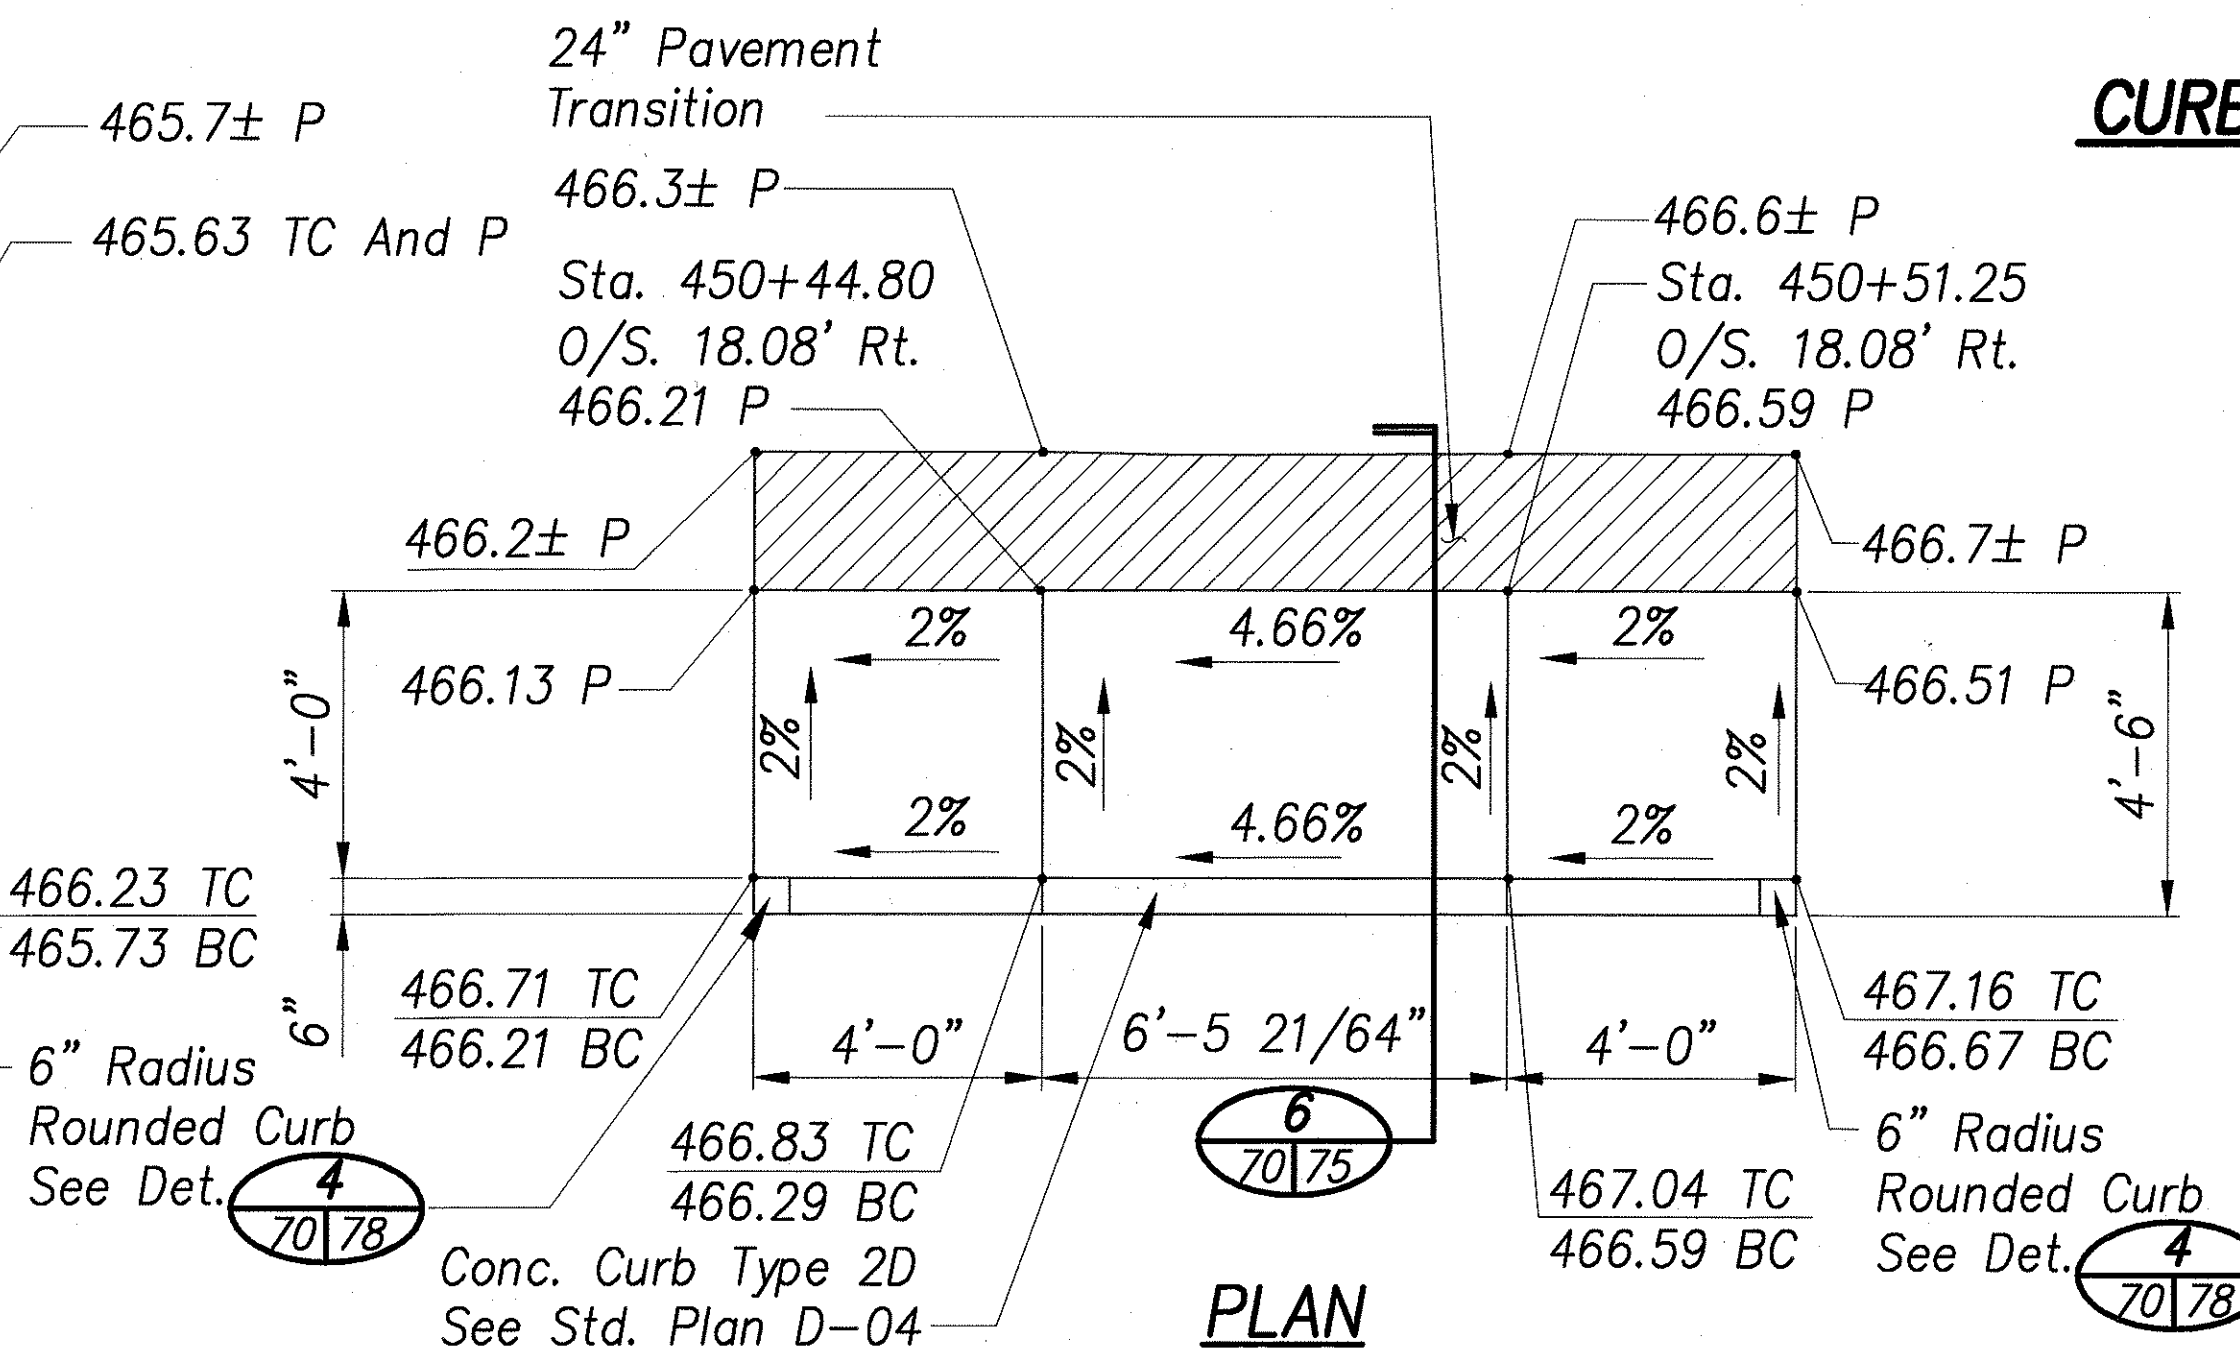
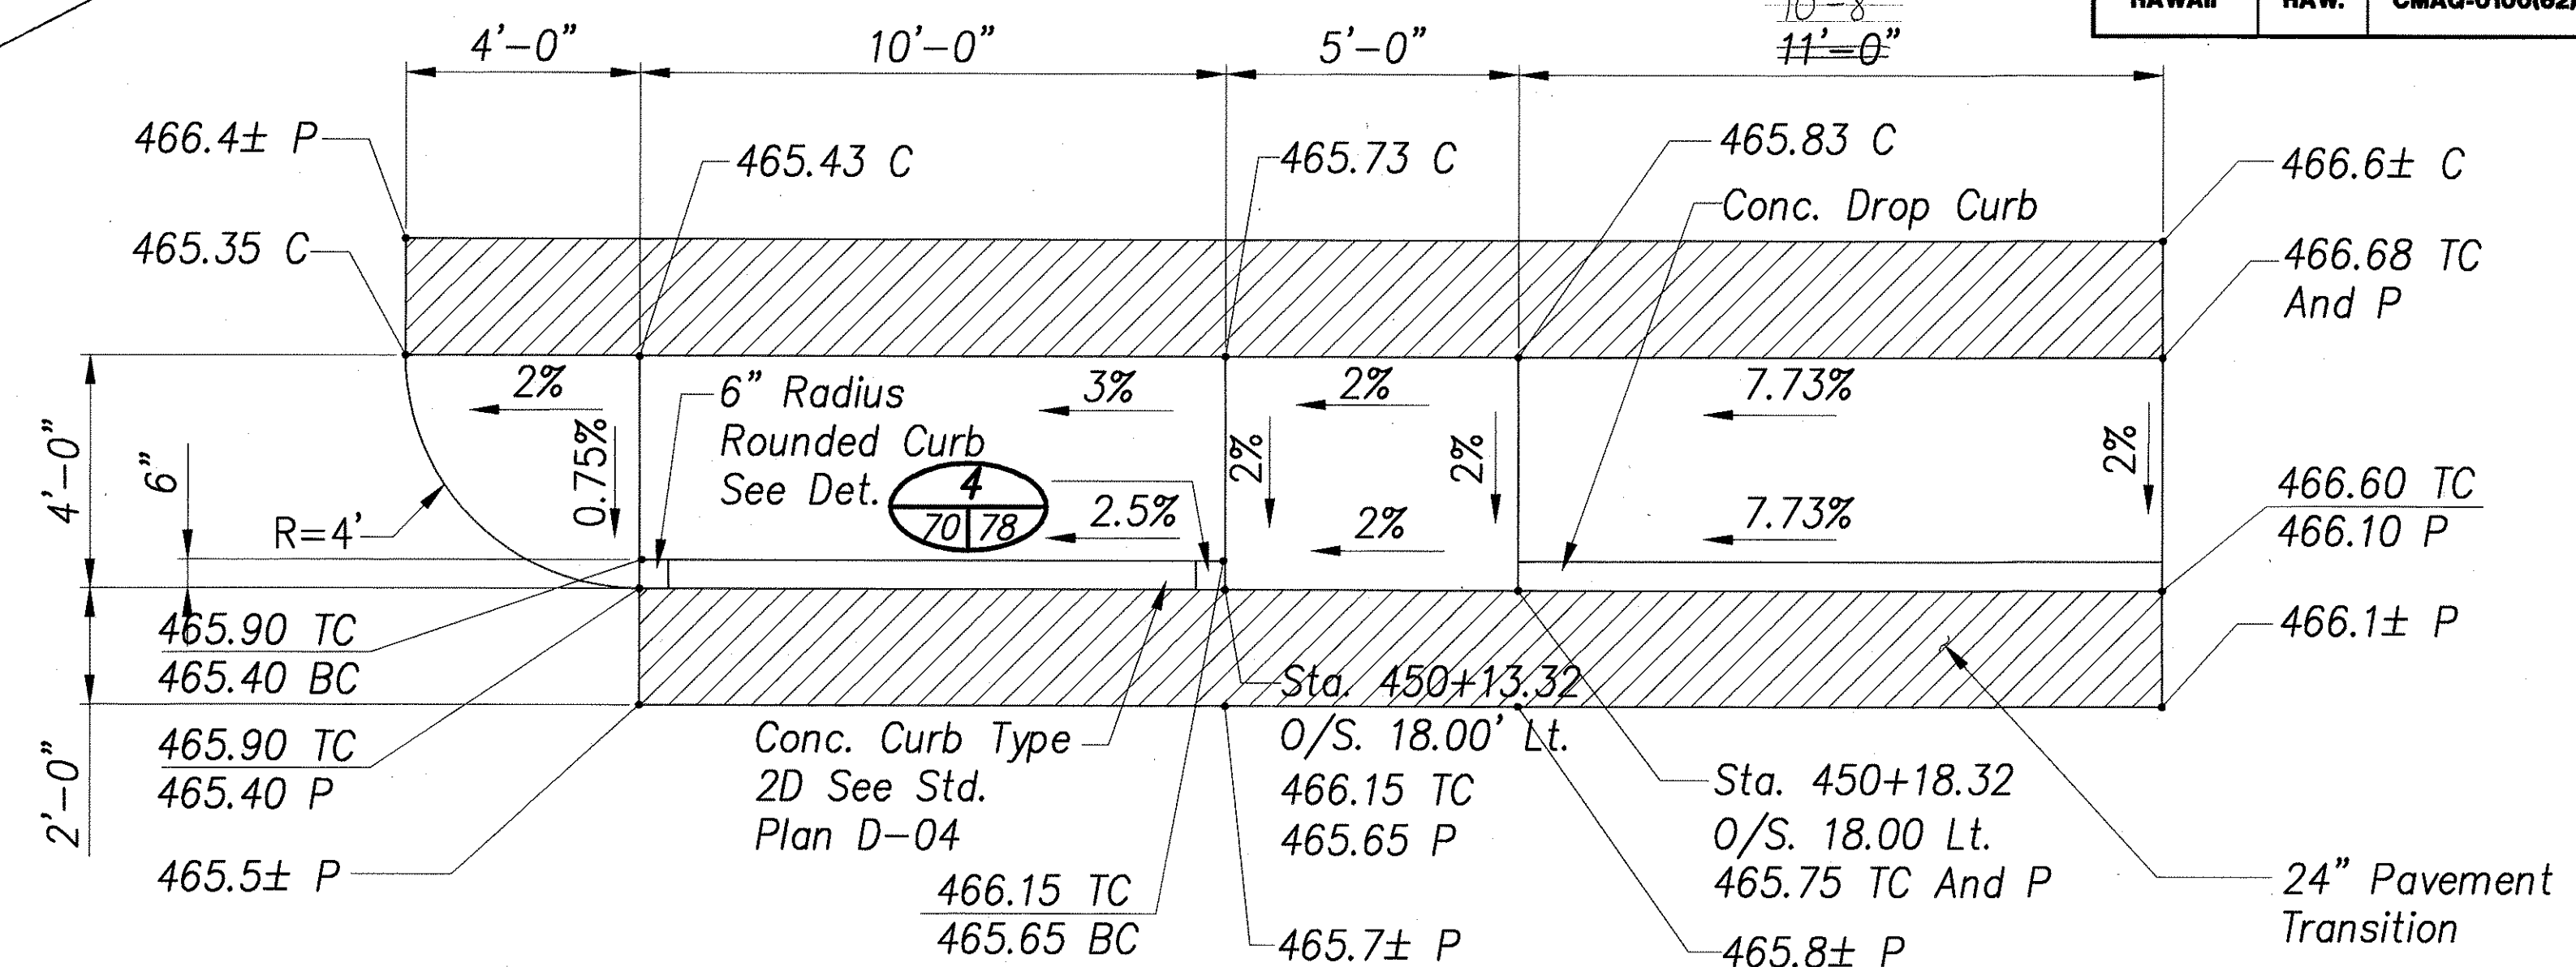
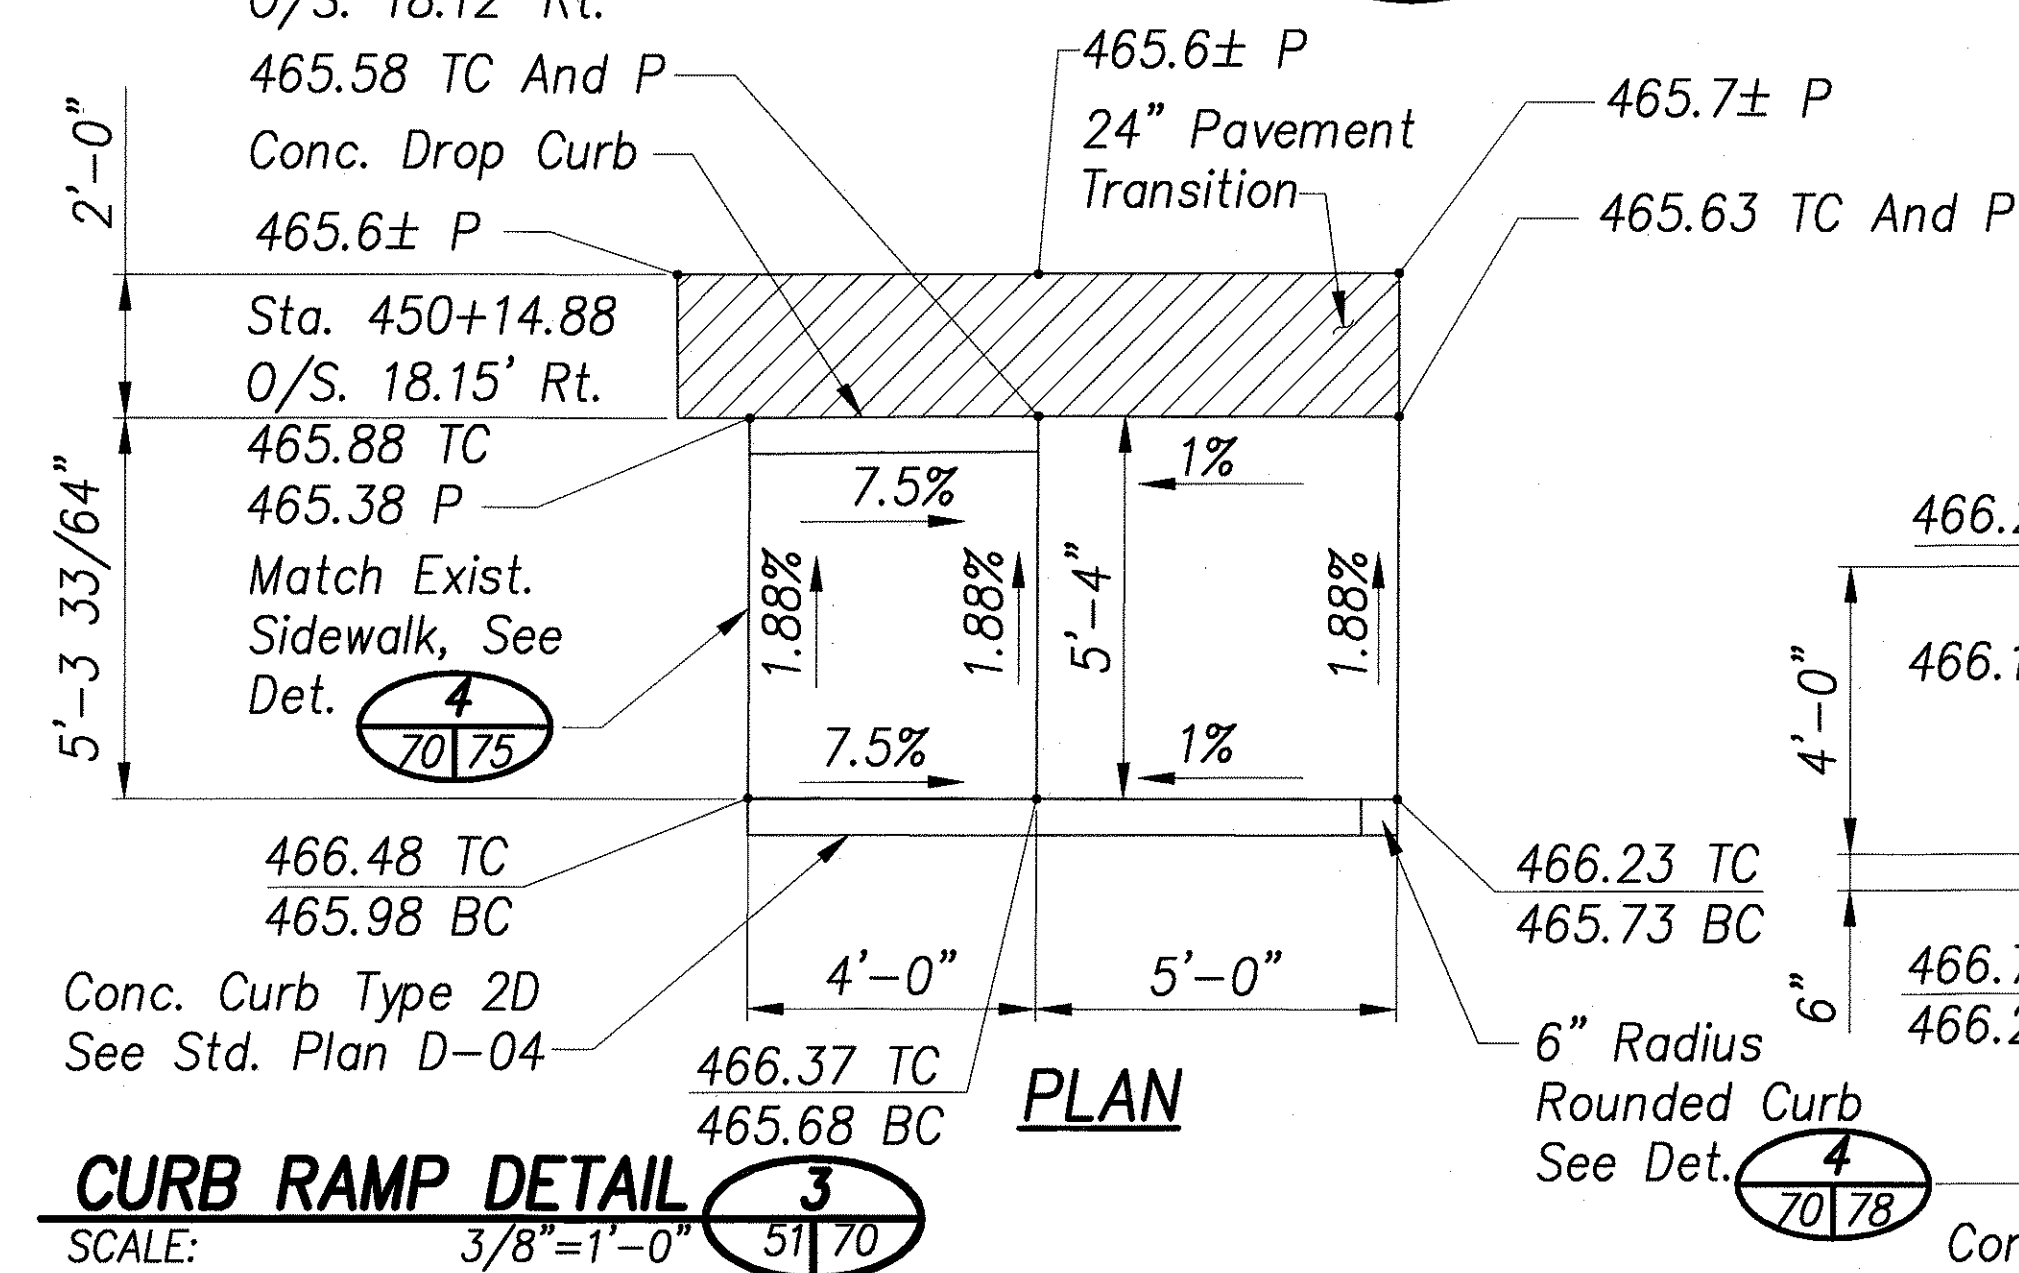


I:\2000\2000\_070.000 PROJECT POINT - PEDESTRIAN ACCESSIBILITY\G DRAWINGS\DETAILS\C-DT0017 KAPAAU RAMP DETAILS 70.DWG 05/15/02 20:22 MTM

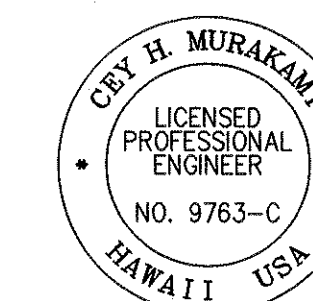

|                  |                                                                                                                                                |                                                |                                                |
|------------------|------------------------------------------------------------------------------------------------------------------------------------------------|------------------------------------------------|------------------------------------------------|
| ORIGINAL<br>PLAN | SURVEY PLOTTED BY                                                                                                                              |                                                | DATE                                           |
|                  | DRAWN BY ..... DL .....<br>TRACED BY ..... DL .....<br>DESIGNED BY ..... CM .....<br>QUANTITIES BY ..... TC .....<br>CHECKED BY ..... ES ..... | 9/2004<br>9/2004<br>9/2004<br>9/2004<br>9/2004 | 9/2004<br>9/2004<br>9/2004<br>9/2004<br>9/2004 |
| No. ....         |                                                                                                                                                |                                                |                                                |

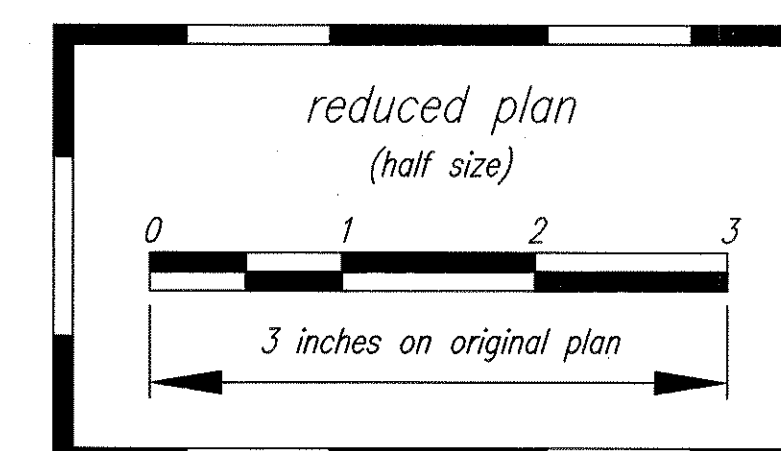

*Cey H Mungjai* 04/30/06  
SIGNATURE EXPIRATION DATE  
OF THE LICENSE

STATE OF HAWAII  
DEPARTMENT OF TRANSPORTATION  
HIGHWAYS DIVISION

KAPAAU - RAMP DETAILS-3

PEDESTRIAN ACCESSIBILITY ROUTE  
IMPROVEMENTS - HONOKAA, HAWI, AND KAPAAU  
Federal Aid Project No. CMAQ-0100(62)

Scale: AS NOTED Date: SEPT. 2004

**SHEET No. 70 OF 86 SHEETS**