




FED. ROAD DIST. NO.	STATE	FED. AID PROJ. NO.	FISCAL YEAR	SHEET NO.	TOTAL SHEETS
HAWAII	HAW.	CMAQ-0100(62)	2004	71	86

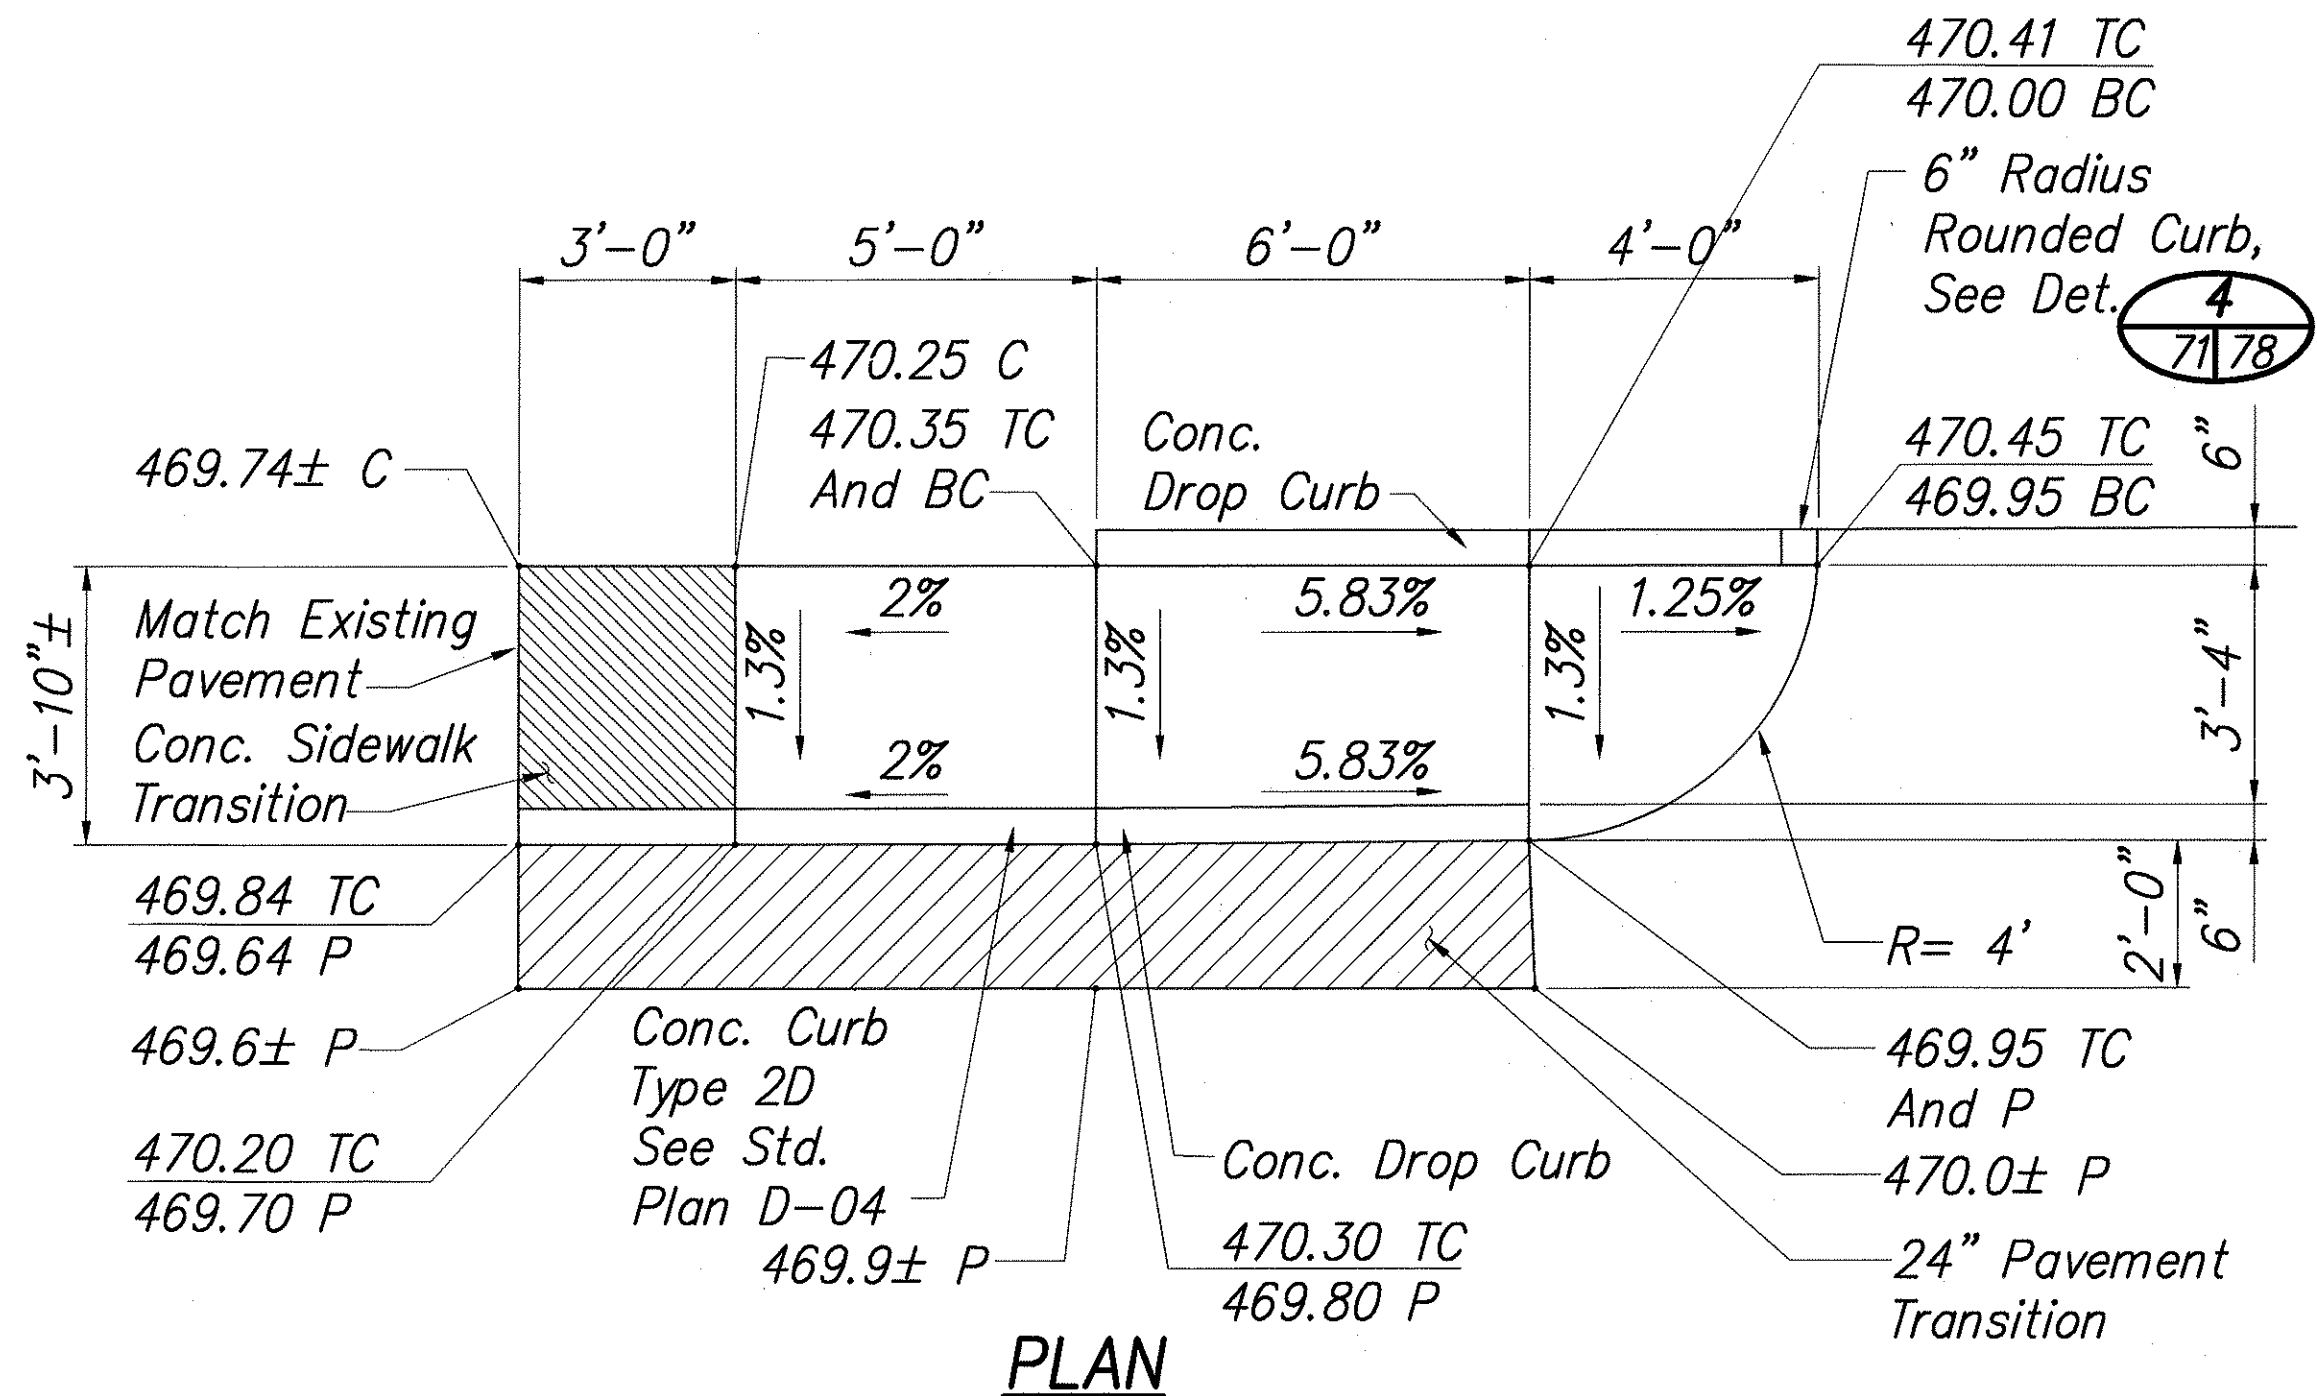


CURB RAMP DETAIL 1
SCALE: 3/8"=1'-0" 52/71

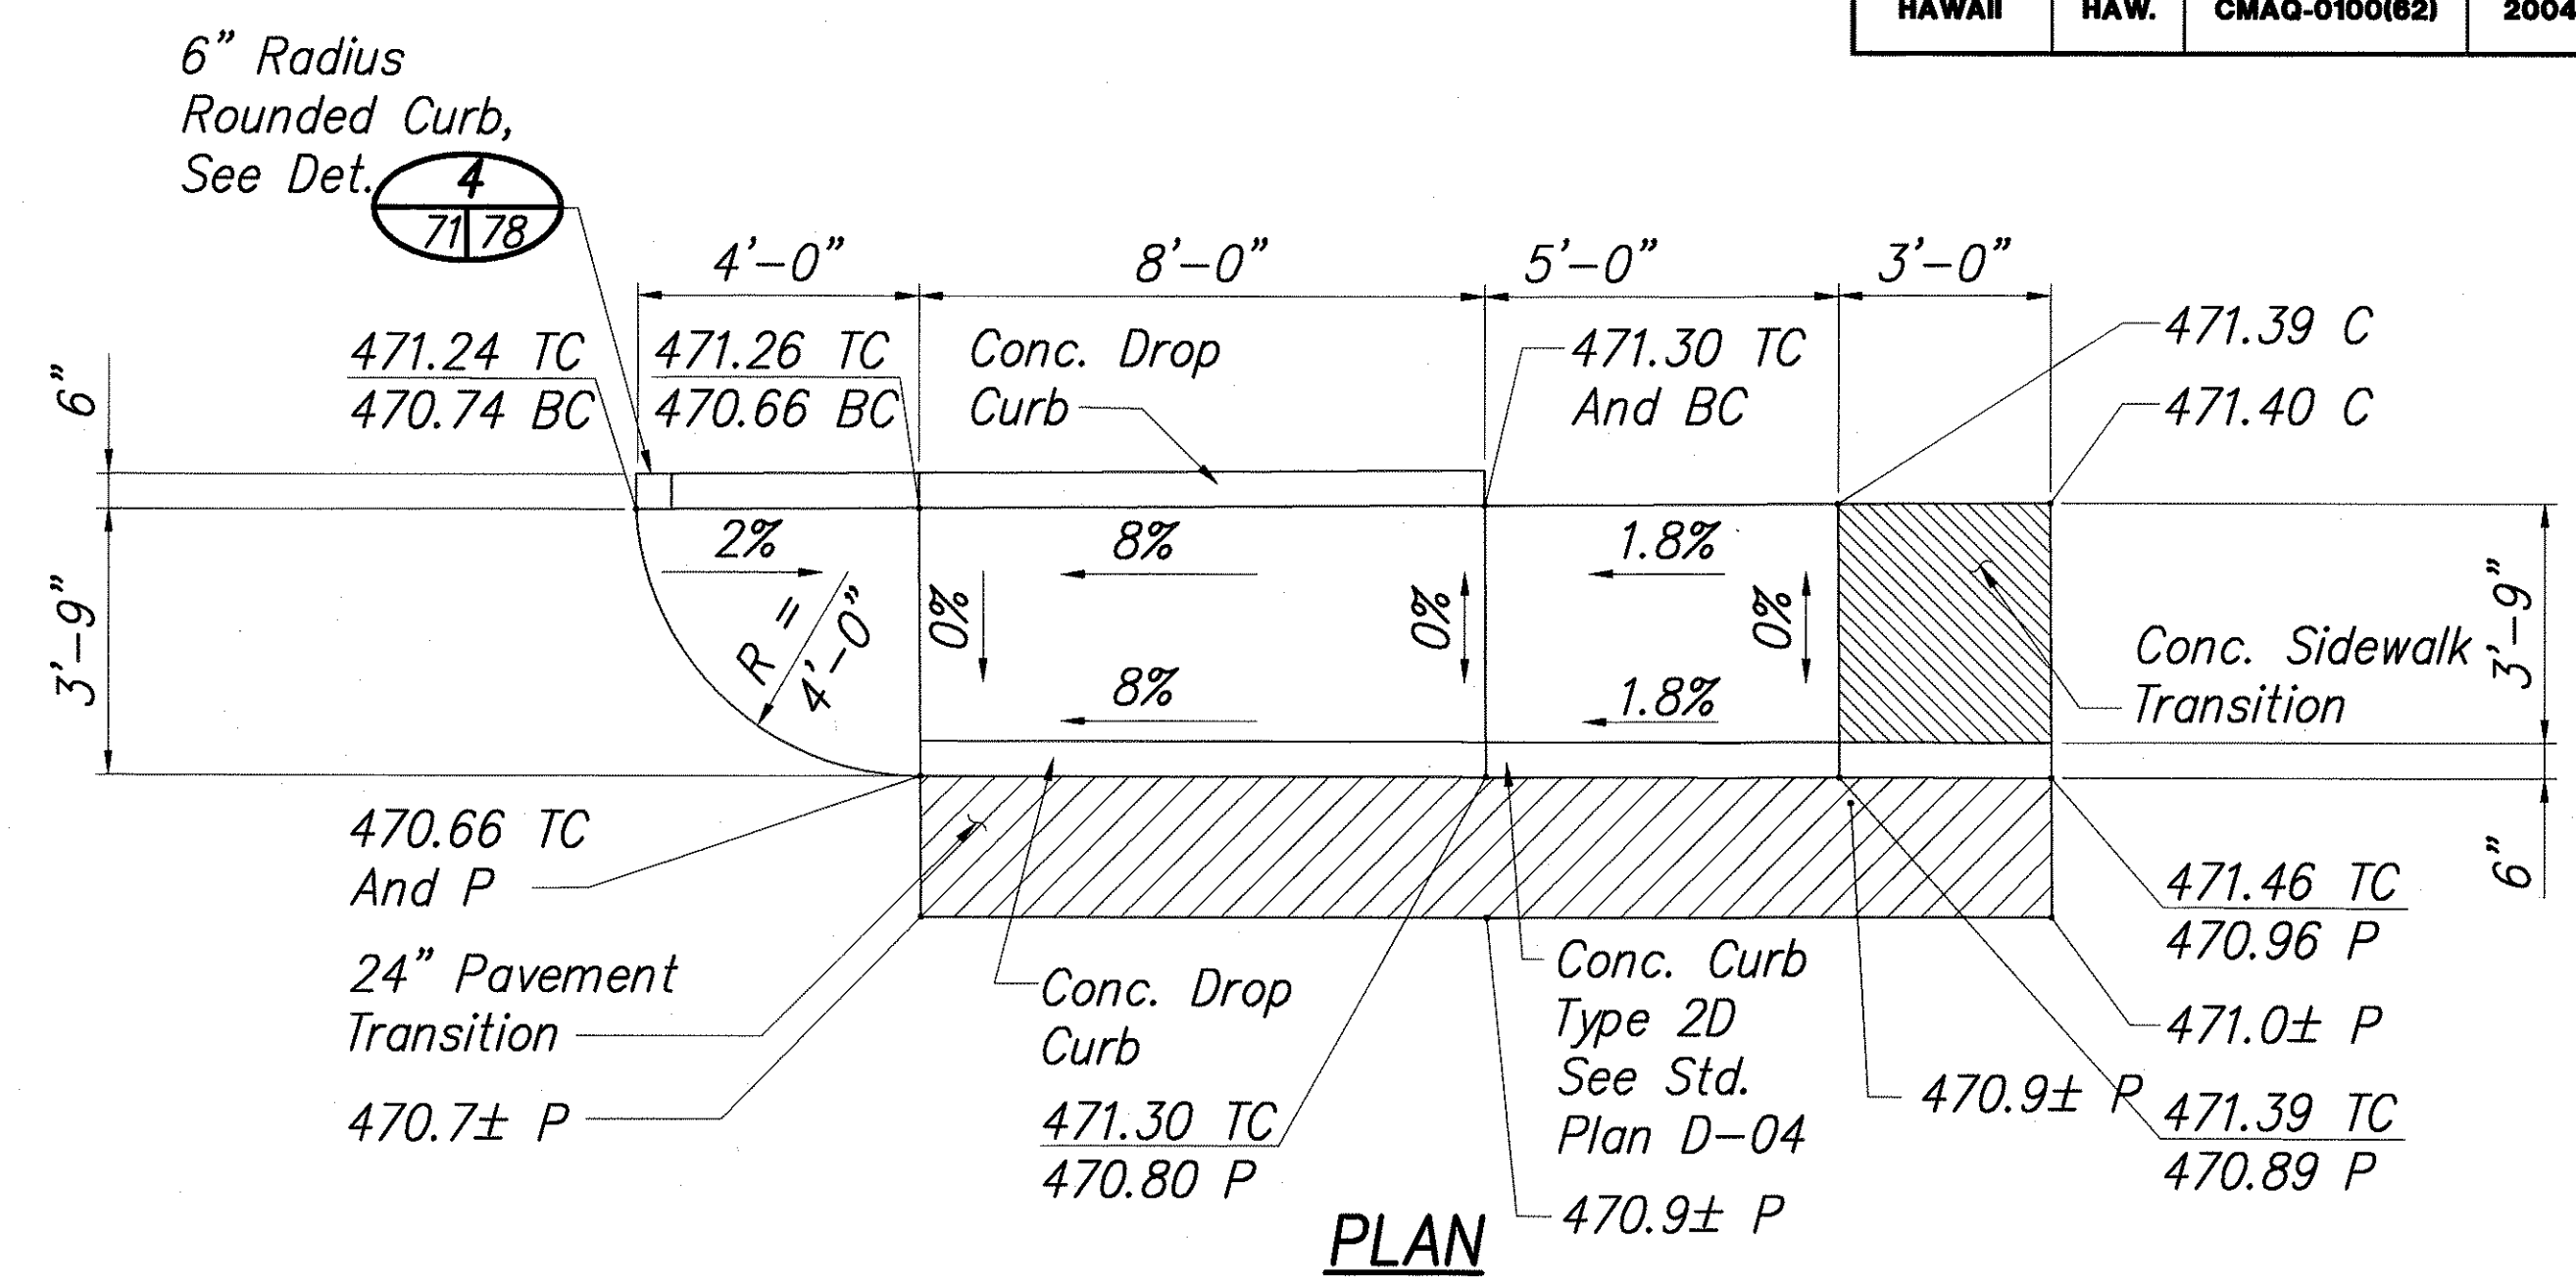


CURB RAMP DETAIL 2
SCALE: 3/8"=1'-0" 52/71

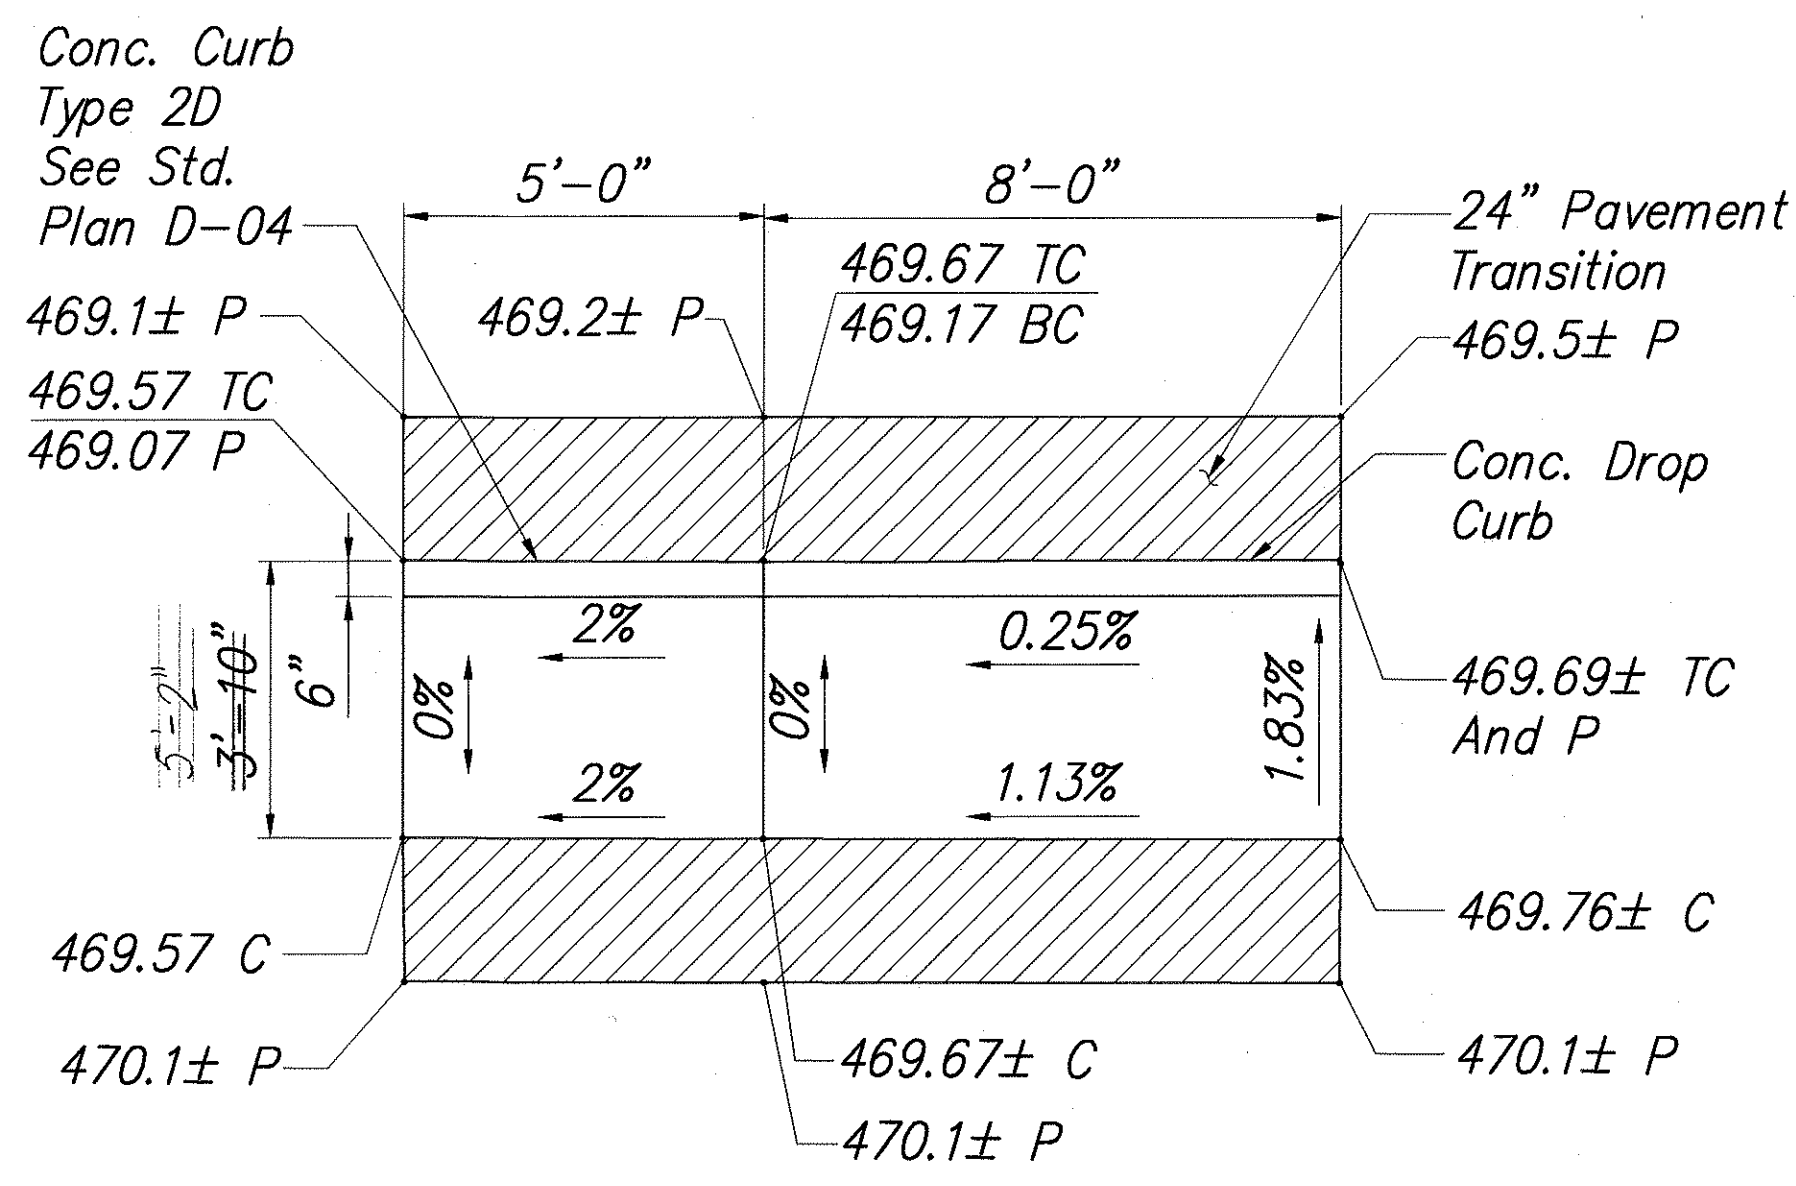



CURB RAMP DETAIL 3
SCALE: 3/8"=1'-0" 52/71

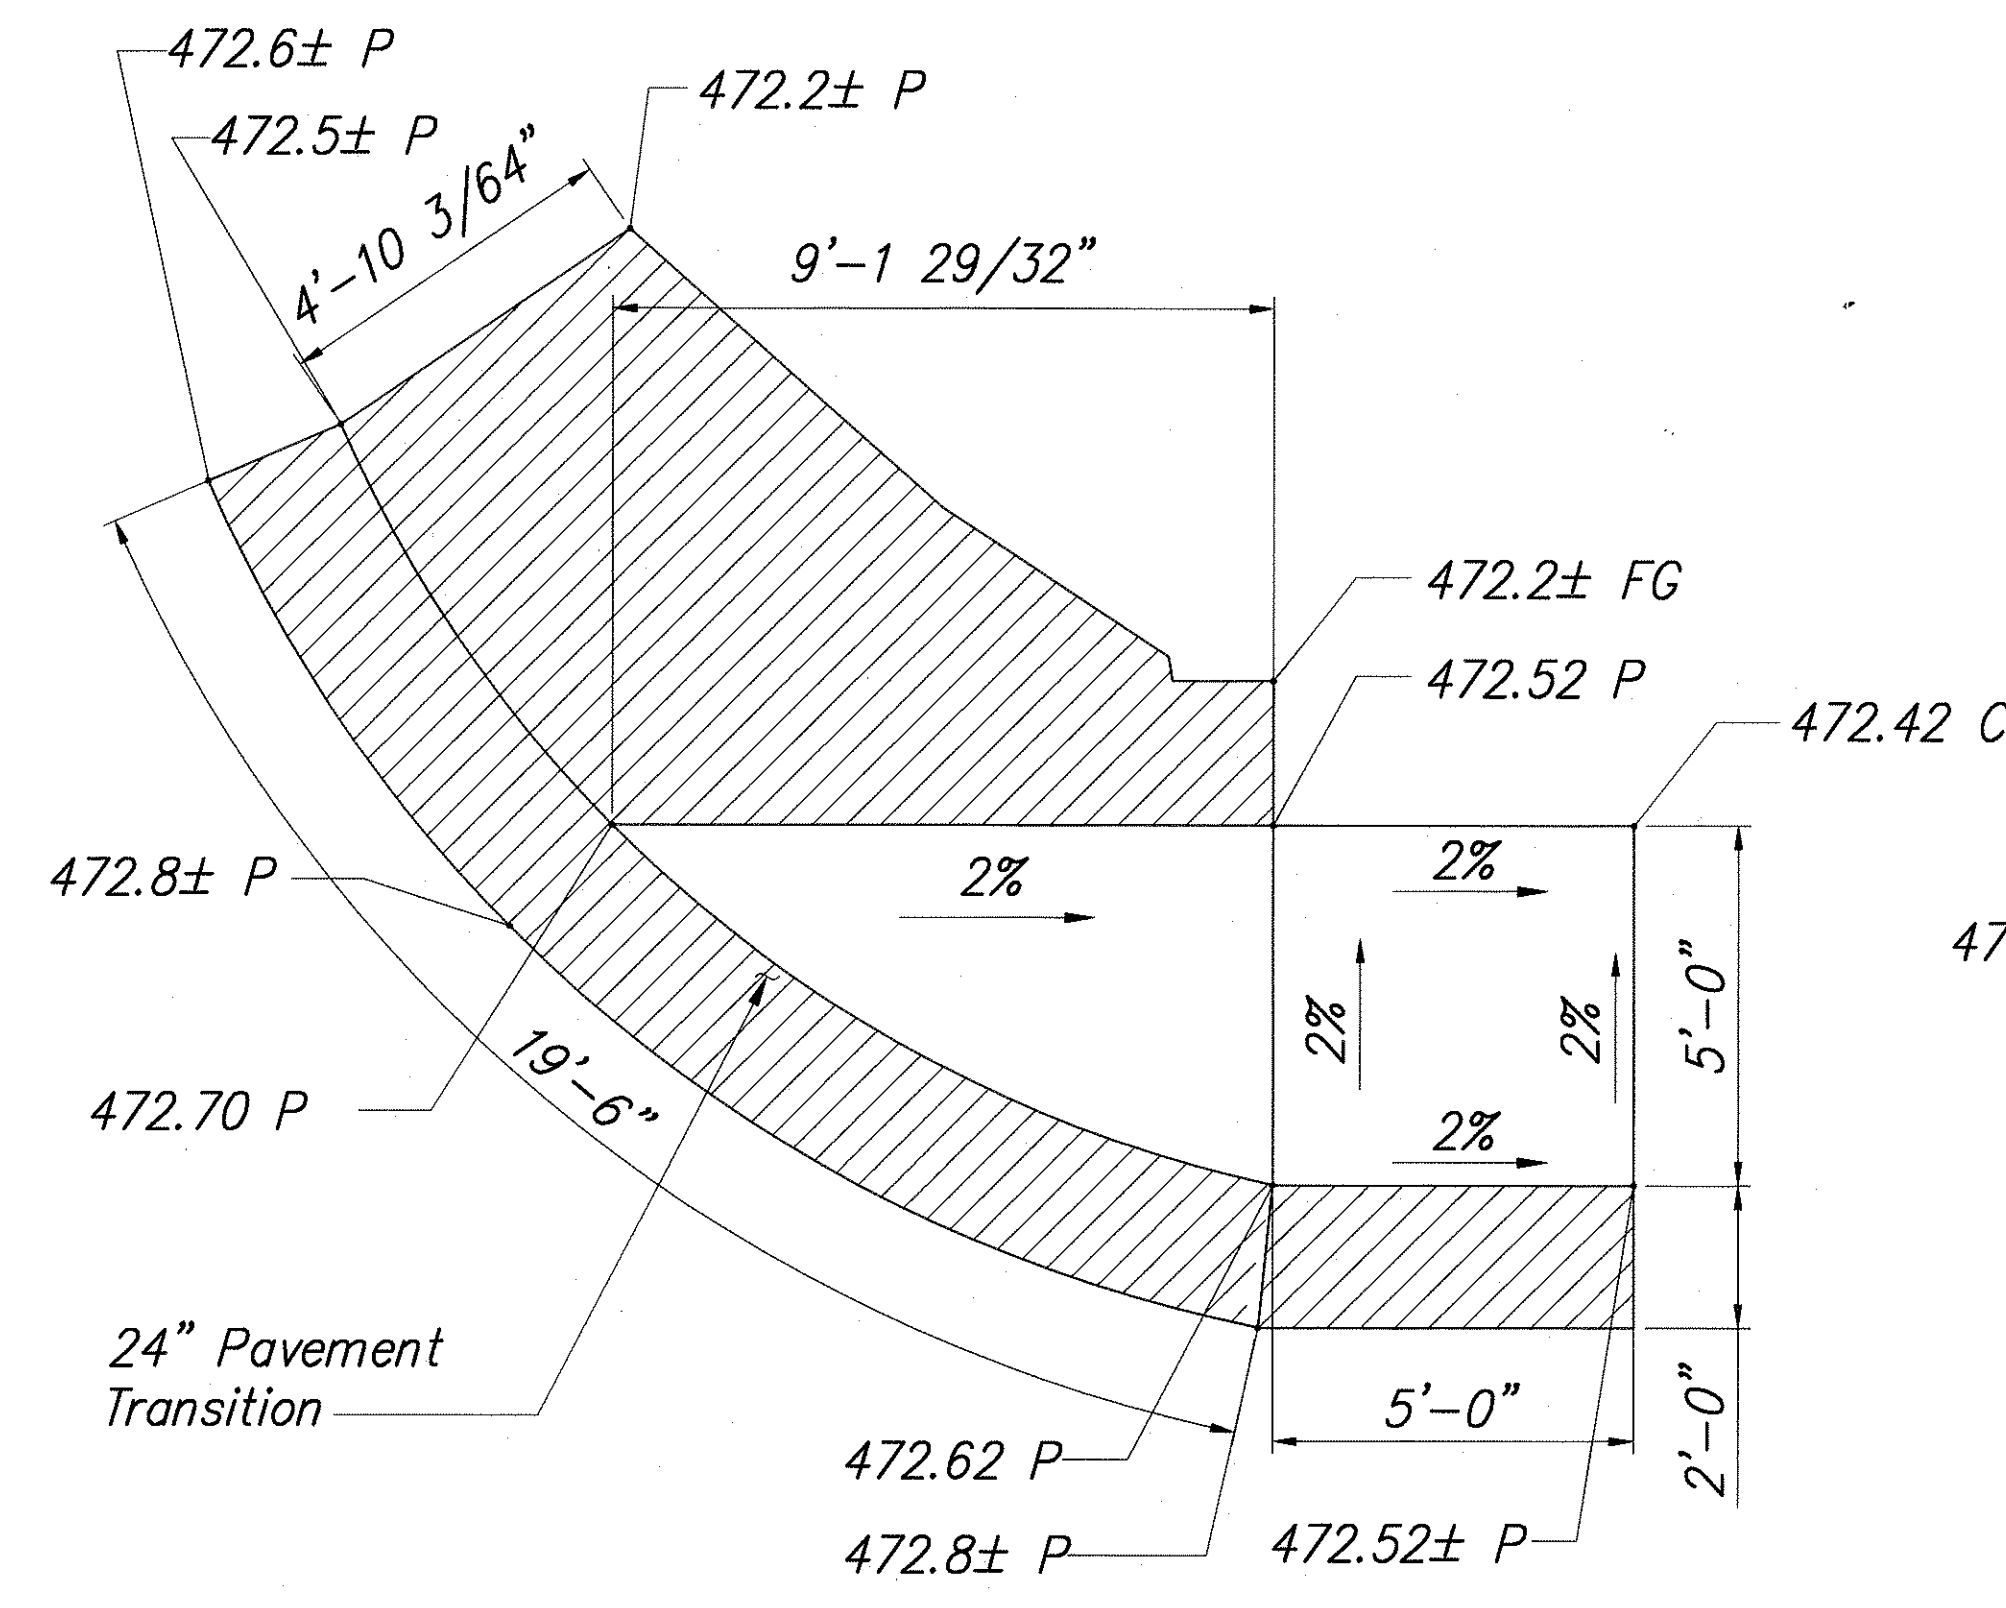

AC TRANSITION RAMP 4
SCALE: 3/8"=1'-0" 49/71

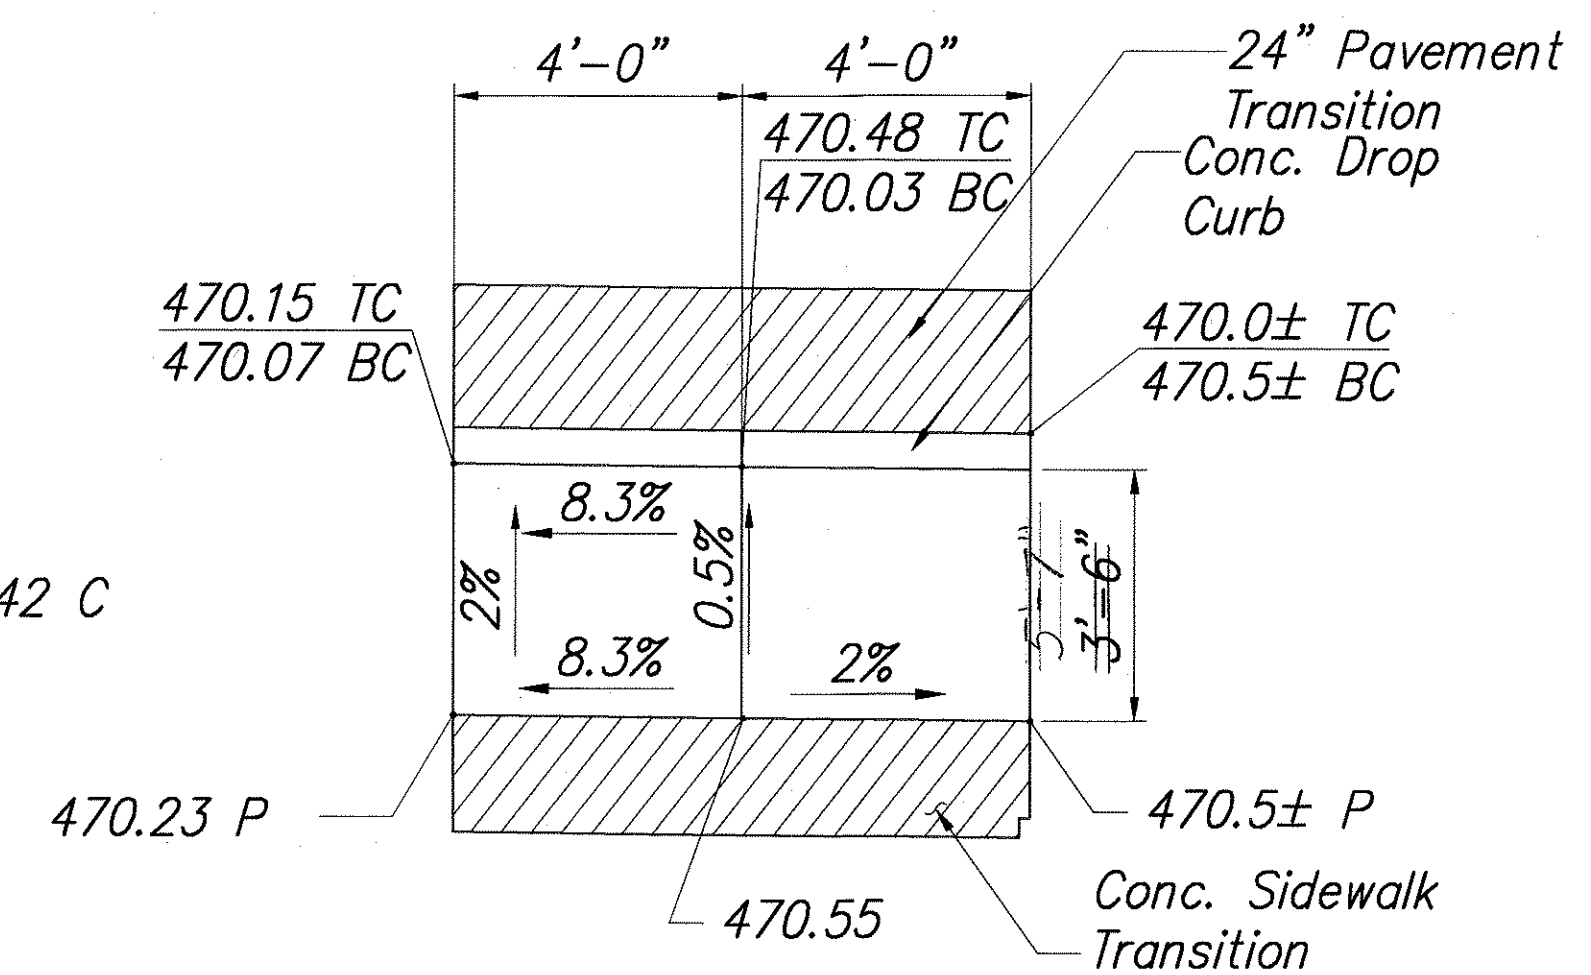

CURB RAMP DETAIL 5
SCALE: 3/8"=1'-0" 52/71

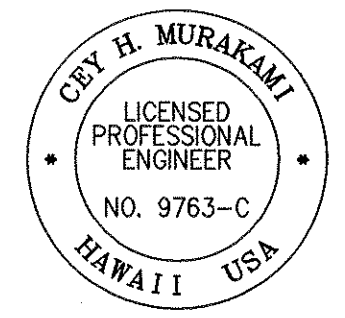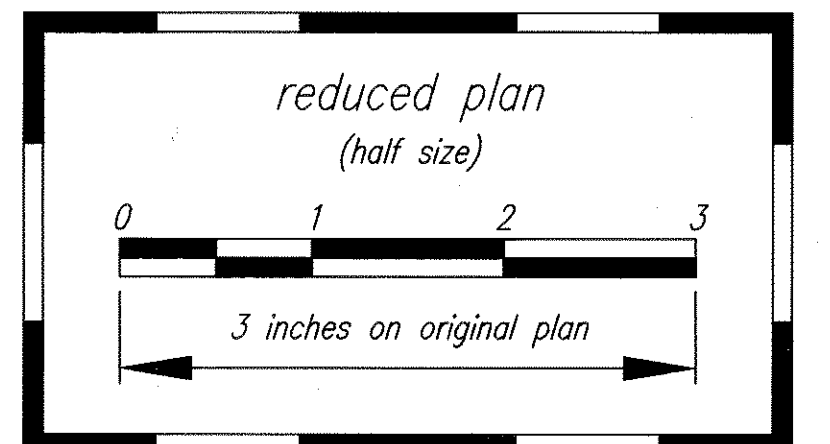

THIS WORK WAS PREPARED BY ME OR UNDER MY SUPERVISION

Cey H. Murakami 04/30/06
SIGNATURE EXPIRATION DATE OF THE LICENSE

STATE OF HAWAII
DEPARTMENT OF TRANSPORTATION
HIGHWAYS DIVISION

KAPAAU - RAMP DETAILS-4

PEDESTRIAN ACCESSIBILITY ROUTE
IMPROVEMENTS - HONOKAA, HAWAII, AND KAPAAU
Federal Aid Project No. CMAQ-0100(62)
Scale: AS NOTED Date: SEPT. 2004


SHEET No. 71 OF 86 SHEETS

ORIGINAL PLAN	DATE
DRAWN BY	9/2004
TRACED BY	9/2004
NOTED BY	9/2004
CHECKED BY	9/2004


I:\2000\2000-070.000 PROJECT POINT - PEDESTRIAN ACCESSIBILITY\DRAWINGS\DETAILS\KAPAAU RAMP DETAILS 71.DWG 05/15/02 20:23 MTM

"AS-BUILT"


FED. ROAD DIST. NO.	STATE	FED. AID PROJ. NO.	FISCAL YEAR	SHEET NO.	TOTAL SHEETS
HAWAII	HAW.	CMAQ-0100(62)	2004	72	86

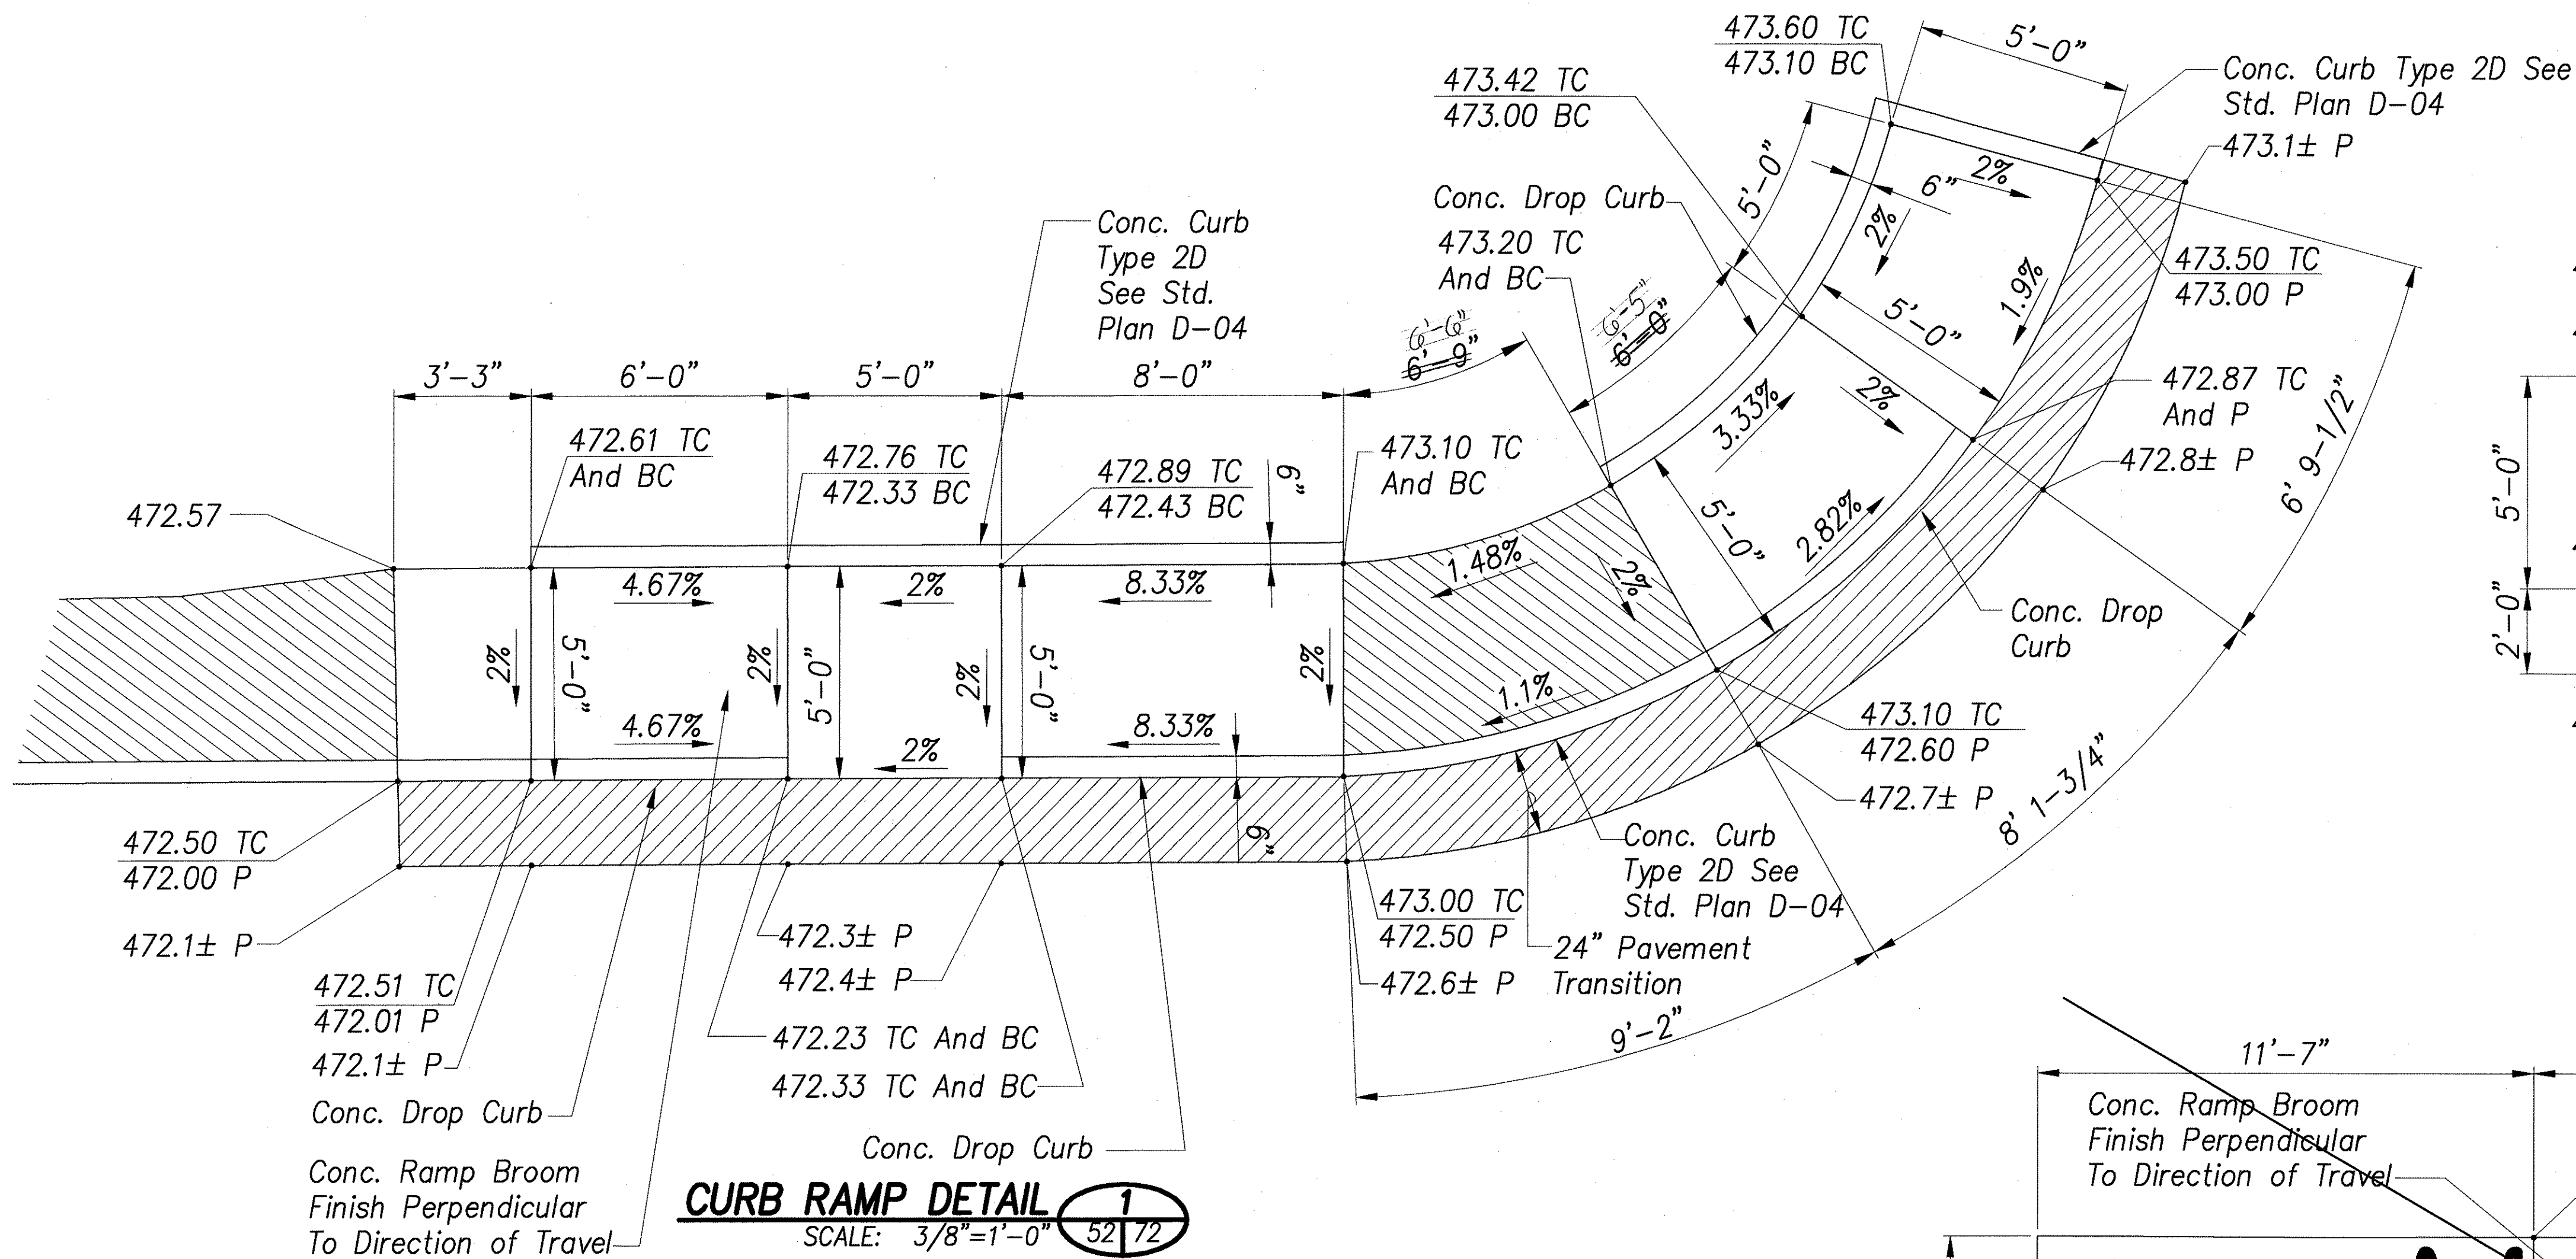


CURB RAMP DETAIL 1
SCALE: 3/8"=1'-0" 52/72

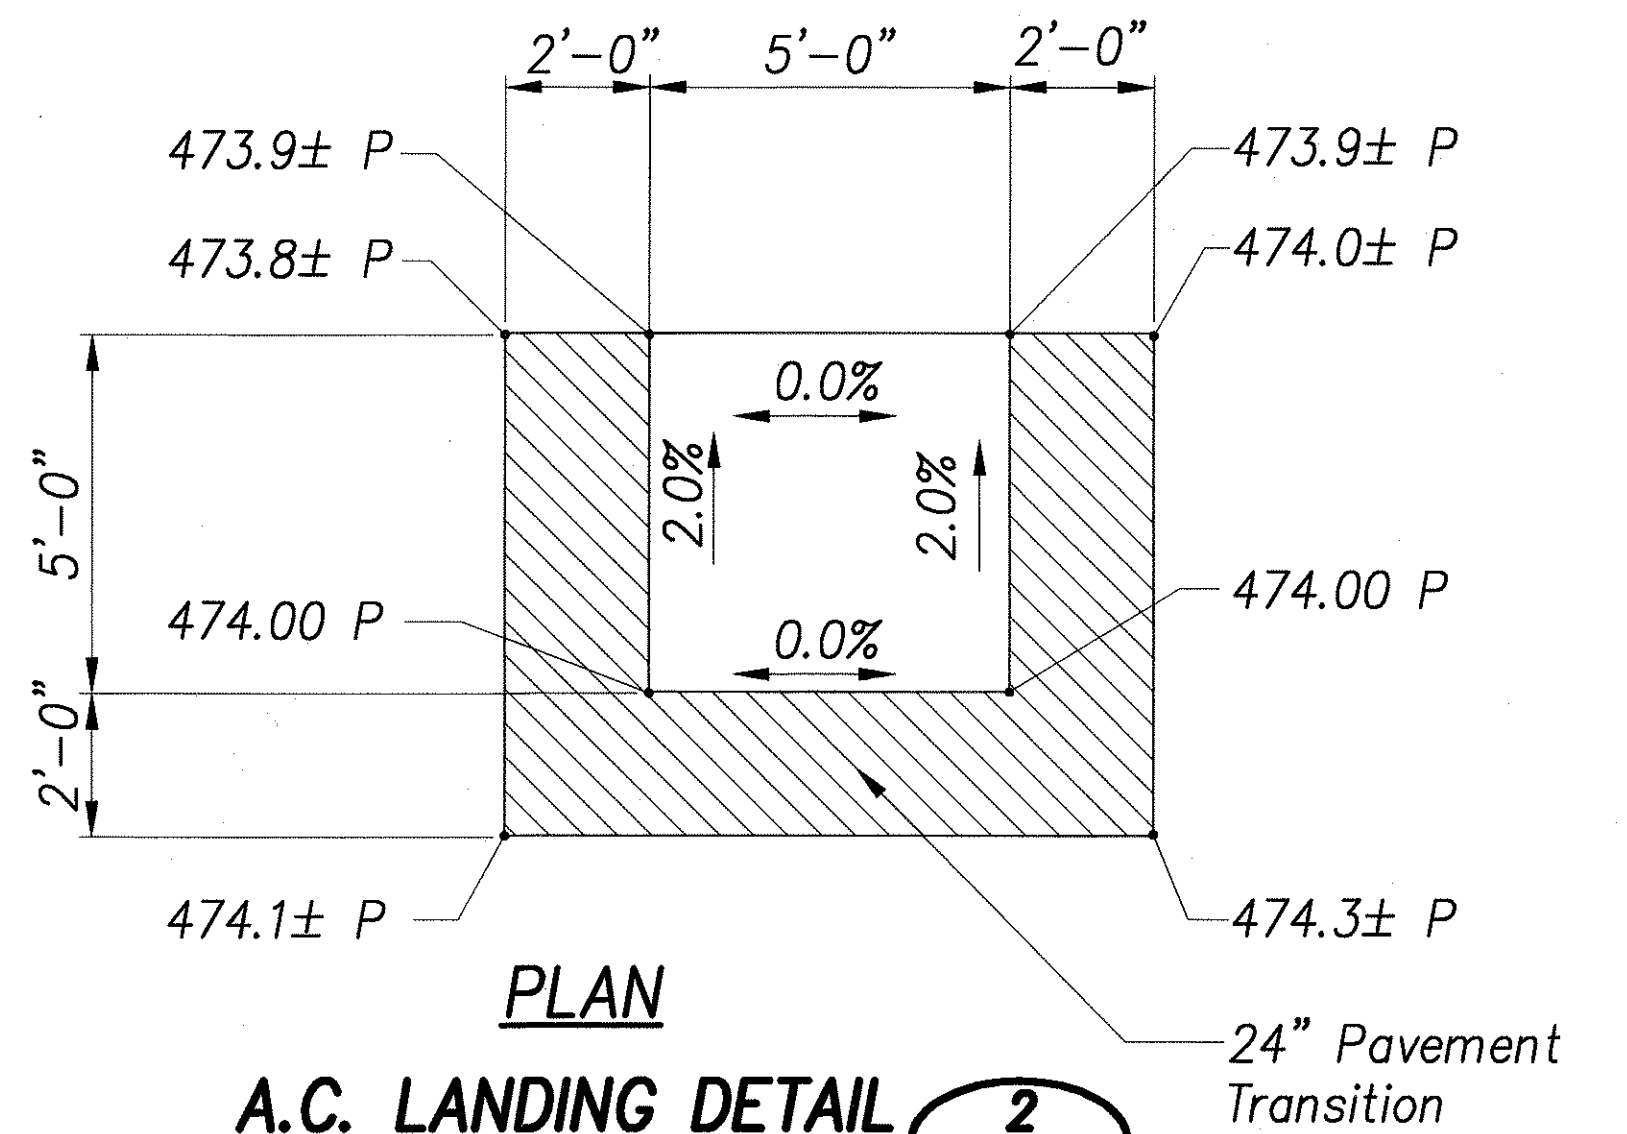

A.C. LANDING DETAIL 2
SCALE: 3/8"=1'-0" 52/72

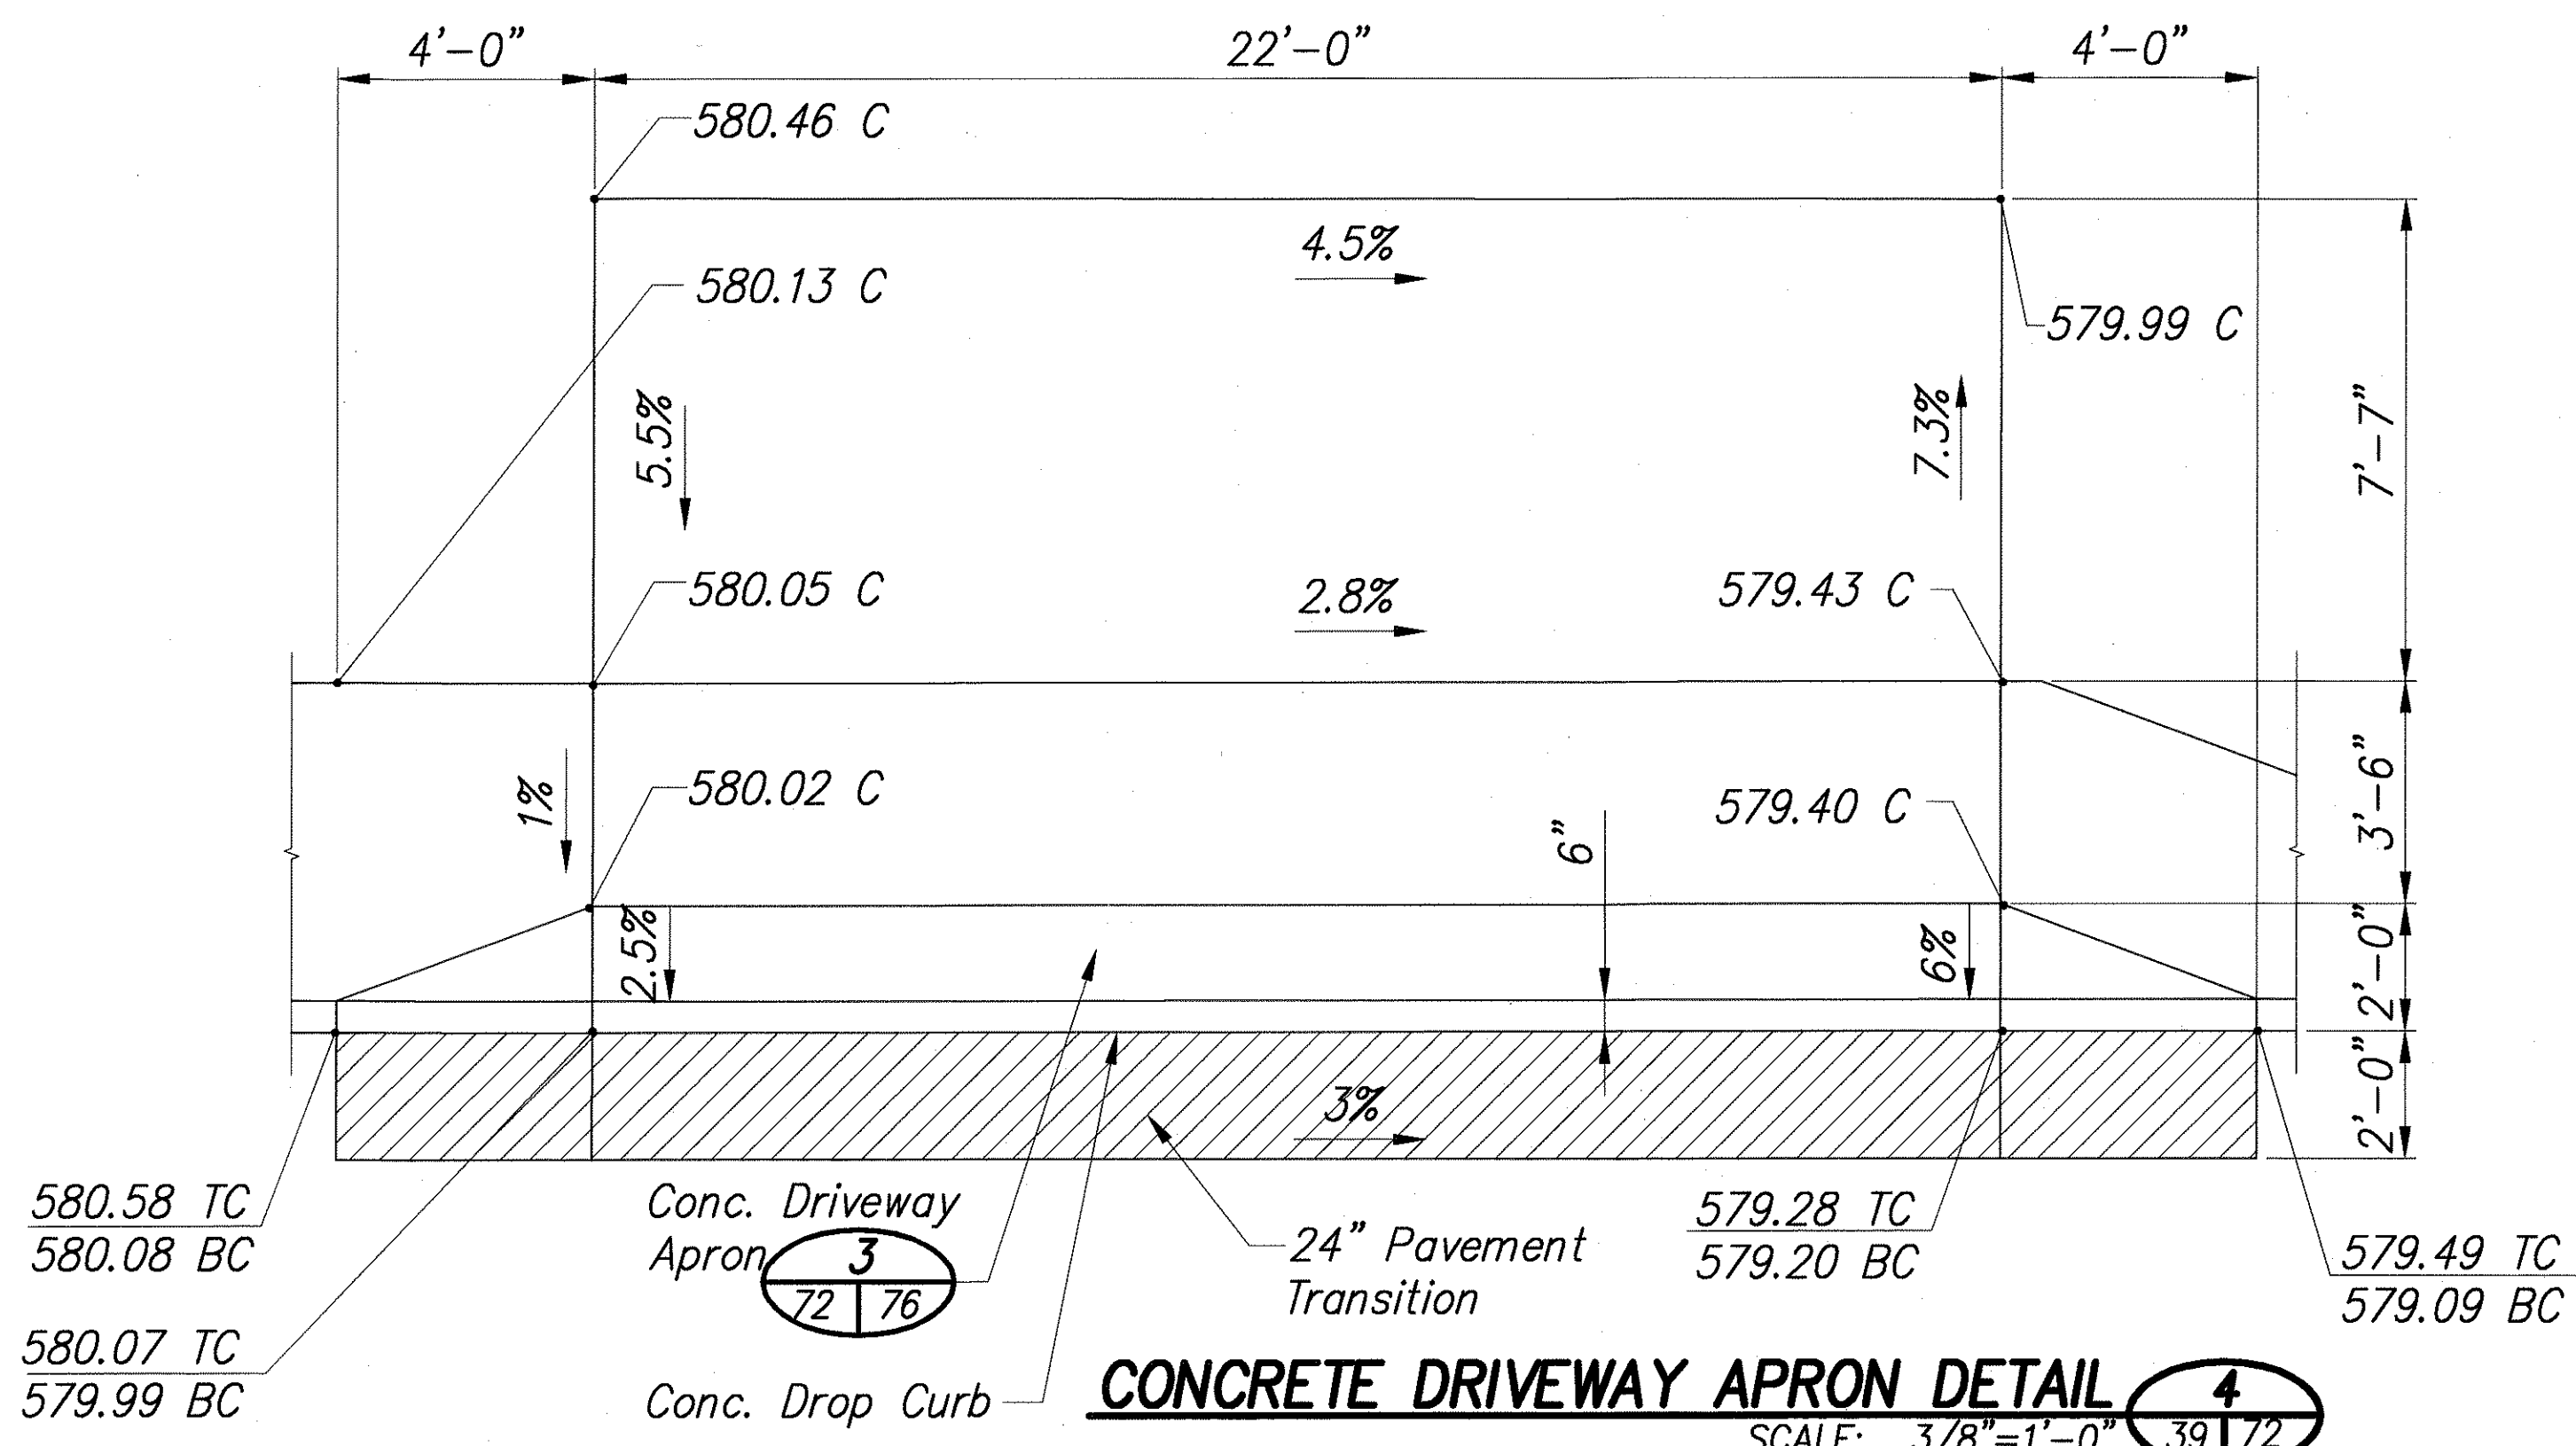


CONCRETE DRIVEWAY APRON DETAIL 4
SCALE: 3/8"=1'-0" 39/72

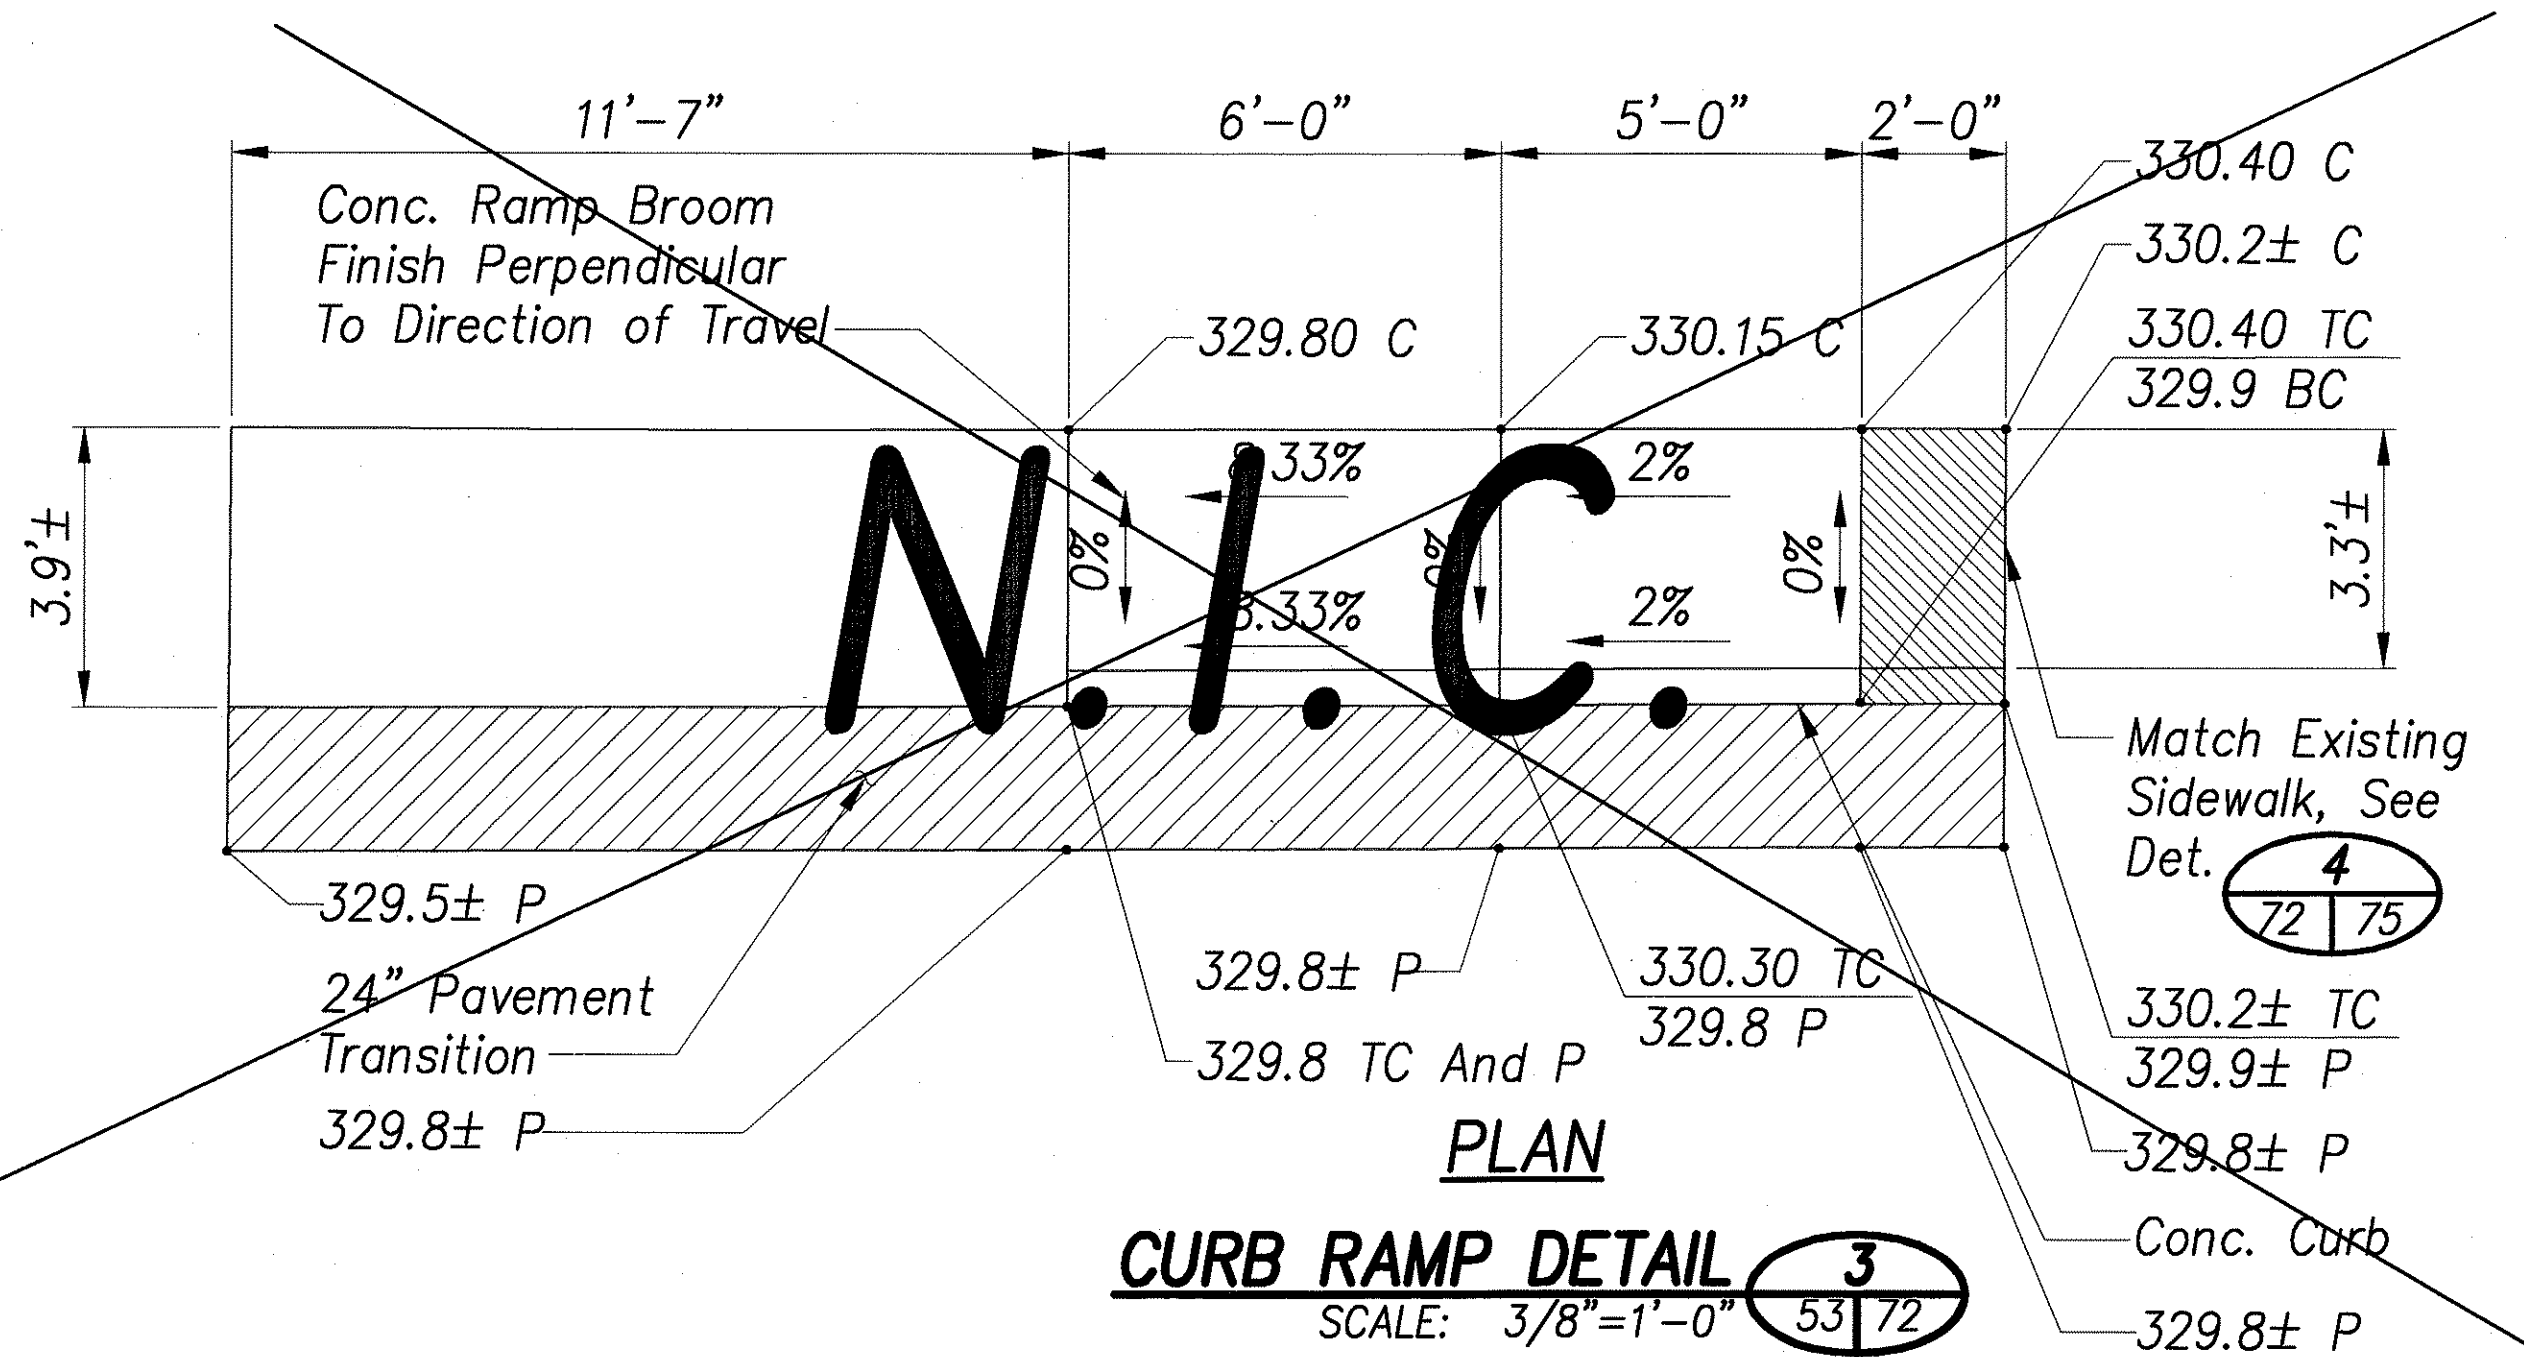


CURB RAMP DETAIL 3
SCALE: 3/8"=1'-0" 53/72

ORIGINAL PLAN	DATE
DRAWN BY	9/2004
DESIGNED BY	9/2004
QUANTITIES BY	9/2004
CHECKED BY	9/2004

I:\2000\2000-070-000 PROJECT POINT - PEDESTRIAN ACCESSIBILITY\G DRAWINGS\DETAILS\KAPA AU RAMP DETAILS 72.DWG 05/15/02 20:25 MTM

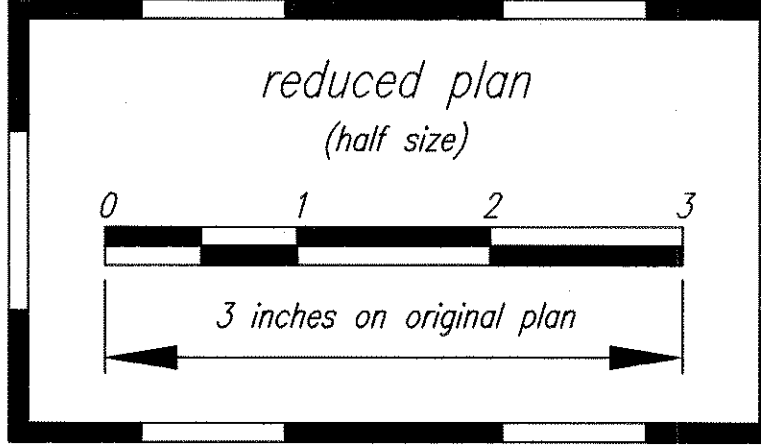

THIS WORK WAS PREPARED BY ME OR UNDER MY SUPERVISION
 Signature: *Cey H. Murakami* 04/30/06
 EXPIRATION DATE OF THE LICENSE

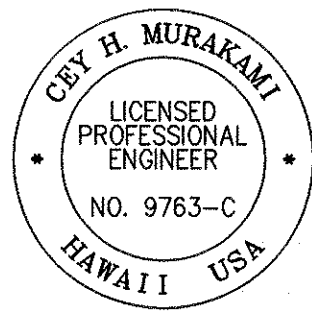

STATE OF HAWAII
 DEPARTMENT OF TRANSPORTATION
 HIGHWAYS DIVISION

KAPA AU & HAWI - RAMP DETAILS-5

PEDESTRIAN ACCESSIBILITY ROUTE
 IMPROVEMENTS - HONOKAA, HAWI, AND KAPA AU
 Federal Aid Project No. CMAQ-0100(62)
 Scale: AS NOTED Date: SEPT. 2004

SHEET No. 72 OF 86 SHEETS

"AS-BUILT"