


I:\2000\2000_070.000 PROJECT POINT - PEDESTRIAN ACCESSIBILITY\G DRAWINGS\DETAILS\C-DT0015 KAPAAU RAMP DETAILS 68.DWG 05/15/02 20:06 MTM

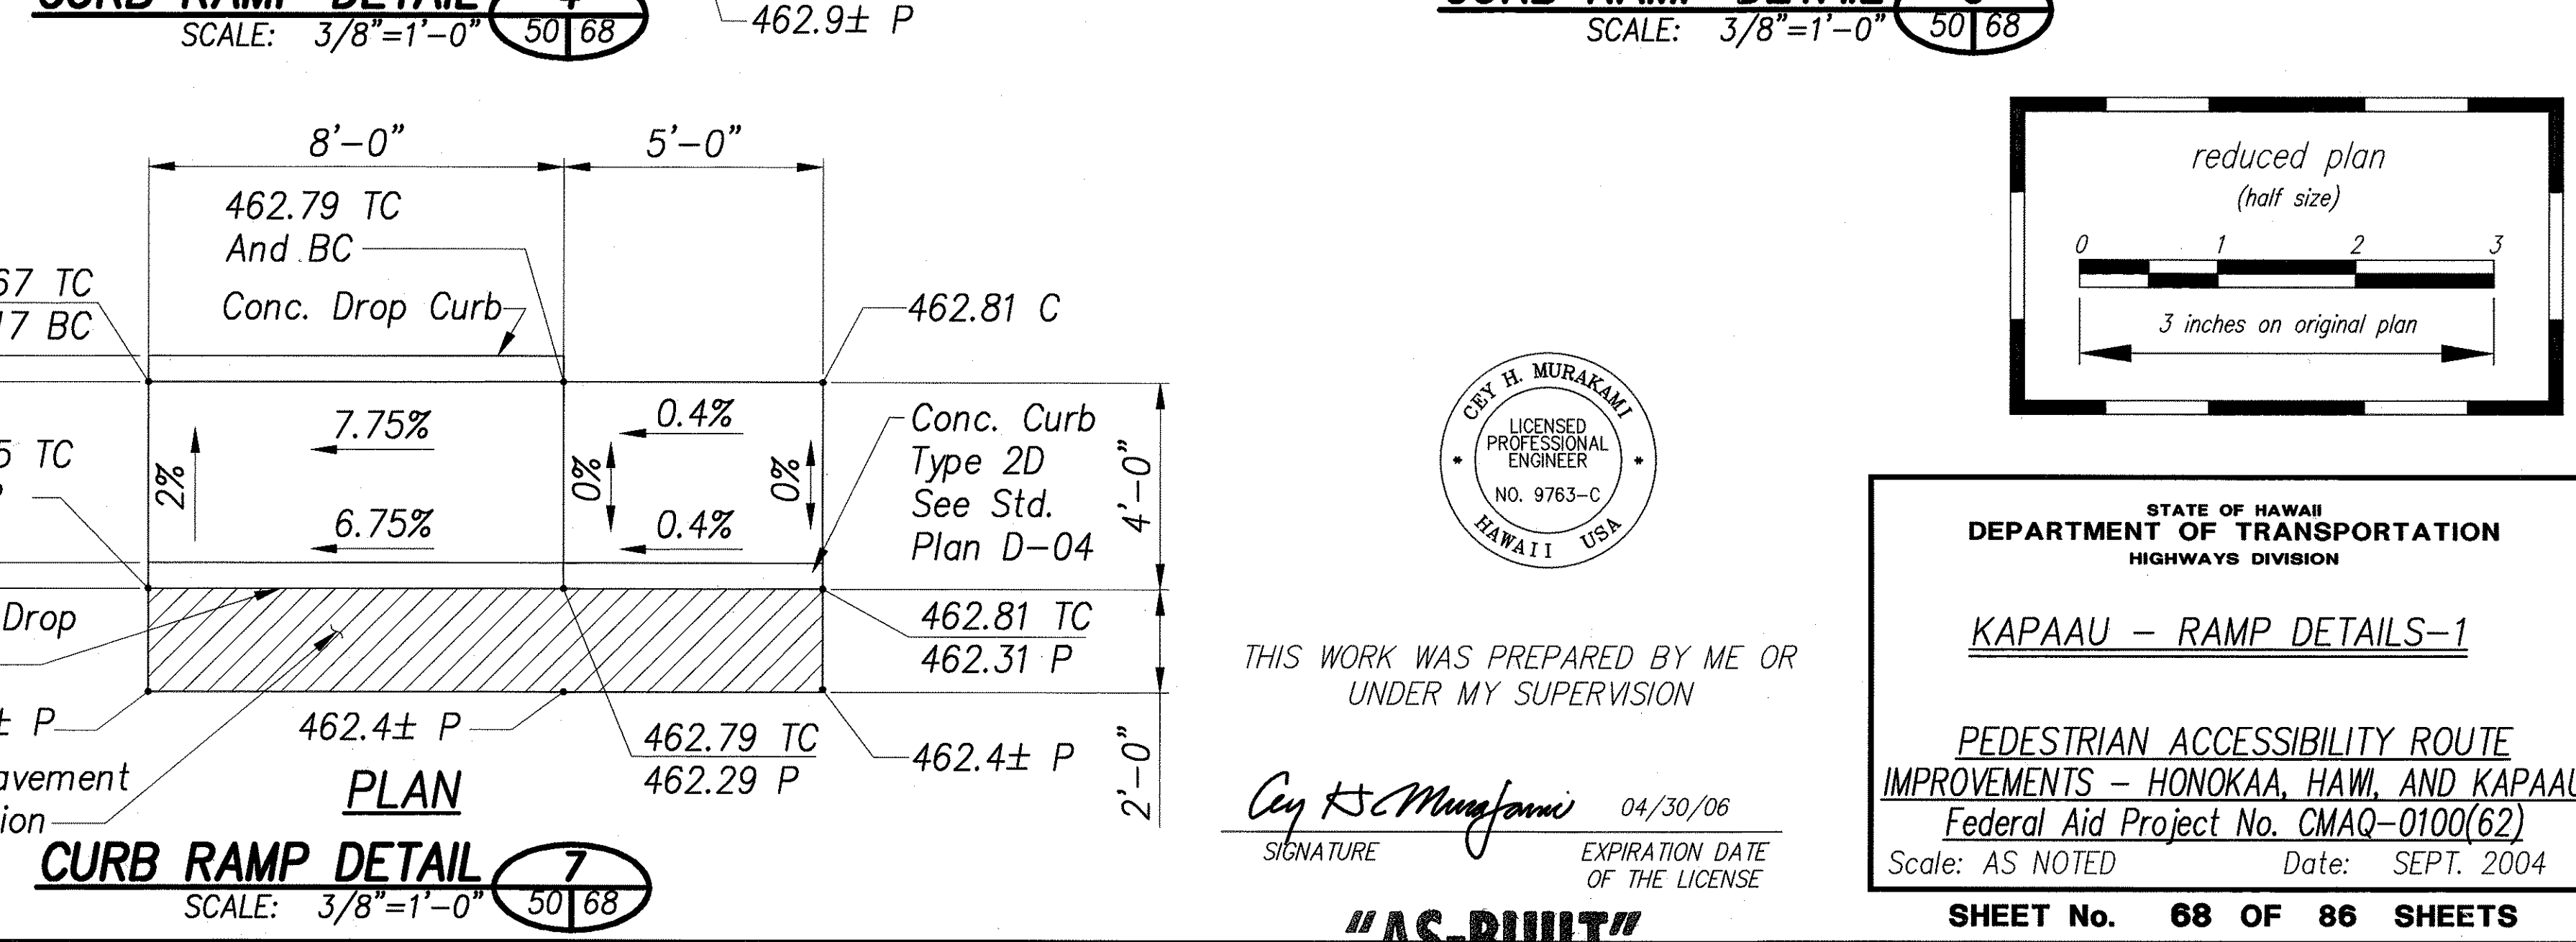

Cey H. Munfami 04/30/06
SIGNATURE EXPIRATION DATE
OF THE LICENSE

STATE OF HAWAII
DEPARTMENT OF TRANSPORTATION
HIGHWAYS DIVISION

KAPAAU – RAMP DETAILS-1

PEDESTRIAN ACCESSIBILITY ROUTE
IMPROVEMENTS – HONOKAA, HAWI, AND KAPAAU
Federal Aid Project No. CMAQ-0100(62)

Scale: AS NOTED Date: SEPT. 2004

SHEET No. 68 OF 86 SHEETS

