


FED. ROAD DIST. NO.	STATE	FED. AID PROJ. NO.	FISCAL YEAR	SHEET NO.	TOTAL SHEETS
HAWAII	HAW.	CMAQ-0100(62)	2004	84	86



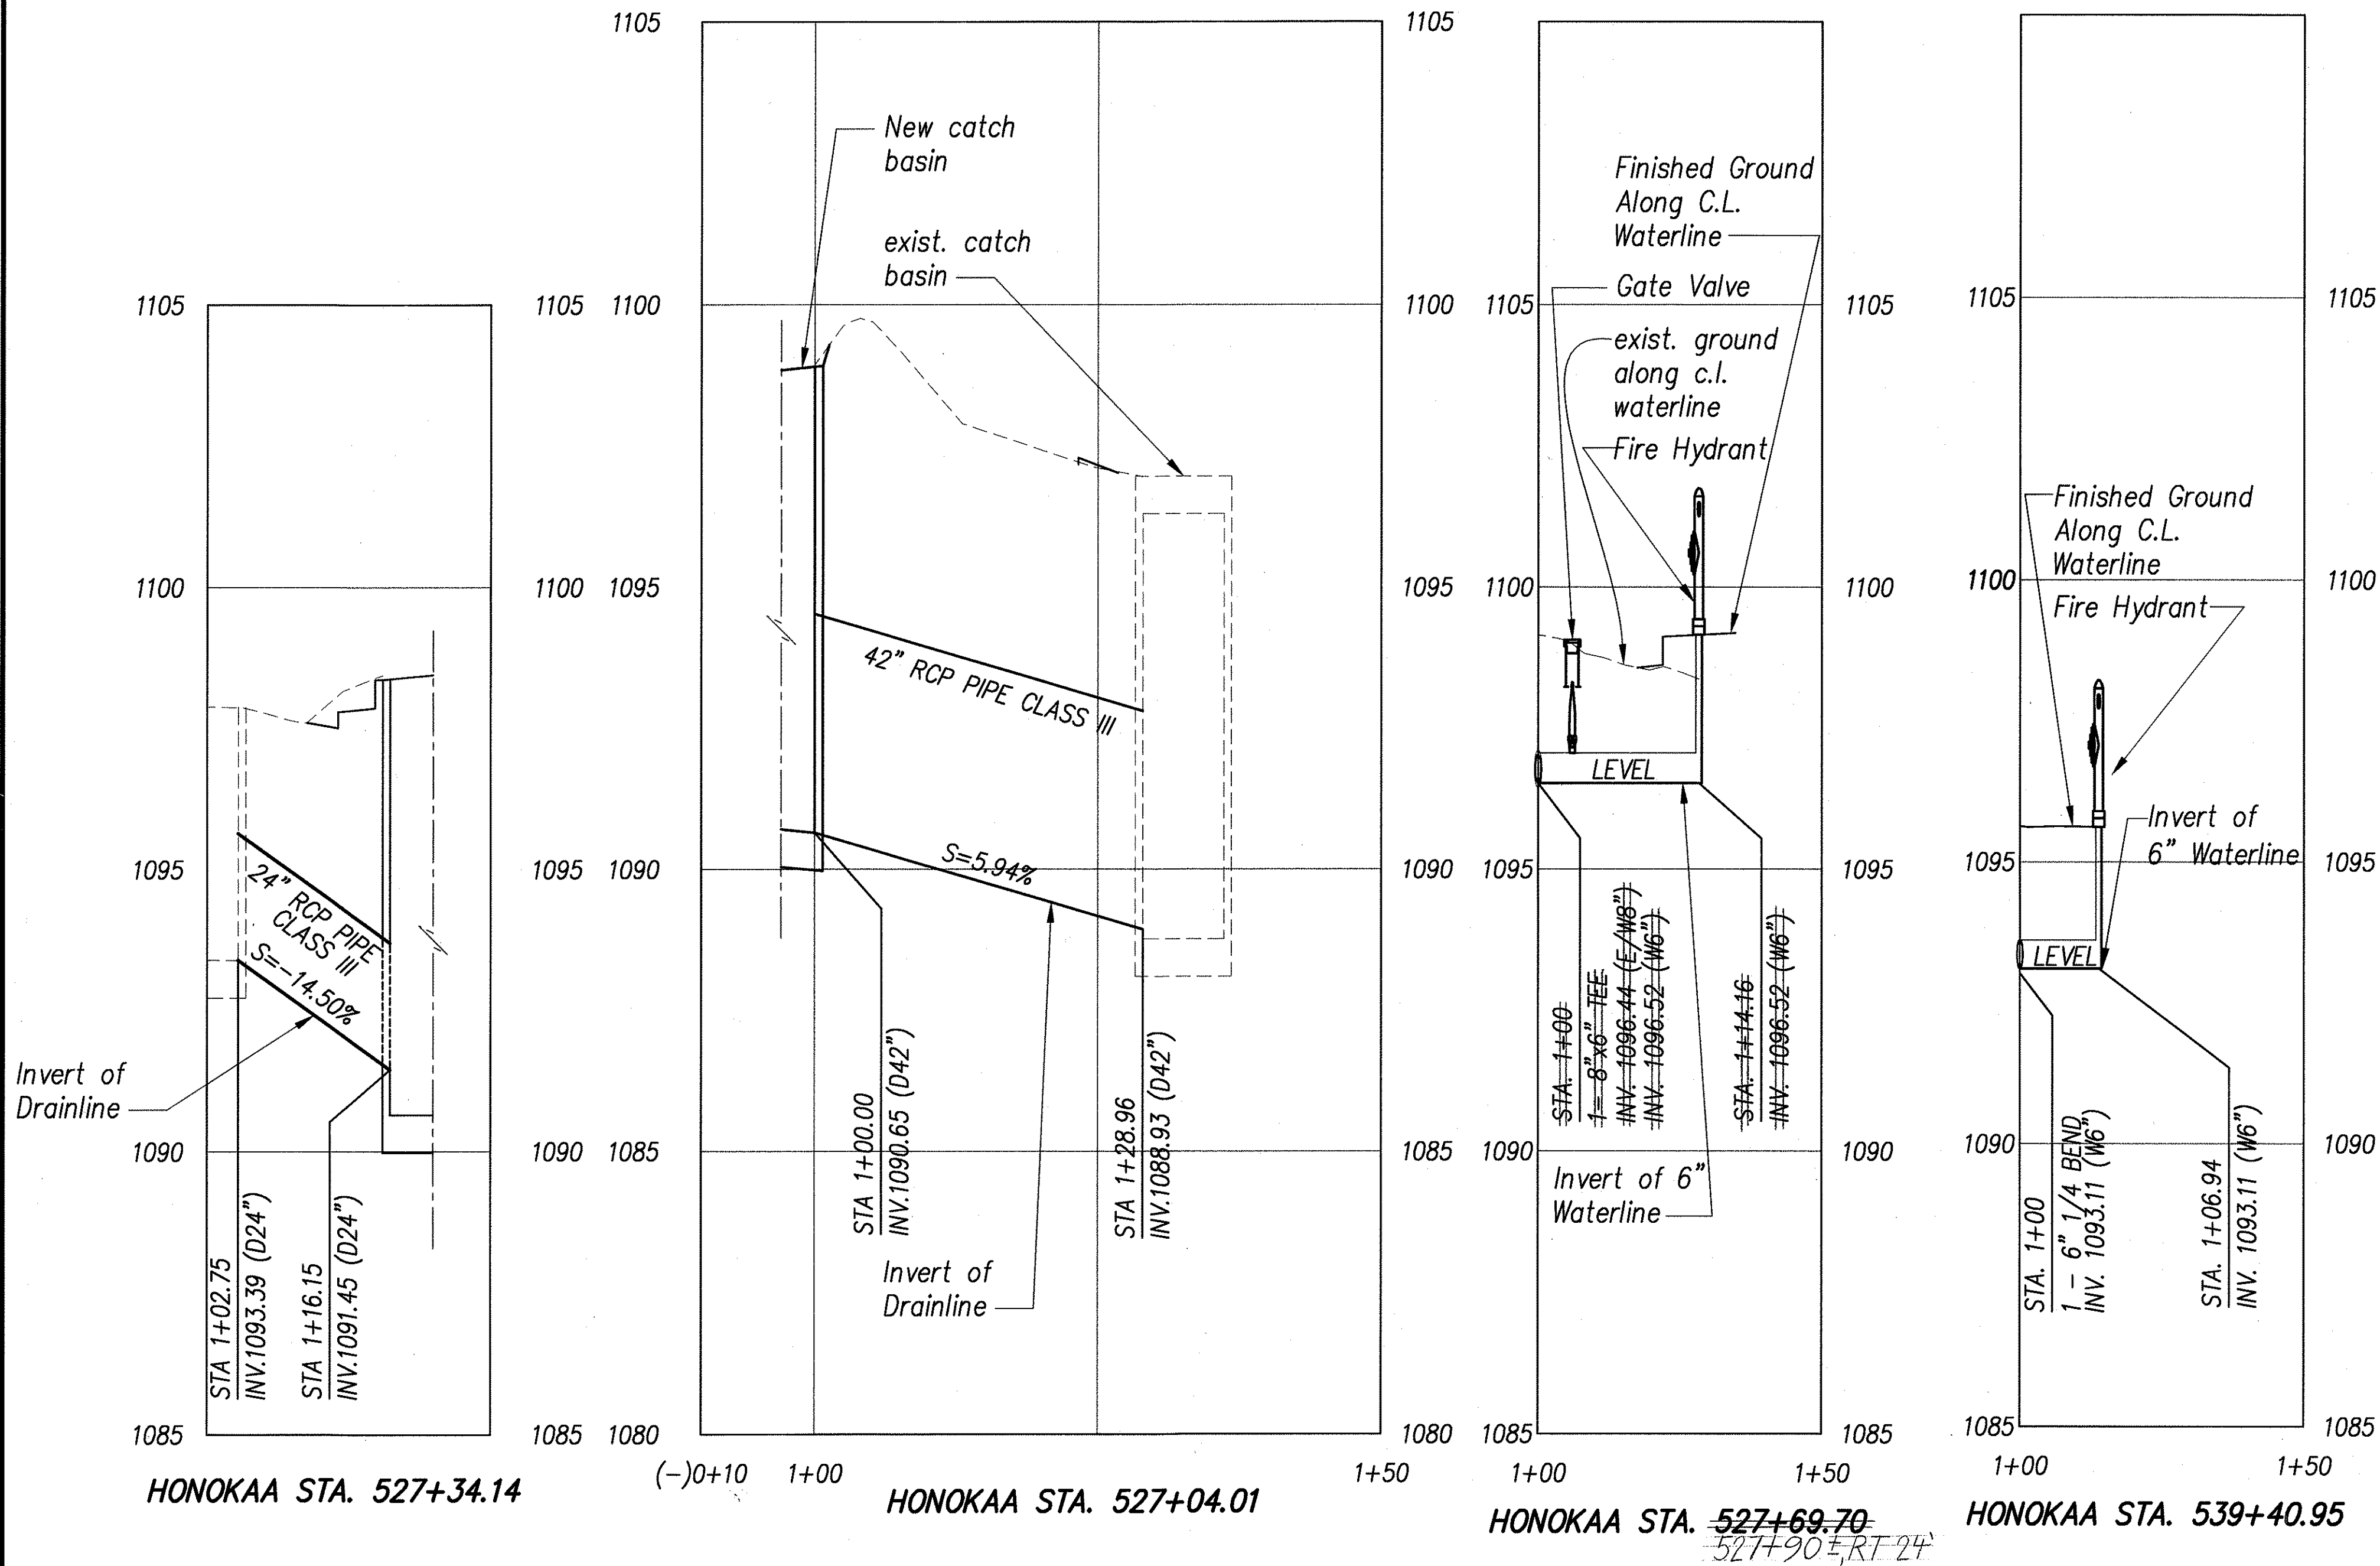


PROFILE - DRAINLINE "A"
 SCALE: HORIZ 1" = 10'
 VERT 1" = 2'

PROFILE - DRAINLINE "B"
 SCALE: HORIZ 1" = 10'
 VERT 1" = 2'

PROFILE FH CONNECTION "A"
 SCALE: HORIZ 1" = 10'
 VERT 1" = 2'

PROFILE FH CONNECTION "B"
 SCALE: HORIZ 1" = 10'
 VERT 1" = 2'

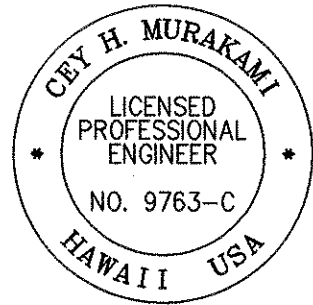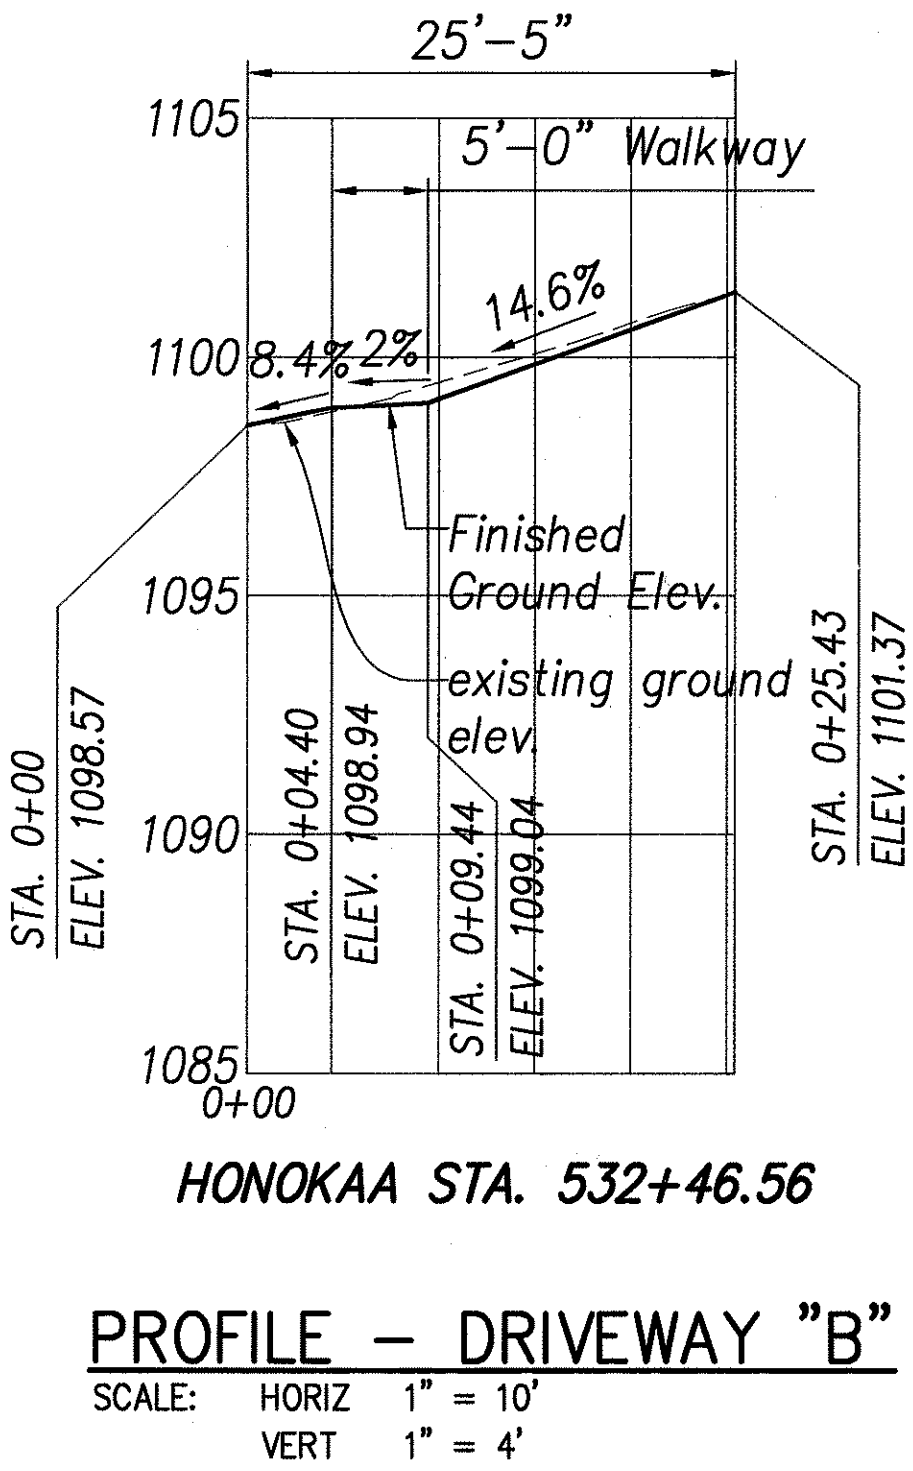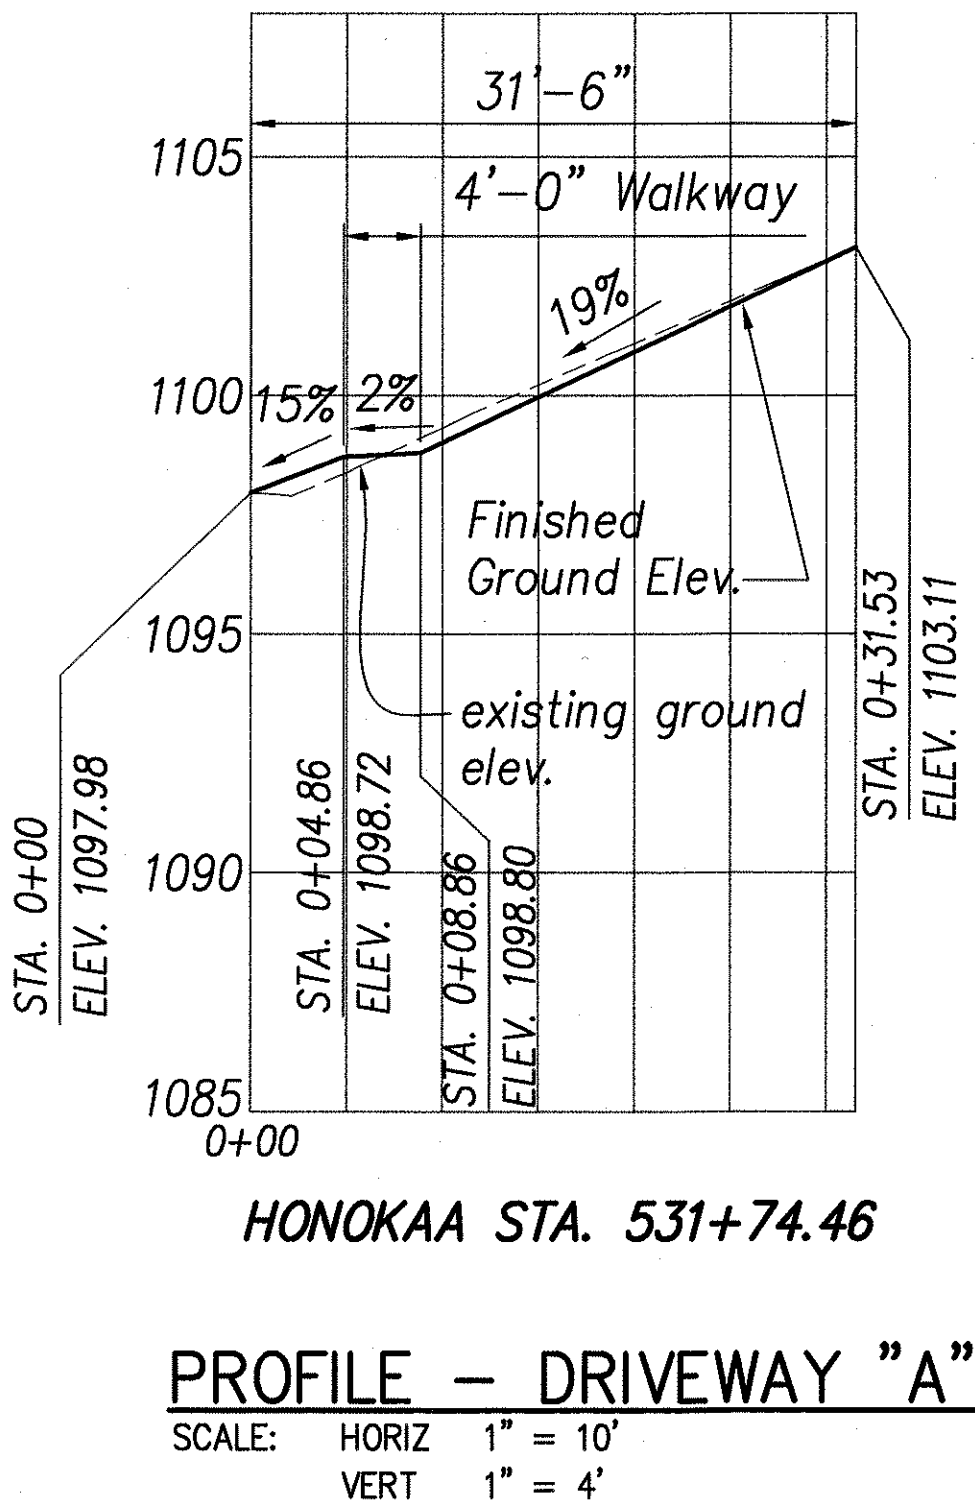

THIS WORK WAS PREPARED BY ME OR UNDER MY SUPERVISION

Cey H. Murakami 04/30/06
 SIGNATURE EXPIRATION DATE OF THE LICENSE

"AS-BUILT"

STATE OF HAWAII

DEPARTMENT OF TRANSPORTATION

HIGHWAYS DIVISION

PROFILES

PEDESTRIAN ACCESSIBILITY ROUTE IMPROVEMENTS - HONOKAA, HAWAII, AND KAPAAU

Federal Aid Project No. CMAQ-0100(62)

Scale: AS NOTED Date: SEPT. 2004

SHEET No. 84 OF 86 SHEETS

ORIGINAL PLAN	DATE
DESIGNED BY	9/2004
CHECKED BY	9/2004
NOTED BY	9/2004
QUANTITIES BY	9/2004
NO.	

I:\2000\2000_070.000 PROJECT POINT-PEDESTRIAN ACCESSIBILITY\DRAWINGS\CONTRACT DOCUMENTS\021009\VED_ACCESS021016\C-DT0081-UTILITY PROFILES.DWG 10/30/02 09:03 XXX