

FED. ROAD DIST. NO.	STATE	FED. AID PROJ. NO.	FISCAL YEAR	SHEET NO.	TOTAL SHEETS
HAWAII	HAW.	CMAQ-0100(62)	2004	37	86

T.M.K.: 3RD DIV.
5-5-09:13

Note:

For All Meter Boxes That Shall Be Relocated/Adjusted, The Contractor Shall Verify The Meter Box Type And Replace Any That is Not a Type "X" To a Type "X" Meter Box, See DWS Det. M3.

T.M.K.: 3RD DIV.
5-5-09:12

Relocation of Existing Water Meter Box

Remove and Replace with New Sign, Post and Anchor

Type D Conc. Curb Ramp See Det.

Type D Modified Conc. Curb Ramp See Det.

T.M.K.: 3RD DIV.
5-5-09:25

Sta. 335+26.56
O/S 22.00' Lt.

exist. utility pole to remain
Sta. 334+99.15
O/S 22.00' Lt.

T.M.K.: 3RD DIV.
5-5-09:10

Type D Conc. Curb Ramp See Det.

Remove and Replace with New Sign, Post and Anchor

Sta. 335+77.38
O/S 22.27' Lt.

Sta. 335+51.14
O/S 22.00' Lt.


T.M.K.: 3RD DIV.
5-5-09:08

Type A Conc. Curb Ramp, See Det.

Type B Modified Conc. Curb Ramp, See Det.


Sta. 335+82.38
O/S 22.23' Lt.

TRUE NORTH
SCALE: 1 in. = 10 ft.

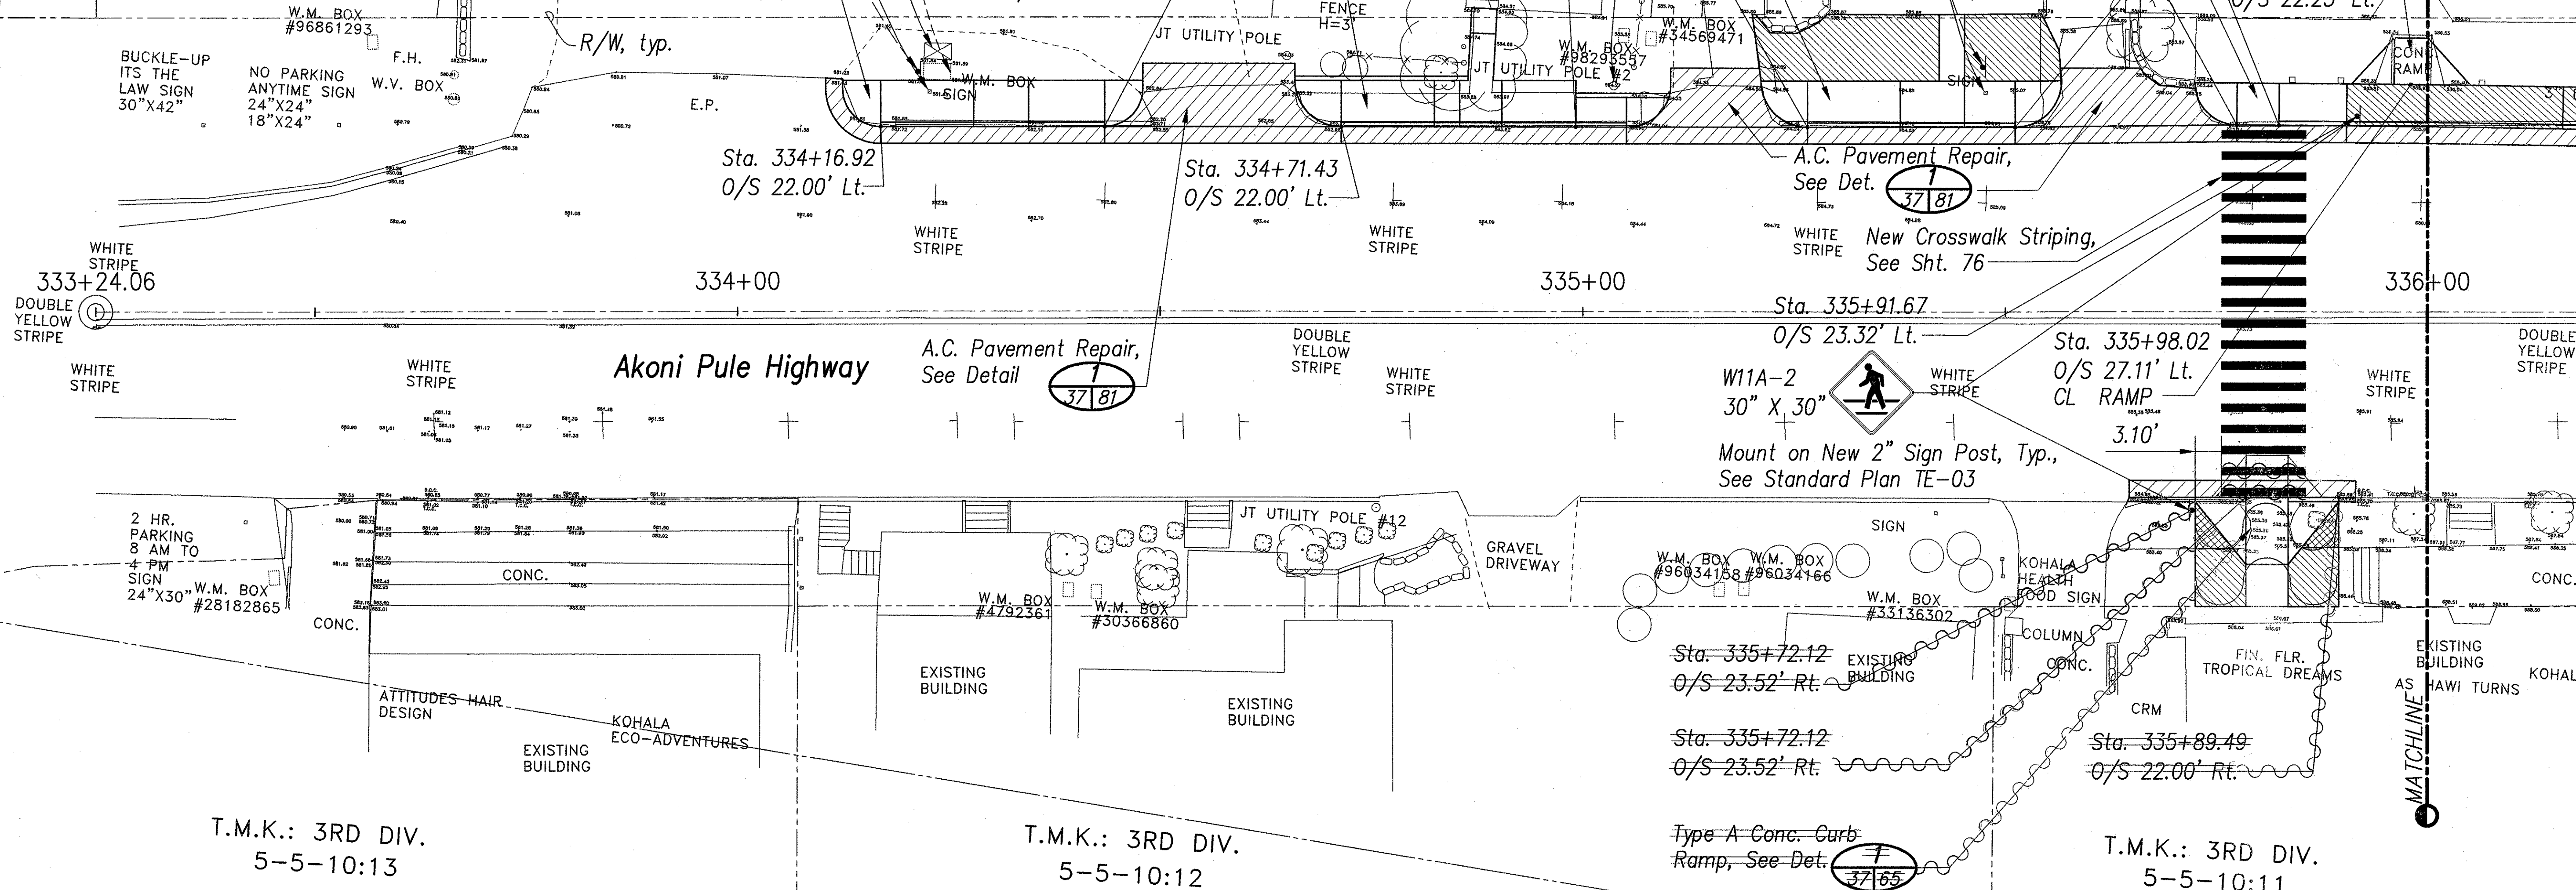

T.M.K.: 3RD DIV.
5-5-10:13


T.M.K.: 3RD DIV.
5-5-10:12

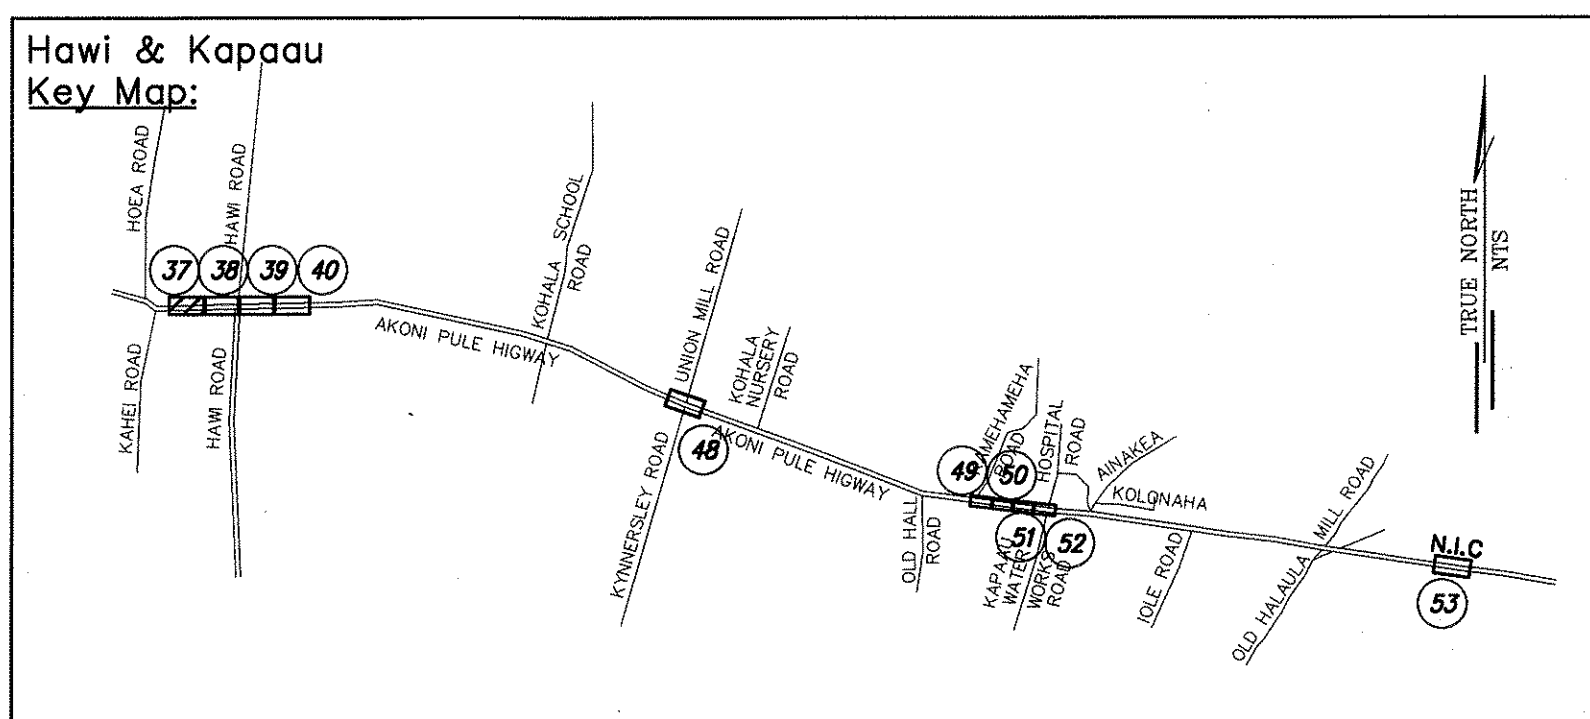

Legend:

- AC Pavement & AC Driveway Repair
- Concrete Sidewalk & Concrete Driveway Repair
- Grassing


SITE PLAN - HAWAII
SCALE: 1" = 10'

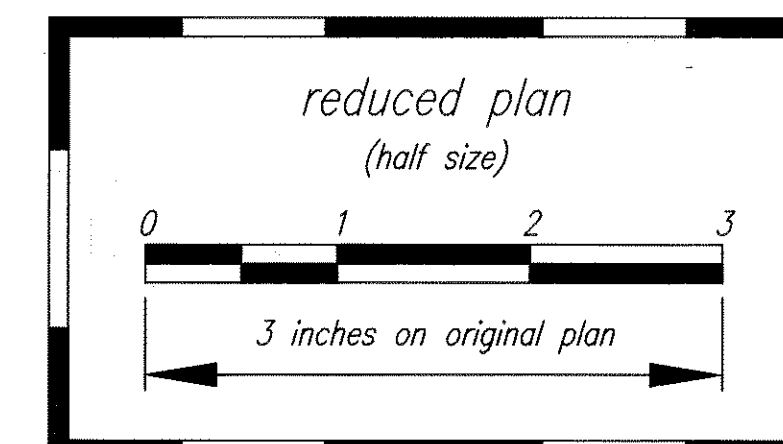

THIS WORK WAS PREPARED BY ME OR UNDER MY SUPERVISION

Cey H. MURAKAMI
SIGNATURE

EXPIRATION DATE OF THE LICENSE

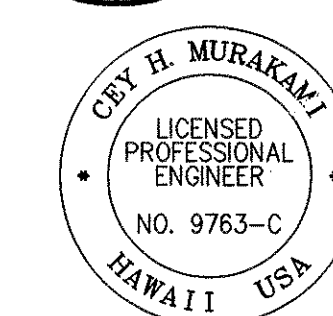

STATE OF HAWAII
DEPARTMENT OF TRANSPORTATION
HIGHWAYS DIVISION

SITE PLAN - HAWAII
AKONI PULE HIGHWAY
STA. 333+24 TO STA. 336+00
PEDESTRIAN ACCESSIBILITY ROUTE IMPROVEMENTS - HONOKAA, HAWAII, AND KAPAAU
Federal Aid Project No. CMAQ-0100(62)



Scale: AS NOTED Date: SEPT. 2004

SHEET No. 37 OF 86 SHEETS

"AS-BUILT"

CHECKED BY: 20 07/2002

FILE: \\2000\\2000_070.000 PROJECT POINT - PEDESTRIAN ACCESSIBILITY\\G DRAWINGS\\PLAN\\C-SP0013_HAWI.DWG 04/16/02 09:47

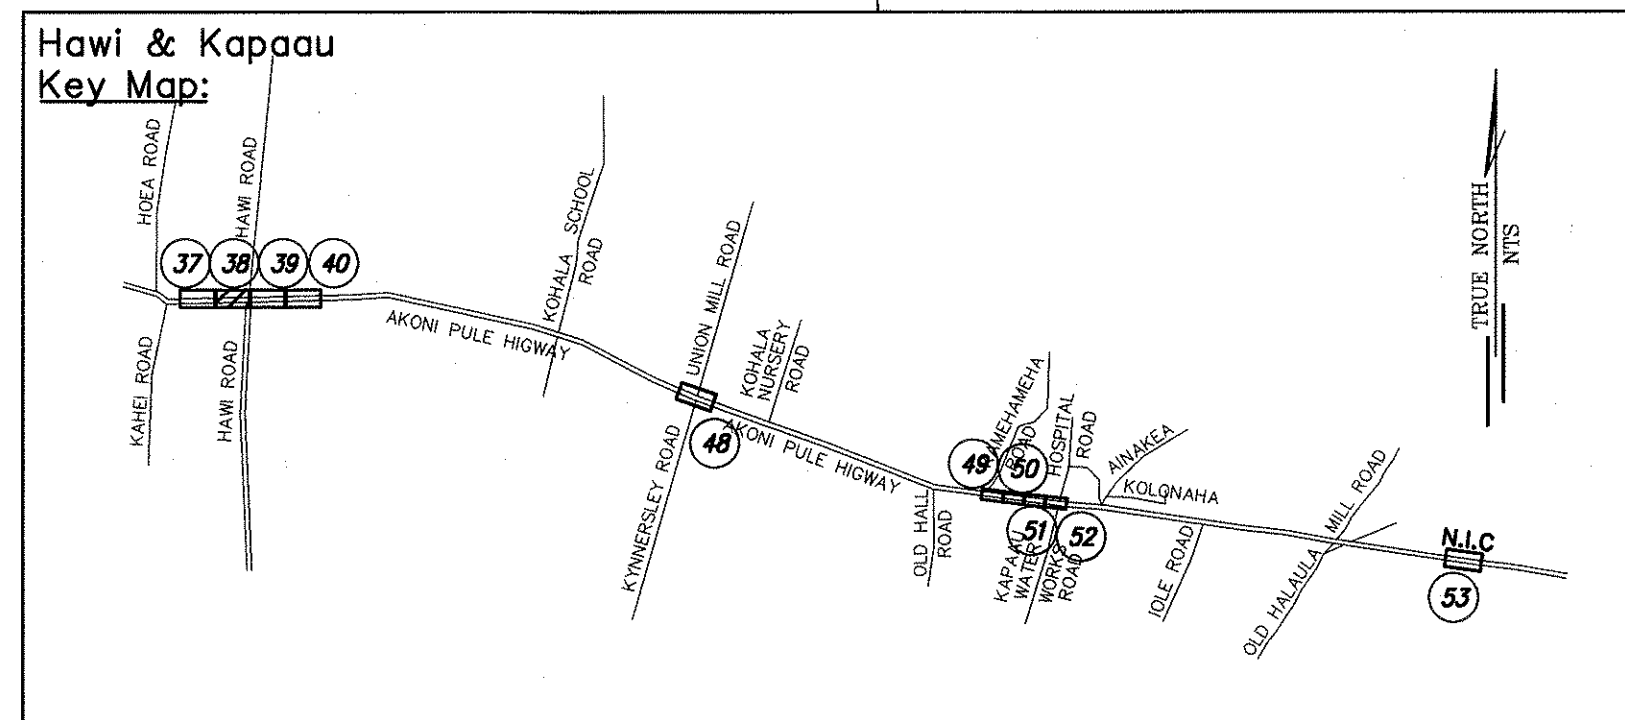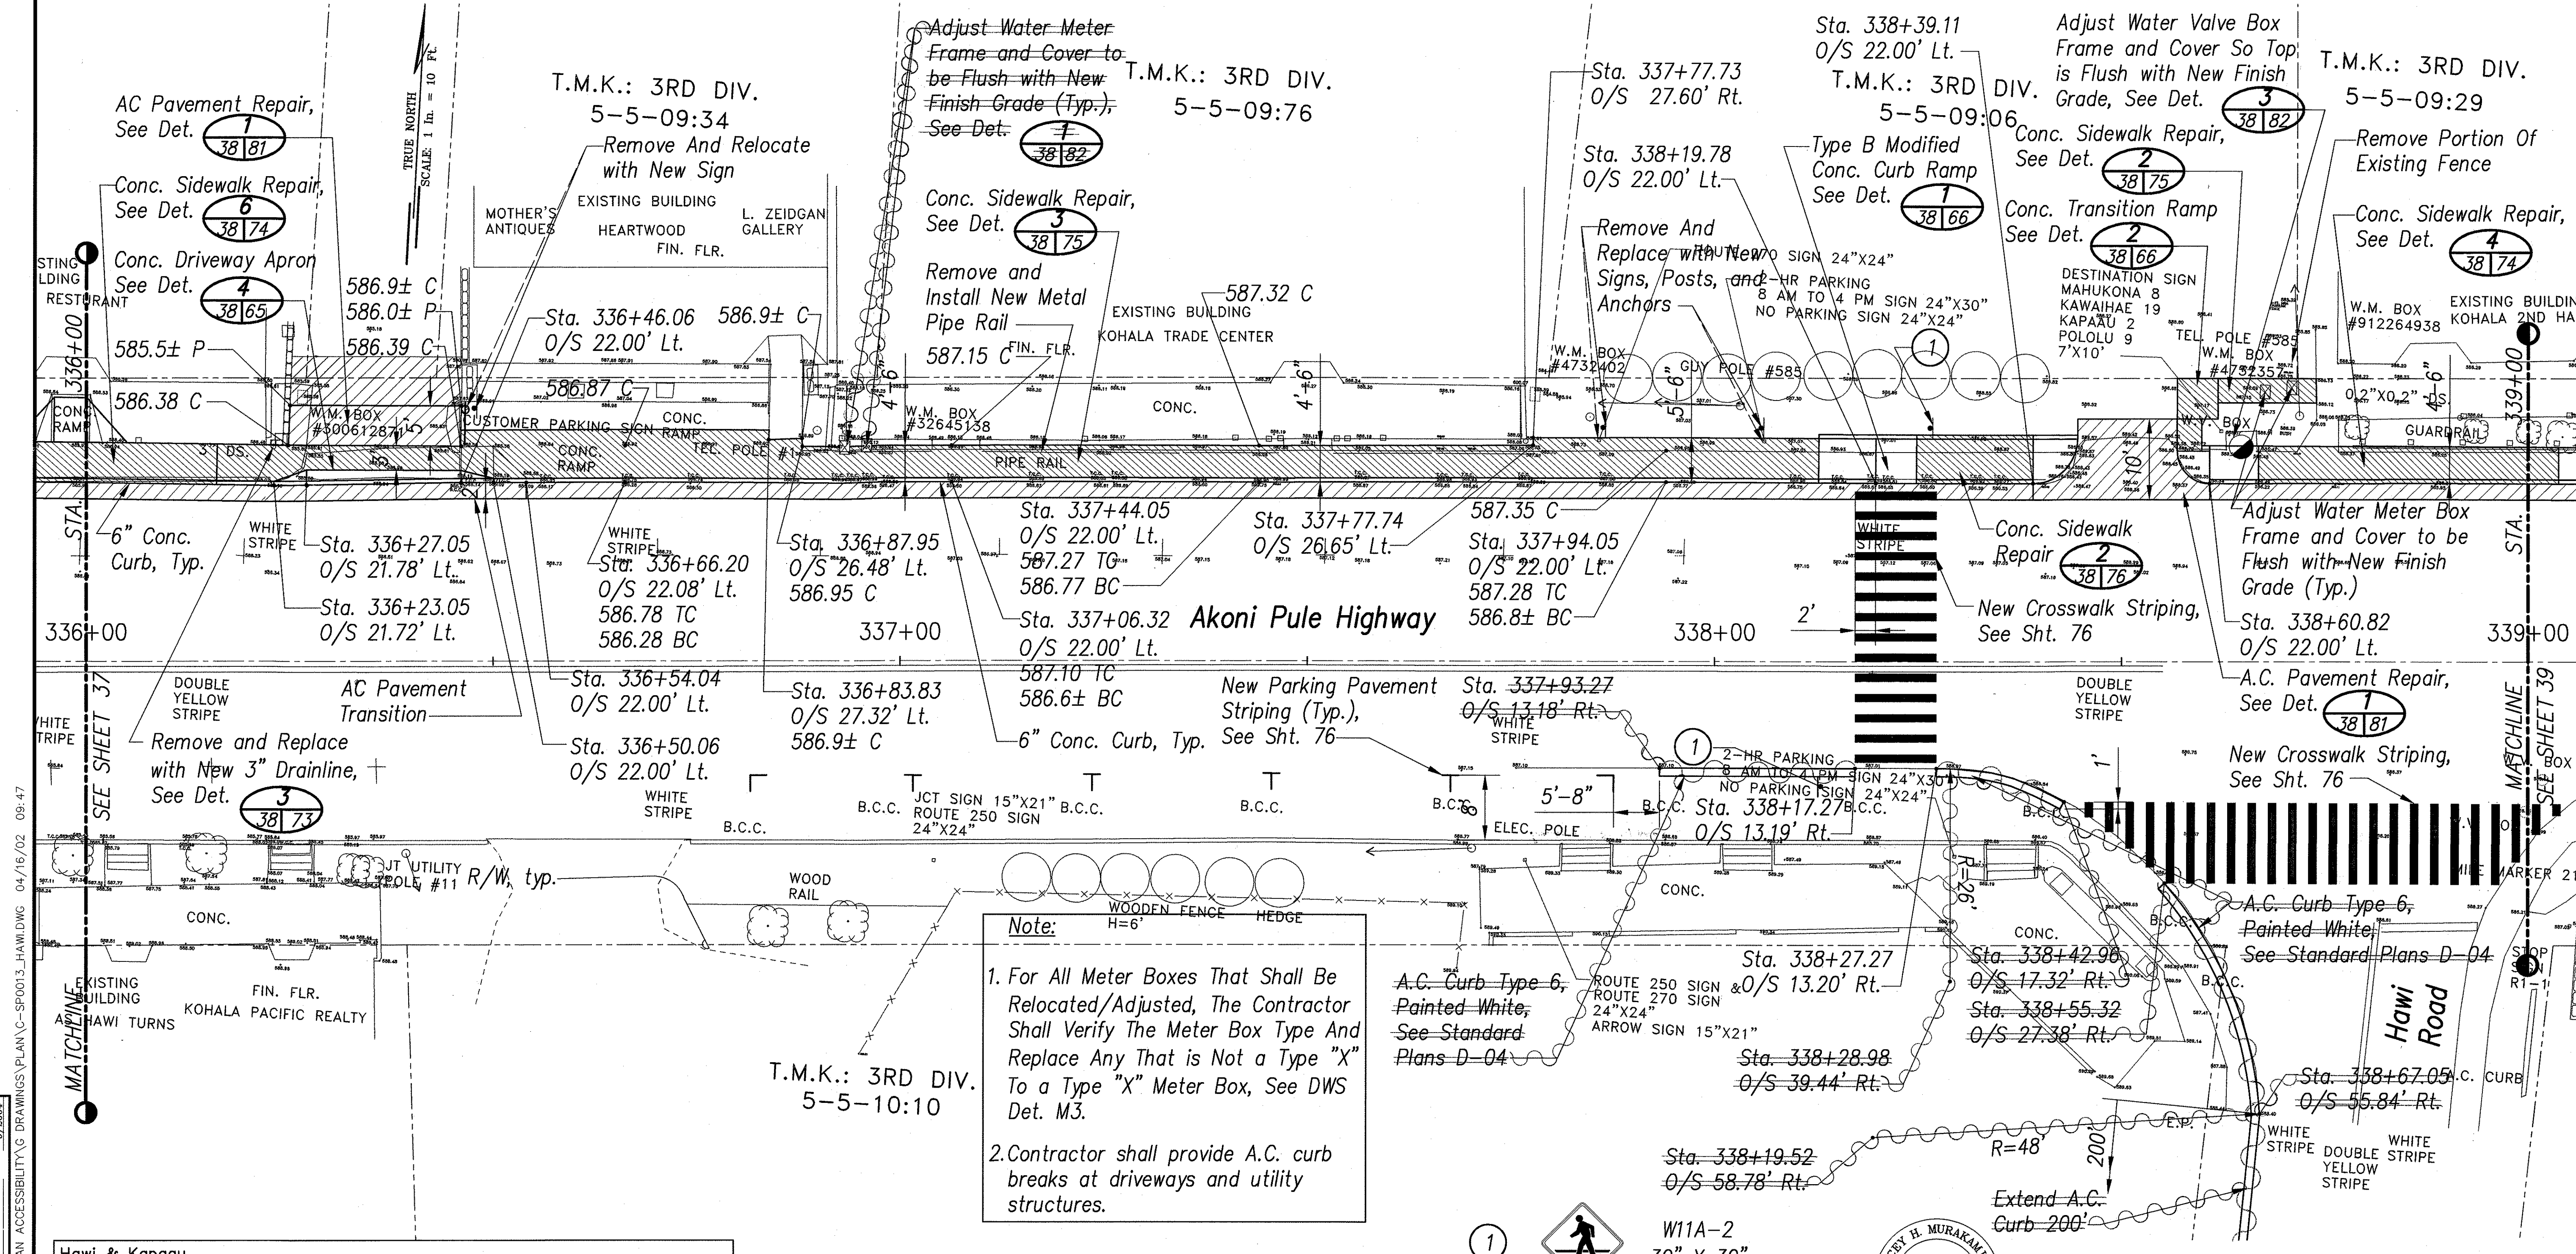

Note: WOODEN FENCE HEDGE
H=6'


1. For All Meter Boxes That Shall Be Relocated/Adjusted, The Contractor Shall Verify The Meter Box Type And Replace Any That is Not a Type "X" To a Type "X" Meter Box, See DWS Det. M3.

2. Contractor shall provide A.C. curb breaks at driveways and utility structures.

Legend:

 AC Pavement & AC Driveway Repair

 Concrete Sidewalk & Concrete Driveway Repair

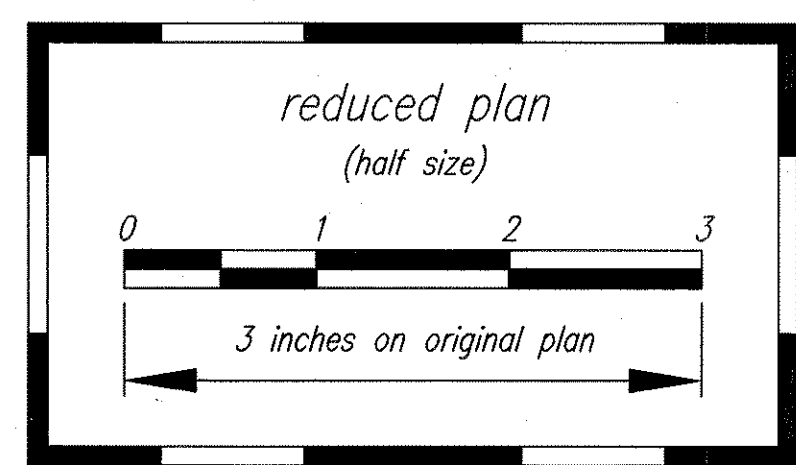



 W11A-2
 30" X 30"

Mount On New 2" Sign Post, Typ.,
 See Standard Plan TE-03

THIS WORK WAS PREPARED BY ME OR
UNDER MY SUPERVISION

Cey H. Mungfami 04/30/06


SIGNATURE EXPIRATION DATE
OF THE LICENSE

STATE OF HAWAII
DEPARTMENT OF TRANSPORTATION
HIGHWAYS DIVISION


SITE PLAN - HAWI
AKONI PULE HIGHWAY
B STA. 336+00 TO STA. 339+00
PEDESTRIAN ACCESSIBILITY ROUTE
IMPROVEMENTS - HONOKAA, HAWI, AND KAPAAU
Federal Aid Project No. CMAQ-0100(62)

Scale: AS NOTED Date: SEPT. 2004

FED. ROAD DIST. NO.	STATE	FED. AID PROJ. NO.	FISCAL YEAR	SHEET NO.	TOTAL SHEETS
HAWAII	HAW.	CMAQ-0100(62)	2004	40	86

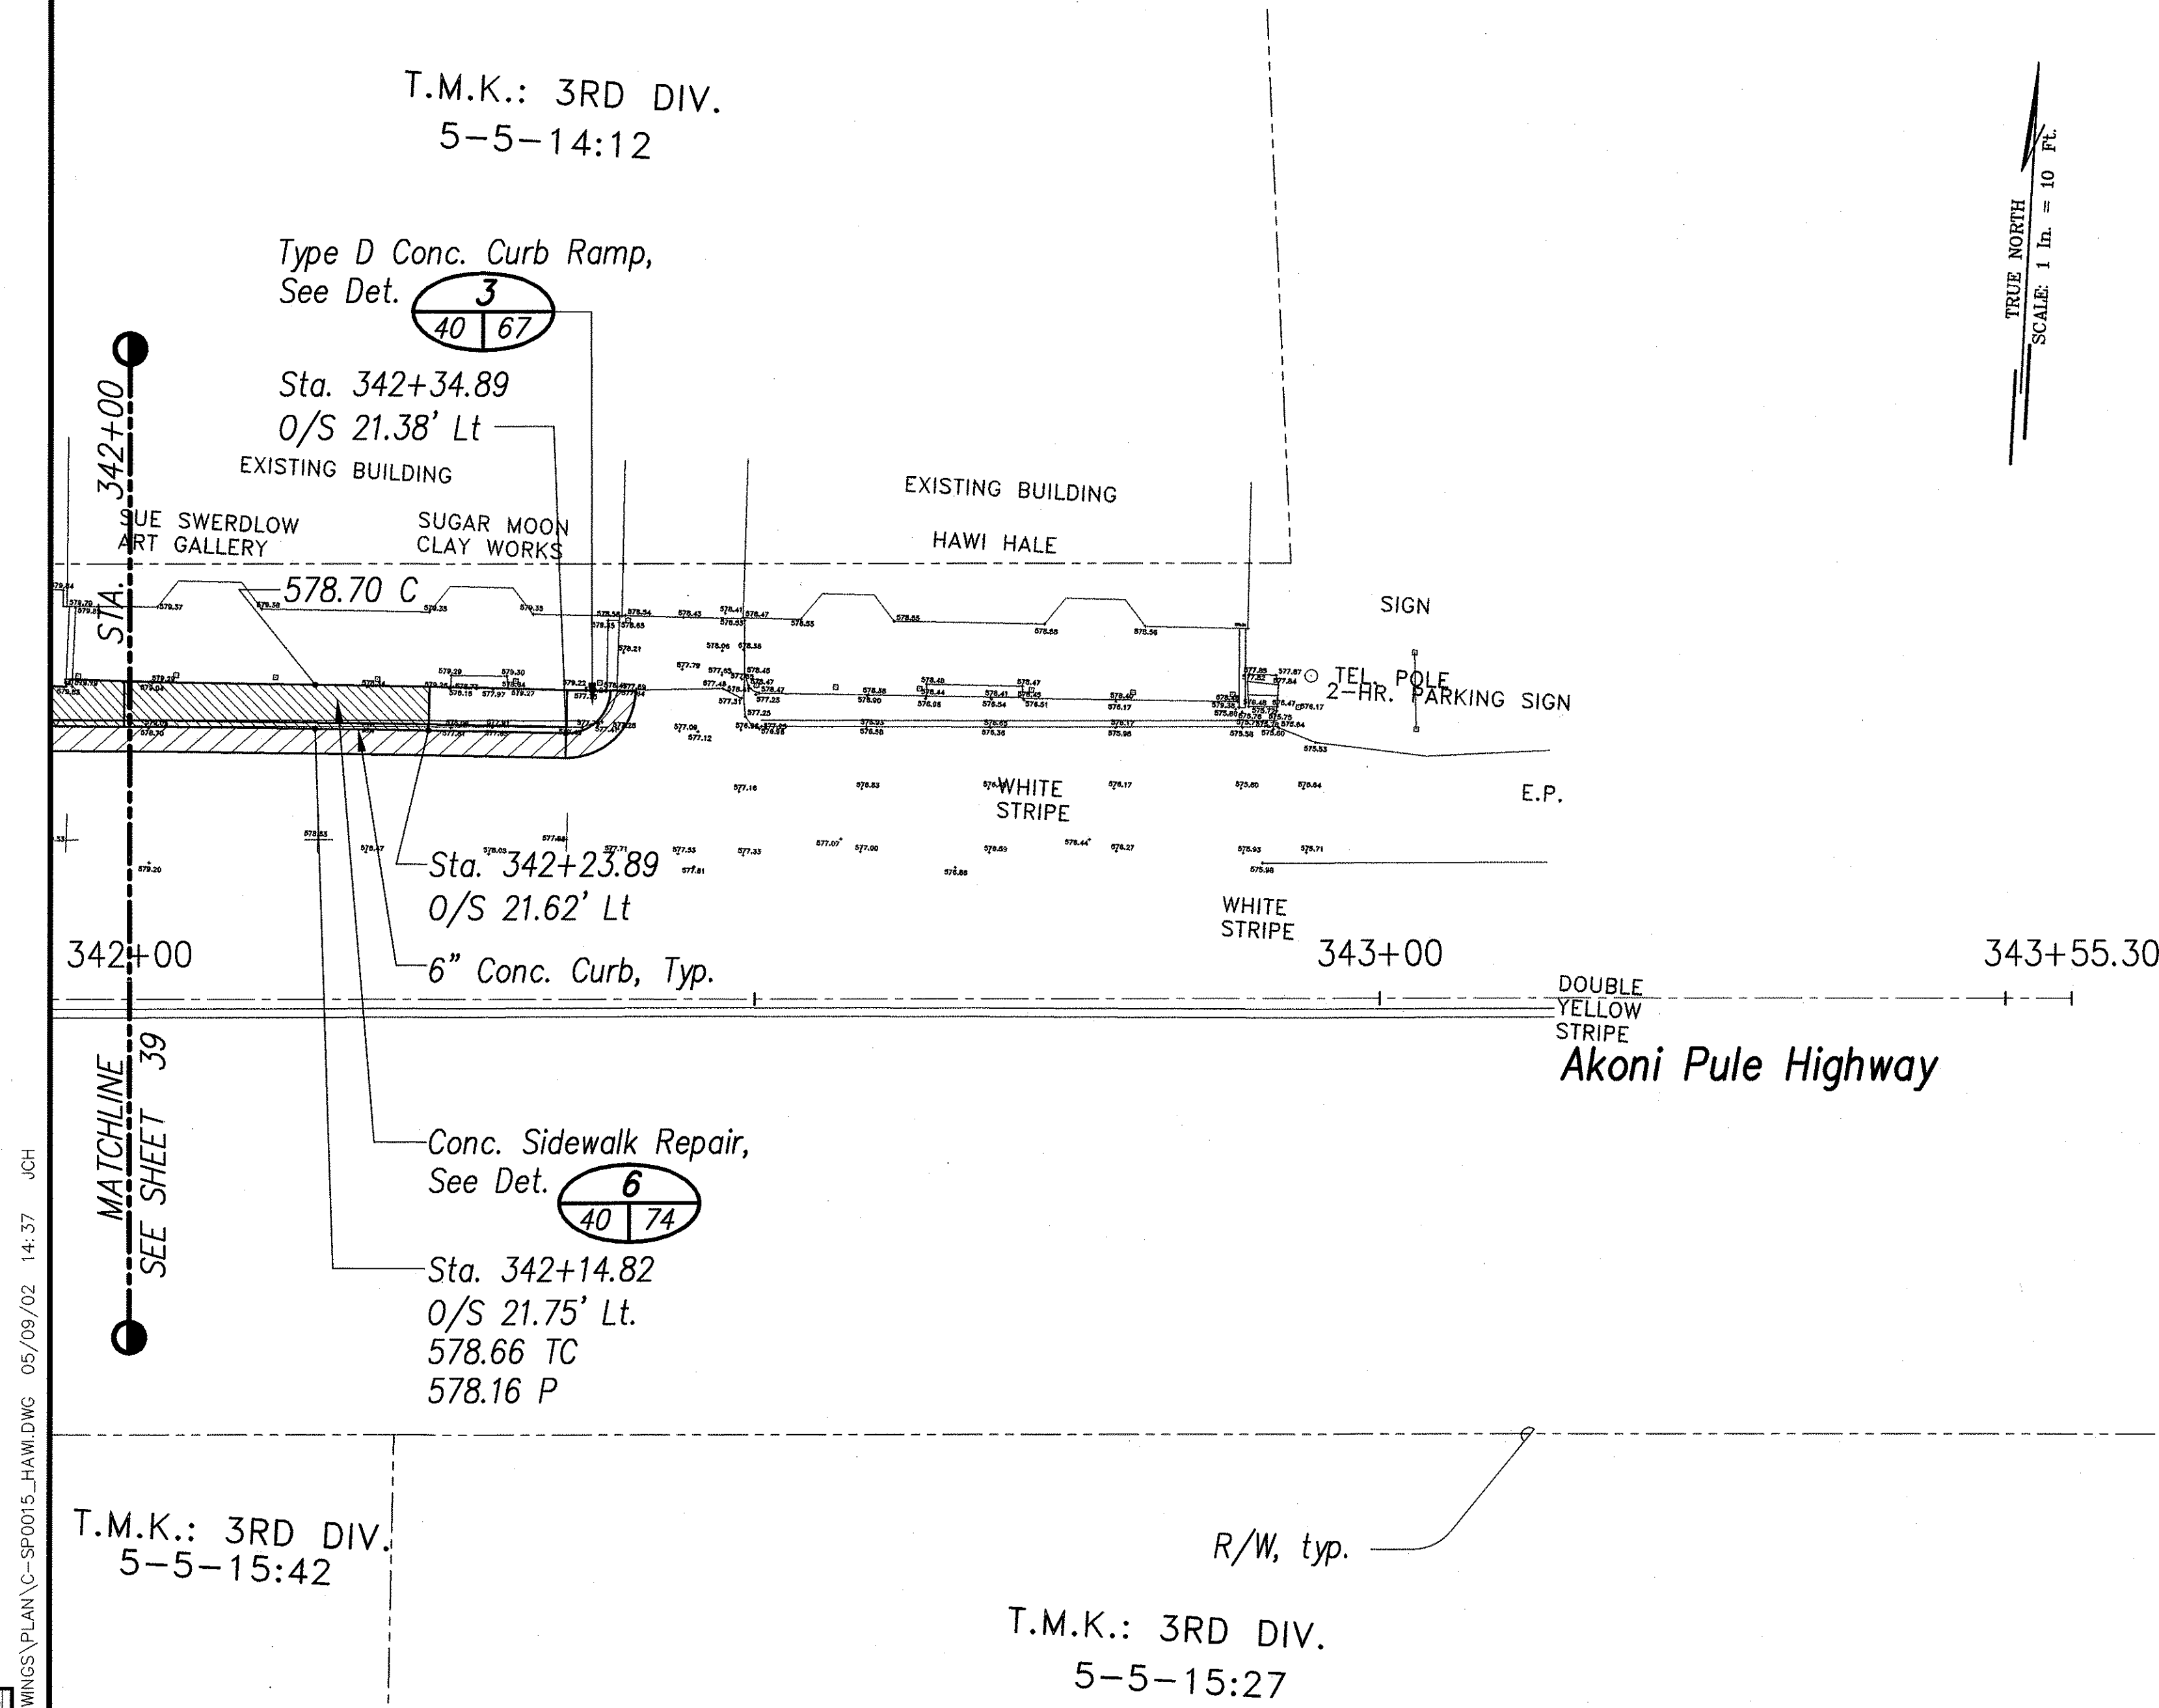


SURVEY PLOTTED BY	DATE
DRAWN BY	9/2004
DESIGNED BY	9/2004
CHECKED BY	9/2004
NO.	

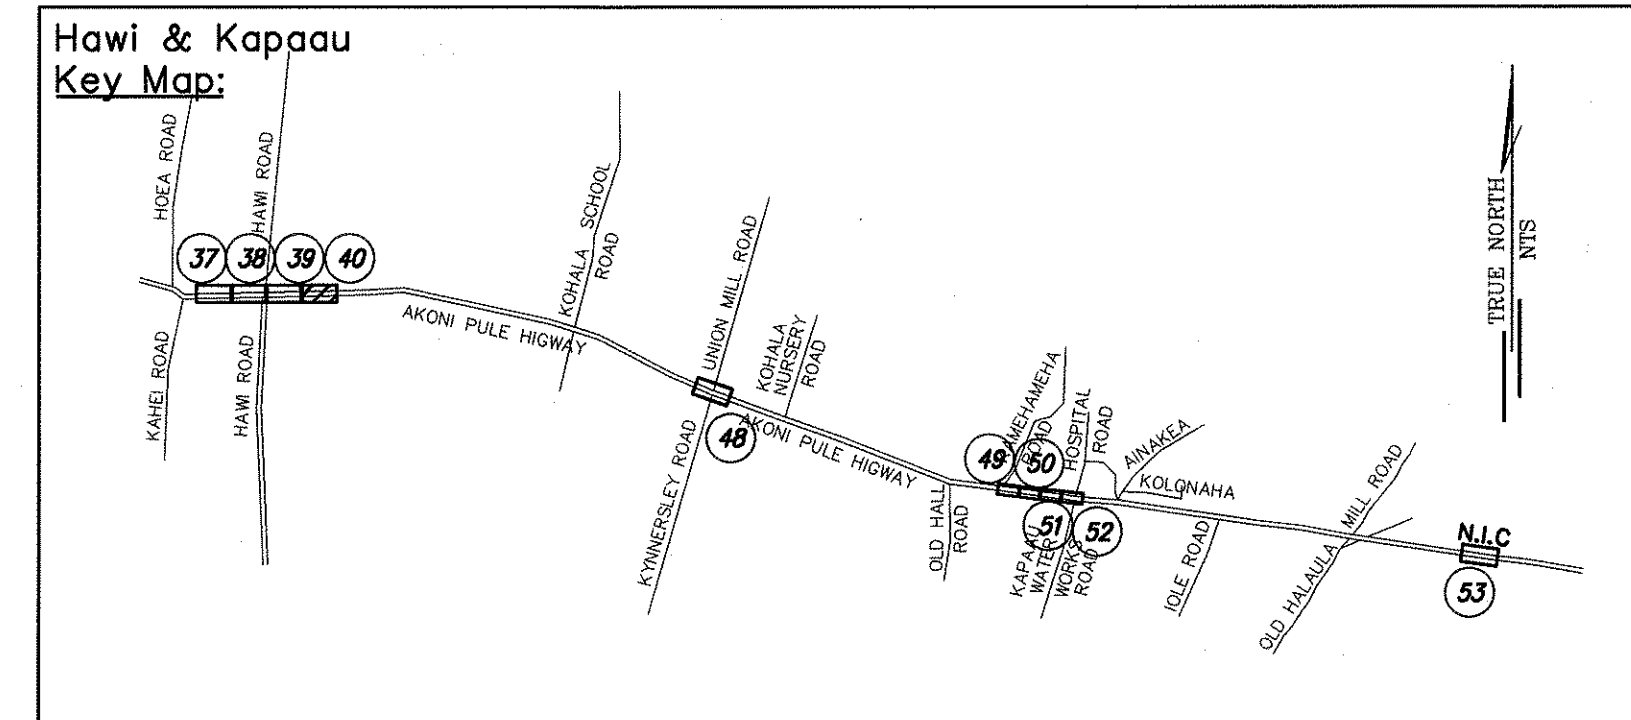

Legend:

- AC Pavement & AC Driveway Repair
- Concrete Sidewalk & Concrete Driveway Repair

SITE PLAN -- HAWI
SCALE: 1" = 10'

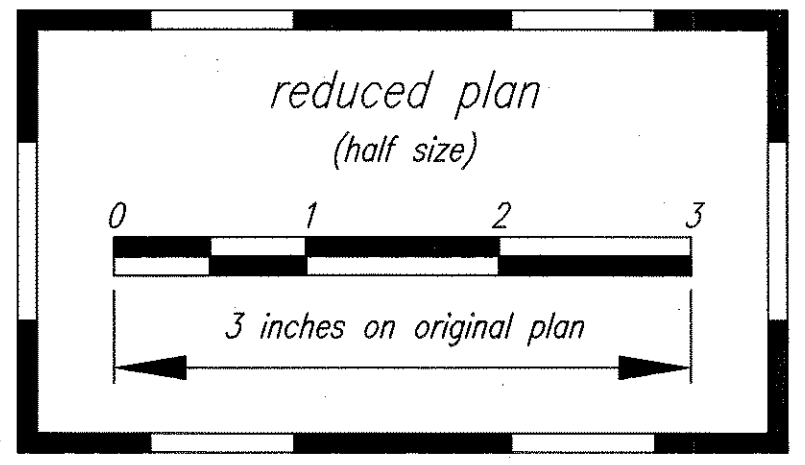

CEY H. MURAKAMI
LICENSED PROFESSIONAL ENGINEER
NO. 9763-C
HAWAII USA

THIS WORK WAS PREPARED BY ME OR UNDER MY SUPERVISION

Cey H. Murakami 04/30/06
SIGNATURE EXPIRATION DATE OF THE LICENSE

STATE OF HAWAII
DEPARTMENT OF TRANSPORTATION
HIGHWAYS DIVISION

SITE PLAN -- HAWI
AKONI PULE HIGHWAY
STA. 342+00 TO STA. 343+00
PEDESTRIAN ACCESSIBILITY ROUTE IMPROVEMENTS - HONOKAA, HAWI, AND KAPAAU
Federal Aid Project No. CMAQ-0100(62)

Scale: AS NOTED Date: SEPT. 2004

SHEET No. 40 OF 86 SHEETS