

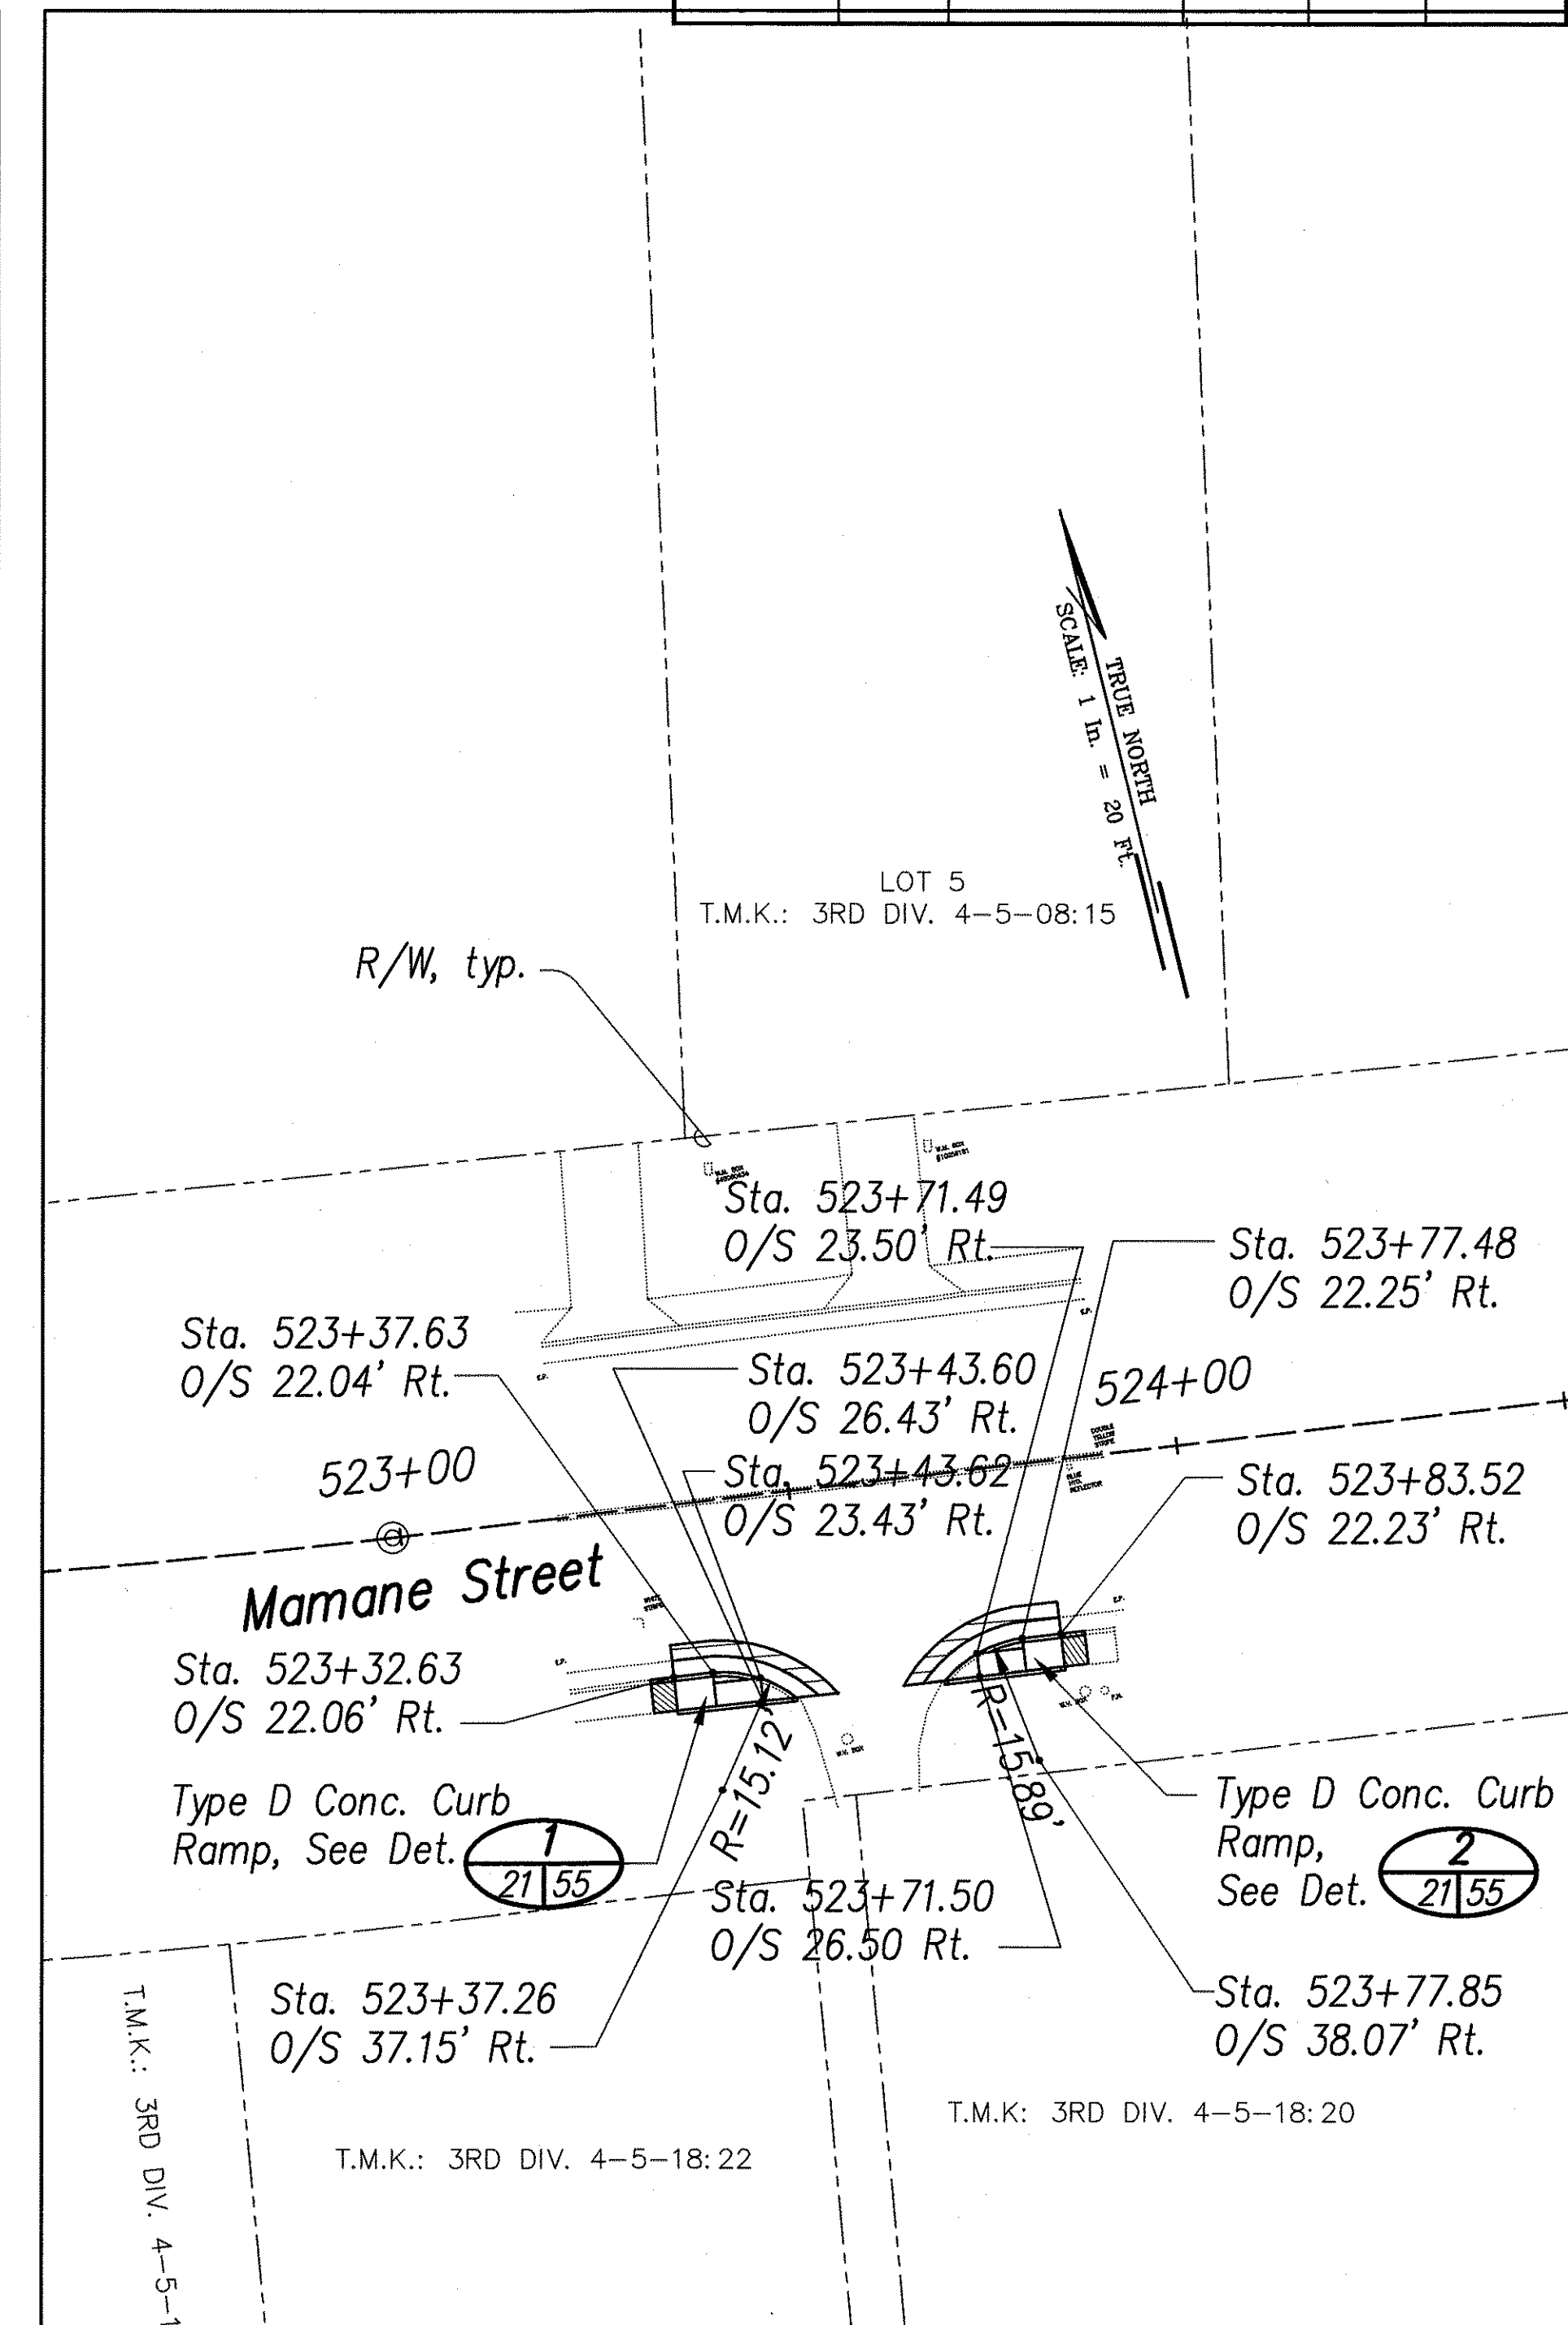
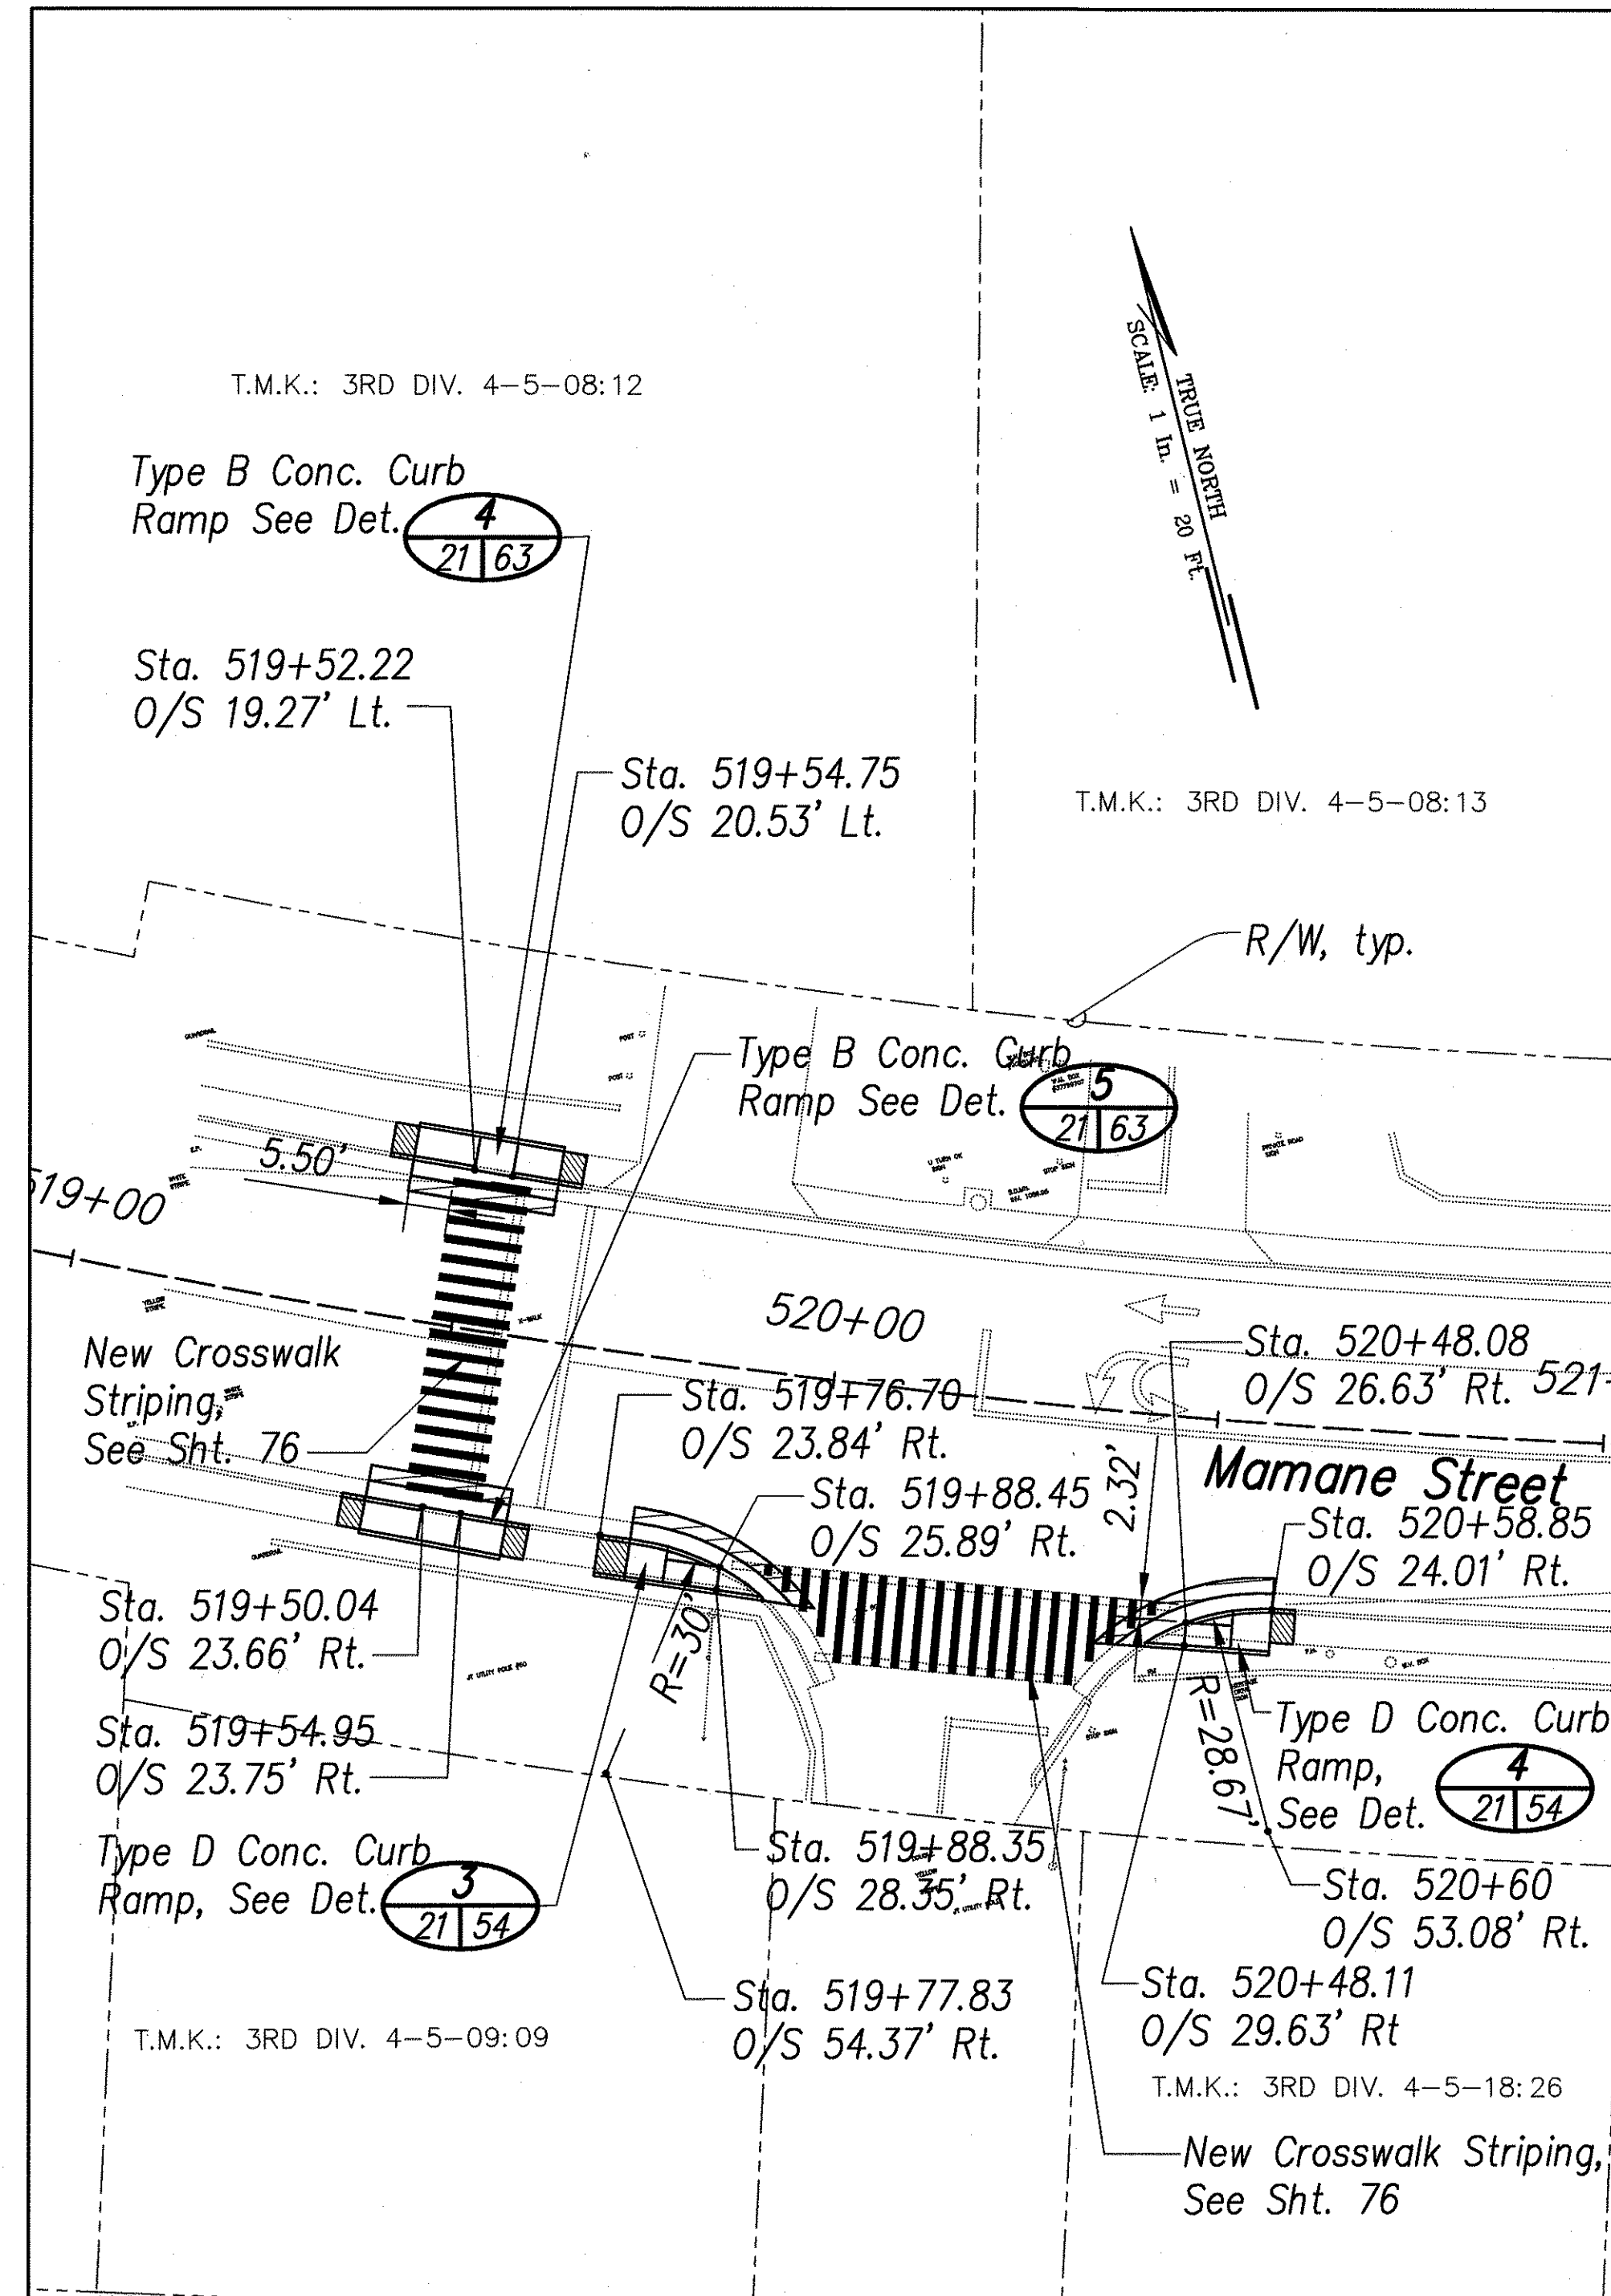


FED. ROAD DIST. NO.	STATE	FED. AID PROJ. NO.	FISCAL YEAR	SHEET NO.	TOTAL SHEETS
HAWAII	HAW.	CMAQ-0100(62)	2004	21	86

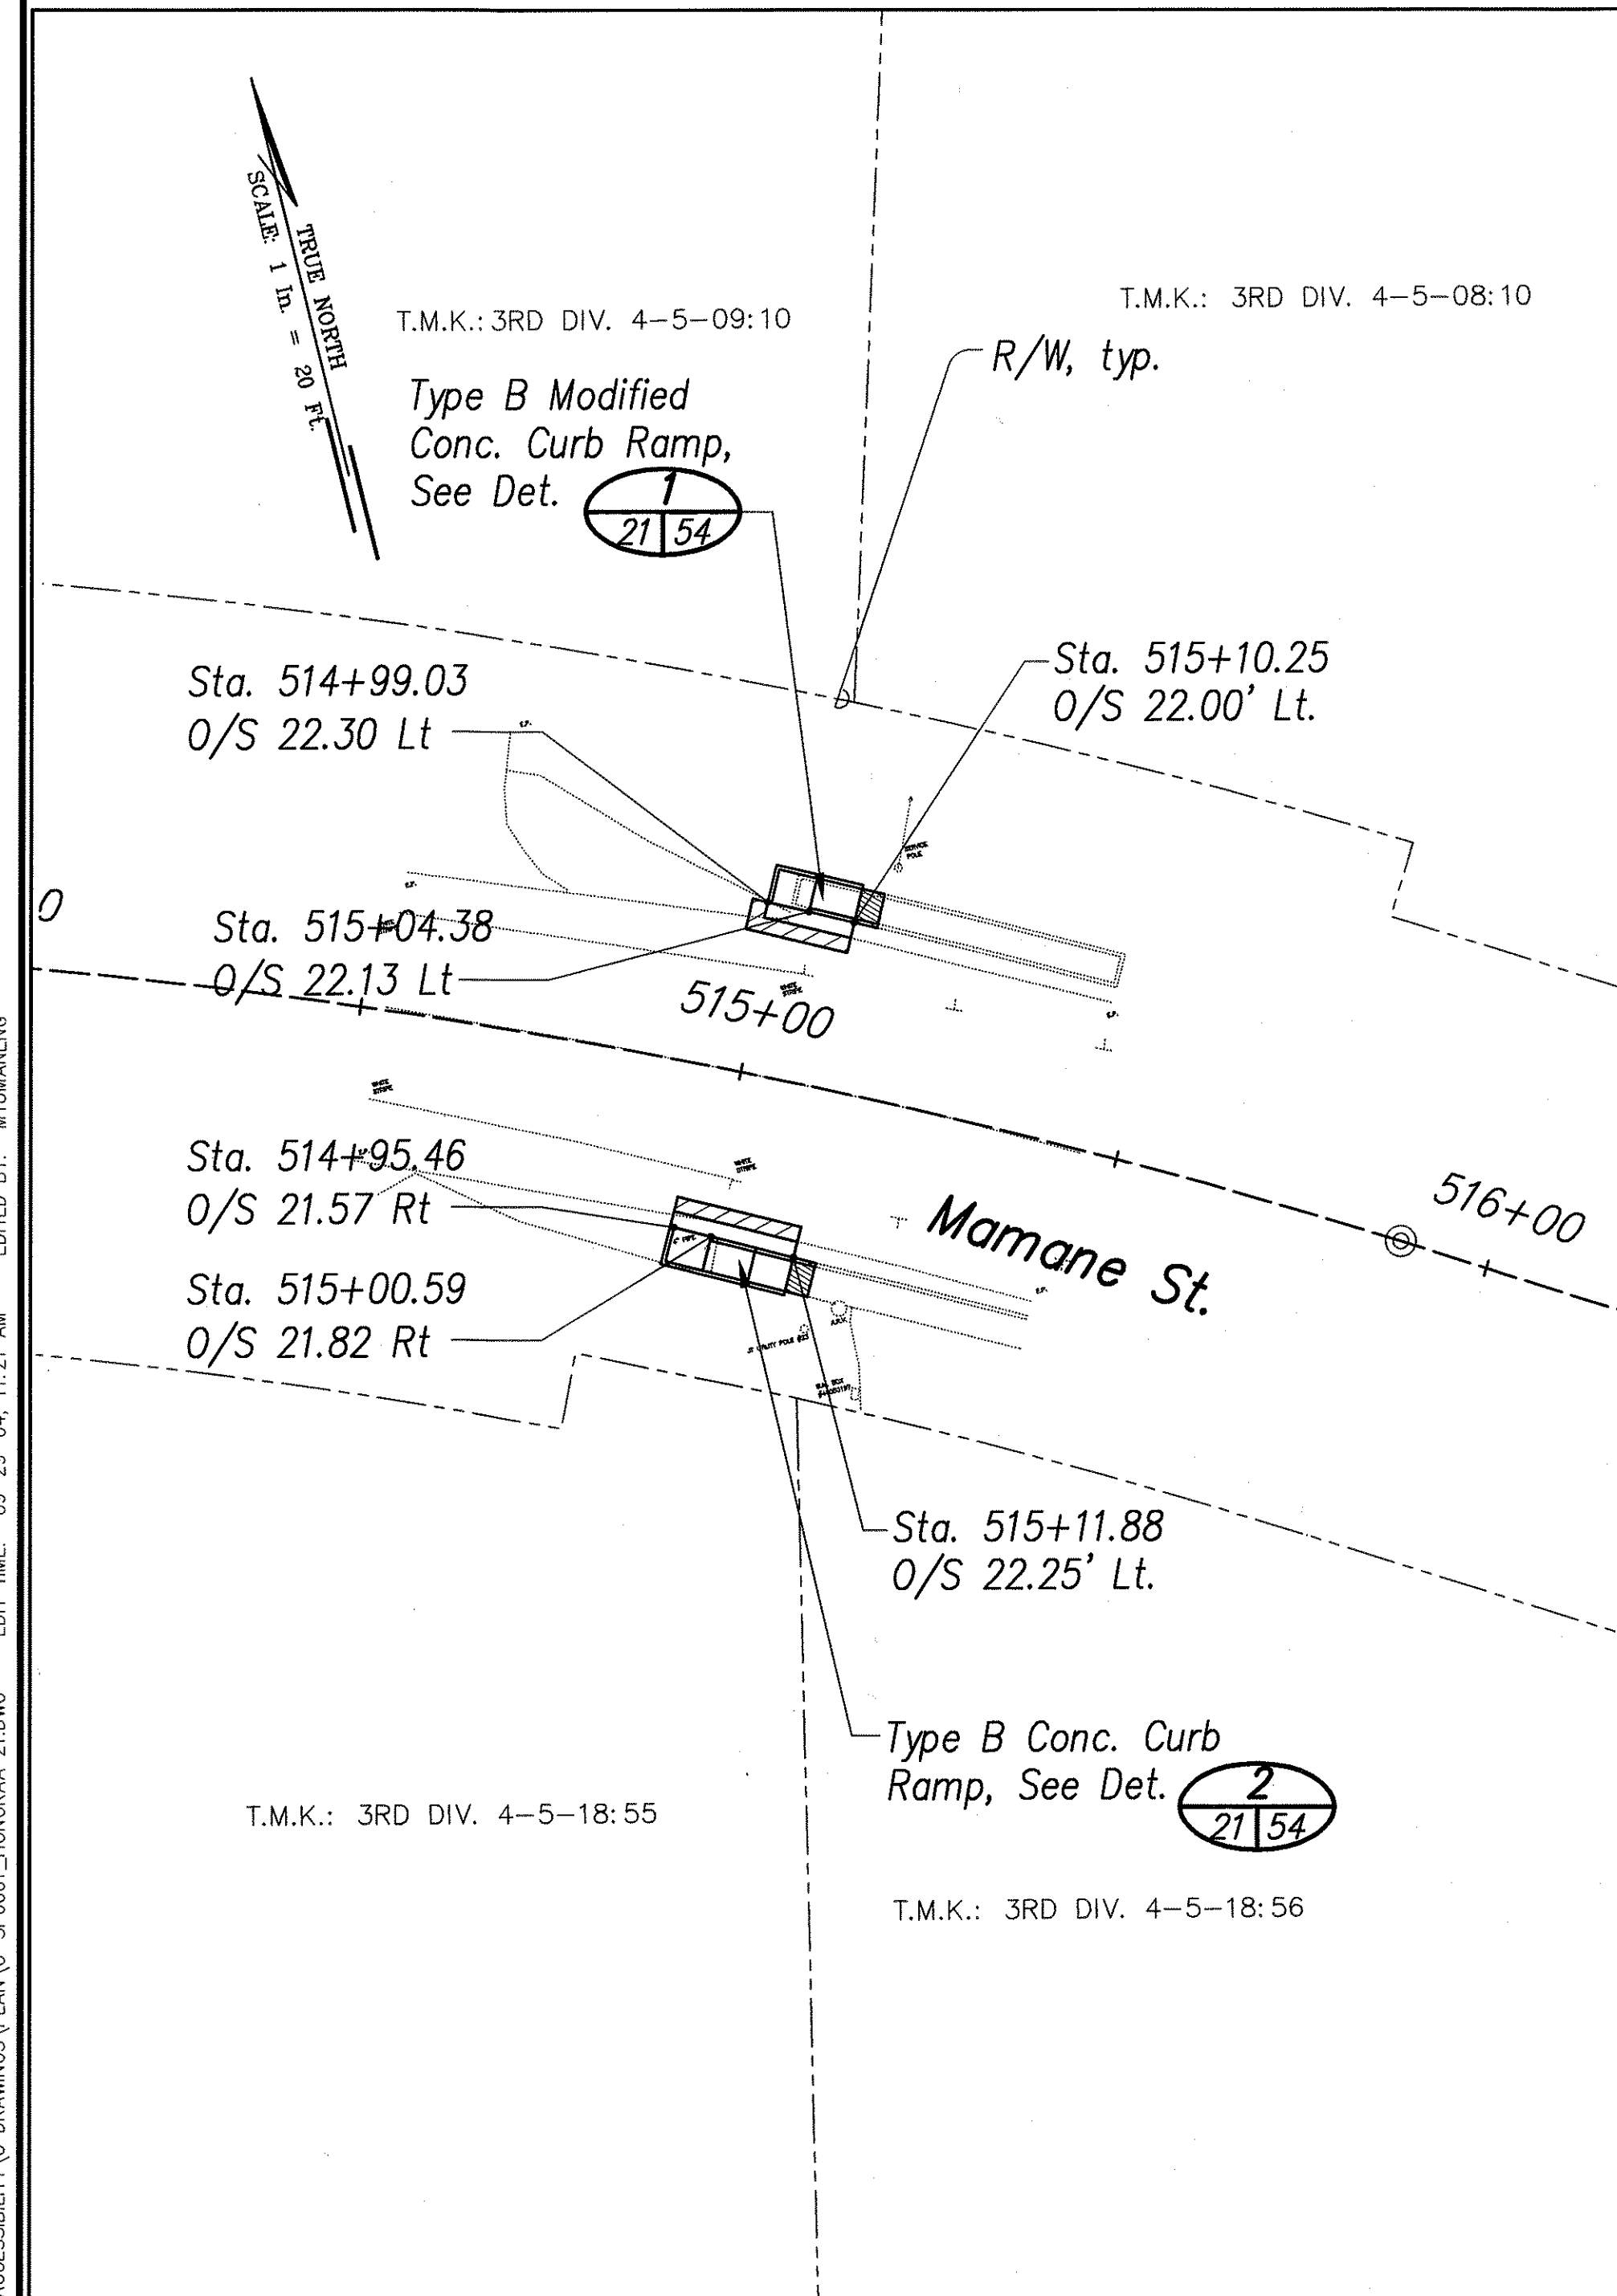

ORIGINAL PLAN	DATE
DESIGNED BY	9/2004
DESIGNED BY	9/2004


DRAWING NAME: I:\2000\2000_070.000 PROJECT POINT - PEDESTRIAN ACCESSIBILITY\DRAWINGS\PLAN\3-SP0001-HONOKAA 21.DWG EDIT TIME: 09-29-04, 11:21 AM EDITED BY: MTUMANENG

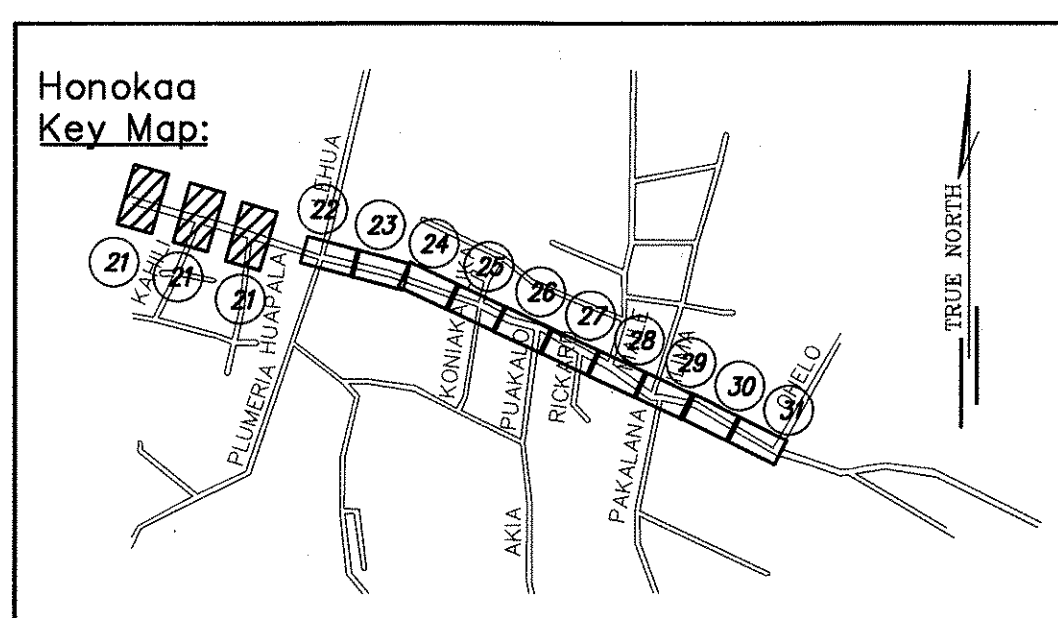

- Legend:**
- AC Pavement & AC Driveway Repair
 - Concrete Sidewalk & Concrete Driveway Repair

SITE PLAN - HONOKAA

SCALE: 1" = 20'

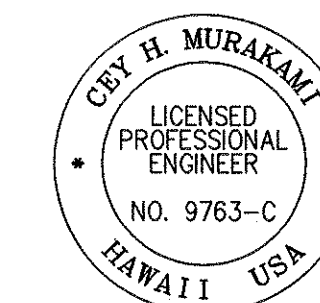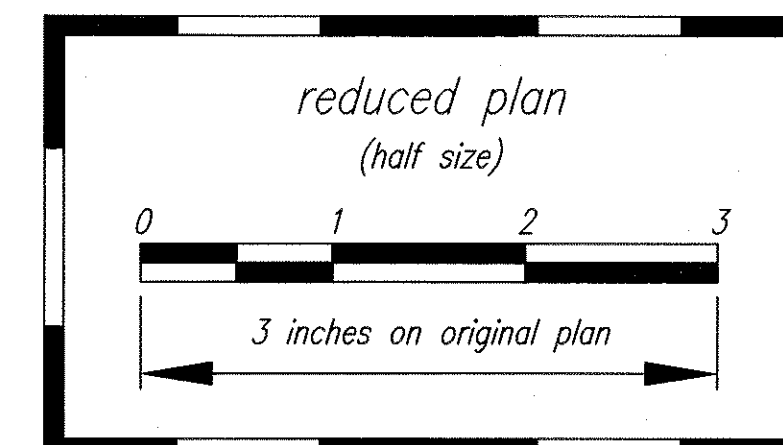

THIS WORK WAS PREPARED BY ME OR UNDER MY SUPERVISION

SIGNATURE: *Cry H. Murakami* 04/30/06
EXPIRATION DATE OF THE LICENSE

STATE OF HAWAII
DEPARTMENT OF TRANSPORTATION
HIGHWAYS DIVISION


SITE PLAN - HONOKAA
MAMANE ST.
STA. 515+00 TO STA. 524+00
PEDESTRIAN ACCESSIBILITY ROUTE
IMPROVEMENTS - HONOKAA, HAWAII, AND KAPAAU
Federal Aid Project No. CMAQ-0100(62)
Scale: AS NOTED Date: SEPT. 2004

SHEET No. 21 OF 86 SHEETS

FED. ROAD DIST. NO.	STATE	FED. AID PROJ. NO.	FISCAL YEAR	SHEET NO.	TOTAL SHEETS
HAWAII	HAW.	CMAQ-0100(62)	2004	22	86

DRAWING NAME: I:\2000\2000_070000 PROJECT POINT - PEDESTRIAN ACCESSIBILITY\DRAWINGS\PLAN\G-SP0002-HONOKAA 22.DWG EDIT TIME: 09-29-04, 11:21 AM EDITED BY: MUTMANENG


STUDY PLOTTED BY	DATE	9/2/2004
ORIGINAL PLAN	DATE	9/2/2004
DESIGNED BY	DATE	9/2/2004
QUANTITIES BY	DATE	9/2/2004
CHECKED BY	DATE	9/2/2004

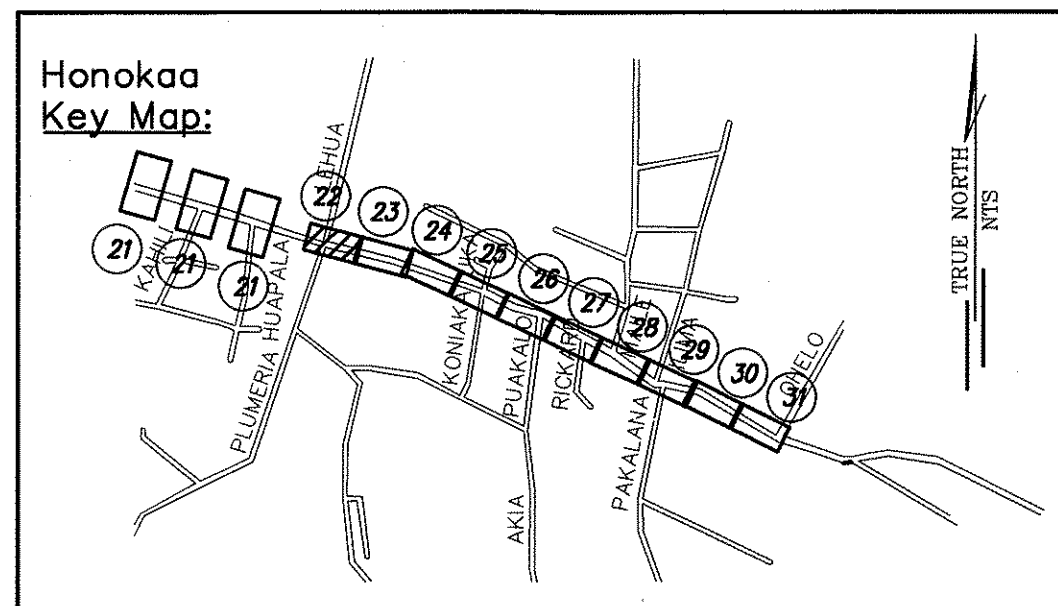

- Legend:**
- AC Pavement & AC Driveway Repair
 - Concrete Sidewalk & Concrete Driveway Repair

SITE PLAN - HONOKAA

SCALE: 1" = 10'

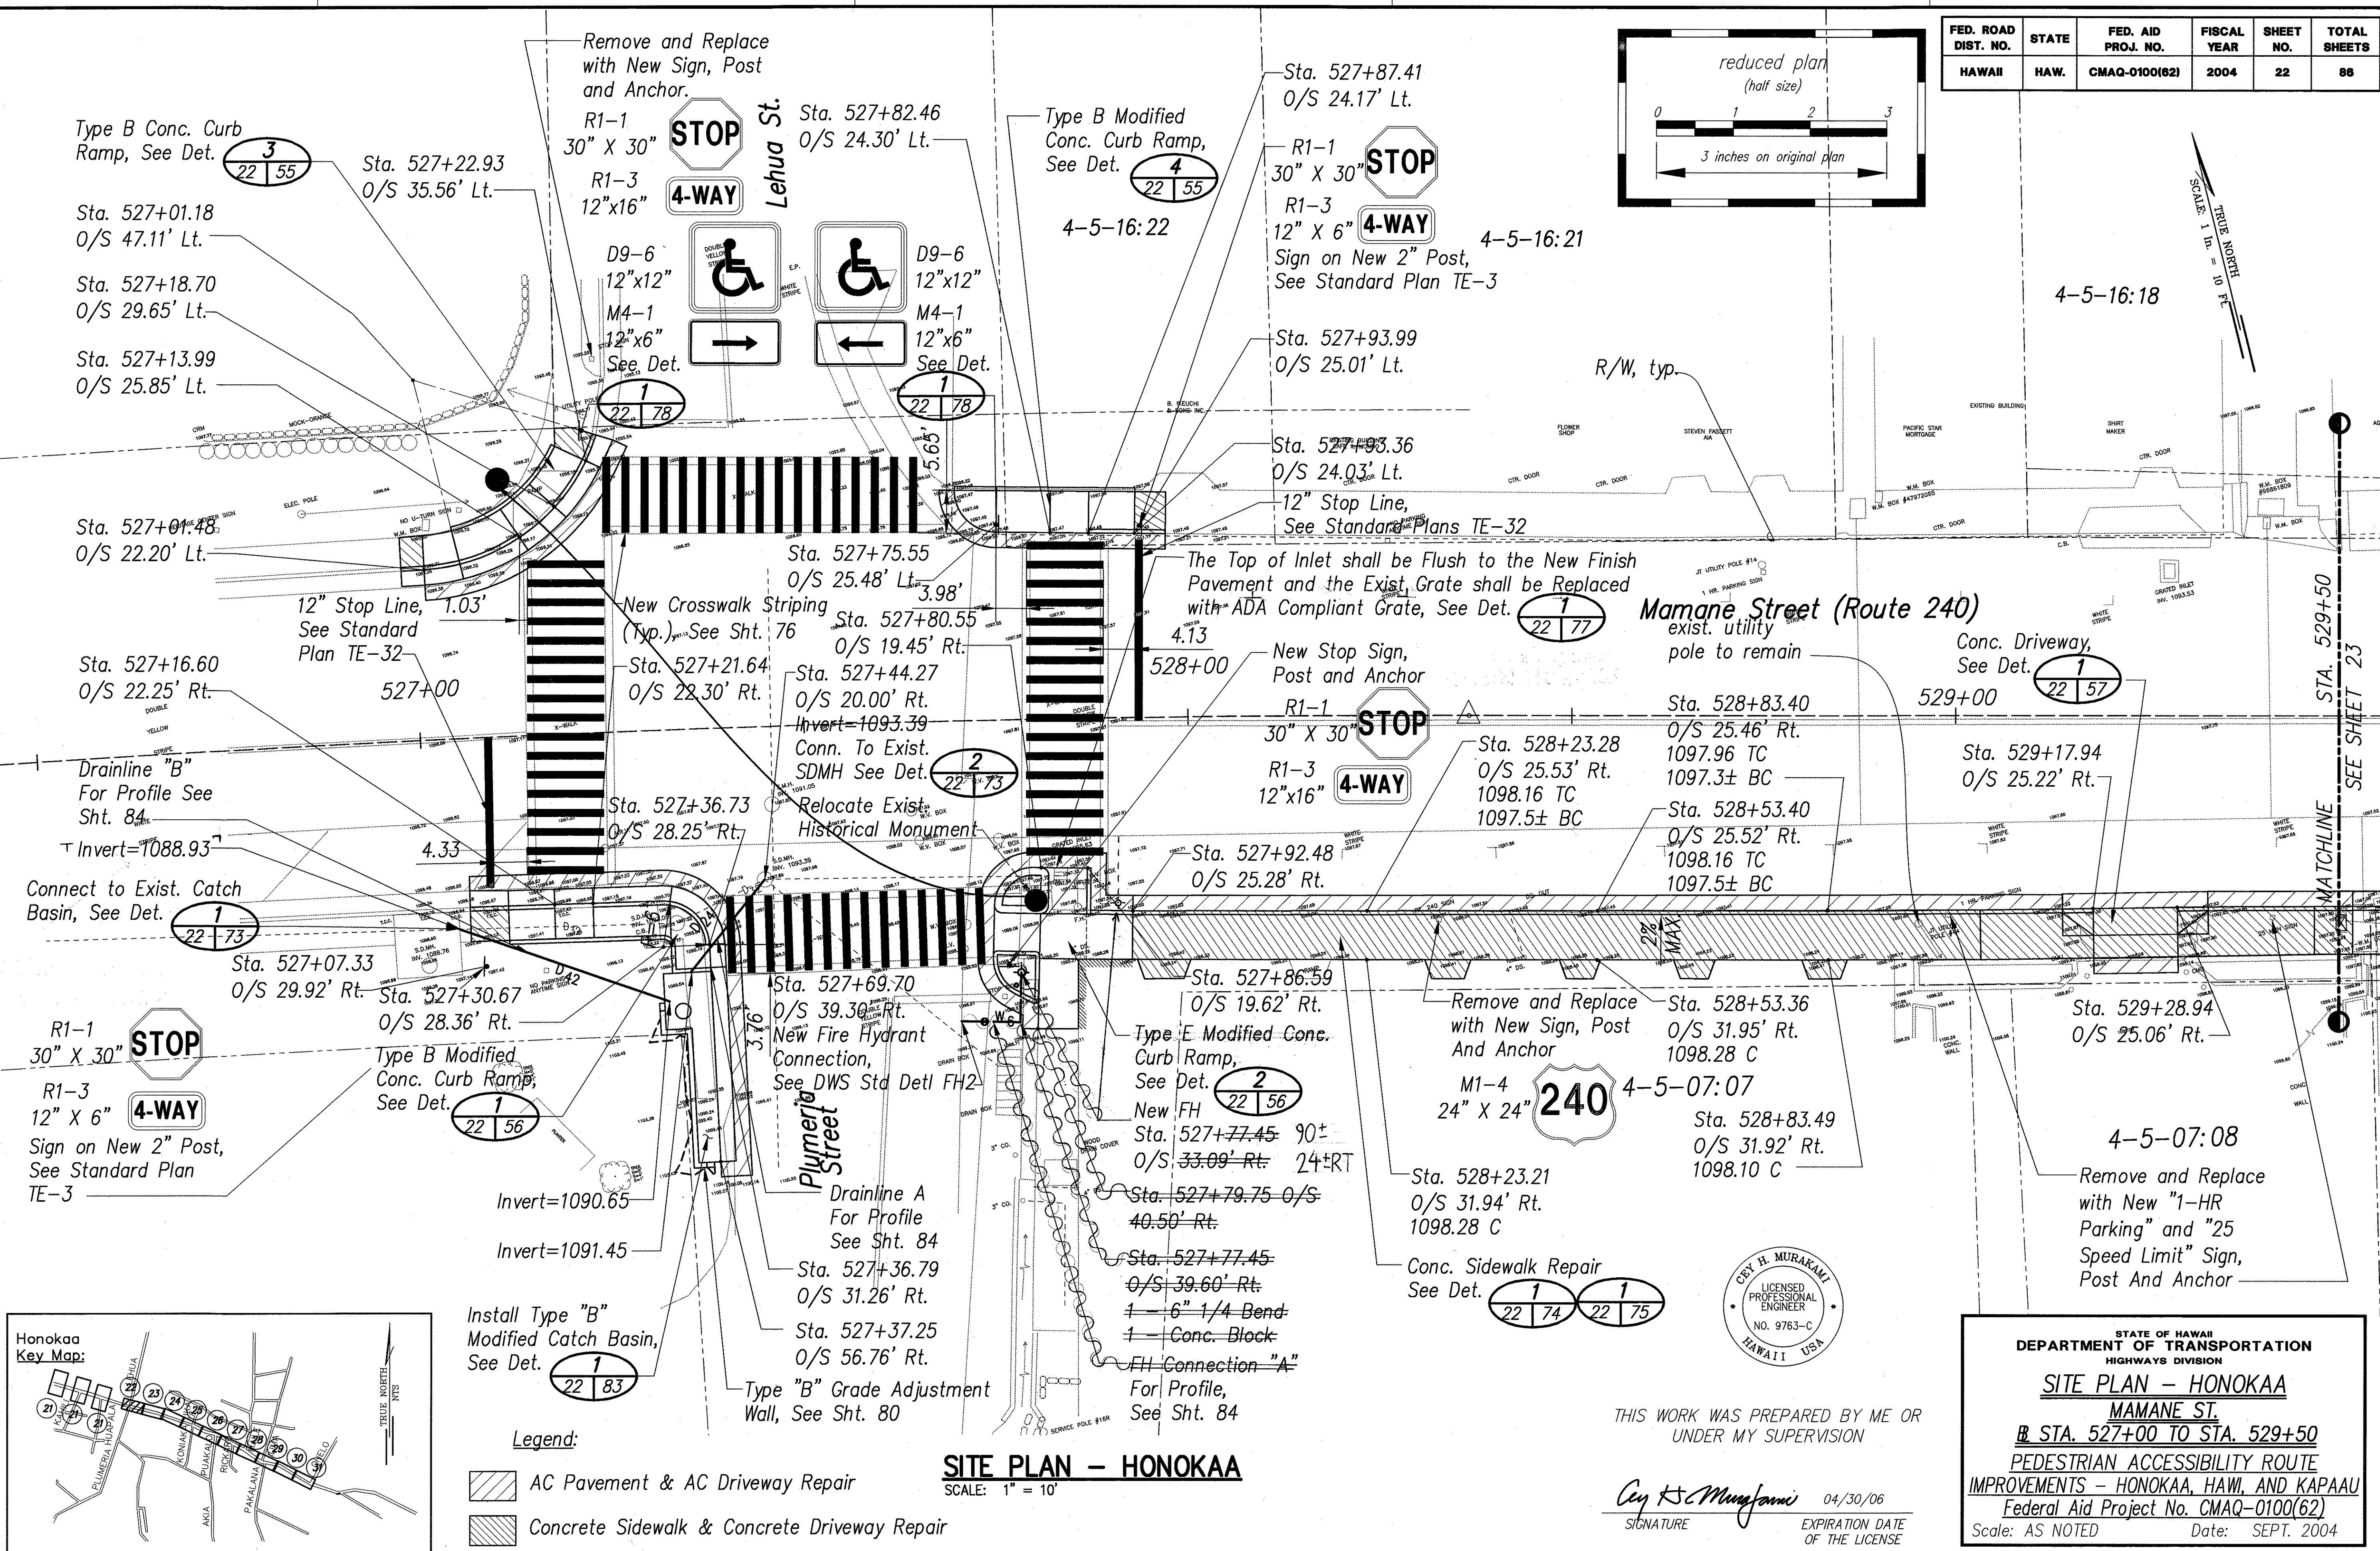

THIS WORK WAS PREPARED BY ME OR UNDER MY SUPERVISION

Cey H. Mungfani 04/30/06
SIGNATURE EXPIRATION DATE OF THE LICENSE

"AS-BUILT"

STATE OF HAWAII
DEPARTMENT OF TRANSPORTATION
HIGHWAYS DIVISION

SITE PLAN - HONOKAA
MAMANE ST.
STA. 527+00 TO STA. 529+50
PEDESTRIAN ACCESSIBILITY ROUTE IMPROVEMENTS - HONOKAA, HAWAII, AND KAPA AU
Federal Aid Project No. CMAQ-0100(62)
Scale: AS NOTED Date: SEPT. 2004


SHEET No. 22 OF 86 SHEETS

FED. ROAD DIST. NO.	STATE	FED. AID PROJ. NO.	FISCAL YEAR	SHEET NO.	TOTAL SHEETS
HAWAII	HAW.	CMAQ-0100(62)	2004	24	86

Note:
For All Meter Boxes That Shall Be Relocated/Adjusted, The Contractor Shall Verify The Meter Box Type And Replace Any That is Not a Type "X" To a Type "X" Meter Box, See DWS Det. M3.

DRAWING NAME: 1. 2000/2000-070000 PROJECT POINT - PEDESTRIAN ACCESSIBILITY DRAWINGS PLAN C-SP0004 HONOKAA 24.DWG
EDIT TIME: 09-29-04, 11:22 AM
EDITED BY: MTUWANEV
MATCHLINE SEE SHEET 23
STA. 532+50
MATCHLINE SEE SHEET 25
STA. 535+50


DATE	BY	REVISION
9/2004	DL	ORIGINAL PLAN
9/2004	CM	REVISION
9/2004	TC	QUANTITIES BY
9/2004	ES	CHECKED BY

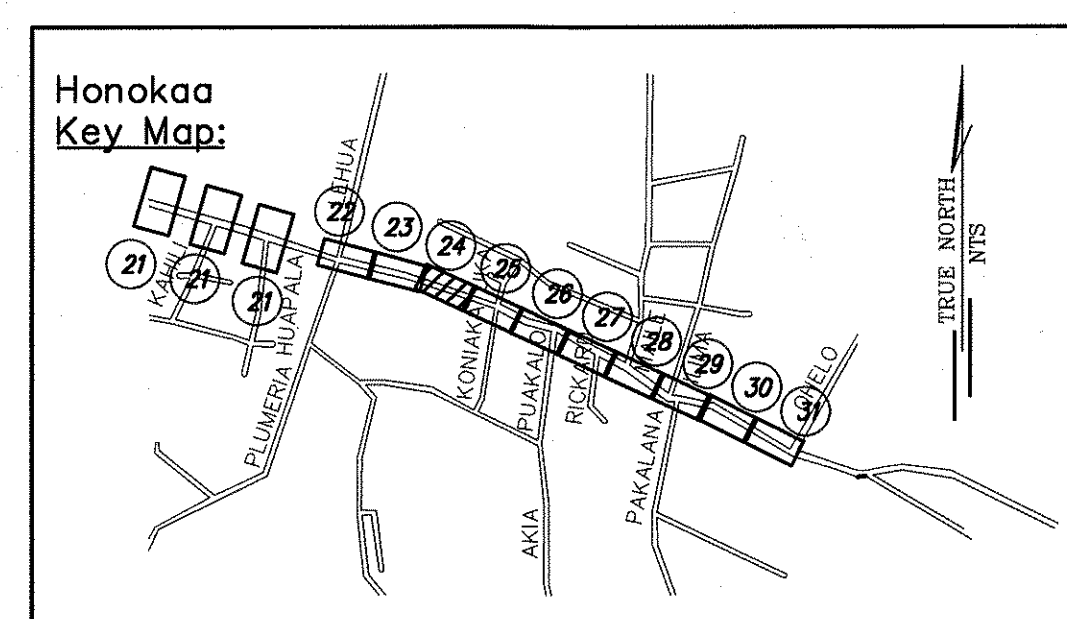

- Legend:**
- AC Pavement & AC Driveway Repair
 - Concrete Sidewalk & Concrete Driveway Repair


SITE PLAN - HONOKAA

SCALE: 1" = 10'

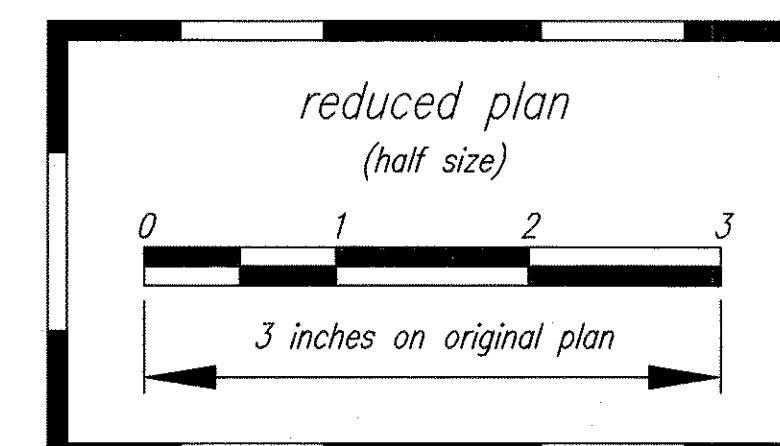

THIS WORK WAS PREPARED BY ME OR UNDER MY SUPERVISION

Cey H. Murakami 04/30/06
SIGNATURE EXPIRATION DATE OF THE LICENSE

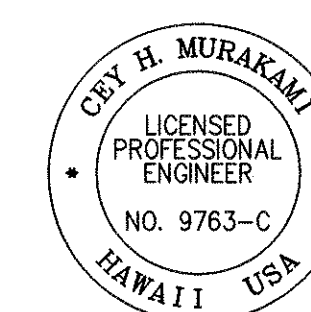


STATE OF HAWAII
DEPARTMENT OF TRANSPORTATION
HIGHWAYS DIVISION

SITE PLAN - HONOKAA
MAMANE ST.
B STA. 532+50 TO STA. 535+50
PEDESTRIAN ACCESSIBILITY ROUTE IMPROVEMENTS - HONOKAA, HAWAII, AND KAPAAU
Federal Aid Project No. CMAQ-0100(62)

Scale: AS NOTED Date: SEPT. 2004

SHEET No. 24 OF 86 SHEETS

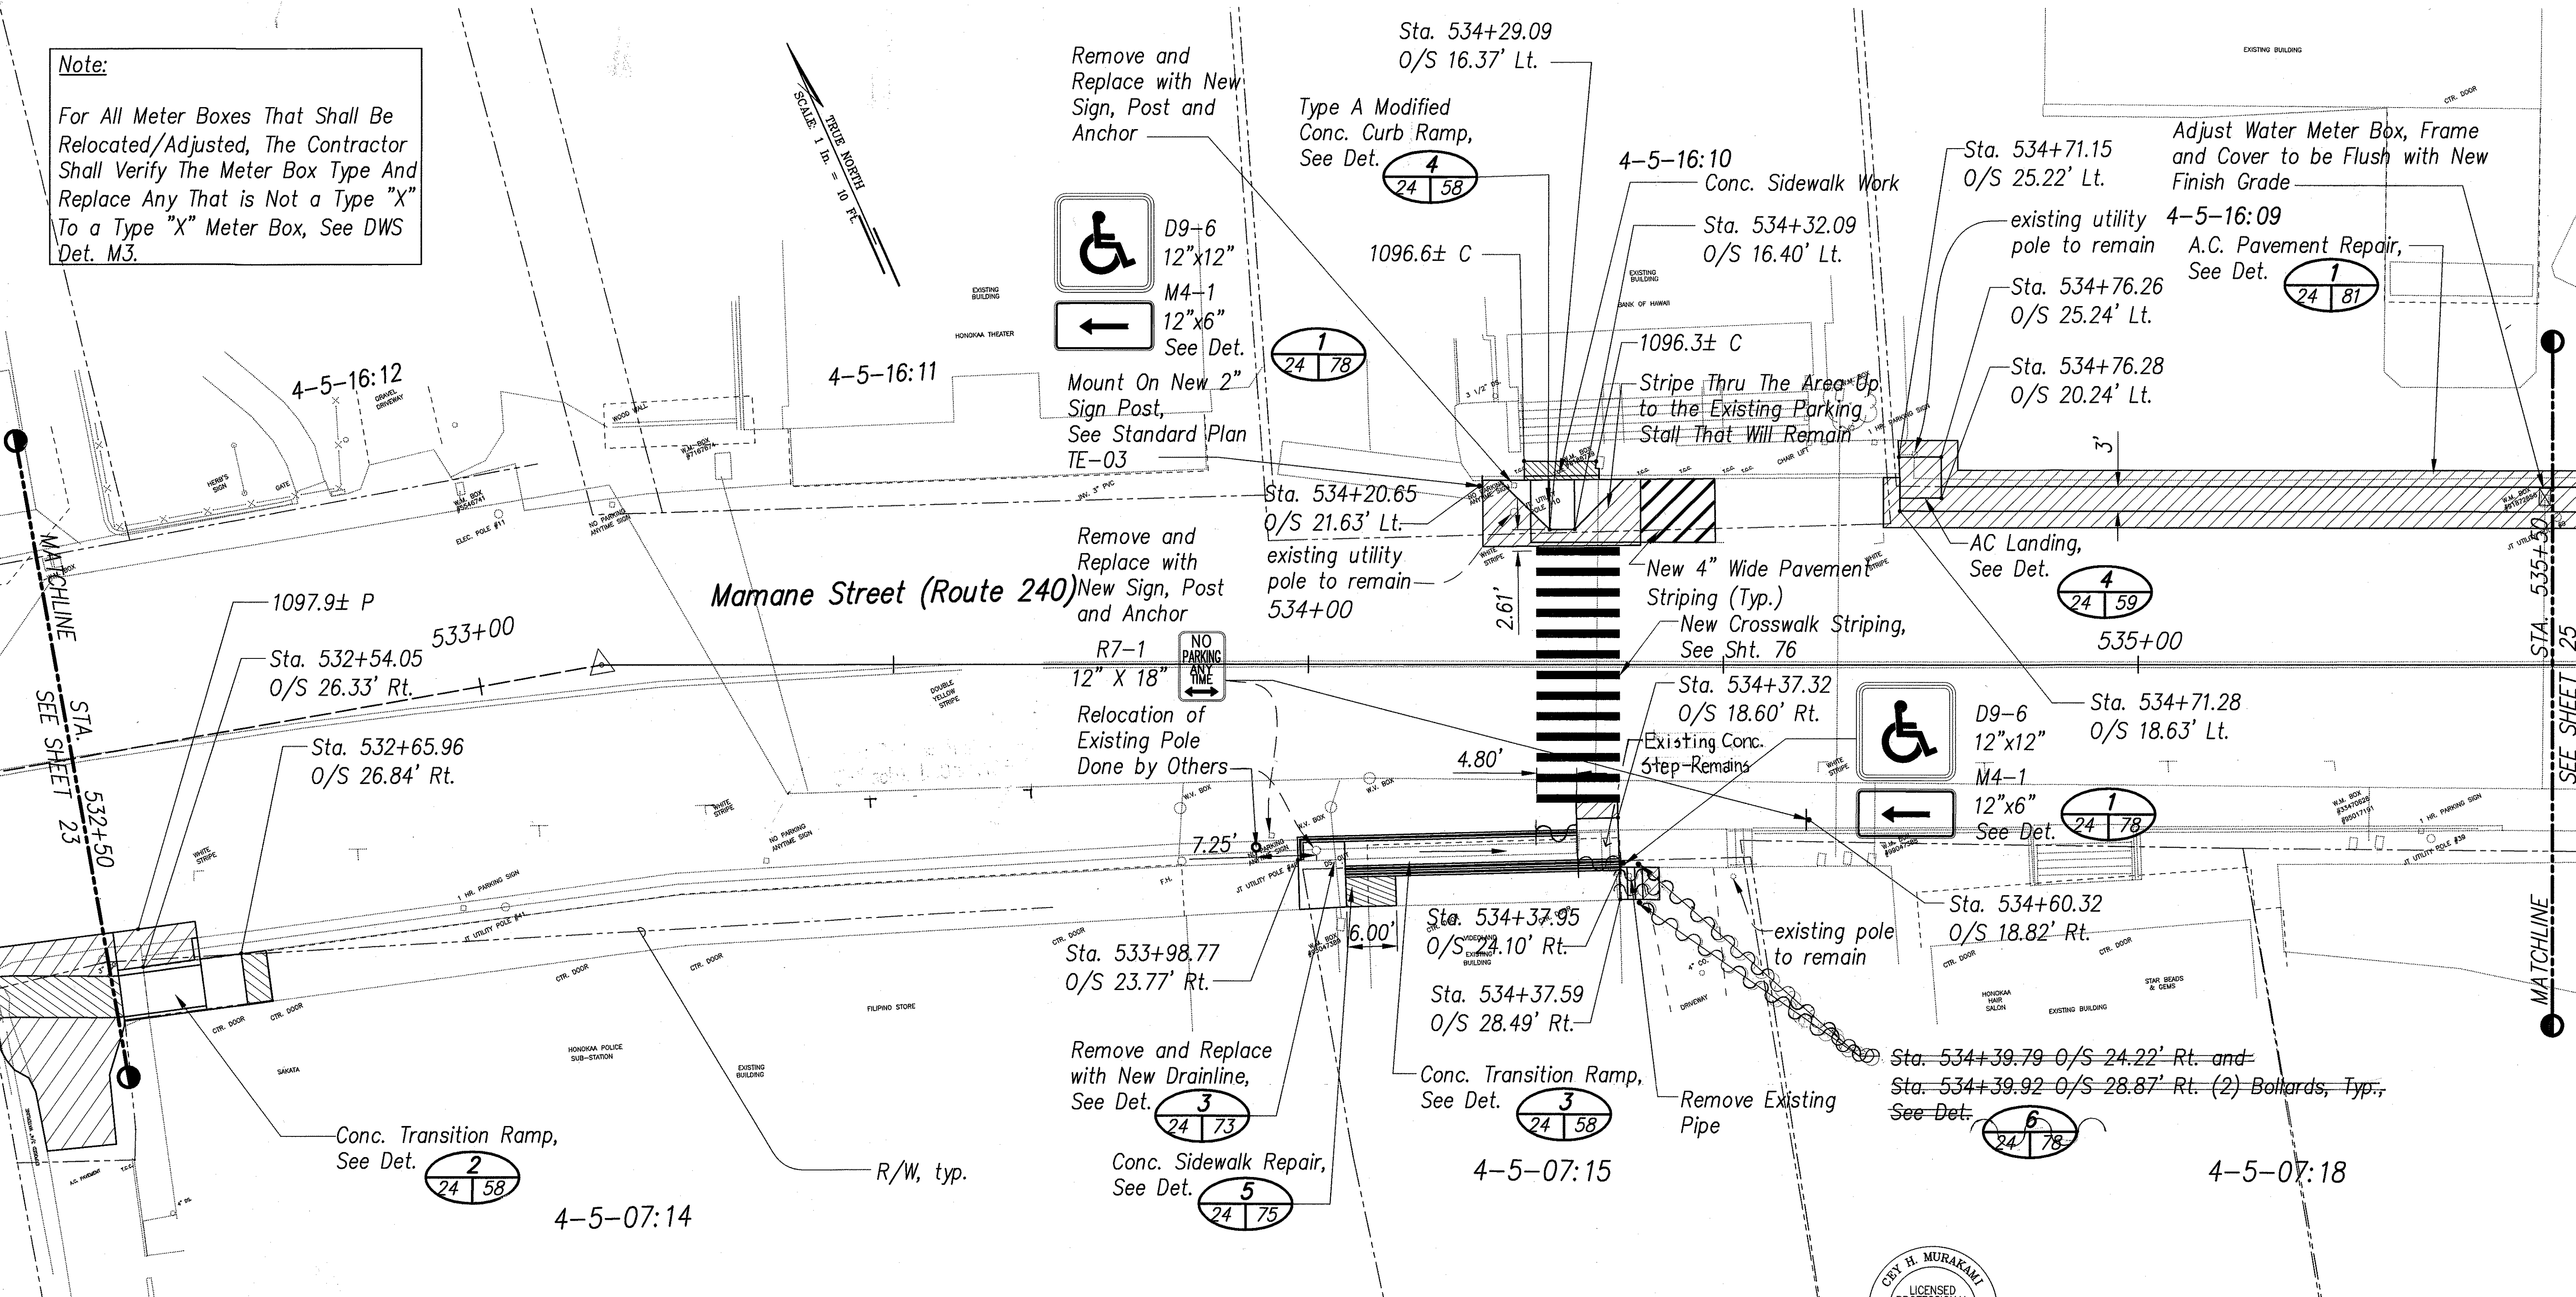

"AS-BUILT"

FED. ROAD DIST. NO.	STATE	FED. AID PROJ. NO.	FISCAL YEAR	SHEET NO.	TOTAL SHEETS
HAWAII	HAW.	CMAQ-0100(62)	2004	25	86

Note:

For All Meter Boxes That Shall Be Relocated/Adjusted, The Contractor Shall Verify The Meter Box Type And Replace Any That is Not a Type "X" To a Type "X" Meter Box, See DWS Det. M3.

Conc. Sidewalk Repair, See Det. **3** 25 | 74

Remove and Replace with New Sign, Post and Anchor

R1-1
30" X 30" **STOP**

exist. utility and tel. poles to remain

A.C. Pavement Repair, See Det. **6** 25 | 81

Sta. 538+05.41
O/S 15.61' Rt.

Sta. 538+32.64
O/S 19.42' Rt.


Sta. 538+27.15
O/S 25.79' Rt.

Sta. 538+26.83
O/S 33.41' 1102.98 TW

Sta. 538+26.76
O/S 35.42' 1102.98 TW

Grouted Rubble Paving, Typ., See Det. **3** 25 | 74

Remove and Replace with New "1-HR Parking" Sign, Post and Anchor

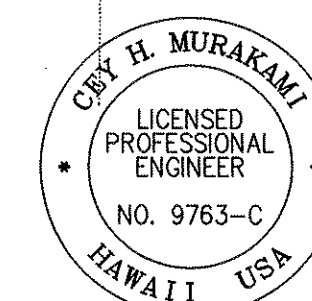

THIS WORK WAS PREPARED BY ME OR UNDER MY SUPERVISION

Cory H. Murakami
SIGNATURE

04/30/06
EXPIRATION DATE OF THE LICENSE



STATE OF HAWAII
DEPARTMENT OF TRANSPORTATION
HIGHWAYS DIVISION

SITE PLAN - HONOKAA
MAMANE ST.
R. STA. 535+50 TO STA. 538+50
PEDESTRIAN ACCESSIBILITY ROUTE IMPROVEMENTS - HONOKAA, HAWAII, AND KAPAAU
Federal Aid Project No. CMAQ-0100(62)
Scale: AS NOTED Date: SEPT. 2004

SHEET No. 25 OF 86 SHEETS

SITE PLAN - HONOKAA
SCALE: 1" = 10'


- Legend:**
- AC Pavement & AC Driveway Repair
 - Concrete Sidewalk & Concrete Driveway Repair
 - Grouted Rubble Paving

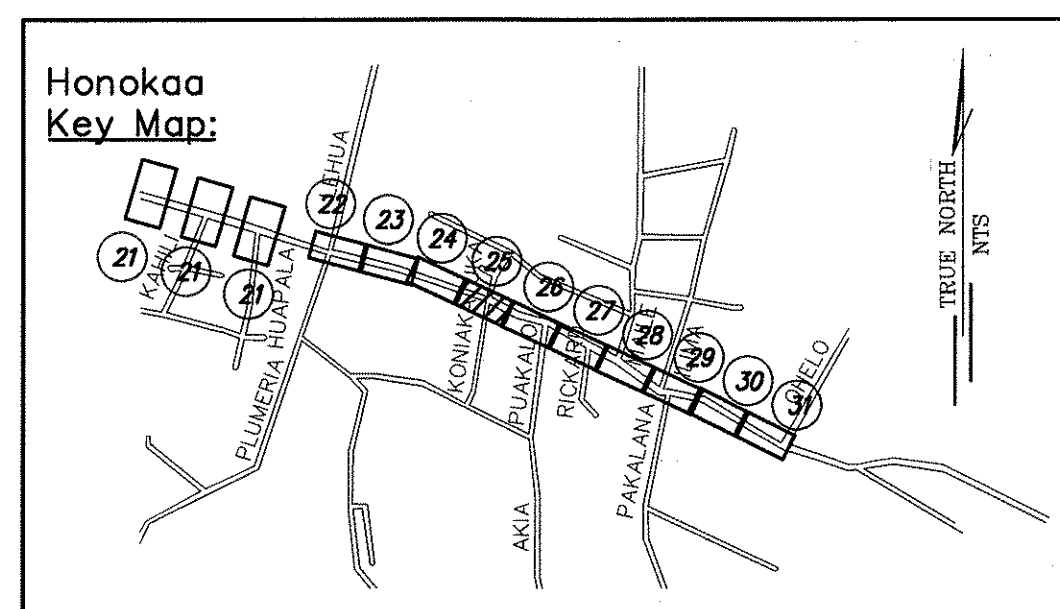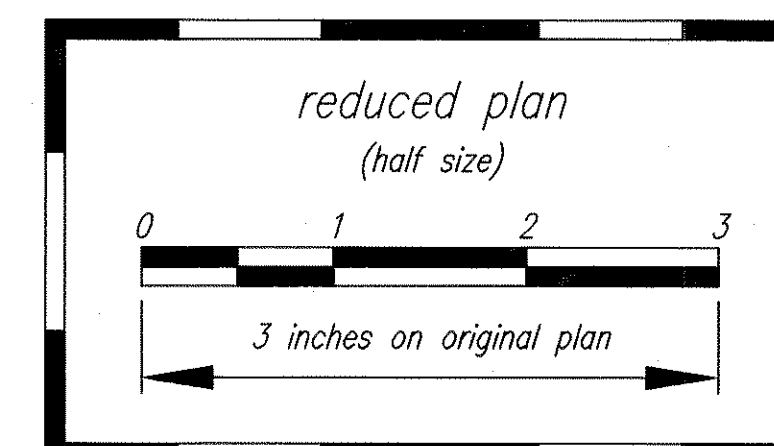


DRAWING NAME: I:\2000\2000_070-000 PROJECT POINT - PEDESTRIAN ACCESSIBILITY DRAWINGS\PLAN\CS-SP006-HONOKAA 25.DWG
EDIT TIME: 09-29-04 11:23 AM
EDITED BY: MTUNANENG

ORIGINAL PLAN	DATE	BY
NOTE BOOK	9/2004	DI
DESIGNED BY	9/2004	CM
QUANTITIES BY	9/2004	TC
CHECKED BY	9/2004	ES

FED. ROAD DIST. NO.	STATE	FED. AID PROJ. NO.	FISCAL YEAR	SHEET NO.	TOTAL SHEETS
HAWAII	HAW.	CMAQ-0100(62)	2004	26	86


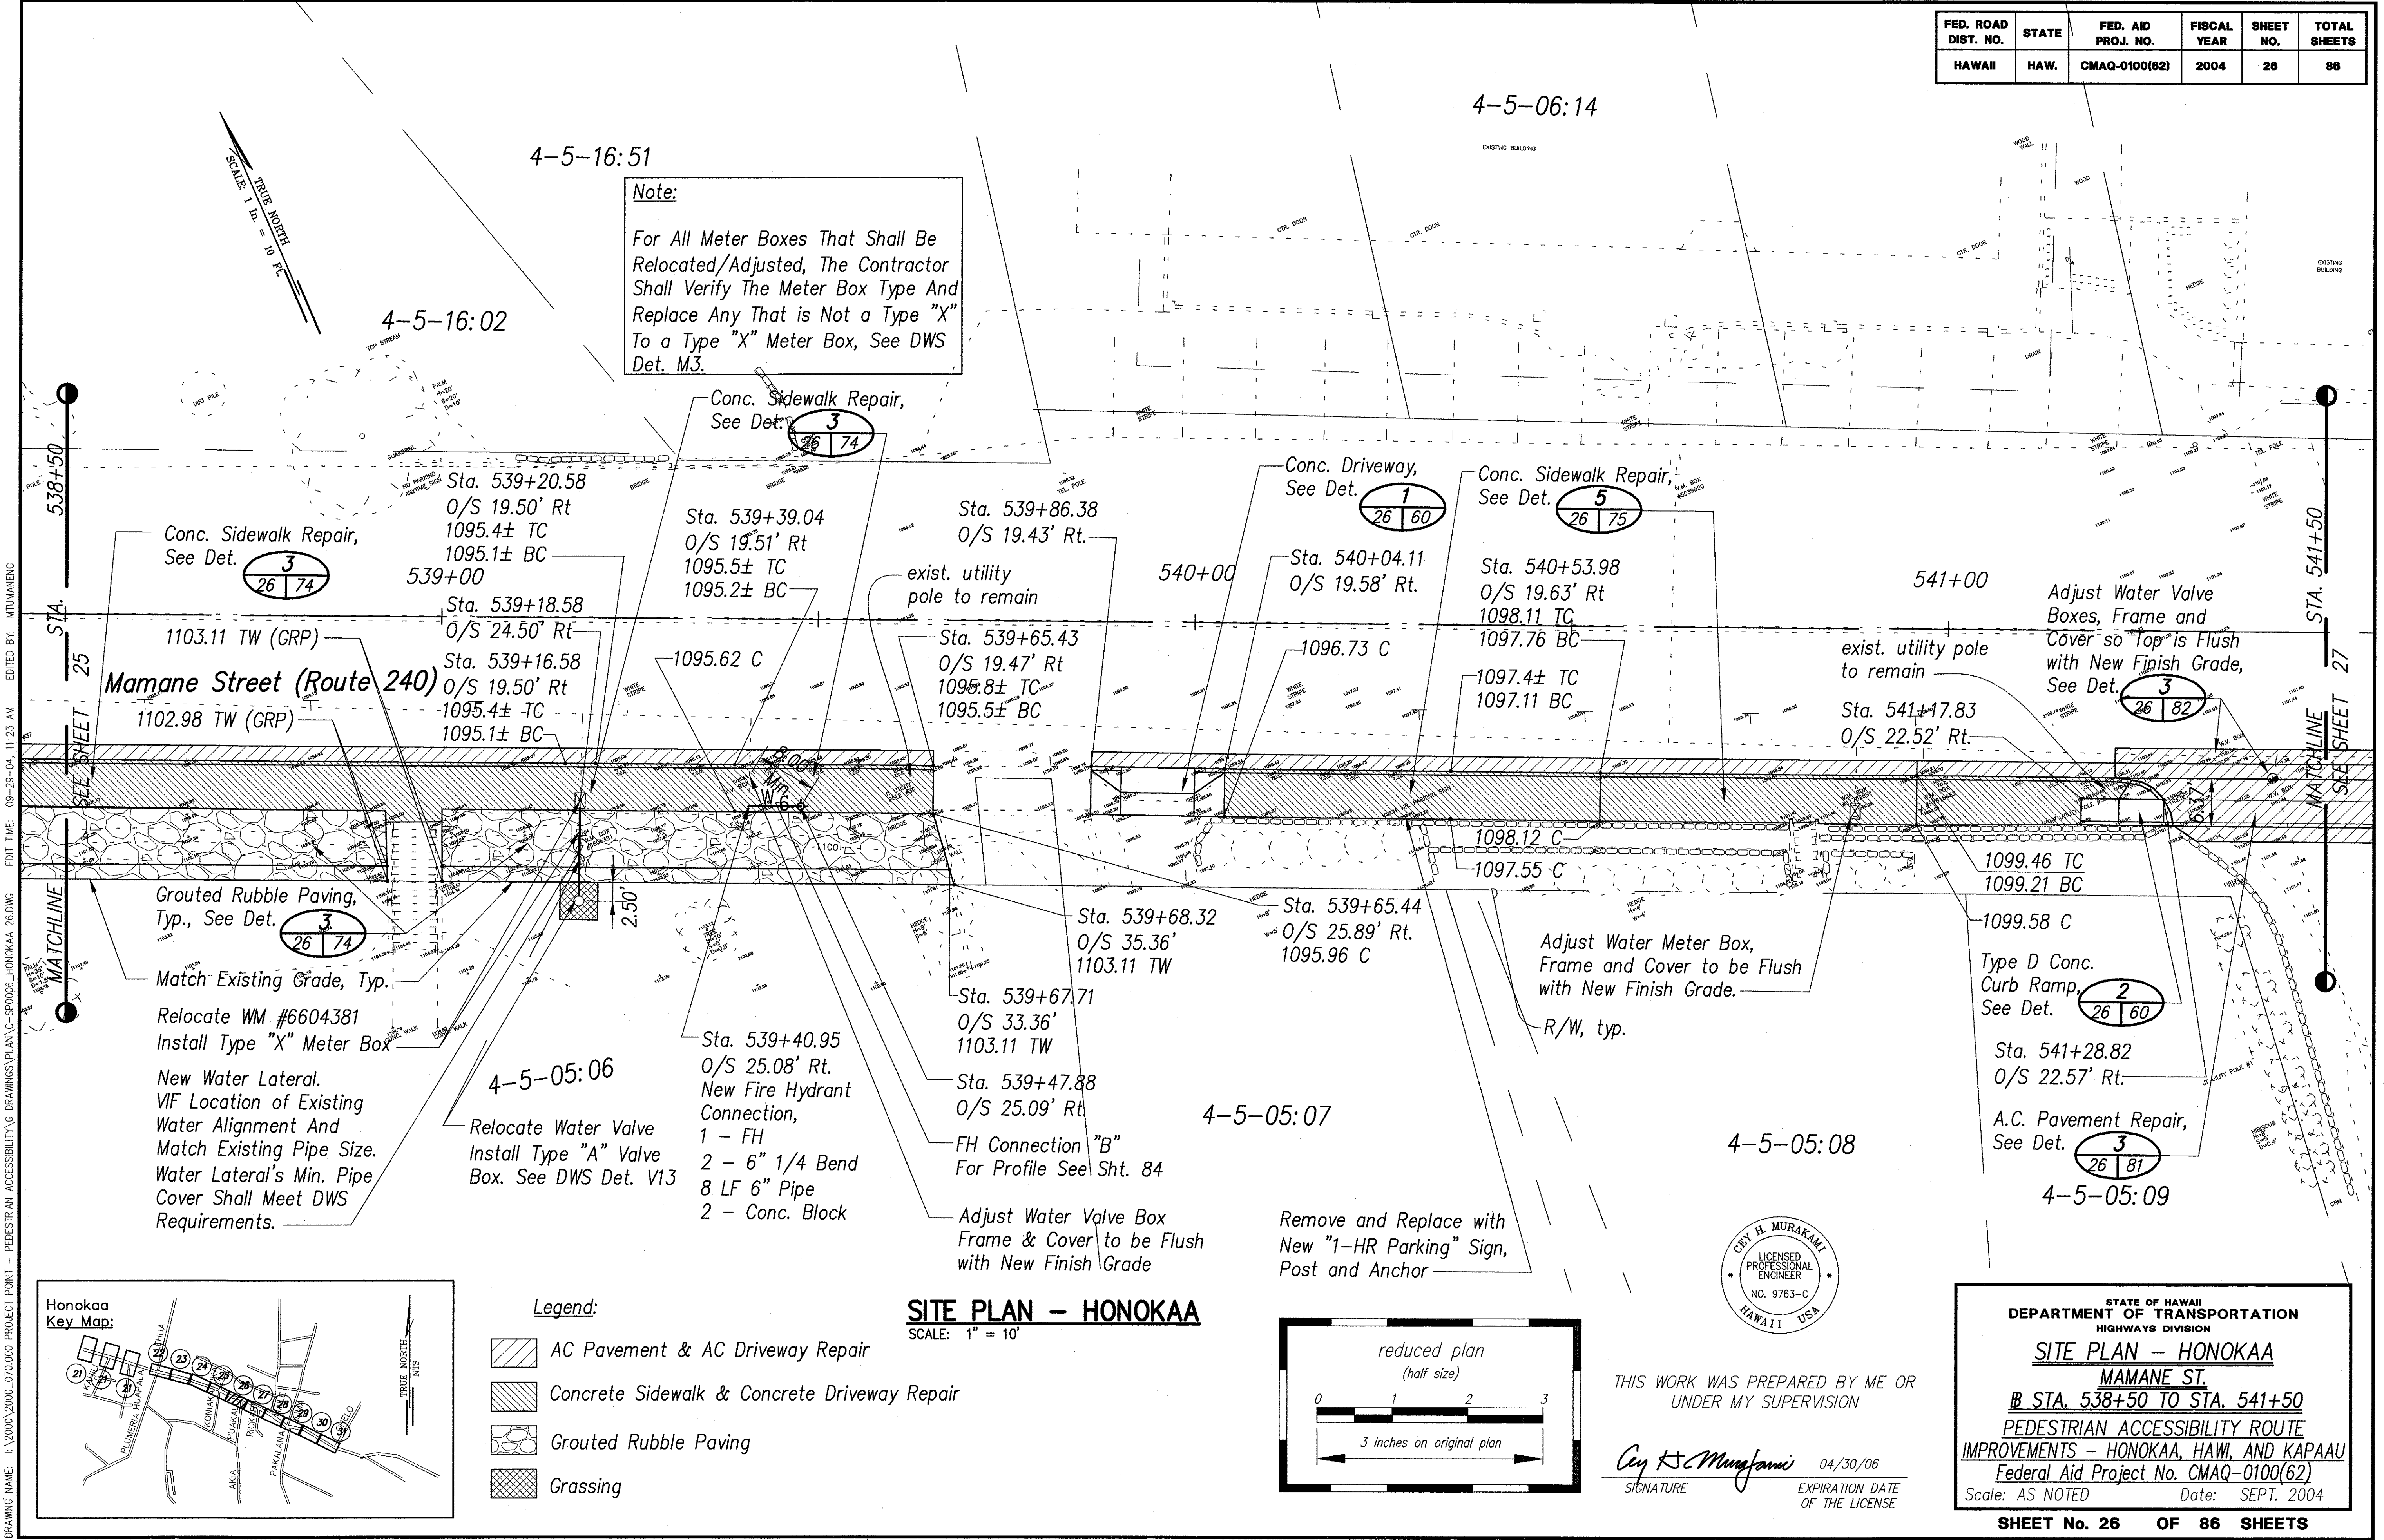


Note:
For All Meter Boxes That Shall Be Relocated/Adjusted, The Contractor Shall Verify The Meter Box Type And Replace Any That is Not a Type "X" To a Type "X" Meter Box, See DWS Det. M3.

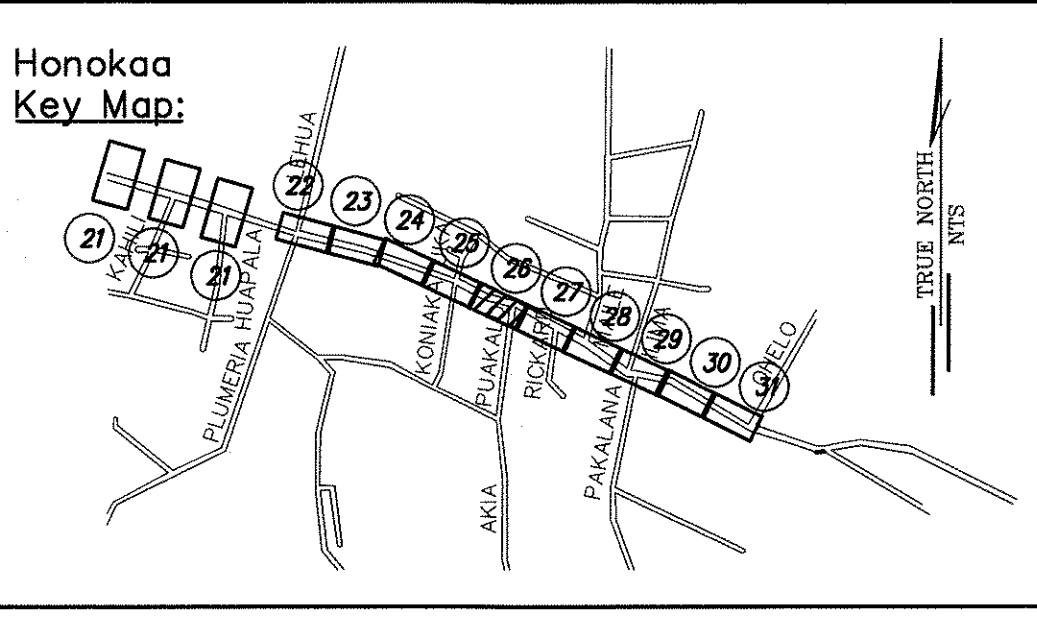

- Legend:**
- AC Pavement & AC Driveway Repair
 - Concrete Sidewalk & Concrete Driveway Repair
 - Grouted Rubble Paving
 - Grassing

SITE PLAN - HONOKAA
SCALE: 1" = 10'

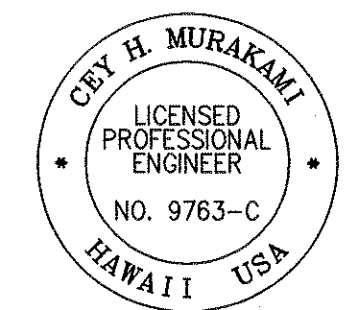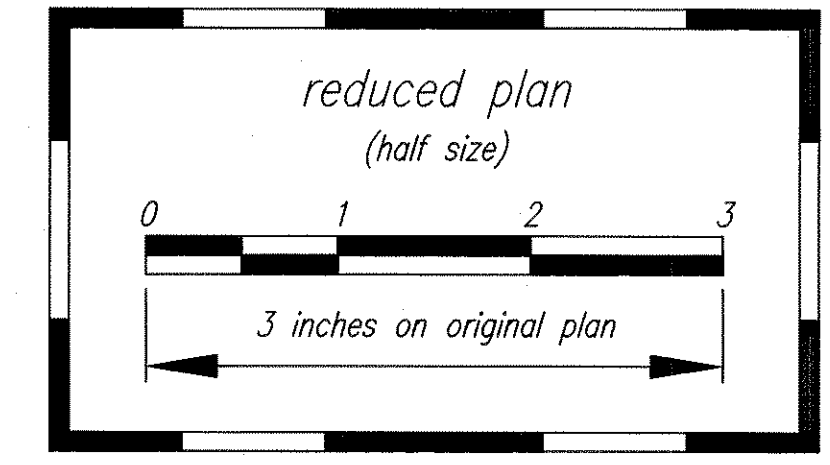

THIS WORK WAS PREPARED BY ME OR UNDER MY SUPERVISION



Cey H. Murakami 04/30/06
SIGNATURE EXPIRATION DATE OF THE LICENSE

STATE OF HAWAII
DEPARTMENT OF TRANSPORTATION
HIGHWAYS DIVISION

SITE PLAN - HONOKAA
MAMANE ST.
STA. 538+50 TO STA. 541+50
PEDESTRIAN ACCESSIBILITY ROUTE IMPROVEMENTS - HONOKAA, HAW. AND KAPAAU
Federal Aid Project No. CMAQ-0100(62)
Scale: AS NOTED Date: SEPT. 2004


SHEET No. 26 OF 86 SHEETS

FED. ROAD DIST. NO.	STATE	FED. AID PROJ. NO.	FISCAL YEAR	SHEET NO.	TOTAL SHEETS
HAWAII	HAW.	CMAQ-0100(62)	2004	27	86

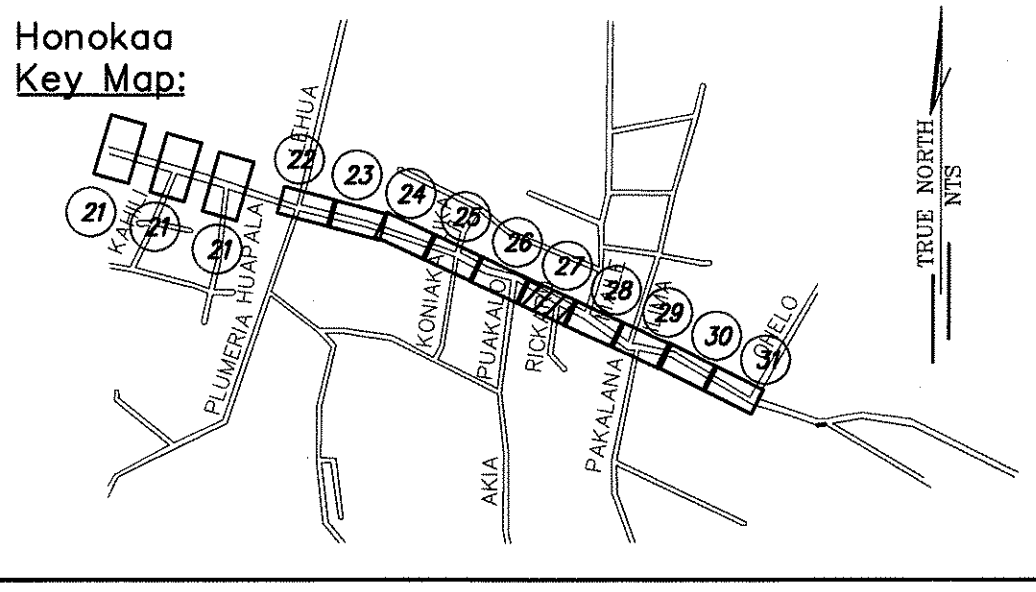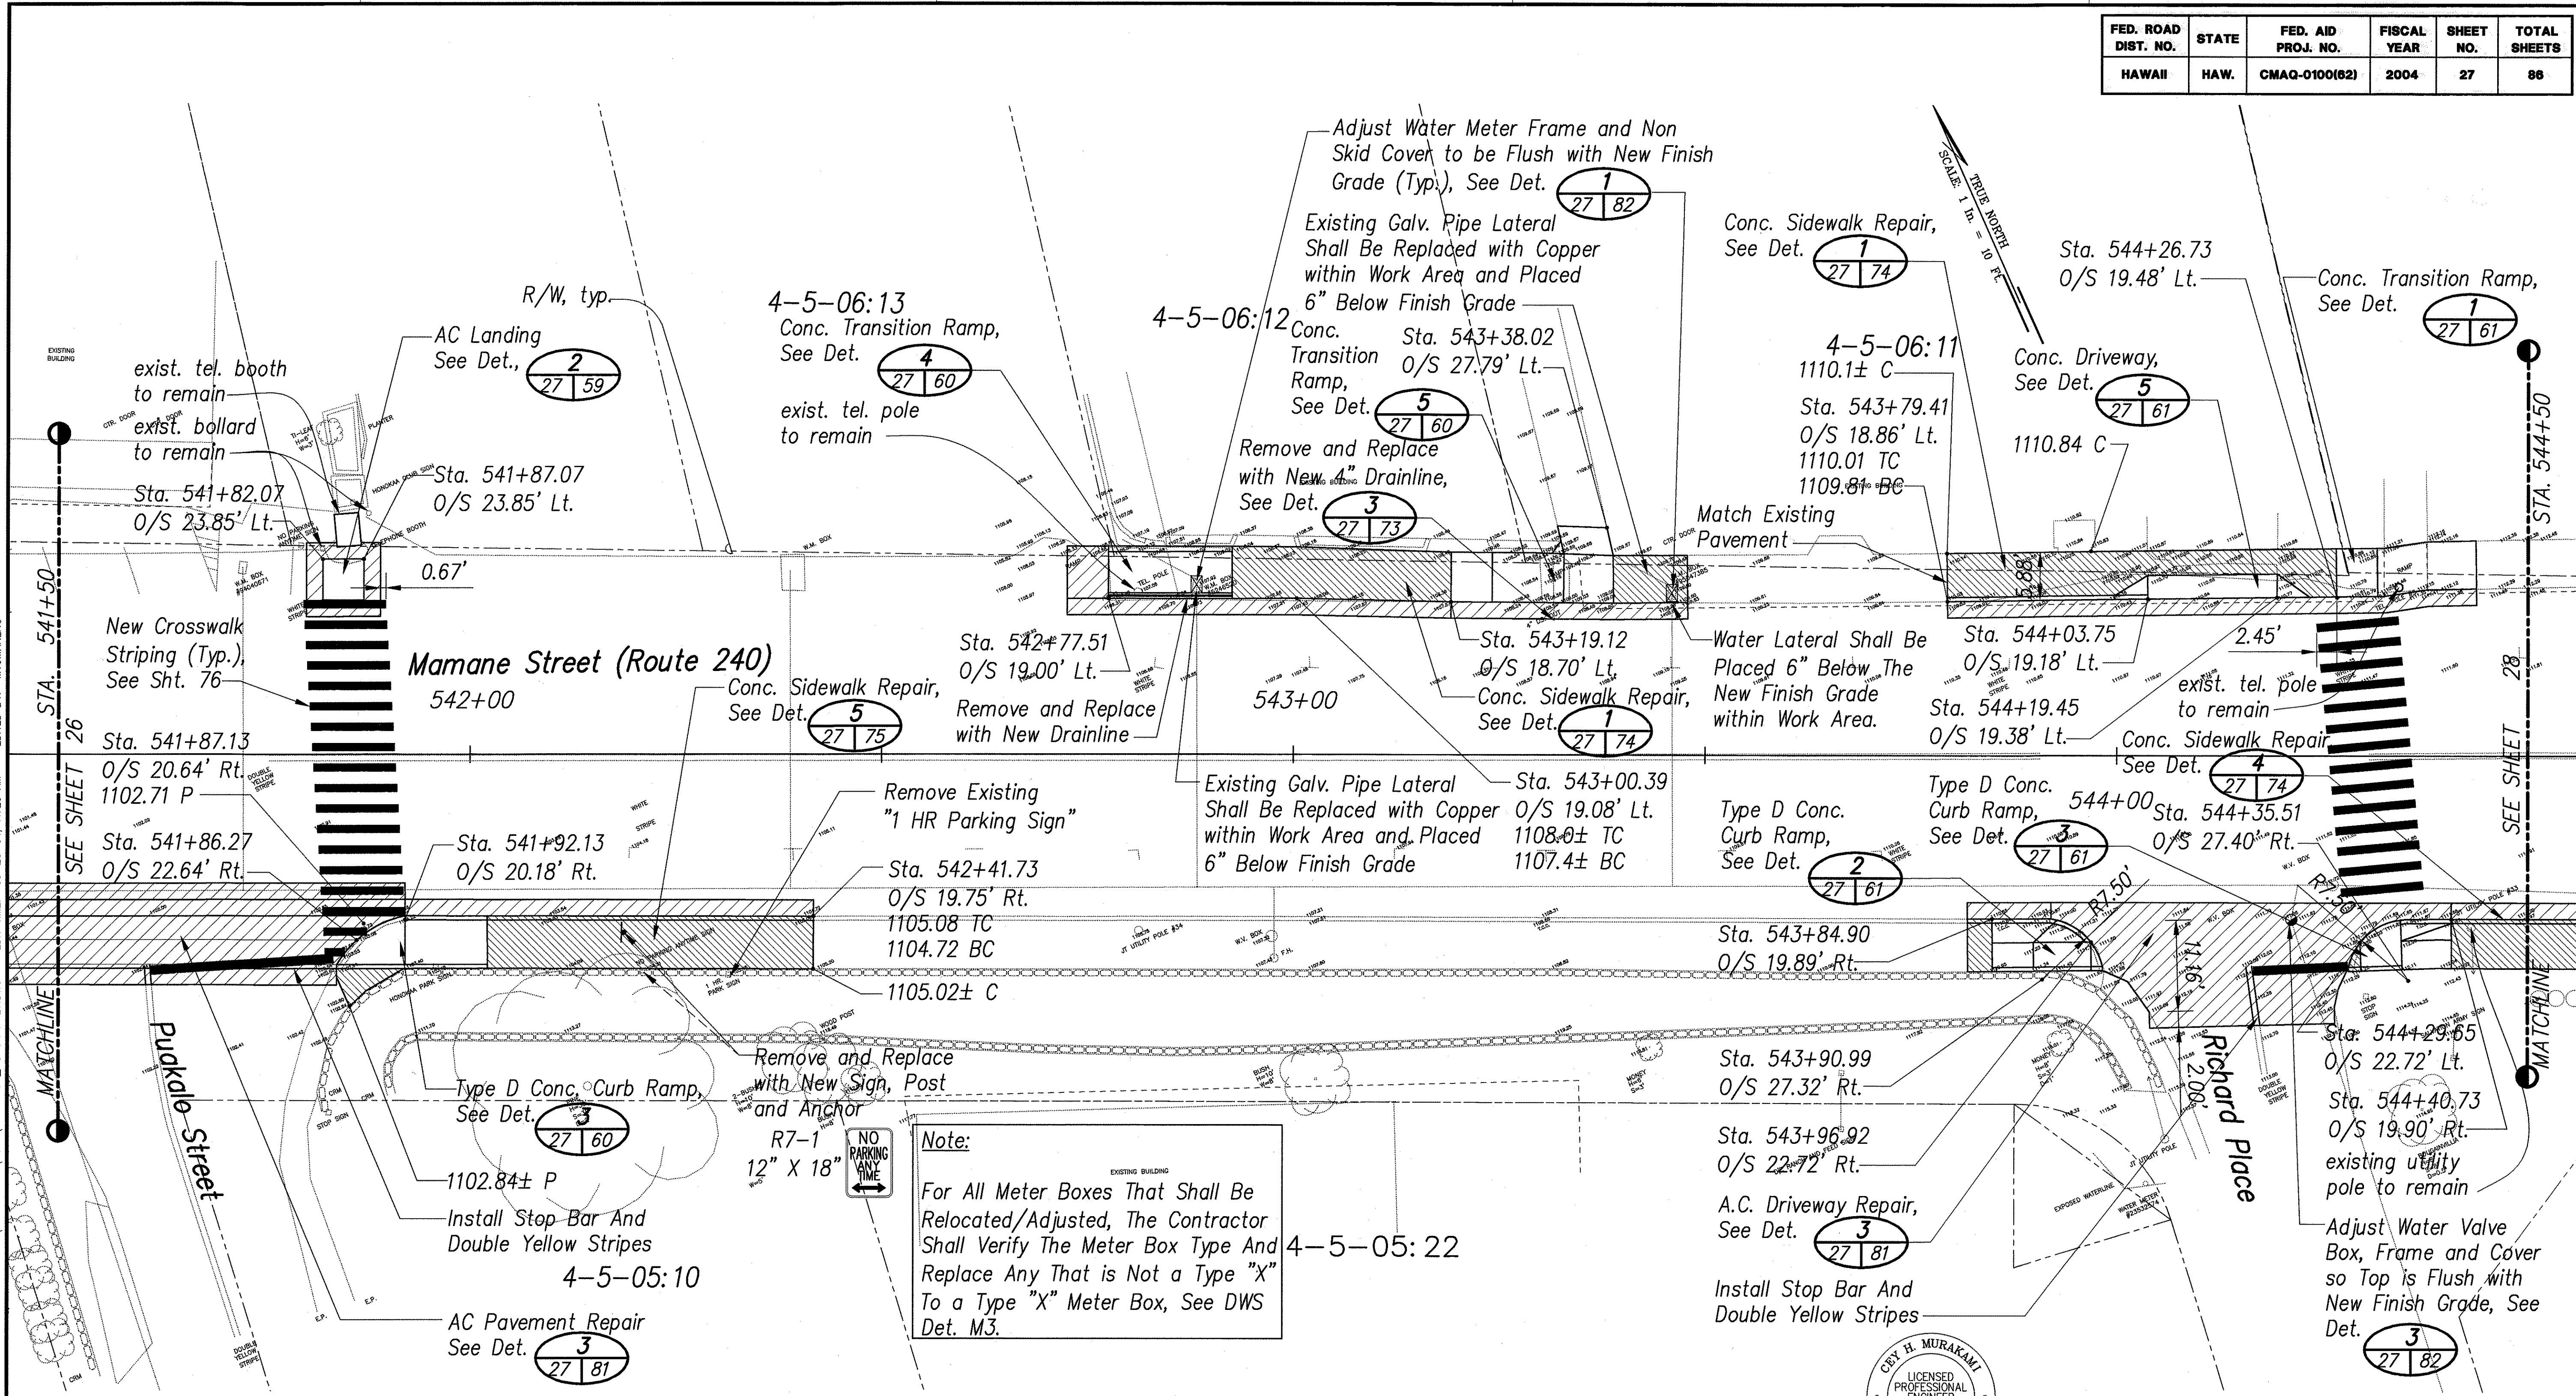

- Legend:**
- AC Pavement & AC Driveway Repair
 - Concrete Sidewalk & Concrete Driveway Repair

SITE PLAN - HONOKAA
SCALE: 1" = 10'

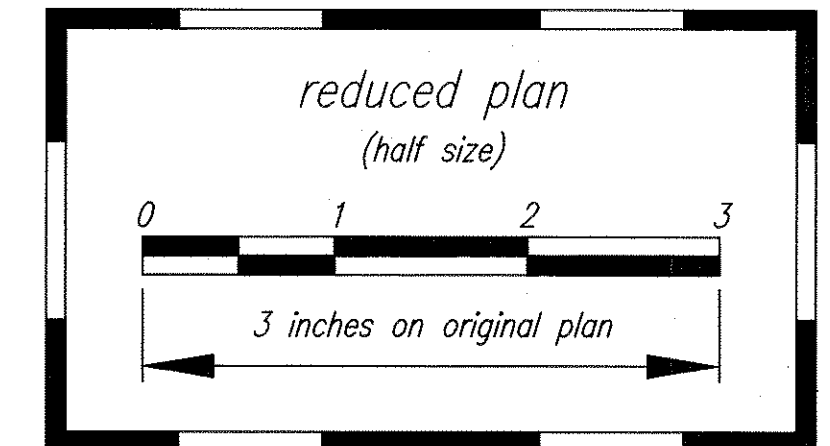

THIS WORK WAS PREPARED BY ME OR UNDER MY SUPERVISION

Cey H. Murakami 04/30/06
SIGNATURE EXPIRATION DATE OF THE LICENSE

STATE OF HAWAII
DEPARTMENT OF TRANSPORTATION
HIGHWAYS DIVISION


SITE PLAN - HONOKAA
MAMANE ST.
Sta. 541+50 TO Sta. 544+50
PEDESTRIAN ACCESSIBILITY ROUTE
IMPROVEMENTS - HONOKAA, HAWAII, AND KAPAAU
Federal Aid Project No. CMAQ-0100(62)
Scale: AS NOTED Date: SEPT. 2004

SHEET No. 27 OF 86 SHEETS

FED. ROAD DIST. NO.	STATE	FED. AID PROJ. NO.	FISCAL YEAR	SHEET NO.	TOTAL SHEETS
HAWAII	HAW.	CMAQ-0100(62)	2004	28	86


DRAWING NAME: I:\2000\2000_070.000 PROJECT POINT - PEDESTRIAN ACCESSIBILITY\DRAWINGS\PLAN\SP008-HONOKAA 28.DWG
 EDIT TIME: 09-29-04, 11:24 AM
 EDITED BY: MTUMANG

ORIGINAL PLAN	DATE
NO.	9/2004
DESIGNED BY	DL
CHECKED BY	DL
DATE	9/2004
DESIGNED BY	DL
CHECKED BY	DL
DATE	9/2004

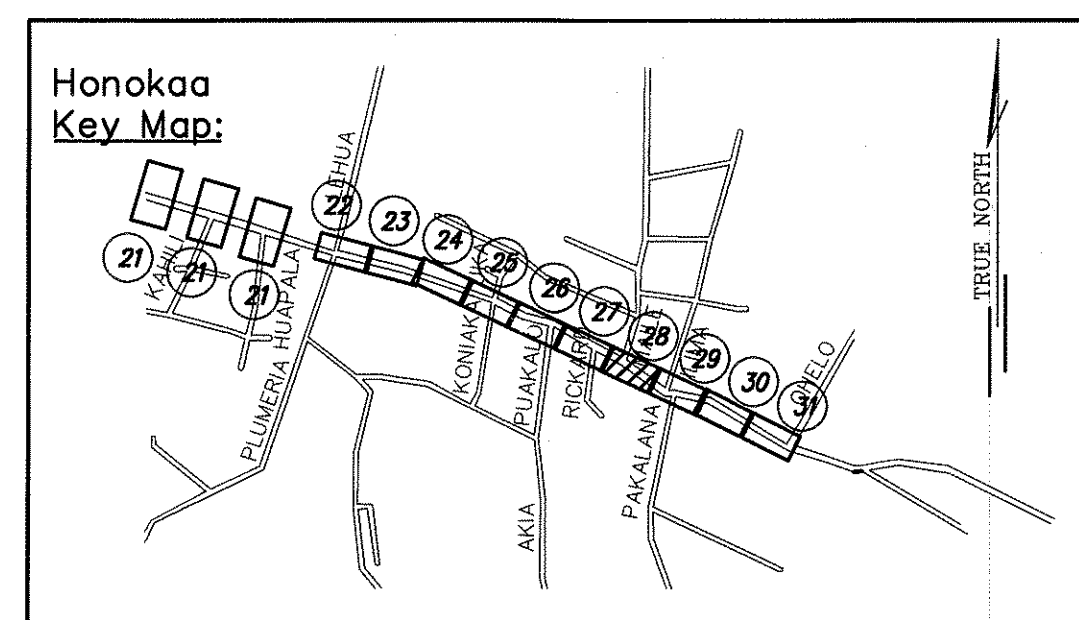

- Legend:**
- AC Pavement & AC Driveway Repair
 - Concrete Sidewalk & Concrete Driveway Repair

SITE PLAN - HONOKAA
 SCALE: 1" = 10'

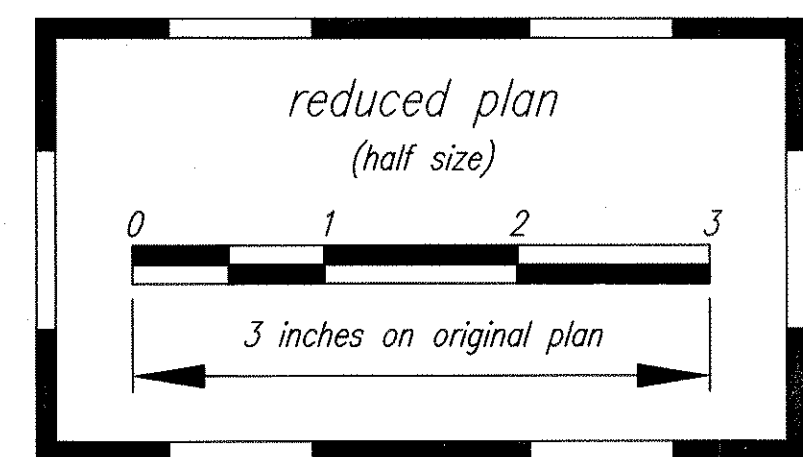


THIS WORK WAS PREPARED BY ME OR UNDER MY SUPERVISION

Cey H. Murakami 04/30/06
 SIGNATURE EXPIRATION DATE OF THE LICENSE

STATE OF HAWAII
 DEPARTMENT OF TRANSPORTATION
 HIGHWAYS DIVISION

SITE PLAN - HONOKAA
MAMANE ST.
B. STA. 544+50 TO STA. 547+50
PEDESTRIAN ACCESSIBILITY ROUTE IMPROVEMENTS - HONOKAA, HAWAII, AND KAPAAU
 Federal Aid Project No. CMAQ-0100(62)
 Scale: AS NOTED Date: SEPT. 2004


"AS-BUILT"

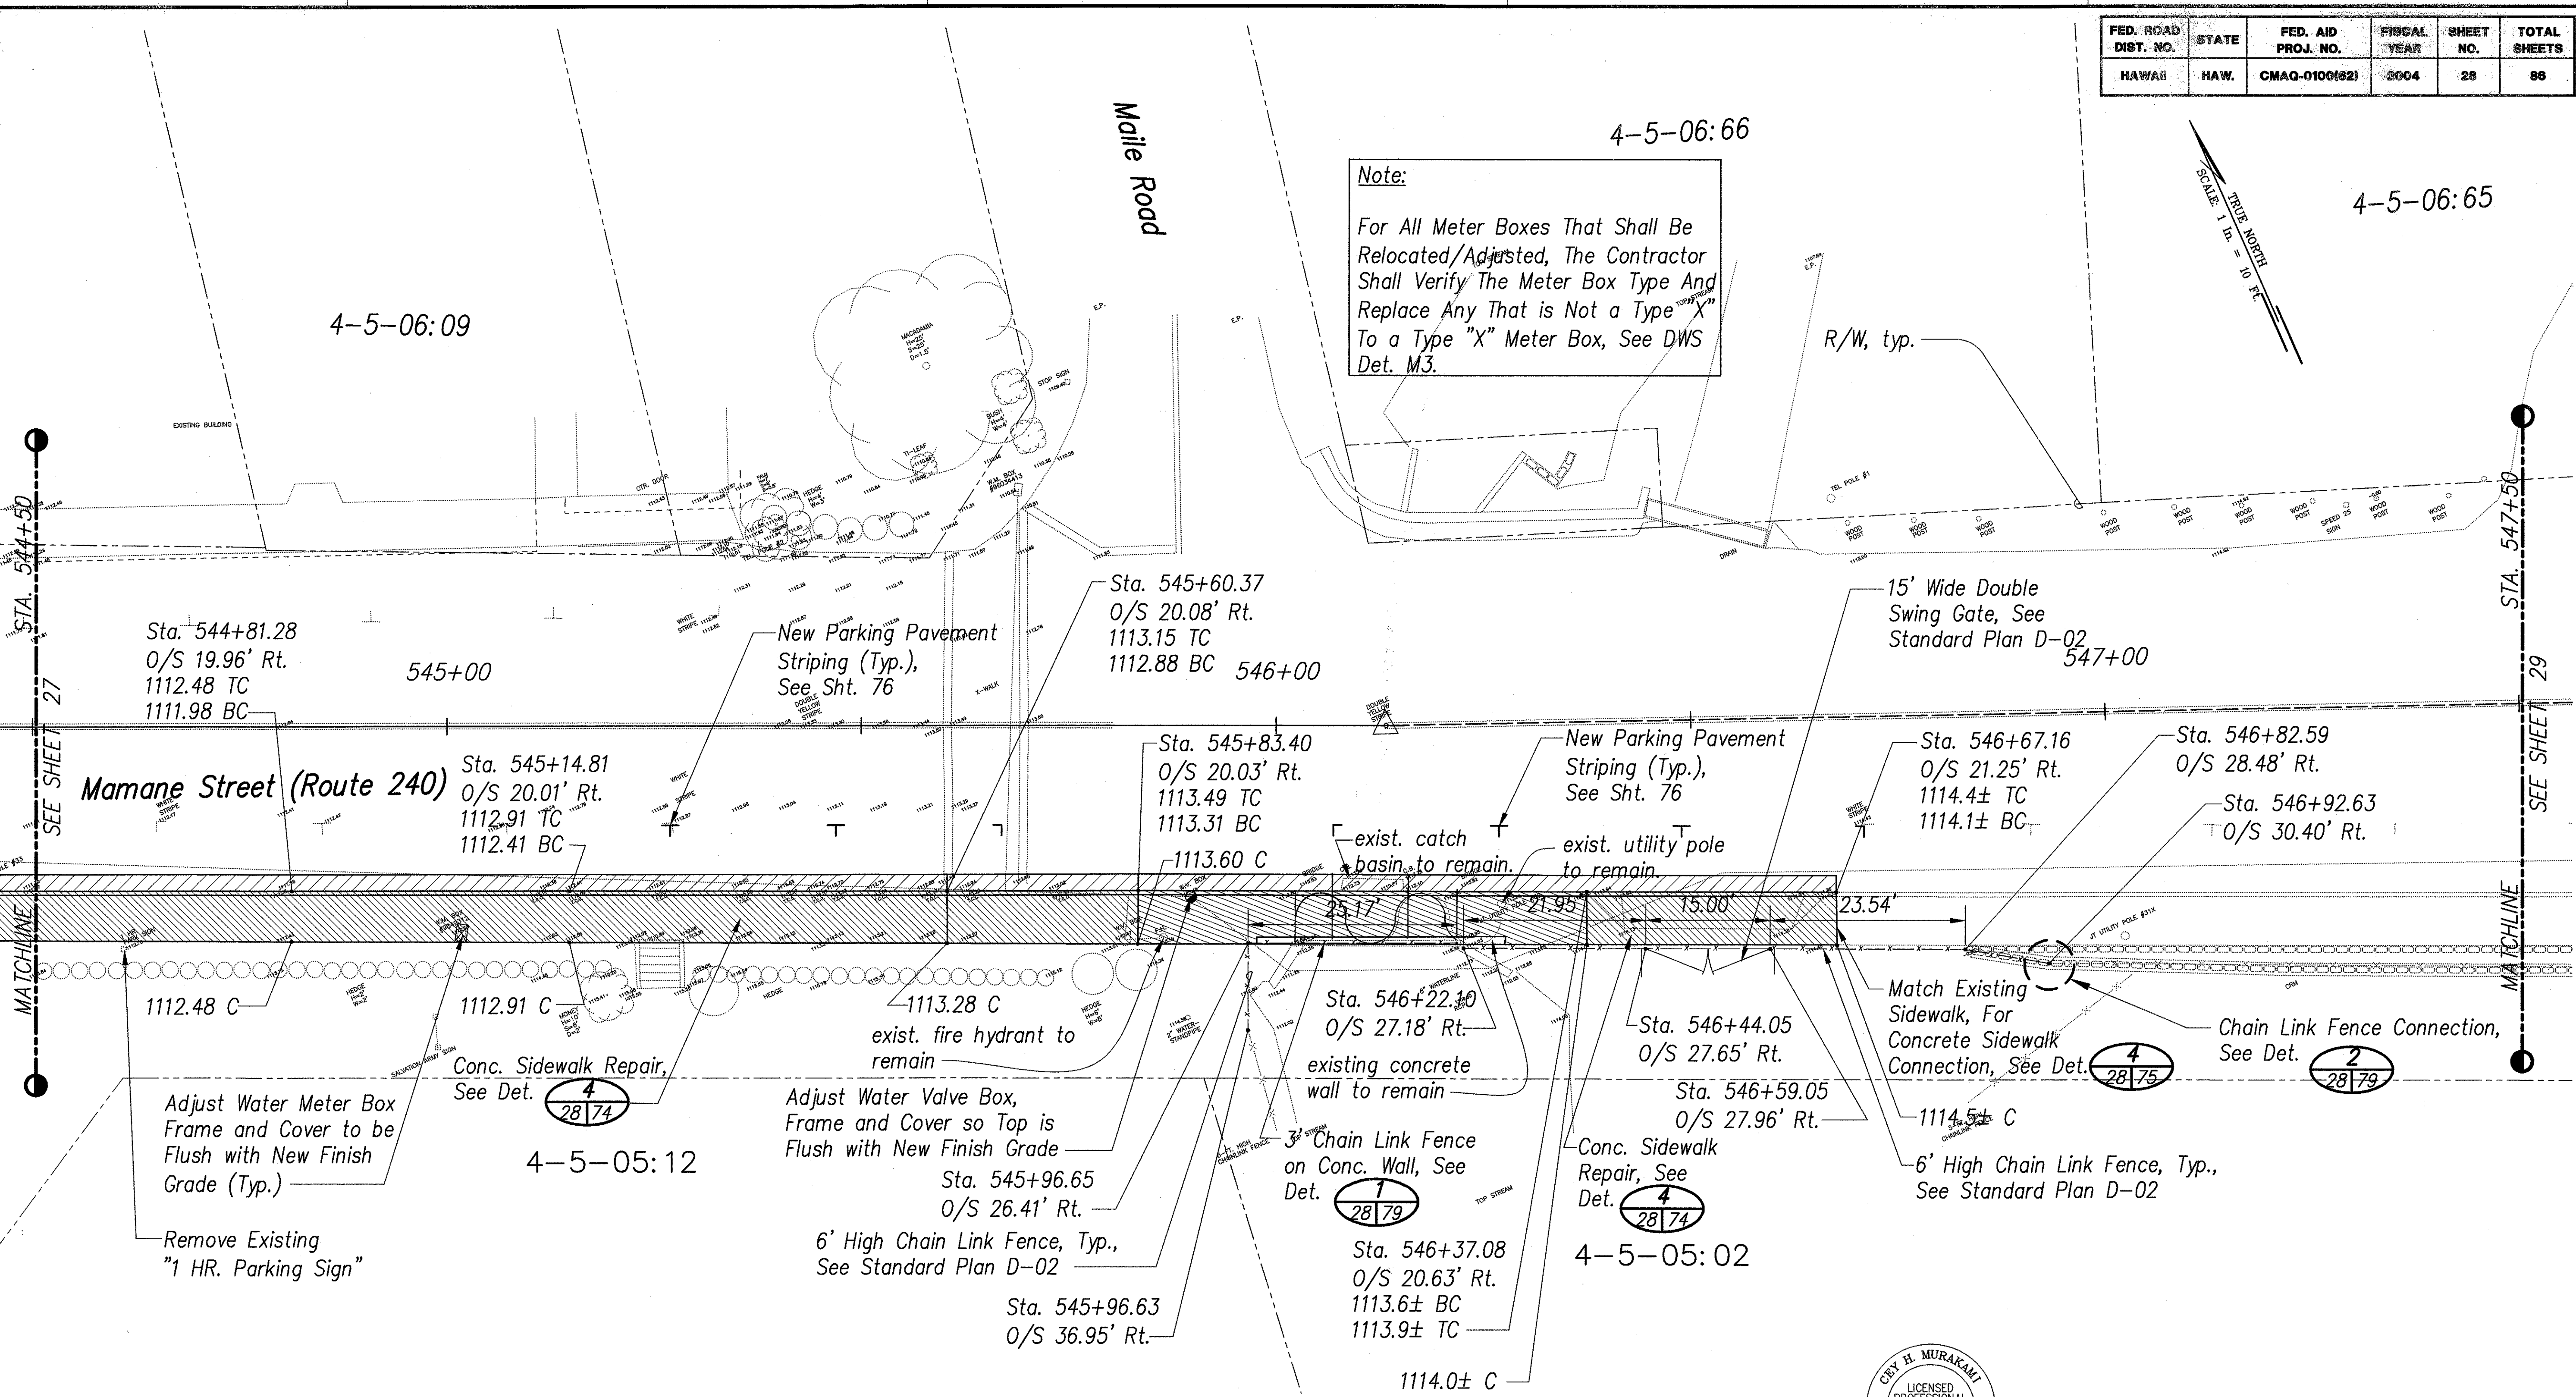


Note:
 For All Meter Boxes That Shall Be Relocated/Adjusted, The Contractor Shall Verify The Meter Box Type And Replace Any That is Not a Type "X" To a Type "X" Meter Box, See DWS Det. M3.

TRUE NORTH
 SCALE 1 in. = 10 ft.

FED. ROAD DIST. NO.	STATE	FED. AID PROJ. NO.	FISCAL YEAR	SHEET NO.	TOTAL SHEETS
HAWAII	HAW.	CMAQ-0100(62)	2004	29	86

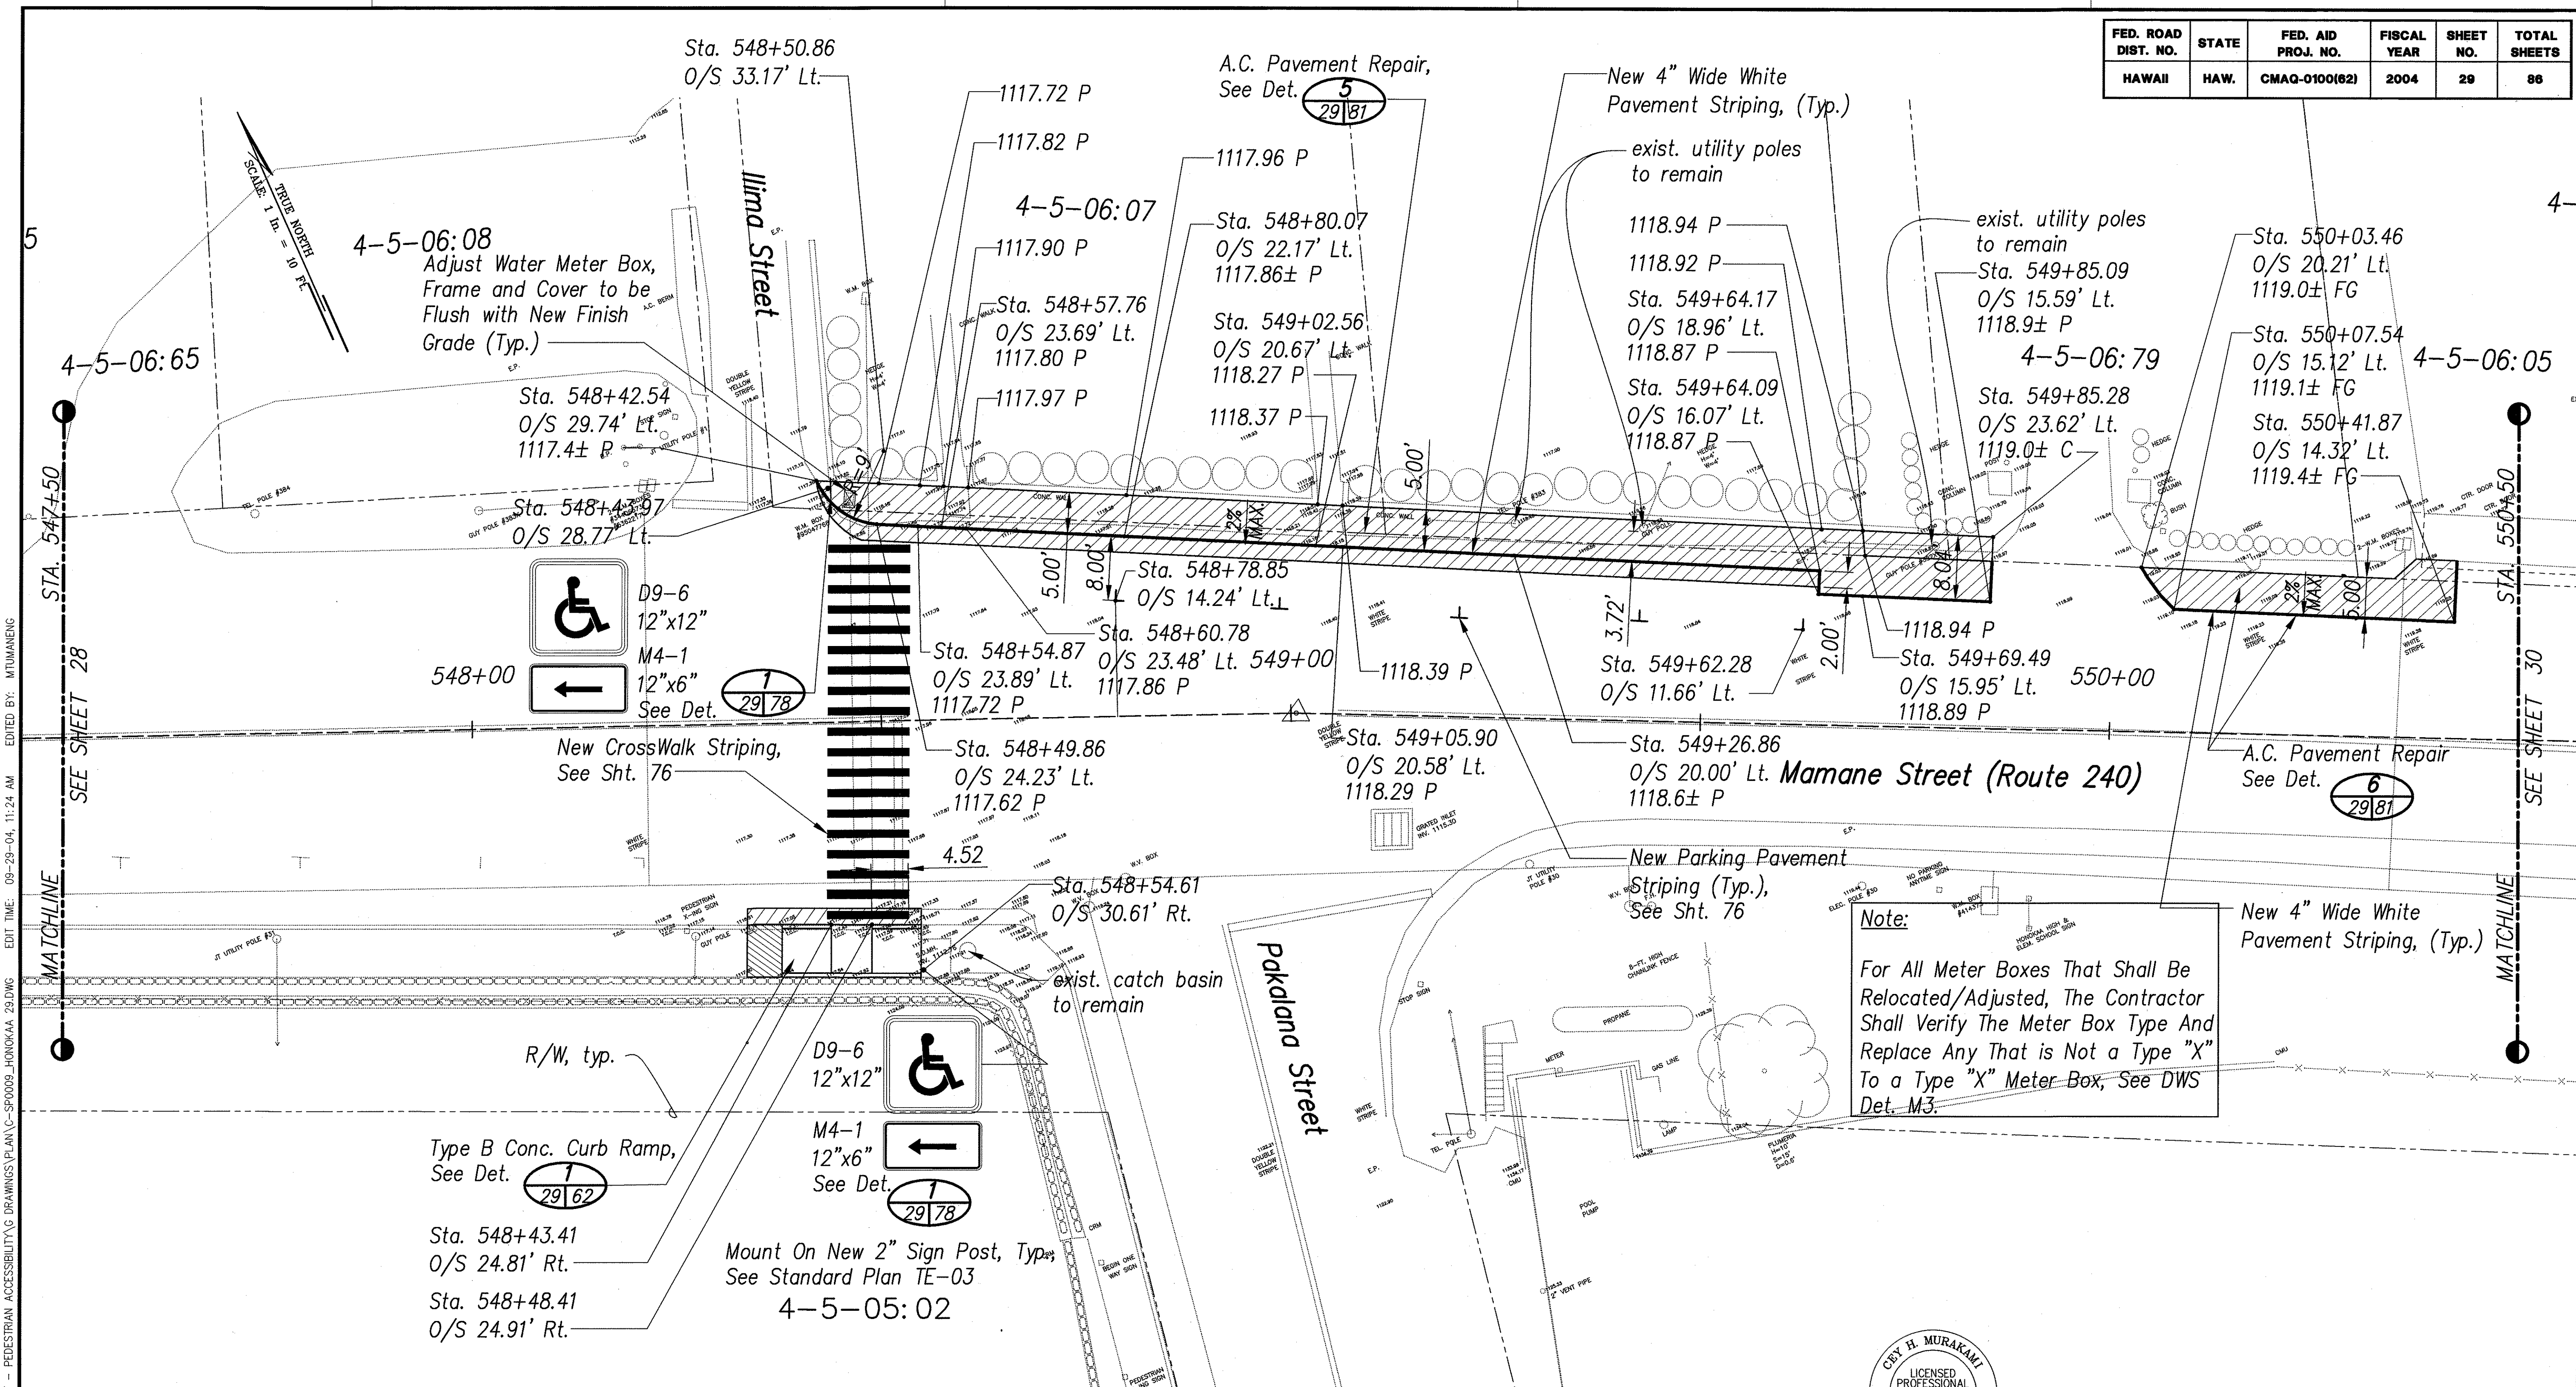


Note:
For All Meter Boxes That Shall Be Relocated/Adjusted, The Contractor Shall Verify The Meter Box Type And Replace Any That is Not a Type "X" To a Type "X" Meter Box, See DWS Det. M3.

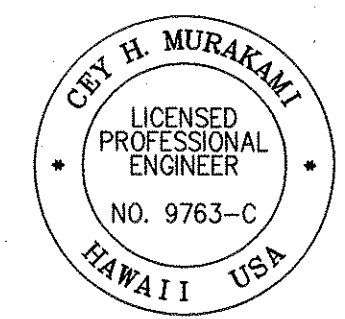


THIS WORK WAS PREPARED BY ME OR UNDER MY SUPERVISION

Cey H. Murakami 04/30/06
SIGNATURE EXPIRATION DATE OF THE LICENSE

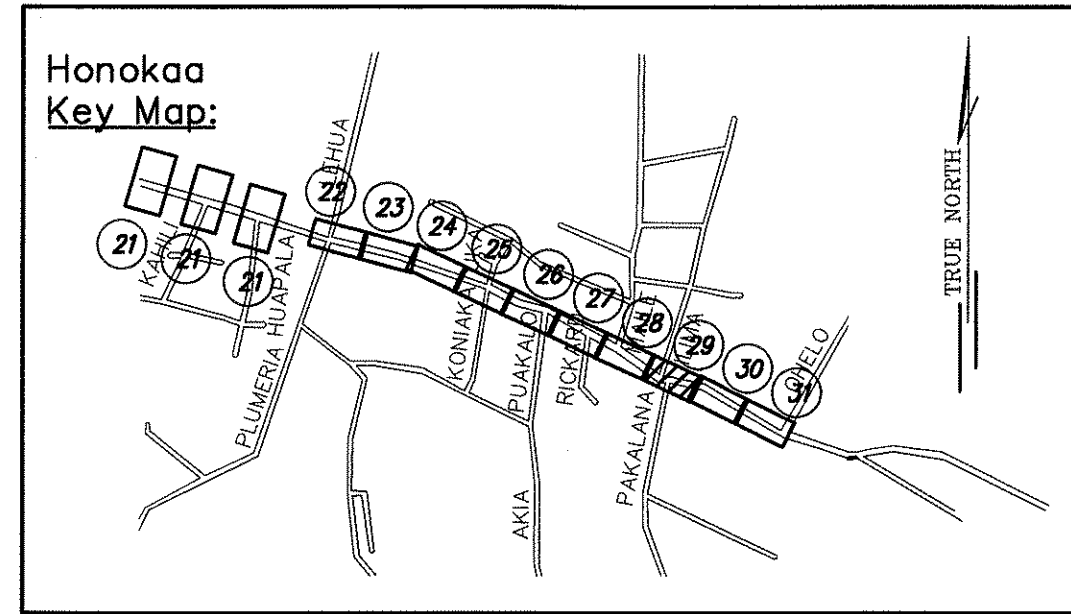

- Legend:**
- AC Pavement & AC Driveway Repair
 - Concrete Sidewalk & Concrete Driveway Repair

SITE PLAN - HONOKAA
SCALE: 1" = 10'

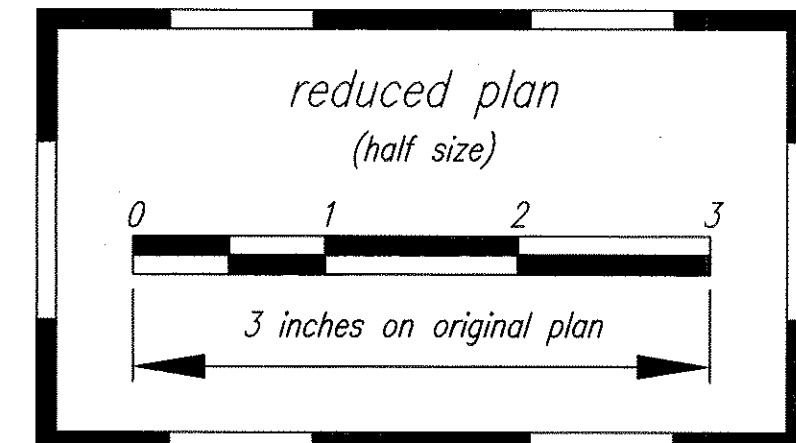

STATE OF HAWAII
DEPARTMENT OF TRANSPORTATION
HIGHWAYS DIVISION


SITE PLAN - HONOKAA
MAMANE ST.
STA. 547+50 TO STA. 550+50
PEDESTRIAN ACCESSIBILITY ROUTE IMPROVEMENTS - HONOKAA, HAWAII, AND KAPAAU
Federal Aid Project No. CMAQ-0100(62)
Scale: AS NOTED Date: SEPT. 2004

SHEET No. 29 OF 86 SHEETS

ORIGINAL PLAN	DATE
DRAWN BY	9/2004
DESIGNED BY	9/2004
CHECKED BY	9/2004
NO.	


DRAWING NAME: I-2000/2000.070.000 PROJECT POINT - PEDESTRIAN ACCESSIBILITY ROUTE IMPROVEMENTS - HONOKAA, HAWAII, AND KAPAAU
EDIT TIME: 09-29-04, 11:24 AM
EDITED BY: MTUMANENG

FED. ROAD DIST. NO.	STATE	FED. AID PROJ. NO.	FISCAL YEAR	SHEET NO.	TOTAL SHEETS
HAWAII	HAW.	CMAQ-0100(62)	2004	30	86

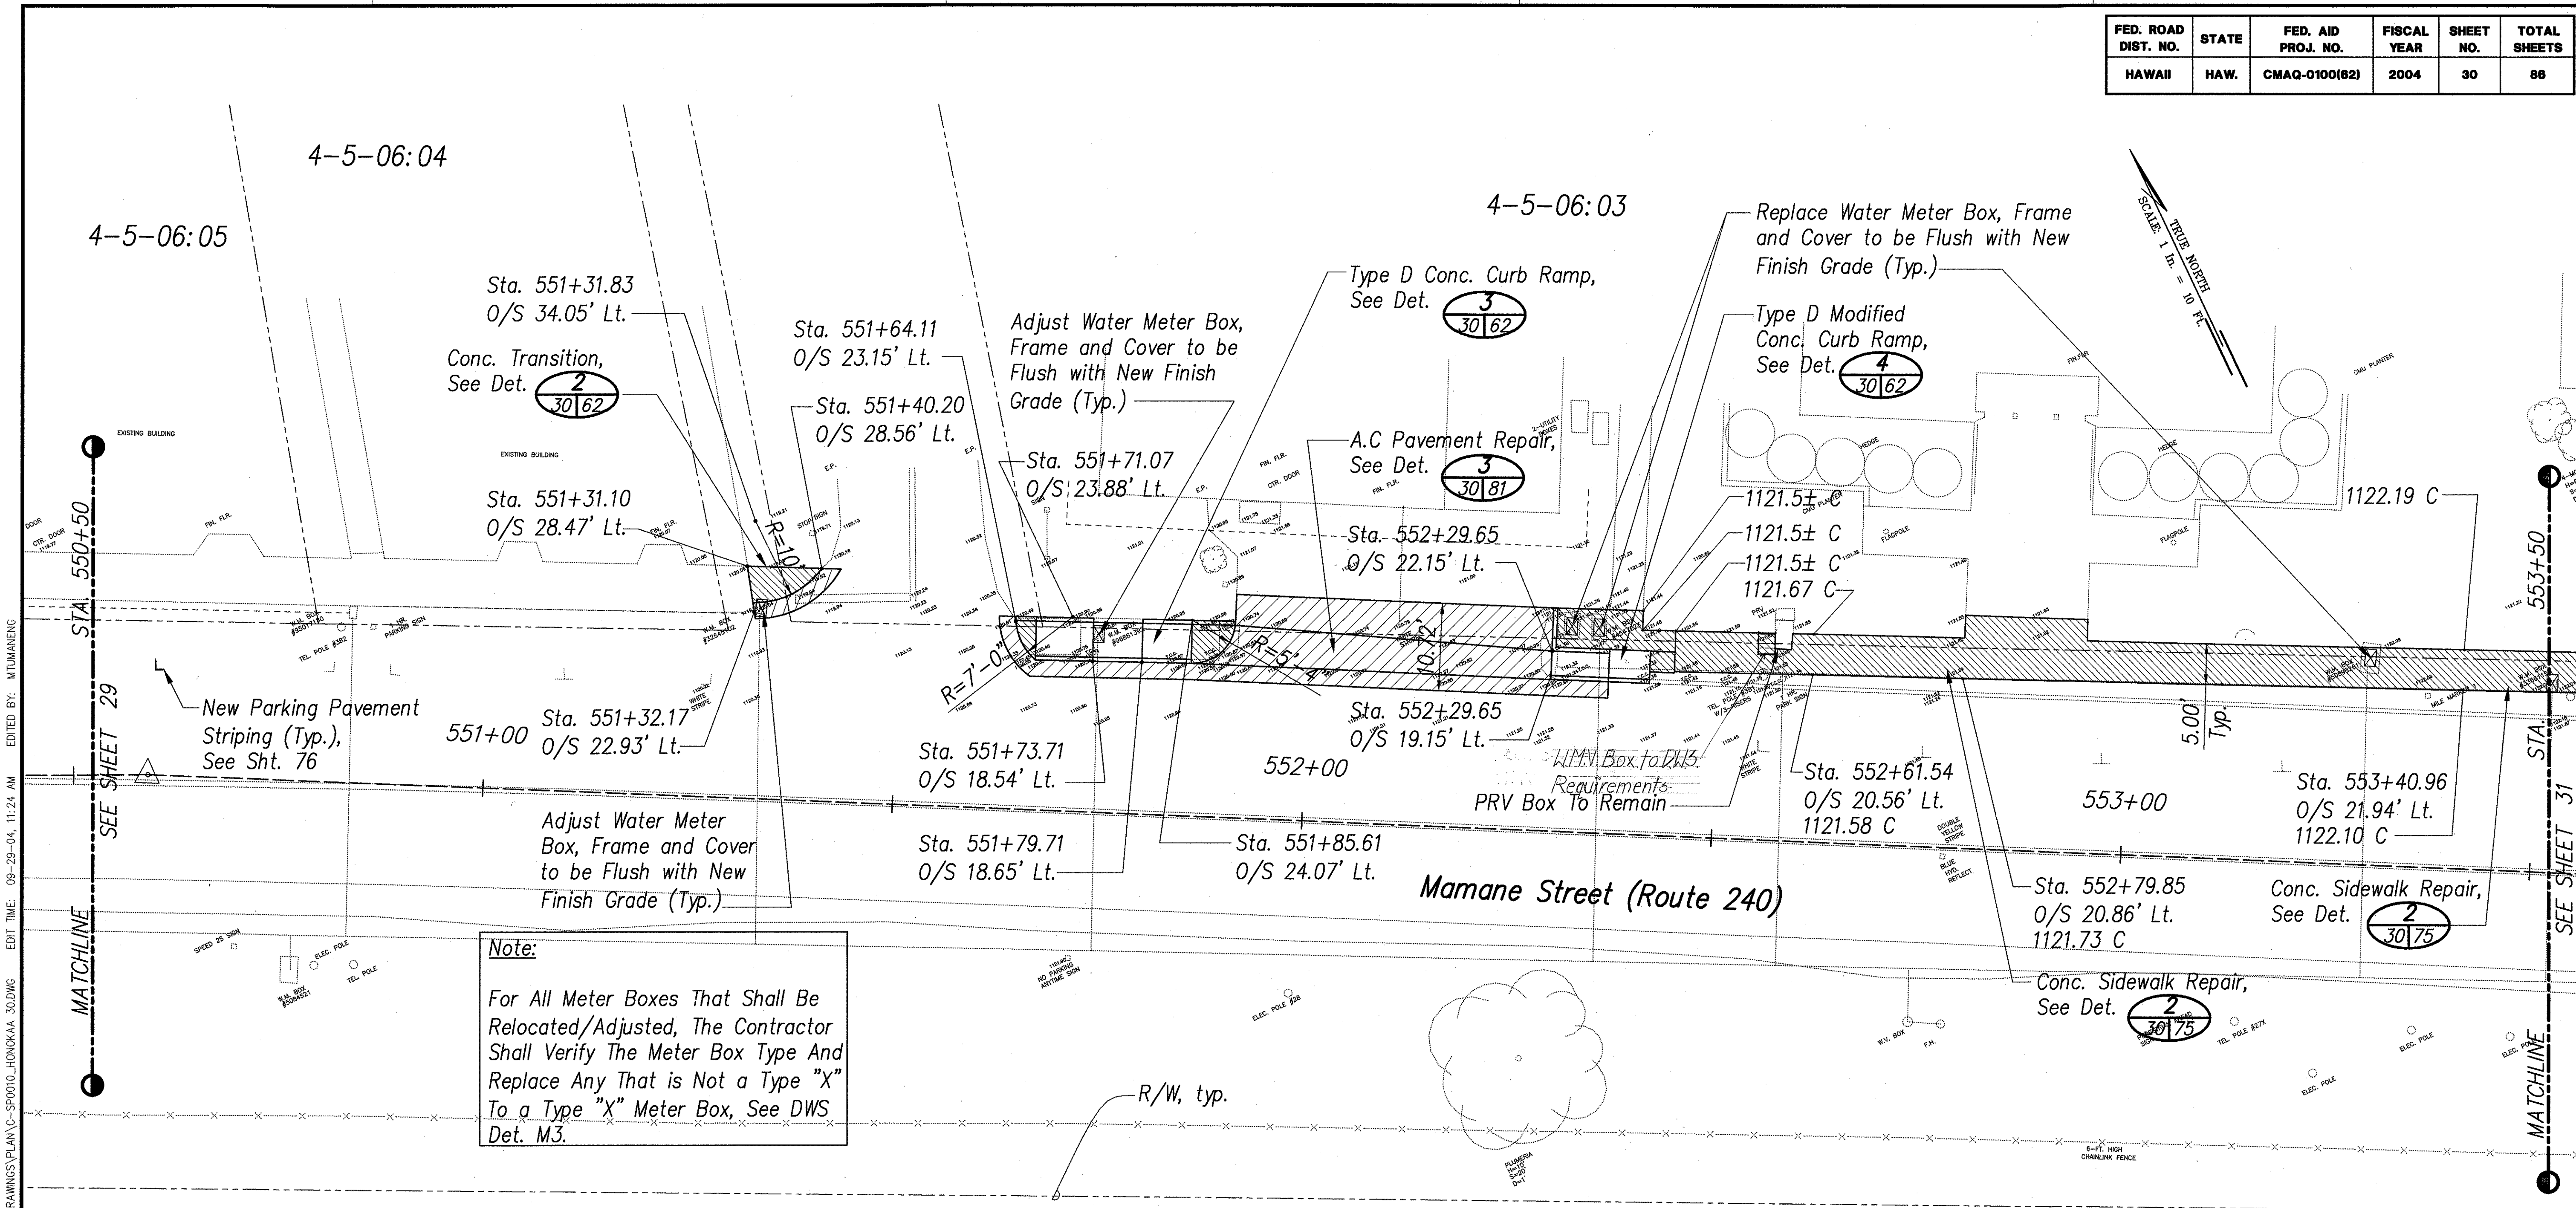



Note:
For All Meter Boxes That Shall Be Relocated/Adjusted, The Contractor Shall Verify The Meter Box Type And Replace Any That is Not a Type "X" To a Type "X" Meter Box, See DWS Det. M3.

ORIGINAL PLAN	DATE
DRAWN BY	9/2004
DESIGNED BY	9/2004
CHECKED BY	9/2004
NO.	

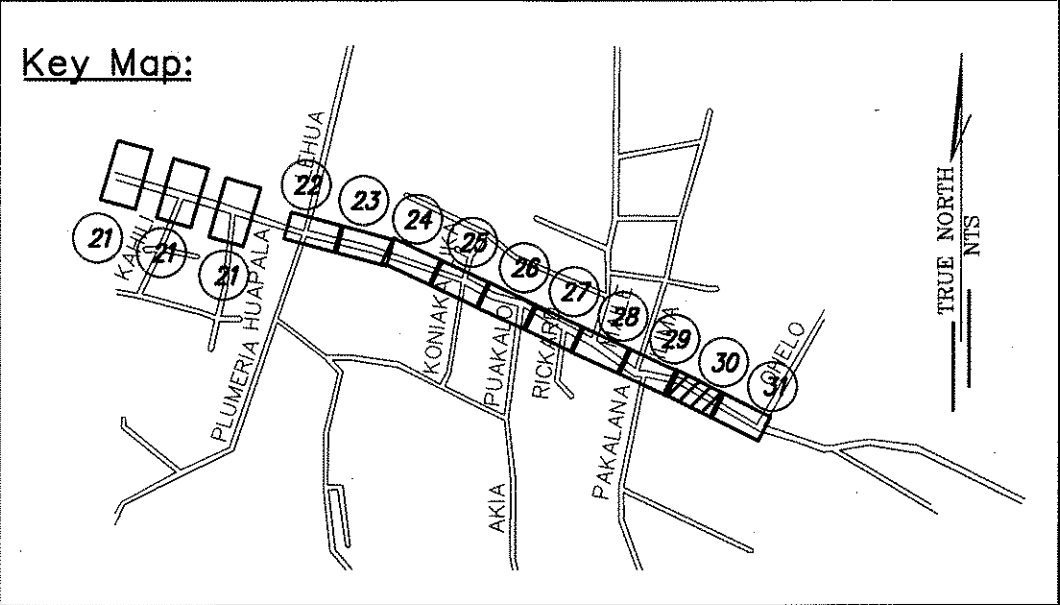

- Legend:**
- AC Pavement & AC Driveway Repair
 - Concrete Sidewalk & Concrete Driveway Repair

SITE PLAN – HONOKAA
SCALE: 1" = 10'

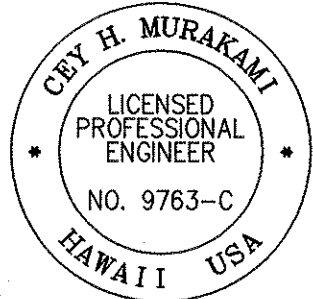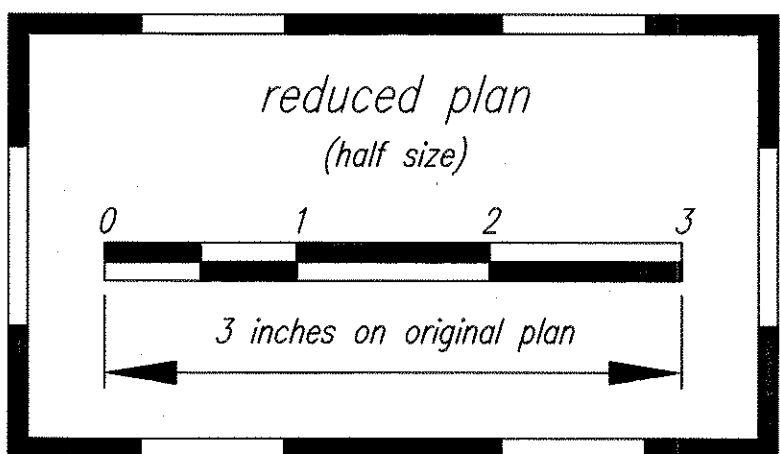

THIS WORK WAS PREPARED BY ME OR UNDER MY SUPERVISION

Cey H. Murakami 04/30/06
SIGNATURE EXPIRATION DATE OF THE LICENSE

"AS-BUILT"

STATE OF HAWAII
DEPARTMENT OF TRANSPORTATION
HIGHWAYS DIVISION

SITE PLAN – HONOKAA
MAMANE ST.
B STA. 550+50 TO STA. 553+50
PEDESTRIAN ACCESSIBILITY ROUTE
IMPROVEMENTS – HONOKAA, HAWAII, AND KAPAAU
Federal Aid Project No. CMAQ-0100(62)
Scale: AS NOTED Date: SEPT. 2004

