

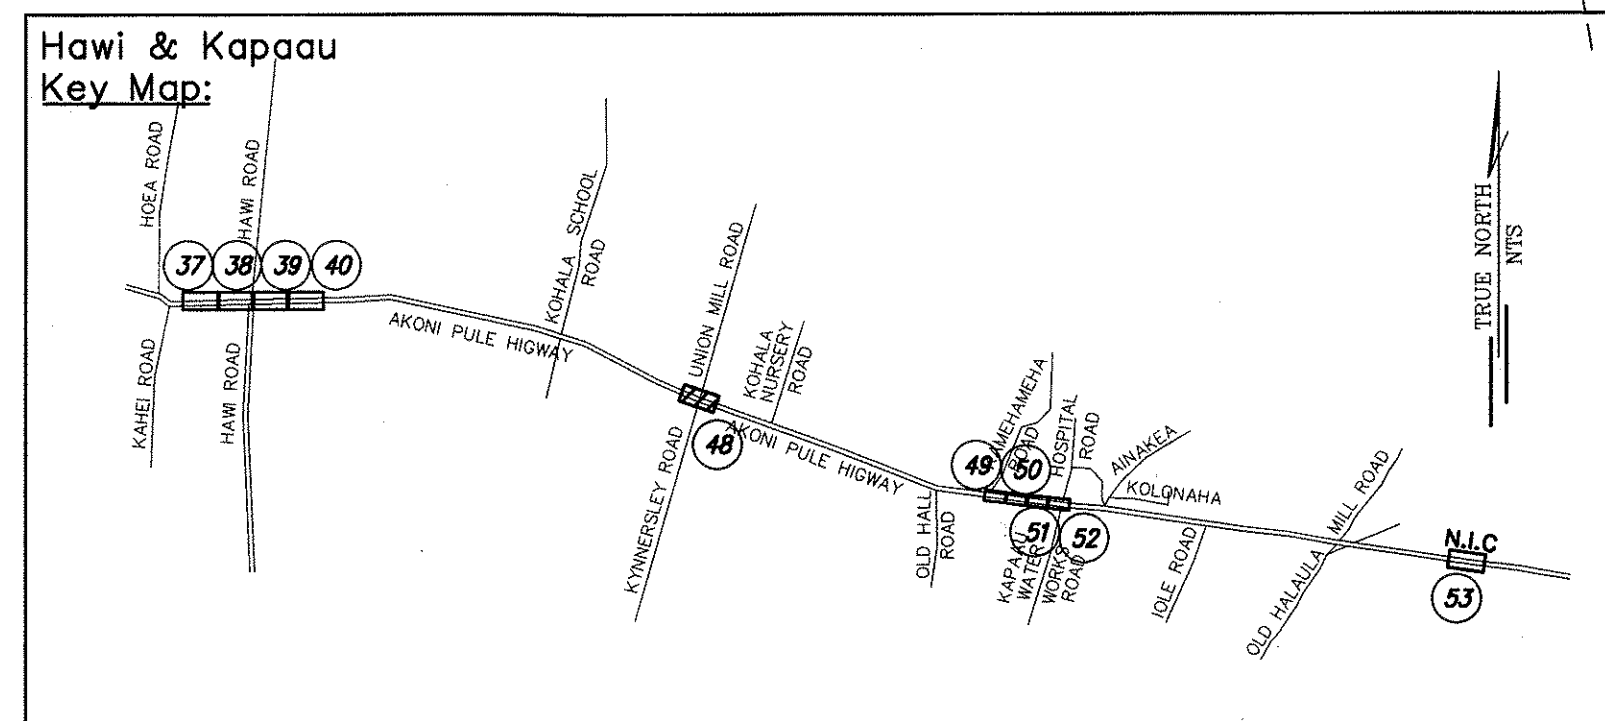


\\2000\2000_070.000 PROJECT POINT - PEDESTRIAN ACCESSIBILITY\G DRAWINGS\PLAN\C-SP0016_KAPAAU.DWG 05/11/02 11:18 MTM

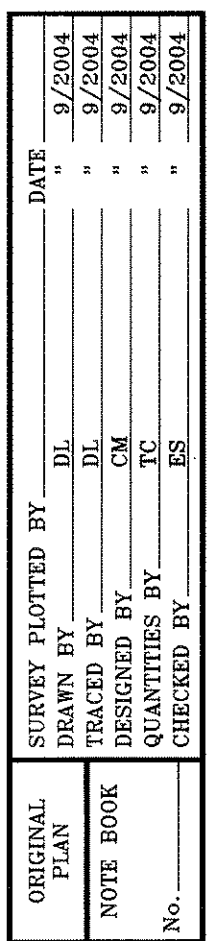

SCALE: 1" = 10'

1. Contractor Shall Provide A.C. Curb Breaks at Driveways and Utility Structures.
2. The Alignment For The New A.C. Curbs Shall Follow The Existing White Striping

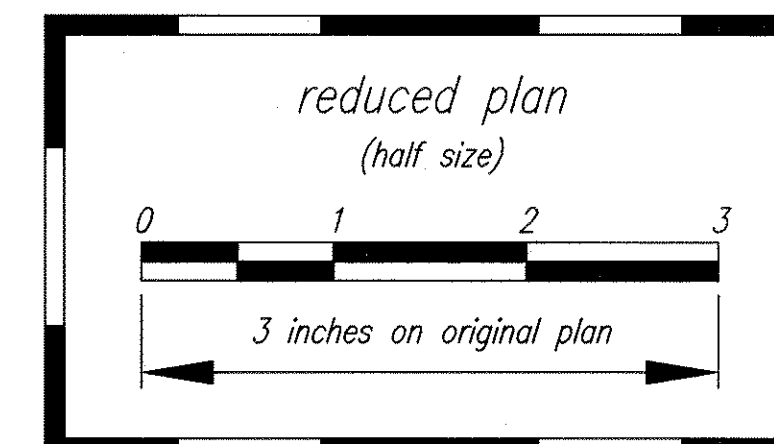

Cey H Mungfami
SIGNATURE


04/30/06
EXPIRATION DATE
OF THE LICENSE

STATE OF HAWAII
DEPARTMENT OF TRANSPORTATION
HIGHWAYS DIVISION


SITE PLAN - KAPAAU
UNION MILL AND KYNNEERSLY INTERSECTION
B. STA. 401+00 TO STA. 402+50
PEDESTRIAN ACCESSIBILITY ROUTE
IMPROVEMENTS - HONOKAA, HAWAII, AND KAPAAU
Federal Aid Project No. CMAQ-0100(62)

Scale: AS NOTED Date: SEPT. 2004

FED. ROAD DIST. NO.	STATE	FED. AID PROJ. NO.	FISCAL YEAR	SHEET NO.	TOTAL SHEETS
HAWAII	HAW.	CMAQ-0100(62)	2004	49	86

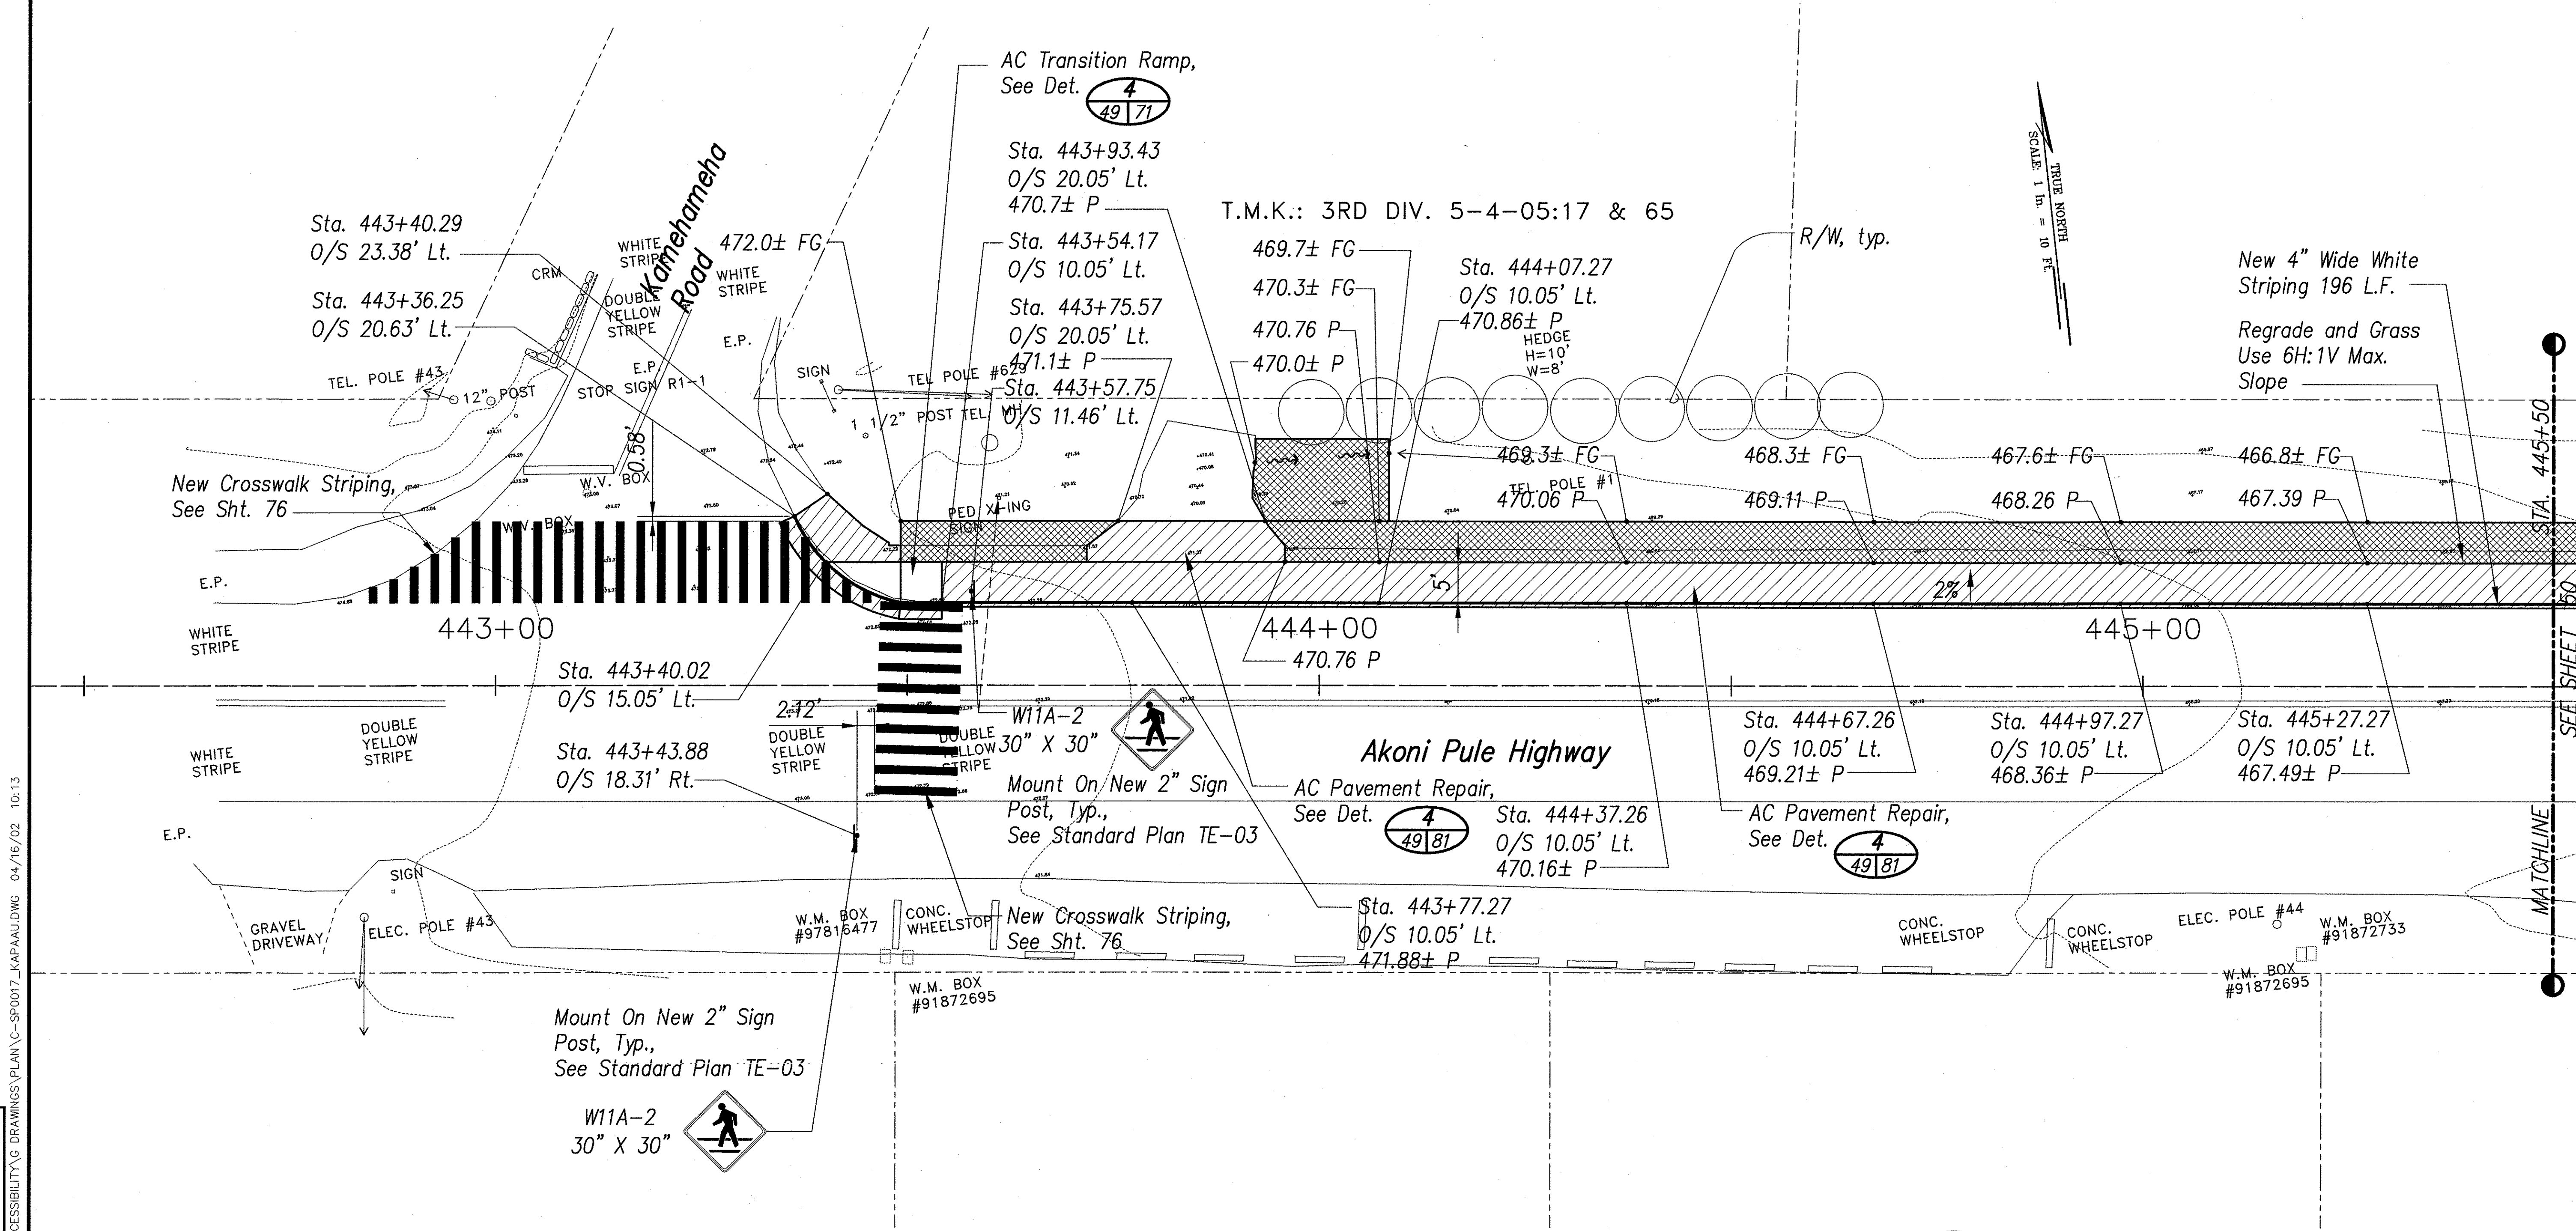

ORIGINAL PLAN	DATE
DESIGNED BY	9/2004
DRAWN BY	9/2004
CHECKED BY	9/2004
IN CHARGE	9/2004


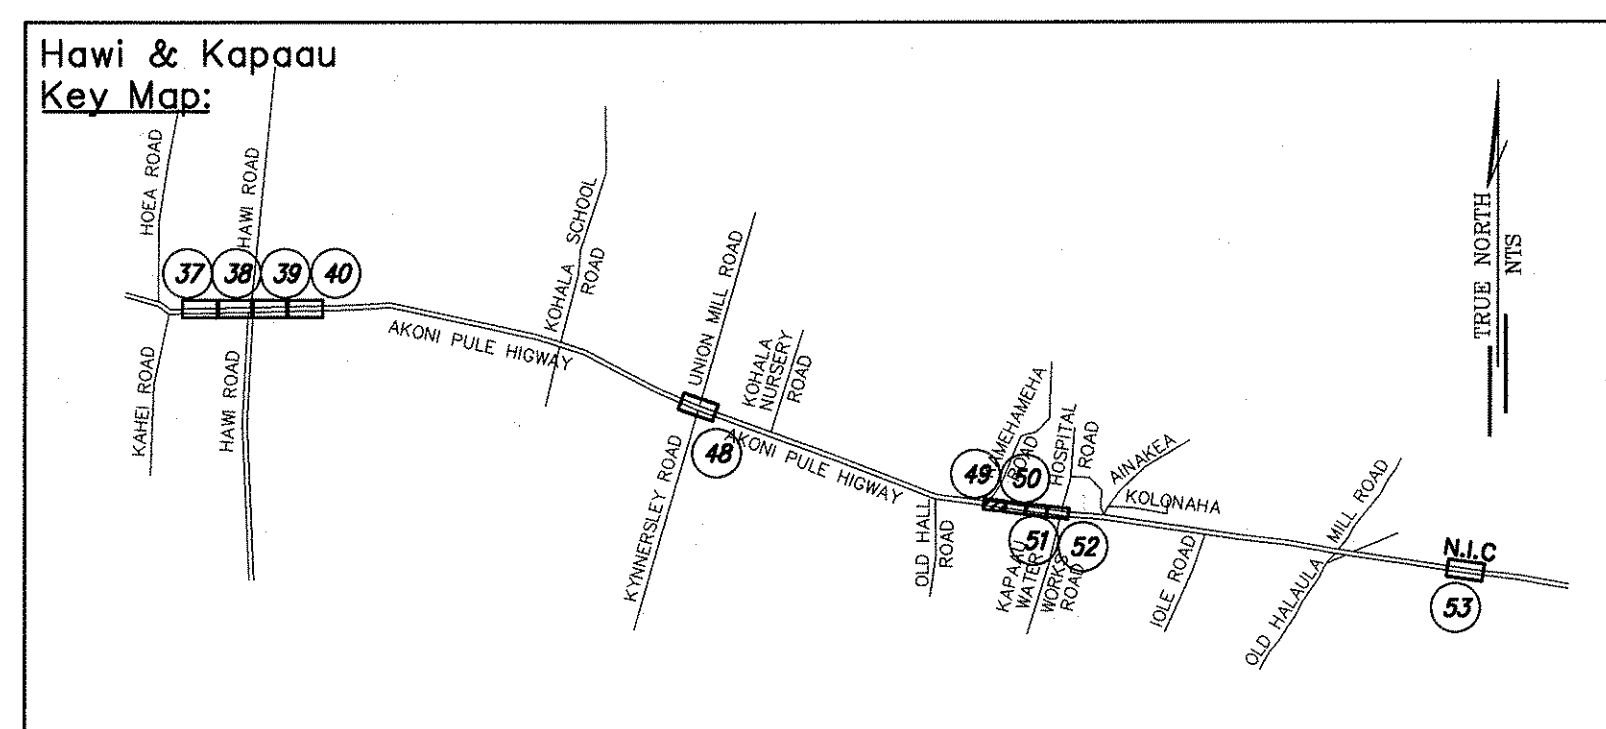


Legend:

- AC Pavement & AC Driveway Repair
- Concrete Sidewalk & Concrete Driveway Repair
- Grassing

SITE PLAN - KAPAAU

SCALE: 1" = 10'

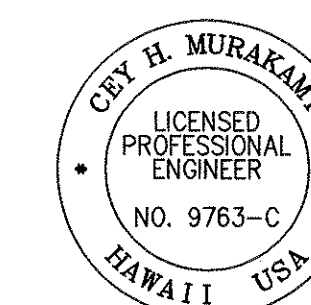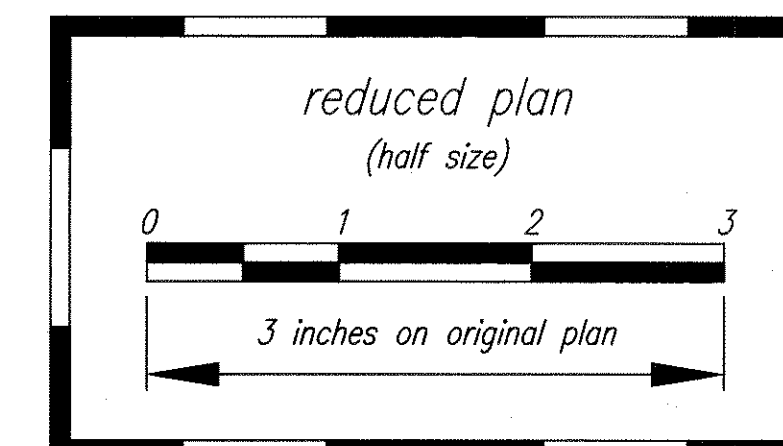

THIS WORK WAS PREPARED BY ME OR UNDER MY SUPERVISION


Cey H. Murakami 04/30/06
SIGNATURE EXPIRATION DATE OF THE LICENSE

STATE OF HAWAII
DEPARTMENT OF TRANSPORTATION
HIGHWAYS DIVISION

SITE PLAN - KAPAAU
AKONI PULE HIGHWAY
R STA. 442+50 TO STA. 445+50
PEDESTRIAN ACCESSIBILITY ROUTE
IMPROVEMENTS - HONOKAA, HAWI, AND KAPAAU
Federal Aid Project No. CMAQ-0100(62)
Scale: AS NOTED Date: SEPT. 2004

SHEET No. 49 OF 86 SHEETS

FED. ROAD DIST. NO.	STATE	FED. AID PROJ. NO.	FISCAL YEAR	SHEET NO.	TOTAL SHEETS
HAWAII	HAW.	CMAQ-0100(62)	2004	50	86

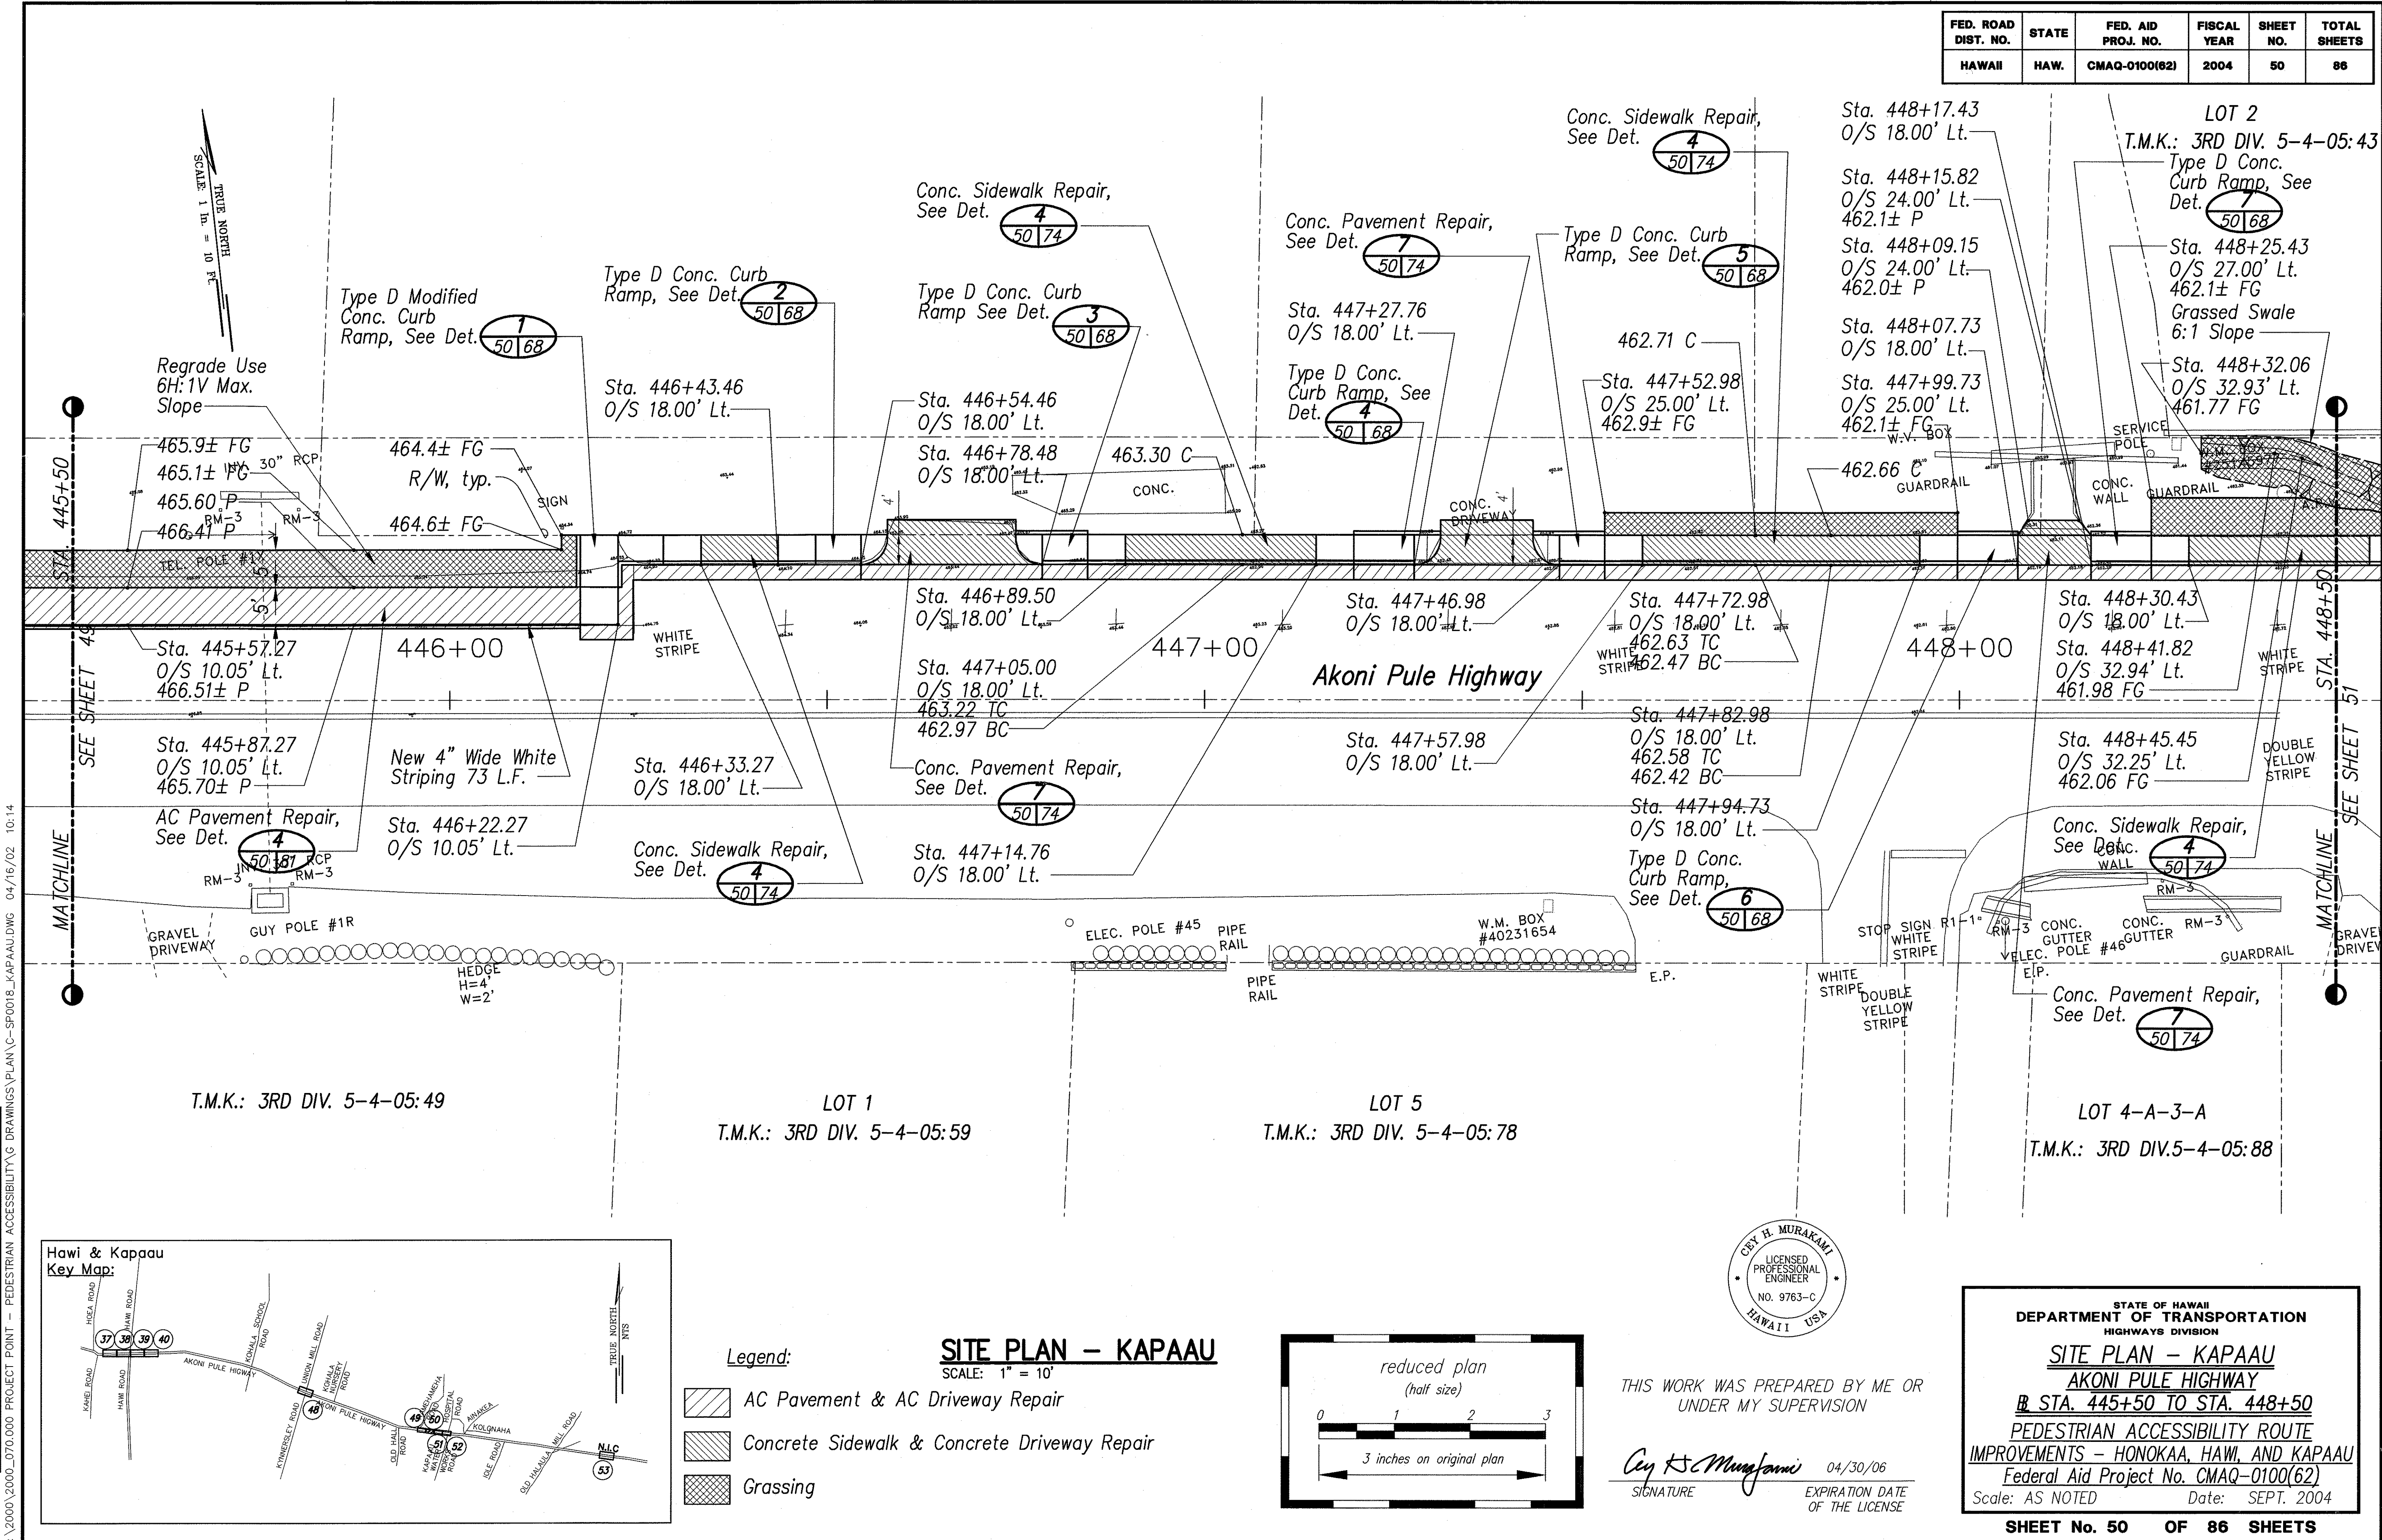

FED. ROAD DIST. NO.	STATE	FED. AID PROJ. NO.	FISCAL YEAR	SHEET NO.	TOTAL SHEETS
HAWAII	HAW.	CMAQ-0100(62)	2004	51	86

LOT 1
T.M.K.: 3RD DIV. 5-4-05:48

T.M.K.: 3RD DIV. 5-4-05:22

T.M.K.: 3RD DIV.
5-4-05:28

Sta. 451+39.88
O/S. 18.06' Lt.

Sta. 451+38.98
O/S. 21.94' Lt.

Sta. 451+28.01
O/S. 21.97' Lt.

Concrete Sidewalk Repair

Sta. 451+25.33
O/S. 18.20' Rt.

Sta. 451+43.75
O/S. 18.18' Rt.

Sta. 451+27.27
O/S. 22.93' Rt.

Sta. 451+34.29
O/S. 22.93' Rt.

Sta. 451+39.88
O/S. 18.06' Lt.

Sta. 451+38.98
O/S. 21.94' Lt.

Sta. 451+28.01
O/S. 21.97' Lt.

Sta. 451+25.33
O/S. 18.20' Rt.

Sta. 451+43.75
O/S. 18.18' Rt.

Sta. 451+27.27
O/S. 22.93' Rt.

Sta. 451+34.29
O/S. 22.93' Rt.

Sta. 451+39.88
O/S. 18.06' Lt.

Sta. 451+38.98
O/S. 21.94' Lt.

Sta. 451+28.01
O/S. 21.97' Lt.

Sta. 451+25.33
O/S. 18.20' Rt.

Sta. 451+43.75
O/S. 18.18' Rt.

Sta. 451+27.27
O/S. 22.93' Rt.

Sta. 451+34.29
O/S. 22.93' Rt.

Sta. 451+39.88
O/S. 18.06' Lt.

Sta. 451+38.98
O/S. 21.94' Lt.


Sta. 451+28.01
O/S. 21.97' Lt.

Sta. 451+25.33
O/S. 18.20' Rt.

Sta. 451+43.75
O/S. 18.18' Rt.

Sta. 451+27.27
O/S. 22.93' Rt.

Sta. 451+34.29
O/S. 22.93' Rt.

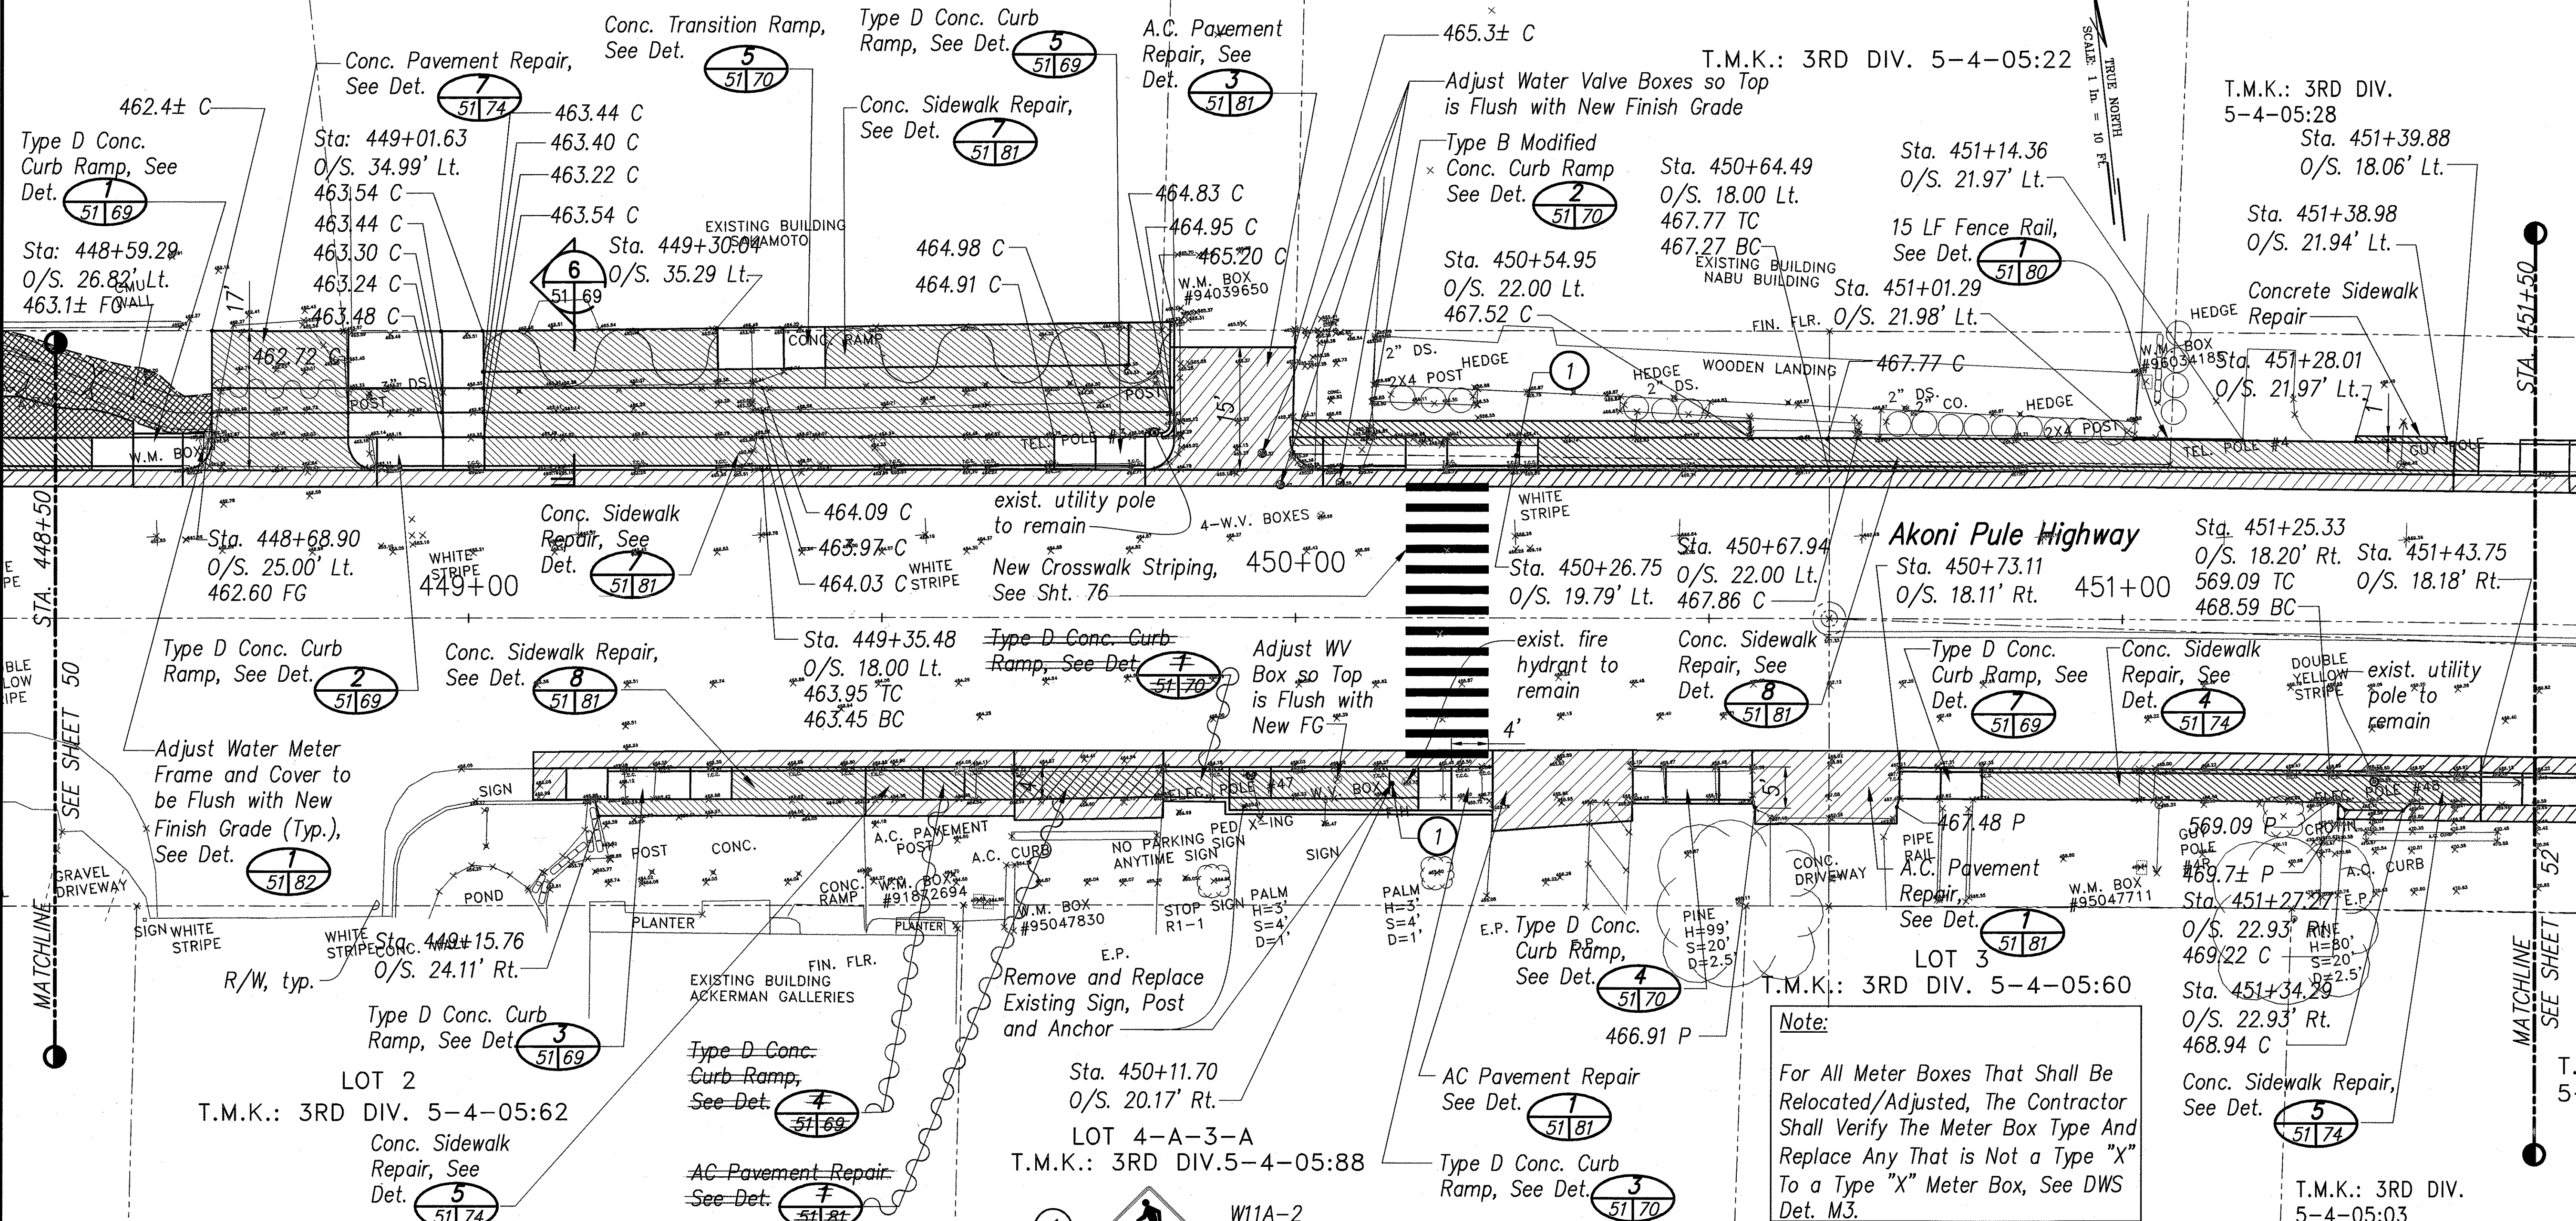

Note:
For All Meter Boxes That Shall Be Relocated/Adjusted, The Contractor Shall Verify The Meter Box Type And Replace Any That is Not a Type "X" To a Type "X" Meter Box, See DWS Det. M3.




THIS WORK WAS PREPARED BY ME OR UNDER MY SUPERVISION

Cey H. Murakami
SIGNATURE
EXPIRATION DATE OF THE LICENSE 04/30/06

"AS-BUILT"

STATE OF HAWAII
DEPARTMENT OF TRANSPORTATION
HIGHWAYS DIVISION
SITE PLAN - KAPAAU
AKONI PULE HIGHWAY
B STA. 448+50 TO STA. 451+50
PEDESTRIAN ACCESSIBILITY ROUTE IMPROVEMENTS - HONOKAA, HAWAII, AND KAPAAU
Federal Aid Project No. CMAQ-0100(62)
Scale: AS NOTED Date: SEPT. 2004
SHEET No. 51 OF 86 SHEETS

SURVEY PLOTTED BY	DATE
DRAWN BY	9/2004
TRACED BY	9/2004
NOTED BY	9/2004
CHECKED BY	9/2004

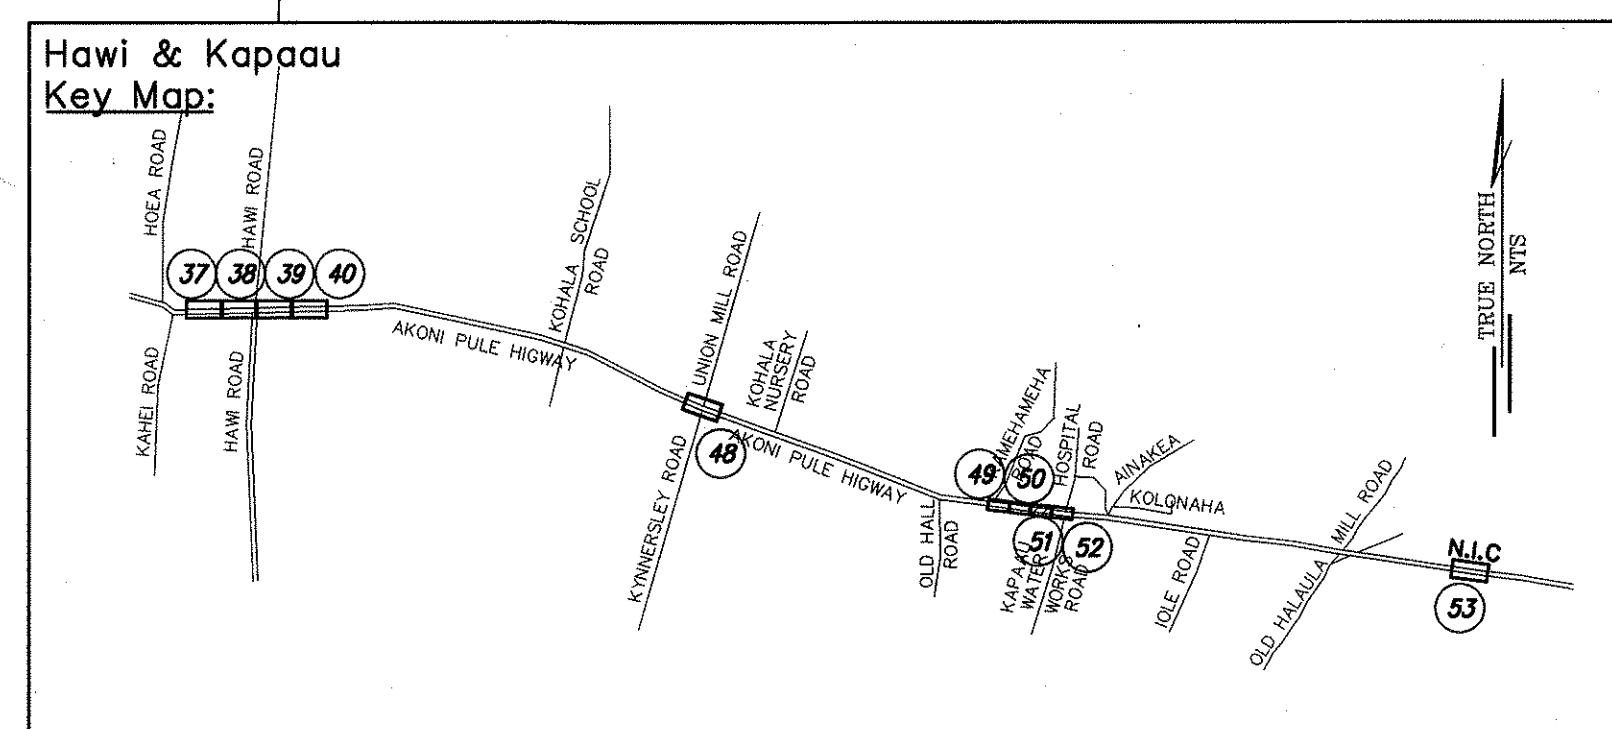


Legend:


- AC Pavement & AC Driveway Repair
- Concrete Sidewalk & Concrete Driveway Repair
- Grassing

SITE PLAN - KAPAAU
SCALE: 1" = 10'


1 W11A-2
30" X 30"
Mount On New 2" Sign Post, Typ.,
See Standard Plan TE-03

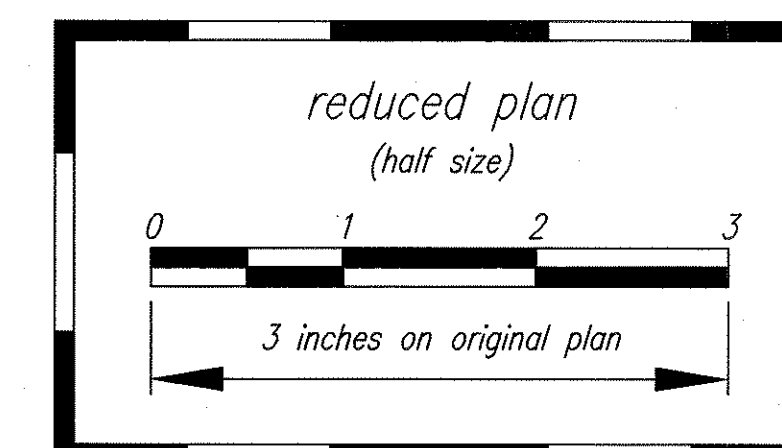

FED. ROAD DIST. NO.	STATE	FED. AID PROJ. NO.	FISCAL YEAR	SHEET NO.	TOTAL SHEETS
HAWAII	HAW.	CMAQ-0100(62)	2004	52	86

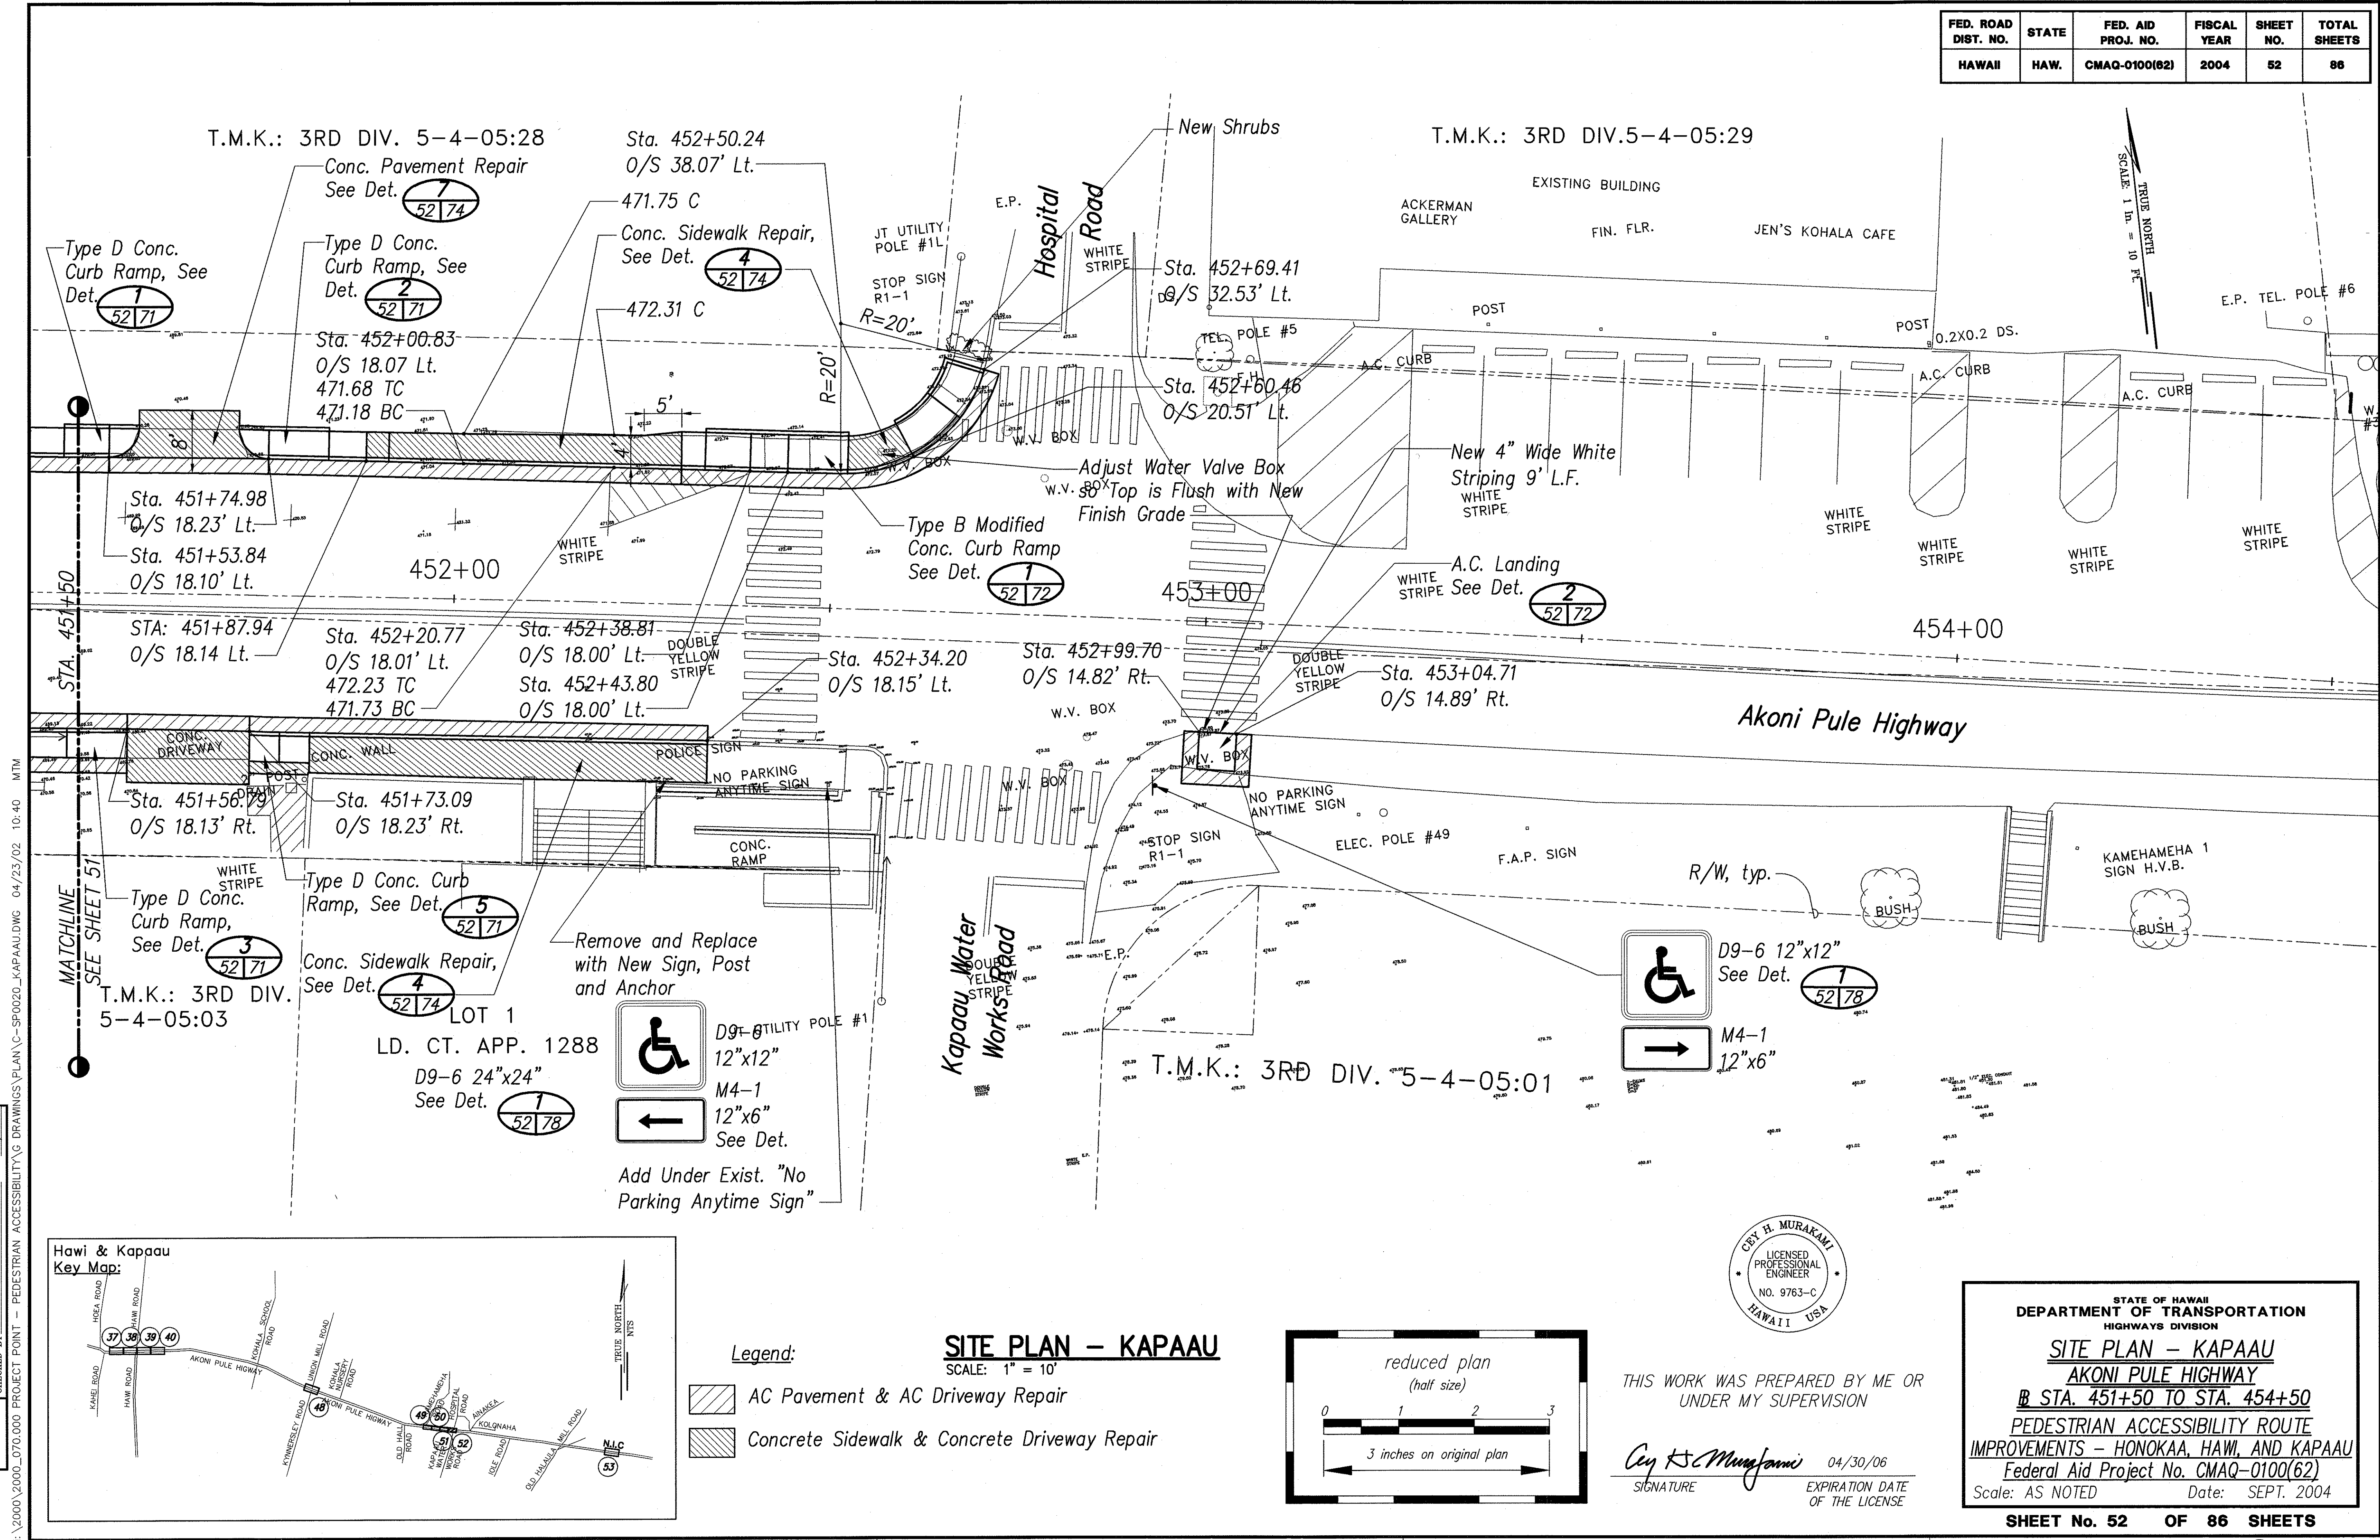


ORIGINAL PLAN	DATE
DRAWN BY	9/2004
DESIGNED BY	9/2004
CHECKED BY	9/2004
NOTED BY	9/2004
NO.	

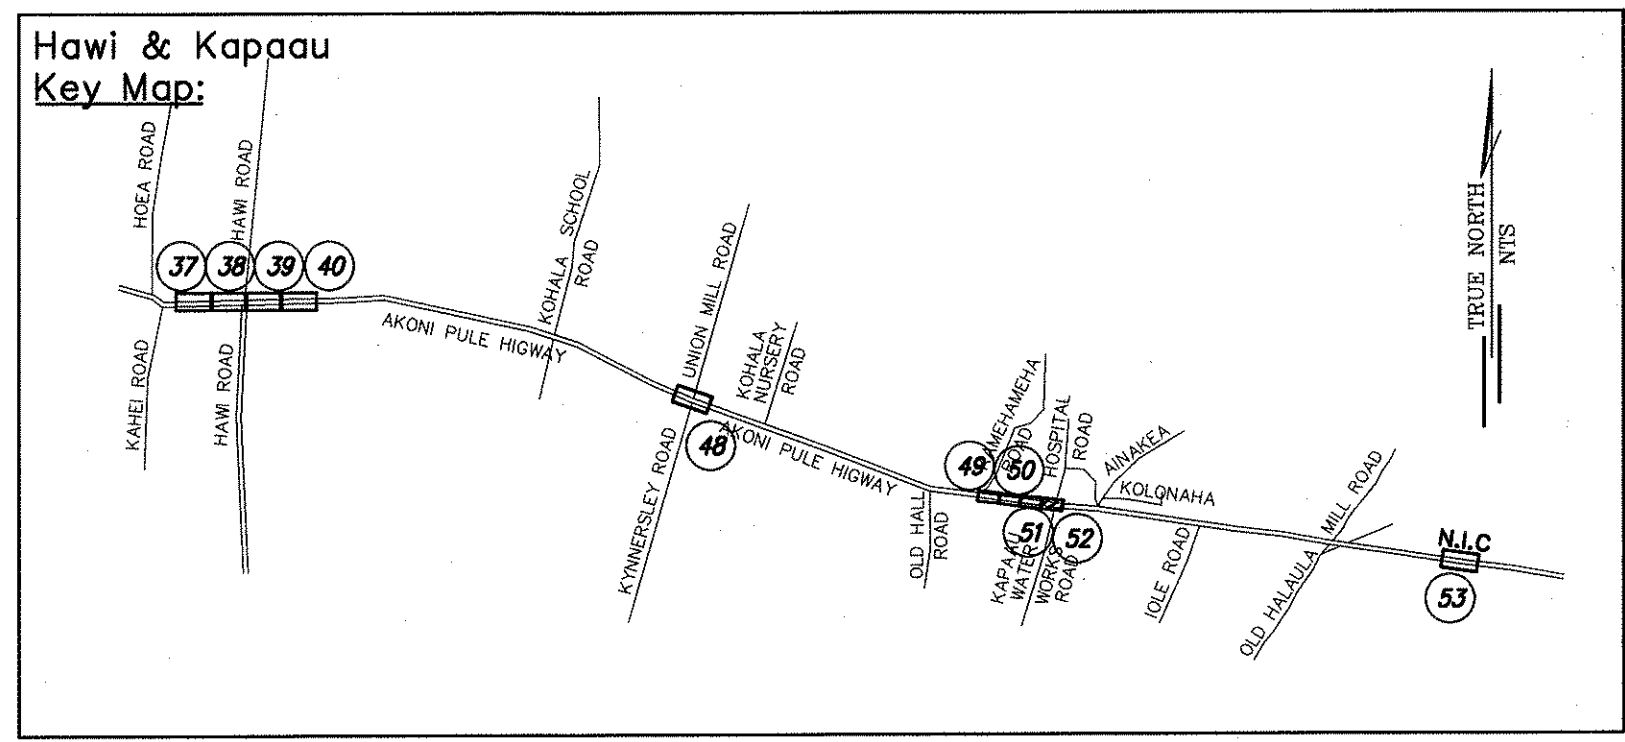

Legend:


- AC Pavement & AC Driveway Repair
- Concrete Sidewalk & Concrete Driveway Repair

SITE PLAN - KAPAAU
SCALE: 1" = 10'

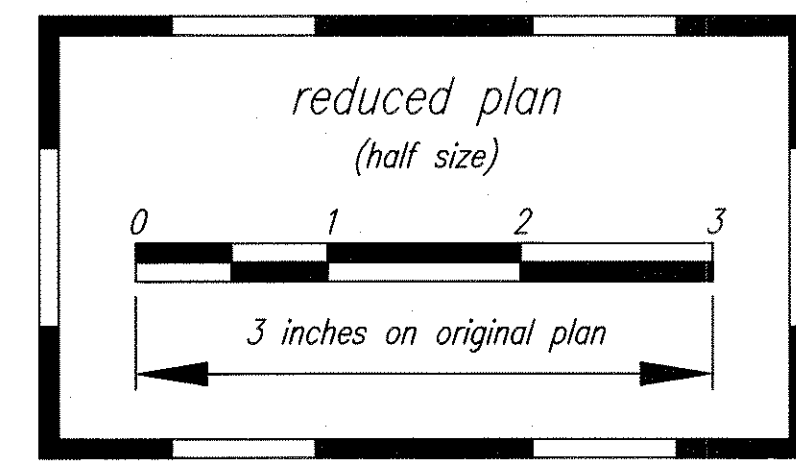

THIS WORK WAS PREPARED BY ME OR UNDER MY SUPERVISION

Cy H. Murakami 04/30/06
SIGNATURE EXPIRATION DATE OF THE LICENSE

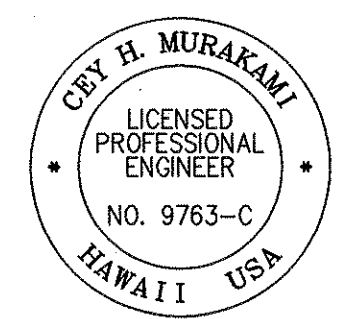

STATE OF HAWAII
DEPARTMENT OF TRANSPORTATION
HIGHWAYS DIVISION

SITE PLAN - KAPAAU
AKONI PULE HIGHWAY
B STA. 451+50 TO STA. 454+50
PEDESTRIAN ACCESSIBILITY ROUTE
IMPROVEMENTS - HONOKAA, HAWI, AND KAPAAU
Federal Aid Project No. CMAQ-0100(62)
Scale: AS NOTED Date: SEPT. 2004