
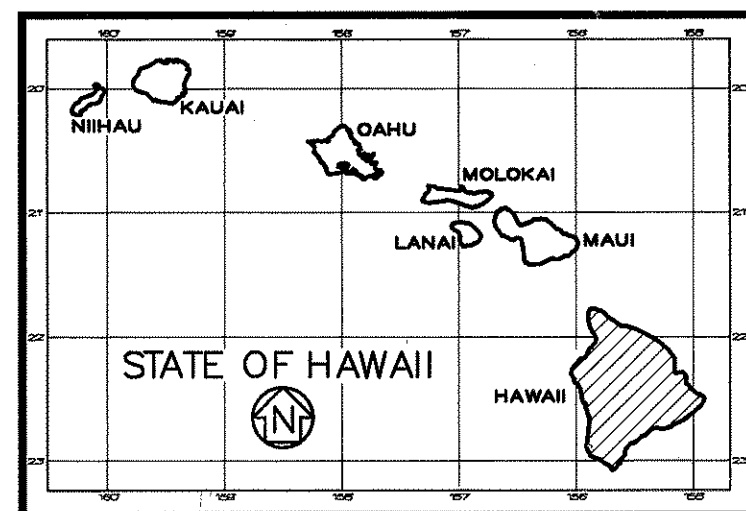



INDEX TO DRAWINGS	
SHEET NO.	DESCRIPTION
1	TITLE SHEET
2	STANDARD PLANS SUMMARY
3	LEGEND
4-8	GENERAL NOTES
9	OVERALL SITE PLAN - HONOKAA
10-20	DEMOLITION PLAN - HONOKAA
21-31	SITE PLAN - HONOKAA
32	OVERALL SITE PLAN - HAWI
33-36	DEMOLITION PLAN - HAWI
37-40	SITE PLAN - HAWI
41	OVERALL SITE PLAN - KAPAAU
42-46	DEMOLITION PLAN - KAPAAU
47	DEMOLITION PLAN - KAPAAU - N.I.C.
48-52	SITE PLAN - KAPAAU
53	SITE PLAN - KAPAAU - N.I.C.
54-63	HONOKAA - RAMP DETAILS
64-67	HAWI - RAMP DETAILS
68-69	KAPAAU - RAMP DETAILS
70	KAPAAU & HAWI RAMP DETAILS
71-72	KAPAAU - RAMP DETAILS
73-83	MISCELLANEOUS DETAILS
84	PROFILES
85	EROSION CONTROL DETAILS
86	SIGN SCHEDULE

STATE OF HAWAII
DEPARTMENT OF TRANSPORTATION
HIGHWAYS DIVISION
HONOLULU, HAWAII
"AS-BUILT"
PLANS FOR
PEDESTRIAN ACCESSIBILITY
ROUTE IMPROVEMENTS
HONOKAA, HAWI, AND KAPAAU
FEDERAL AID PROJECT NO. CMAQ-0100(62)
DISTRICTS OF HAMAKUA AND NORTH KOHALA
ISLAND OF HAWAII


FED. ROAD DIST. NO.	STATE	FED. AID PROJ. NO.	FISCAL YEAR	SHEET NO.	TOTAL SHEETS
HAWAII	HAW.	CMAQ-0100(62)	2004	1	86

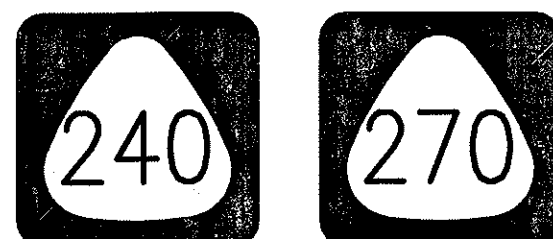


8/16/04
DATE
933-8866
PHONE
HWY-H
MANAGED BY
SSFM INTERNATIONAL, INC.
DESIGNED BY

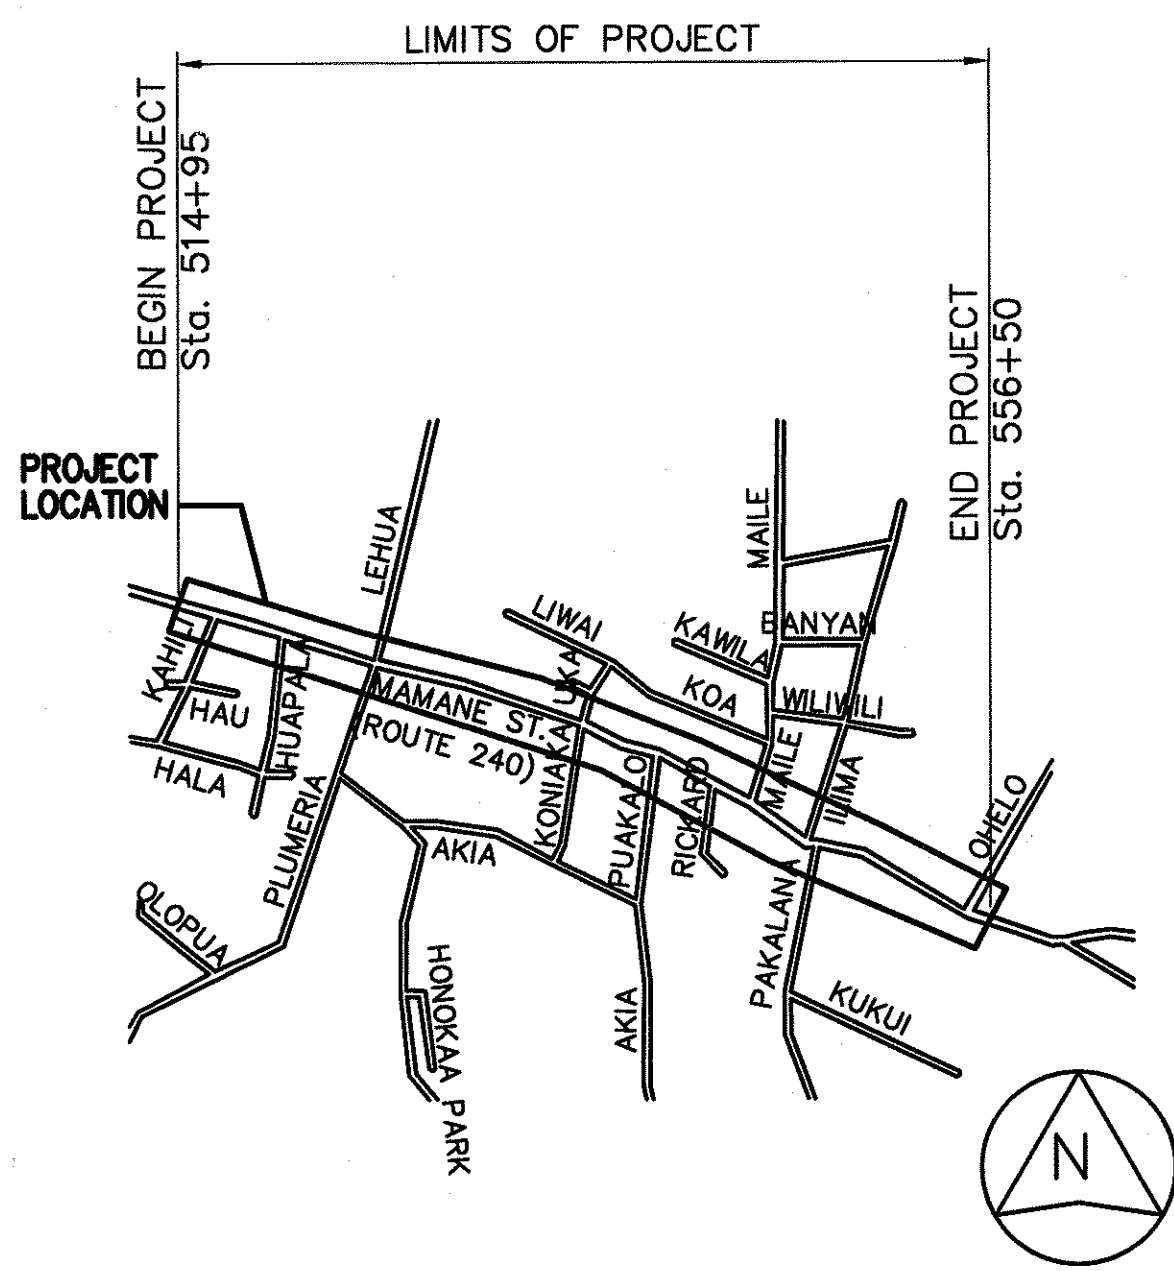

HONOKAA (ROUTE 240) - LOCATION MAP
NOT TO SCALE

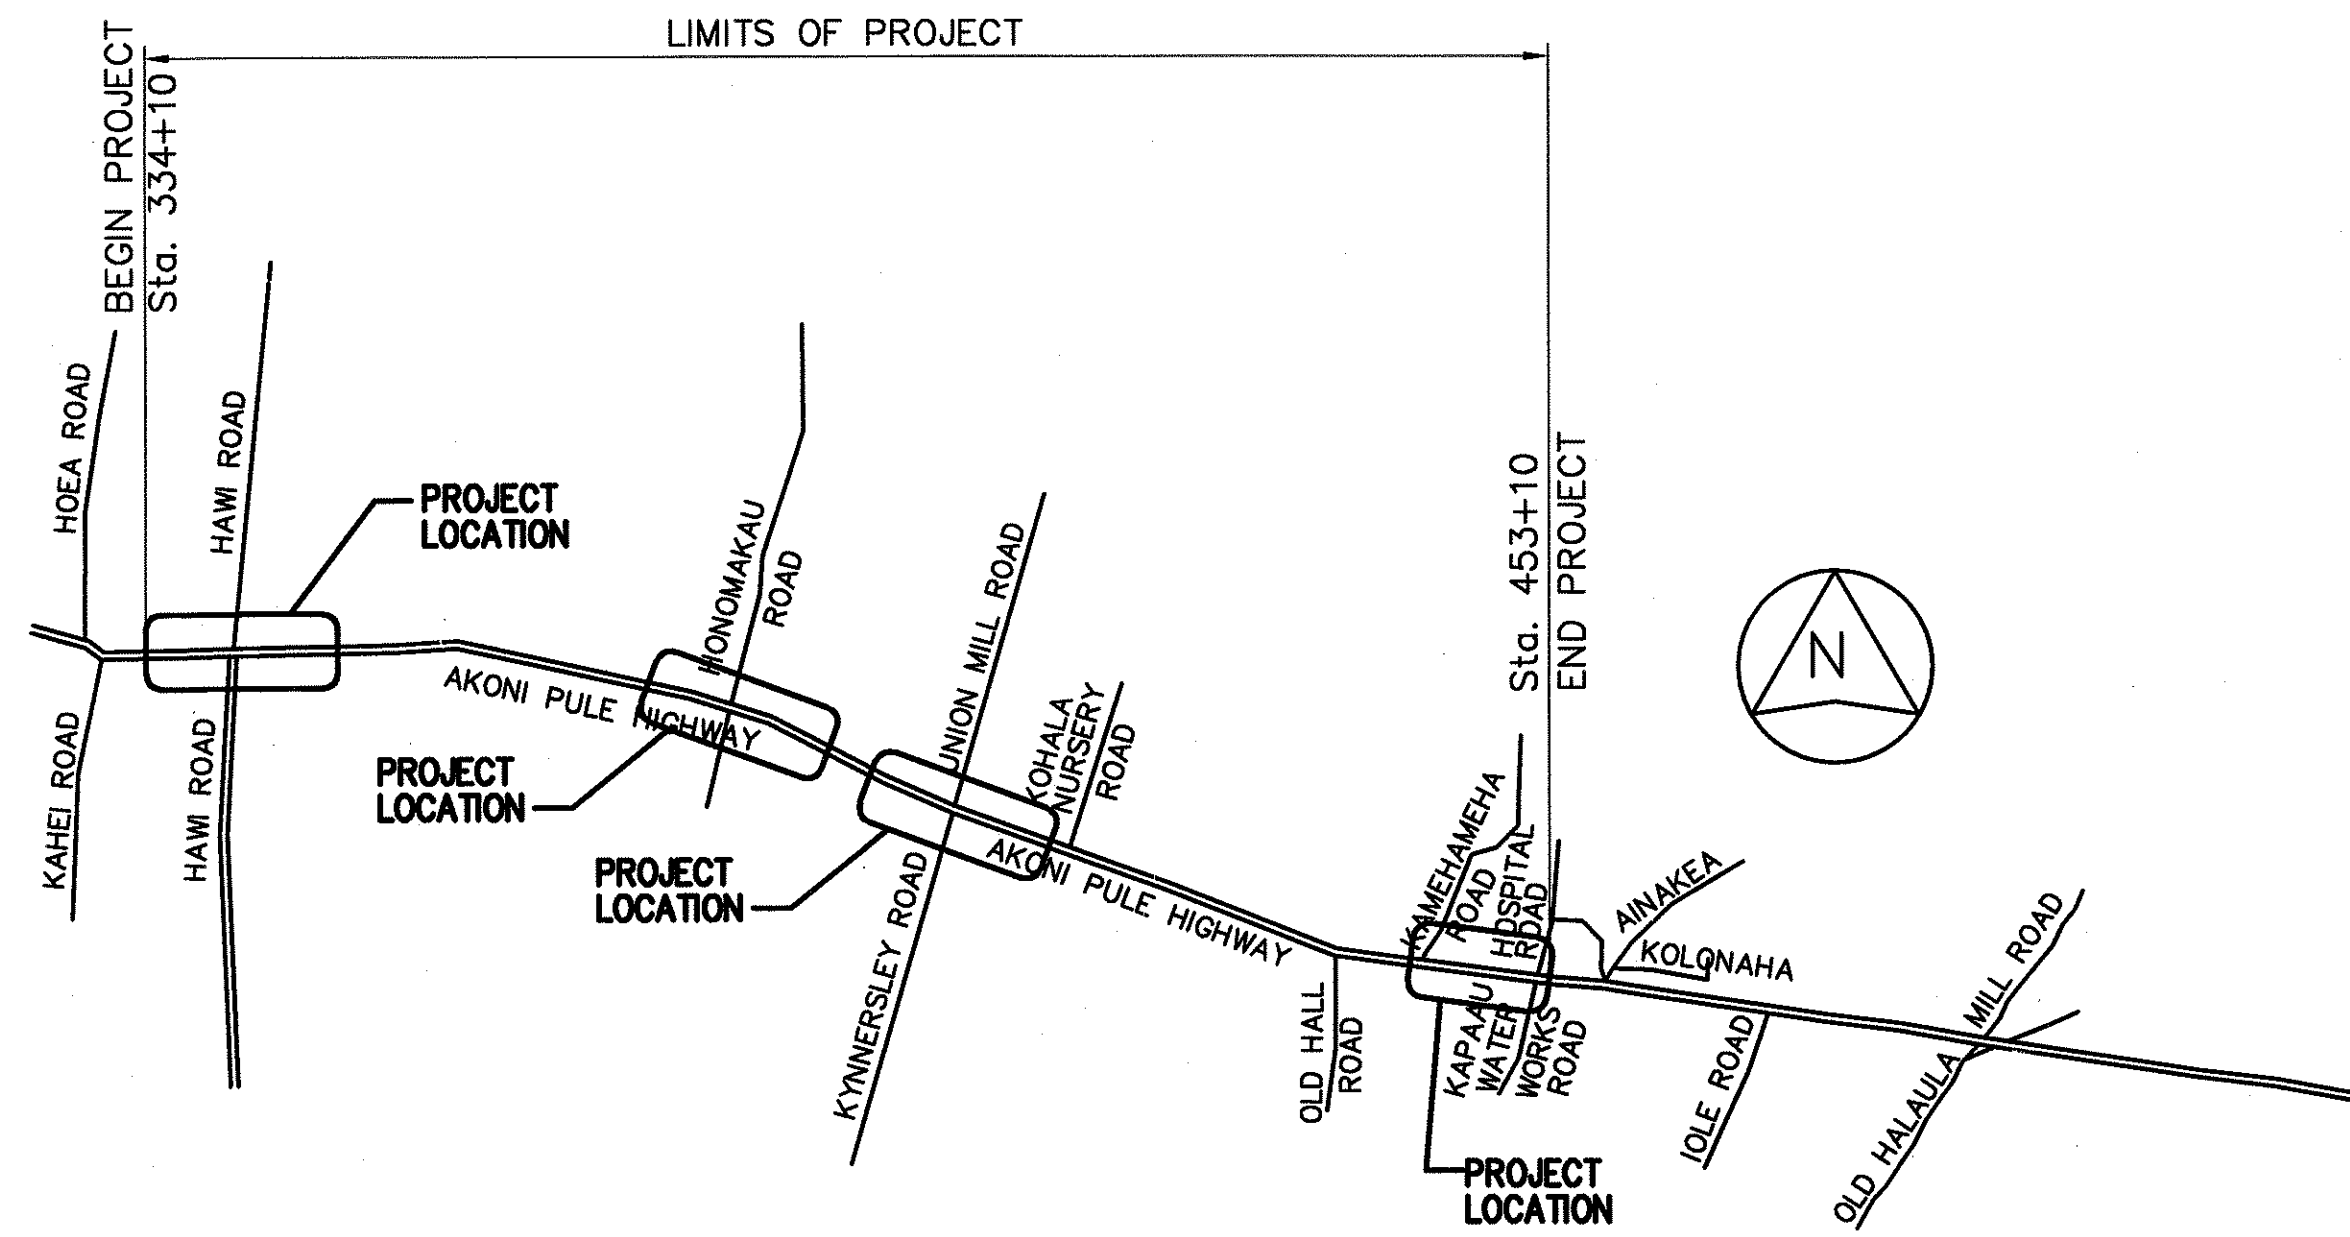

HAWI & KAPAAU (ROUTE 270) - LOCATION MAP
NOT TO SCALE

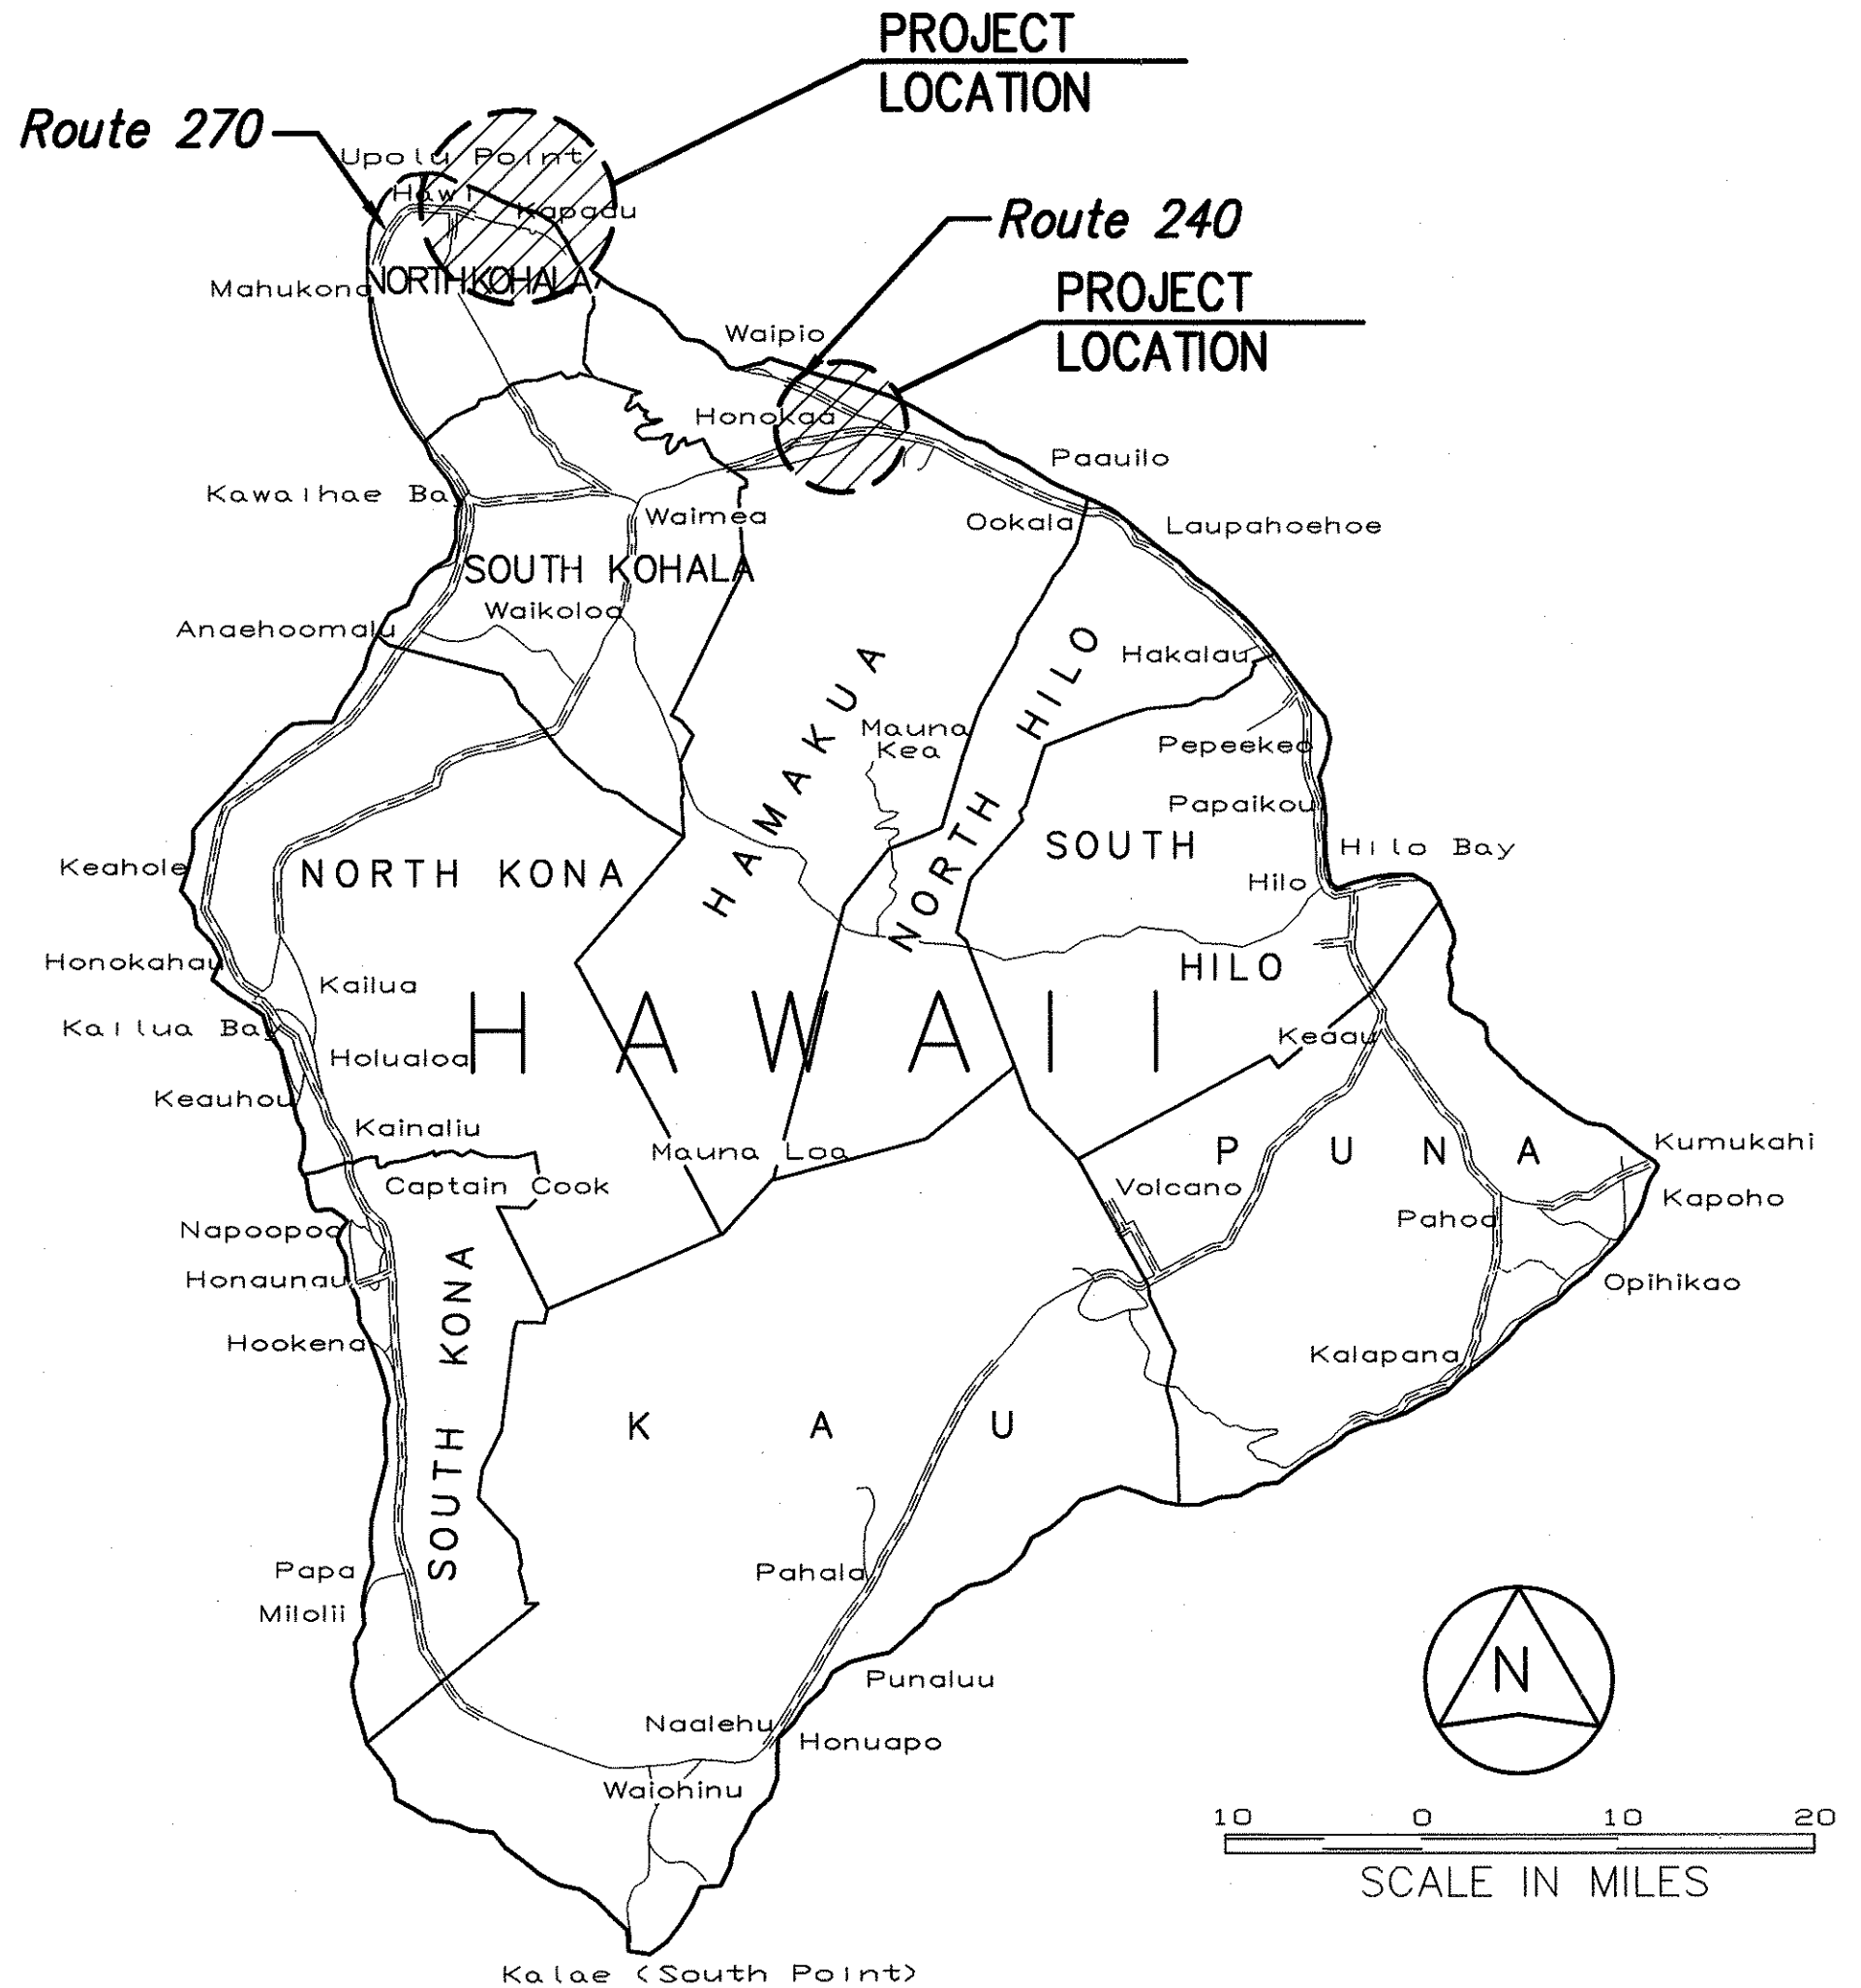

Route 240: Mile Post 1.73 to Mile Post 0.94
Route 270: Mile Post 21.12 to Mile Post 23.37

MANAGER, DEPARTMENT OF WATER SUPPLY,
COUNTY OF HAWAII
APPROVED:
DIR. OF TRANSPORTATION
DATE 9/22/04

CHANGES MADE DURING CONSTRUCTION HAVE BEEN
INCORPORATED ON THESE PLANS EXCEPT CHANGES
IN THE ORIGINAL THEORETICAL QUANTITIES. FOR
ACTUAL QUANTITIES, REFER TO PROJECT LEDGER
AND/OR COMPUTATION BOOK.
Charles A. Lohrke
RESIDENT ENGINEER
4-16-08
DATE