

INDEX TO DRAWINGS	
SHEET NO.	DESCRIPTION
1	TITLE SHEET
2	DETAILED INDEX
3	STANDARD PLANS SUMMARY
4-12	GENERAL NOTES
13-14	LOCATION PLAN
15-36	DETAILS
37-99	CURB RAMP SITE, GRADING & TRAFFIC SIGNAL PLANS
① 100-105	TYPICAL TRAFFIC CONTROL PLANS

Sheet Nos. ① C.O. 105 S-1, C.O. 105 S-2, and C.O. 105 S-3 are Supplementary Sheets to this project. Also, project no. 139A-01-05M (Select Sheets) is for reference drawings only.  
Total sheet count after "As-Built" posting 129 sheets.

STATE OF HAWAII

DEPARTMENT OF TRANSPORTATION

HIGHWAYS DIVISION

HONOLULU, HAWAII

"AS-BUILT"

PLANS FOR

PEDESTRIAN FACILITIES & ADA COMPLIANCE AT


VARIOUS LOCATIONS ON HAWAII

FEDERAL AID PROJECT NO. CMAQ-0100 (66)

DISTRICTS OF SOUTH HILO, PUNA, KA'U, AND NORTH KONA

ISLAND OF HAWAII

FED. ROAD DIST. NO.	STATE	PROJ. NO.	FISCAL YEAR	SHEET NO.	TOTAL SHEETS
HAWAII	HAW.	CMAQ-0100(66)	2004	1	105

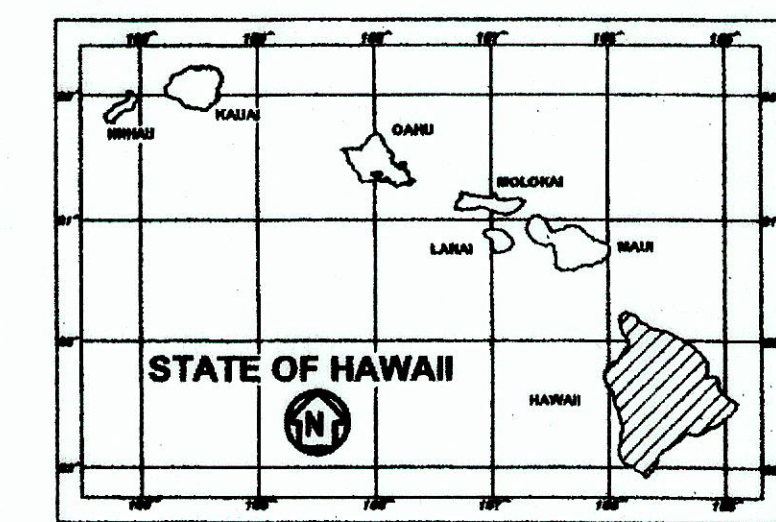

PROJECT SITES

- ① Mamalahoa Hwy. (Route 11)
- MILE POST 63.52 TO MILE POST 63.52
- ② Kanoelehua Ave. (Route 11)
- MILE POST 0.00 TO MILE POST 1.60
- ③ Kalaniana'ole St. (Route 19)
- MILE POST 1.00 TO MILE POST 0.08
- ④ Puainako Street (Route 2000)
- MILE POST 0.72 TO MILE POST 1.58
- ⑤ Kamehameha Ave. (Route 19)
- MILE POST 1.21 TO MILE POST 0.84
- ⑥ Kuakini Hwy. (Route 11)
- MILE POST 117.32 TO MILE POST 117.32
- ⑦ Queen Kaahumanu Hwy. (Route 19)
- MILE POST 121.78 TO MILE POST 122.08
- ⑧ Kiholo Scenic Lookout (Route 19)
- MILE POST 82.08 TO MILEPOST 82.08
- ⑨ Old Keaau-Paho Road (Route 139)
- MILEPOST 0.00 TO MILEPOST 1.20



CHANGES MADE DURING CONSTRUCTION HAVE BEEN INCORPORATED ON THESE PLANS EXCEPT CHANGES IN THE ORIGINAL THEORETICAL QUANTITIES. FOR ACTUAL QUANTITIES, REFER TO PROJECT LEDGER AND/OR COMPUTATION BOOK.

RESIDENT ENGINEER 9/6/18 DATE

DEPARTMENT OF TRANSPORTATION

STATE OF HAWAII

APPROVED:

DIR. OF TRANSPORTATION

8.27.04

DATE

DESIGNED BY

PARSONS BRINCKERHOFF QUADE & DOUGLAS

MANAGED BY

DATE

AUGUST 2004

PHONE

692-7545

DATE

8/27/04

ORIGINAL PLAN	DATE
DESIGNED BY	
TRACED BY	
QUANTITIES BY	
CHECKED BY	