





FED. ROAD DIST. NO.	STATE	FED. AID PROJ. NO.	FISCAL YEAR	SHEET NO.	TOTAL SHEETS
HAWAII	HAW.	ER-15(19)	2009	23	59

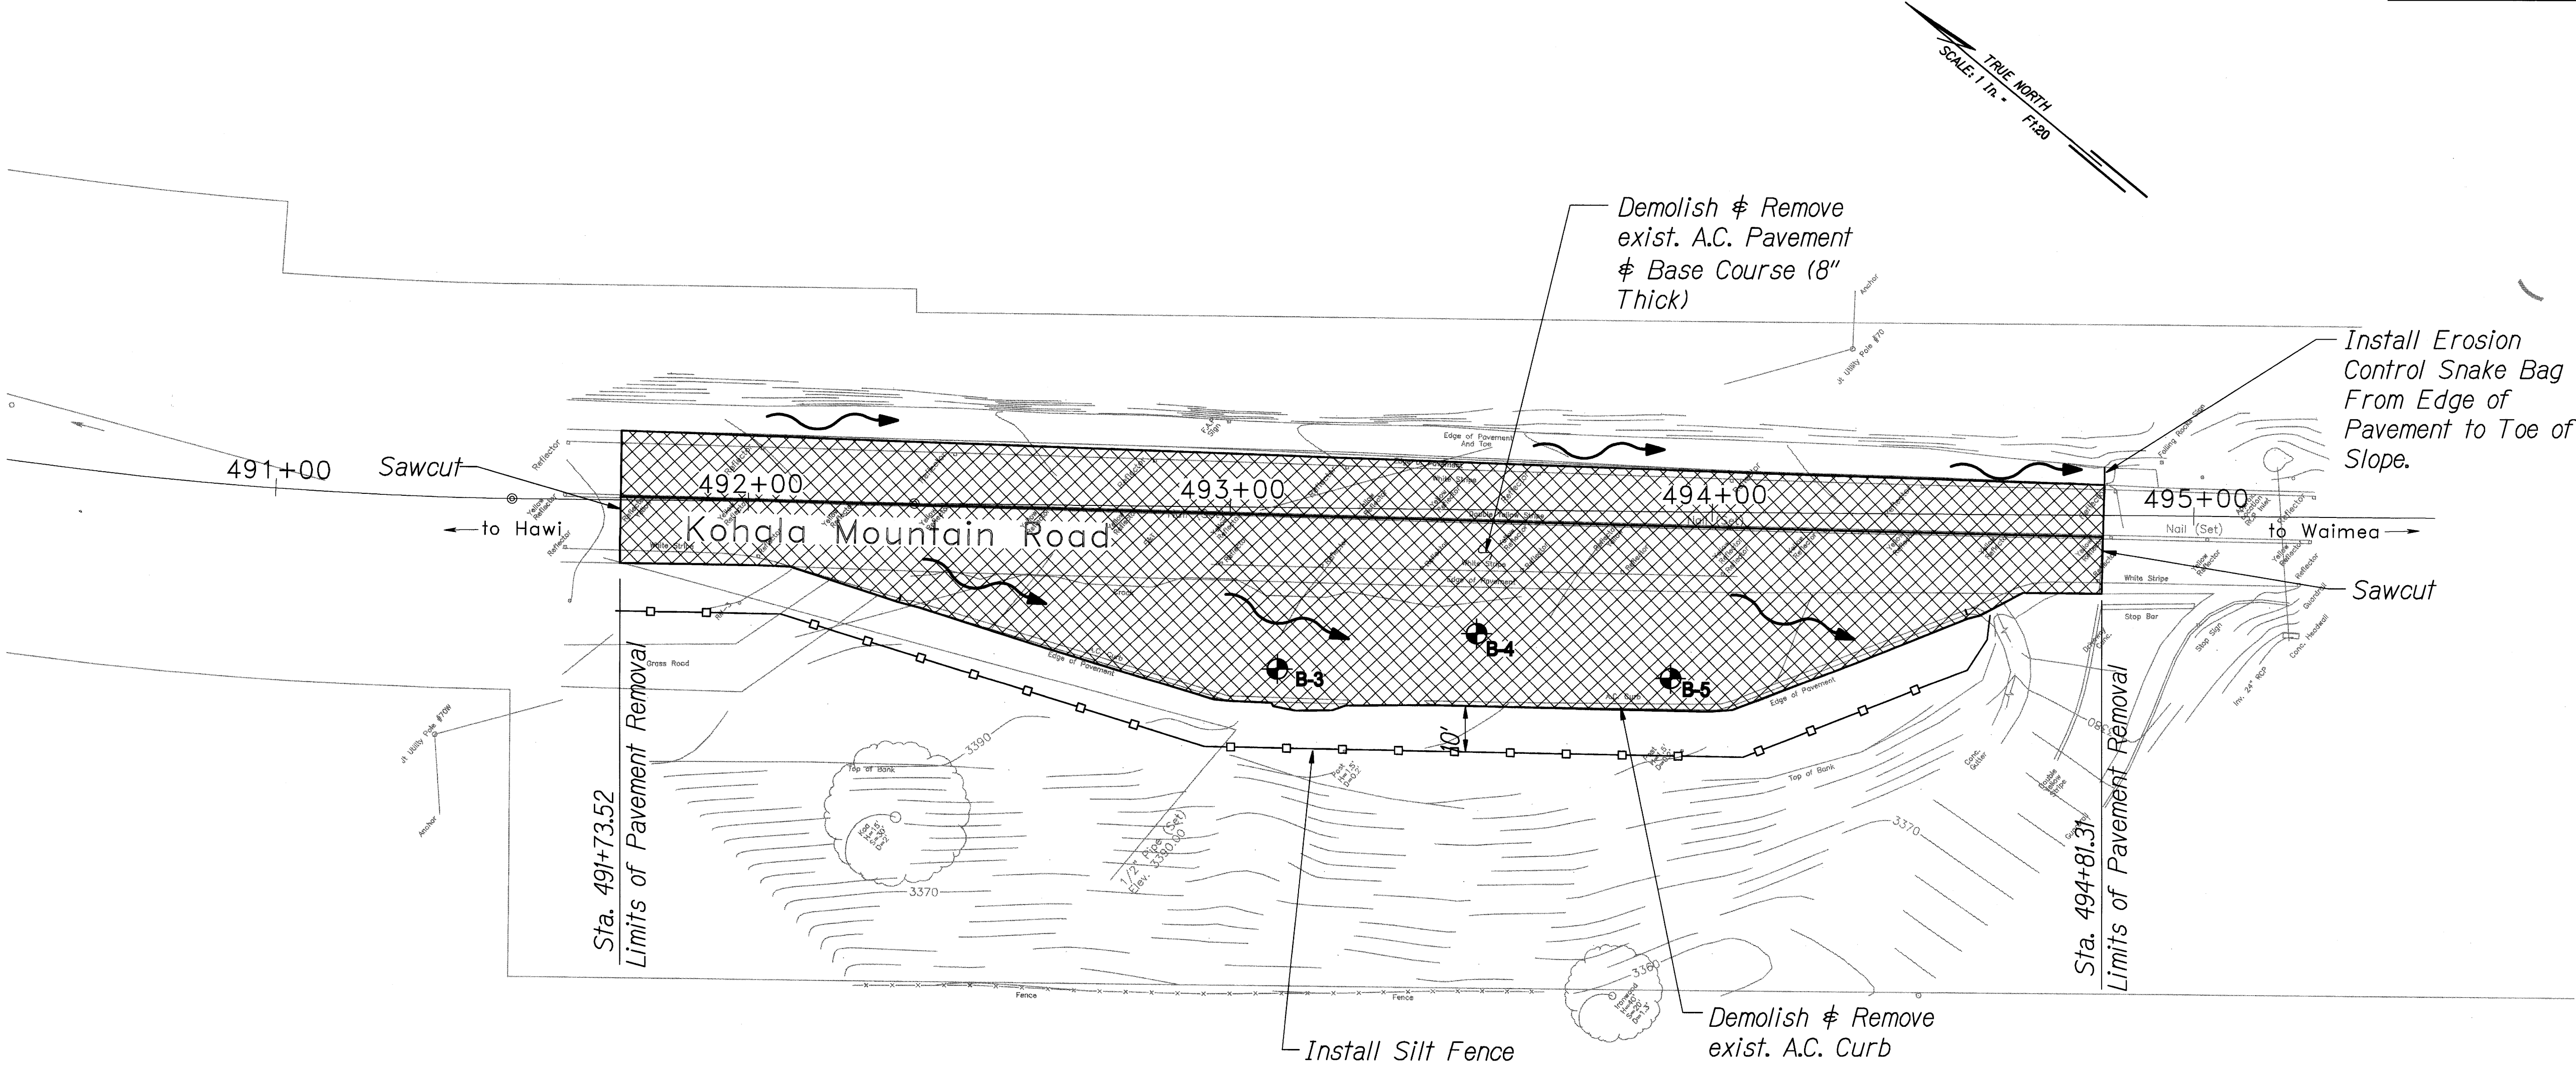


DEMOLITION & EROSION CONTROL PLAN - SITE 2
 Scale: 1"=20'

LEGEND:

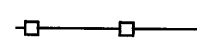-  A.C. Pavement and Base Removal (Exact Location and Limits To Be Determined By Engineer in Field)
-  Boring Location
-  Silt Fence

SURVEY PLOTTED BY	DATE
DRAWN BY	
TRACED BY	
DESIGNED BY	
QUANTITIES BY	
CHECKED BY	
ORIGINAL PLAN	
NOTE BOOK	
No.	

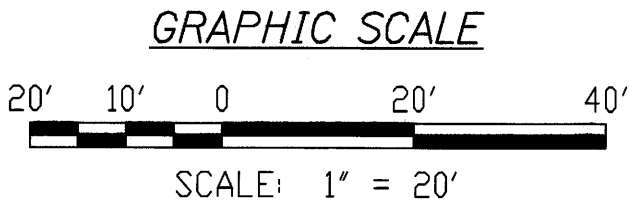

SCOTT A. KUNIOKA
 LICENSED PROFESSIONAL ENGINEER
 No. 7257-C
 HAWAII, U.S.A.

LICENSE EXPIRATION DATE: 4/30/10
 THIS WORK WAS PREPARED BY ME OR UNDER MY SUPERVISION

Scott A. Kunioka
 SHIMABOKURO, ENDO & YOSHIZAKI, INC.
 1126 12TH Avenue
 Honolulu, Hawaii 96816

STATE OF HAWAII
 DEPARTMENT OF TRANSPORTATION
 HIGHWAYS DIVISION

DEMOLITION & EROSION CONTROL PLAN - SITE 2


EMERGENCY EARTHQUAKE ROCKFALL REPAIRS

Various Locations on Hawai'i, Unit 1
 Federal Aid Project No. ER-15(19)


Scale: 1" = 20' Date: December 18, 2009

SHEET No. C-21 OF 3 SHEETS


FED. ROAD DIST. NO.	STATE	FED. AID PROJ. NO.	FISCAL YEAR	SHEET NO.	TOTAL SHEETS
HAWAII	HAW.	ER-15(19)	2009	24	59

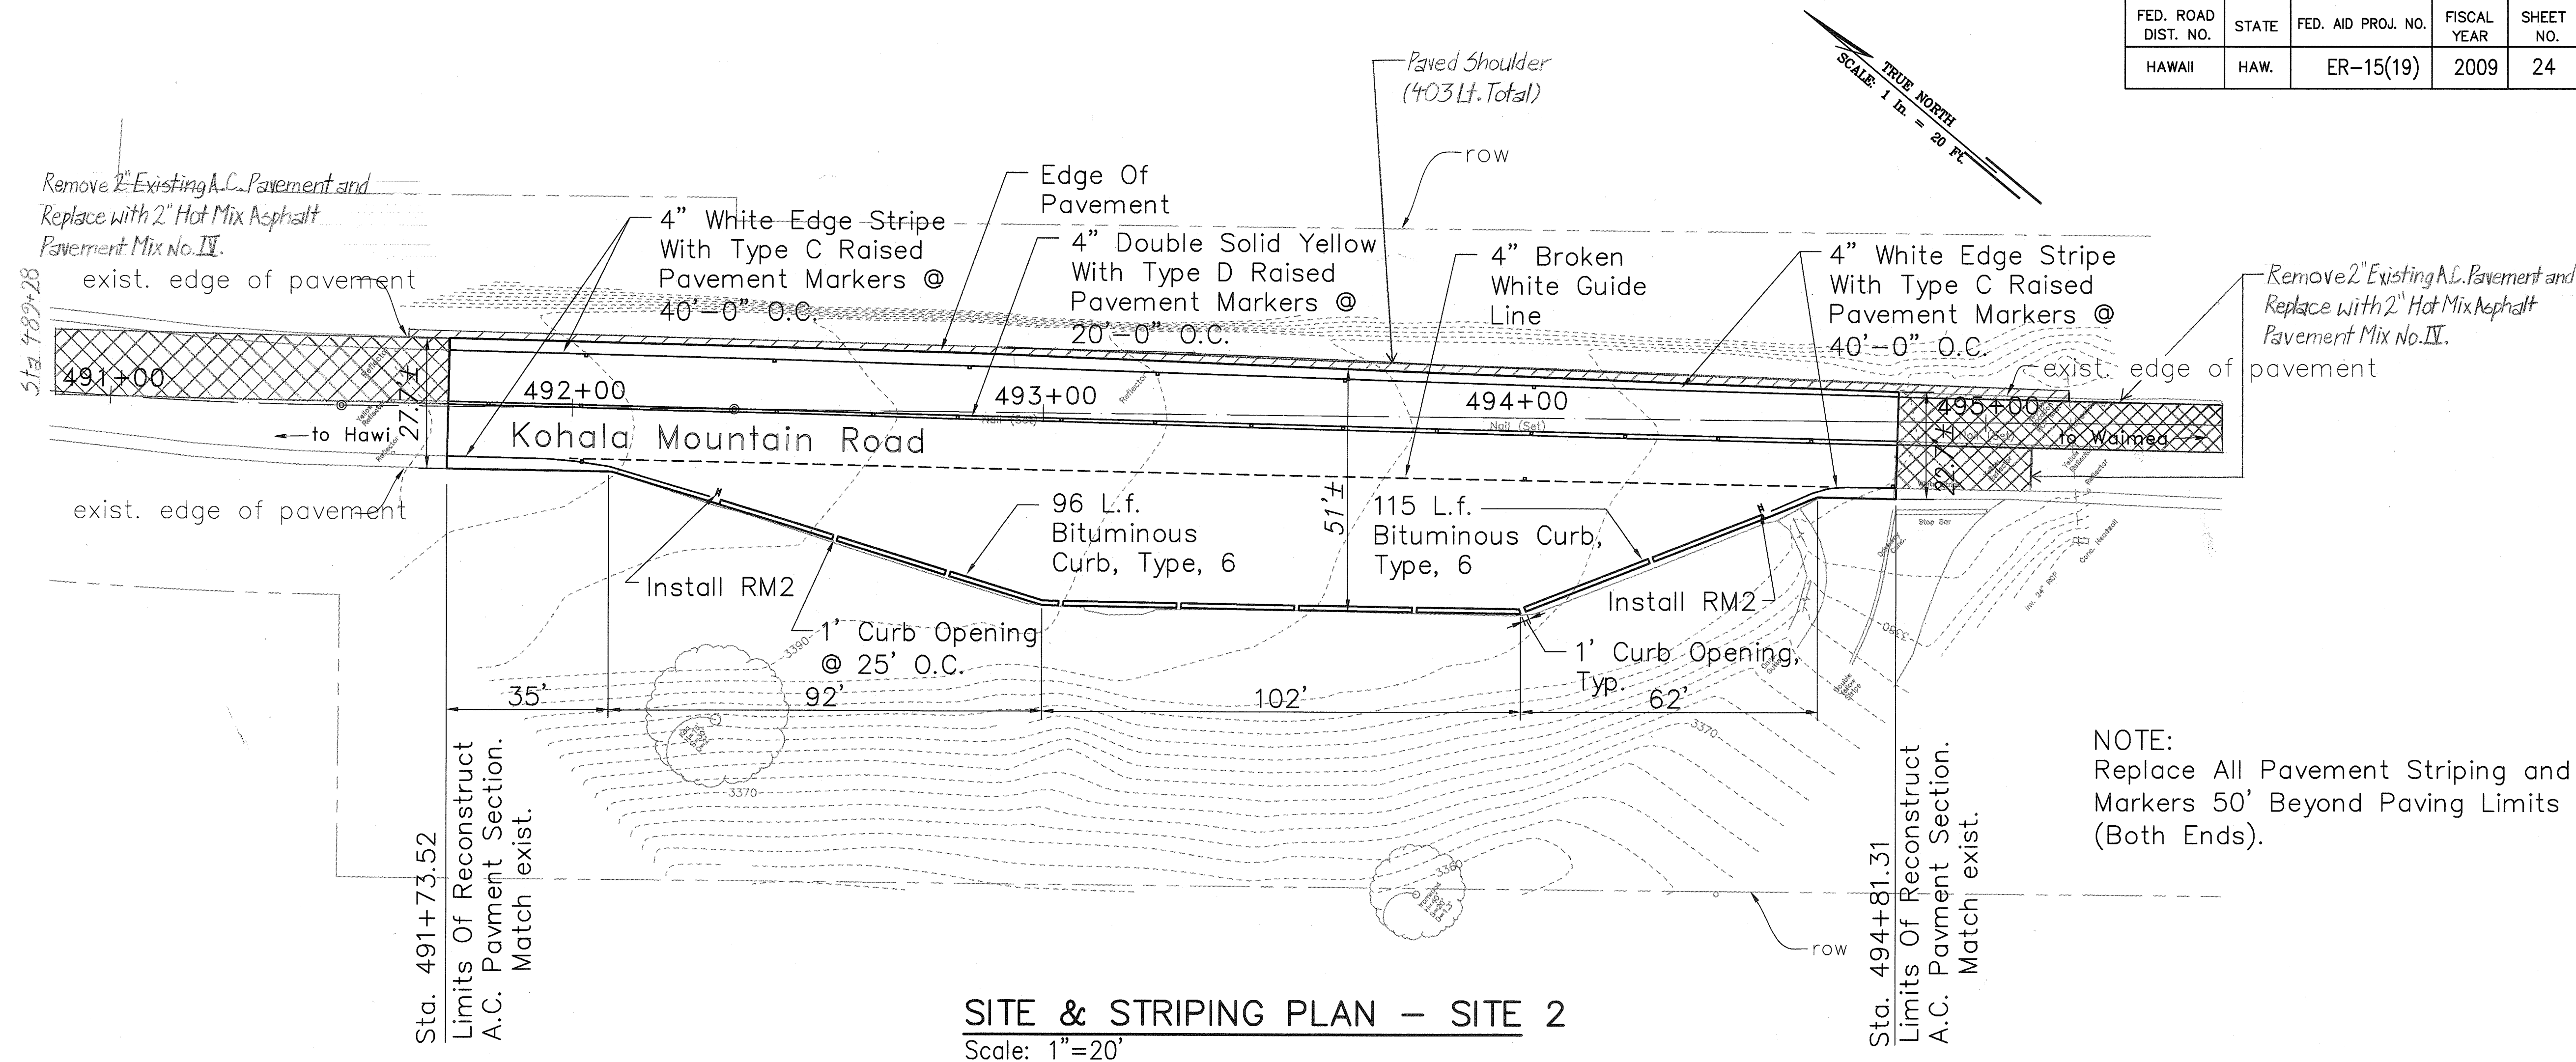

SITE & STRIPING PLAN - SITE 2
Scale: 1"=20'

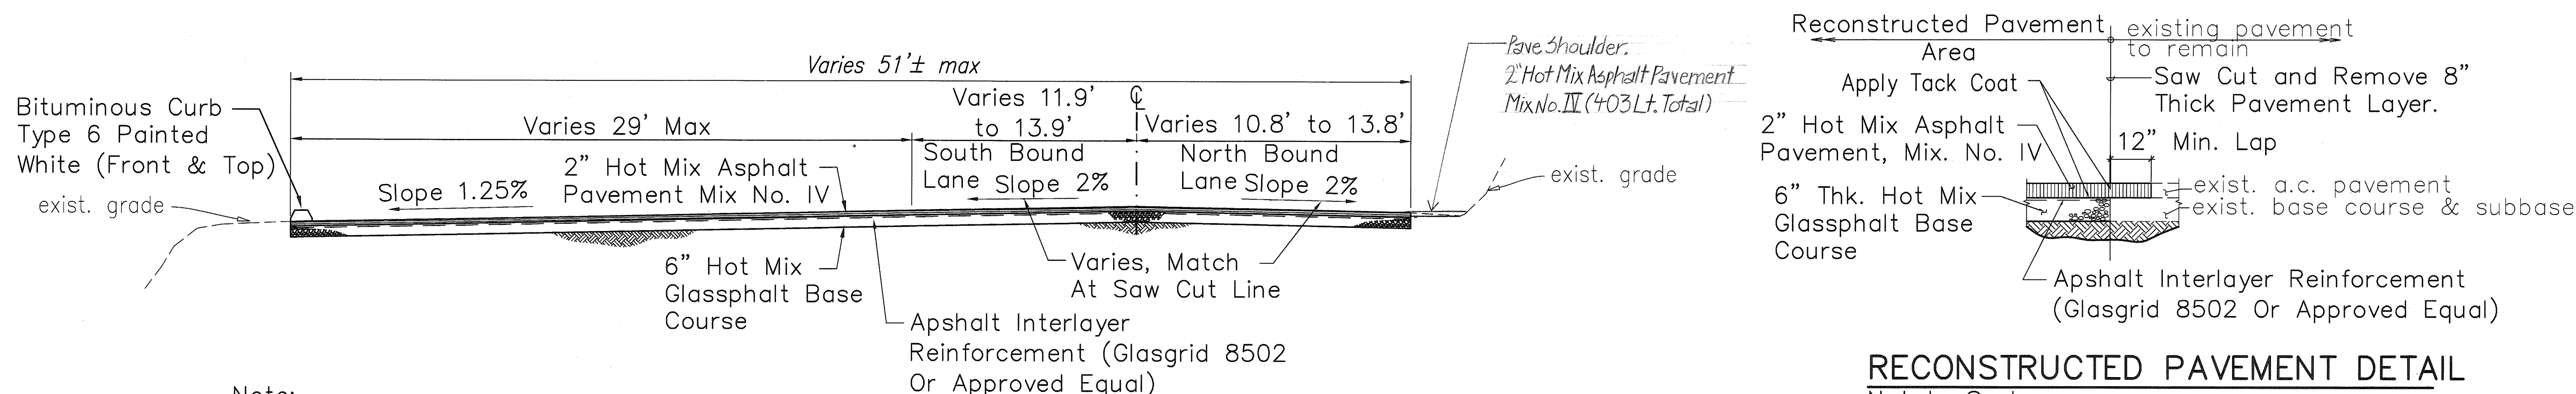



RECONSTRUCTED PAVEMENT DETAIL
Not to Scale

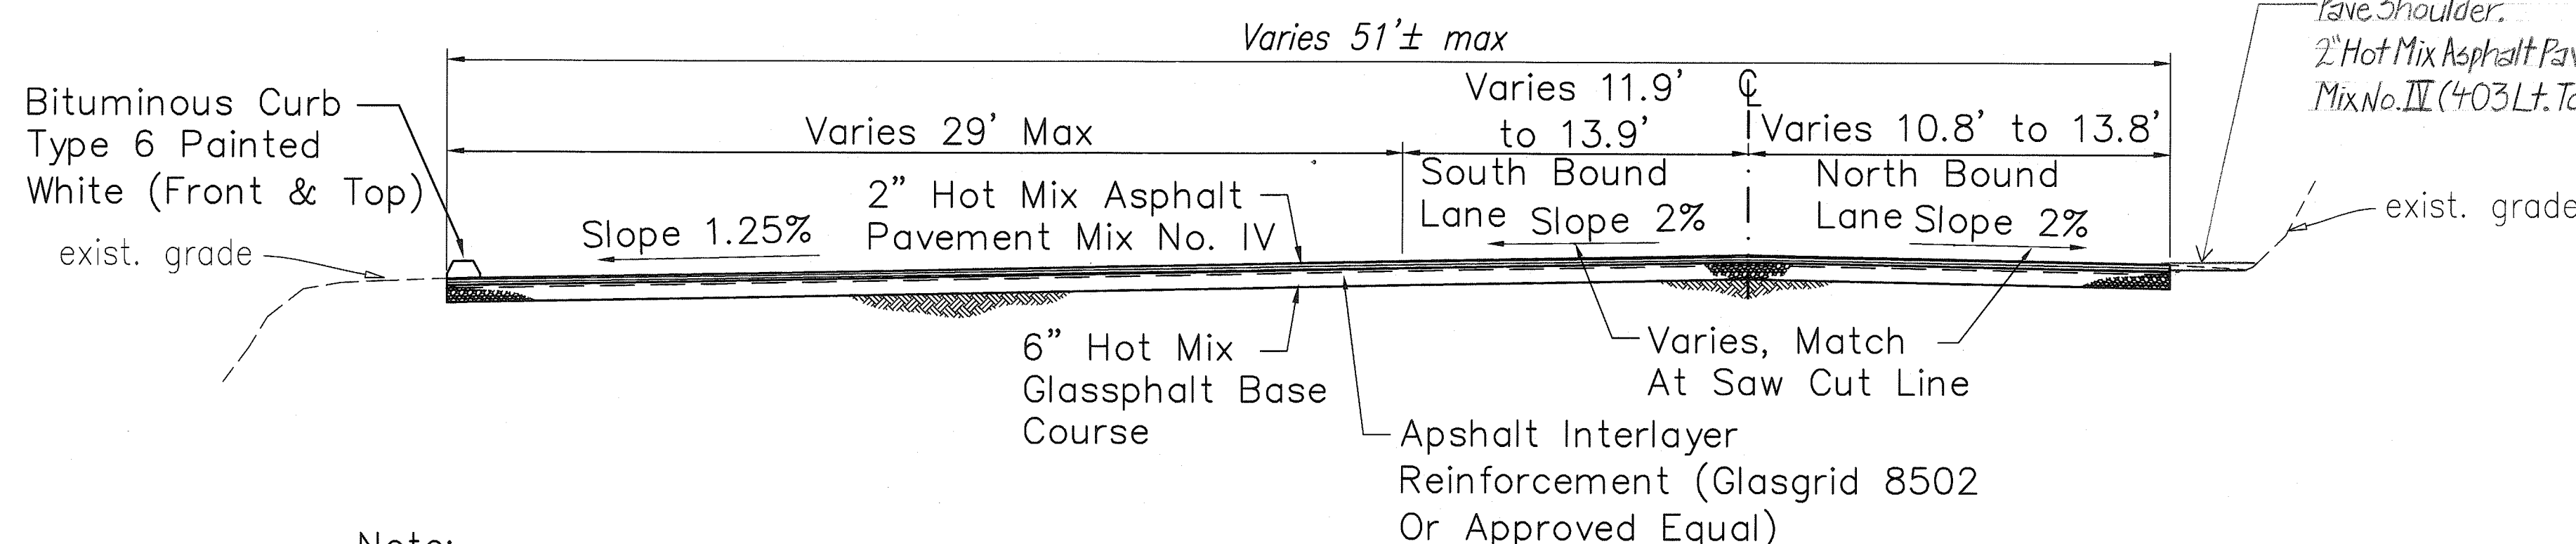

TYPICAL ROADWAY SECTION
Scale: 1/4" = 1'-0"

Note:
Asphalt Interlayer
Reinforcement (Glasgrid 8502
Or Approved Equal) In
Pavement Shall Be Continuous
Across Entire Roadway
Section.

SURVEY PLOTTED BY	DATE
DRAWN BY	
TRACED BY	
QUANTITIES BY	
CHECKED BY	
ORIGINAL PLAN	
NOTE BOOK	
No.	

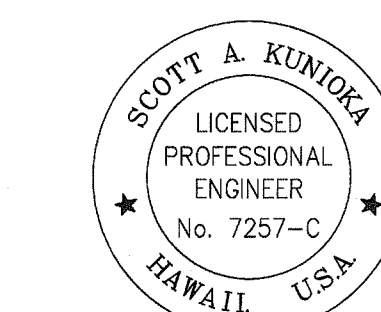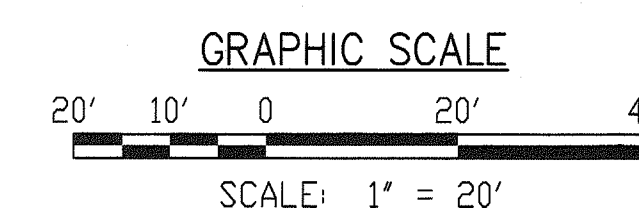


LICENSE EXPIRATION DATE: 4/30/10
THIS WORK WAS PREPARED BY ME
OR UNDER MY SUPERVISION
SHIMABUKURO, ENDO & YOSHIZAKI, INC.
1126 12TH AVENUE
HONOLULU, HAWAII 96816

STATE OF HAWAII DEPARTMENT OF TRANSPORTATION HIGHWAYS DIVISION
SITE & STRIPING PLAN - SITE 2
EMERGENCY EARTHQUAKE ROCKFALL REPAIRS
Various Locations on Hawai'i, Unit 1
Federal Aid Project No. ER-15(19)
Scale: AS NOTED Date: December 18, 2009
SHEET No. C-2.20F 3 SHEETS

"AS-BUILT"

FED. ROAD DIST. NO.	STATE	FED. AID PROJ. NO.	FISCAL YEAR	SHEET NO.	TOTAL SHEETS
HAWAII	HAW.	ER-15(19)	2009	25	59

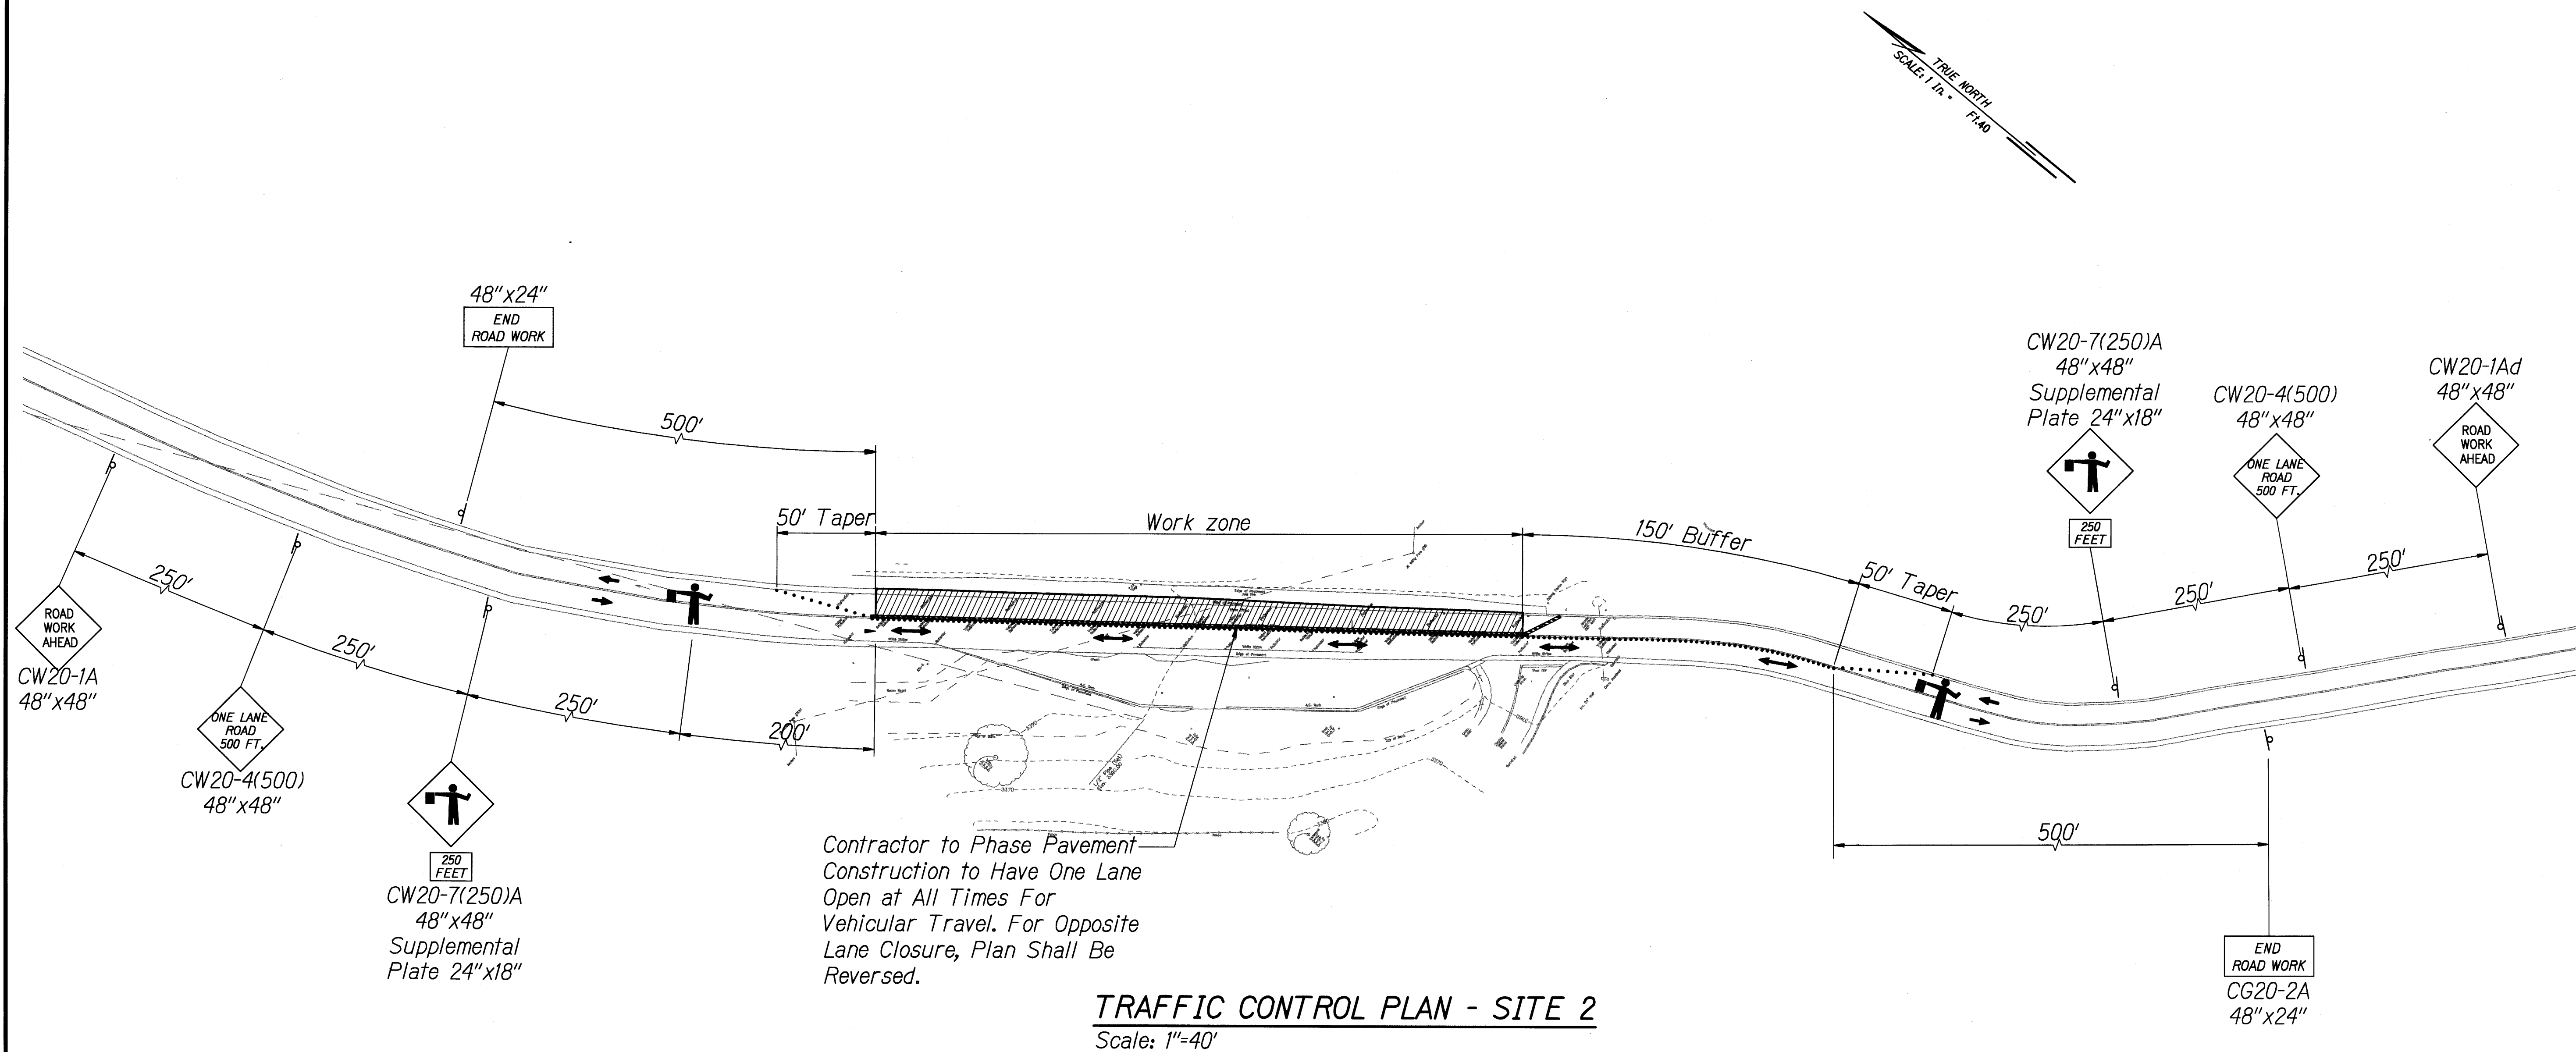


TRAFFIC CONTROL PLAN - SITE 2
Scale: 1"=40'

NOTE:
Refer To General Notes For Traffic Control Plan Within State Right Of Way, Sheet C-4.

- LEGEND:**
- Work Area
 - Temporary Traffic Control Sign W/ Stand
 - Cone Or Delineator
 - Direction Of Traffic
 - Police Officer Or Flagman
 - Barrier For Lane Closure During Non Working Hours

SURVEY PLOTTED BY	DATE
DRAWN BY	
DESIGNED BY	
QUANTITIES BY	
CHECKED BY	
ORIGINAL PLAN	
NOTE BOOK	
No.	

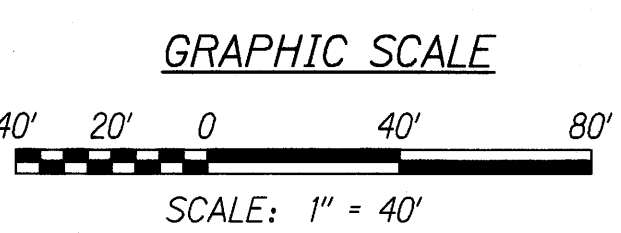

SCOTT A. KUNIOKA
LICENSED PROFESSIONAL ENGINEER
No. 7257-C
HAWAII, U.S.A.
LICENSE EXPIRATION DATE: 4/30/10
THIS WORK WAS PREPARED BY ME OR UNDER MY SUPERVISION
Scott A. Kuniooka
SHIMABUKURO, ENDO & YOSHIKAWA, INC.
1126 12TH AVENUE
Honolulu, Hawaii 96816

STATE OF HAWAII
DEPARTMENT OF TRANSPORTATION
HIGHWAYS DIVISION

TRAFFIC CONTROL PLAN - SITE 2
EMERGENCY EARTHQUAKE ROCKFALL REPAIRS
Various Locations on Hawai'i, Unit 1
Federal Aid Project No. ER-15(19)
Scale: 1" = 40' Date: December 18, 2009
SHEET No. C-23 OF 3 SHEETS