



FED. ROAD DIST. NO.	STATE	FED. AID PROJ. NO.	FISCAL YEAR	SHEET NO.	TOTAL SHEETS
HAWAII	HAW.	ER-15(20)	2010	20	33


SECTION A-A
SCALE: 1" = 10'-0"

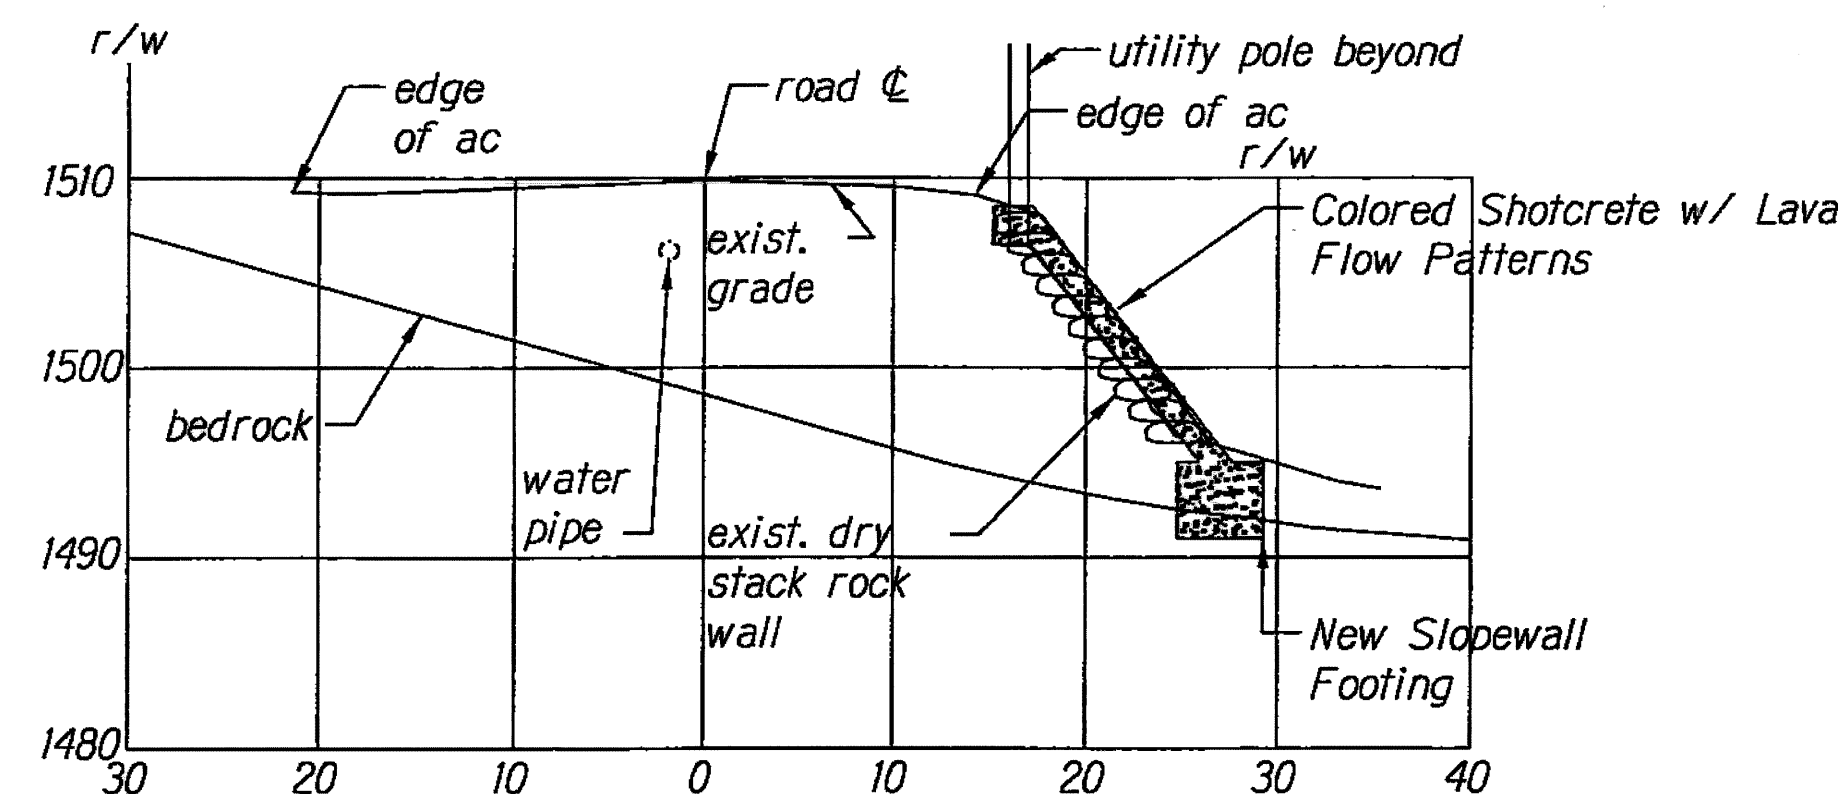



SECTION B-B
SCALE: 1" = 10'-0"

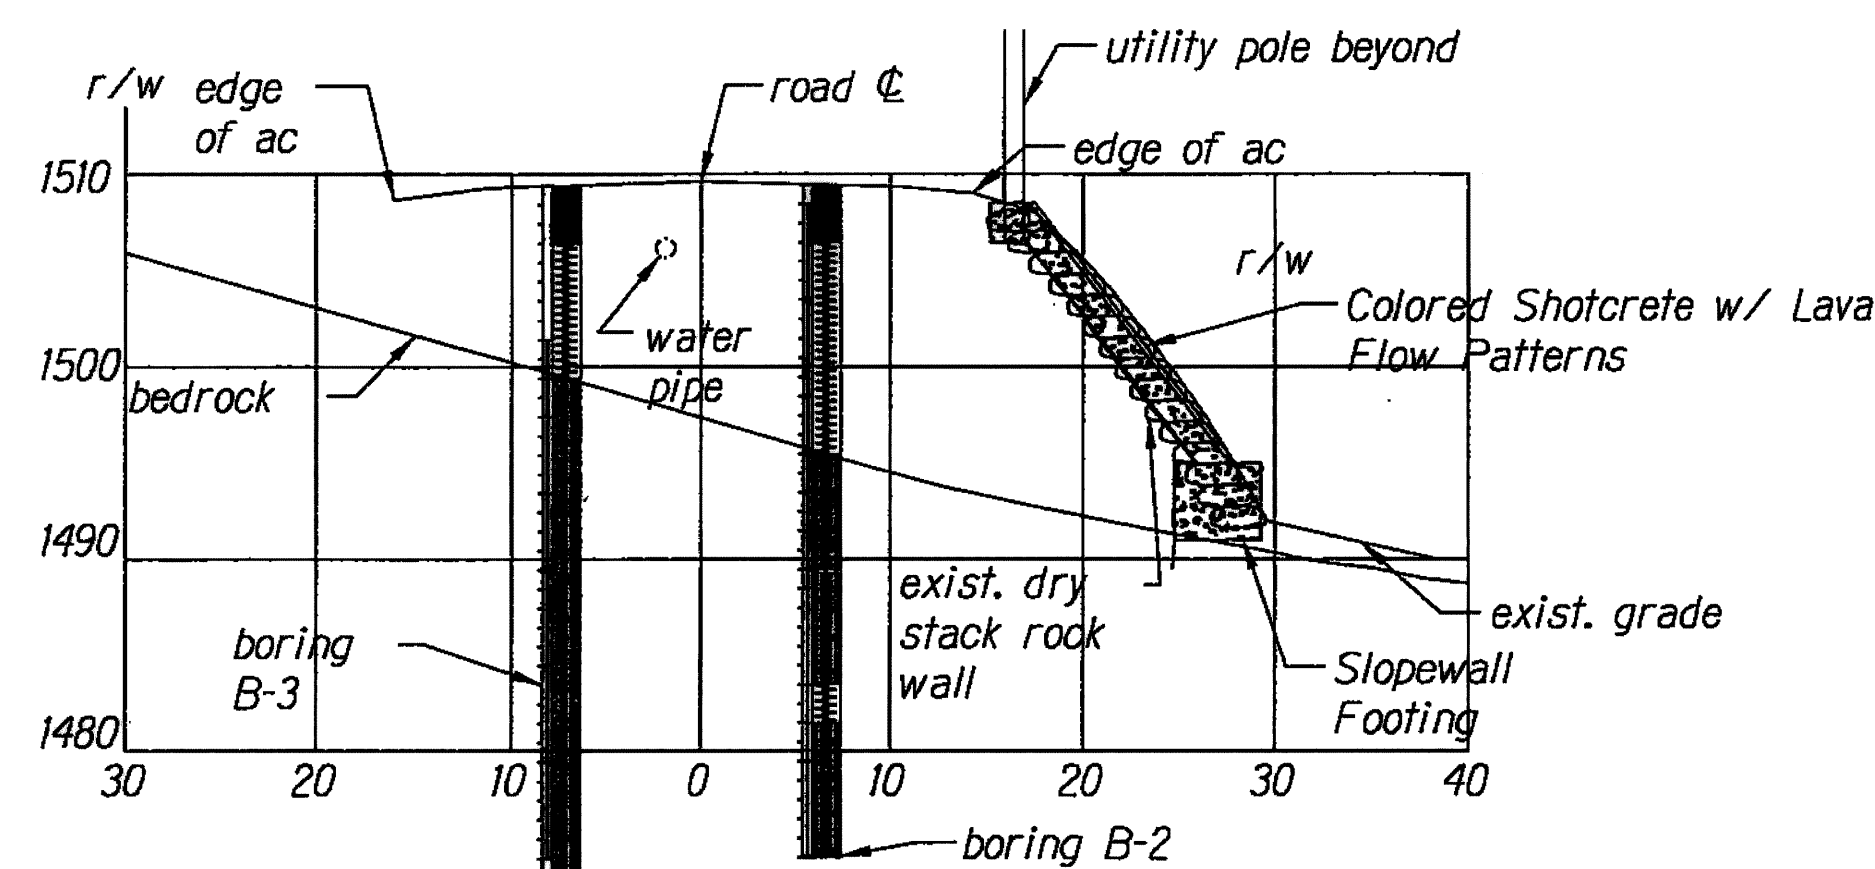


SECTION C-C
SCALE: 1" = 10'-0"

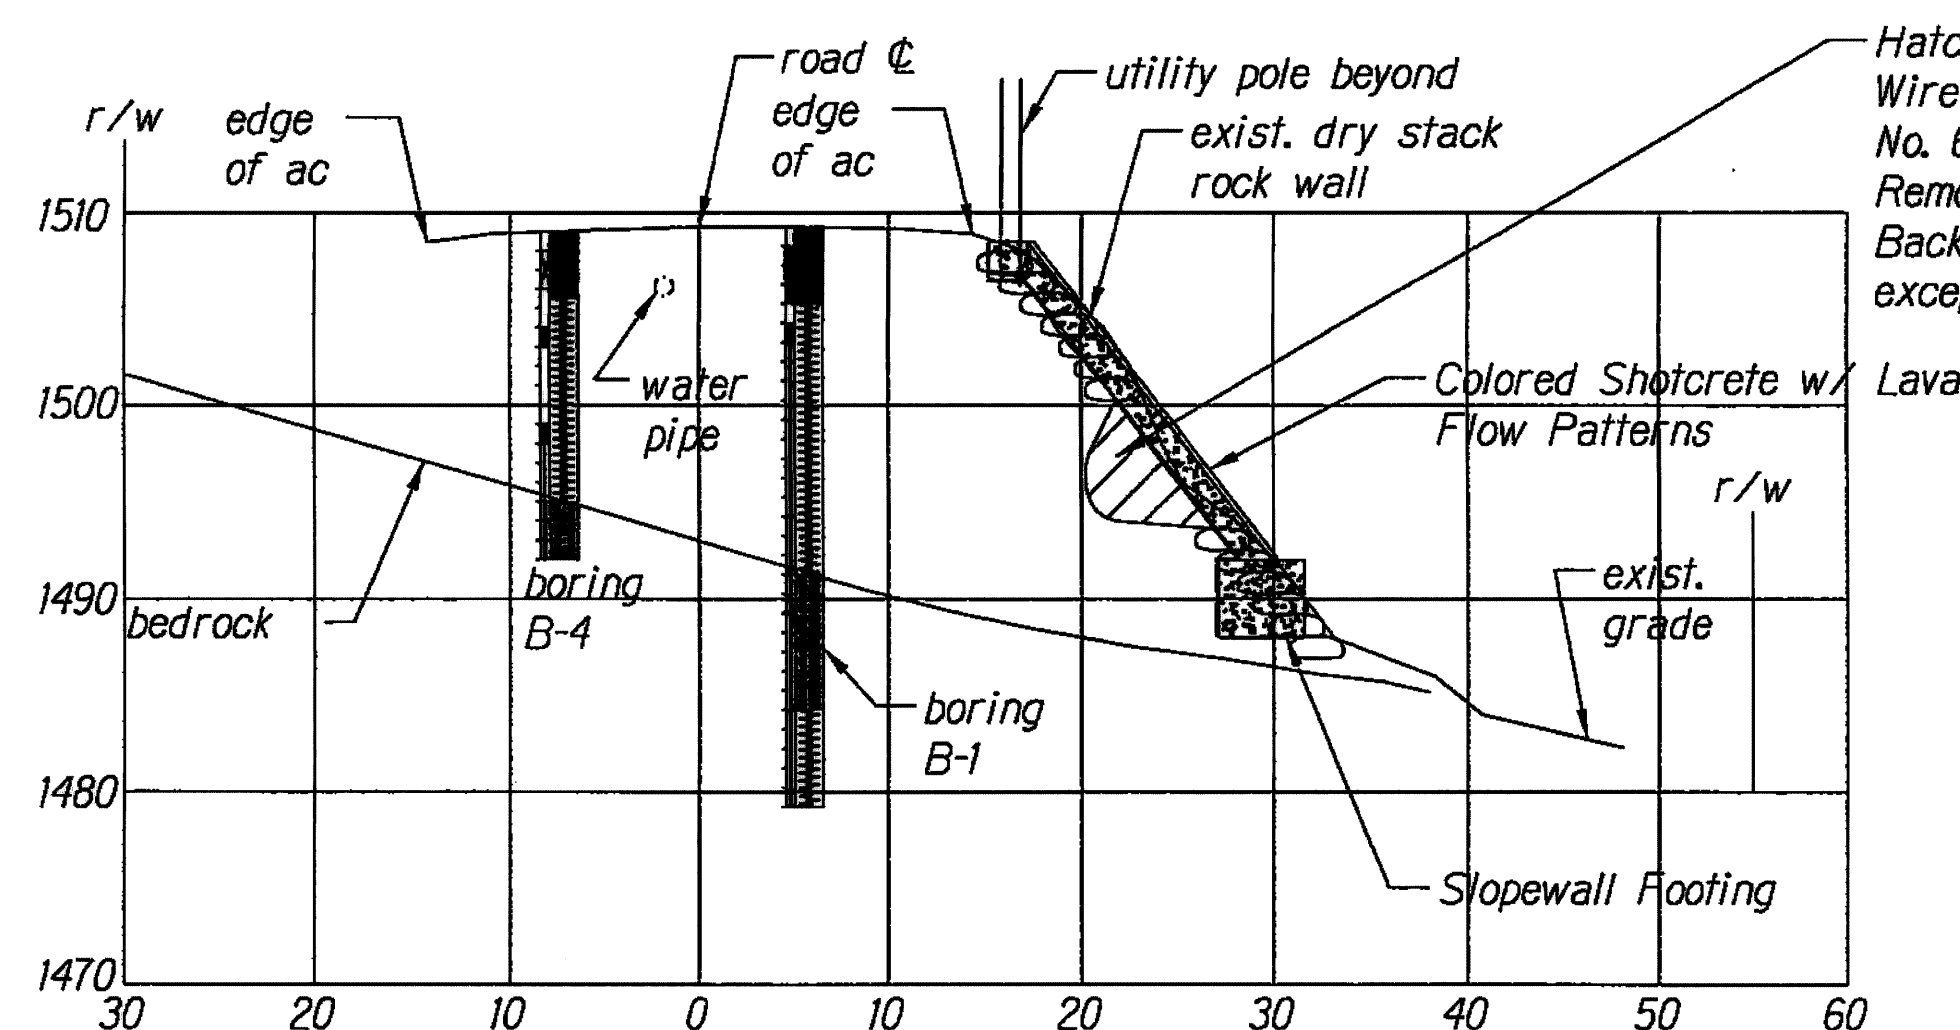

SECTION D-D
SCALE: 1" = 10'-0"

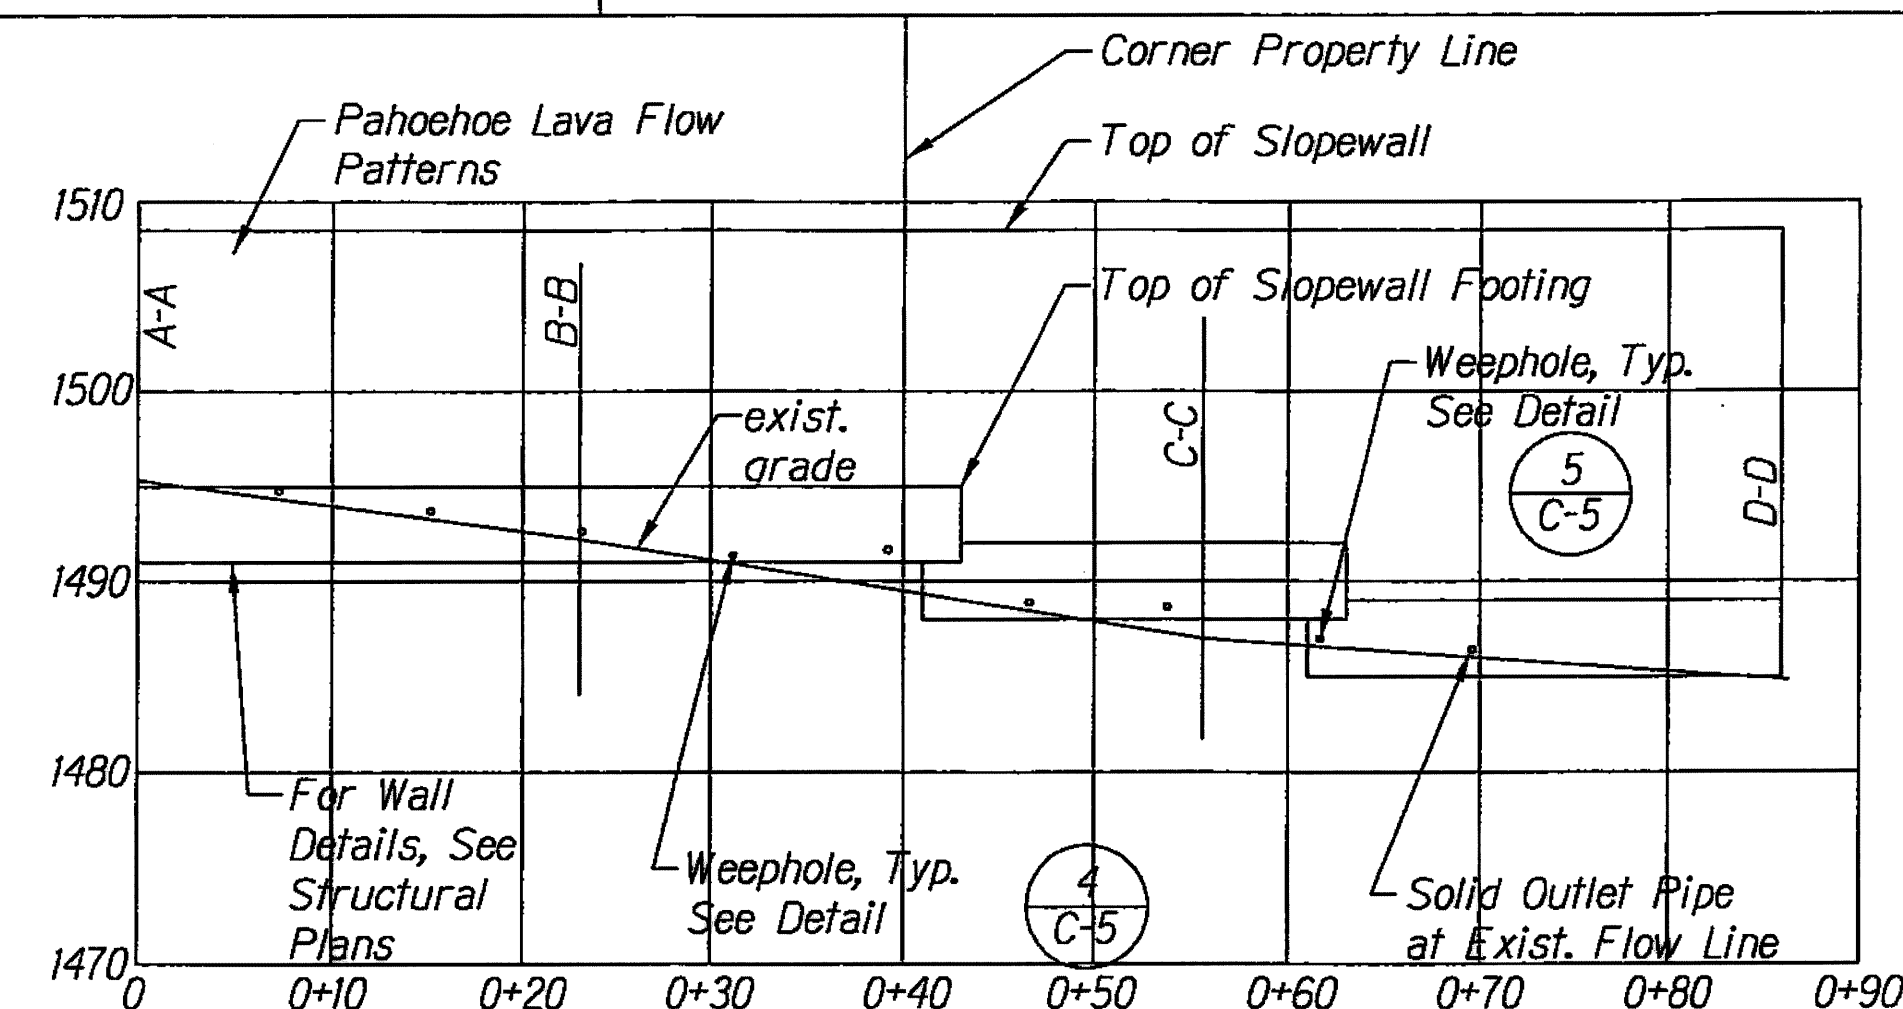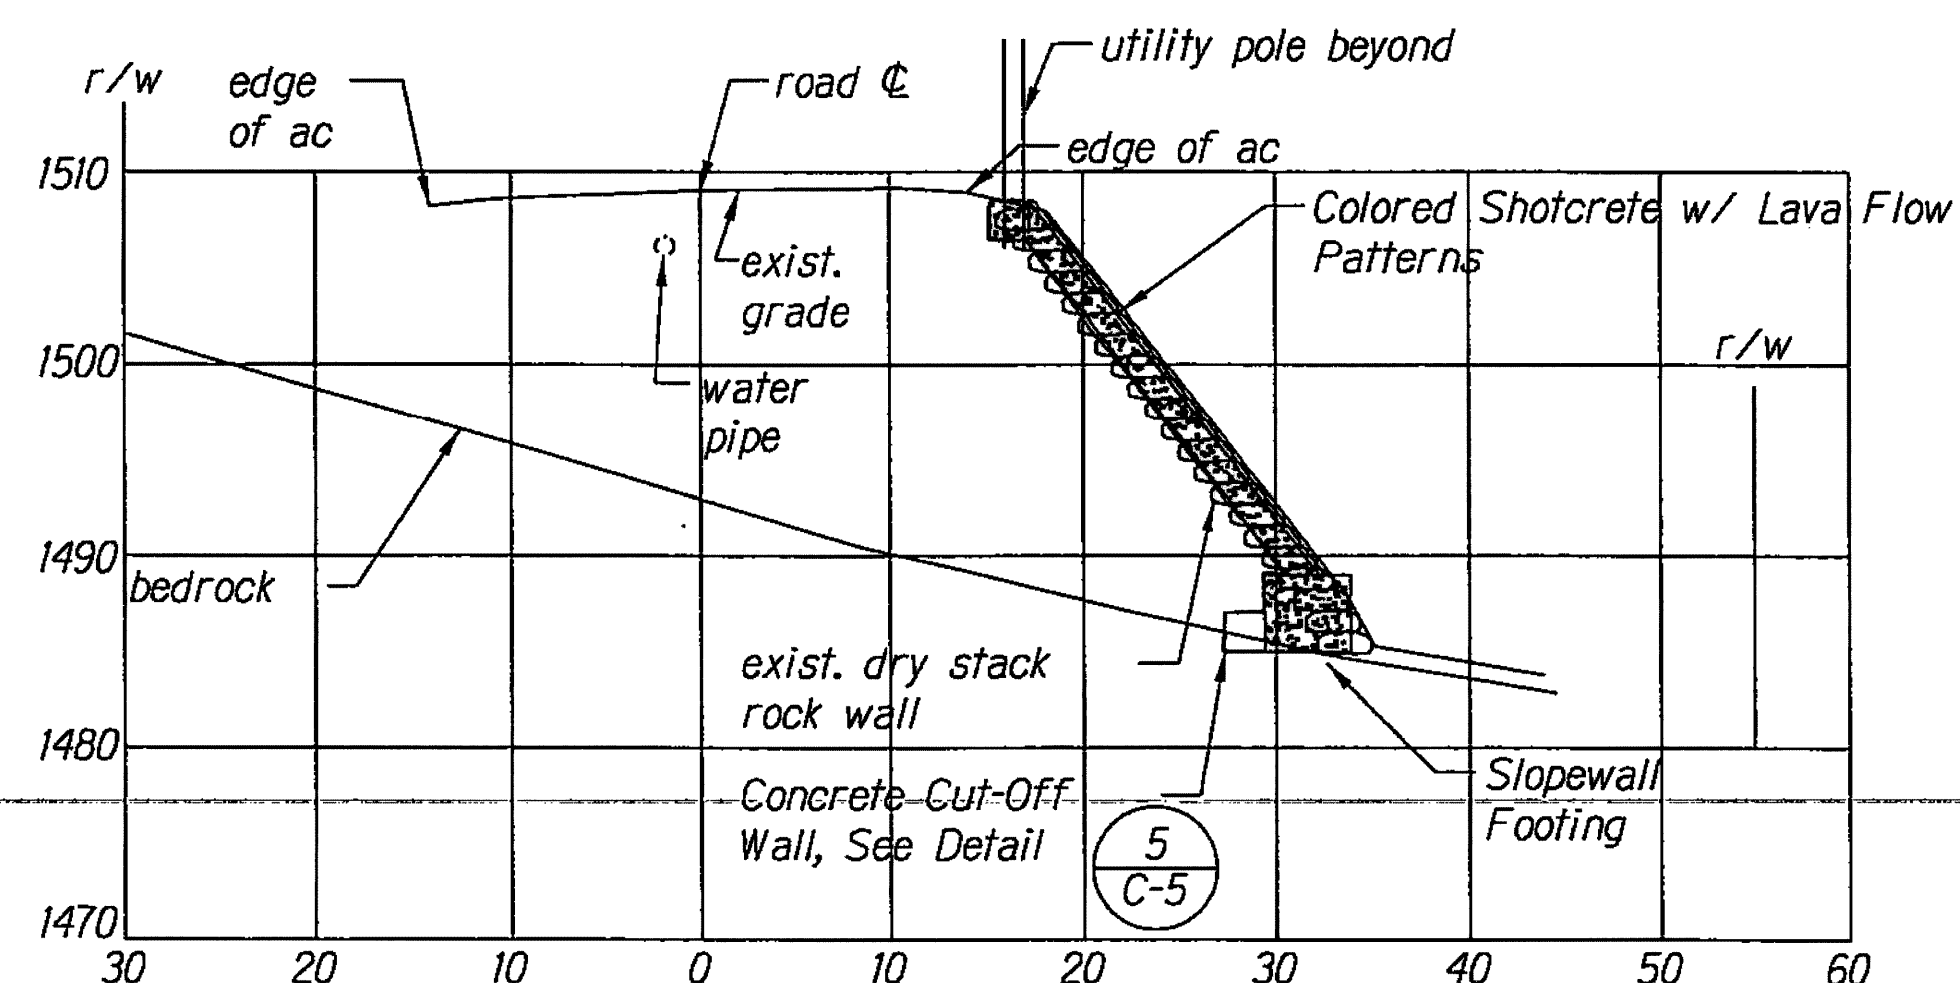

WALL ELEVATION
SCALE: 1" = 10'-0"

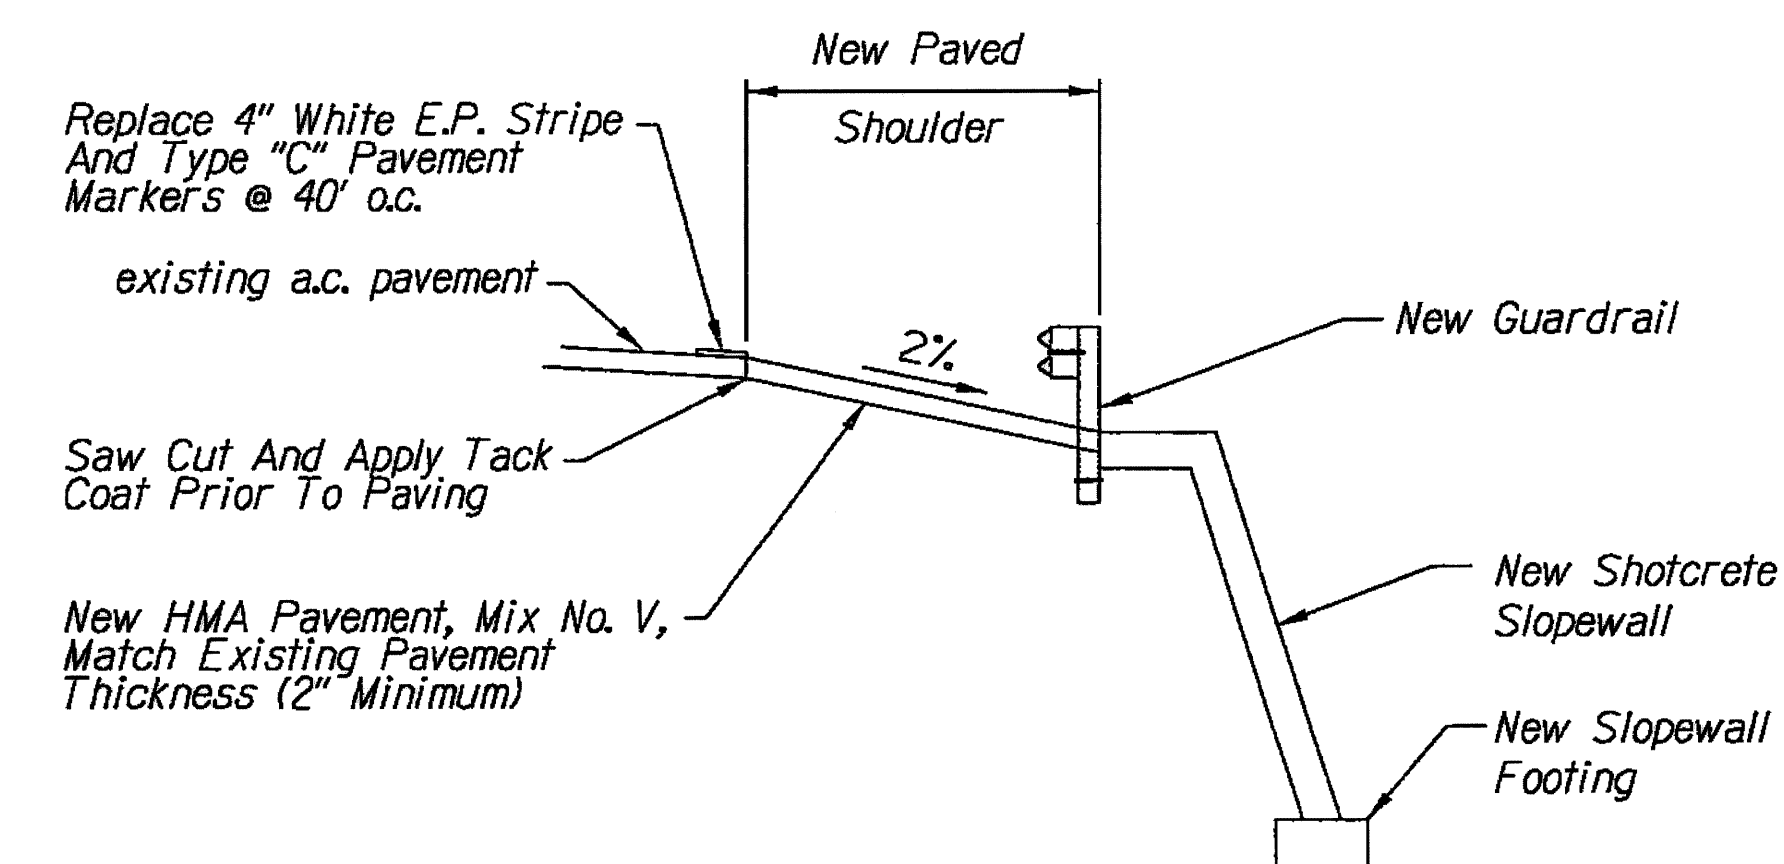

SHOULDER RESTORATION
Not To Scale

MAMALAHOA HIGHWAY, ROUTE 11, MP 108.8

SURVEY PLOTTED BY	DATE
DRAWN BY	8/20/10
DESIGNED BY	
NOTES BOOK	
QUANTITIES BY	
CHECKED BY	



This work was prepared by me or under my supervision and construction of this project will be under my observation.

signature *Marshall Lew* 4/30/12
expiration date of the license

STATE OF HAWAII DEPARTMENT OF TRANSPORTATION HIGHWAYS DIVISION
SECTIONS & ELEVATIONS
FOR MP 108.8
EMERGENCY EARTHQUAKE
ROCKFALL REPAIRS
VARIOUS LOCATIONS ON HAWAII, UNIT 2
FEDERAL AID PROJECT NO. ER-15(20)
Scale: AS NOTED Date: NOVEMBER 2010
SHEET No. C-18 OF 33 SHEETS