
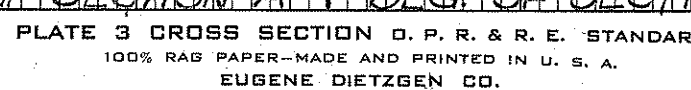


R/K

[illegible]

DATE _____ BY _____
 SURVEY NO. _____
 ORIGINAL SURVEY NO. _____
 NOTE BOOK NO. _____
 PLATE NO. _____
 AREAS CHECKED _____

DATE _____ BY _____
 SURVEY NO. _____
 ORIGINAL SURVEY NO. _____
 NOTE BOOK NO. _____
 PLATE NO. _____
 AREAS CHECKED _____

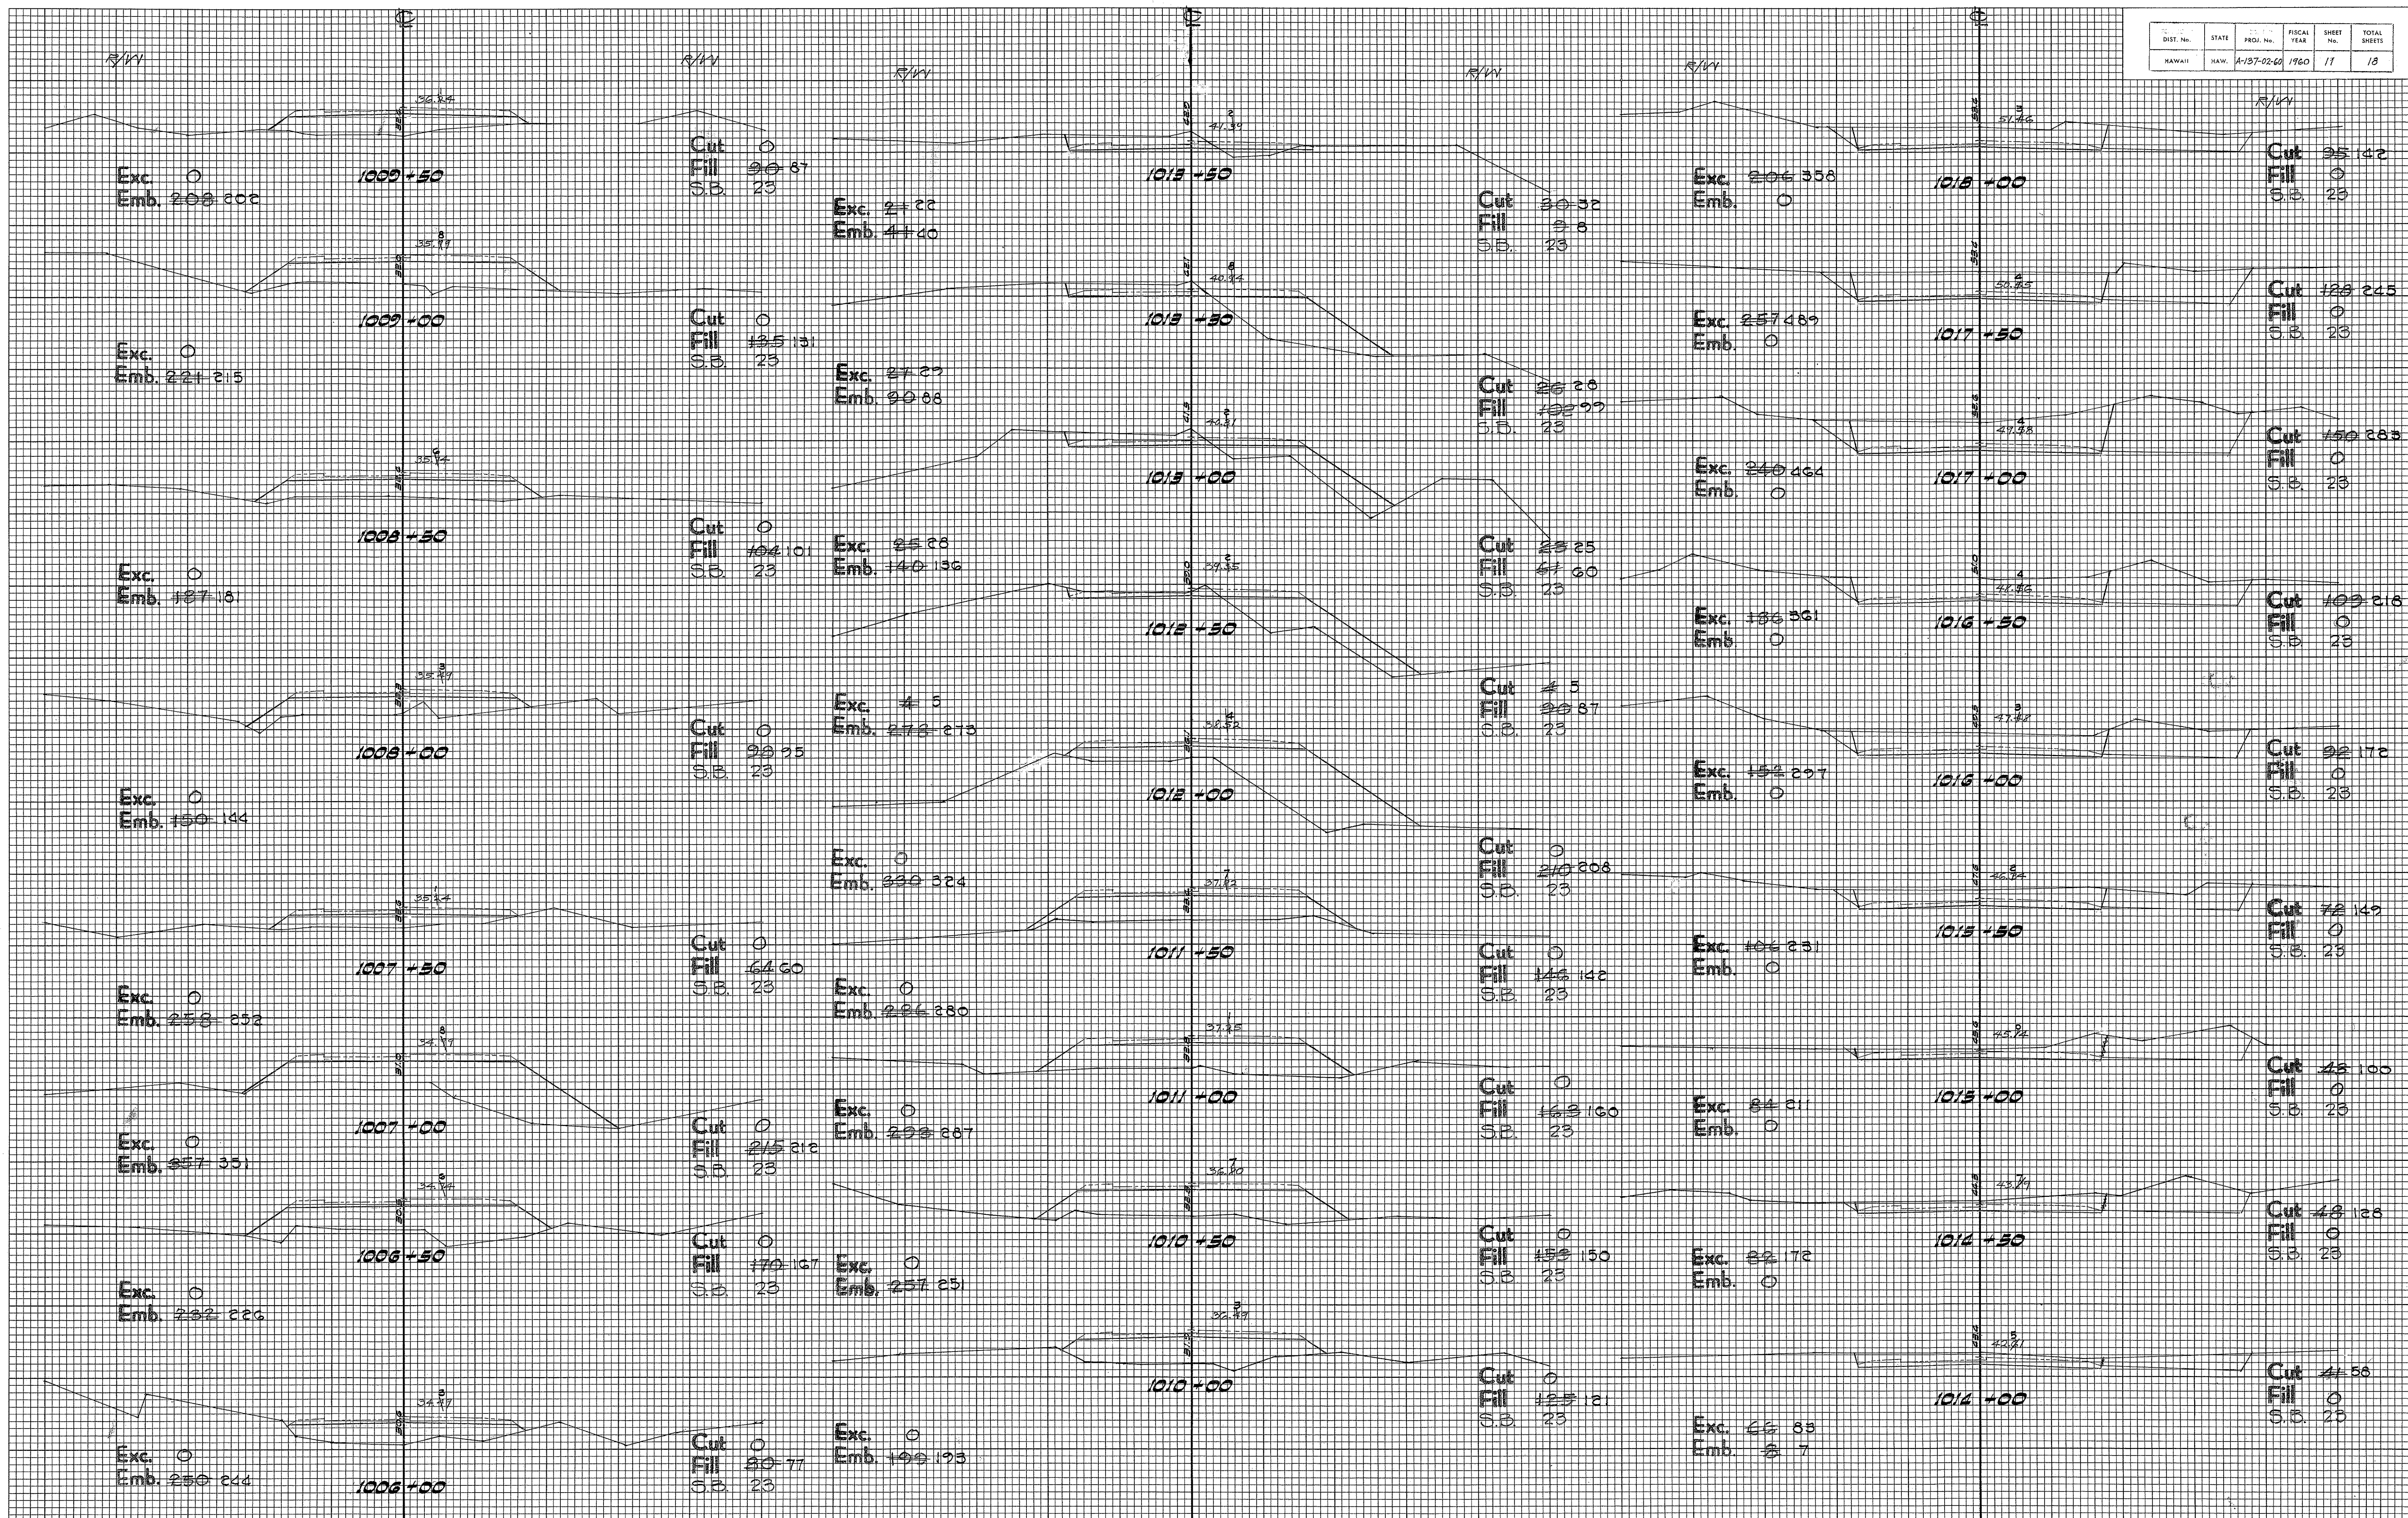

DIST. No.	STATE	PROJ. No.	FISCAL YEAR	SHEET No.	TOTAL SHEETS
HAWAII	HAW.	A-197-02-50	1960	12	18

FINAL SURVEY	DATE
SURVEYED	BY
NOTE BOOK	
TEMPLATE	
AREAS CHECKED	
NO.	

ORIGINAL SURVEY	DATE
SURVEYED	BY
NOTE BOOK	
TEMPLATE	
AREAS CHECKED	
NO.	


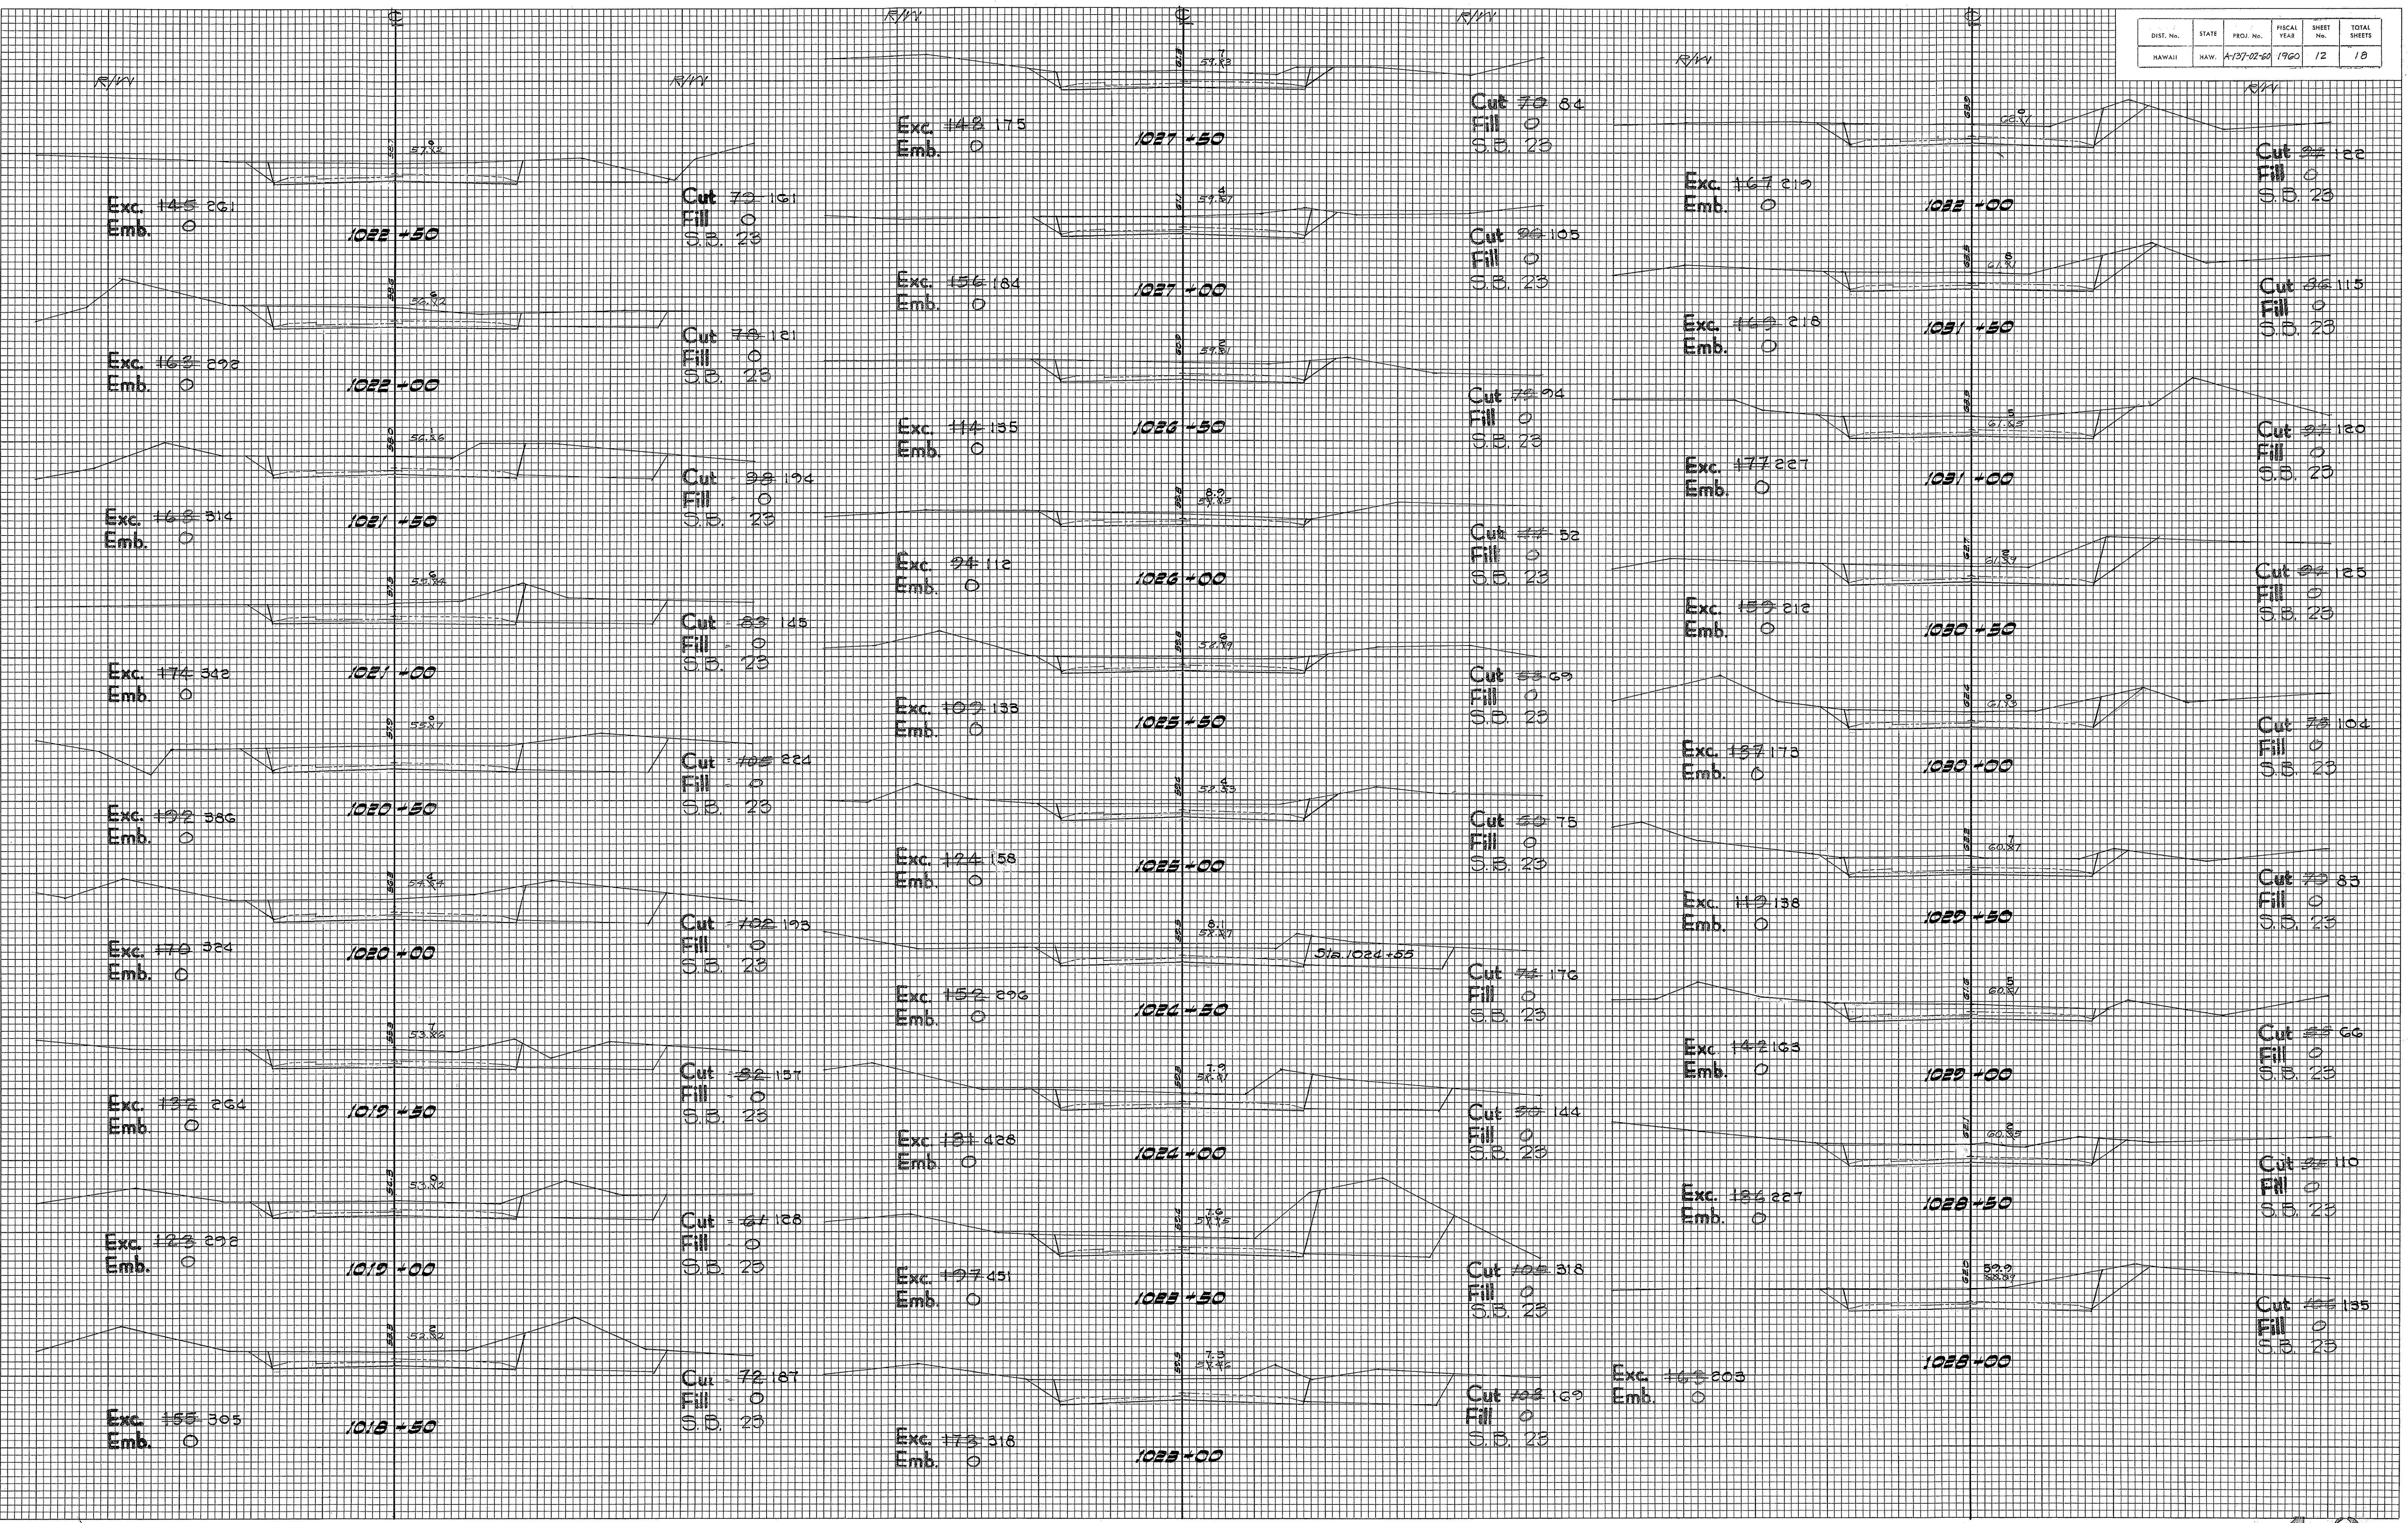


PLATE 3 CROSS SECTION D. P. R. & R. E. STANDARD
100% RAG PAPER-MADE AND PRINTED IN U. S. A.
EUGENE DIETZGEN CO.

DATE	BY	SURVEYED	PLOTTED	NOTED	CHECKED
		BOOK	BOOK	BOOK	BOOK
		NO.	NO.	NO.	NO.

DATE	BY	SURVEYED	PLOTTED	NOTED	CHECKED
		BOOK	BOOK	BOOK	BOOK
		NO.	NO.	NO.	NO.

DIST. NO.	STATE	PROJ. NO.	FISCAL YEAR	SHEET NO.	TOTAL SHEETS
HAWAII	HAW.	A-137-12-60	1960	13	18

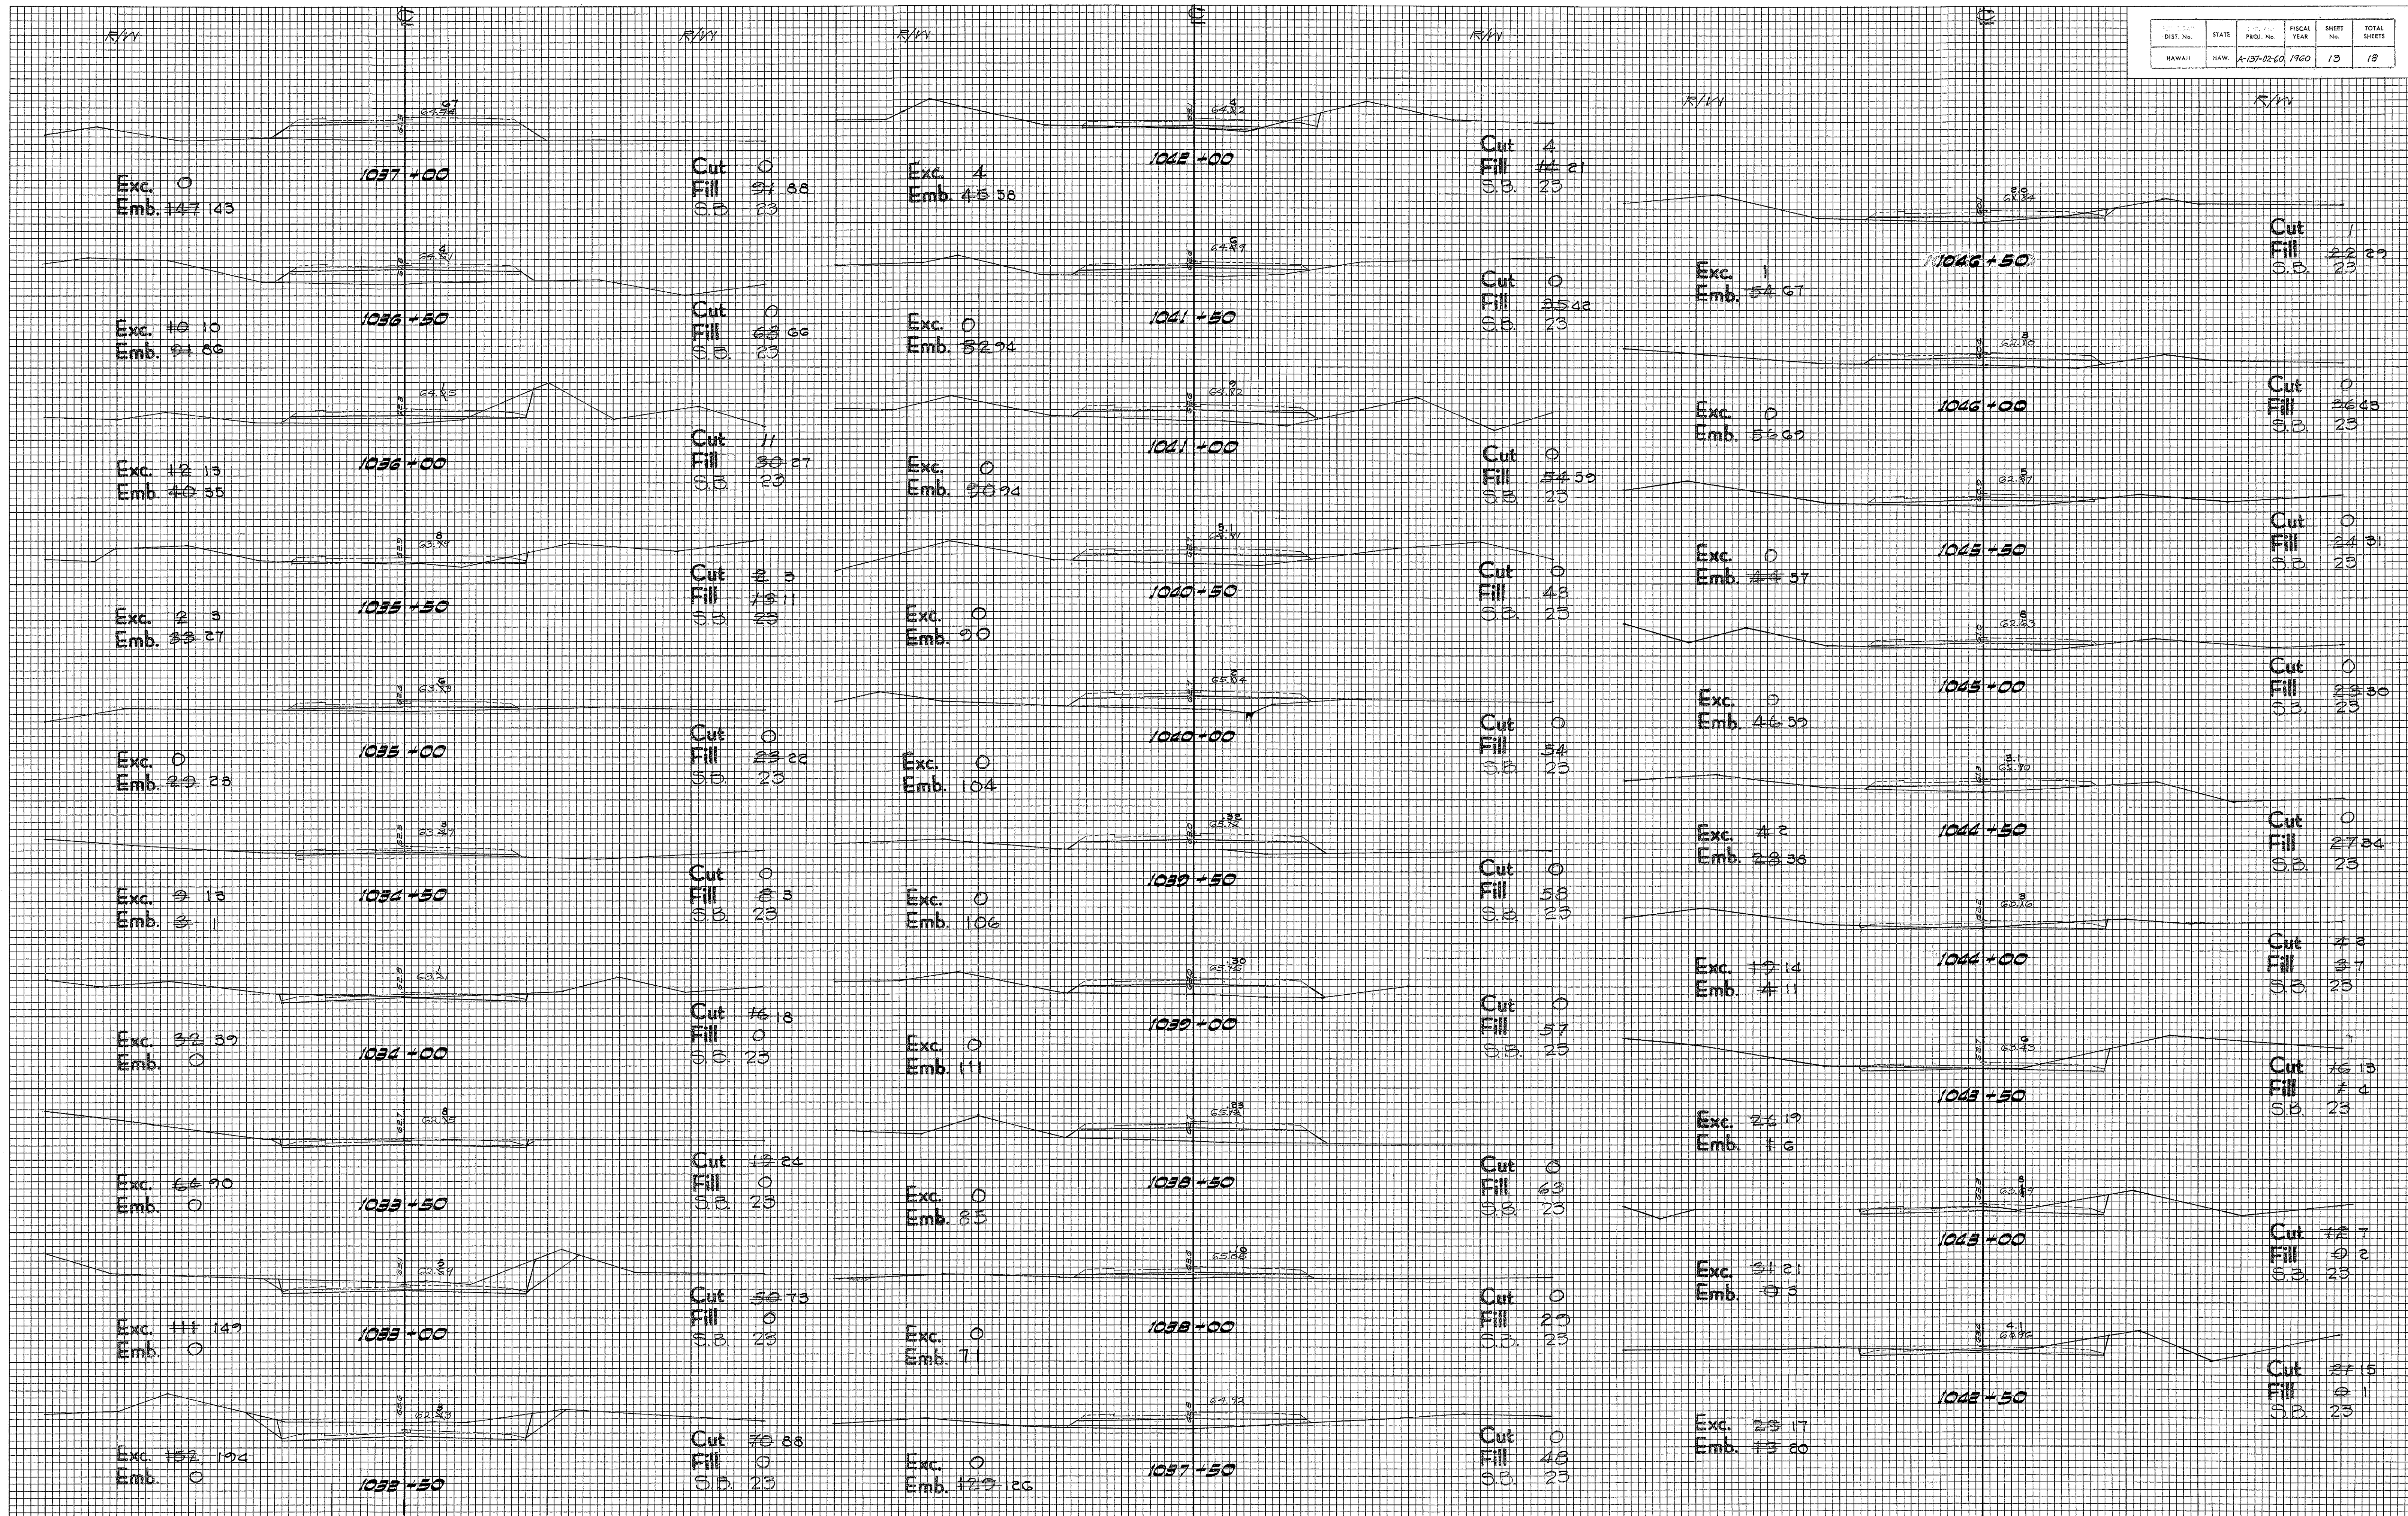

FINAL SURVEY
SURVEYED
PLOTTED
NOTE BOOK
NO. _____
AREAS CHECKED

ORIGINAL SURVEY
SURVEYED
PLOTTED
NOTE BOOK
NO. _____
AREAS CHECKED


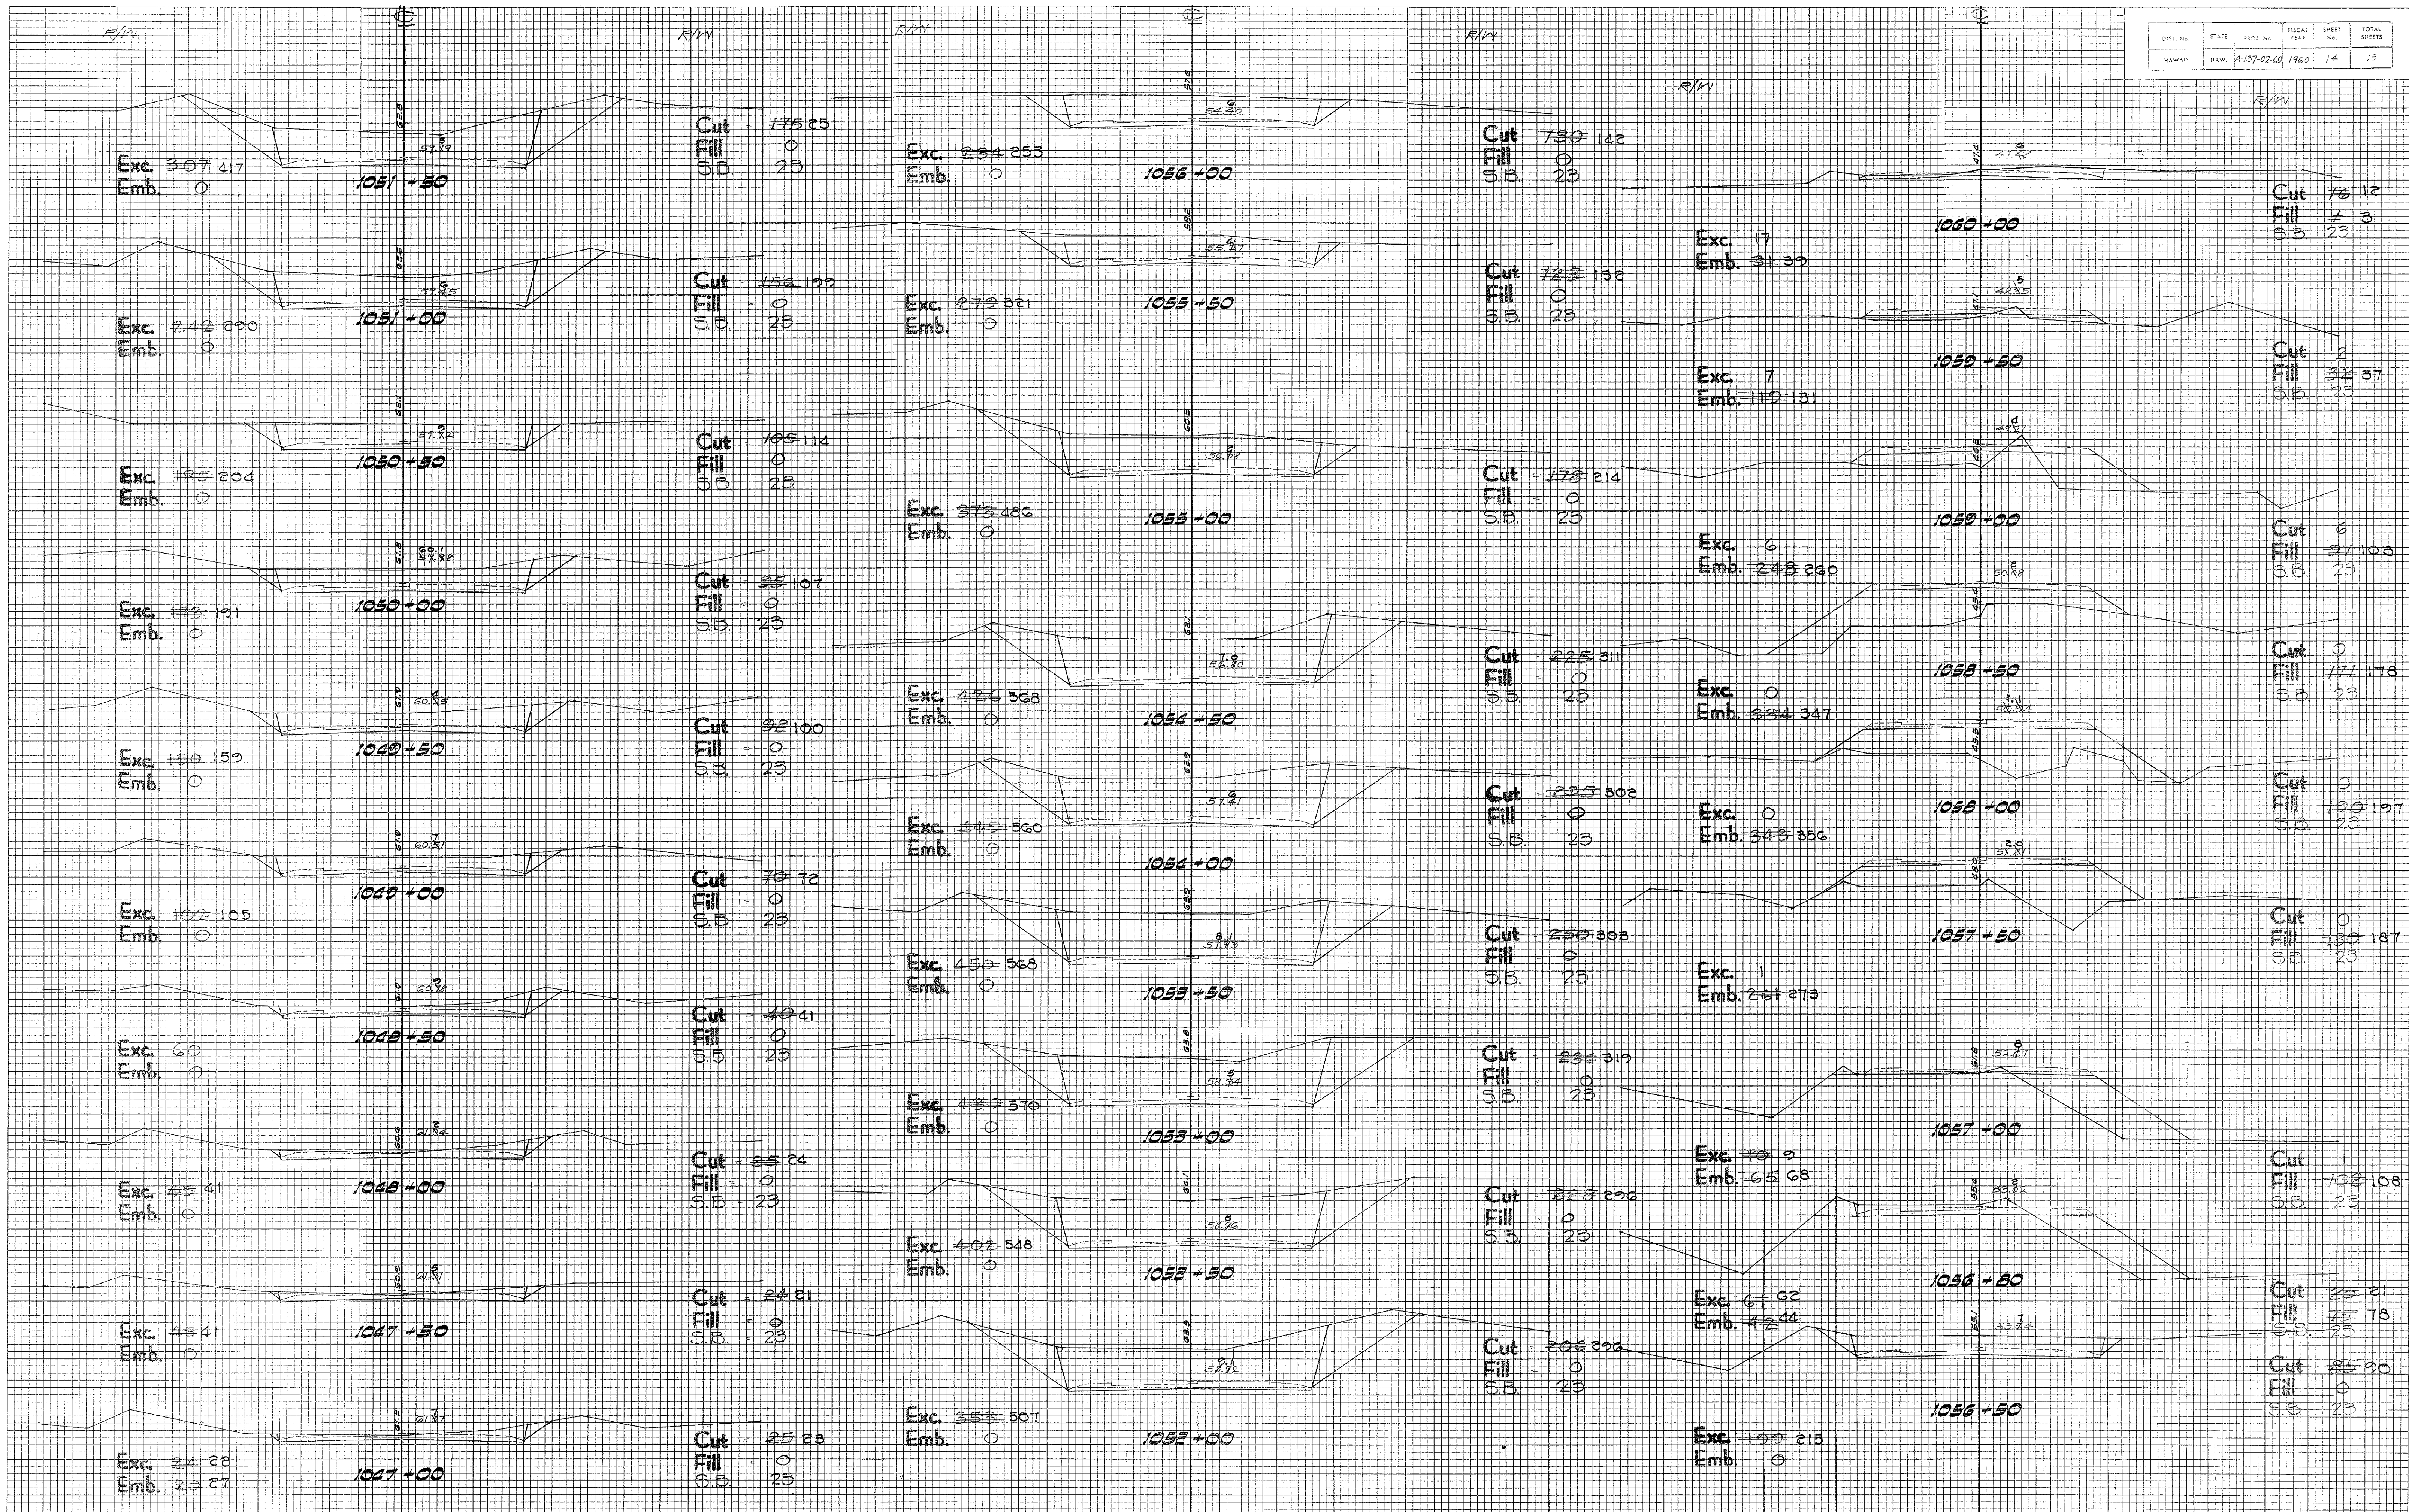


PLATE 3 CROSS SECTION O.P.R. & R.E. STANDARD
100% RAG PAPER-MADE AND PRINTED IN U. S. A.
EUGENE DIETZEN CO.


FINAL SURVEY
DATE
BY
SURVEYED
PLOTTER
NOTE BOOK
REMARKS
AREAS CHECKED
NO.

ORIGINAL SURVEY
DATE
BY
SURVEYED
PLOTTER
NOTE BOOK
REMARKS
AREAS CHECKED
NO.

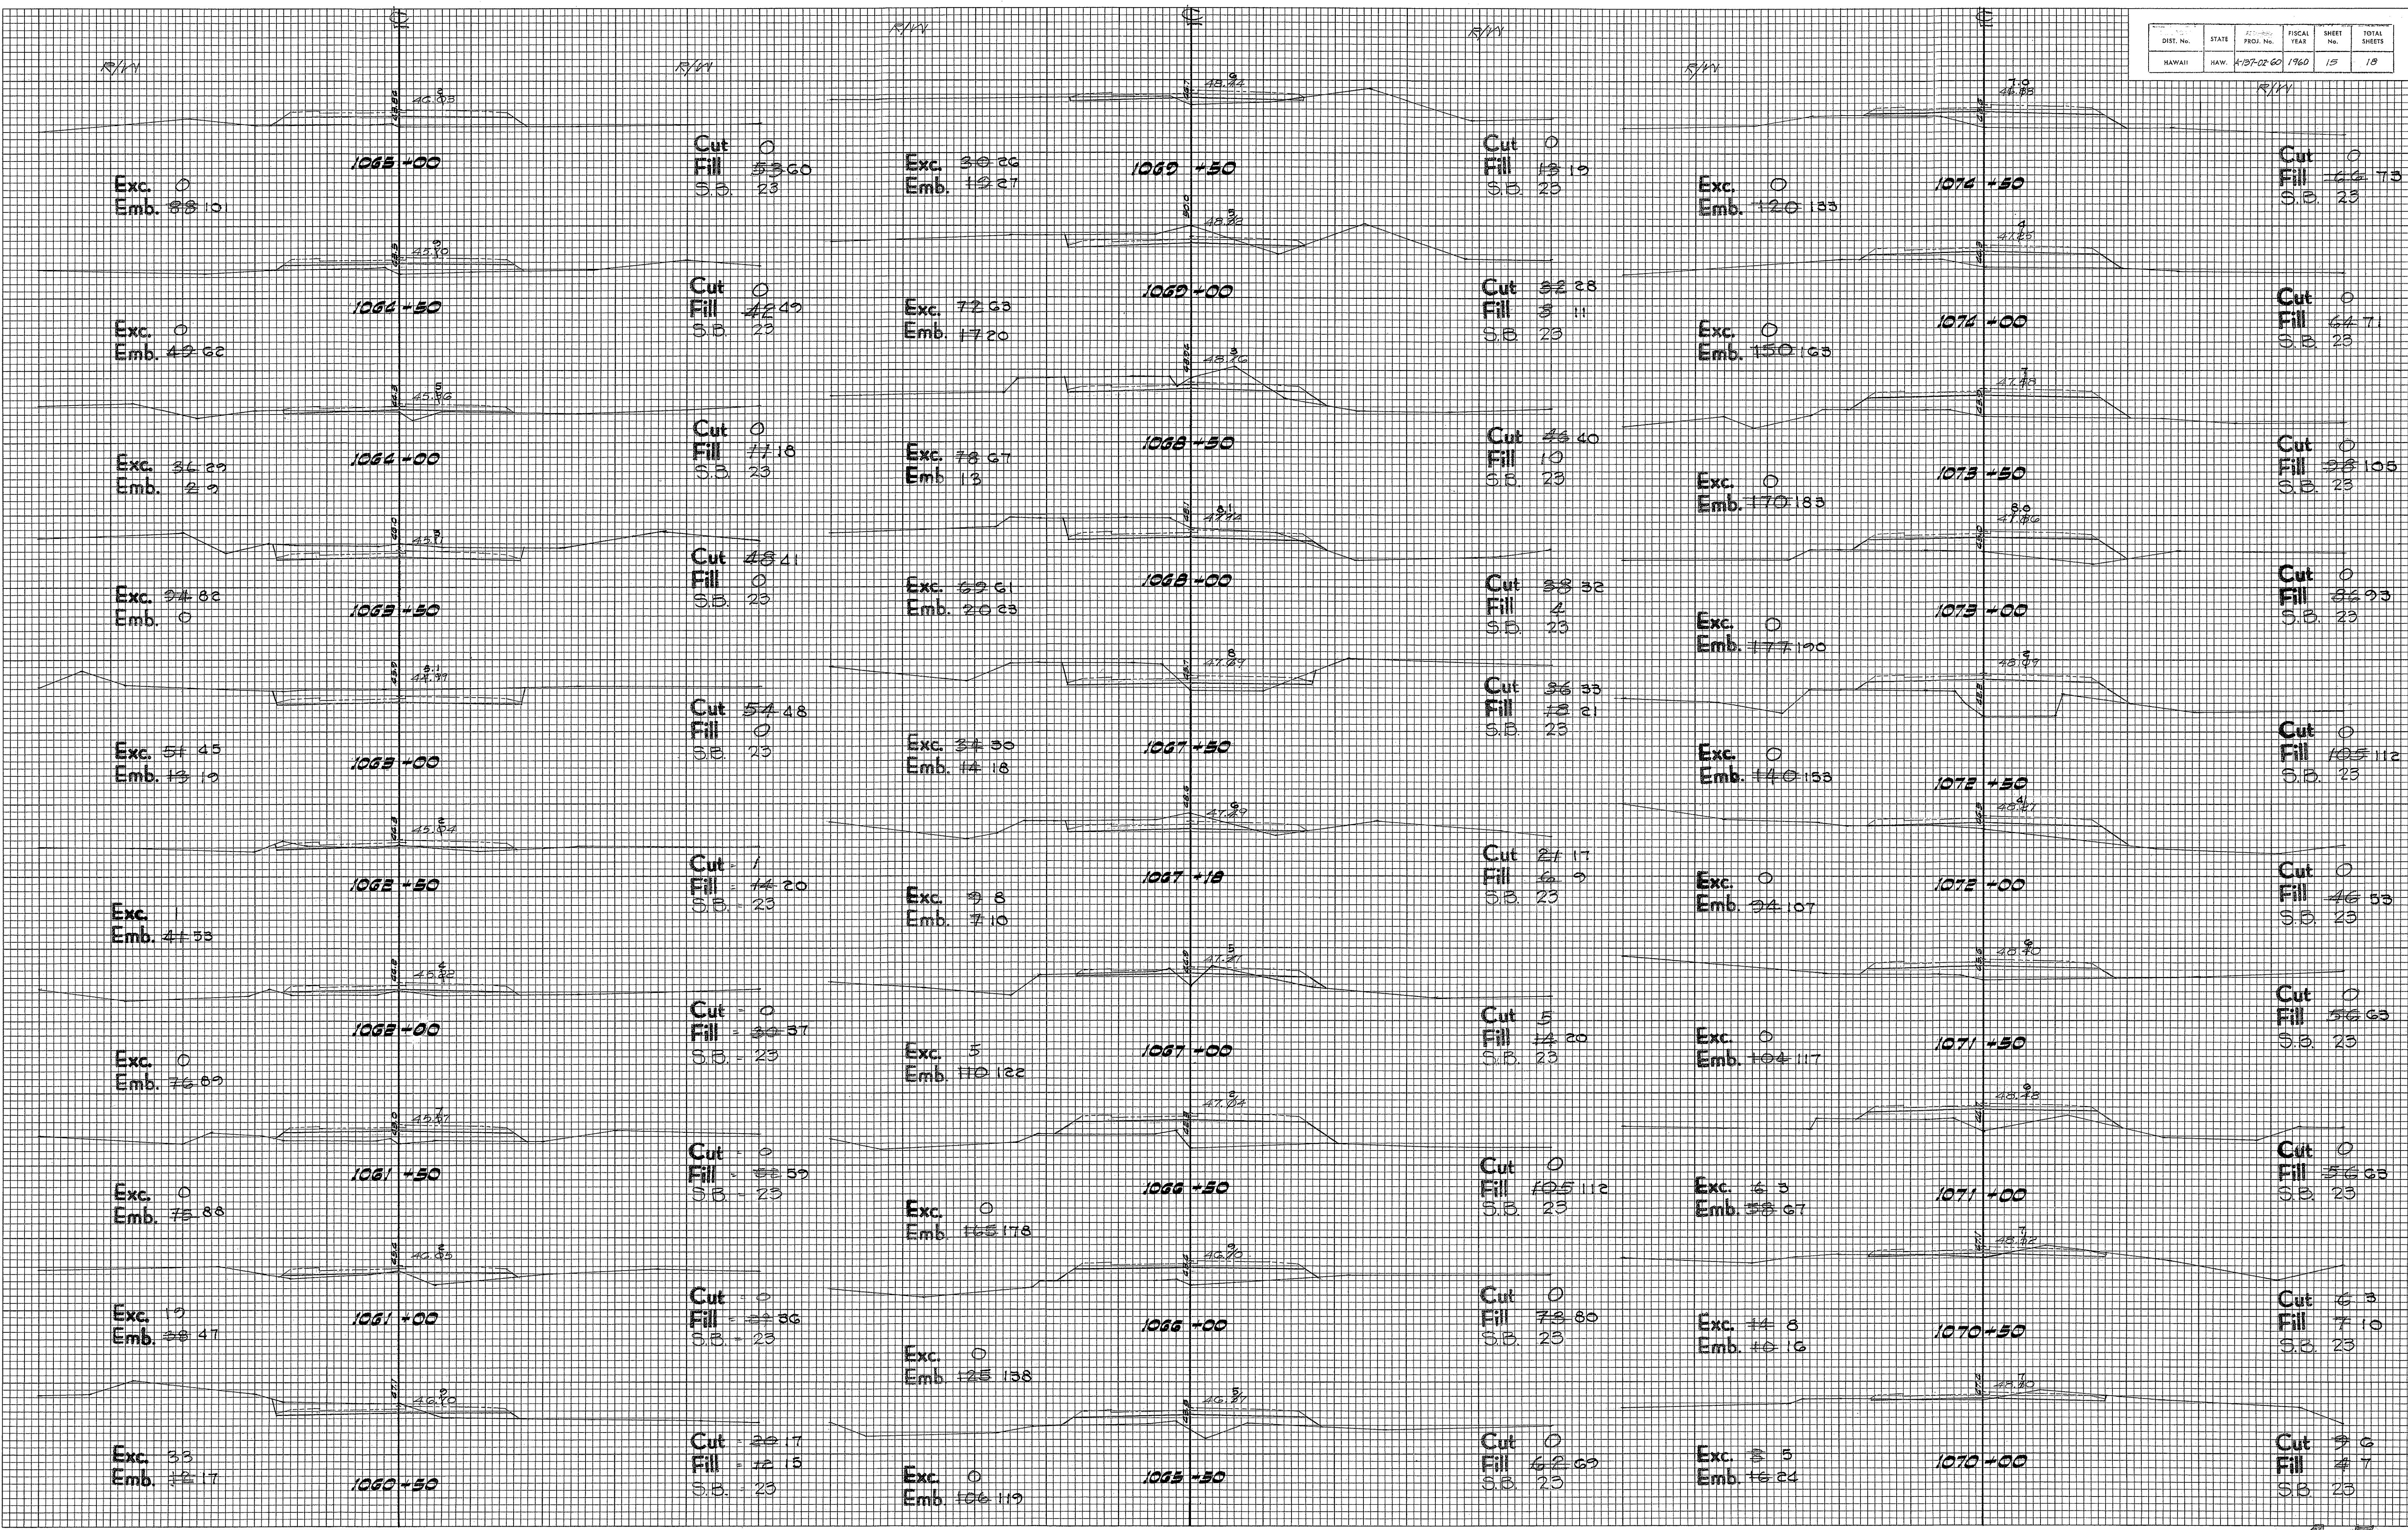

FINAL SURVEY
DATE
BY
SURVEYED
PLOTTED
NOTE BOOK
NO.
AREAS CHECKED


ORIGINAL SURVEY
DATE
BY
SURVEYED
PLOTTED
NOTE BOOK
NO.
AREAS CHECKED

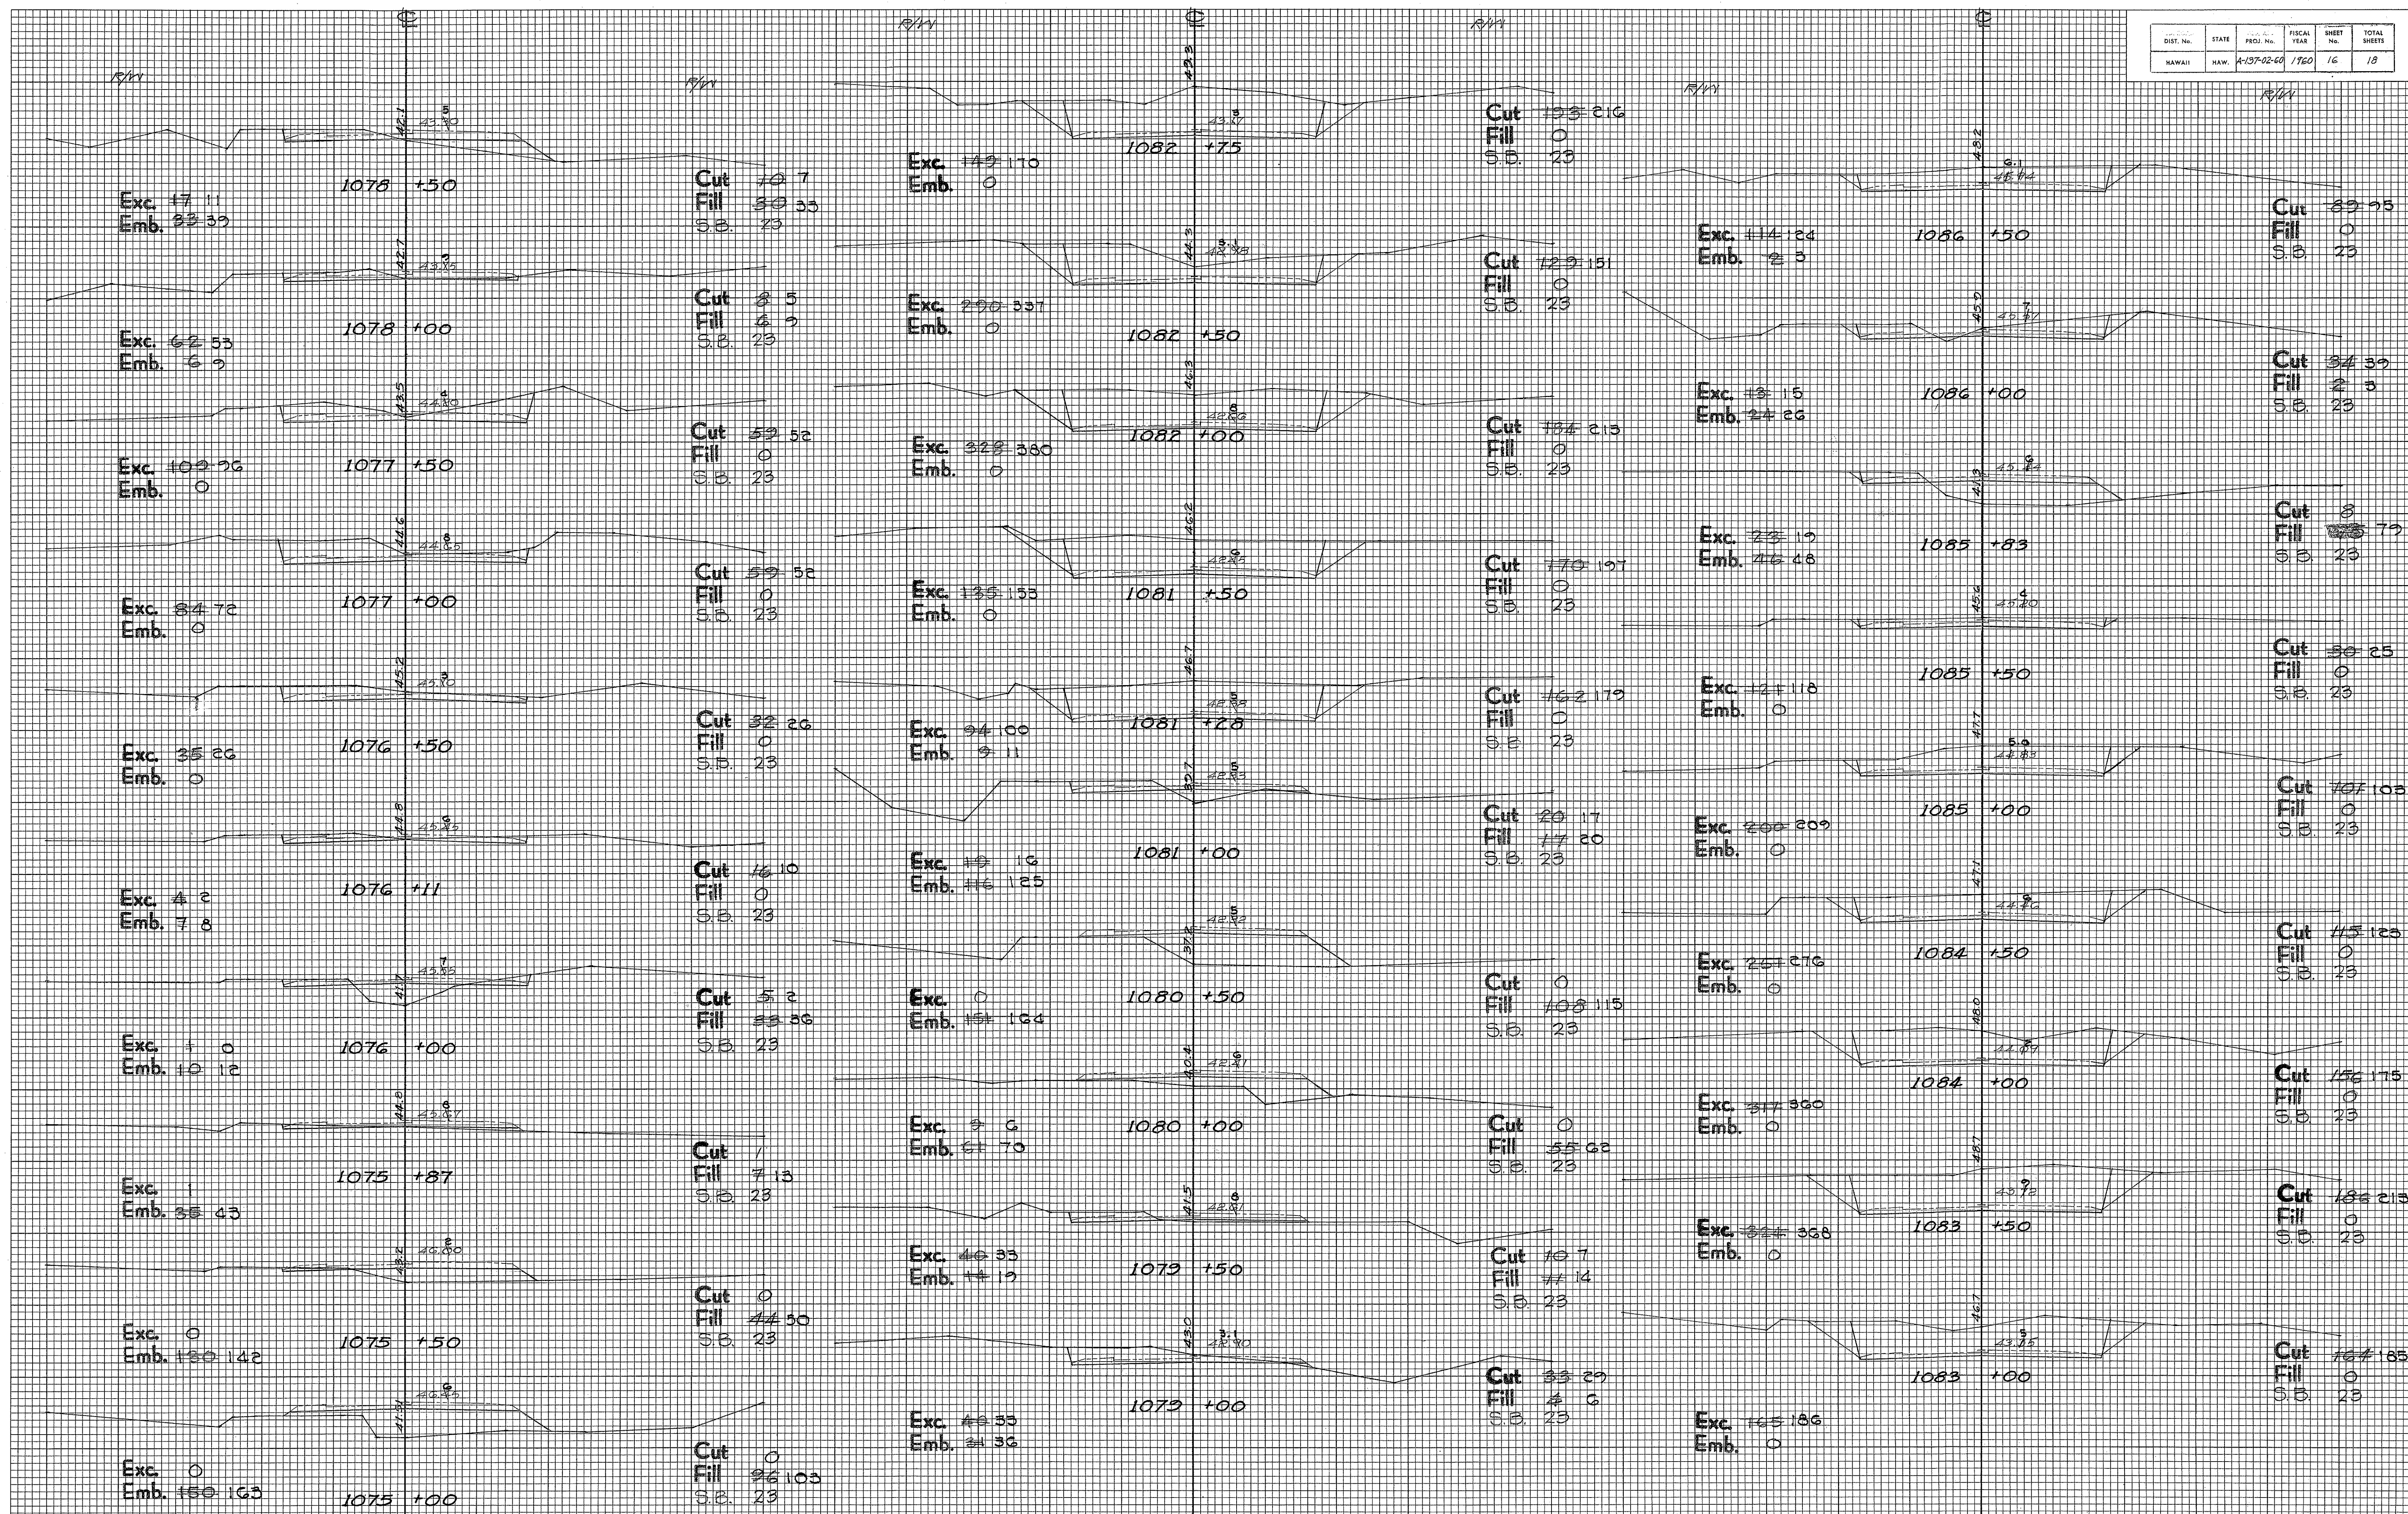

DIST. No.	STATE	PROJ. No.	FISCAL YEAR	SHEET No.	TOTAL SHEETS
HAWAII	HAW.	A-137-12-60	1960	17	18

DATE	BY
FINAL SURVEY	SURVEYED
NOTE BOOK	PLOTTED
NO.	AREAS CHECKED


DATE	BY
ORIGINAL SURVEY	SURVEYED
NOTE BOOK	PLOTTED
NO.	AREAS CHECKED

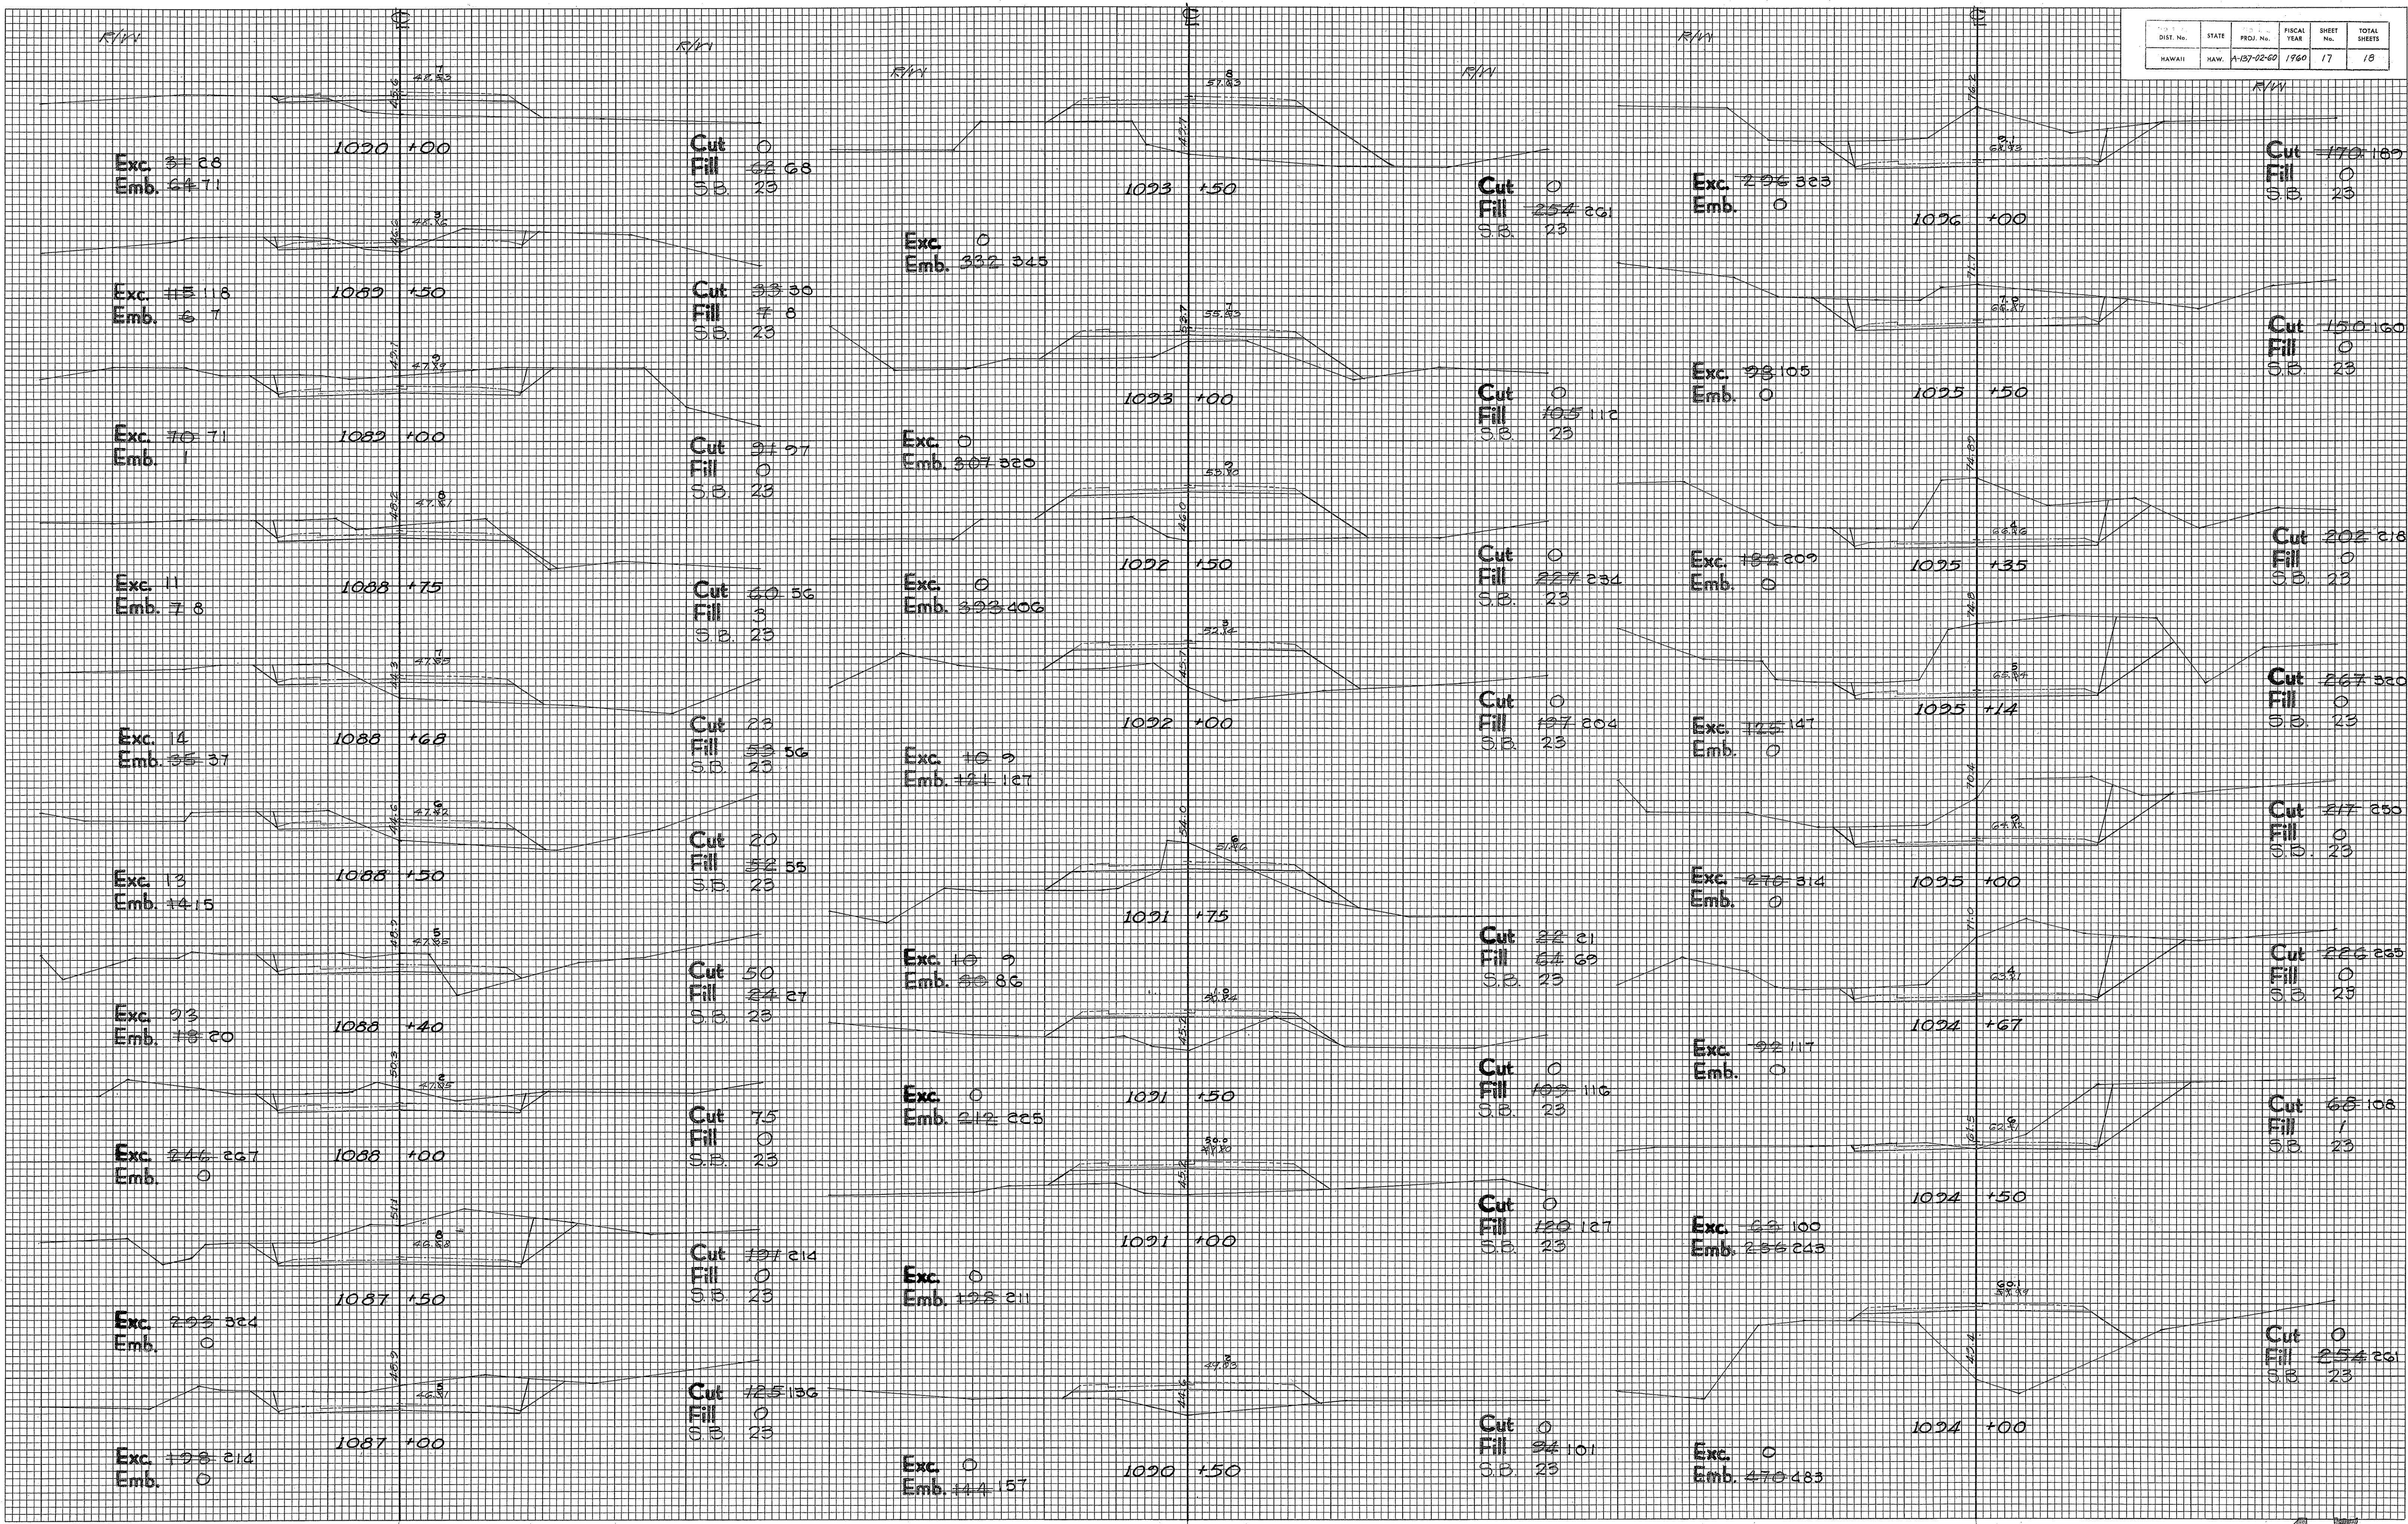

DIST. No.	STATE	PROJ. No.	FISCAL YEAR	SHEET No.	TOTAL SHEETS
HAWAII	HAW.	A-137-02-50	1960	18	18

DATE	BY	NO.

DATE	BY	NO.
11-28-60		

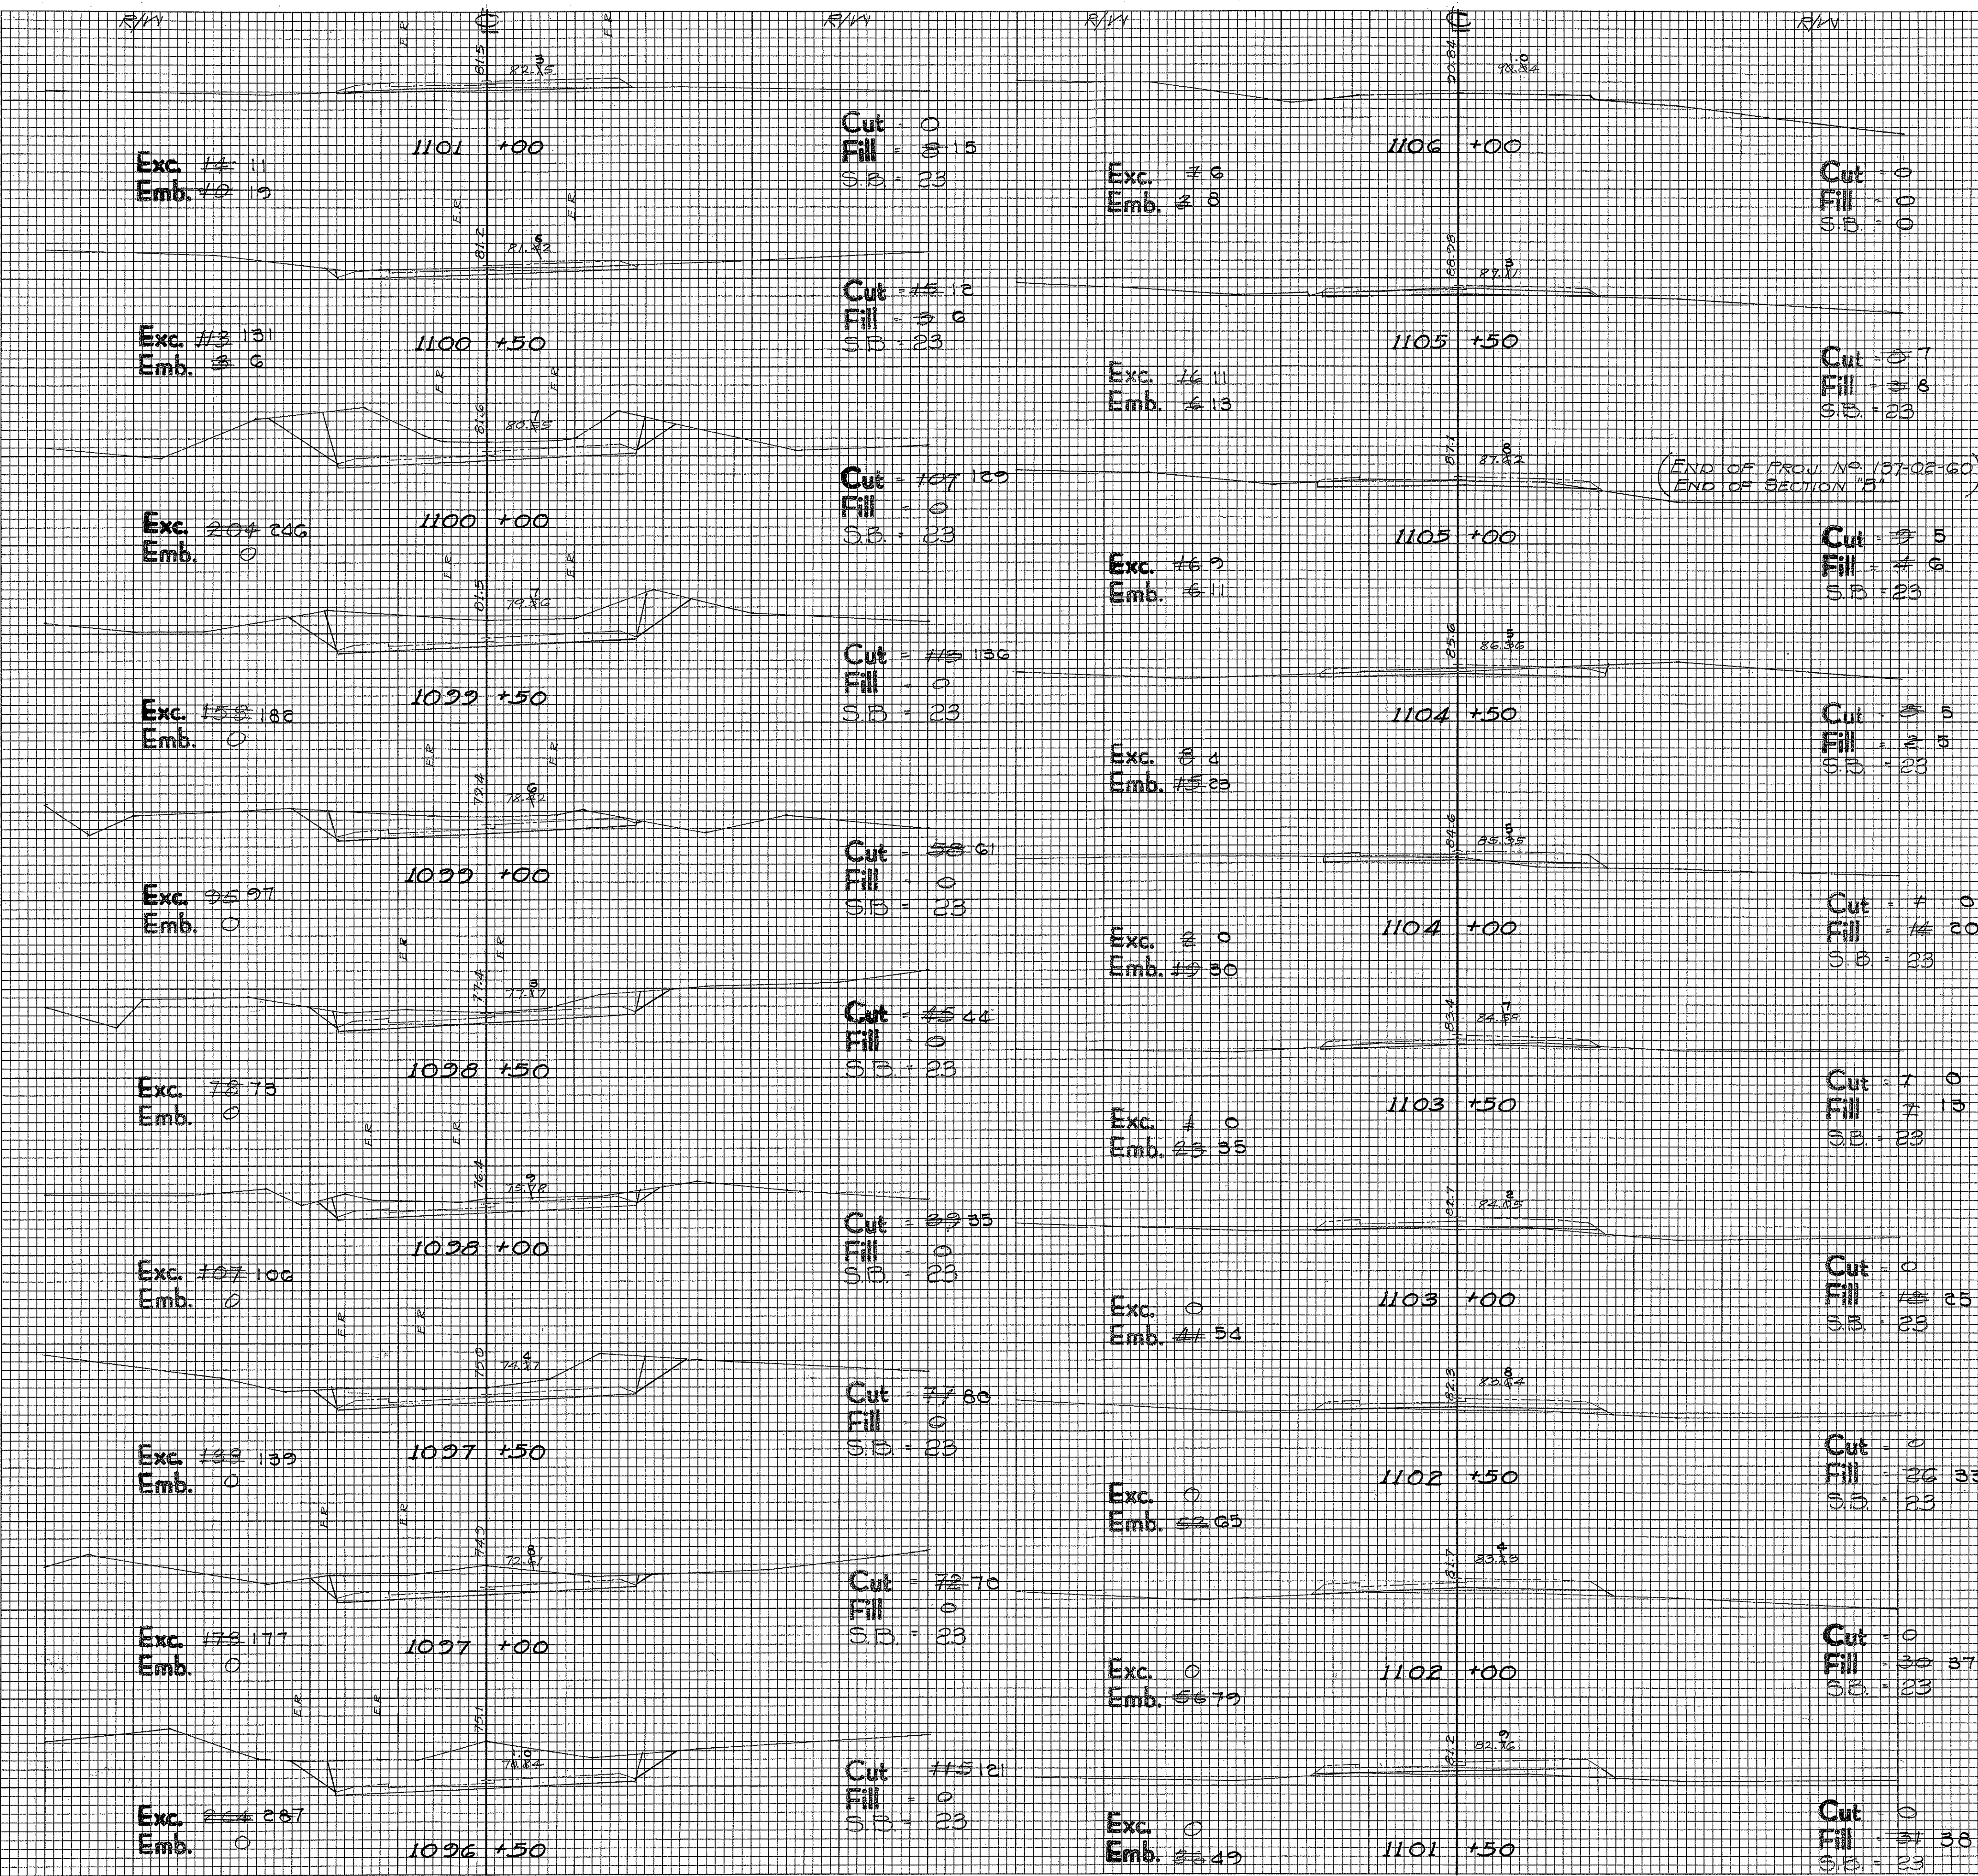

(END OF PROJ. NO. 137-02-50)
(END OF SECTION "B")