

INDEX TO DRAWINGS	
SHEET	DESCRIPTION
1	TITLE SHEET
2-3	TYPICAL SECTIONS
4-7	PLAN AND PROFILE
8-9	STANDARD DETAILS
10-18	CROSS SECTIONS



STATE OF HAWAII
DEPARTMENT OF TRANSPORTATION
DIVISION OF HIGHWAYS
"AS BUILT" PLANS OF

KAIMU - KAPOHO ROAD
KAIMU TO BEG. PROJ. ER 8(2)
PROJECT NO. A-137-02-60

DISTRICT OF PUNA
ISLAND OF HAWAII

SCALES

PLAN	1 INCH = 100 FT.
PROFILE	HOR. 1 INCH = 100 FT.
	VER. 1 INCH = 10 FT.
CROSS SECTION	HOR. 1 INCH = 10 FT.
	VER. 1 INCH = 10 FT.

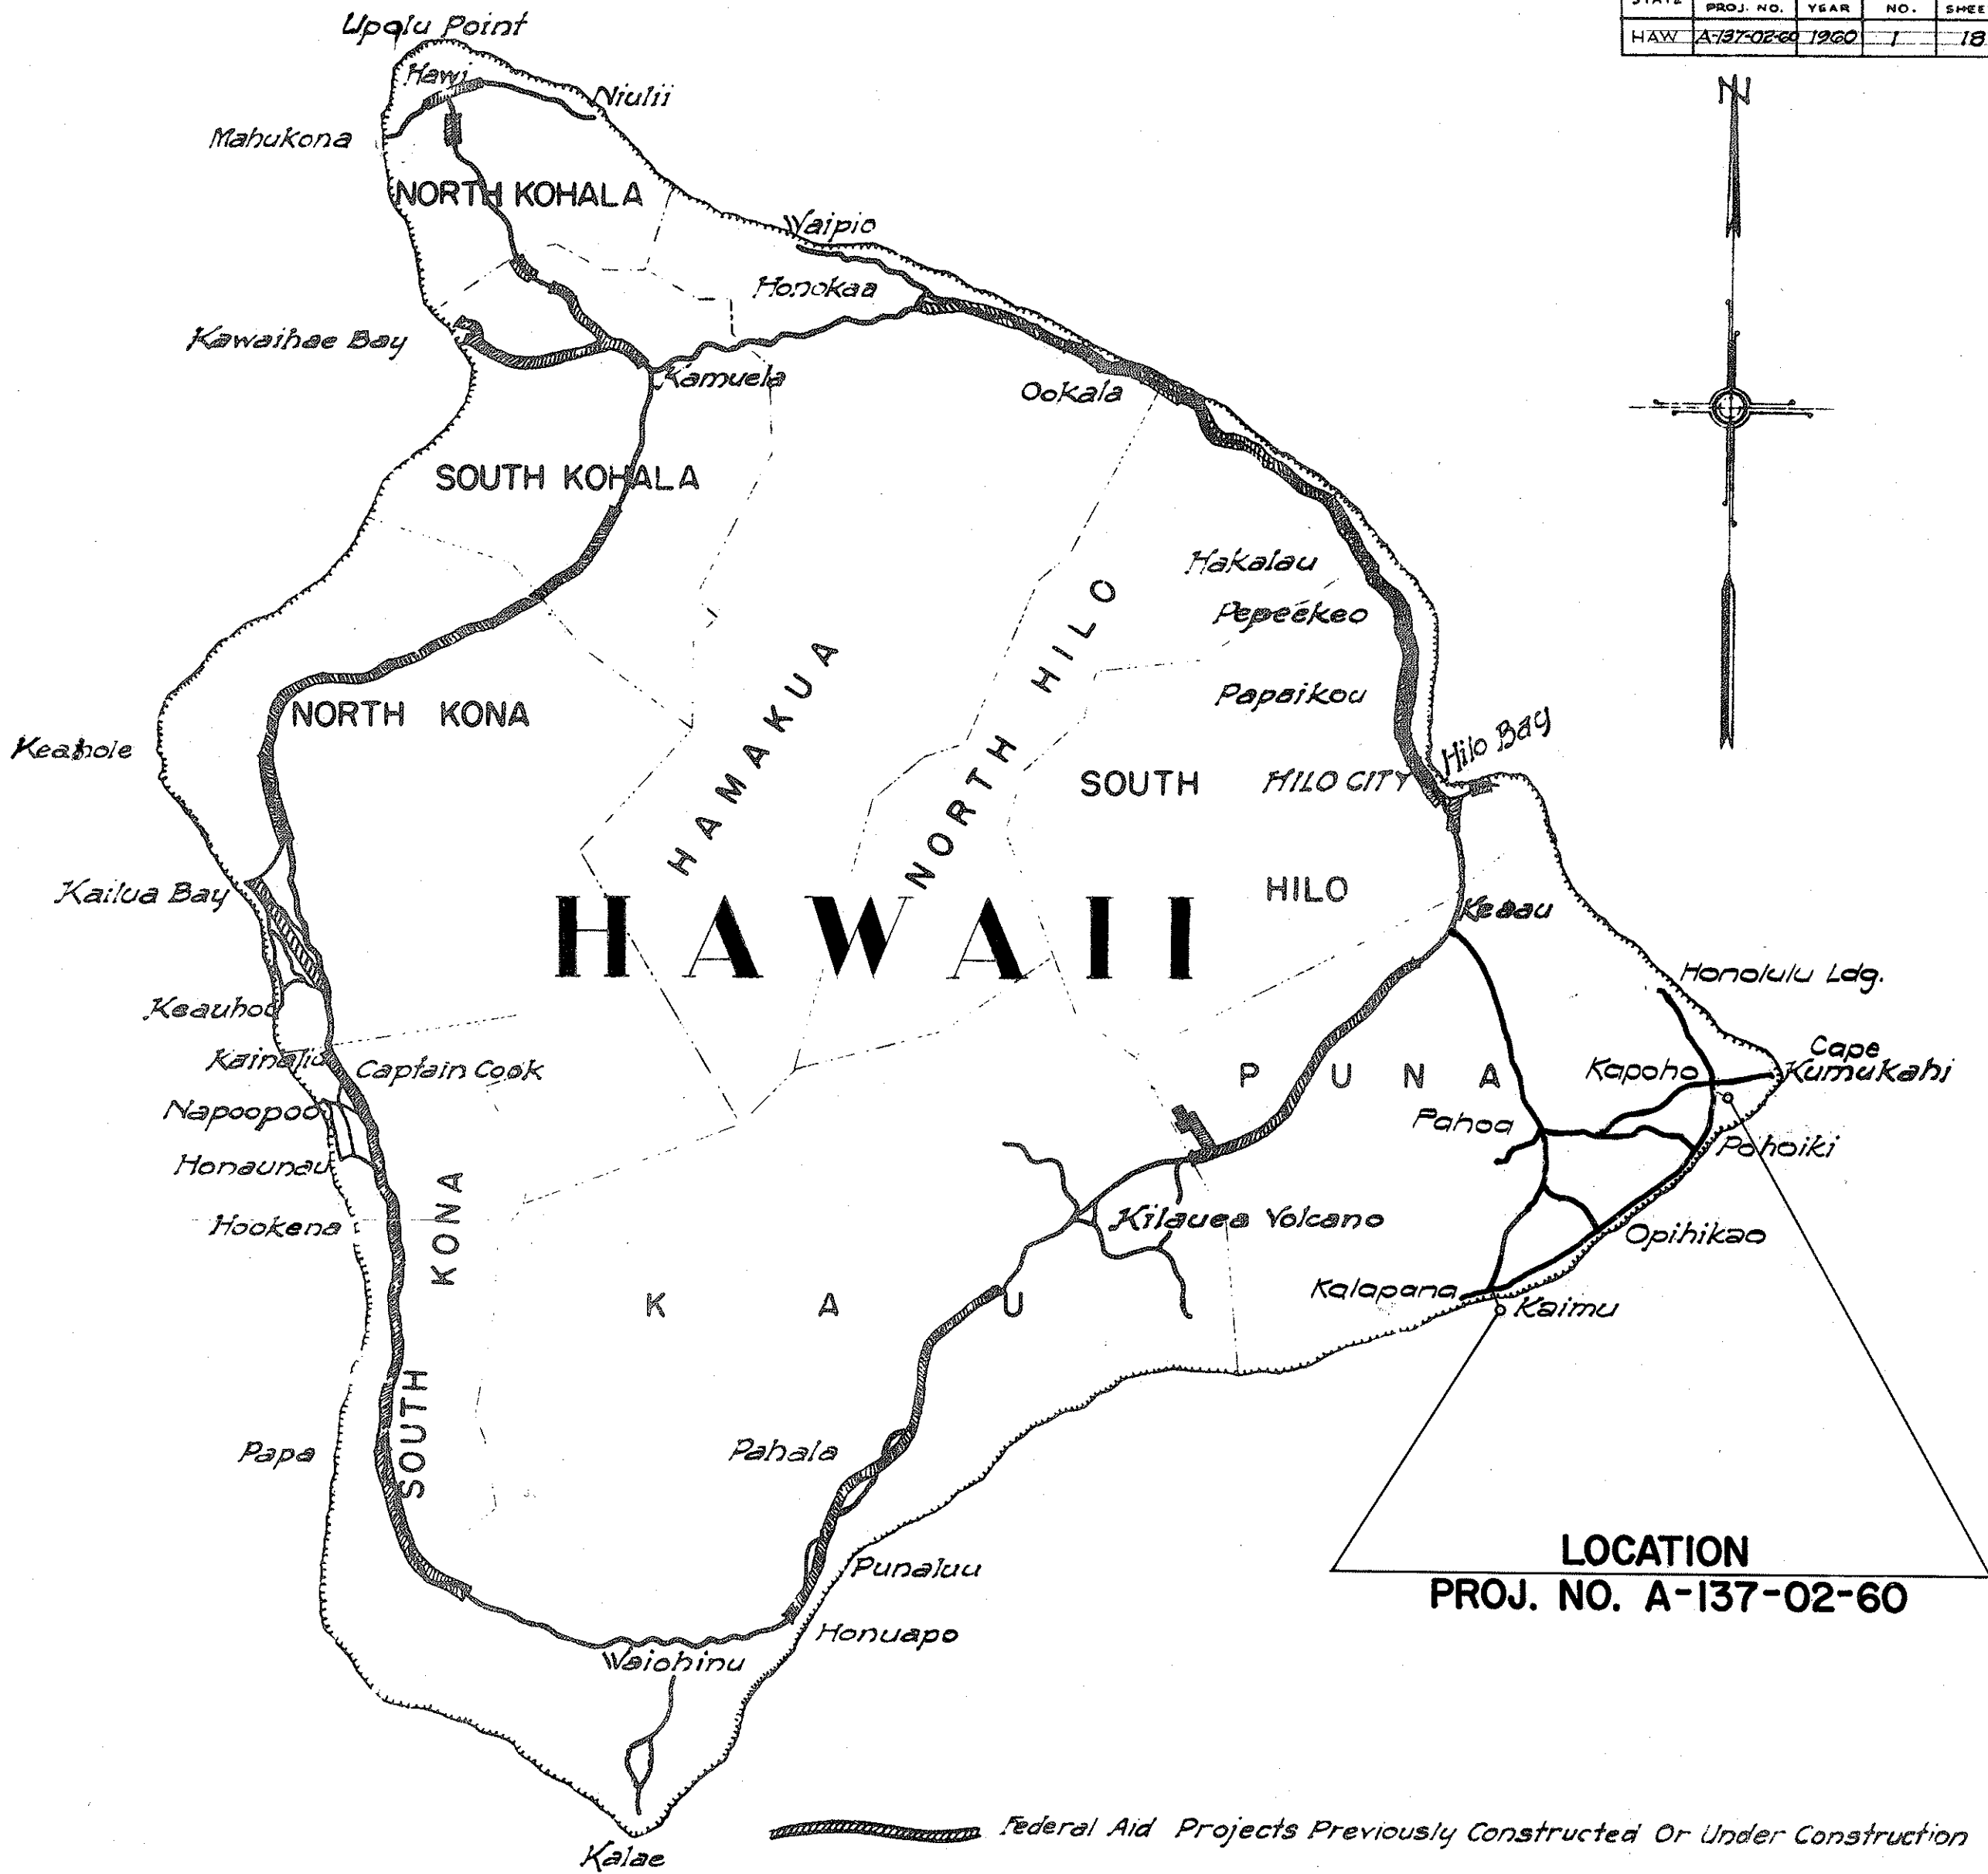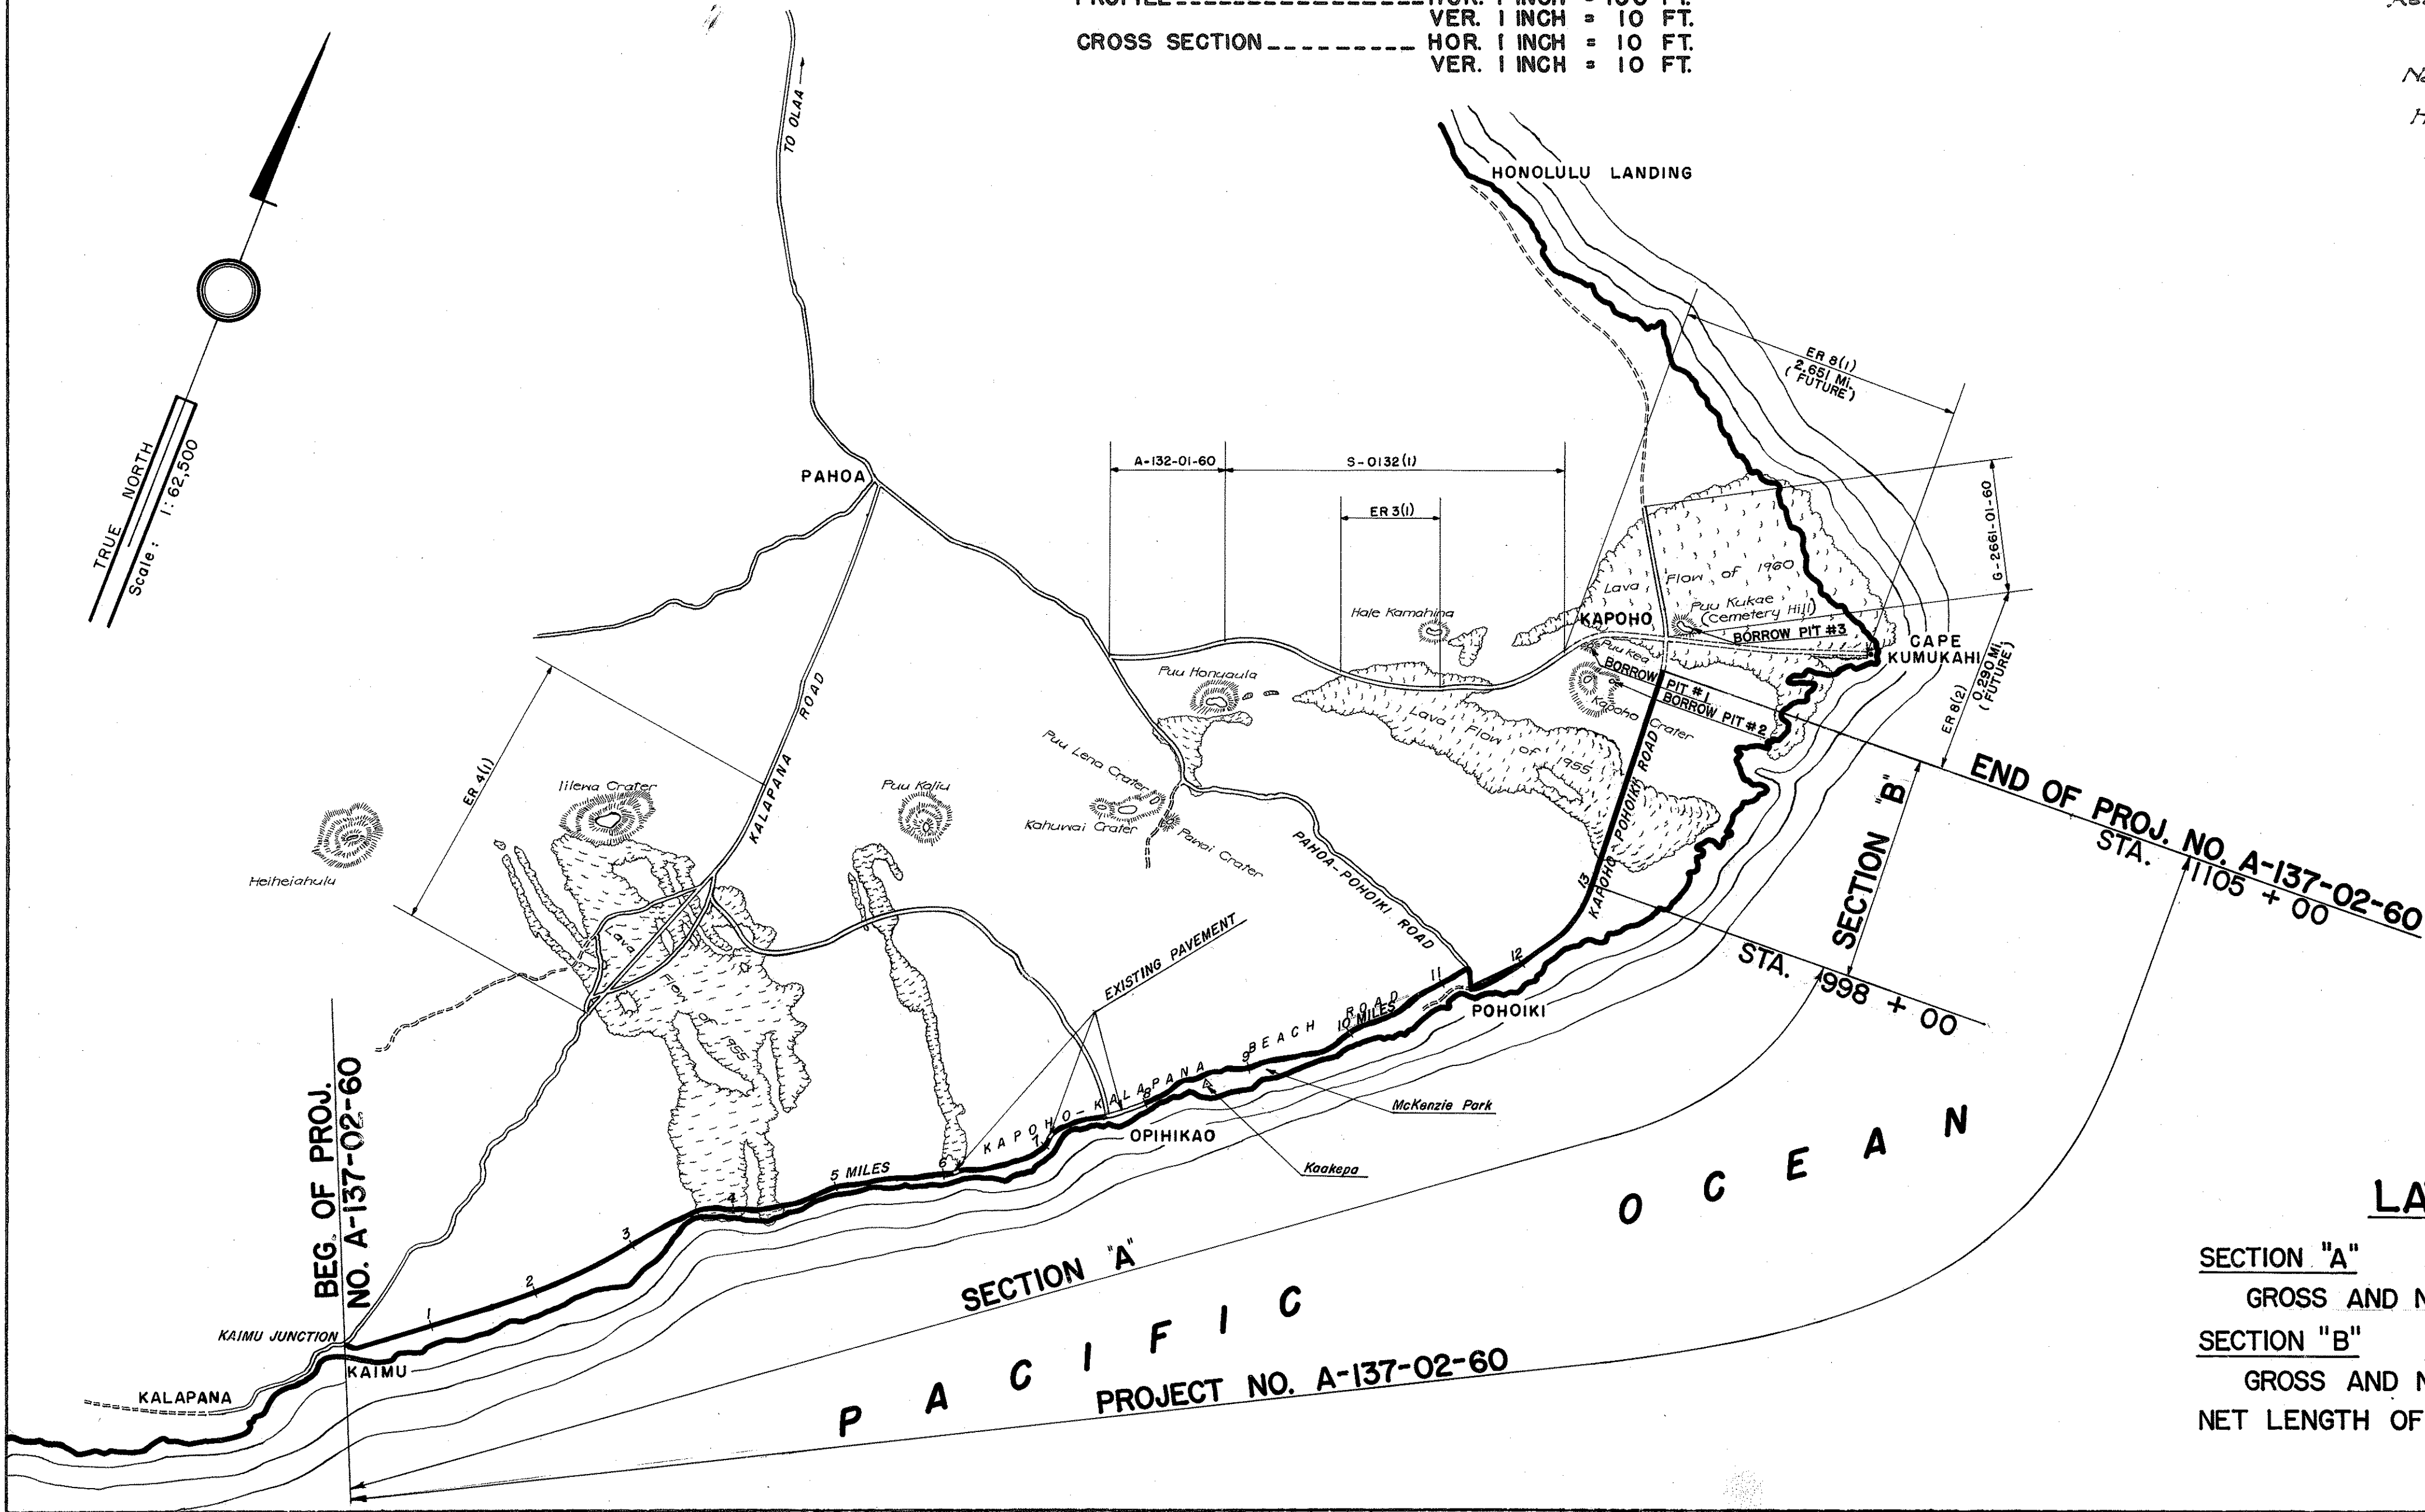

NOTE:
ALL CHANGES MADE DURING CONSTRUCTION
HAVE BEEN NOTED ON THESE TRACINGS IN
RED AND CHECKED BY:

Kazumi Okamura
PROJECT ENGINEER

May 27, 1963
DATE

AUTHORIZED BY ACT 23, SLH 1960,
SECTION 1(a), ITEM C-36

APPROVED:

DATE: Apr. 24 '61

DIRECTOR OF TRANSPORTATION

LAYOUT OF PROJECT

SECTION "A"	
GROSS AND NET LENGTH	13 MILES (APPROX.)
SECTION "B"	
GROSS AND NET LENGTH	2.027 MILES
NET LENGTH OF PROJECT	15 MILES (APPROX.)

A01370260.01