



STATE	PROJ. NO.	FISCAL YEAR	SHEET NO.	TOTAL SHEETS
HAW.	BMD 66-343 PHASE I	FY 74-75	3	41

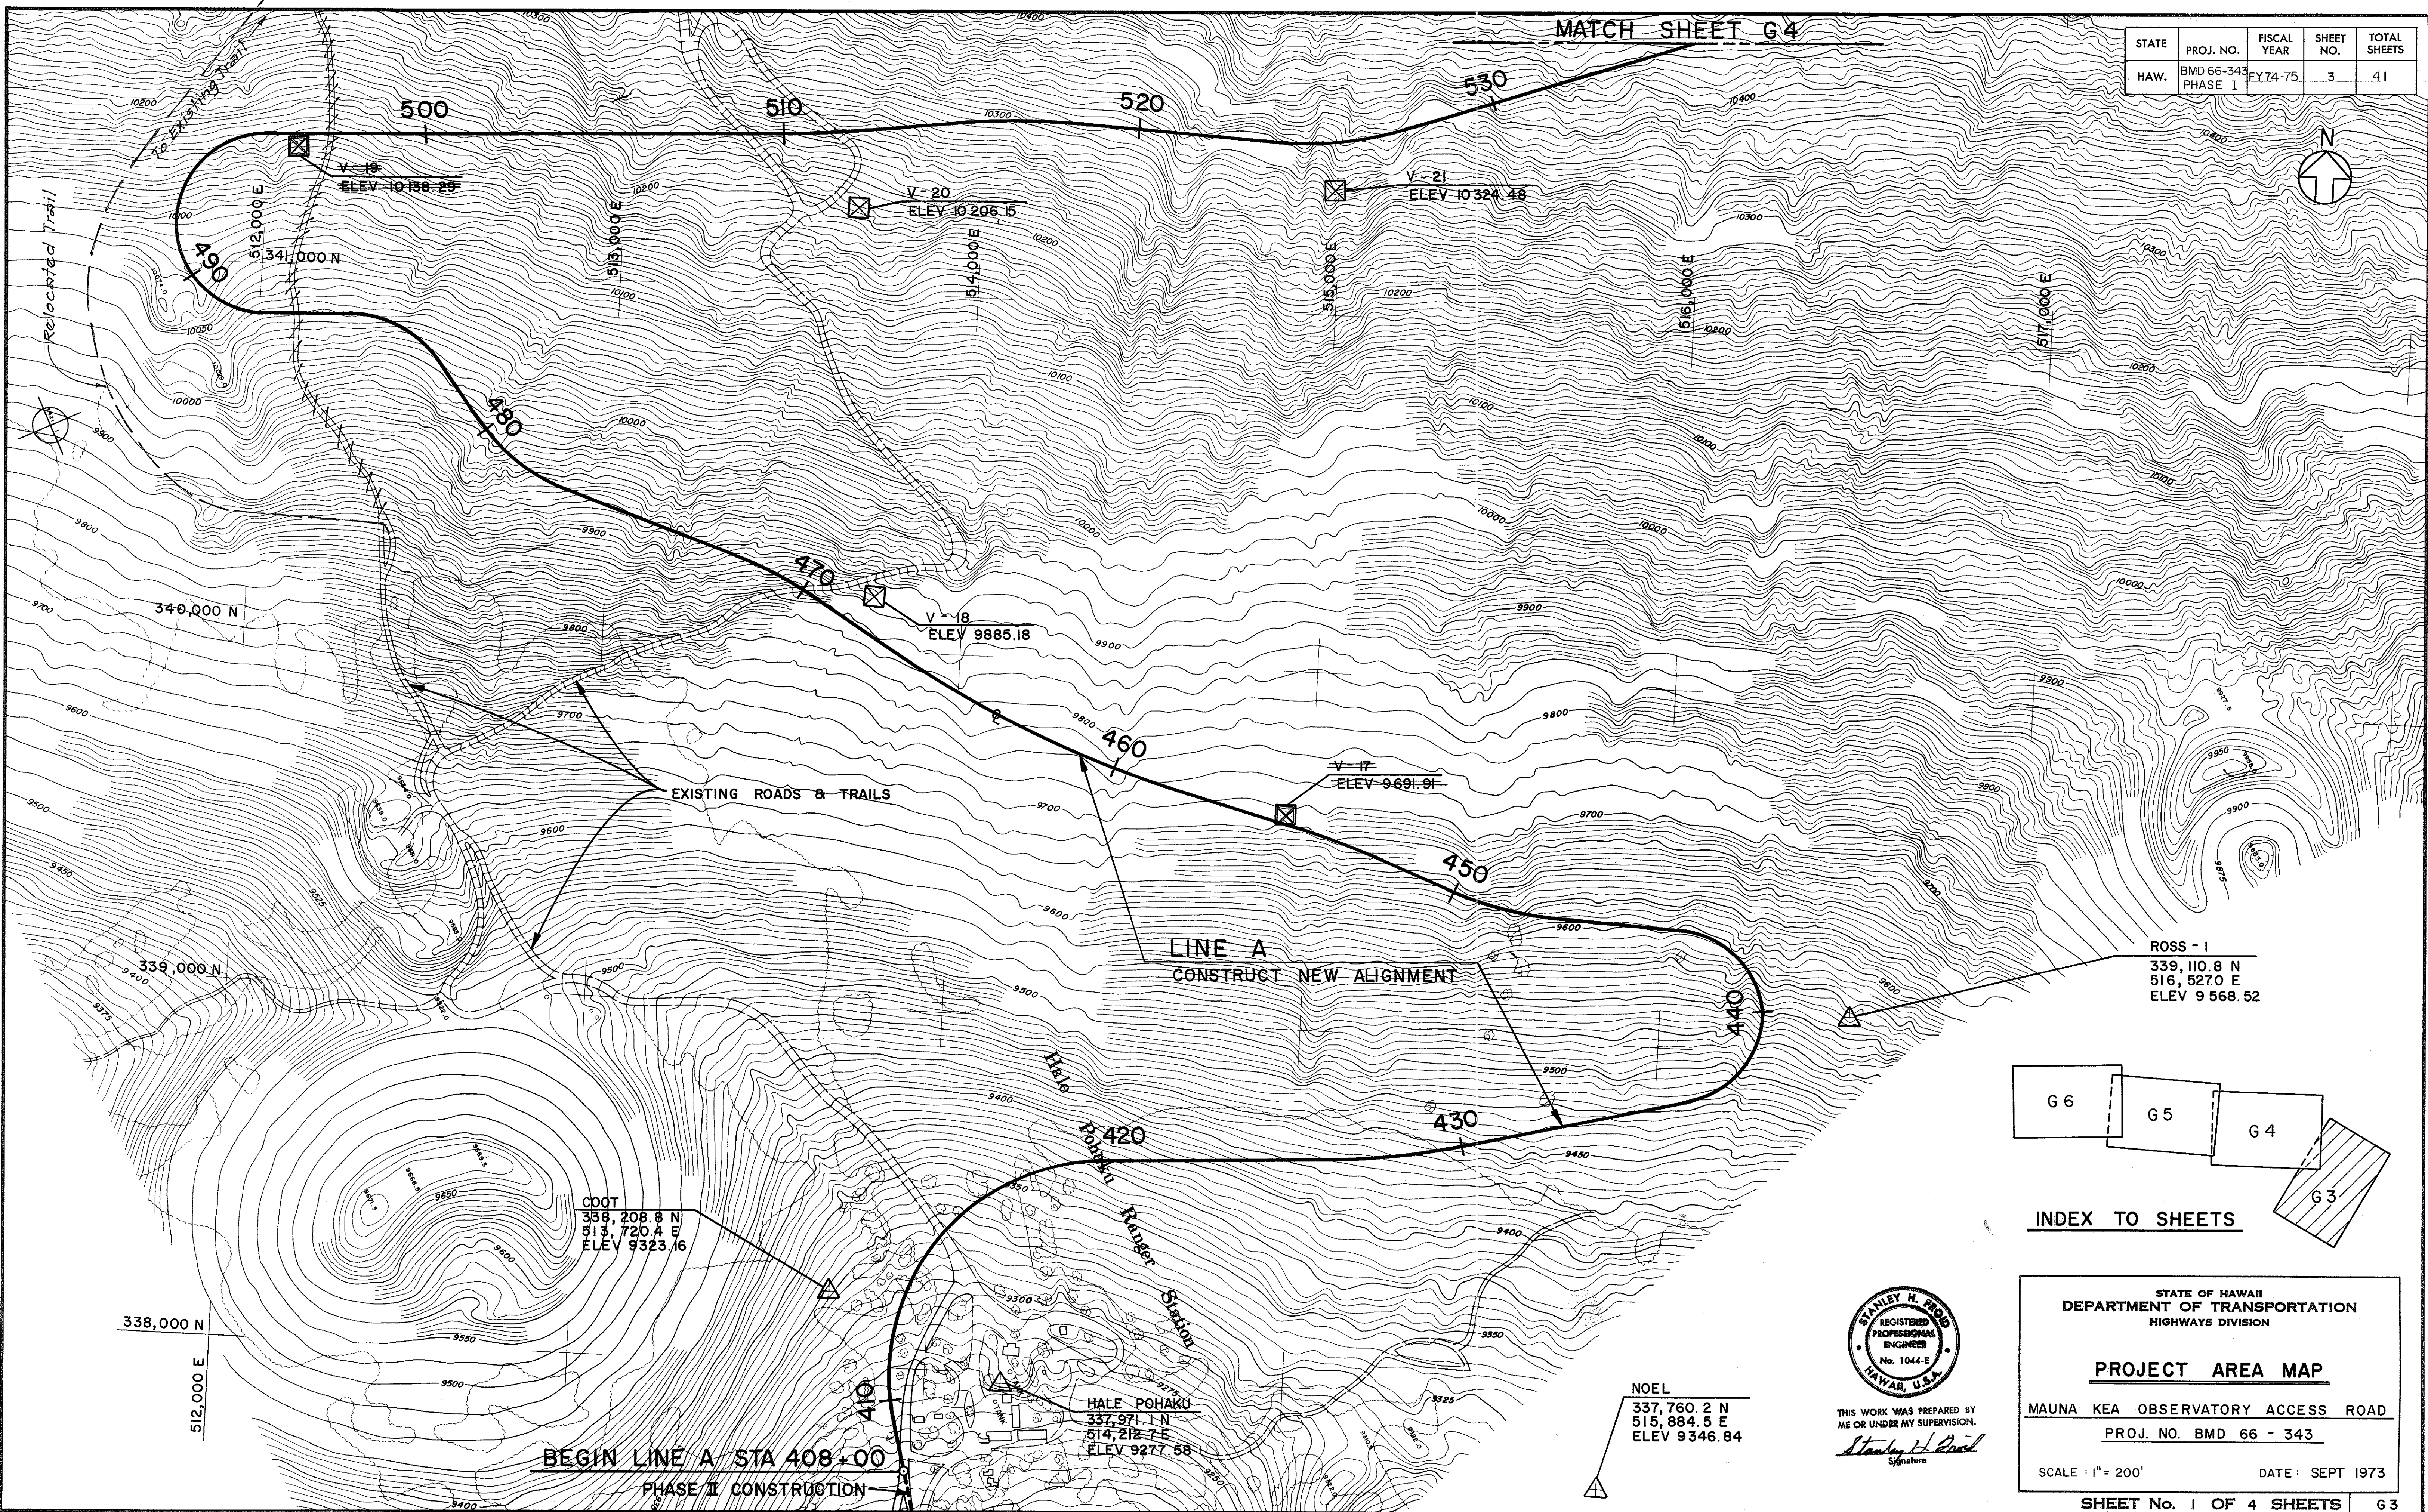

ROSS - 1
339,110.8 N
516,527.0 E
ELEV 9568.52

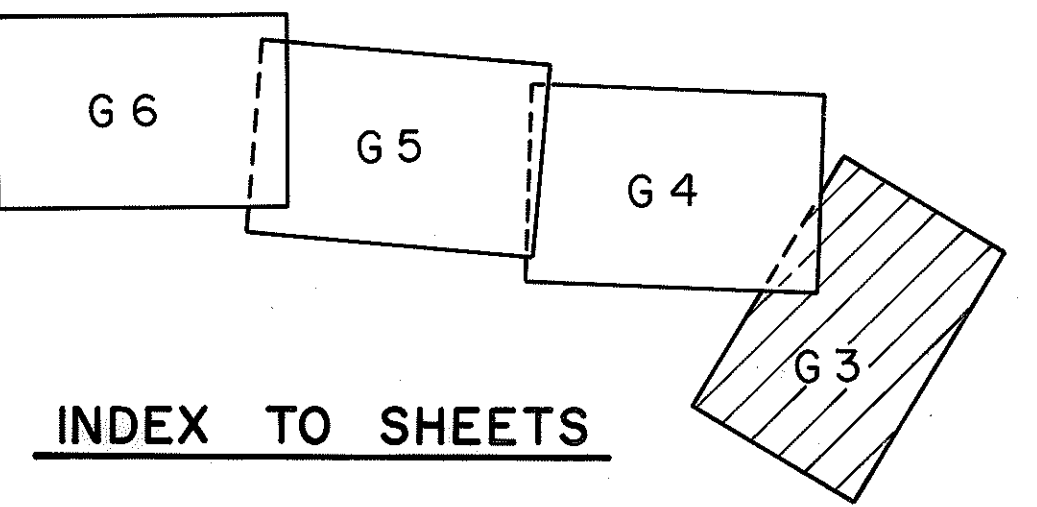

STATE OF HAWAII
DEPARTMENT OF TRANSPORTATION
HIGHWAYS DIVISION

PROJECT AREA MAP


MAUNA KEA OBSERVATORY ACCESS ROAD

PROJ. NO. BMD 66 - 343

SCALE: 1" = 200'

DATE: SEPT 1973


SHEET No. 1 OF 4 SHEETS

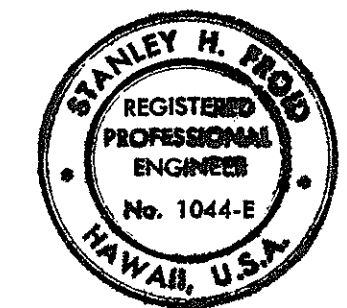

THIS WORK WAS PREPARED BY
ME OR UNDER MY SUPERVISION.
Stanley H. Prod
Signature

ORIGINAL PLAN	SURVEY PLOTTED BY	DATE
DRAWN BY	TRACED BY	
NOTE BOOK	QUANTITIES BY	
NO.	CHECKED BY	

STATE	PROJ. NO.	FISCAL YEAR	SHEET NO.	TOTAL SHEETS
HAW.	BMD 66-343 PHASE I	FY 74-75	4	41

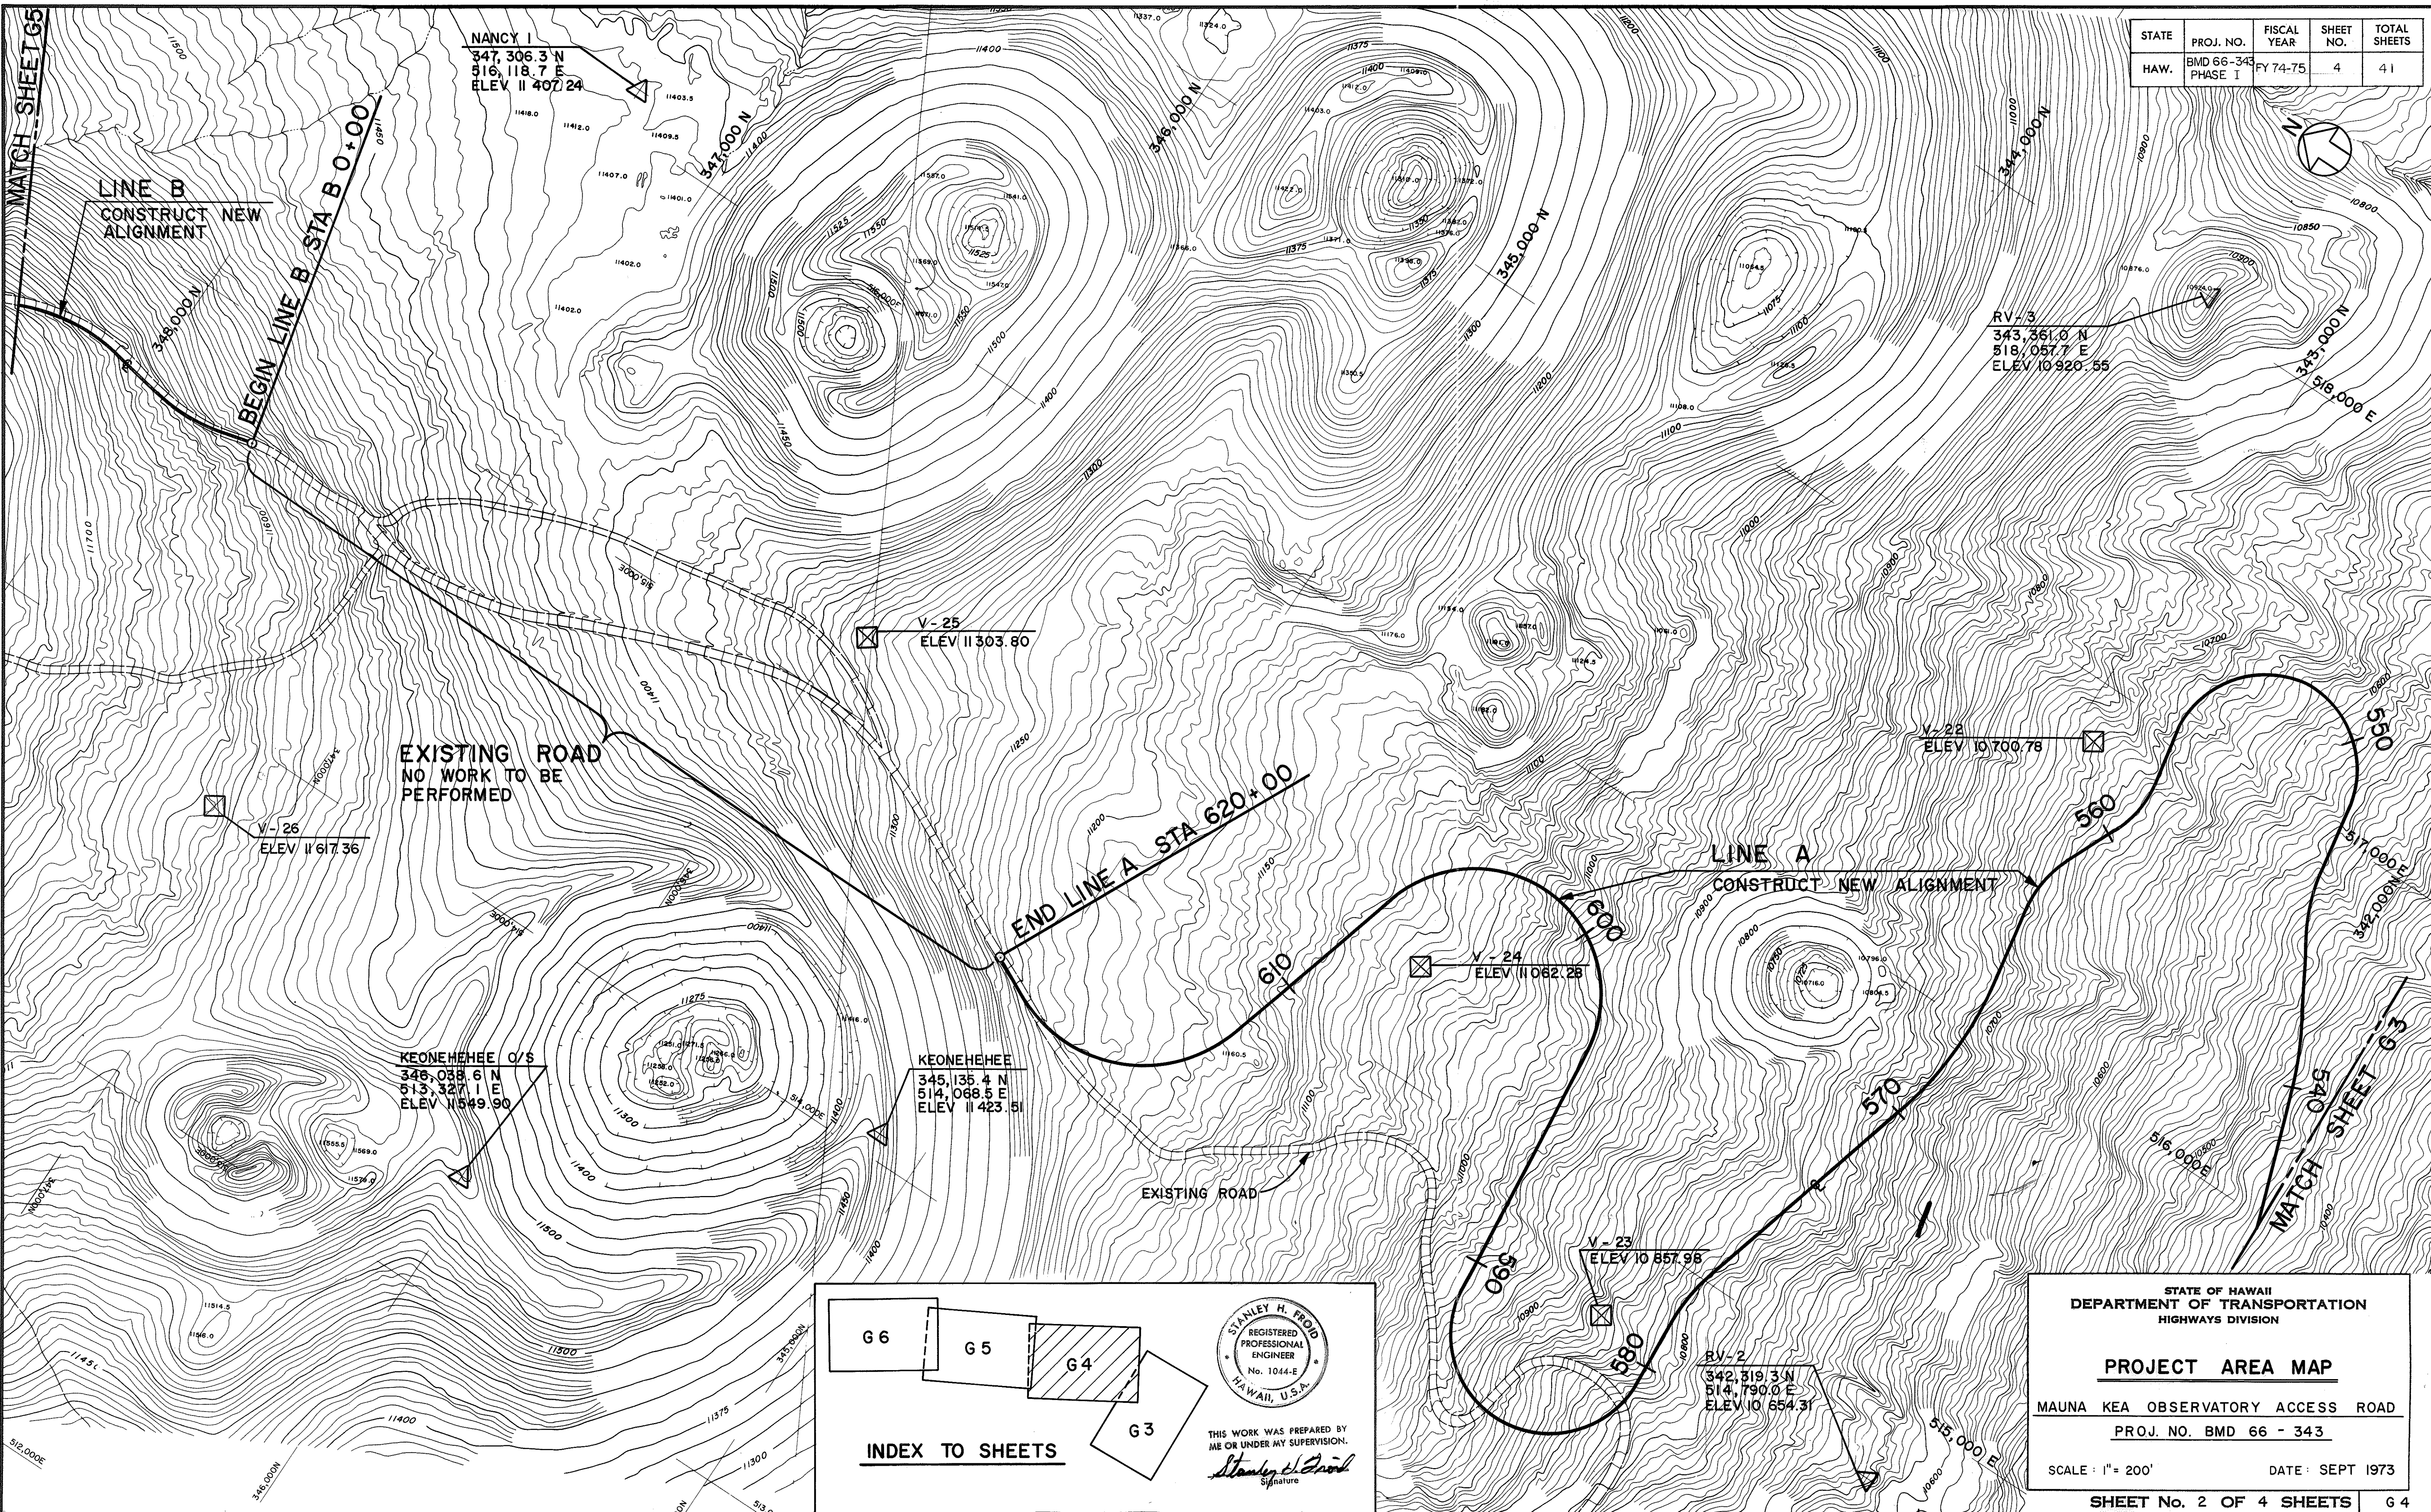

ORIGINAL PLAN	SURVEY PLOTTED BY	DATE
NOTE BOOK	DRAWN BY	
	DESIGNED BY	
	QUANTITIES BY	
	CHECKED BY	

INDEX TO SHEETS

THIS WORK WAS PREPARED BY ME OR UNDER MY SUPERVISION.

Stanley H. Frod

STATE OF HAWAII
DEPARTMENT OF TRANSPORTATION
HIGHWAYS DIVISION

PROJECT AREA MAP


MAUNA KEA OBSERVATORY ACCESS ROAD

PROJ. NO. BMD 66 - 343

SCALE: 1" = 200' DATE: SEPT 1973


SHEET No. 2 OF 4 SHEETS G 4

STATE	PROJ. NO.	FISCAL YEAR	SHEET NO.	TOTAL SHEETS
HAW.	BMD66-343 PHASE I	FY 74-75	5	41

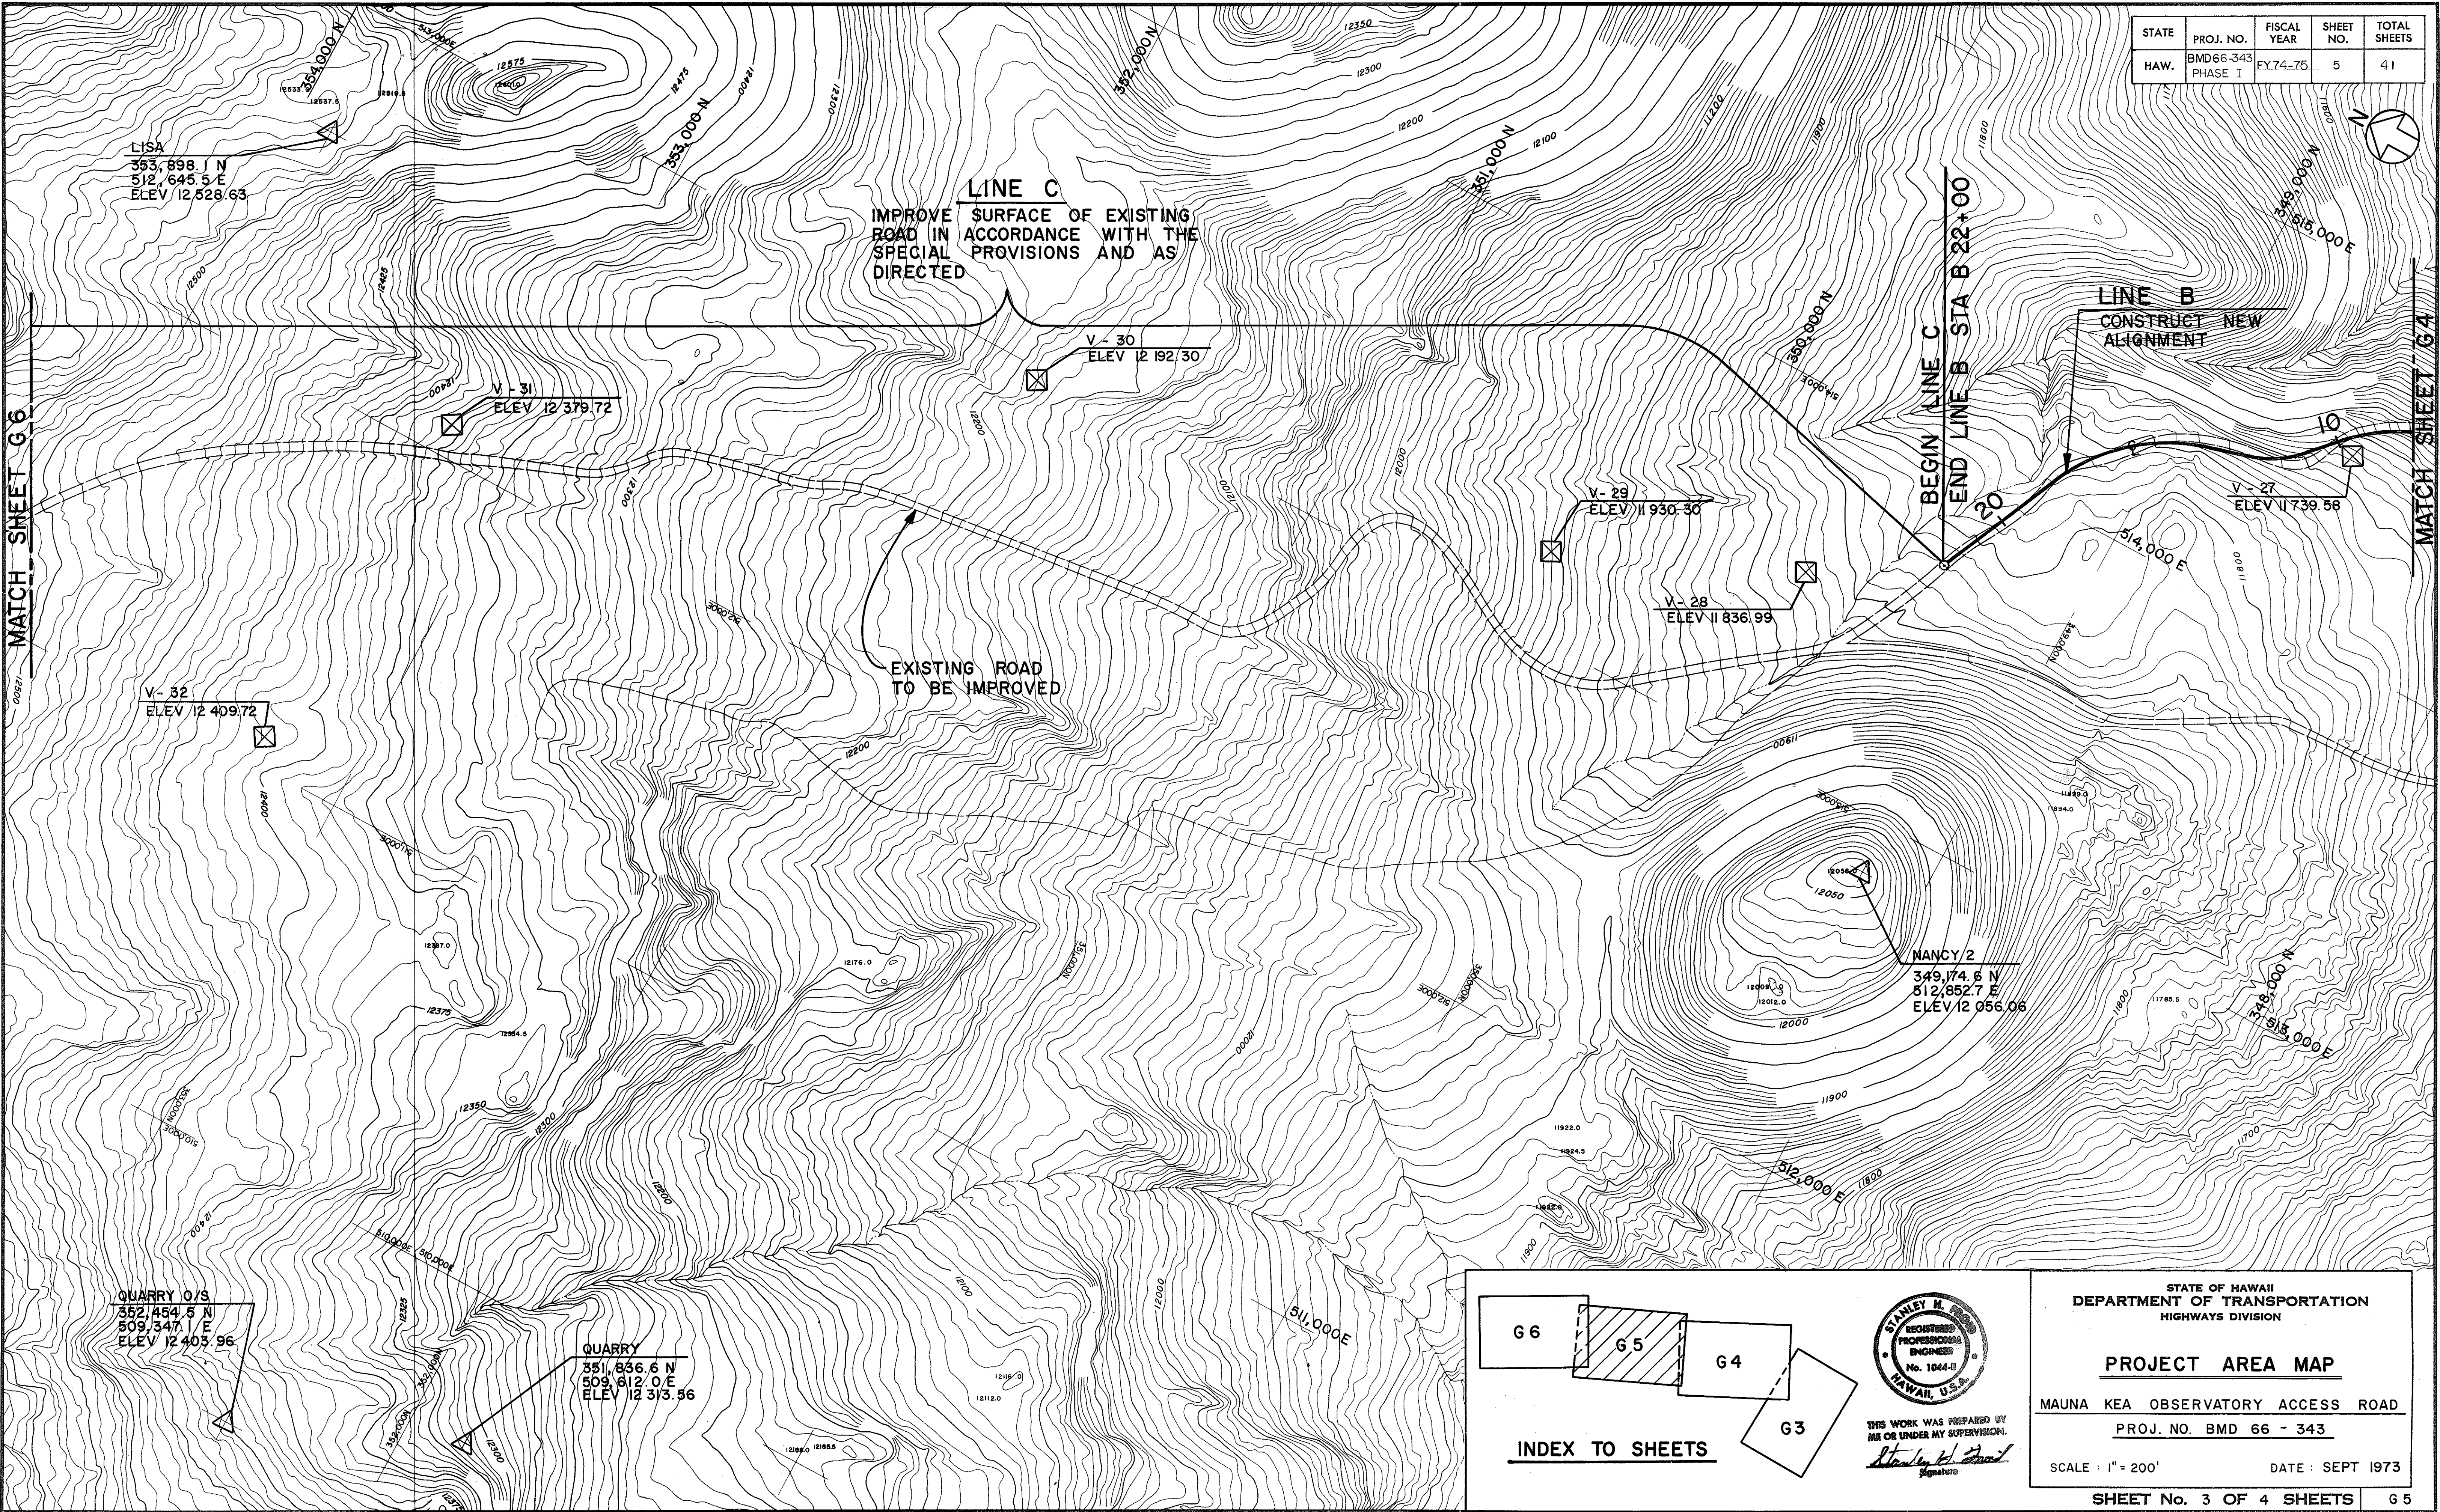

ORIGINAL PLAN	DATE
SURVEY PLOTTED BY	
DRAWN BY	
DESIGNED BY	
QUANTITIES BY	
CHECKED BY	

STATE	PROJ. NO.	FISCAL YEAR	SHEET NO.	TOTAL SHEETS
HAW.	BMD66-343 PHASE I	FY74-75	6	41

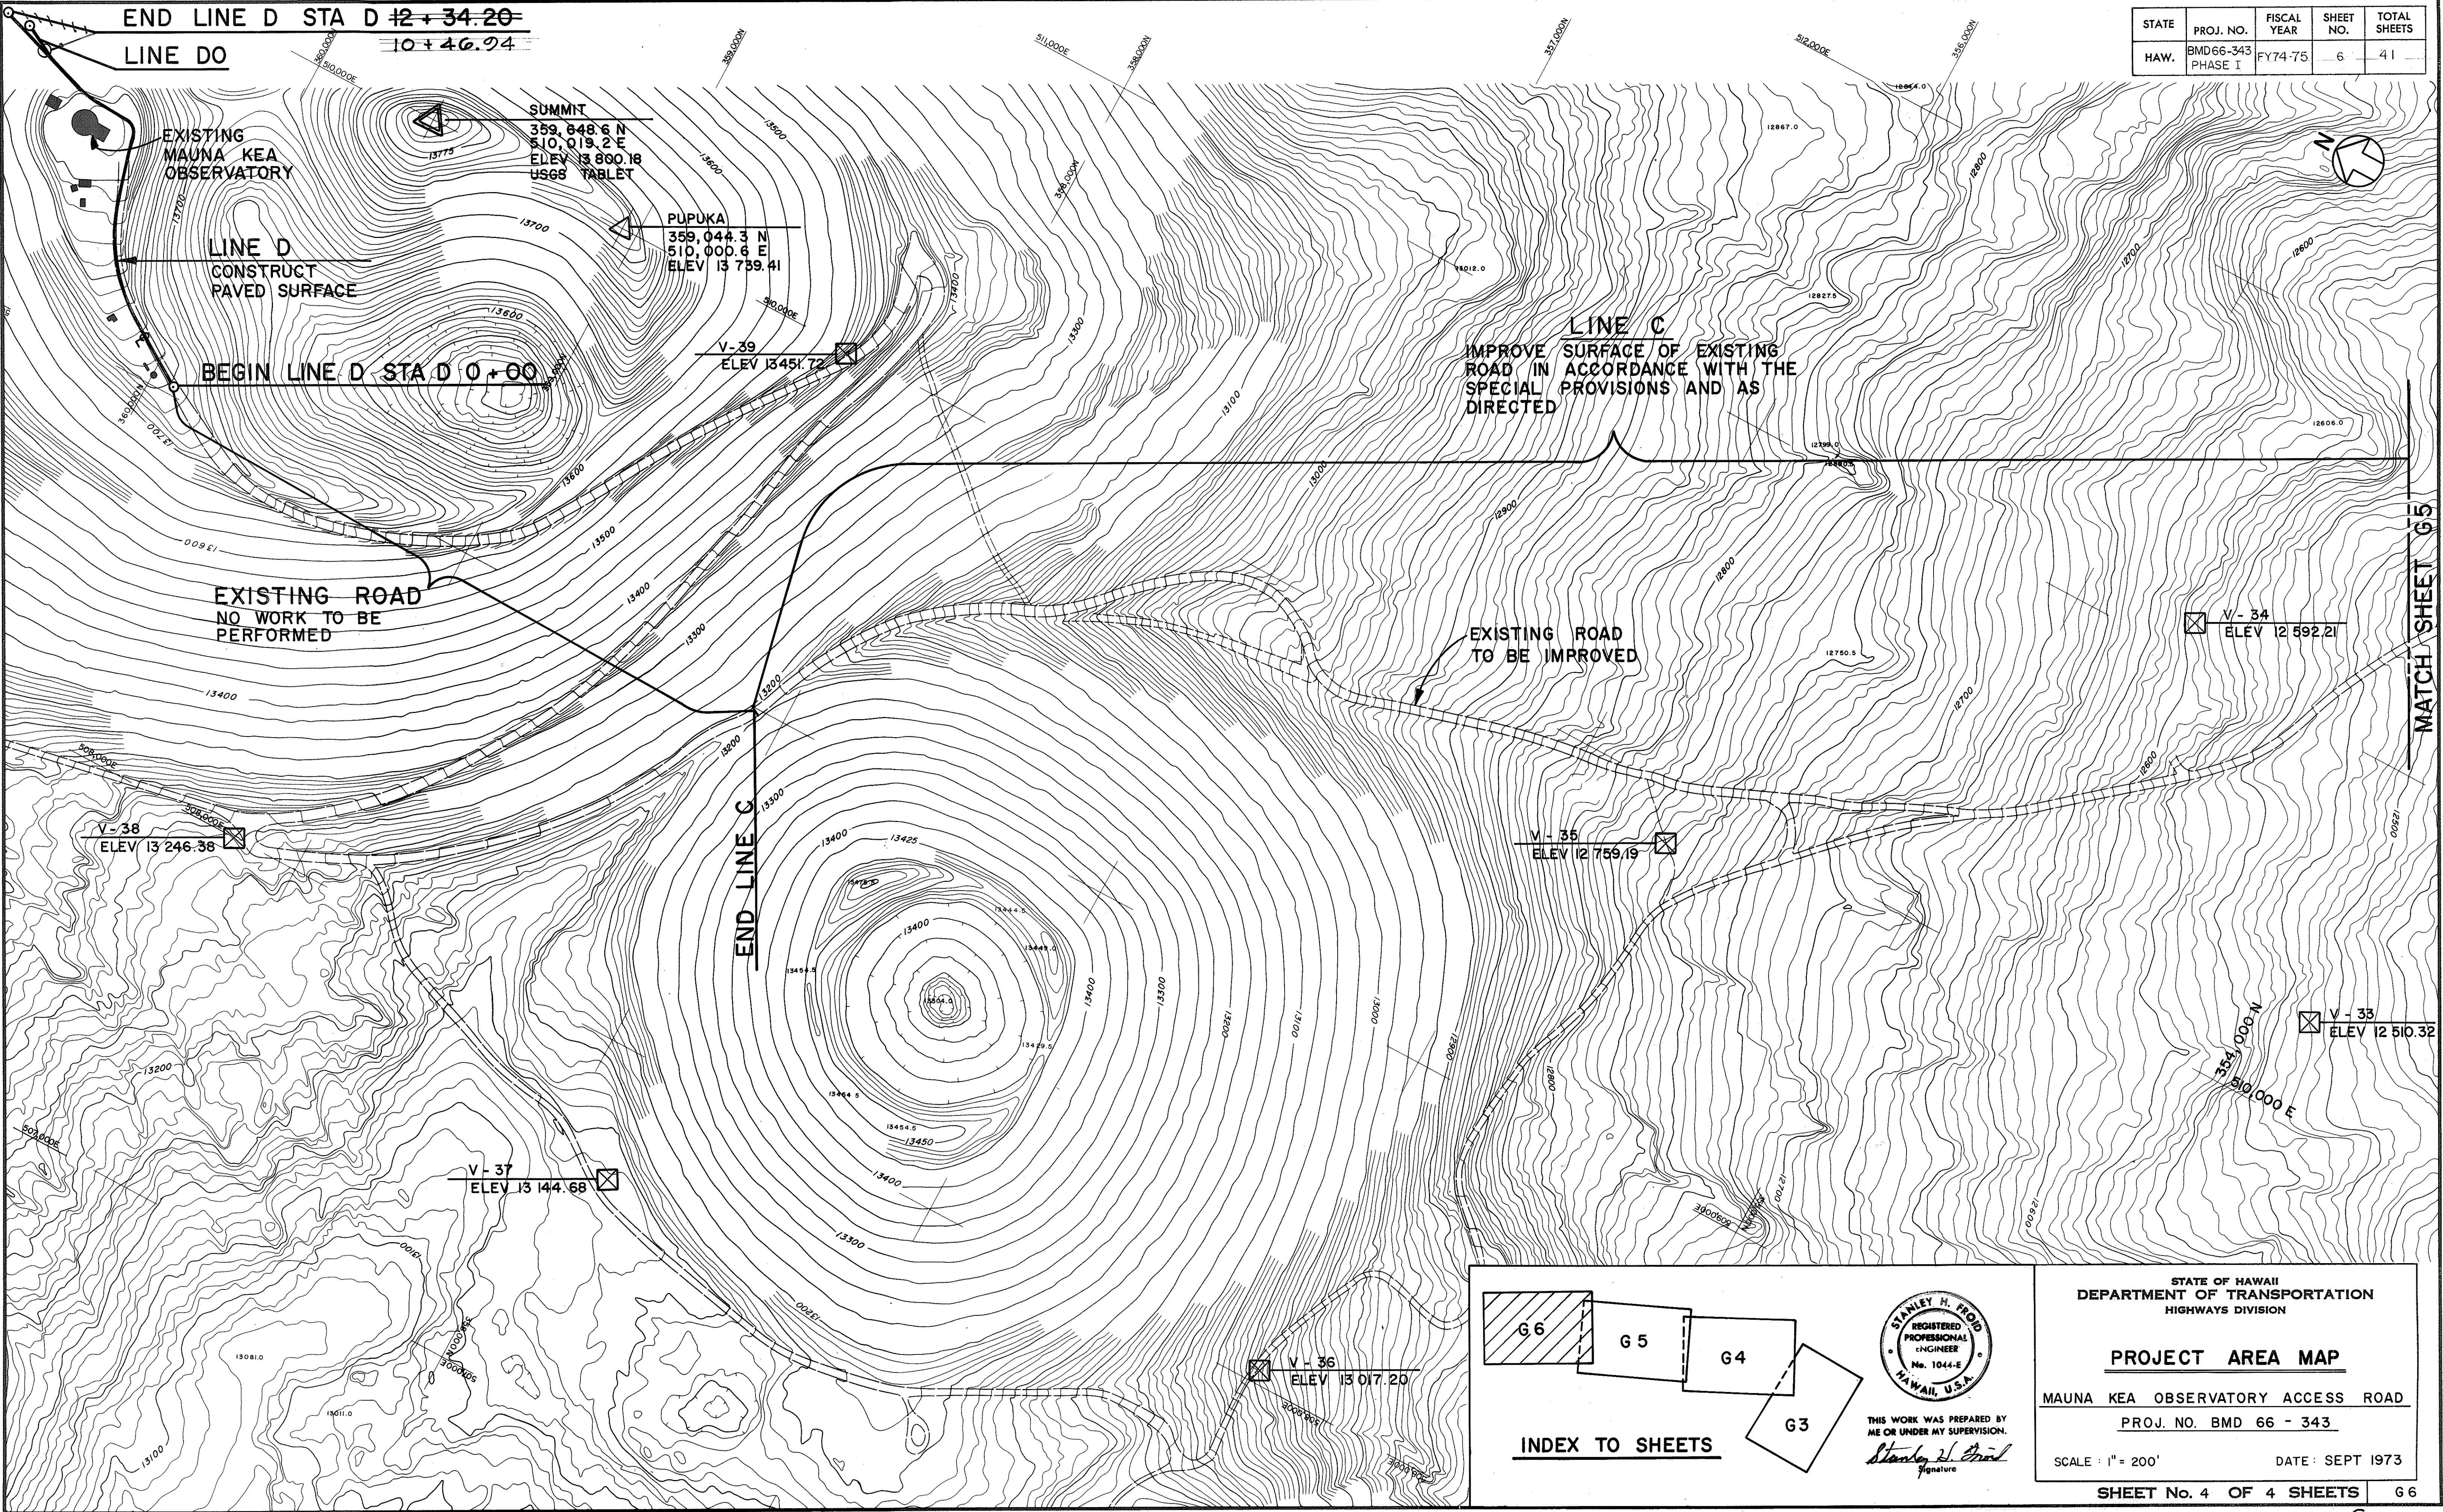

ORIGINAL PLAN	DATE
DRAWN BY	
TRACED BY	
NOTED BY	
CHECKED BY	
No.	