



STATE	PROJ. NO.	FISCAL YEAR	SHEET NO.	TOTAL SHEETS
HAW.	BMD 66-343 PHASE I	FY74-75	30	41

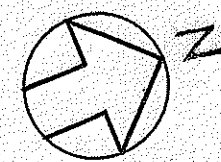



NOTES

- Topographic and layout control data are taken from the map "Topography of Quarry Site near Pohakuloa, Island of Hawaii, July 1972" prepared by the Highways Division.
- Natural material to be used for mineral aggregate shall be removed from the area designated as Quarry Site. See Section 106.02 of the Special Provisions.
- No excavation shall be allowed outside the Quarry Site except as approved by the Engineer.
- No disturbance of the natural terrain shall be allowed outside the Limits of Operations.

This Sheet "DELETED".

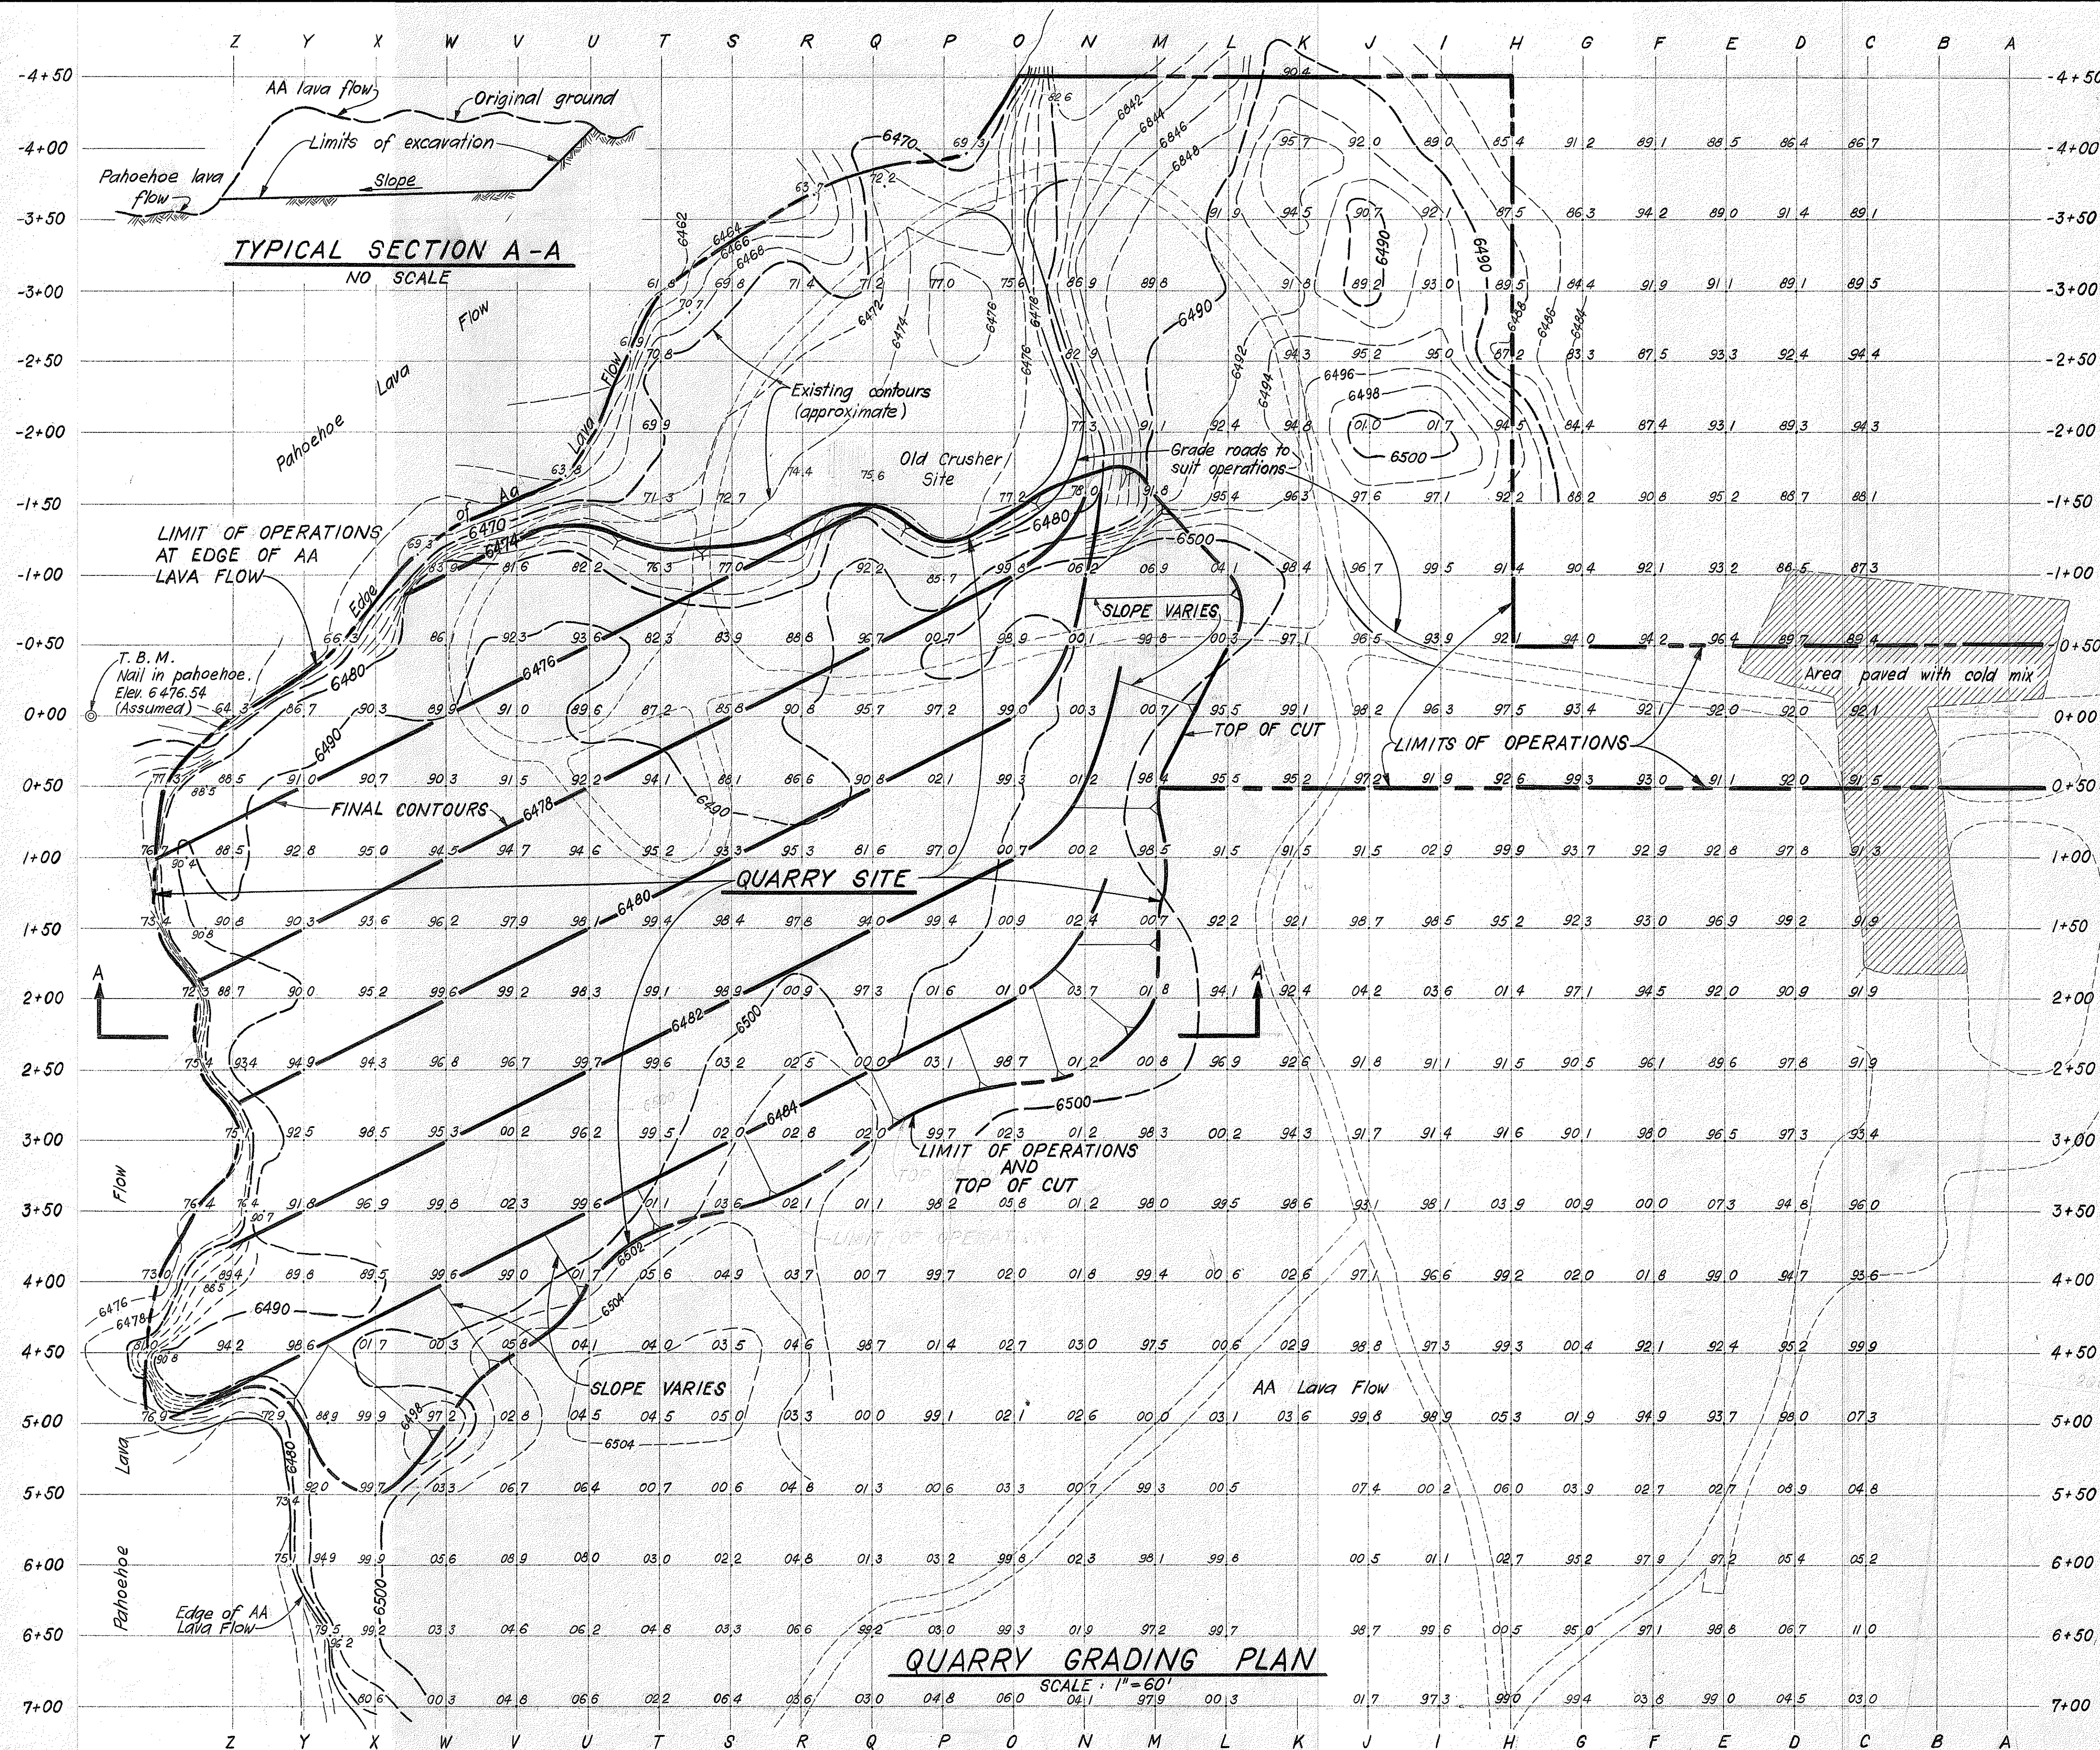

T.B.M. Elevation Datum
Spoke in telephone pole.
Elev. 6500 (Assumed)

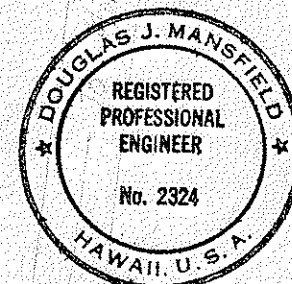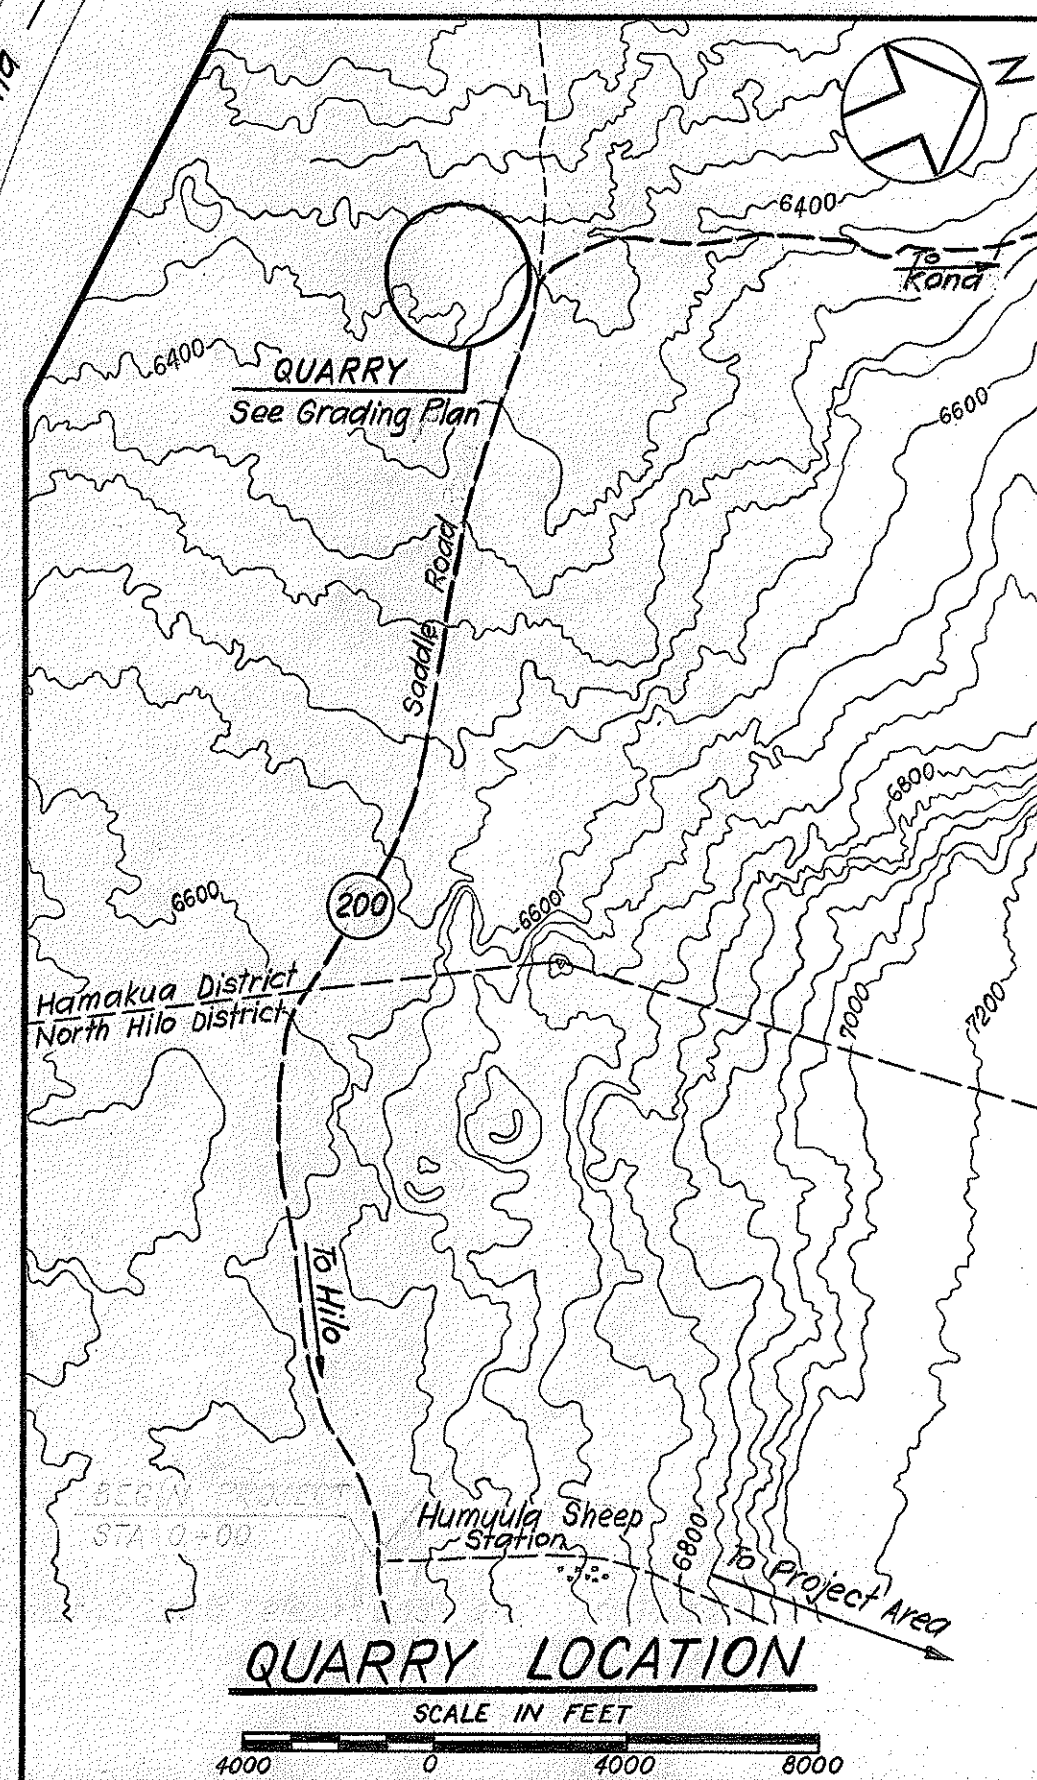

This work was prepared by me or under my supervision.
D. Mansfield

STATE OF HAWAII
DEPARTMENT OF TRANSPORTATION
HIGHWAYS DIVISION

**QUARRY LOCATION AND
GRADING PLAN**

MAUNA KEA OBSERVATORY ACCESS ROAD
PROJ. NO. BMD 66 - 343

SCALE: AS NOTED DATE: SEPT 1973

SHEET No. 1 OF 1 SHEETS C 801

DATE	
ORIGINAL PLAN	
DRAWN BY	
TRACED BY	
CHECKED BY	
NOTE BOOK	
CHECKED BY	