

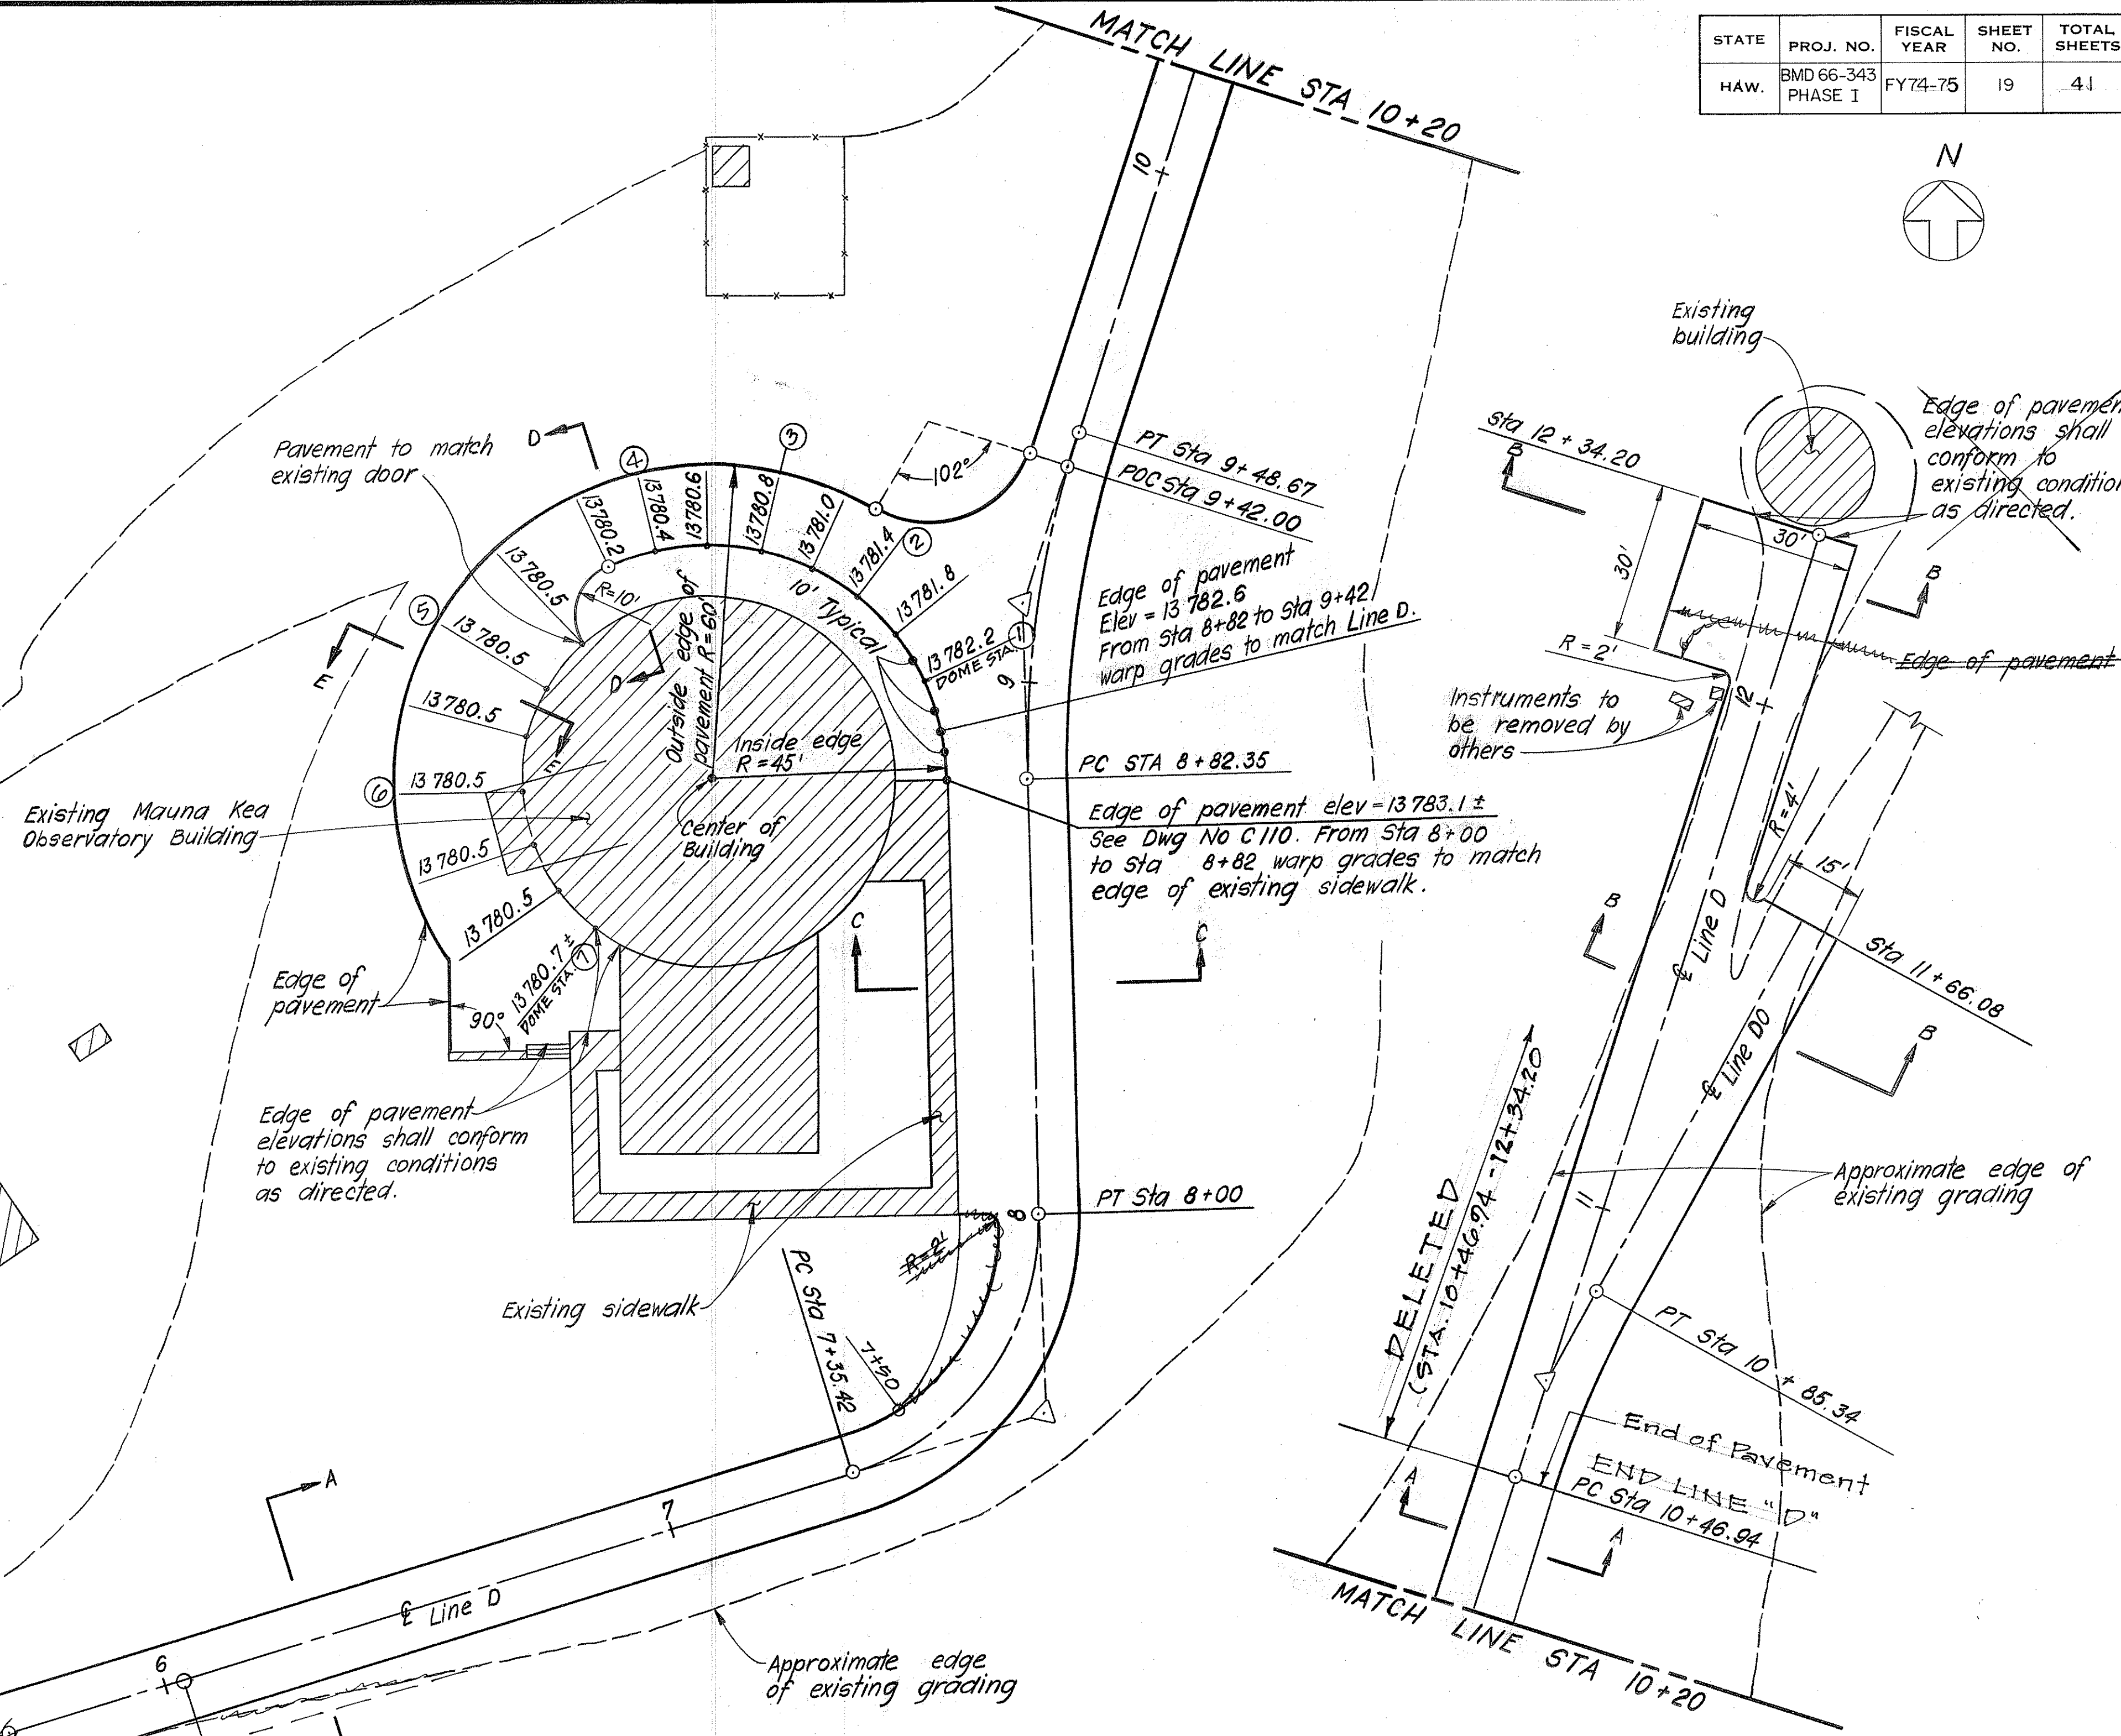


STATE	PROJ. NO.	FISCAL YEAR	SHEET NO.	TOTAL SHEETS
HAW.	BMD 66-343 PHASE I	FY 74-75	19	41

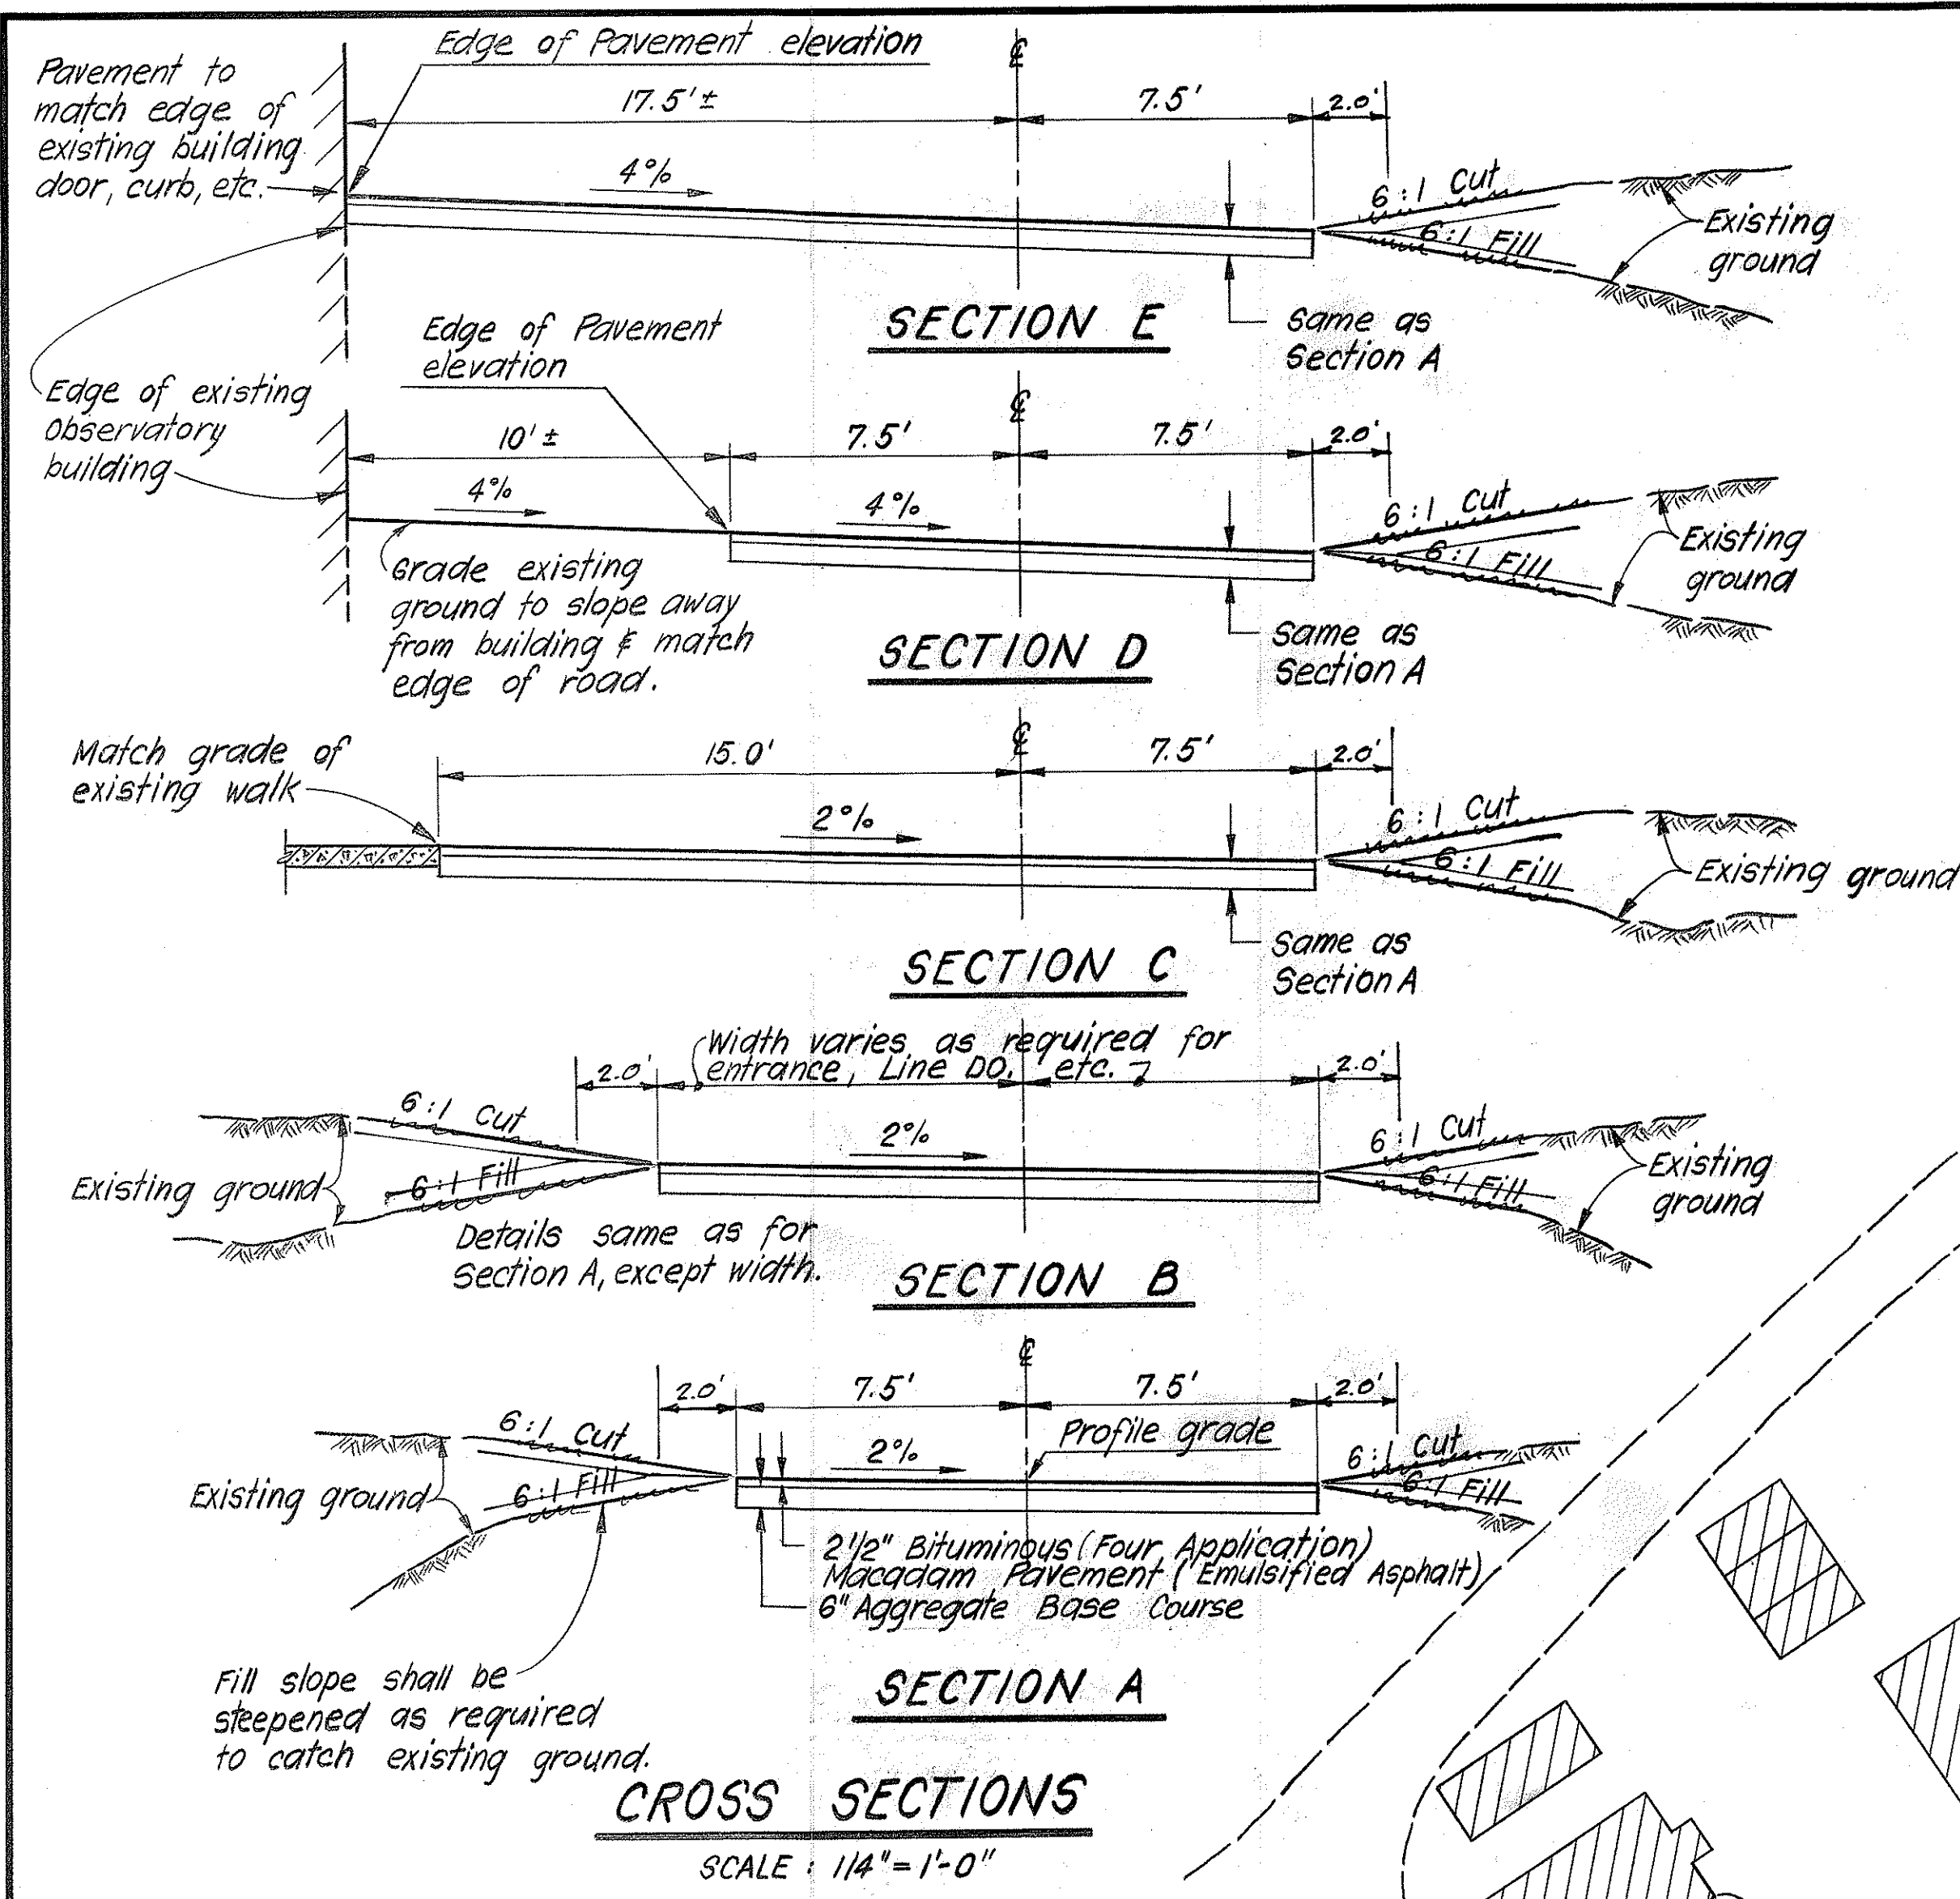

- NOTES**
1. Indicates existing facilities
 2. For geometry & layout control of Line D and Line DO see Dwg No C 110.

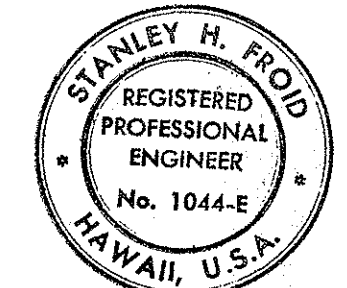

THIS WORK WAS PREPARED BY ME OR UNDER MY SUPERVISION.
Stanley H. Frod
Signature

STATE OF HAWAII
DEPARTMENT OF TRANSPORTATION
HIGHWAYS DIVISION

SITE PLAN
MAUNA KEA SUMMIT AREA
MAUNA KEA OBSERVATORY ACCESS ROAD
PROJ. NO. BMD 66 - 343

SCALE: AS NOTED
DATE: SEPT 1973

SHEET NO. 1 OF 1 SHEETS C 202

DATE	_____
SURVEY PLOTTED BY	_____
DRAWN BY	_____
TRACED BY	_____
DESIGNED BY	_____
QUANTITIES BY	_____
CHECKED BY	_____
NO.	_____