


STATE	PROJ. NO.	FISCAL YEAR	SHEET NO.	TOTAL SHEETS
HAW.	BMD66-343	FY 71-72	26	88

PLAN	DATE	BY
SURVEYED		
PLOTTED		
NOTE BOOK		
NO.		


PROFILE	DATE	BY
SURVEYED		
PLOTTED		
NOTE BOOK		
NO.		

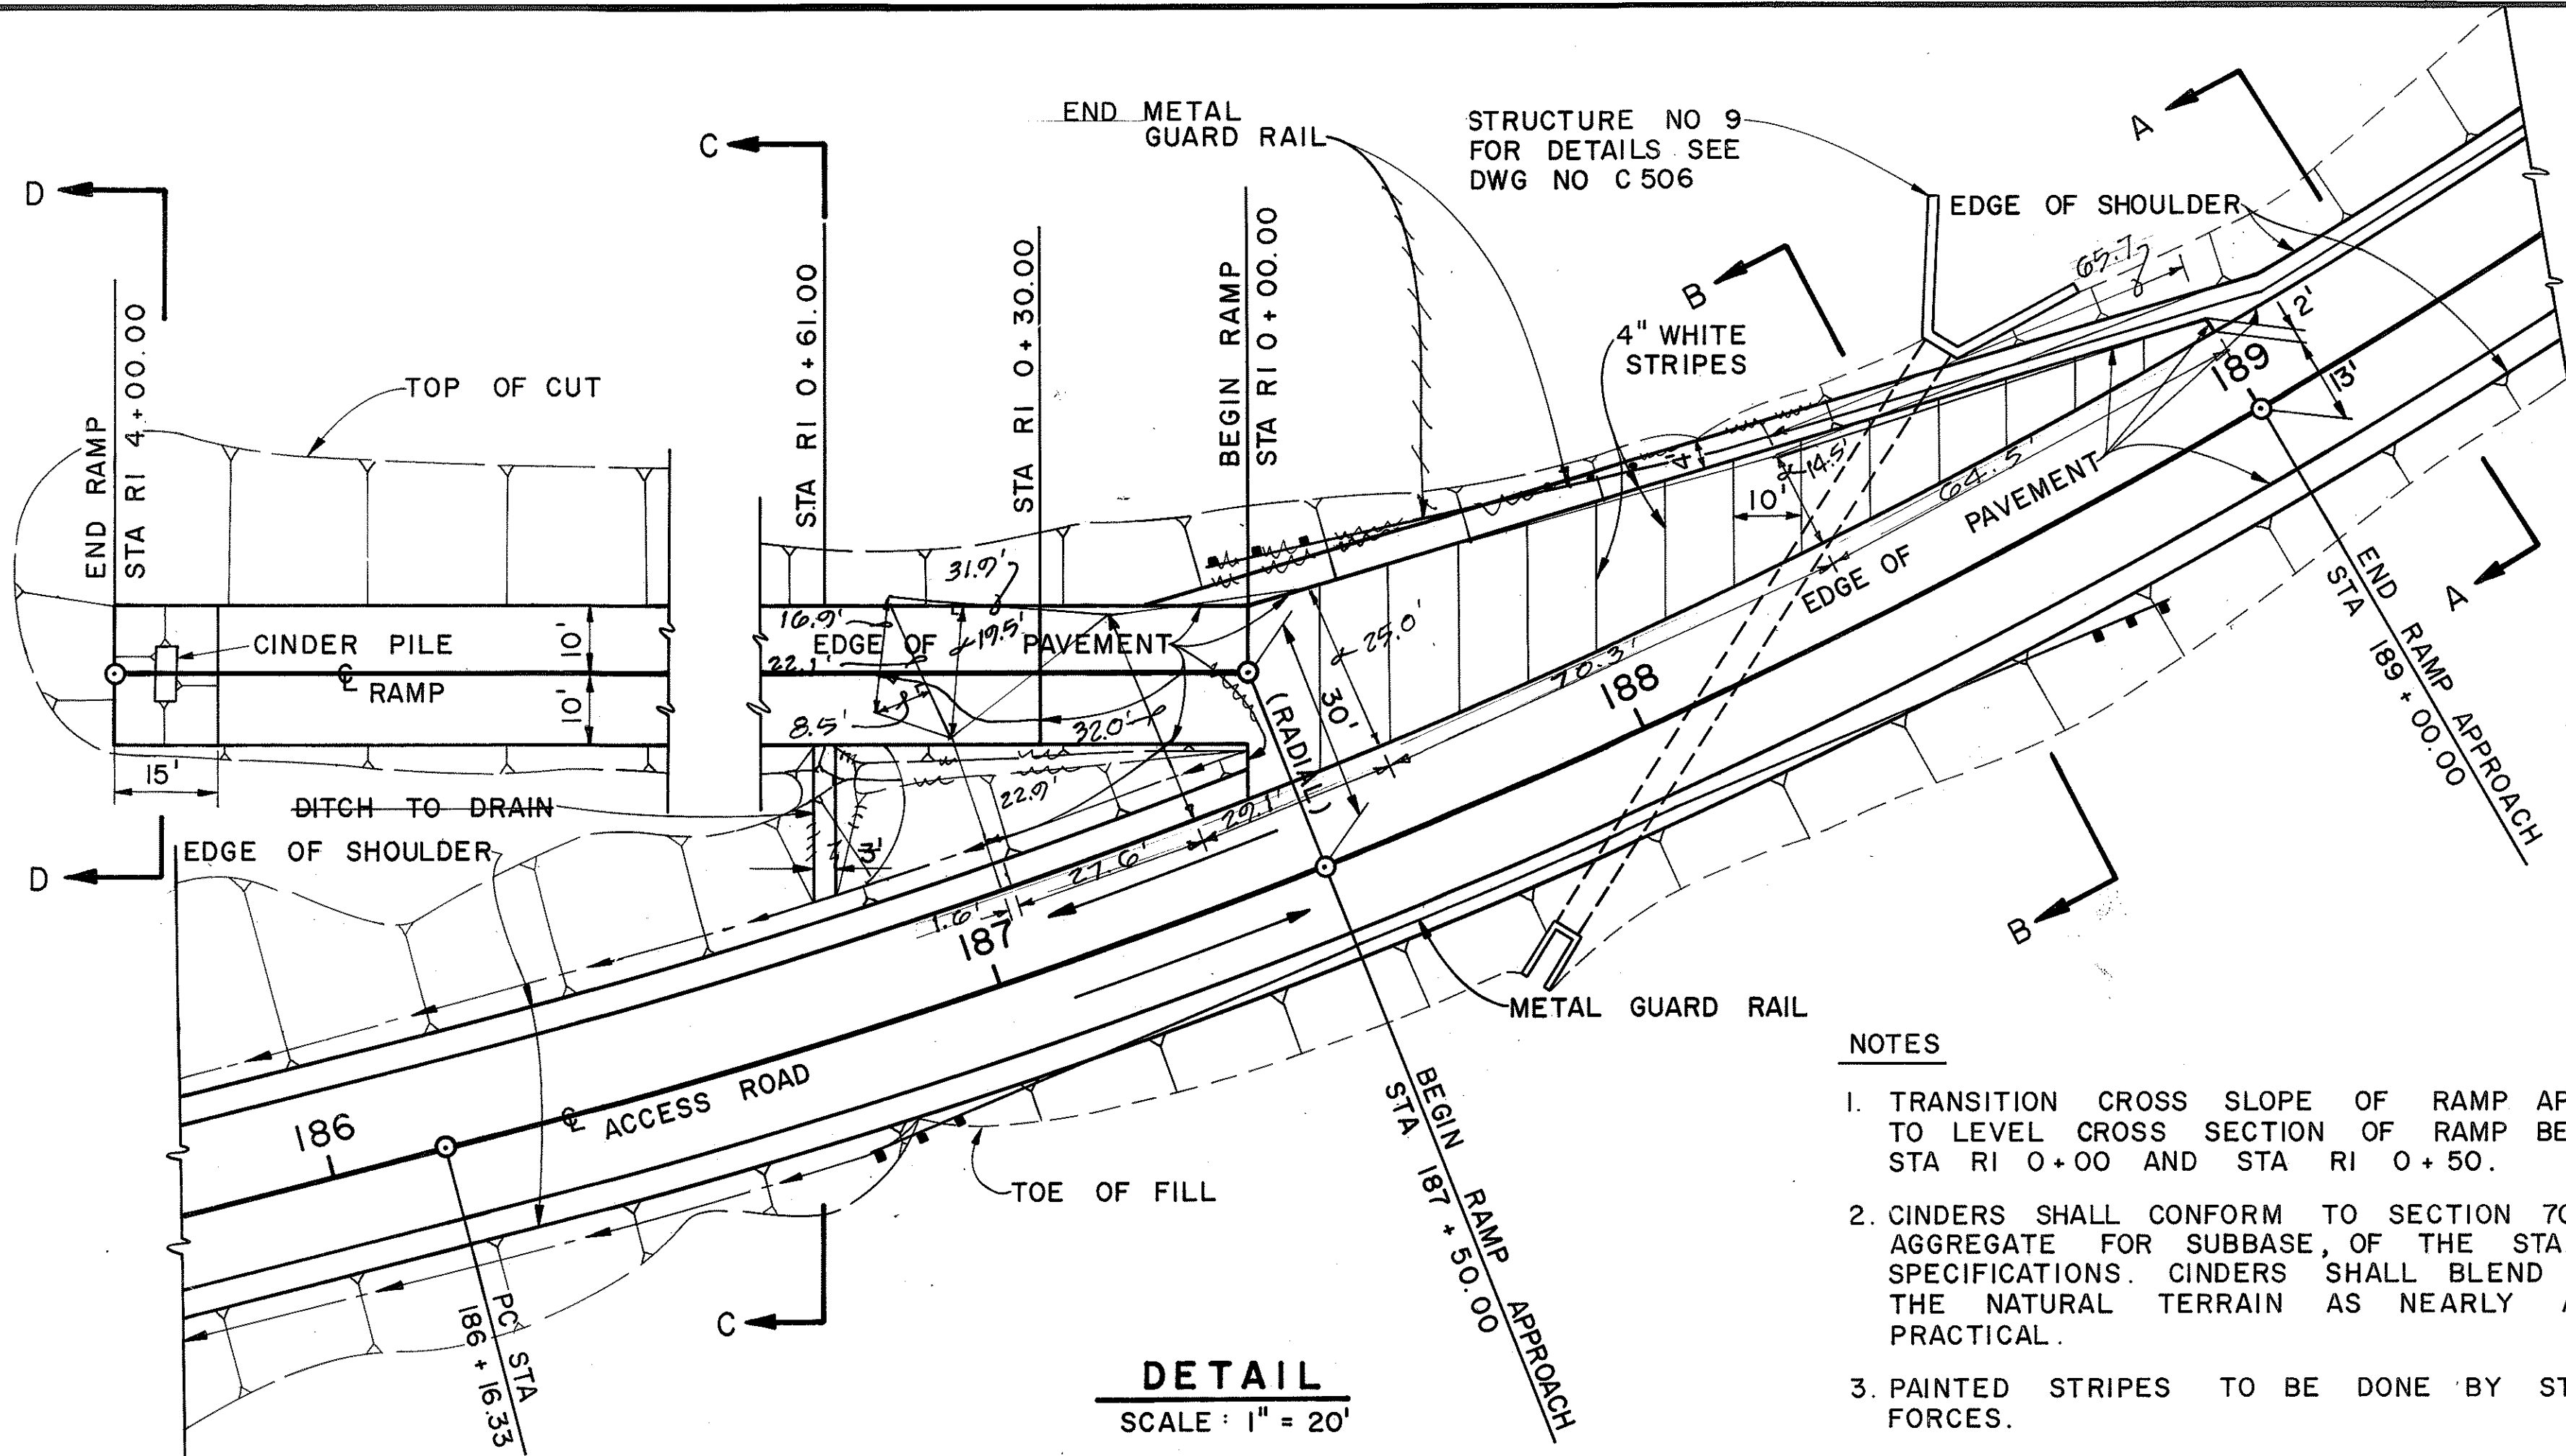


DETAIL
SCALE: 1" = 20'

NOTES


1. TRANSITION CROSS SLOPE OF RAMP APPROACH TO LEVEL CROSS SECTION OF RAMP BETWEEN STA RI 0+00 AND STA RI 0+50.
2. CINDERS SHALL CONFORM TO SECTION 703.17, AGGREGATE FOR SUBBASE, OF THE STANDARD SPECIFICATIONS. CINDERS SHALL BLEND WITH THE NATURAL TERRAIN AS NEARLY AS PRACTICAL.
3. PAINTED STRIPES TO BE DONE BY STATE FORCES.

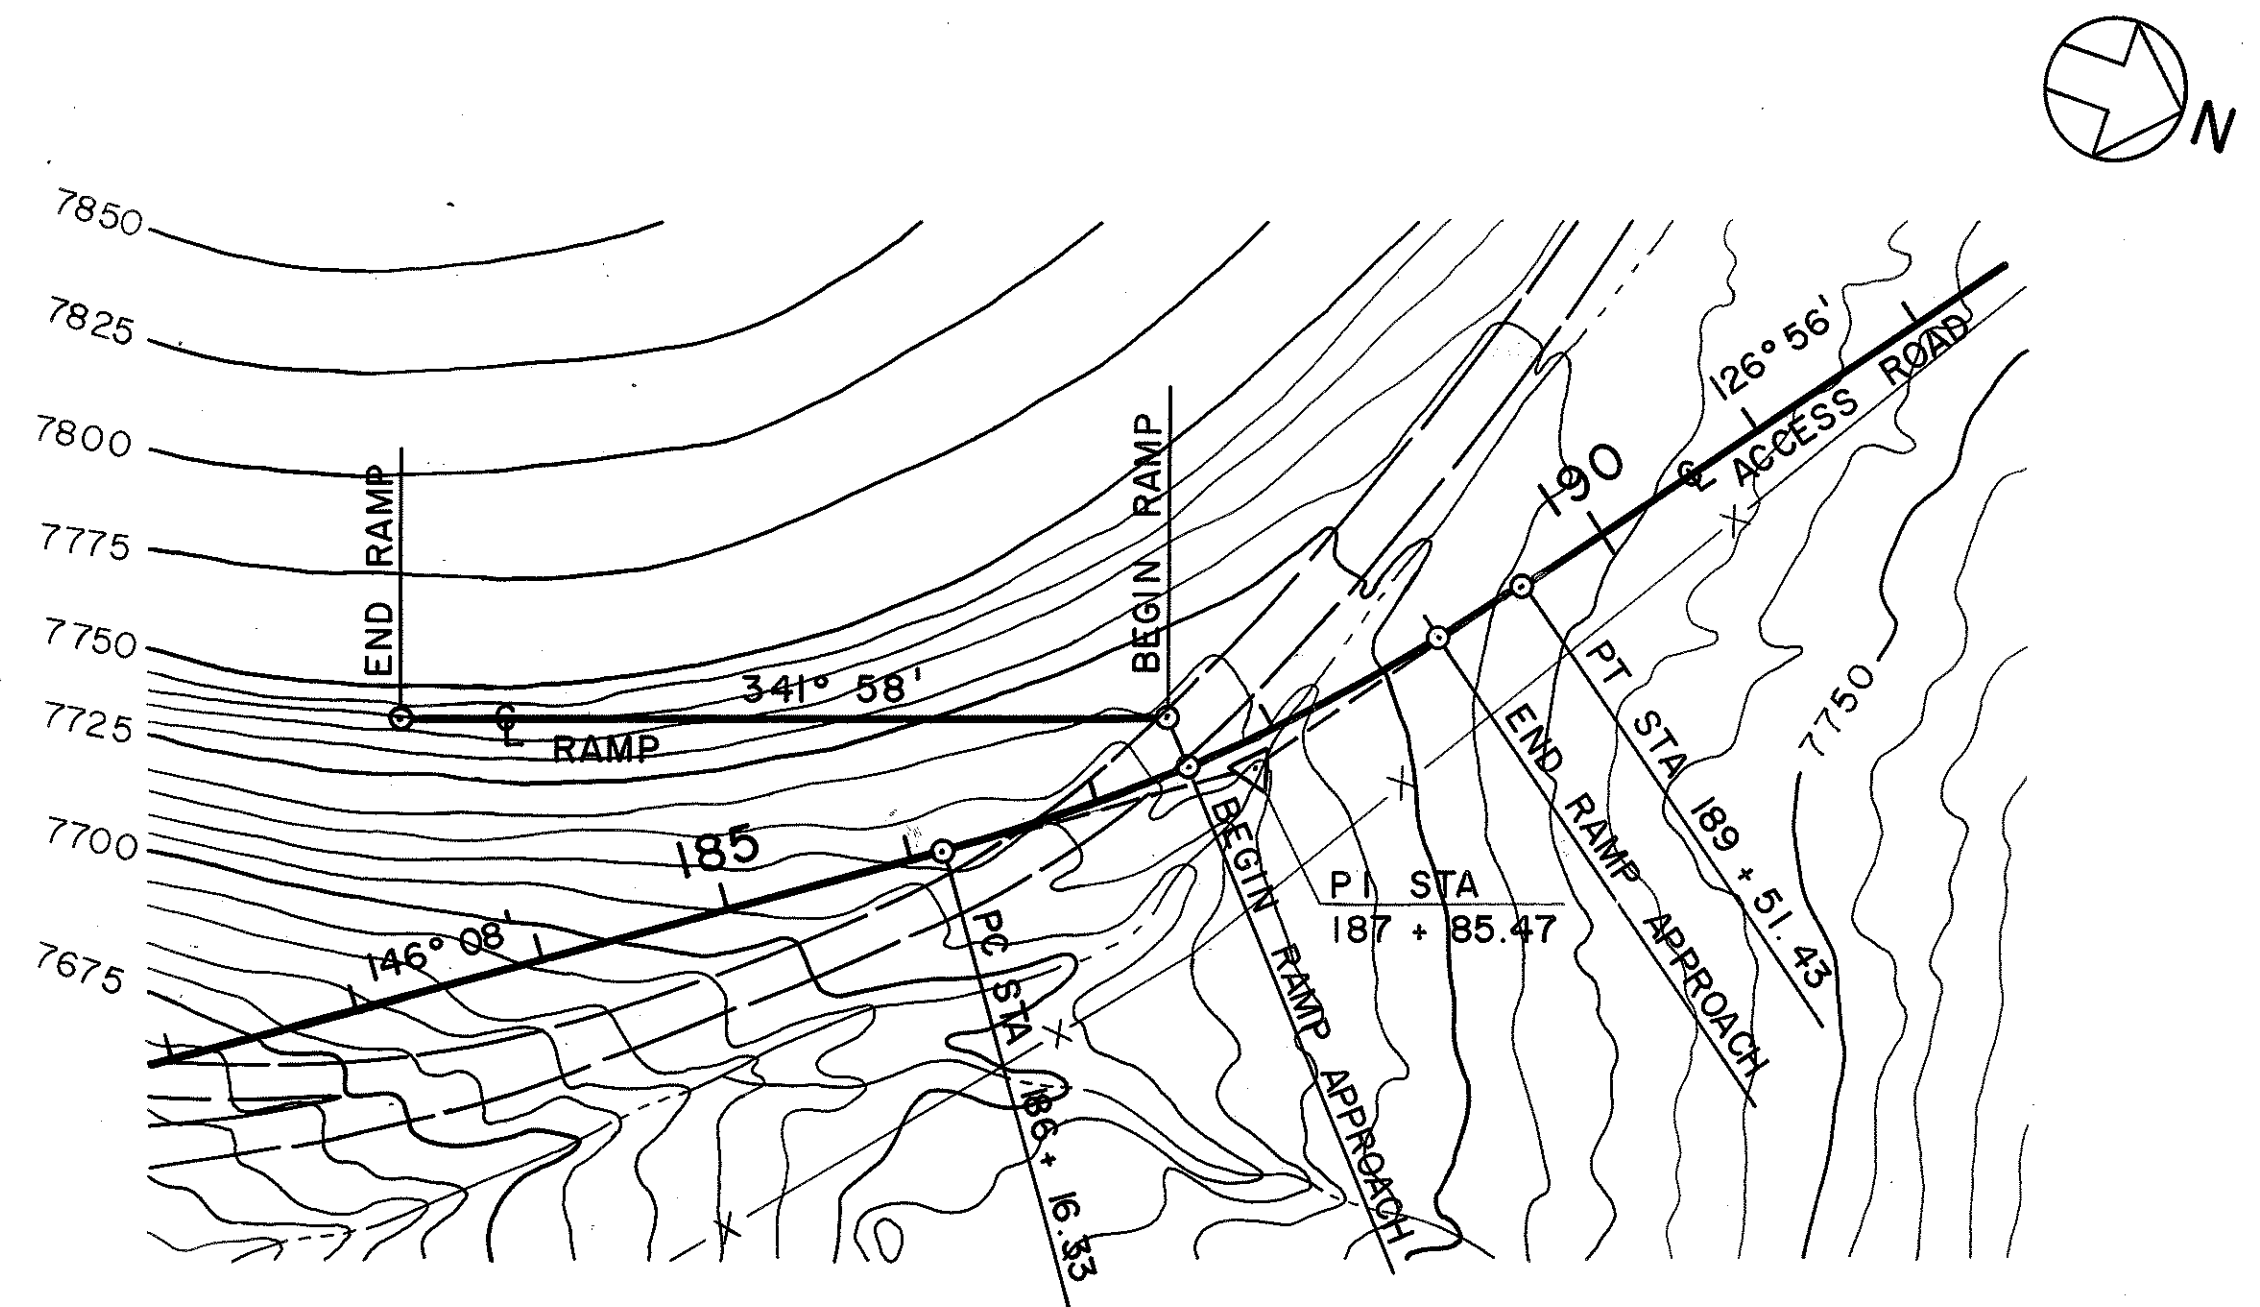


PLAN
SCALE: 1" = 100'

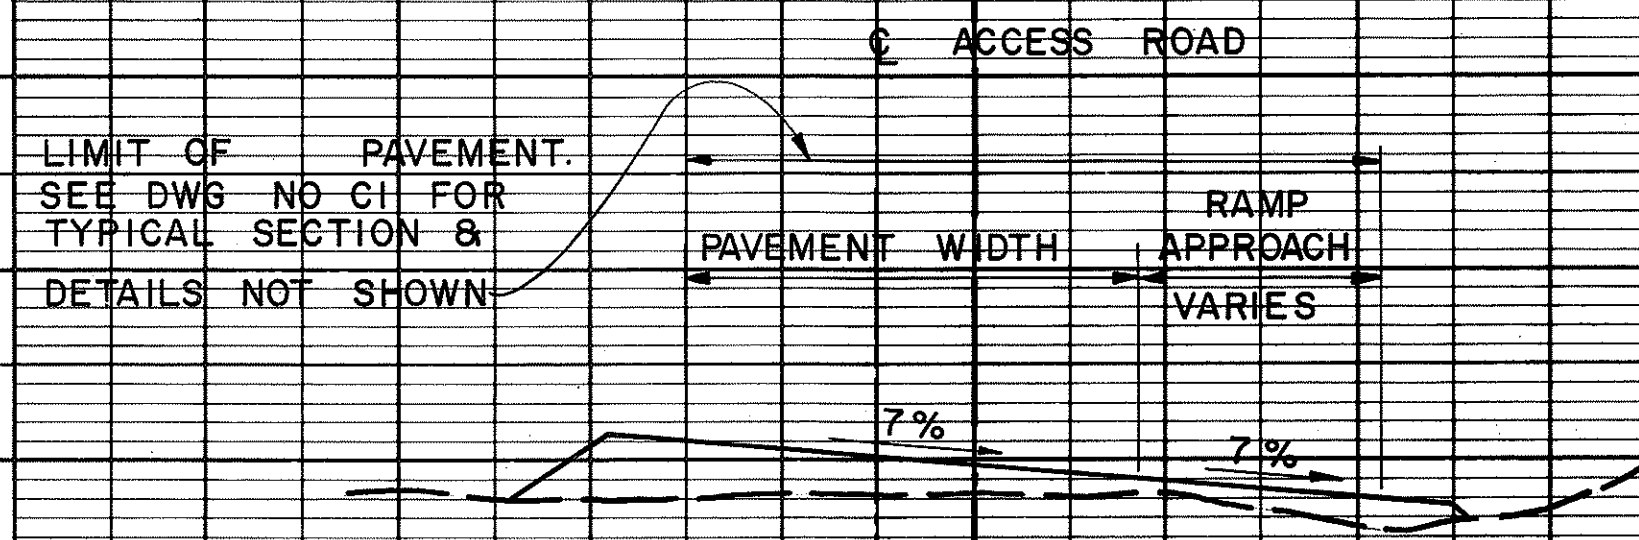


SECTION B
SCALE: 1" = 10'

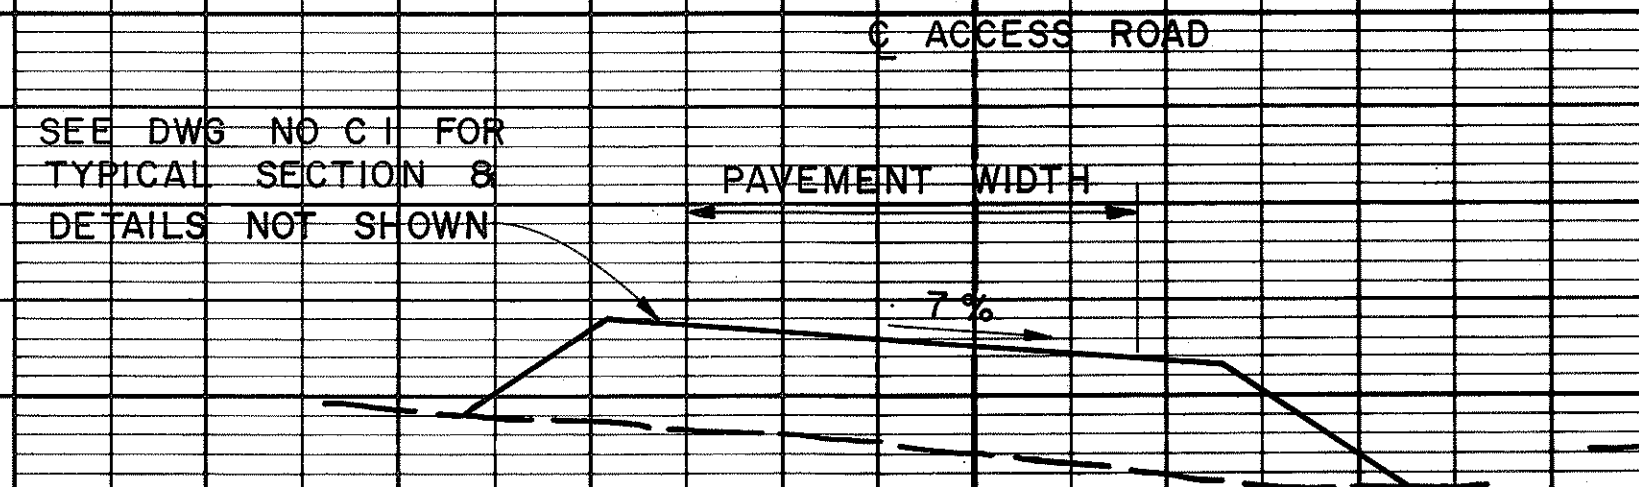


SECTION A
SCALE: 1" = 10'

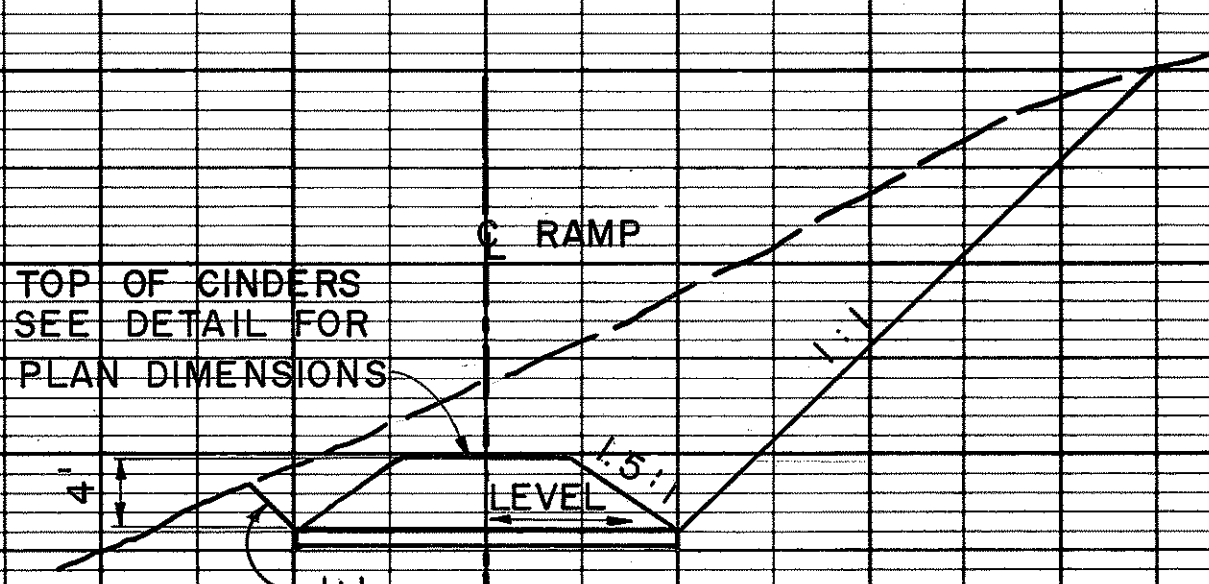


SECTION D
SCALE: 1" = 10'

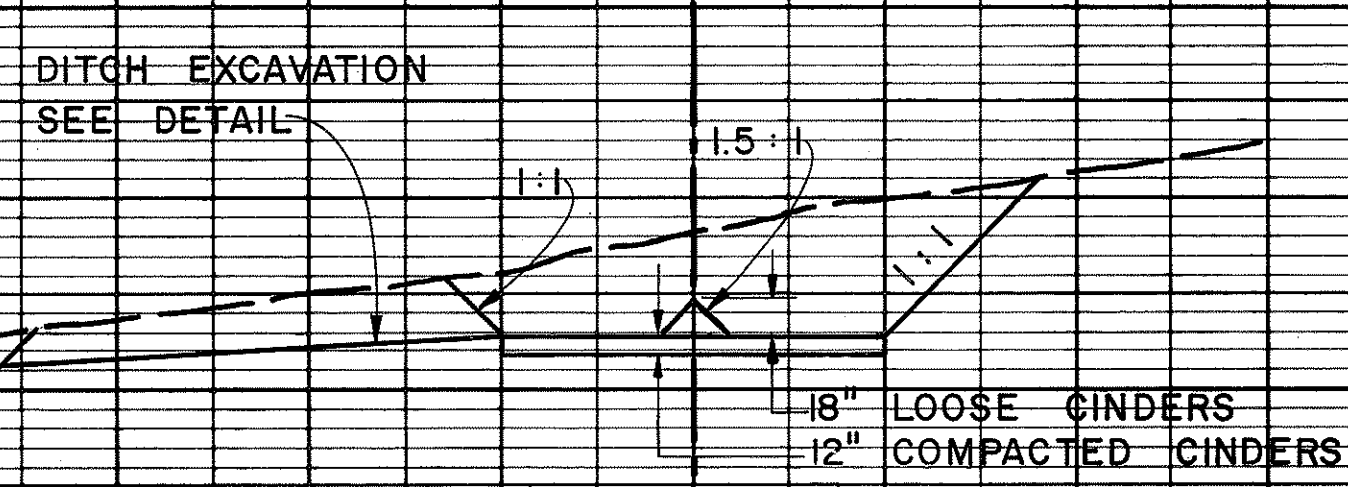

SECTION C
SCALE: 1" = 10'

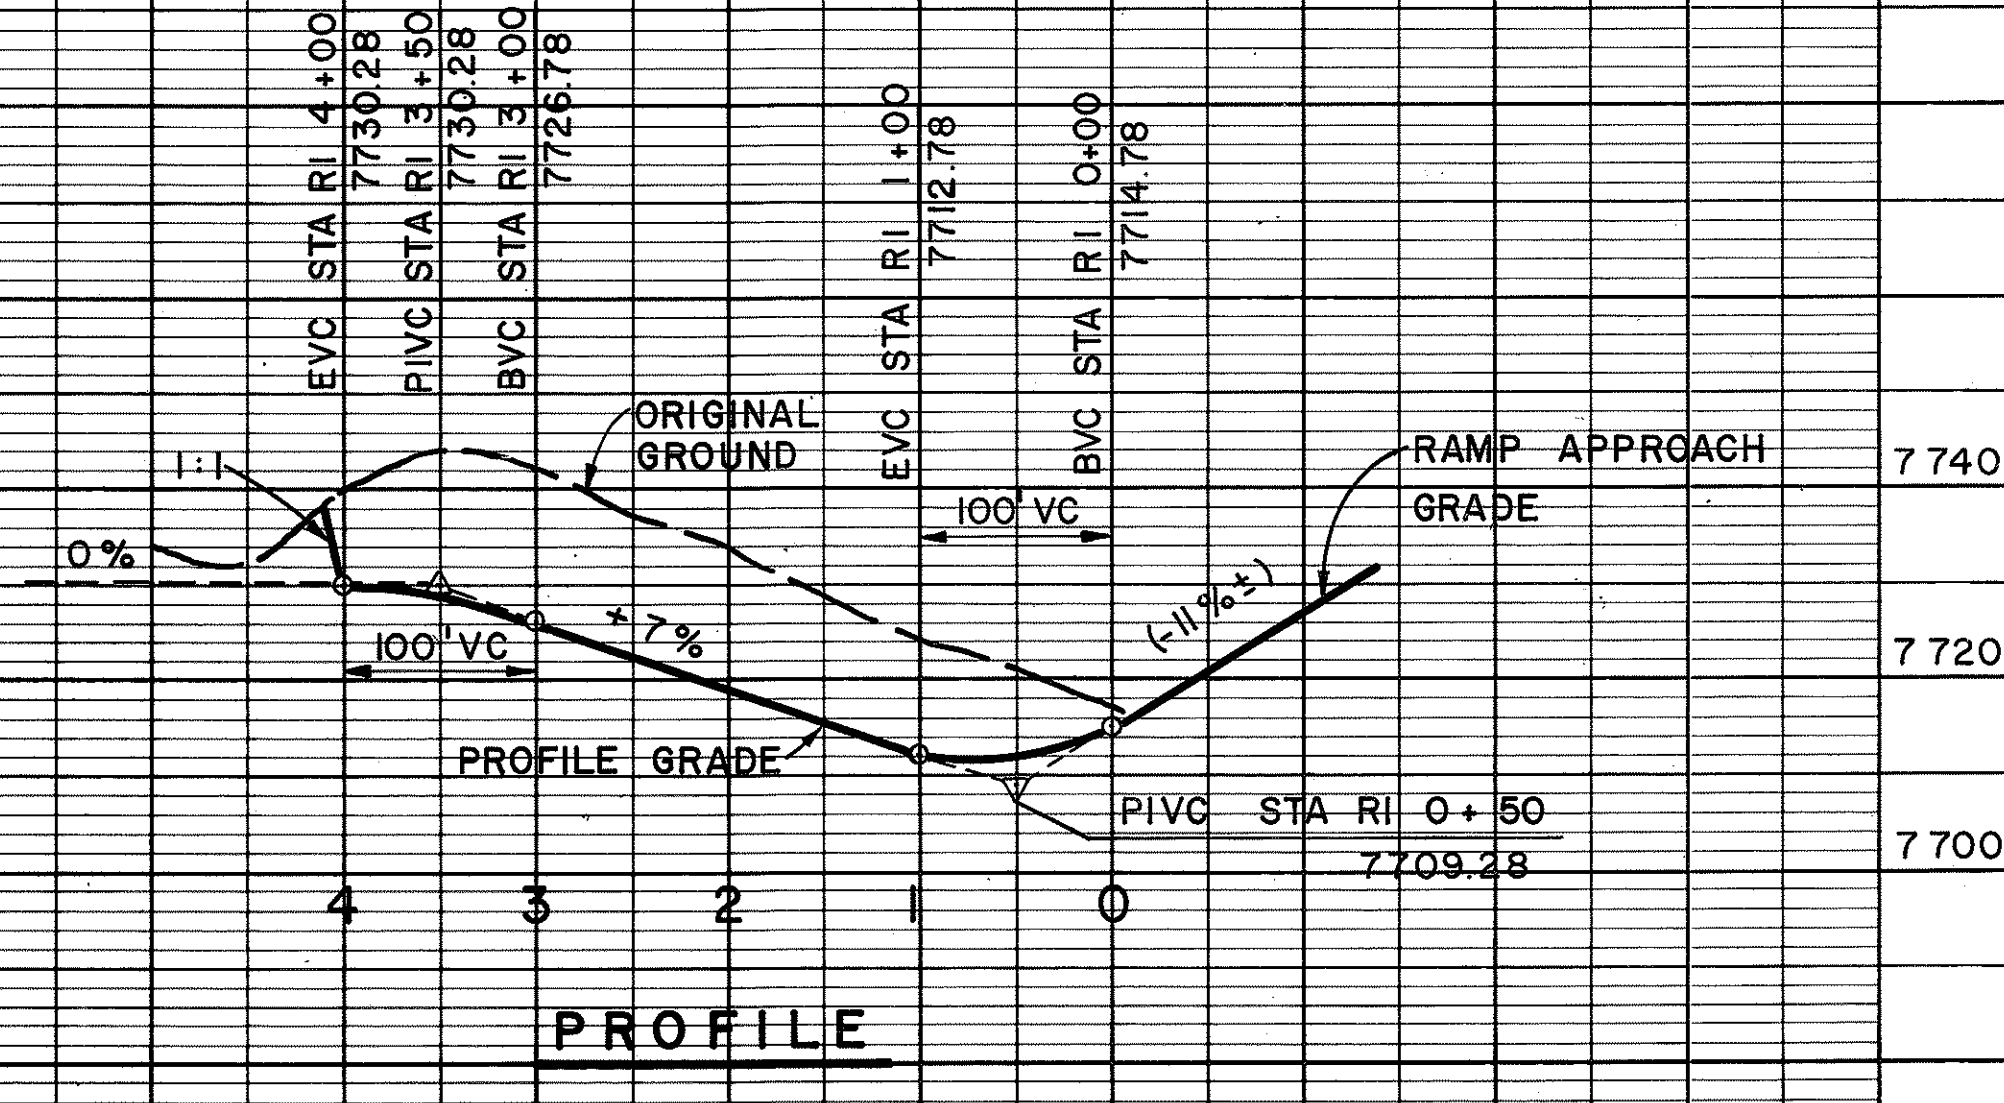

PROFILE

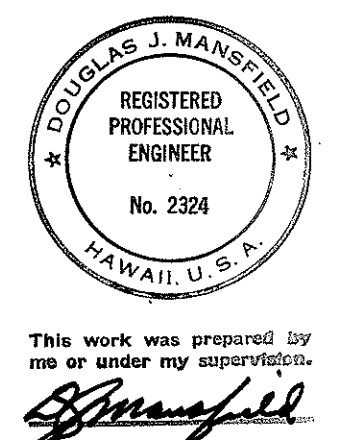

STATE OF HAWAII
DEPARTMENT OF TRANSPORTATION
HIGHWAYS DIVISION

RUNAWAY TRUCK RAMP NO 1

MAUNA KEA OBSERVATORY ACCESS ROAD
PROJ. NO. BMD 66 - 343

SCALE: AS NOTED
REVISED: SEP. 1972
DATE: MARCH 1972

SHEET No. 1 OF 1 SHEETS C221