


FINAL SURVEY
NOTE BOOK NO. _____
DATE _____
BY _____
SURVEYED _____
PLOTTED _____
CHECKED _____
AREAS CHECKED _____

ORIGINAL SURVEY
NOTE BOOK NO. _____
DATE _____
BY _____
SURVEYED _____
PLOTTED _____
CHECKED _____
AREAS CHECKED _____

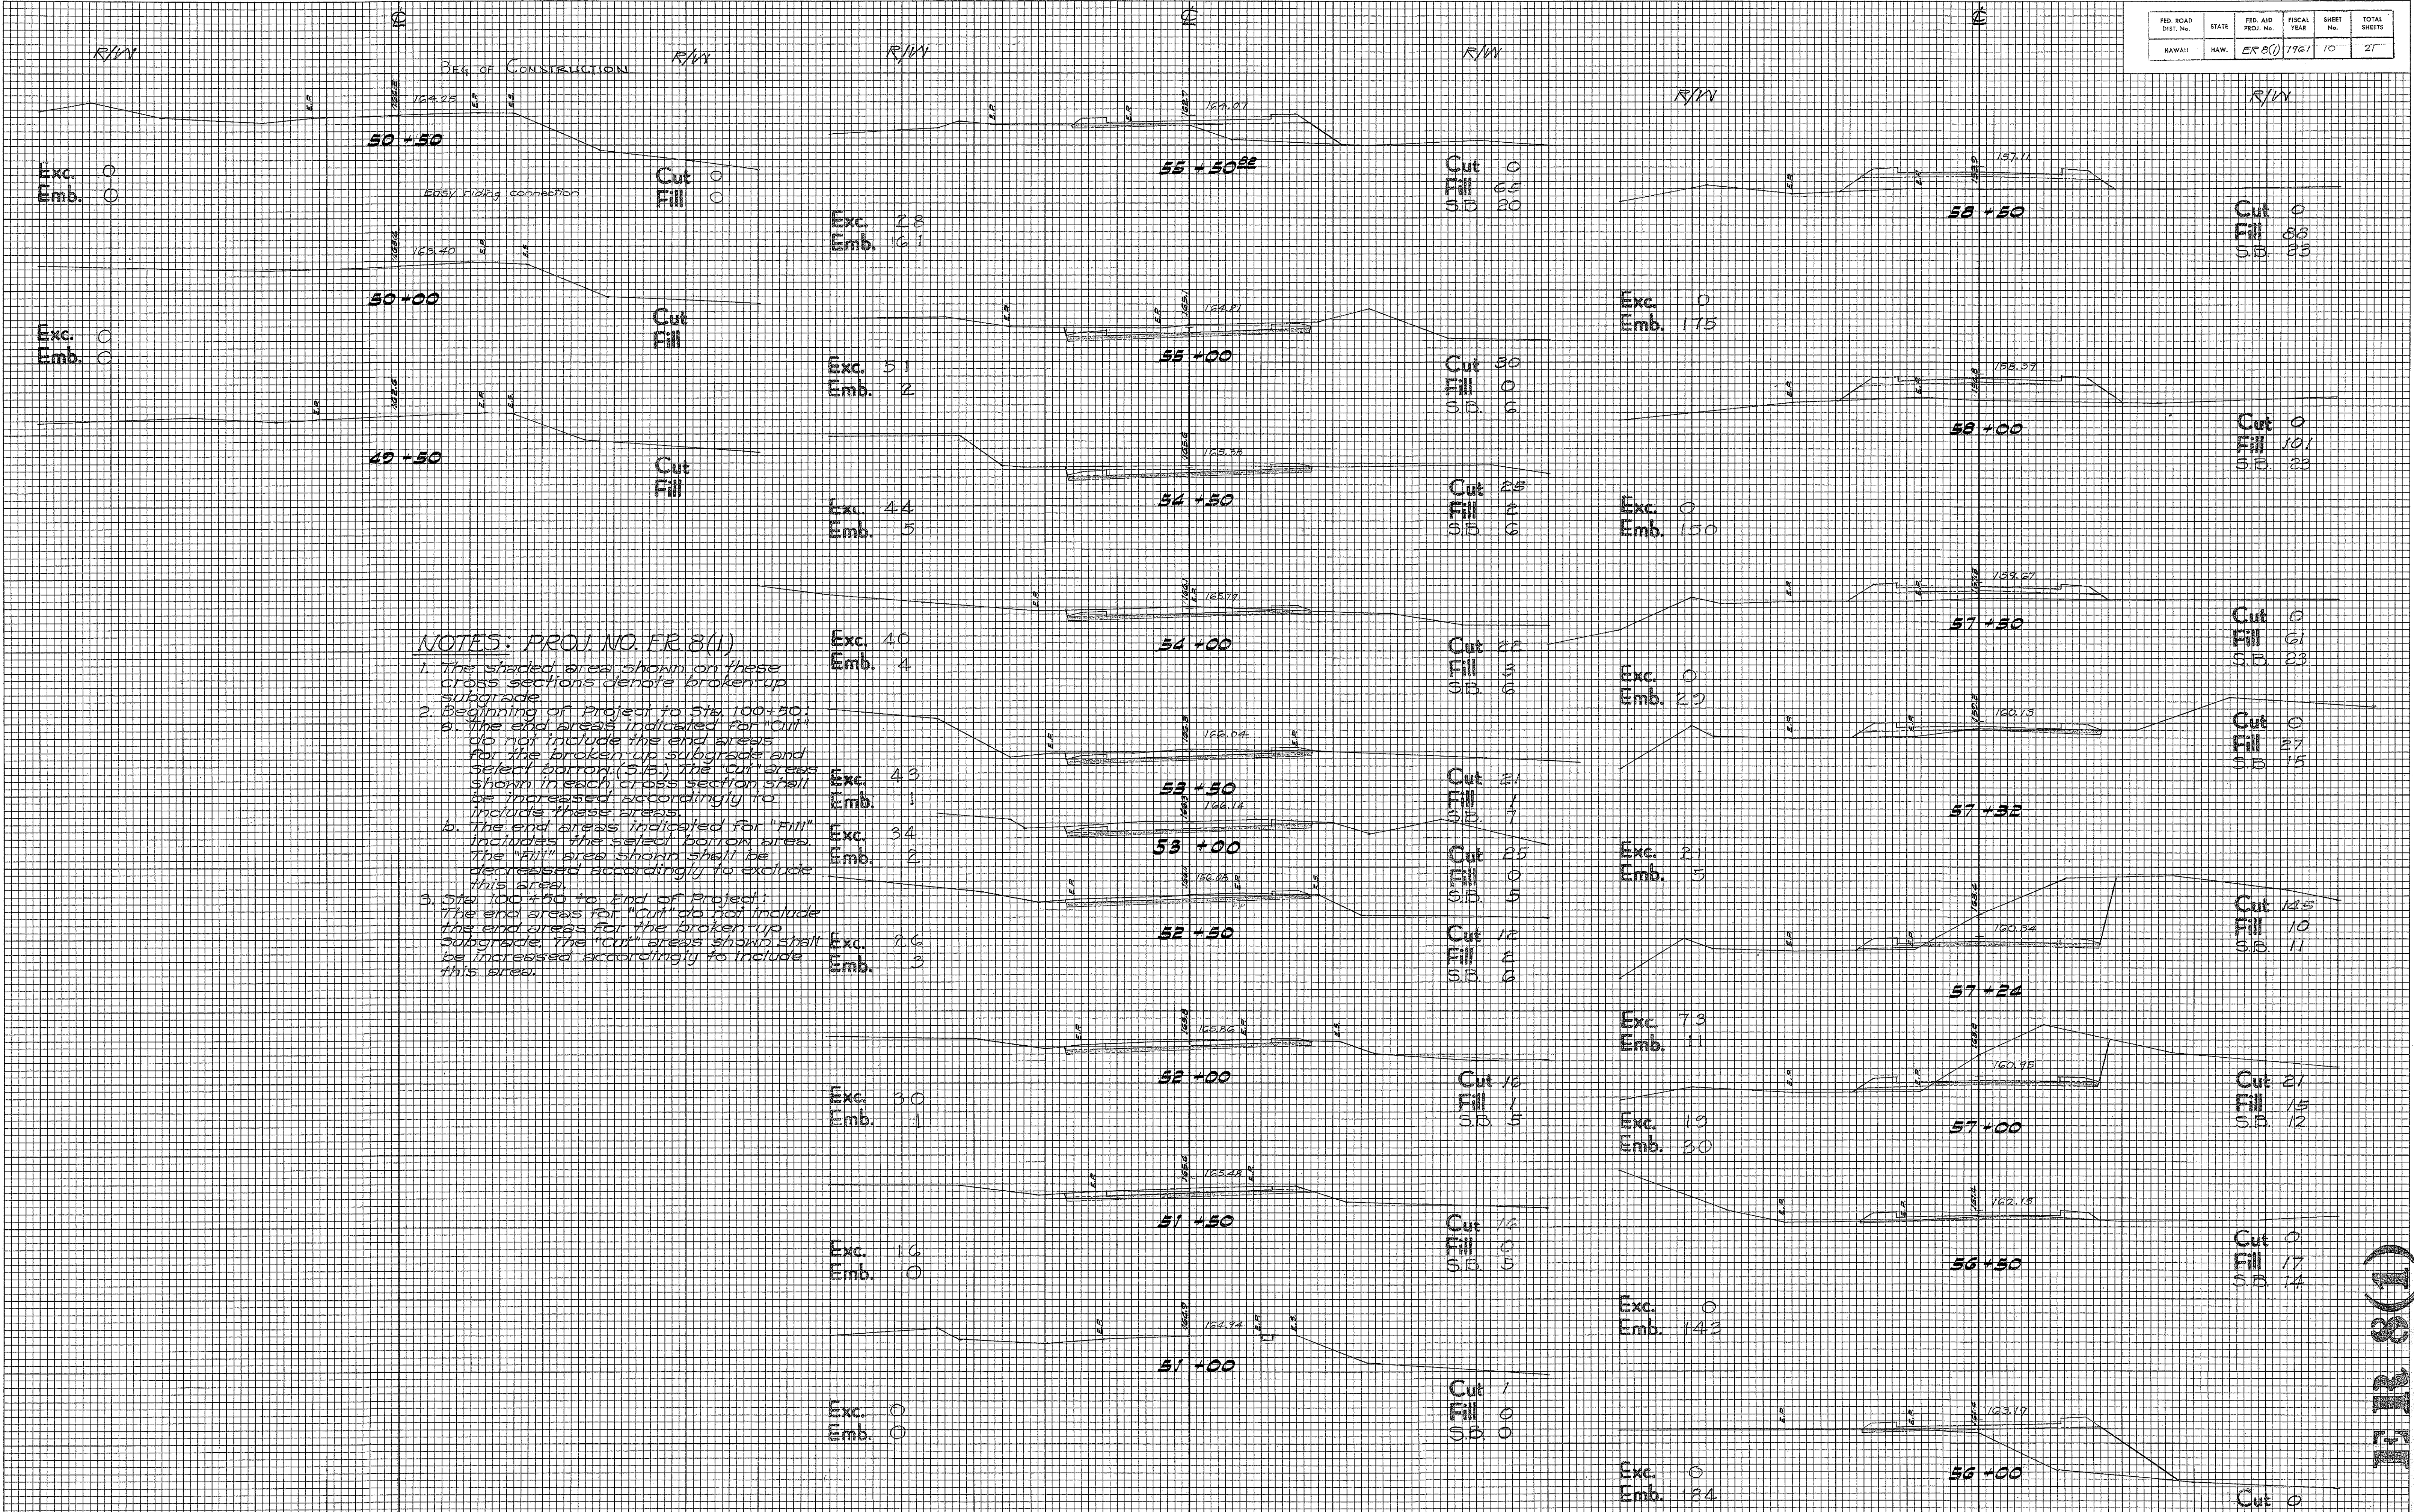


NOTES: PROJ. NO. FR 8(1)

- The shaded area shown on these cross sections denote broken up subgrade.
- Beginning of Project to Sta. 100+50:
a. The end areas indicated for "Cut" do not include the end areas for the broken up subgrade and select bottom (S.B.). The "Cut" areas shown in each cross section shall be increased accordingly to include these areas.
b. The end areas indicated for "Fill" includes the select bottom area. The "Fill" area shown shall be decreased accordingly to exclude this area.
- Sta. 100+50 to End of Project:
The end areas for "Cut" do not include the end areas for the broken up subgrade. The "Cut" areas shown shall be increased accordingly to include this area.

FINAL SURVEY	DATE	
	BY	
	REVISION	
	NOTE BOOK	
	NO.	

ORIGINAL SURVEY	DATE	12-17-60
	BY	L.O.
	REVISION	
	NOTE BOOK	L.O.
	NO.	3,500

FED. ROAD DIST. No.	STATE	FED. AID PROJ. No.	FISCAL YEAR	SHEET No.	TOTAL SHEETS
HAWAII	HAW.	ER 8(1)	1961	11	21

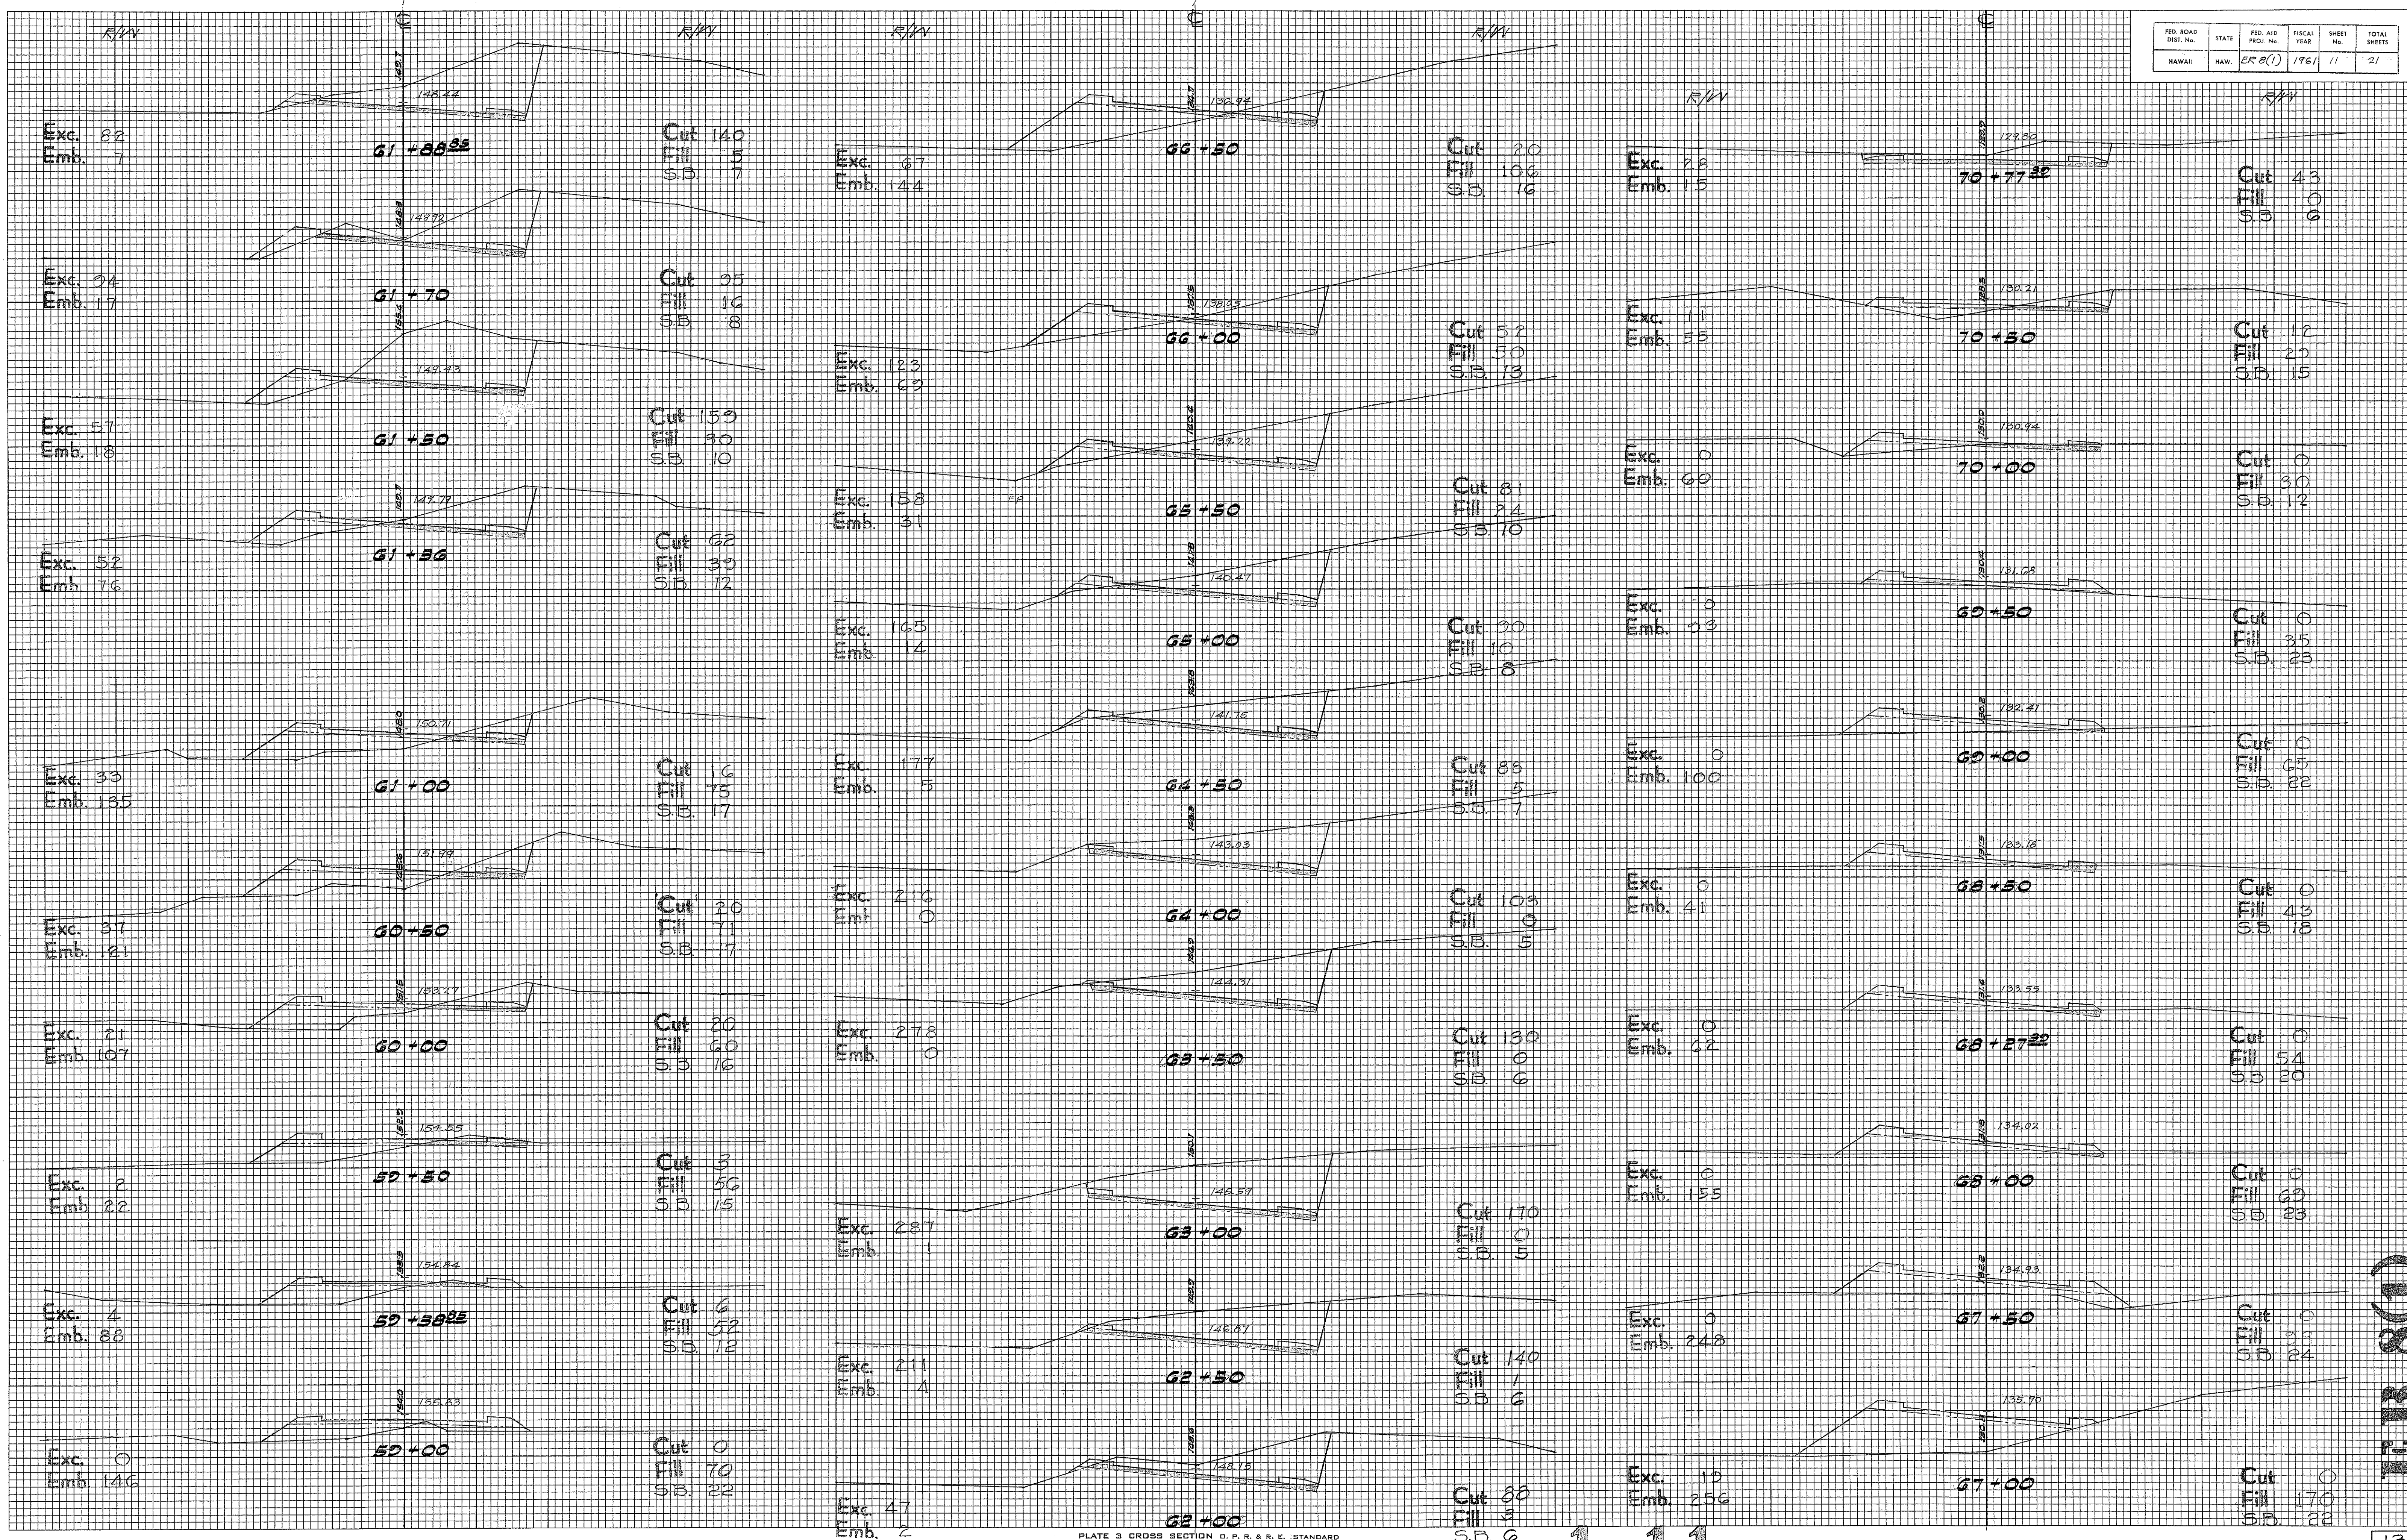

FINAL SURVEY	DATE	
	BY	
	SURVEYED	
	NOTE BOOK	
	NO.	

ORIGINAL SURVEY	DATE	
	BY	
	SURVEYED	
	NOTE BOOK	
	NO.	

FED. ROAD DIST. No.	STATE	FED. AID PROJ. No.	FISCAL YEAR	SHEET No.	TOTAL SHEETS
HAWAII	HAW.	ER 8(1)	1961	12	21

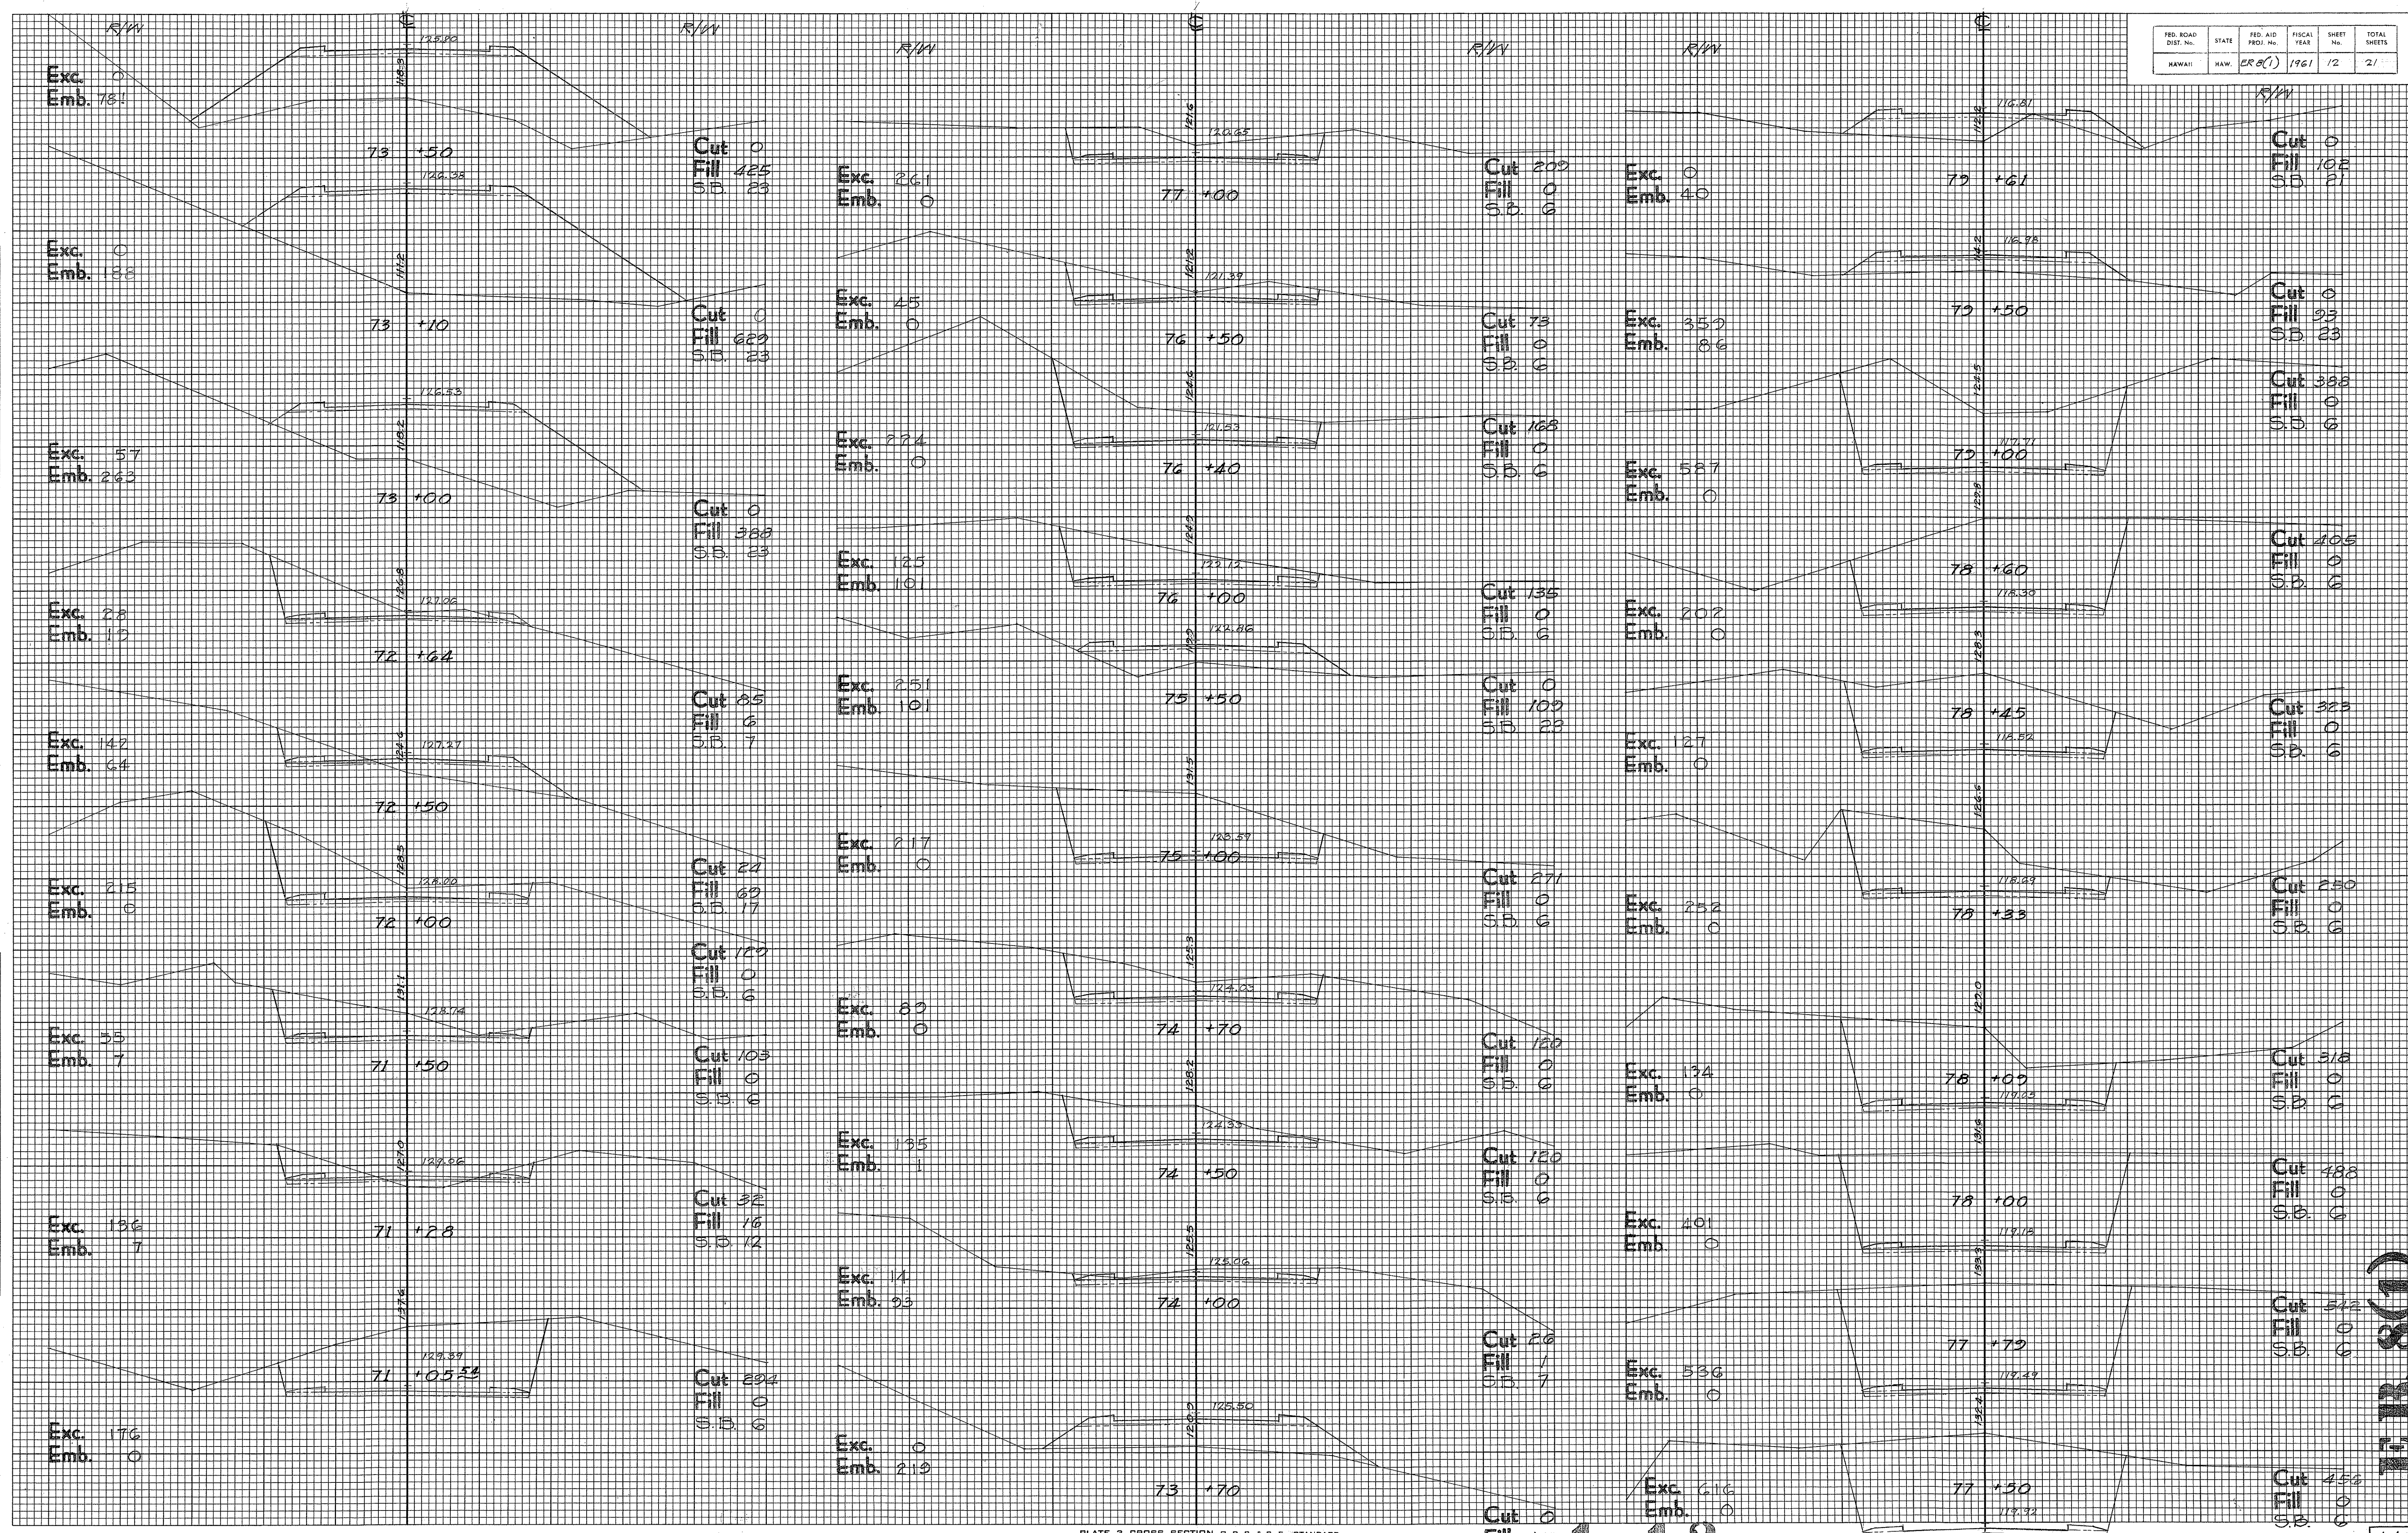


PLATE 3 CROSS SECTION D. P. R. & R. E. STANDARD
100% RAD PAPER-MADE AND PRINTED IN U. S. A.
EUGENE DIETZEN CO.


Cut 0
Fill 167
S.B. 23

14

FINAL SURVEY	DATE	
	BY	
	SURVEYED	
	NOTE BOOK	
	NO.	

ORIGINAL SURVEY	DATE	10-17-60
	BY	J.E.
	SURVEYED	
	NOTE BOOK	
	NO.	


FED. ROAD DIST. No.	STATE	FED. AID PROJ. No.	FISCAL YEAR	SHEET No.	TOTAL SHEETS
HAWAII	HAW.	ER 8(1)	1961	13	21

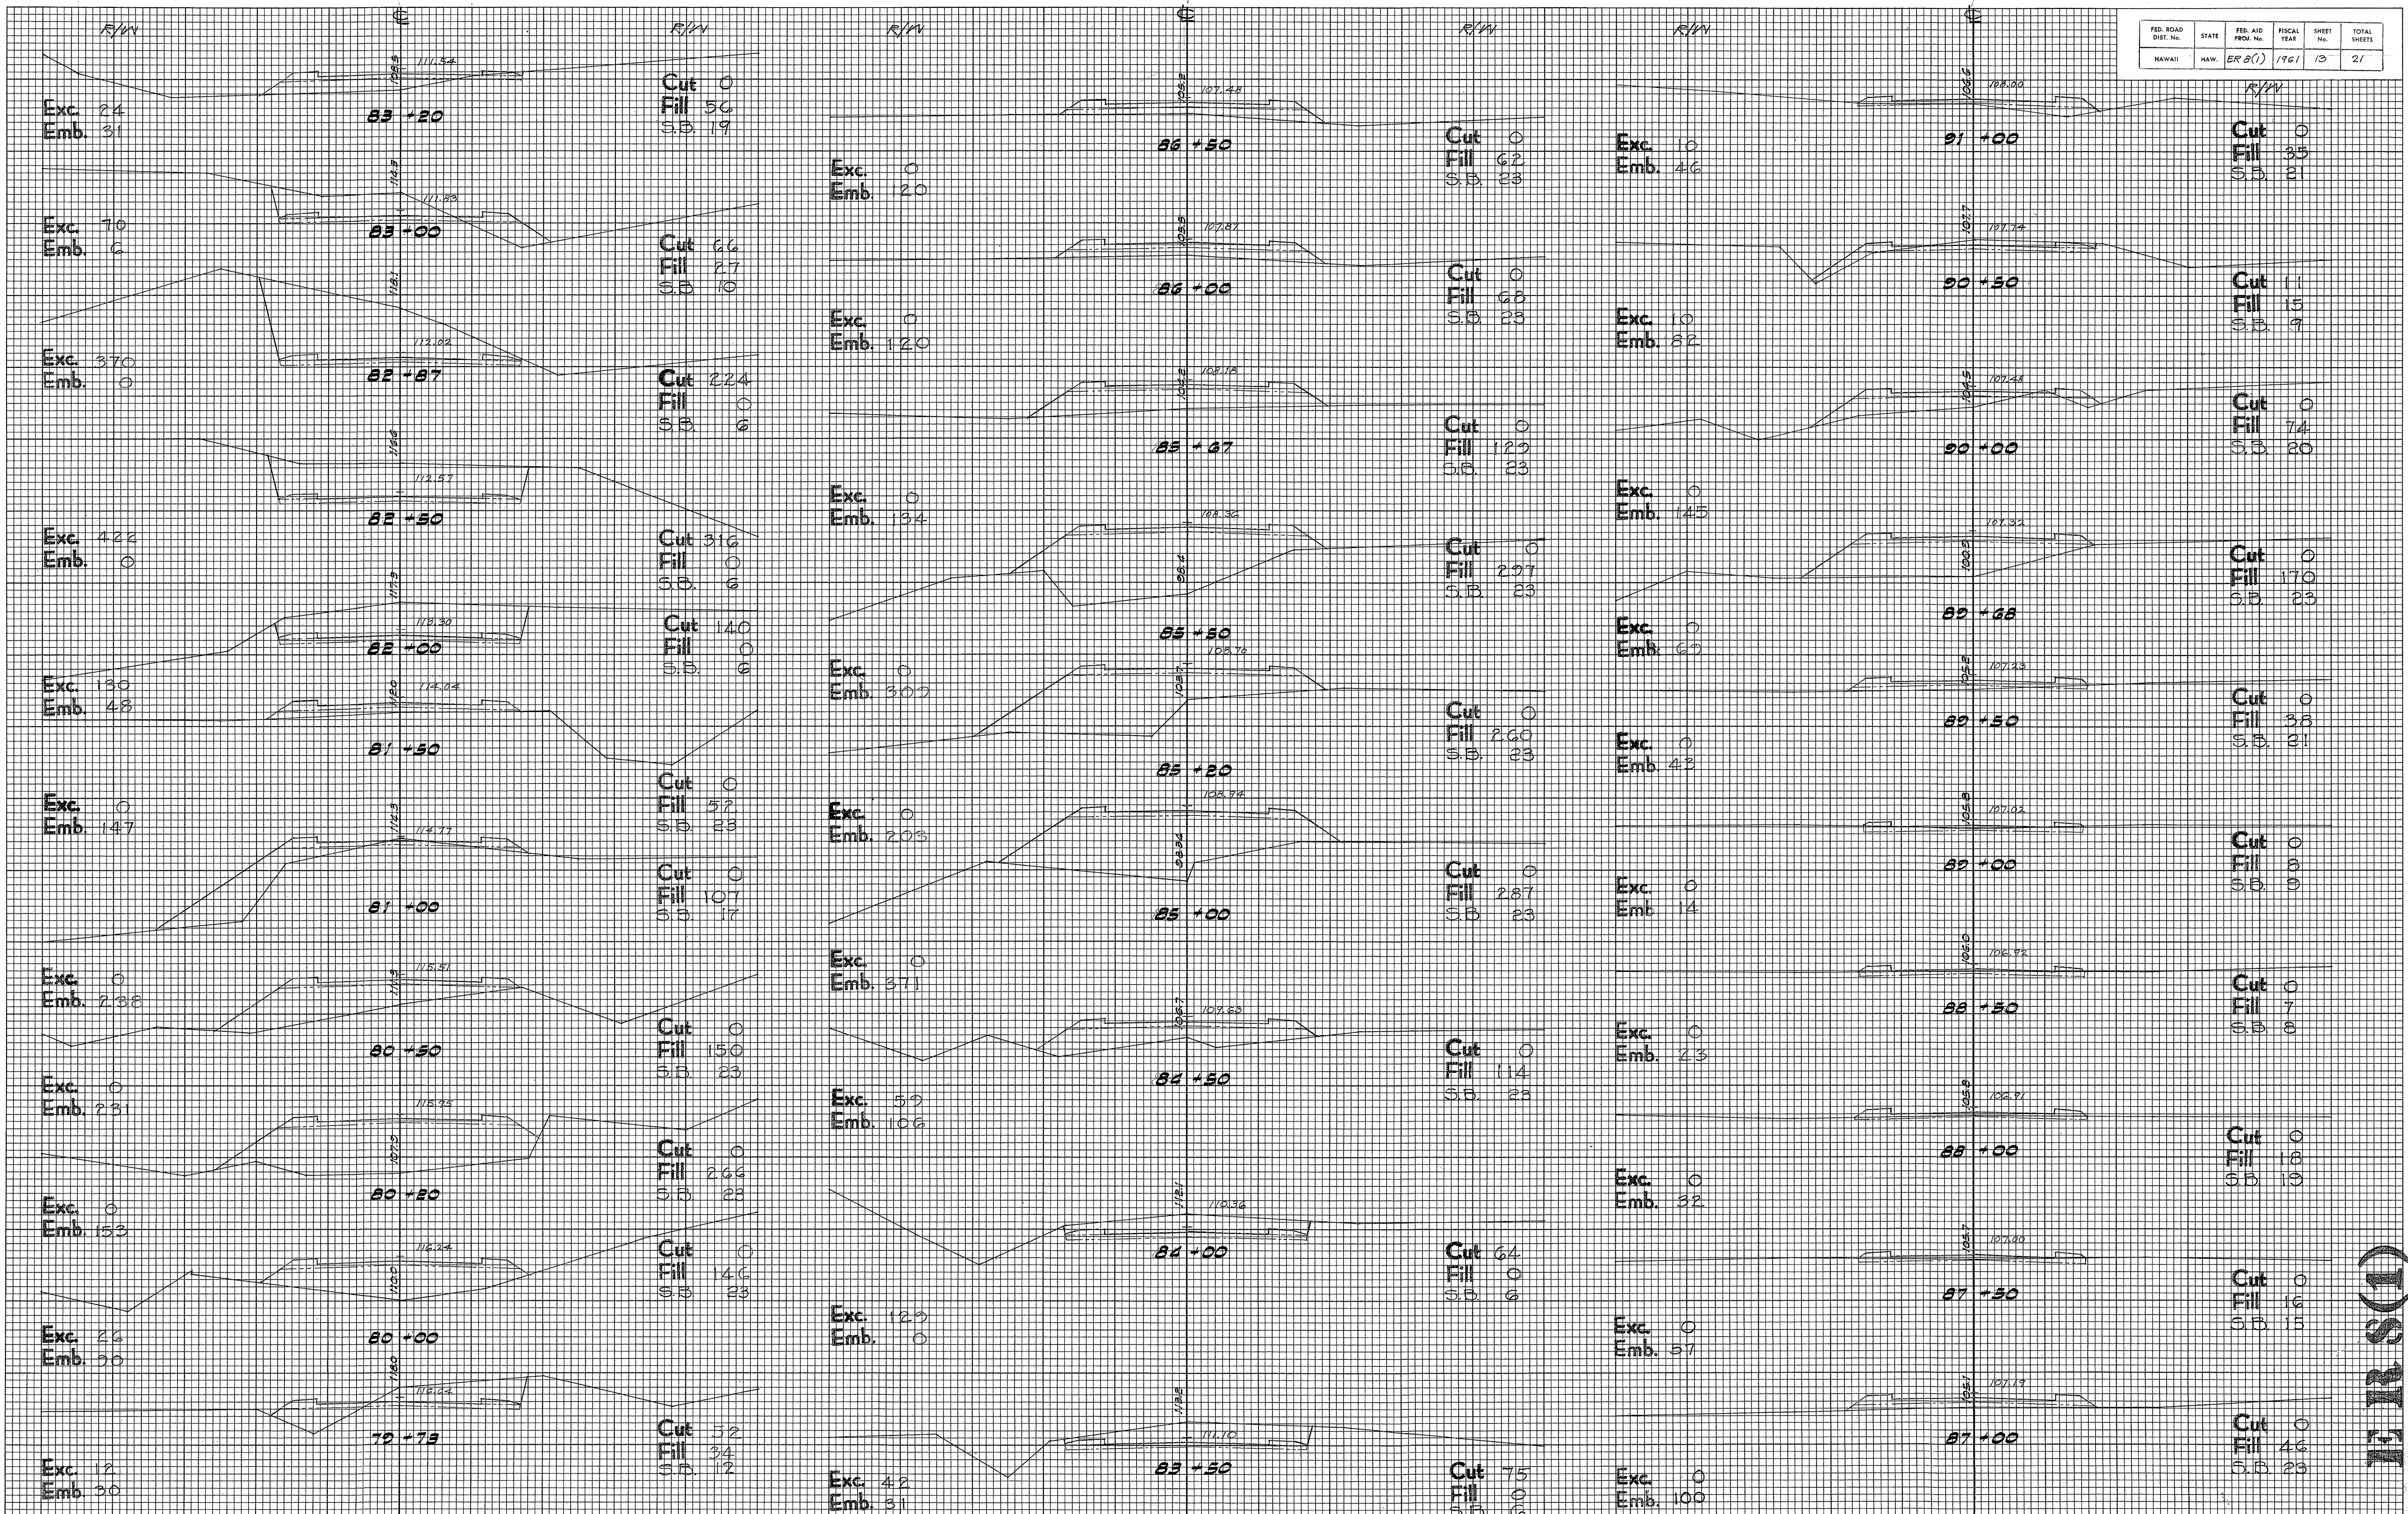

FINAL SURVEY	DATE	
	BY	
	REVISIONS	
	NO. OF SHEETS	


ORIGINAL SURVEY	DATE	10-15-60
	BY	J.P.
	REVISIONS	
	NO. OF SHEETS	14

FED. ROAD DIST. NO.	STATE	FED. AID PROJ. NO.	FISCAL YEAR	SHEET NO.	TOTAL SHEETS
HAWAII	HAW.	ER 8(1)	1961	14	21

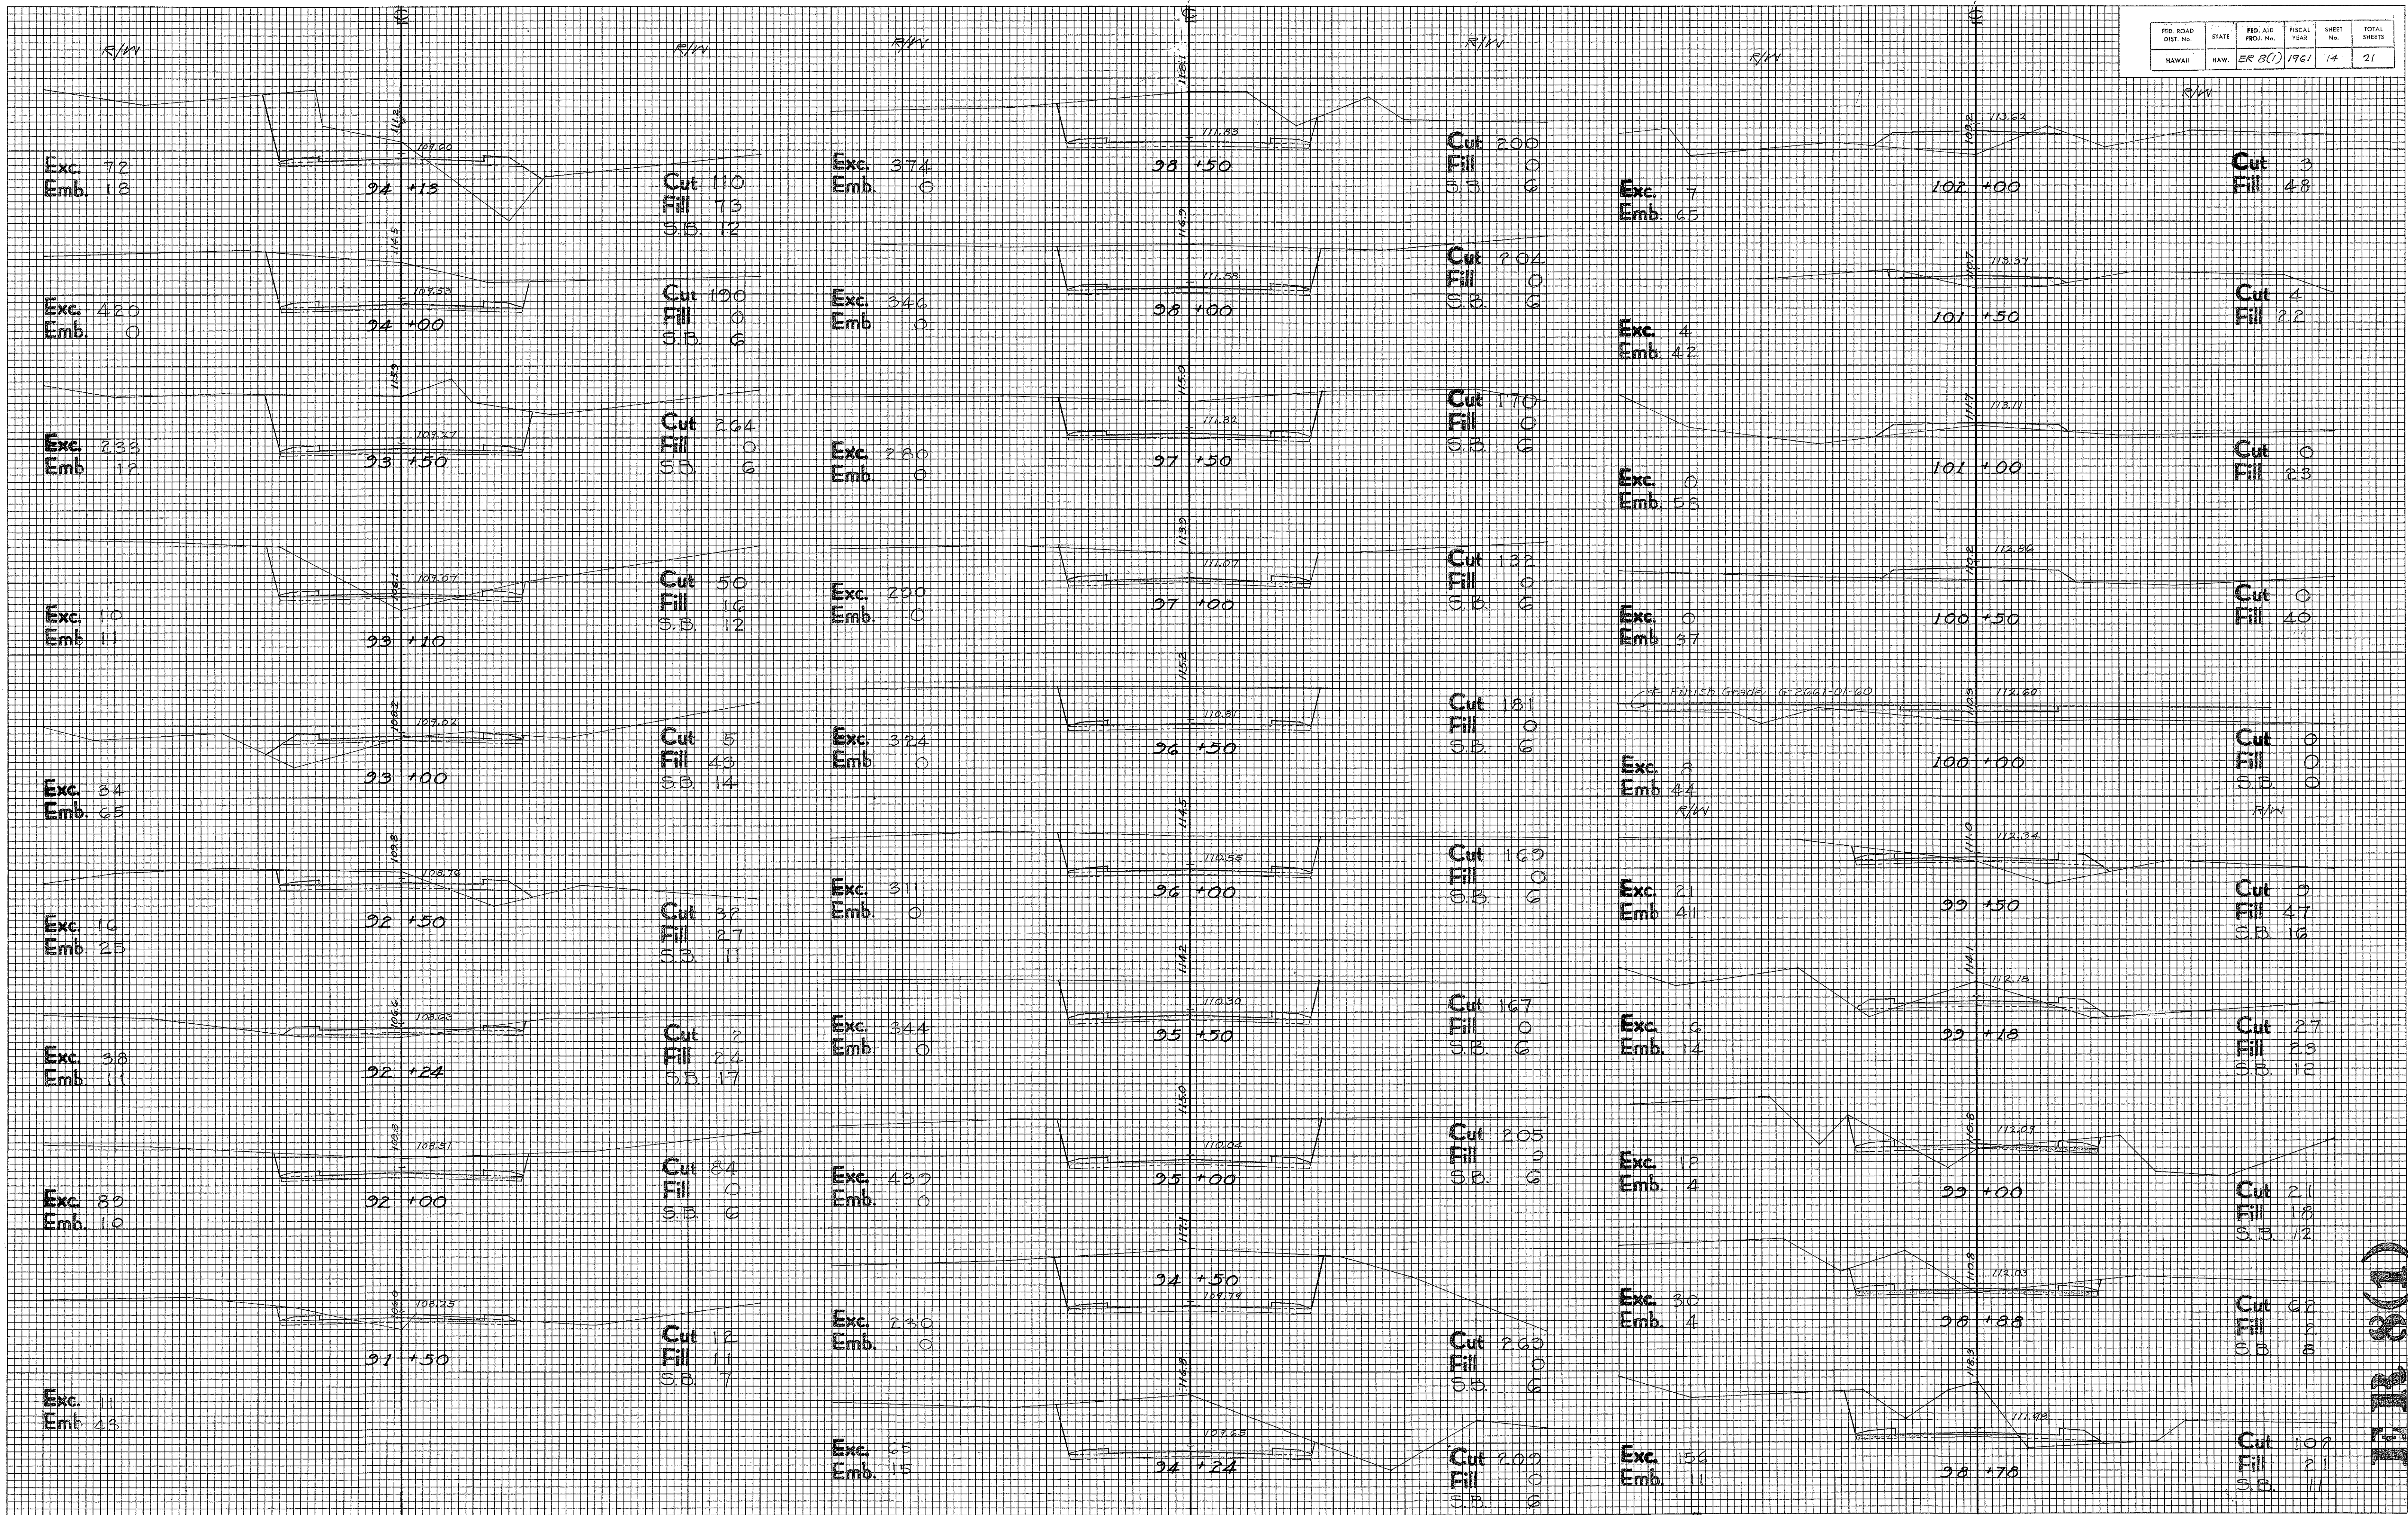

FINAL SURVEY
 BY _____
 DATE _____
 SURVEYED _____
 PLOTTED _____
 NOTE BOOK _____
 AREAS CHECKED _____
 NO. _____


ORIGINAL SURVEY
 BY _____
 DATE _____
 SURVEYED _____
 PLOTTED _____
 NOTE BOOK _____
 AREAS CHECKED _____
 NO. _____

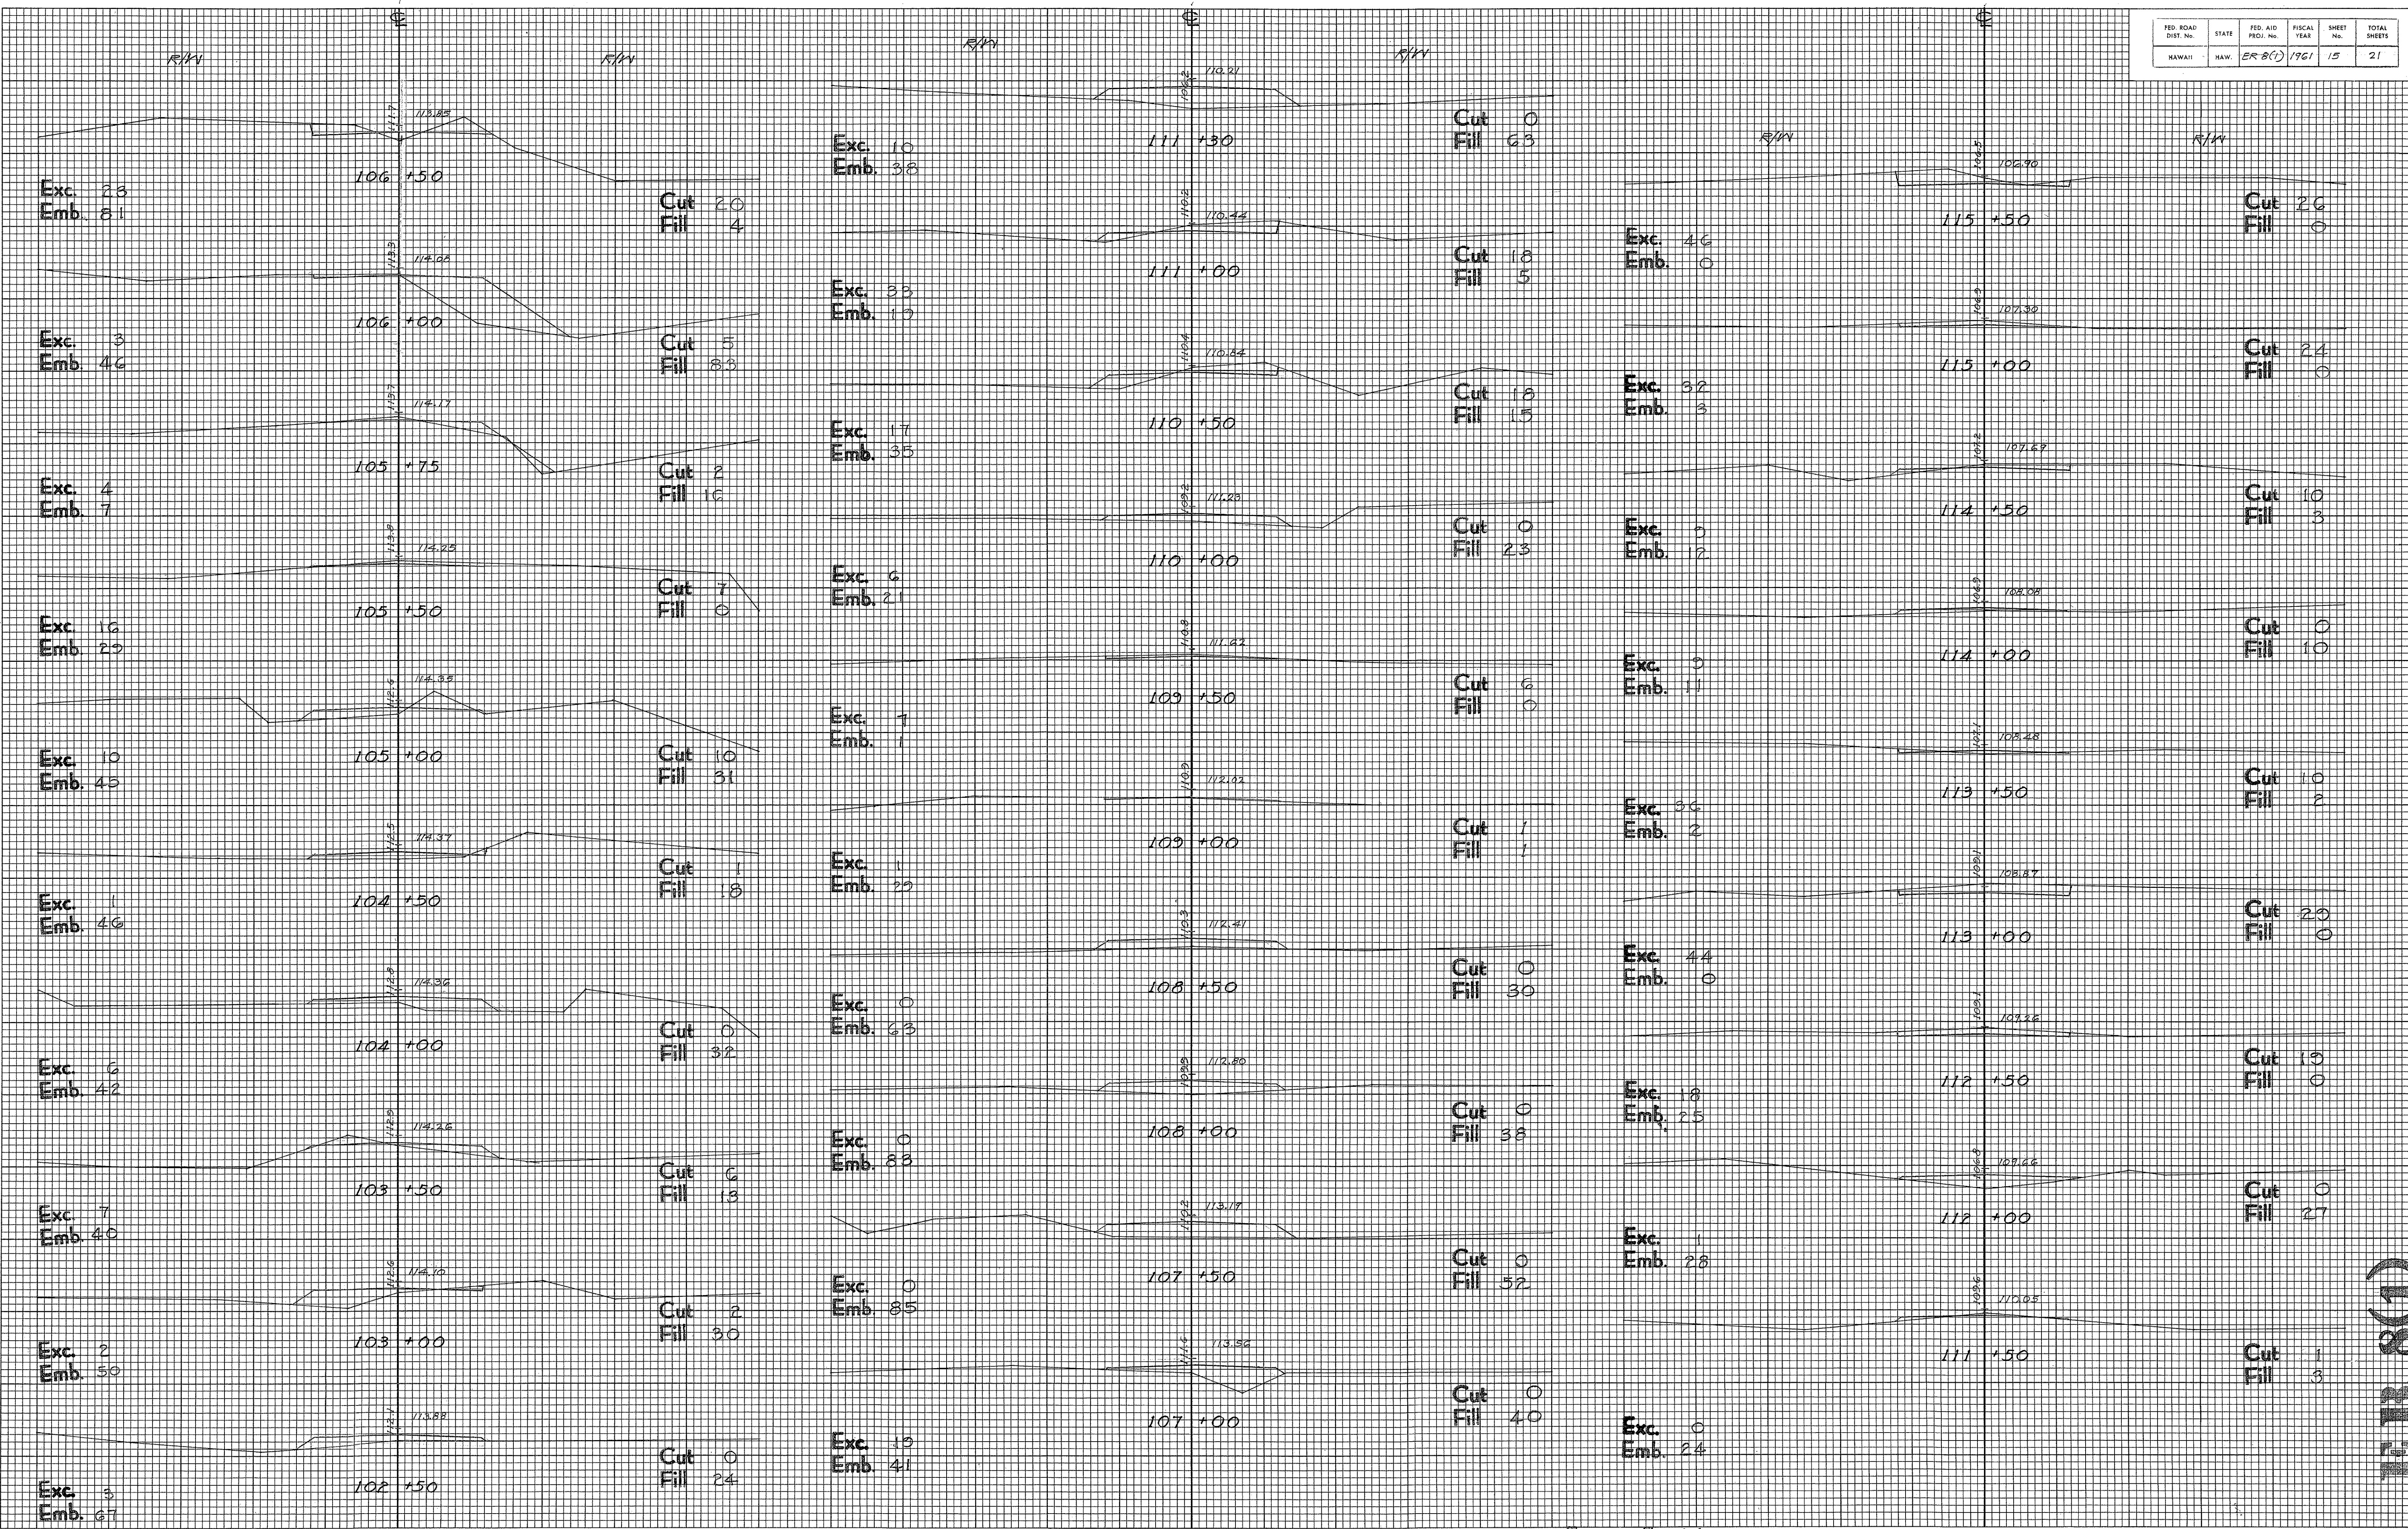

FINAL SURVEY	DATE	
	BY	
	SURVEYED	
	PLOTTED	
NOTE BOOK	DATE	
NO.	AREAS CHECKED	


ORIGINAL SURVEY	DATE	10-11-60
	BY	T.F. S. S. E.
	SURVEYED	
	PLOTTED	
NOTE BOOK	DATE	10-11-60
NO.	AREAS CHECKED	

FED. ROAD DIST. No.	STATE	FED. AID PROJ. No.	FISCAL YEAR	SHEET No.	TOTAL SHEETS
HAWAII	HAW.	25 8(1)	1961	16	21

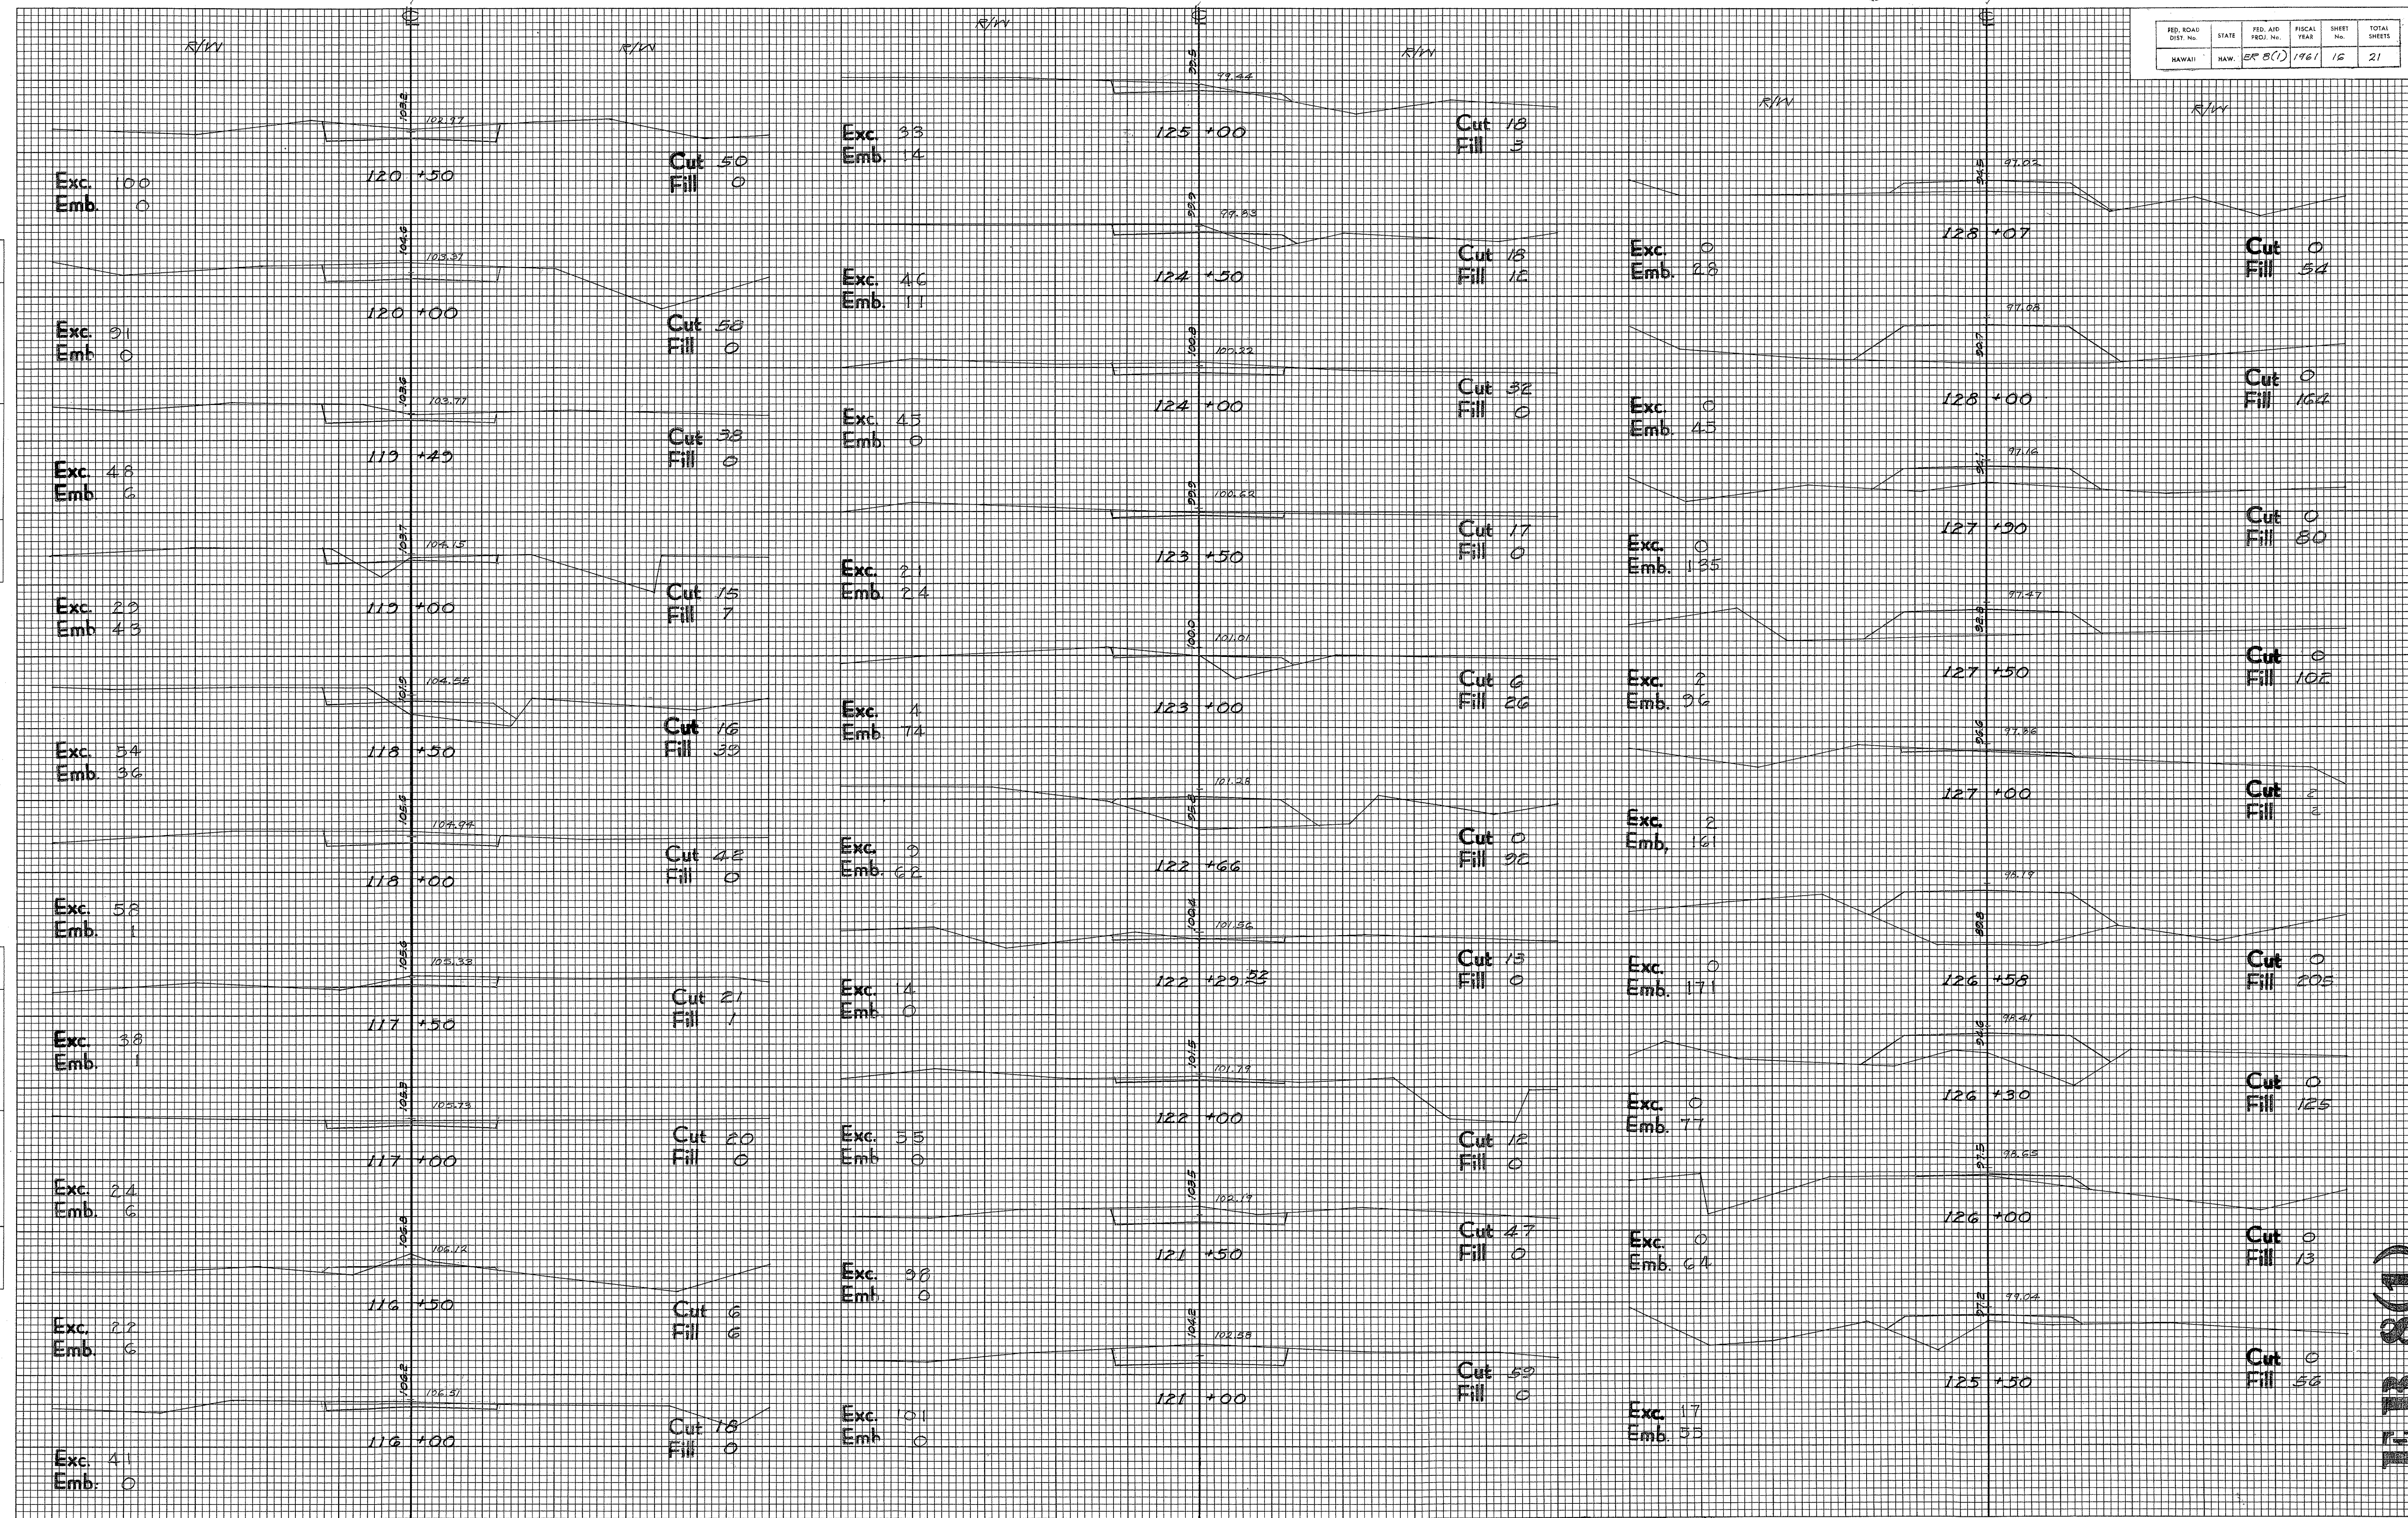

FINAL SURVEY
BY
DATE
SURVEYED
NOTE BOOK
NO.
TEMPLATE
AREAS
CHECKED


ORIGINAL SURVEY
BY
DATE
SURVEYED
NOTE BOOK
NO.
TEMPLATE
AREAS
CHECKED

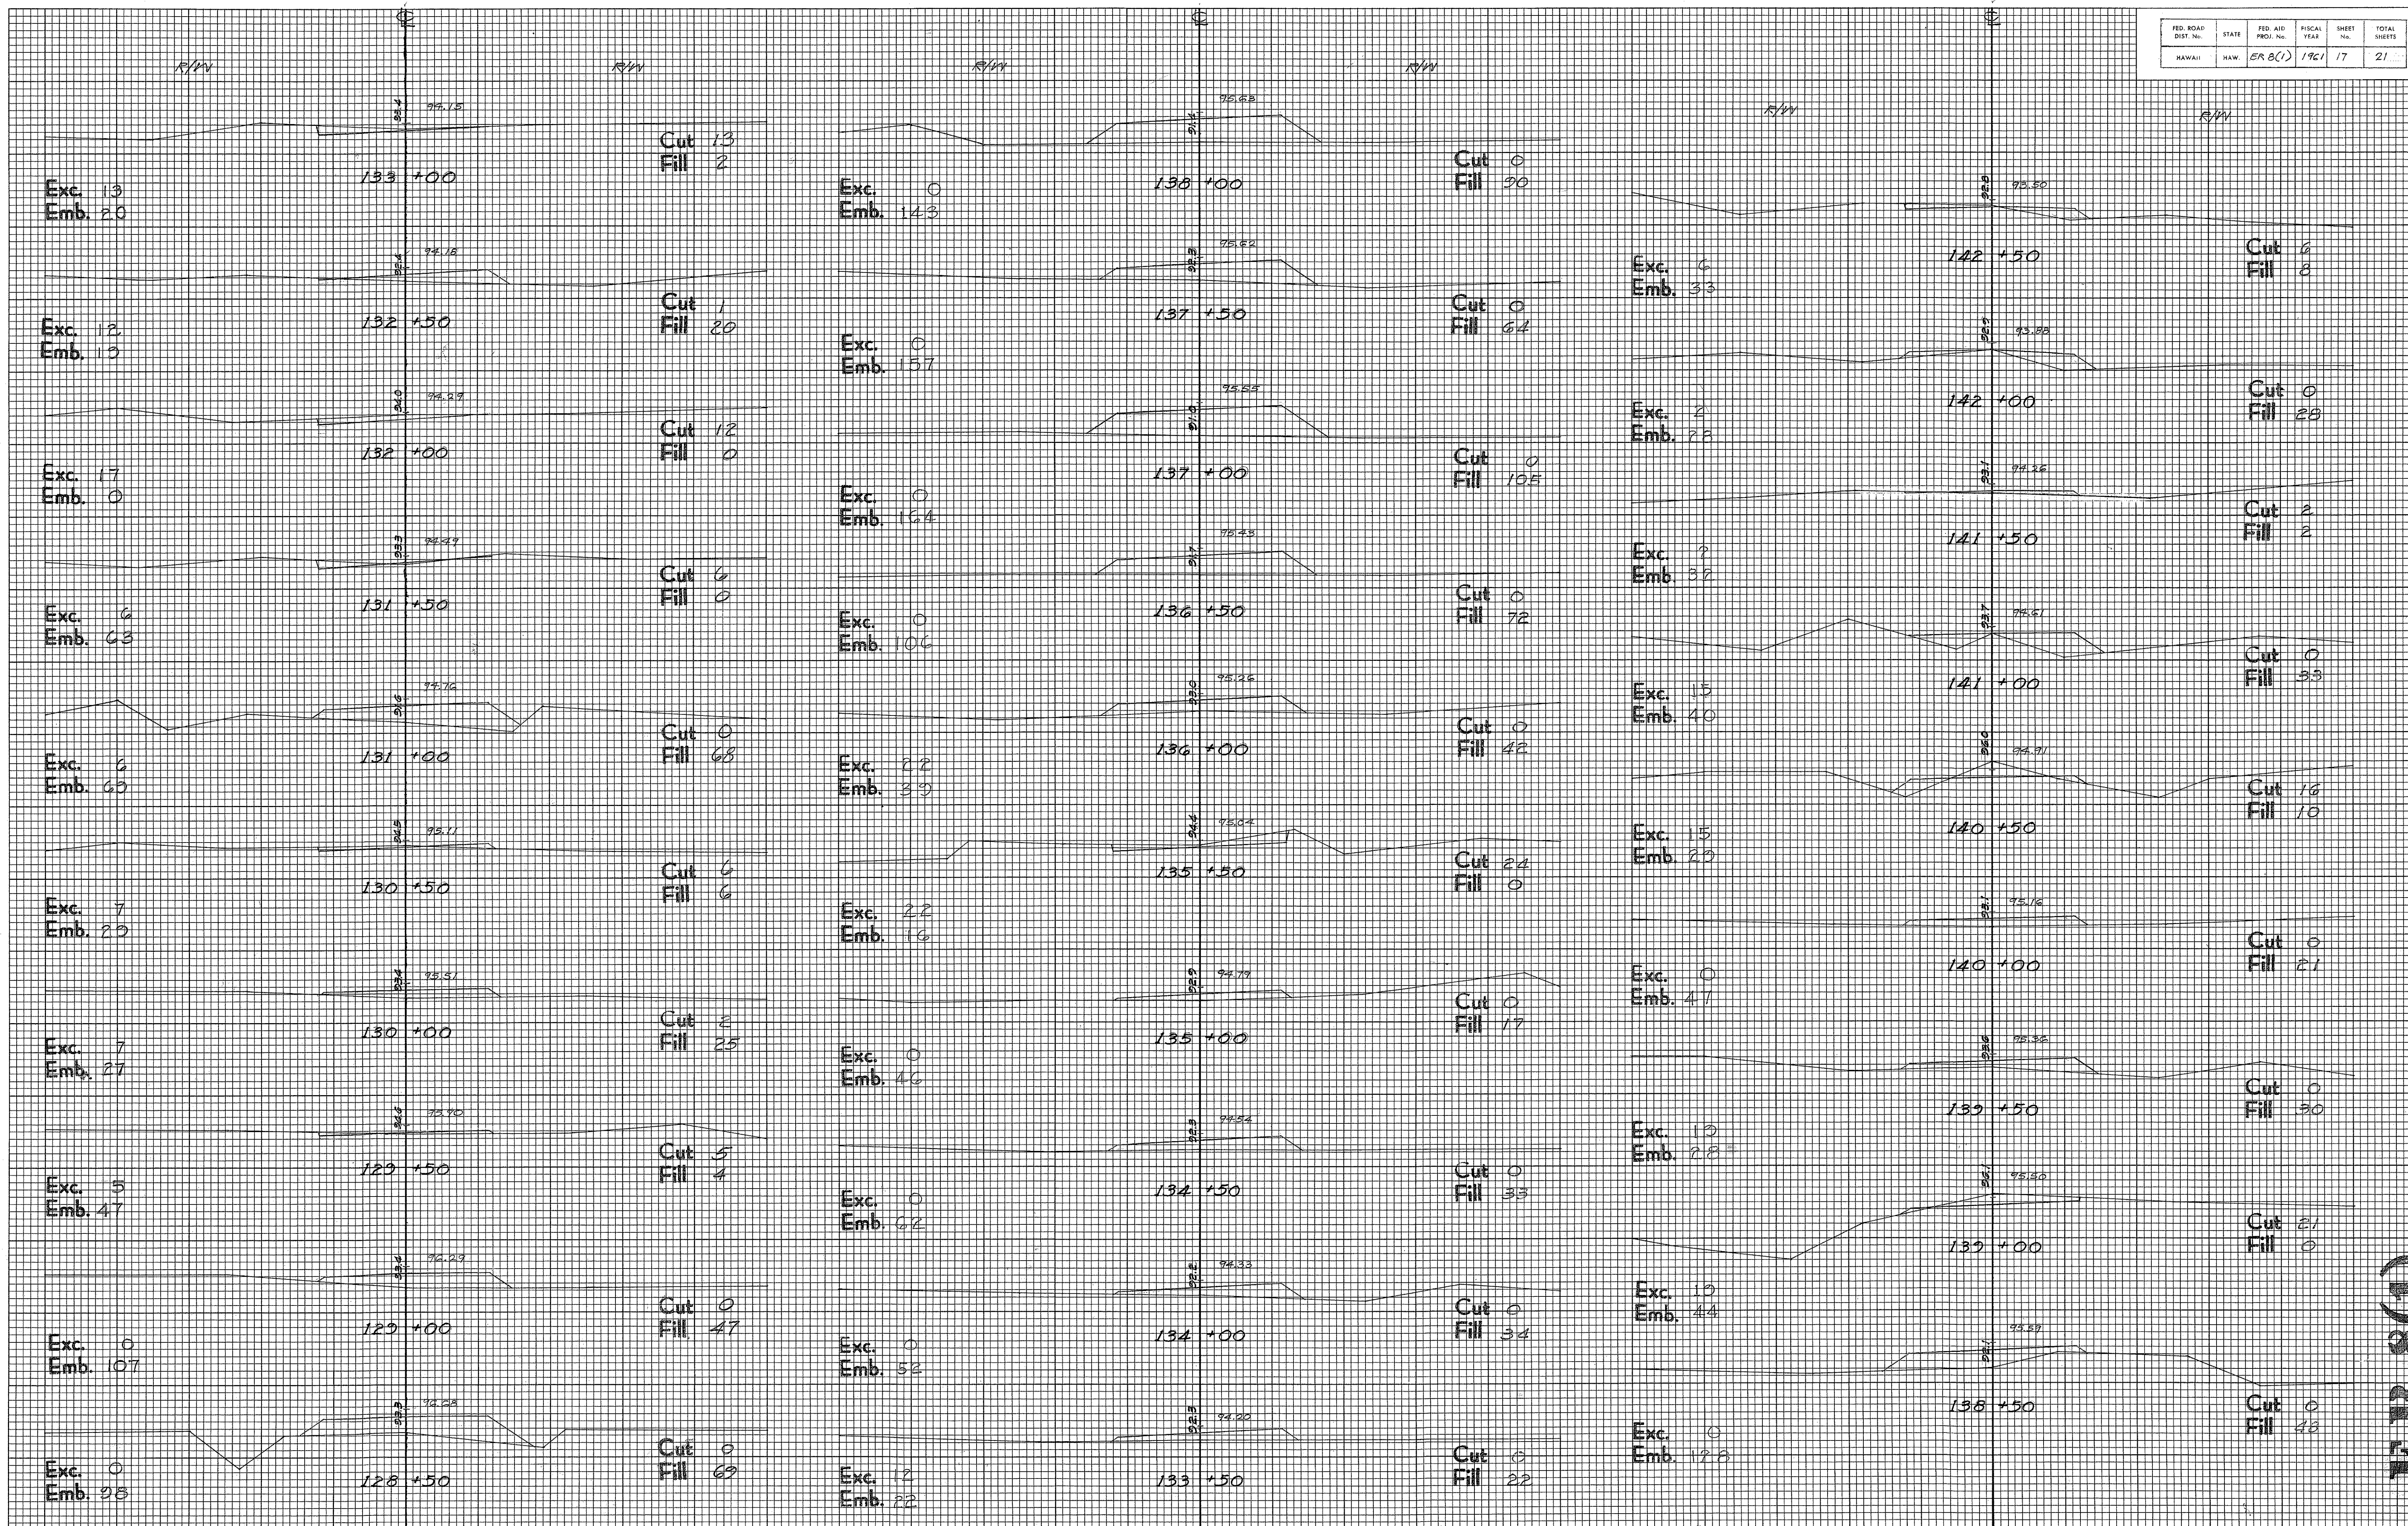

FINAL SURVEY	NO.	DATE
	BY	
	REVIEWED	
	PLOTTED	
	NOTE BOOK	TEMPLATE
	AREAS CHECKED	

ORIGINAL SURVEY	NO.	DATE
	BY	
	REVIEWED	
	PLOTTED	
	NOTE BOOK	TEMPLATE
	AREAS CHECKED	


FED. ROAD DIST. NO.	STATE	FED. AID PROJ. NO.	FISCAL YEAR	SHEET NO.	TOTAL SHEETS
HAWAII	HAW.	ER 8(1)	1961	18	21

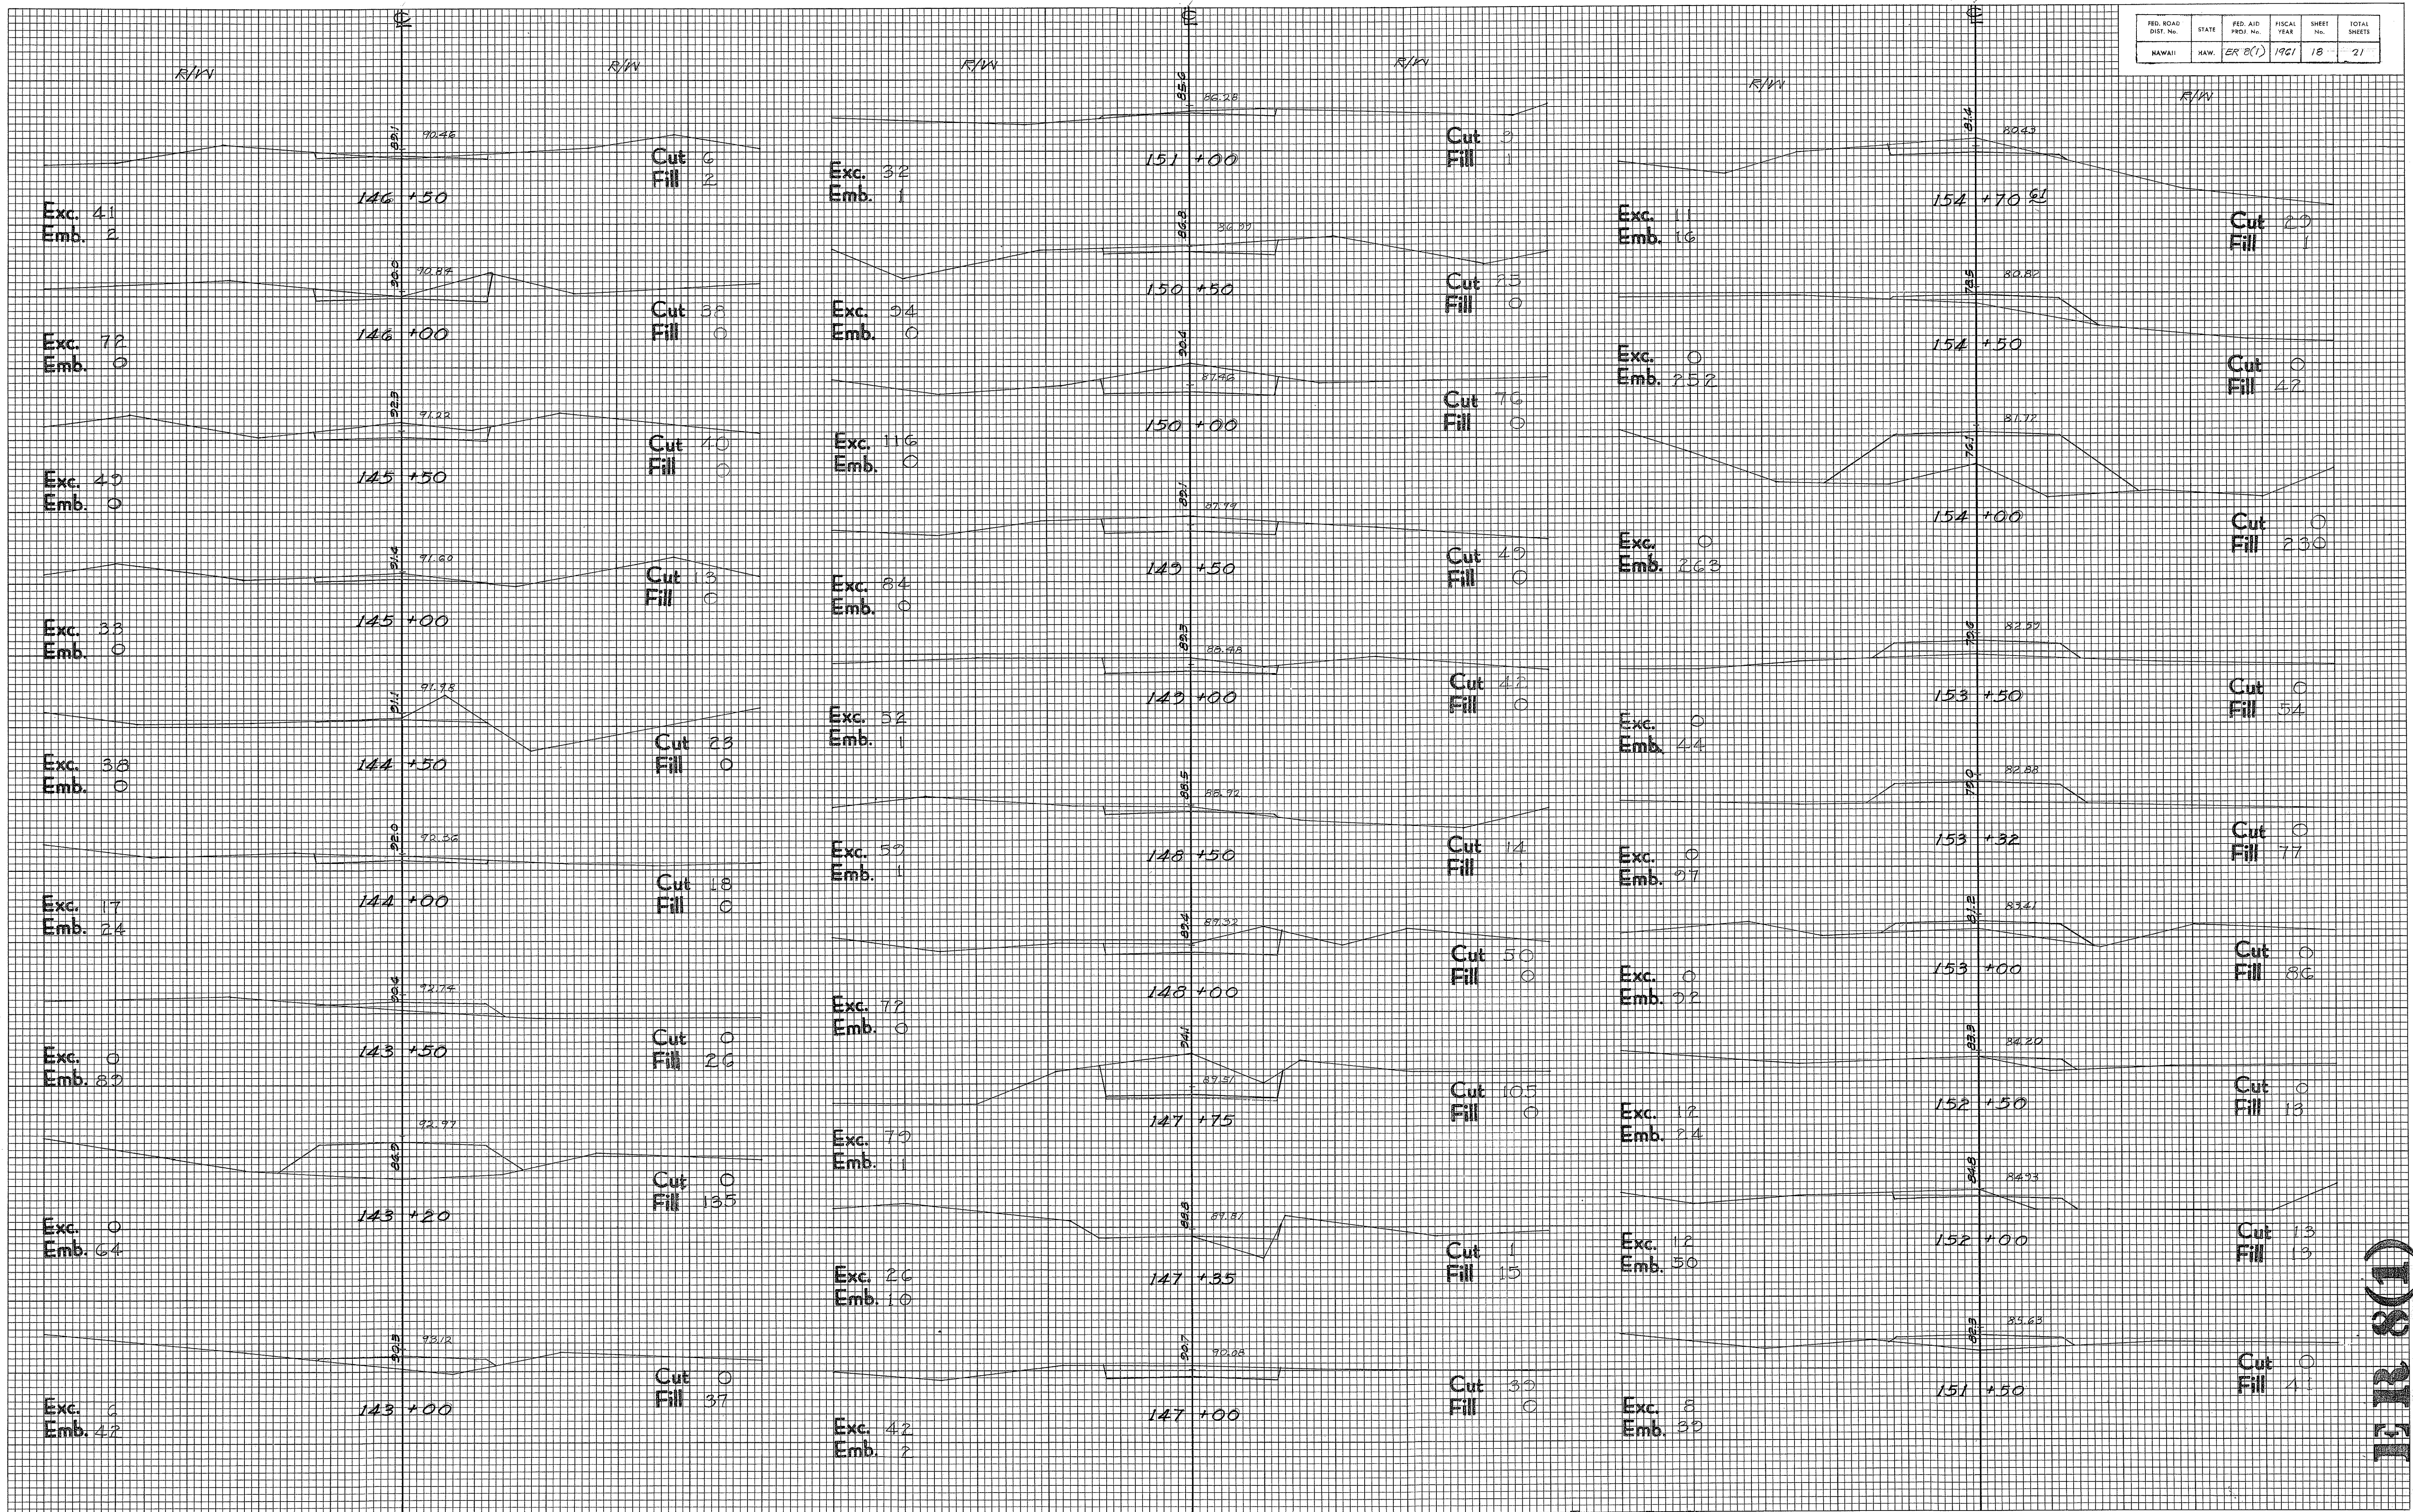

FINAL SURVEY	DATE	
	BY	
	SURVEYED	
	NOTE BOOK	
	NO.	


ORIGINAL SURVEY	DATE	02-12-60
	BY	J.E.
	SURVEYED	J.E.
	NOTE BOOK	W.K.
	NO.	

FED. ROAD DIST. No.	STATE	FED. AID PROJ. No.	FISCAL YEAR	SHEET No.	TOTAL SHEETS
HAWAII	HAW.	ER 8(1)	1961	19	21

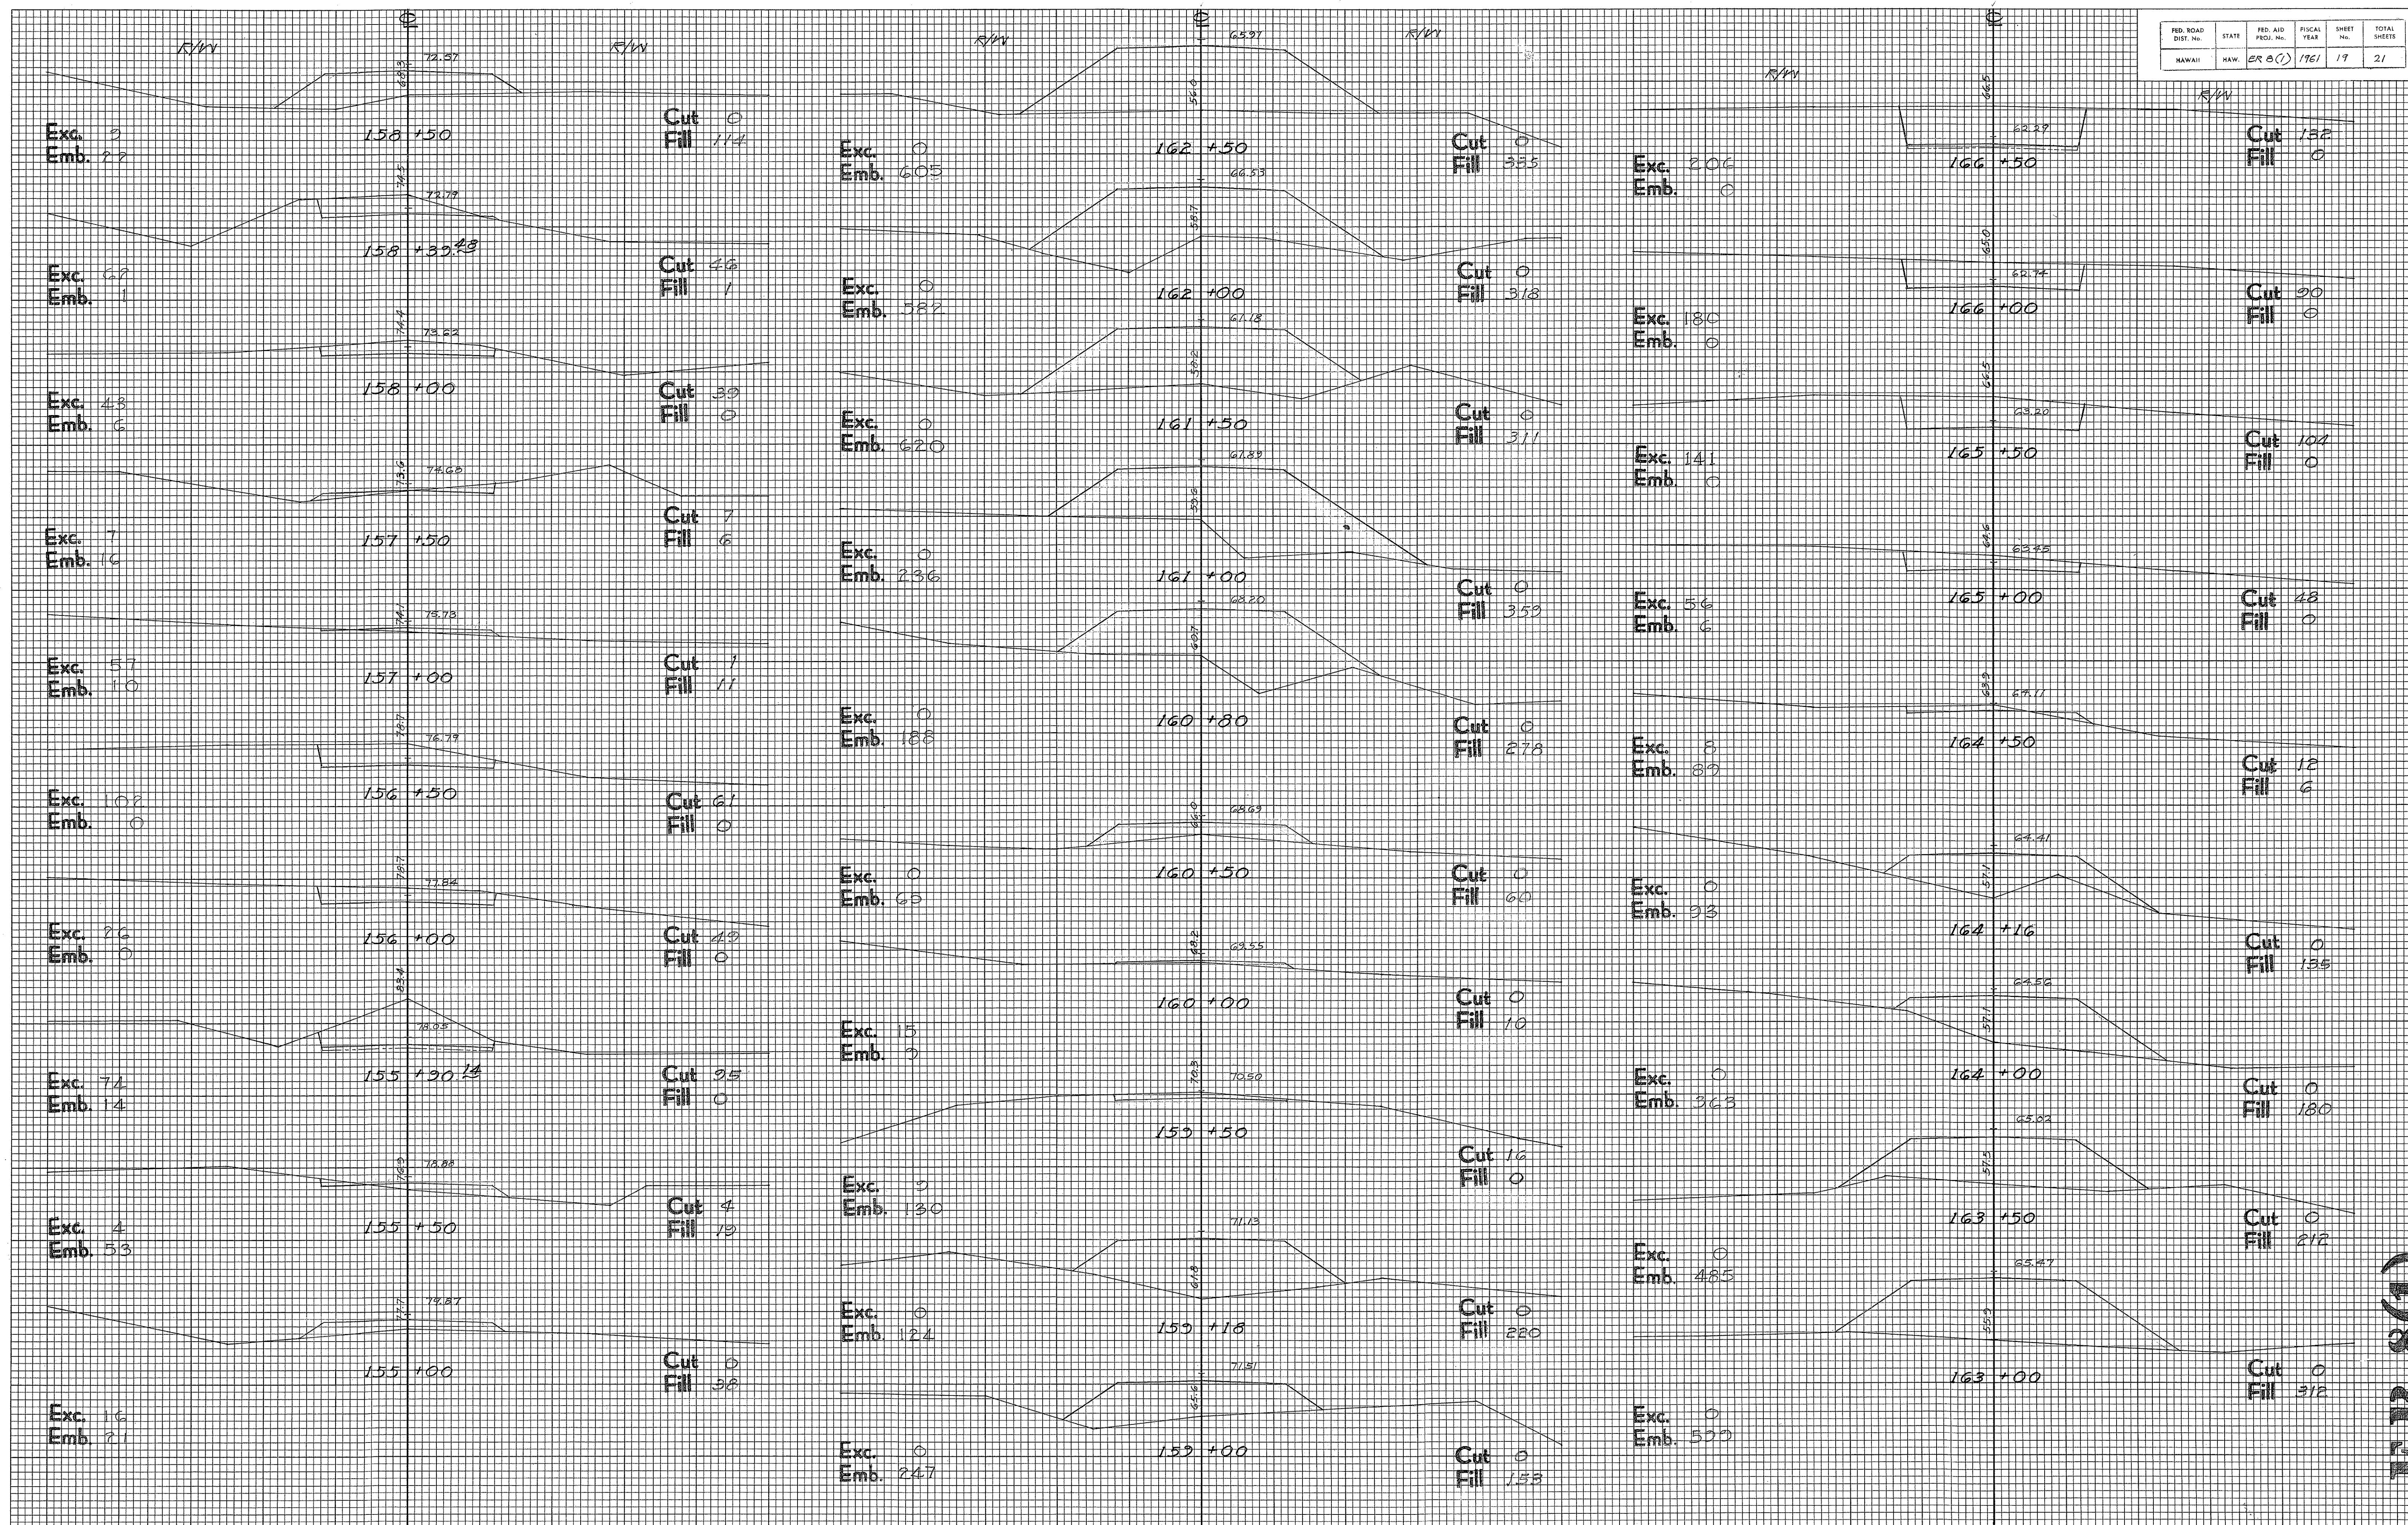


FINAL SURVEY
BY S.A.
DATE 9/60
SHEET 20
SCALE 1" = 40'
T.E.D.O.

ORIGINAL SURVEY
BY T.E.
DATE 8-29-60
SHEET 20
SCALE 1" = 40'
T.E.D.O.

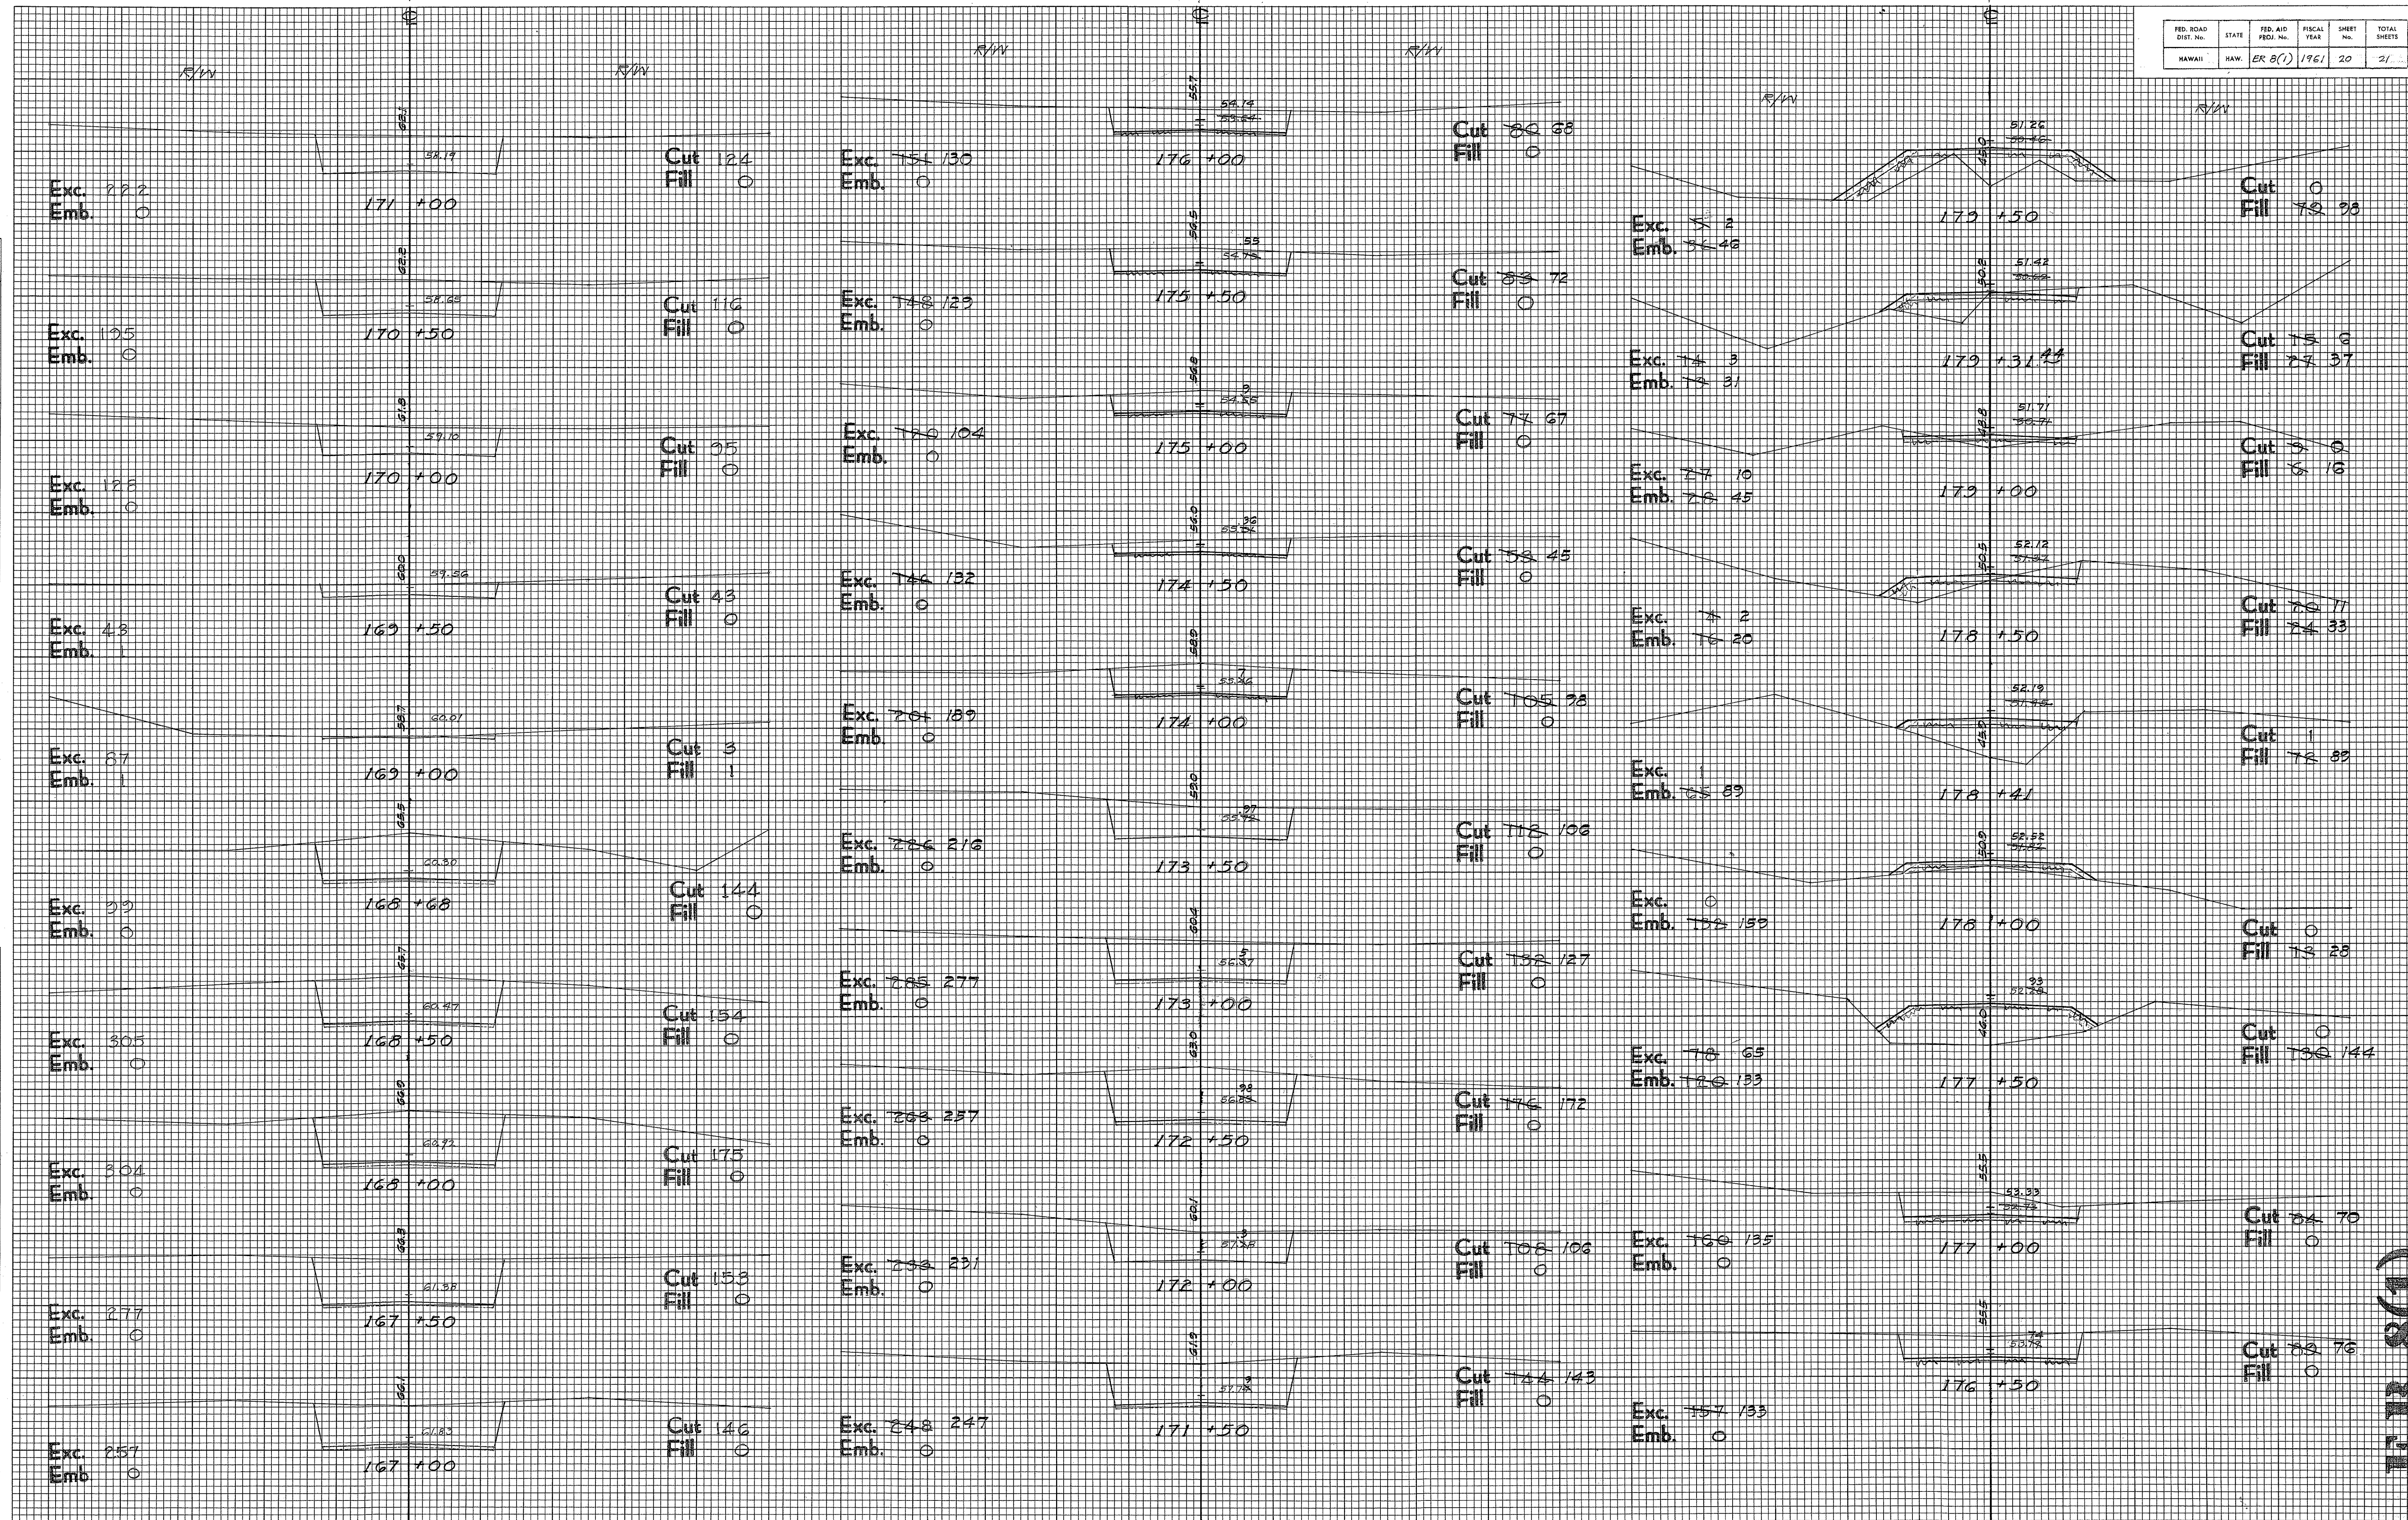

ORIGINAL SURVEY NOTE BOOK NO. _____	SURVEYED	BY _____ DATE _____
	PLOTTED	
	TEMPLATE	
	AREAS	
	AREAS CHECKED	

STA. 186+50 TO STA. 188+65
SUPERSEDED - SEE SHEET
NO. 621A

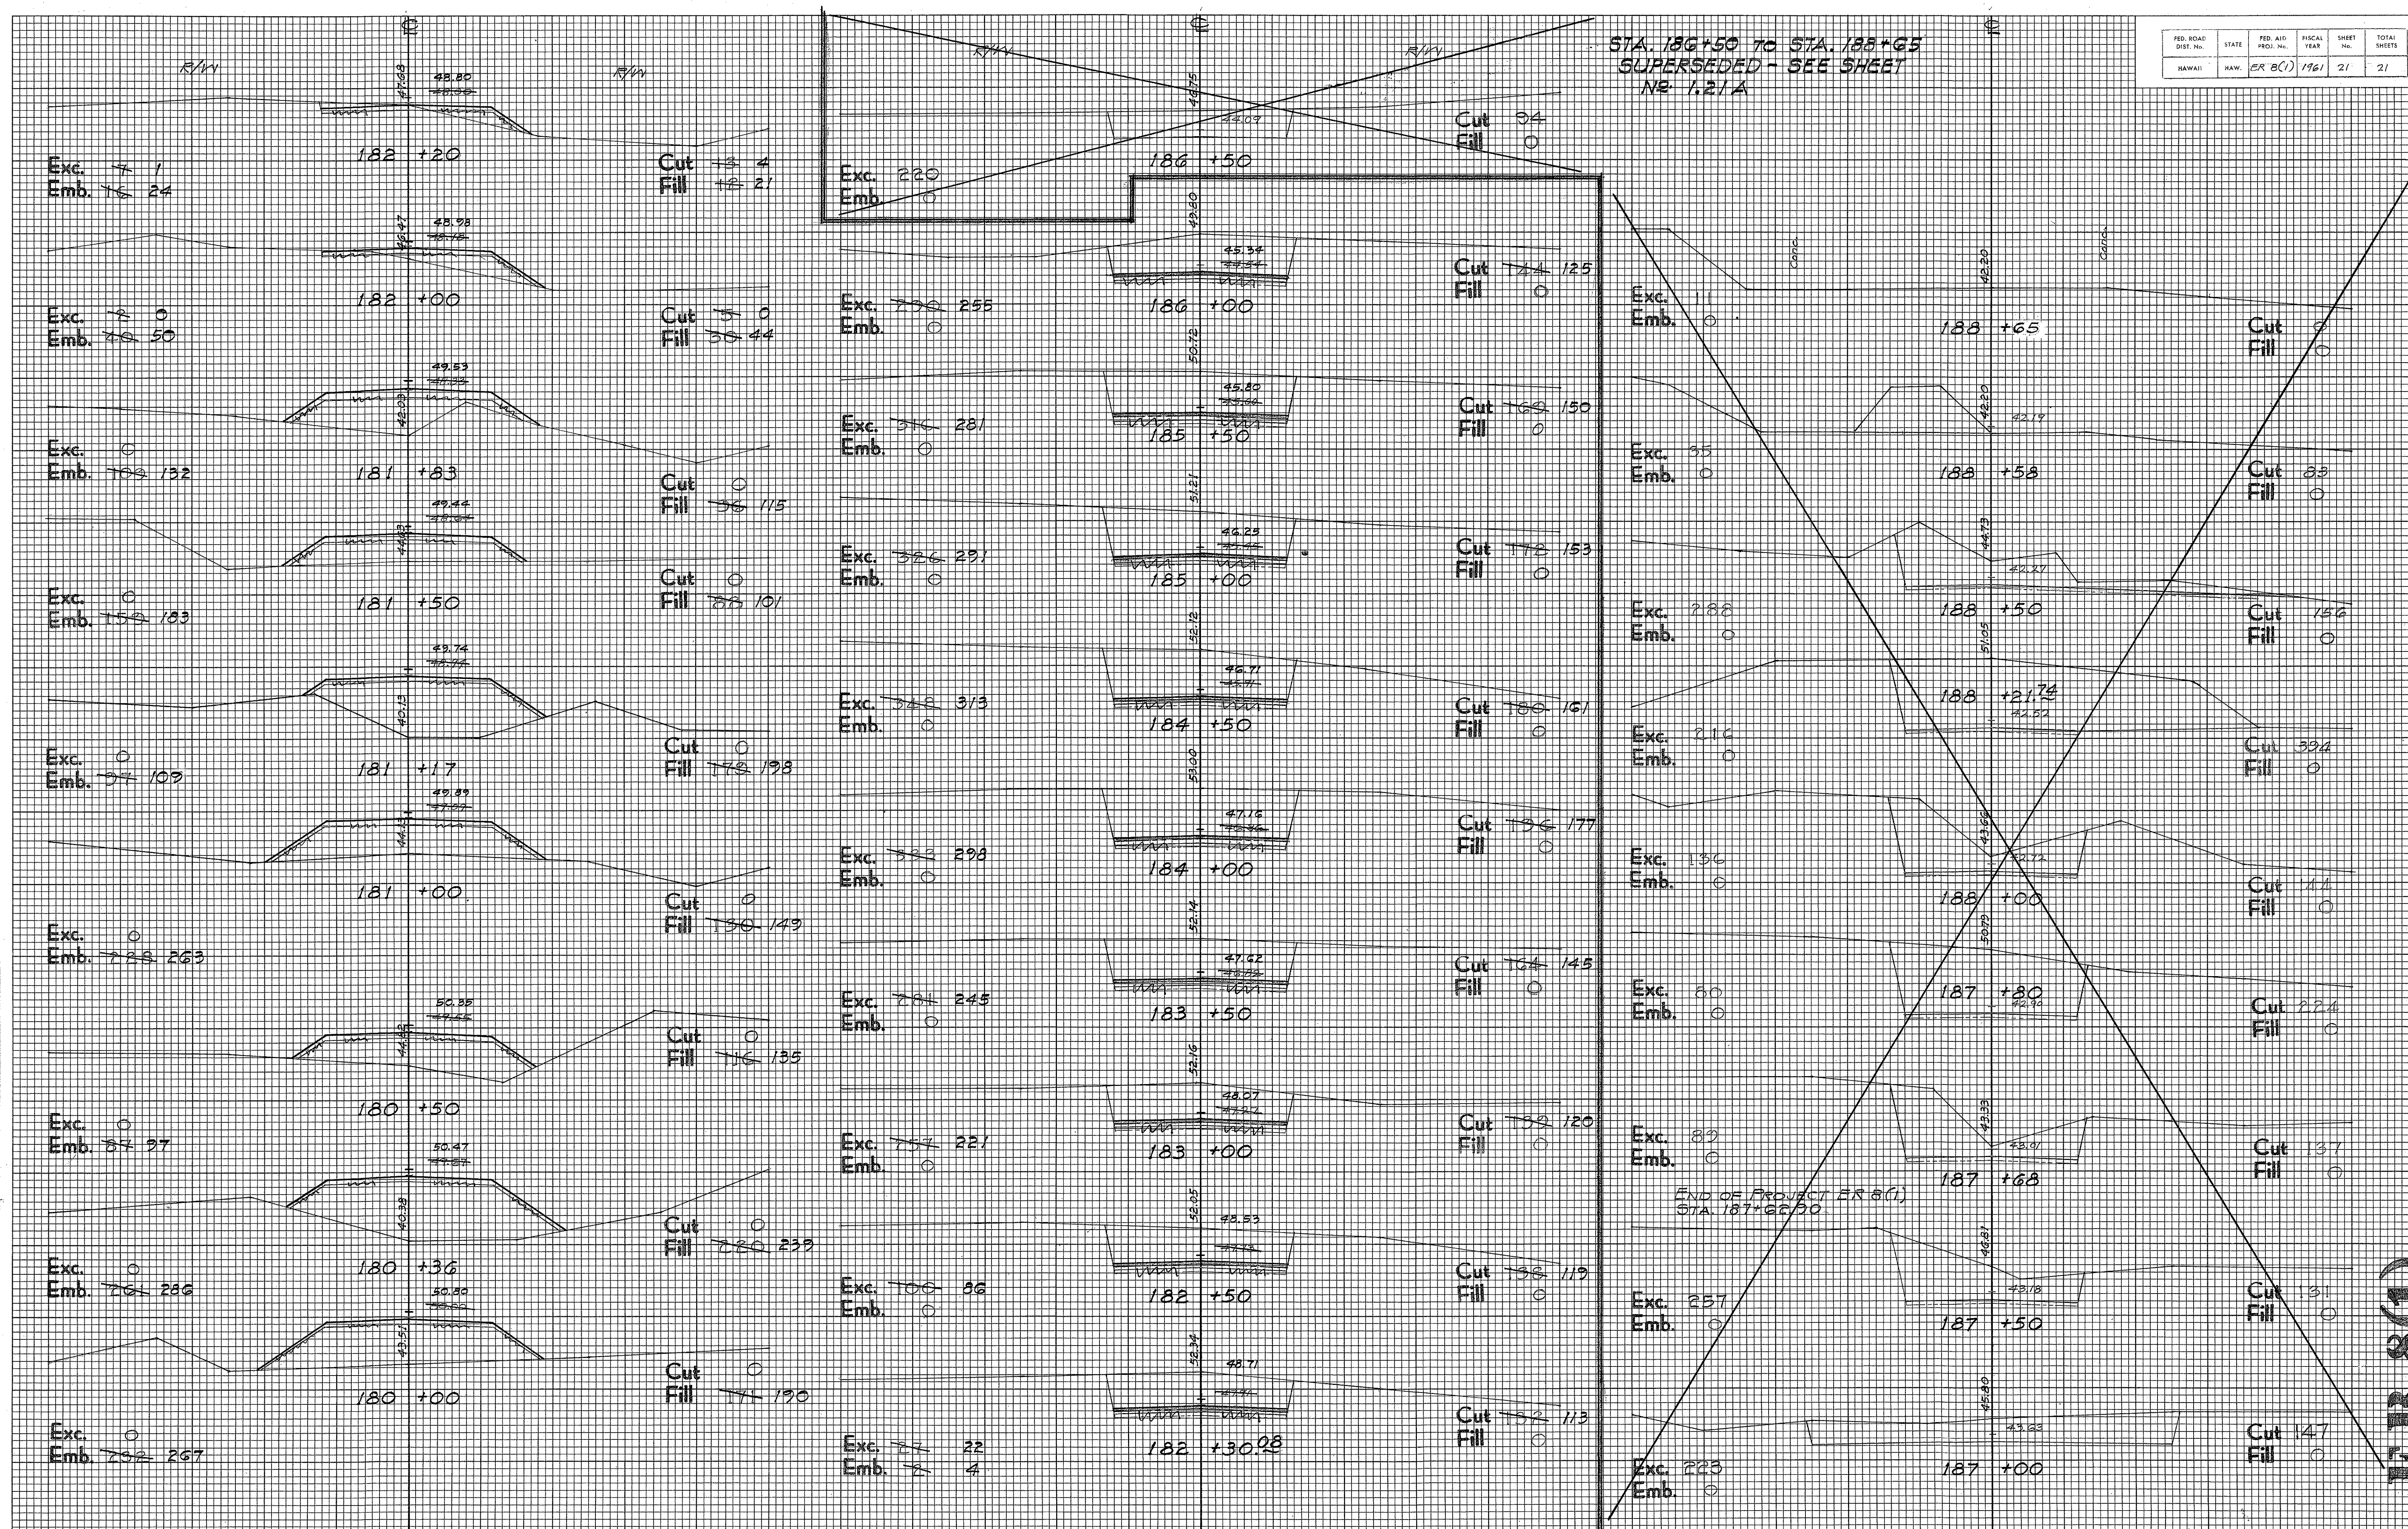

FINAL SURVEY	DATE
BURIED	BY
NOTE BOOK	
AREAS	
UNRECORDED	

ORIGINAL SURVEY	DATE
BURIED	BY
NOTE BOOK	
AREAS	
UNRECORDED	

