



DATE	STATE	NO. & NO.	FISCAL YEAR	SHEET NO.	TOTAL SHEETS
1960	HAWAII	G-2661-01-60	1960	3	13

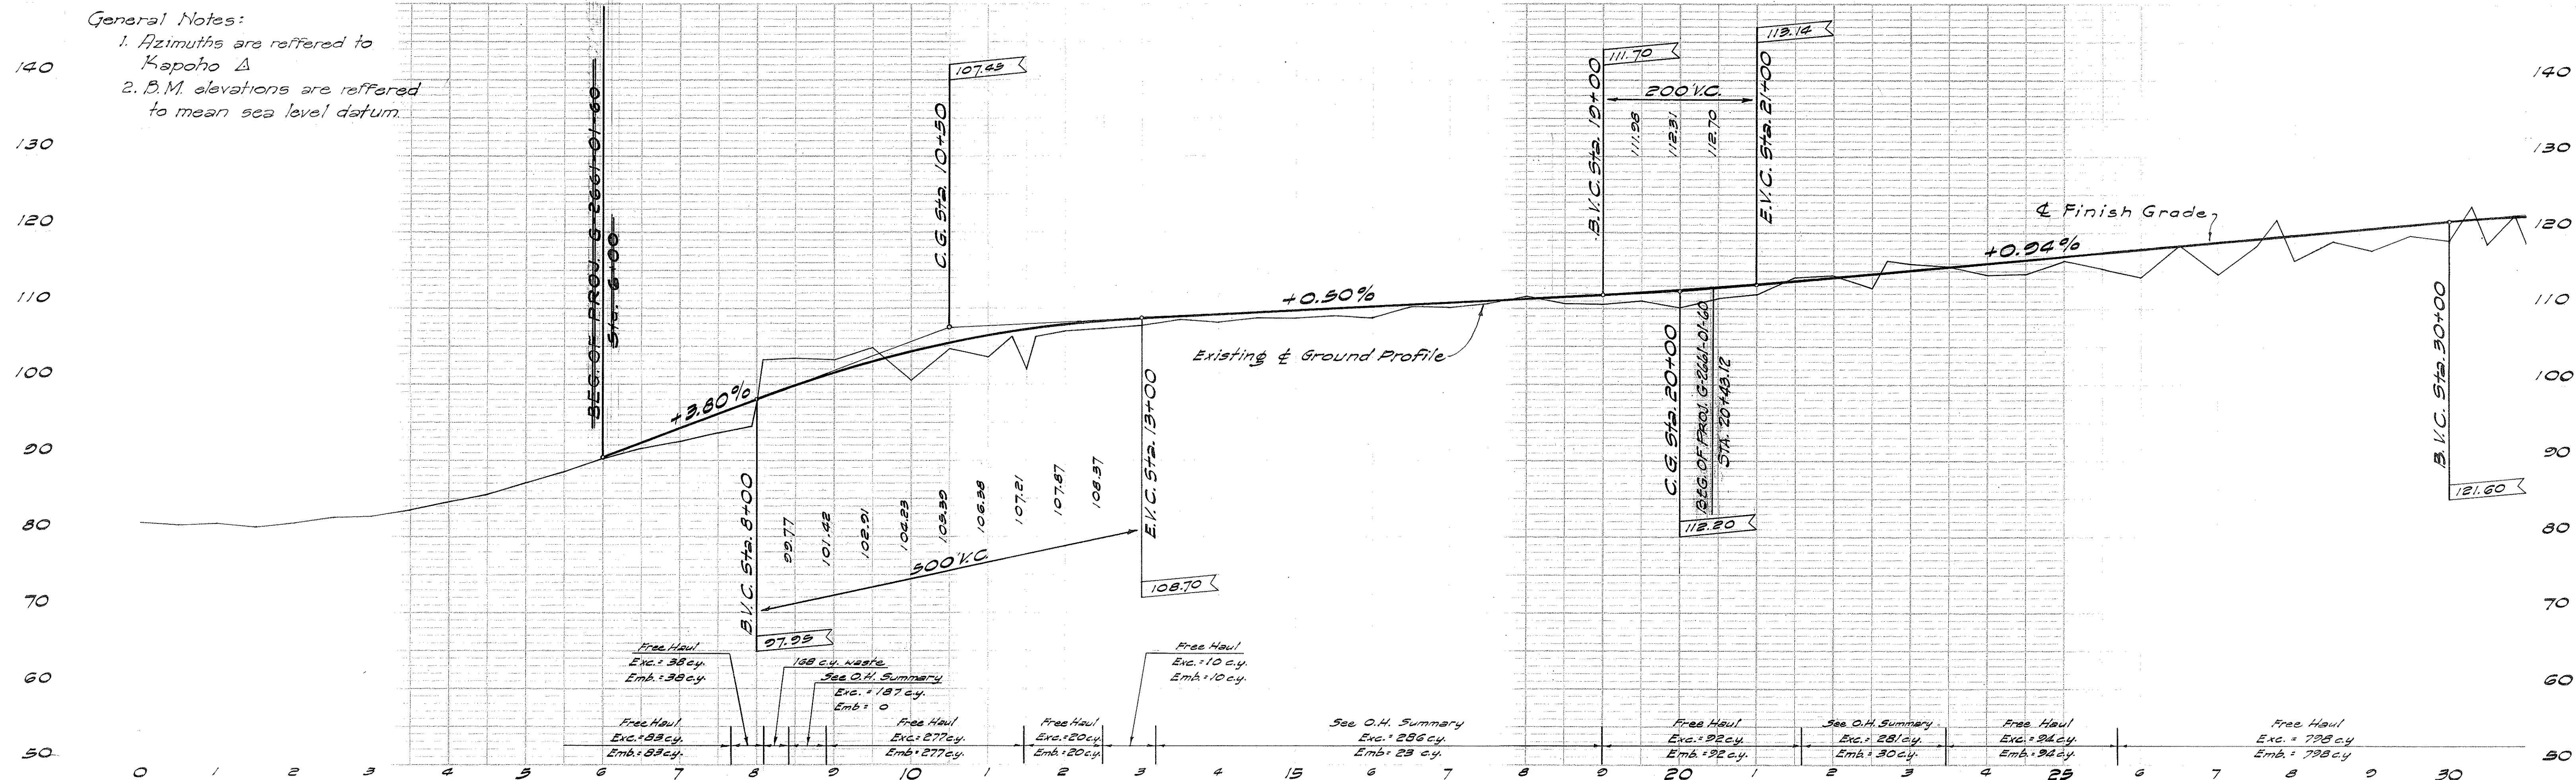

DIST.	STATE	PROJECT NO.	FISCAL YEAR	SHEET NO.	TOTAL SHEETS
HAWAII	HAW.	62661-0140	1960	4	12

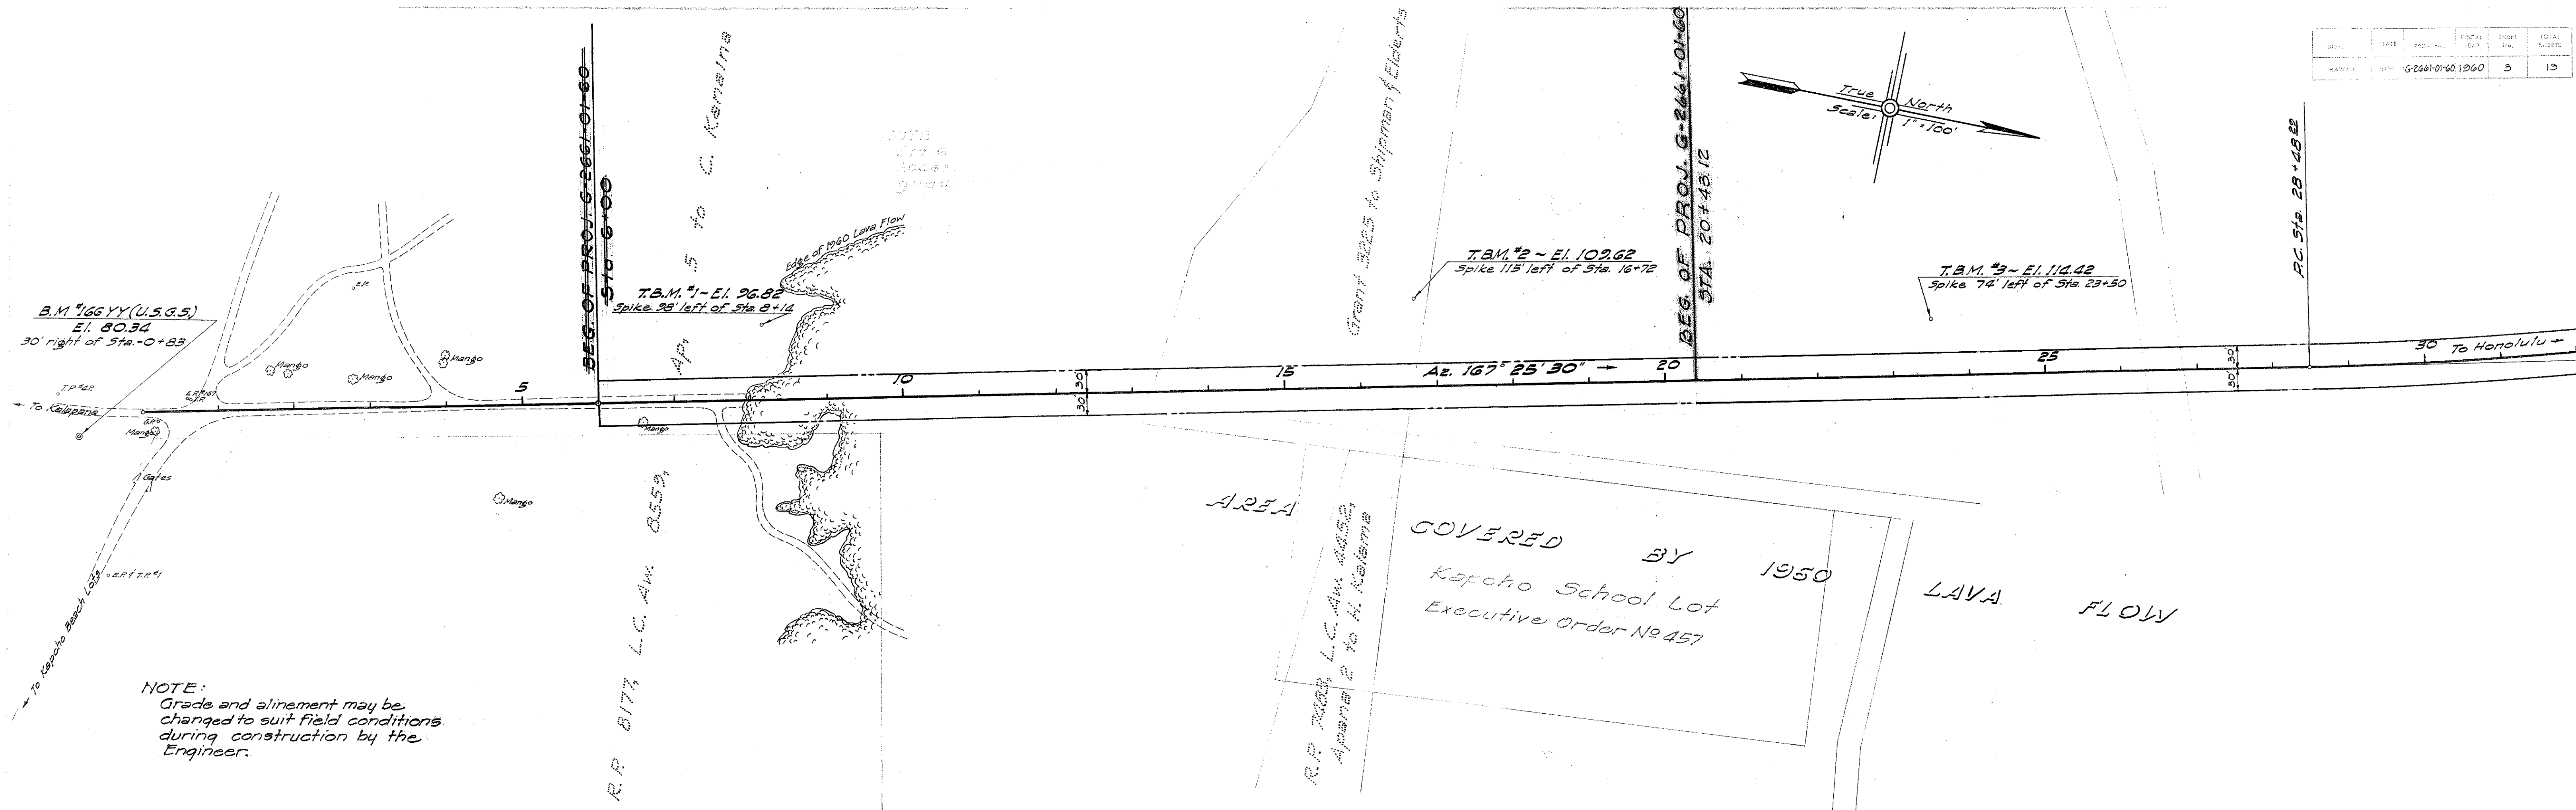