

INDEX TO DRAWINGS	
SHEET	DESCRIPTION
1	TITLE SHEET
2	TYPICAL SECTION
3-5	PLAN AND PROFILE
6-13	CROSS SECTIONS

STATE OF HAWAII

DEPARTMENT OF TRANSPORTATION

DIVISION OF HIGHWAYS

PLANS OF

KAPOHO - HONOLULU ROAD

(KAPOHO SCHOOL TO KOAE)

PROJECT NO. G-2661-01-60

DISTRICT OF PUNA

ISLAND OF HAWAII

PLAN

1 INCH = 100 FT.

PROFILE



HOR. 1 INCH = 100 FT.

VER. 1 INCH = 10 FT.

CROSS SECTION

HOR. 1 INCH = 10 FT.

VER. 1 INCH = 10 FT.

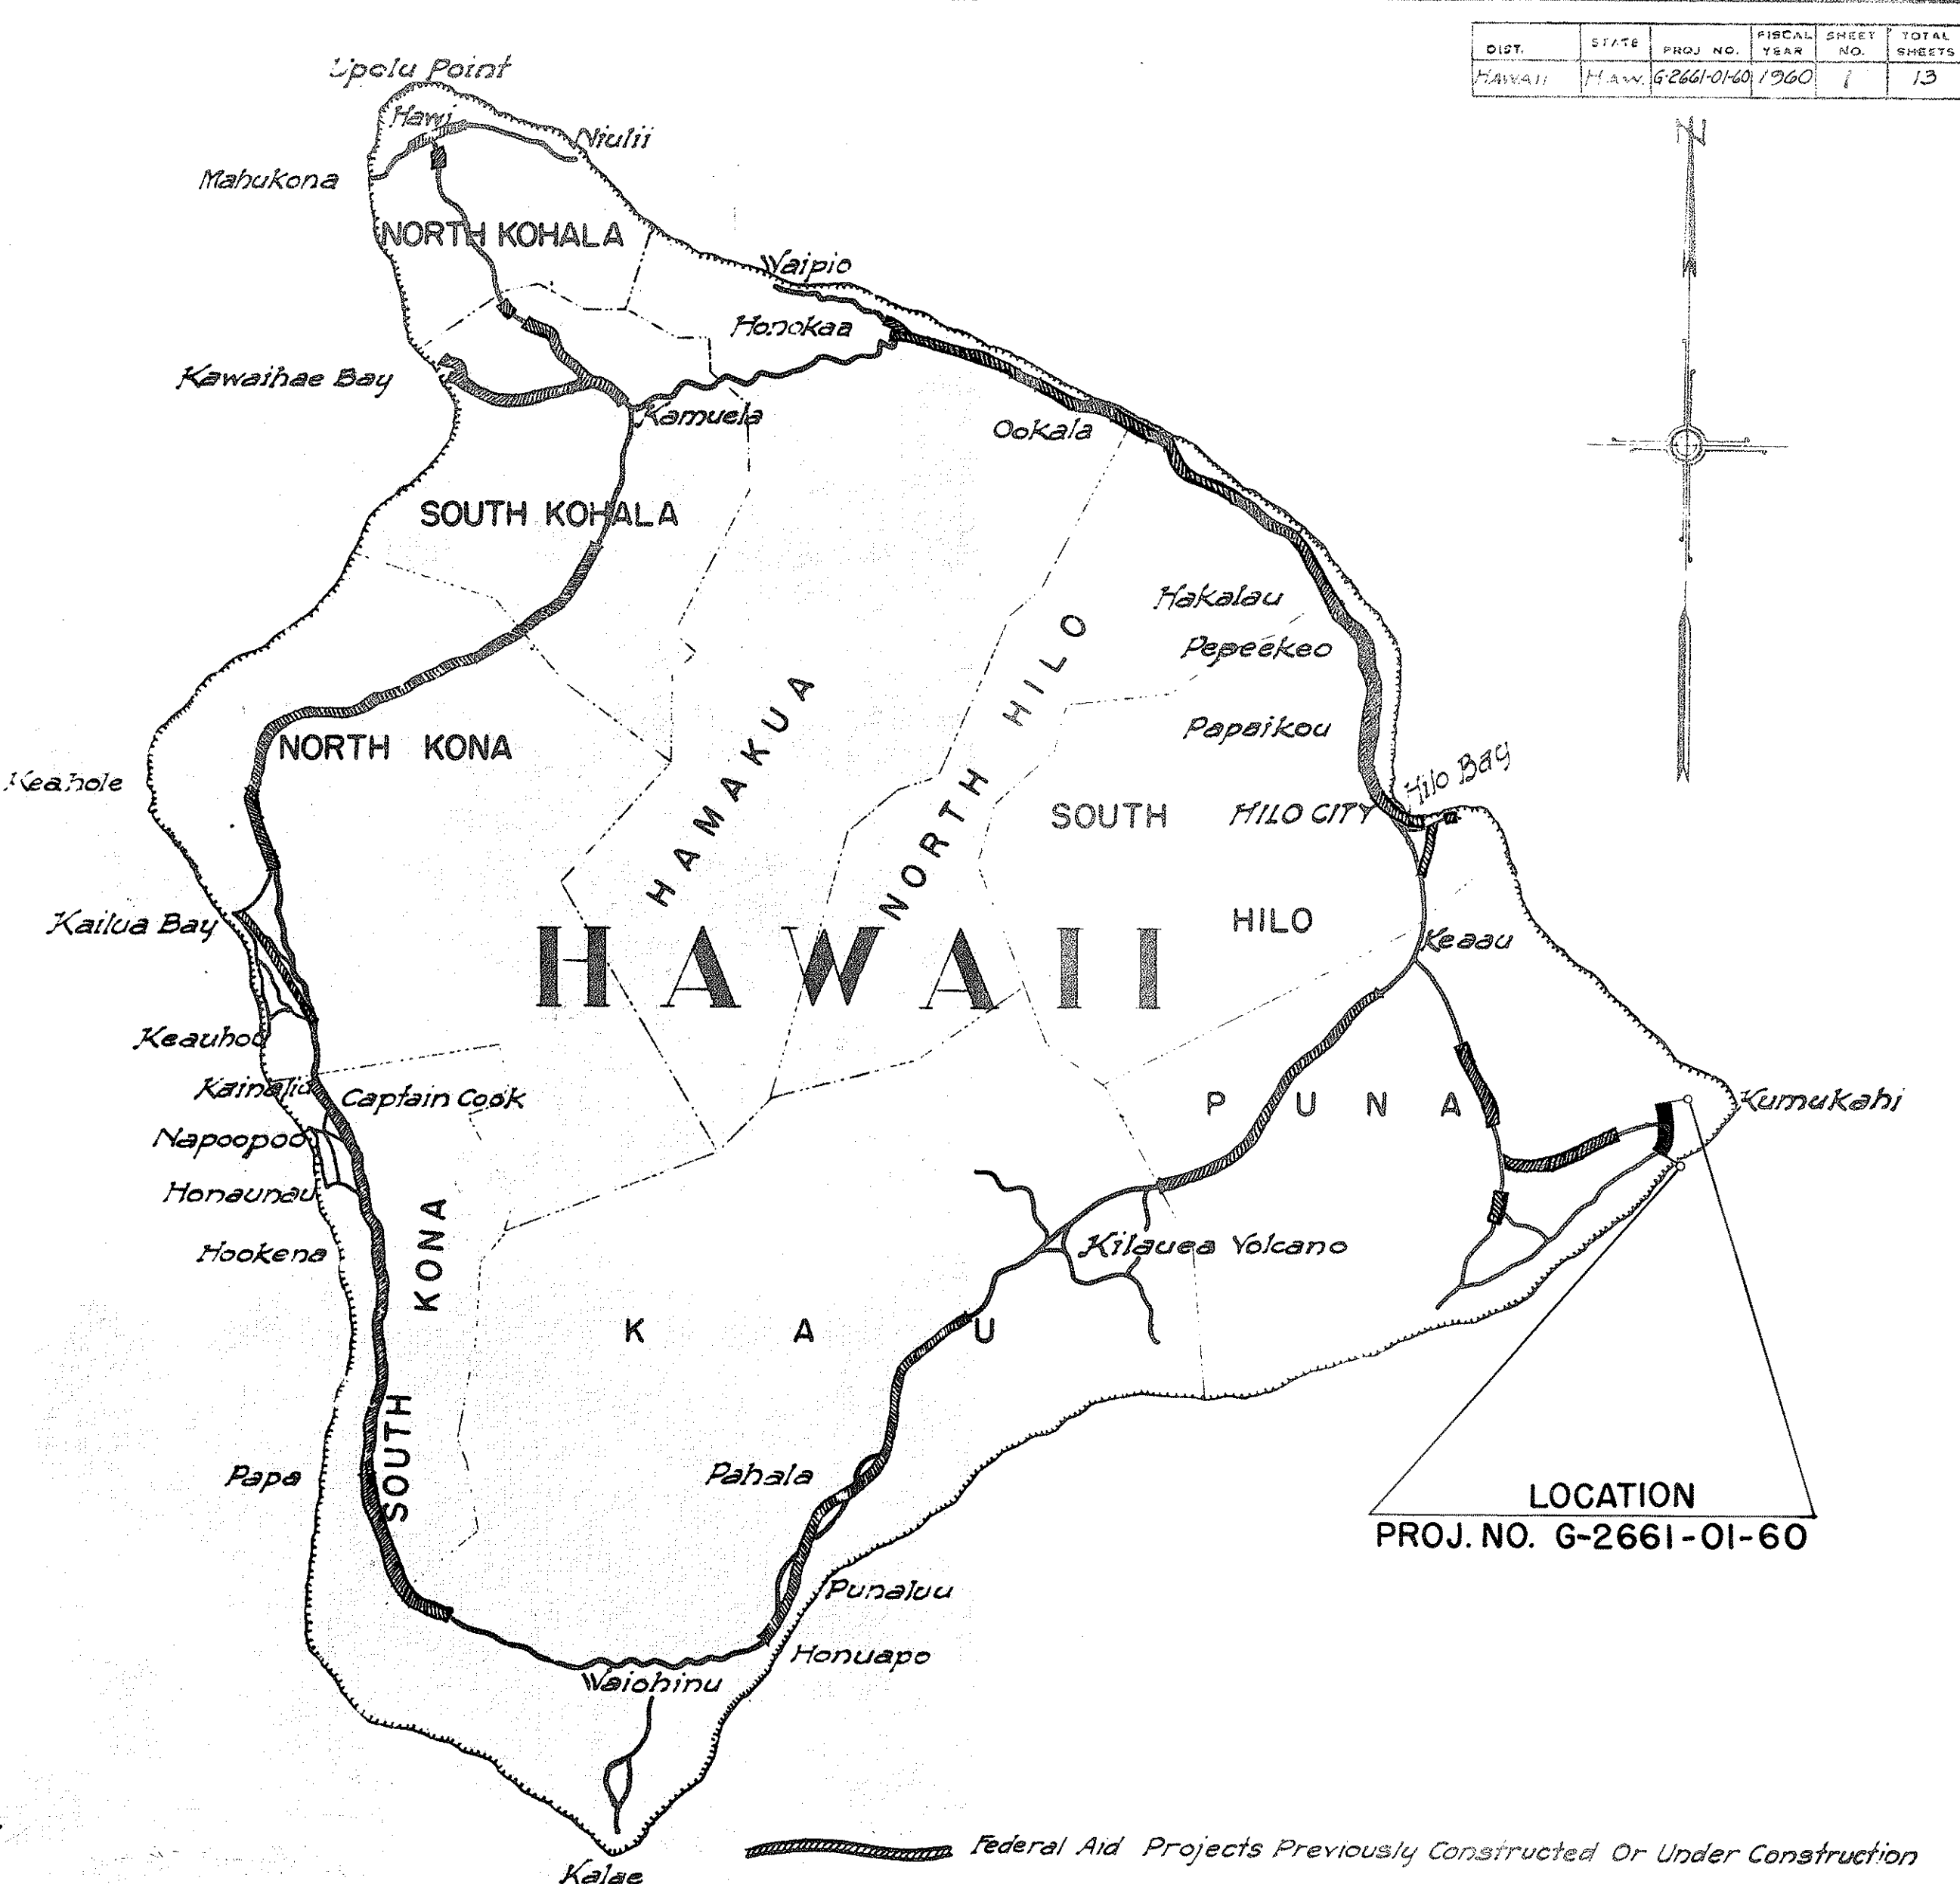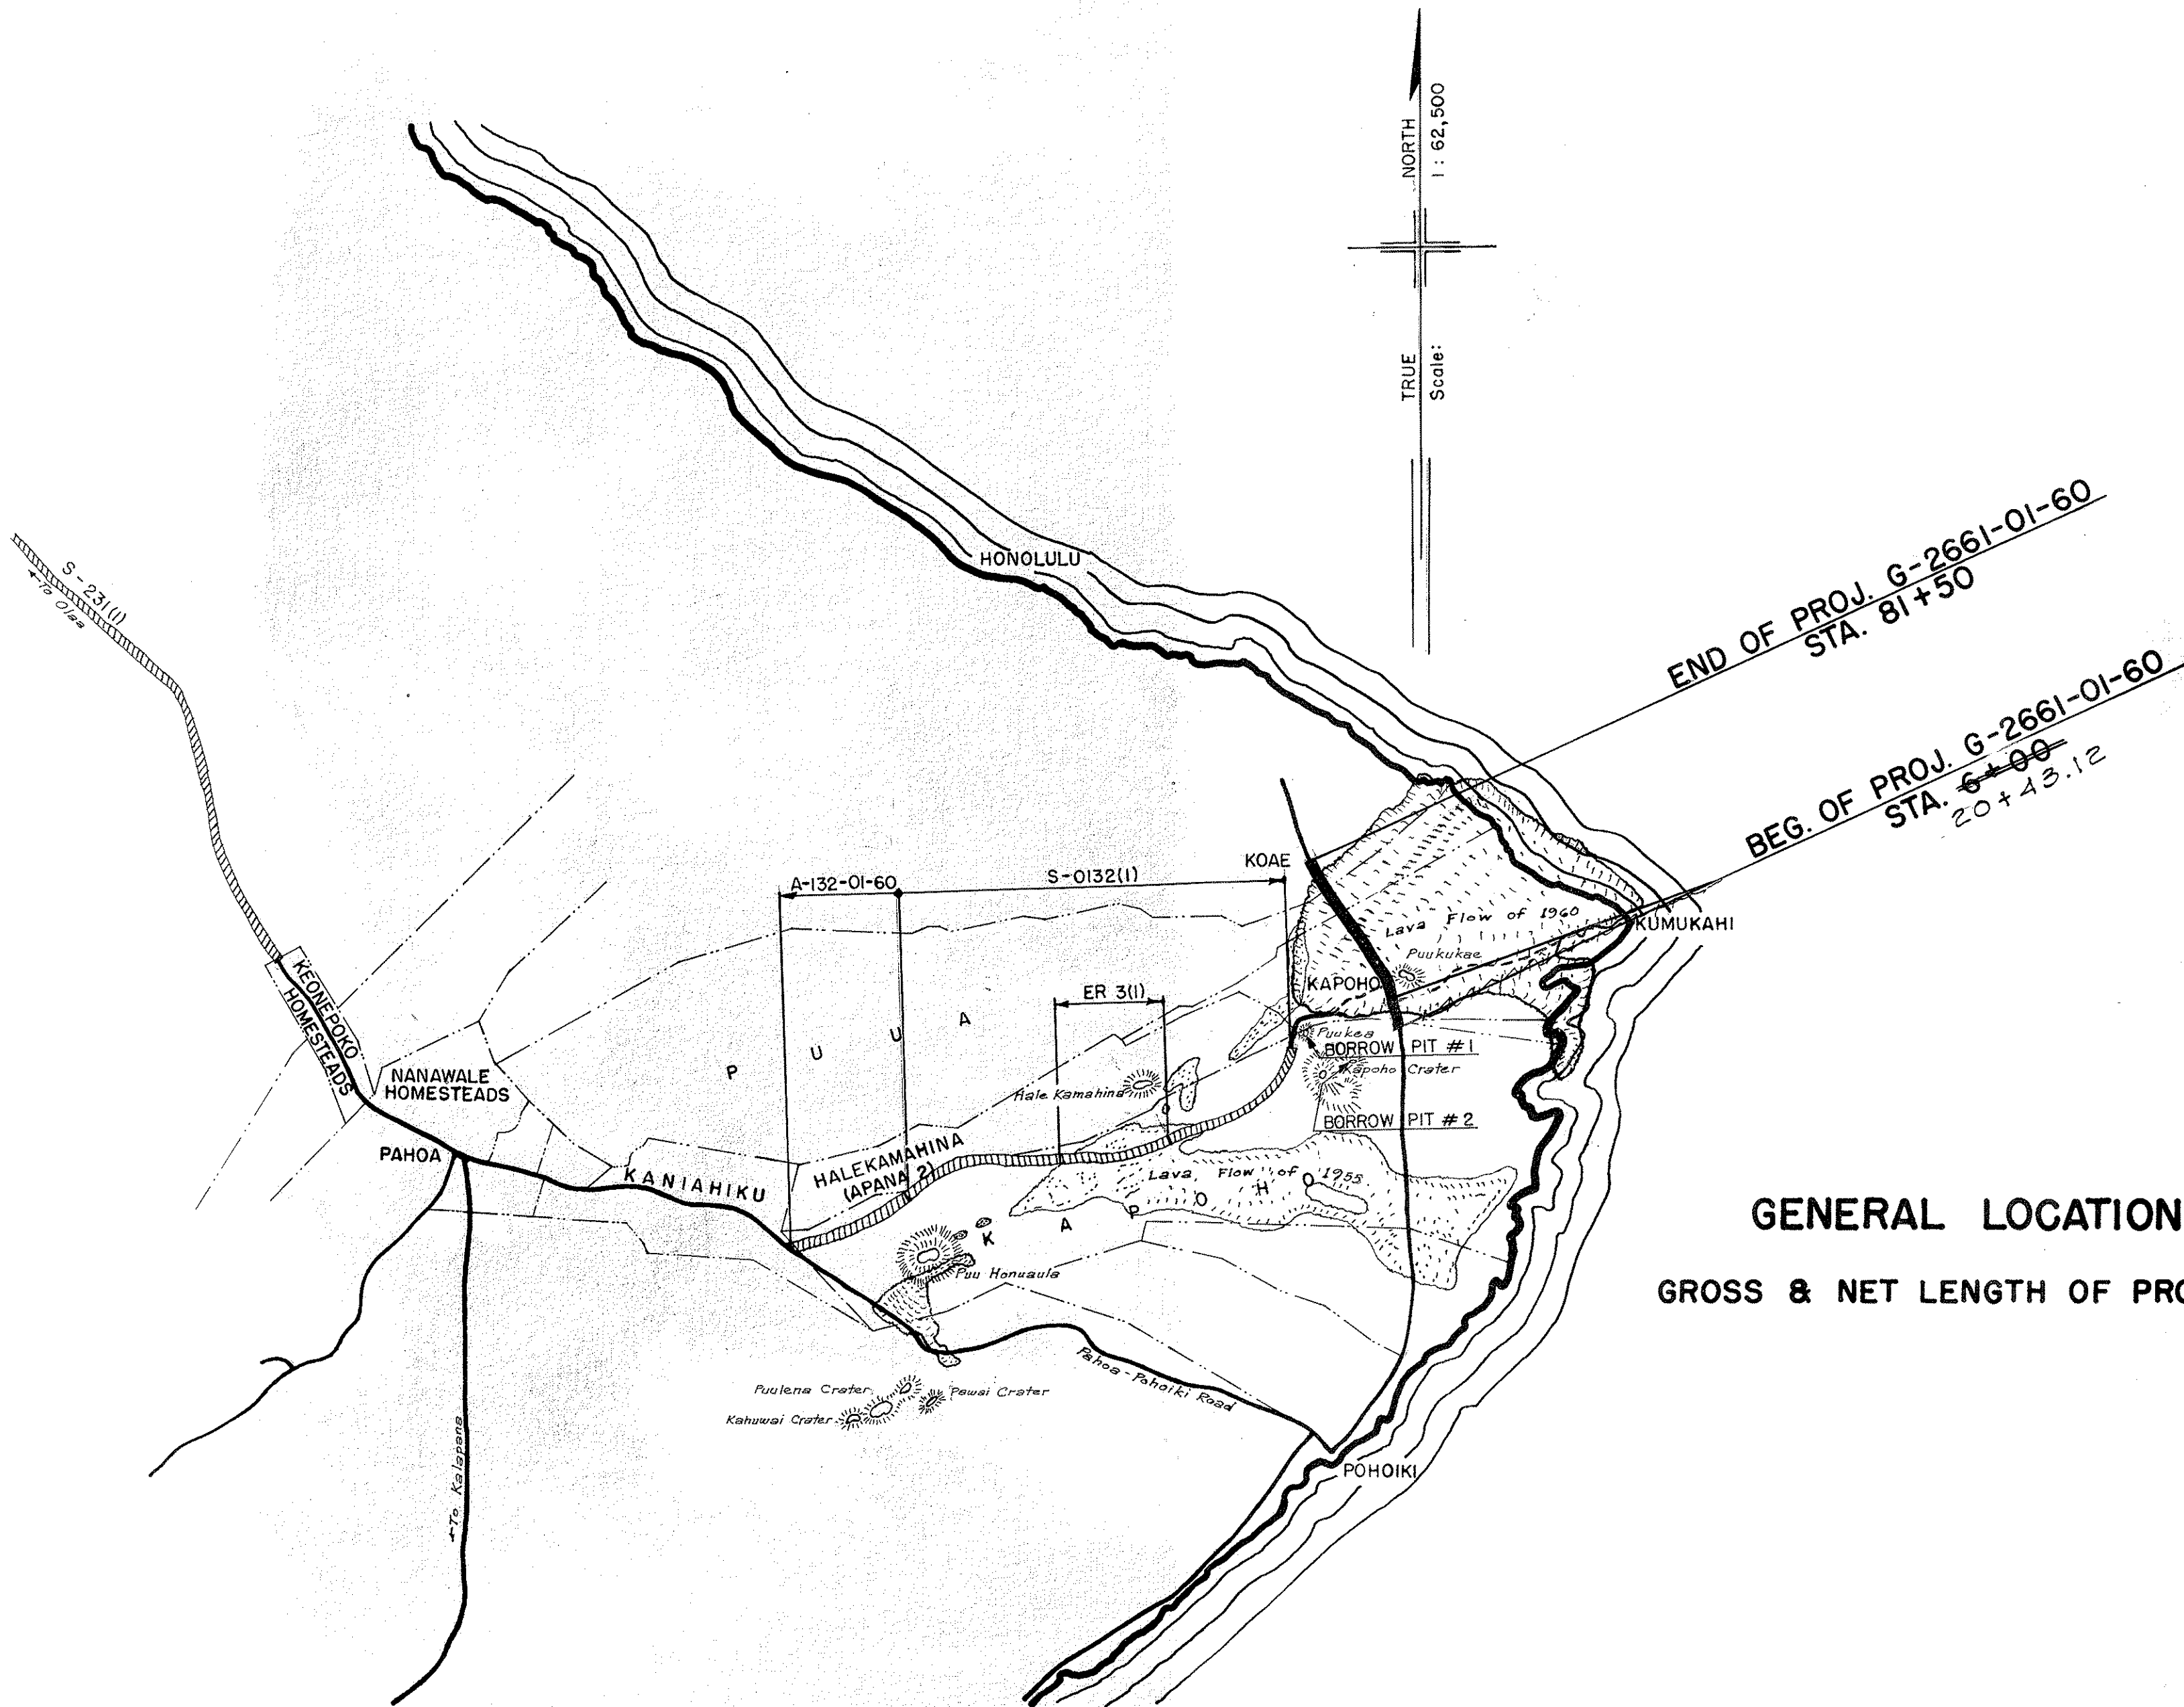

Note:
All changes made during construction
have been noted in these tracings in
red and checked by:

Date:

GENERAL LOCATION PLAN

GROSS & NET LENGTH OF PROJECT: 1.157 MILES

APPROVED:

DATE 9/26/60

[Signature]

DIRECTOR OF TRANSPORTATION