


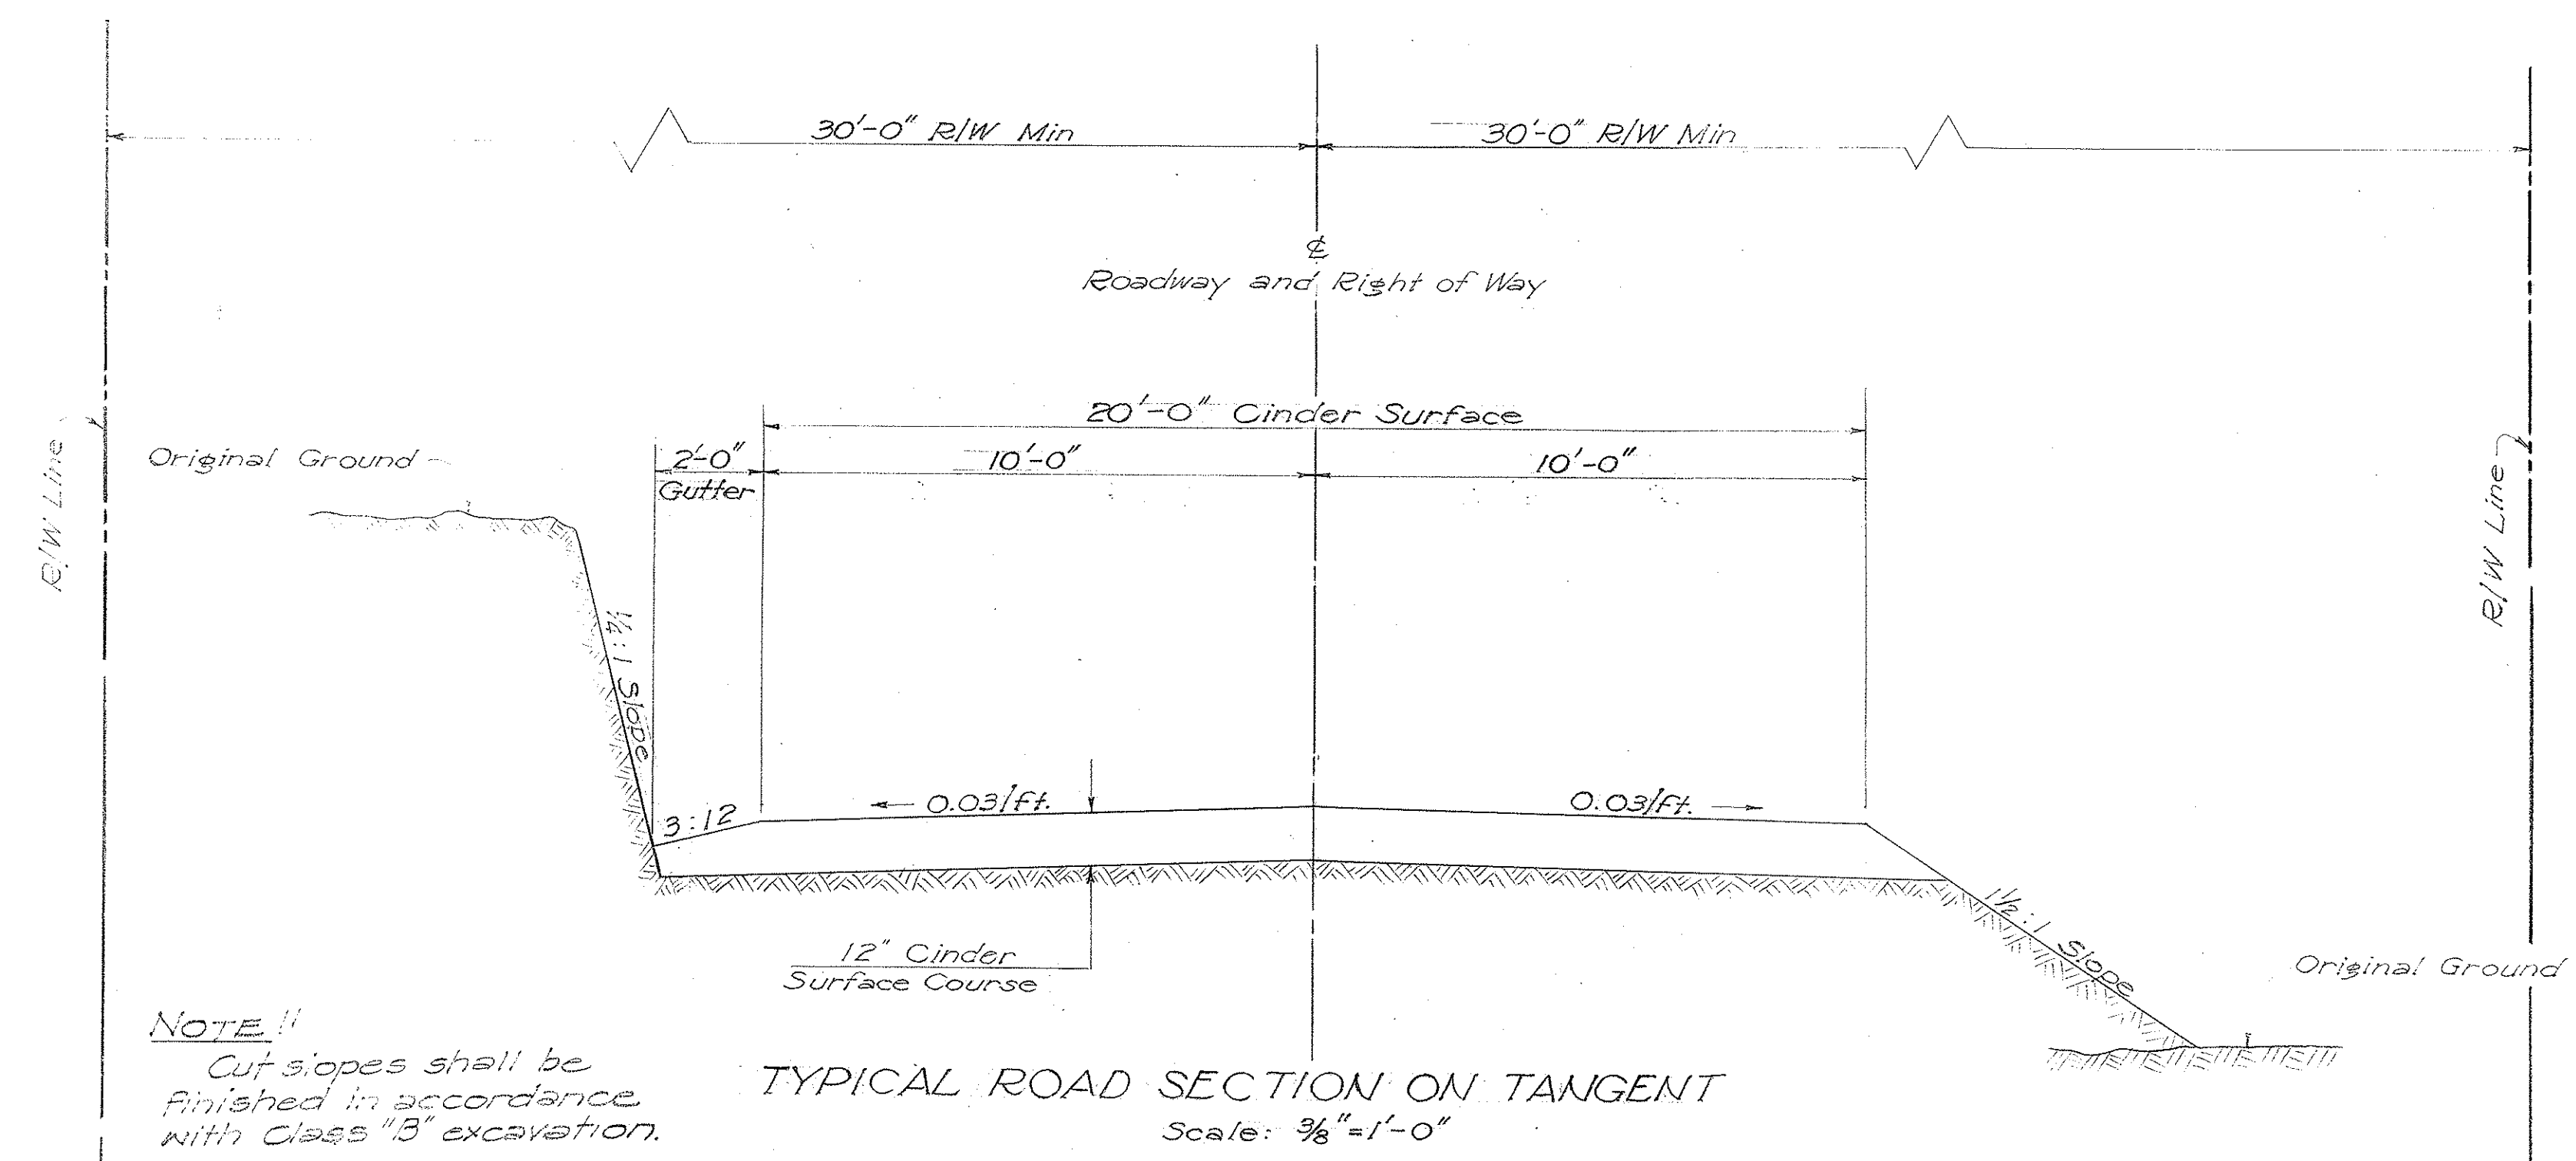


NOTE:
Cut slopes shall be finished in accordance with Class "B" excavation.

NOTE: Fill slopes shall be flattened as per Fill Slope Table with excess material where ordered by the Engineer.

FILL SLOPE TABLE

0'-4'	4:1 Slope
4'-10'	3:1 to 2:1 Slope
10'-Over	1 1/2:1 Slope

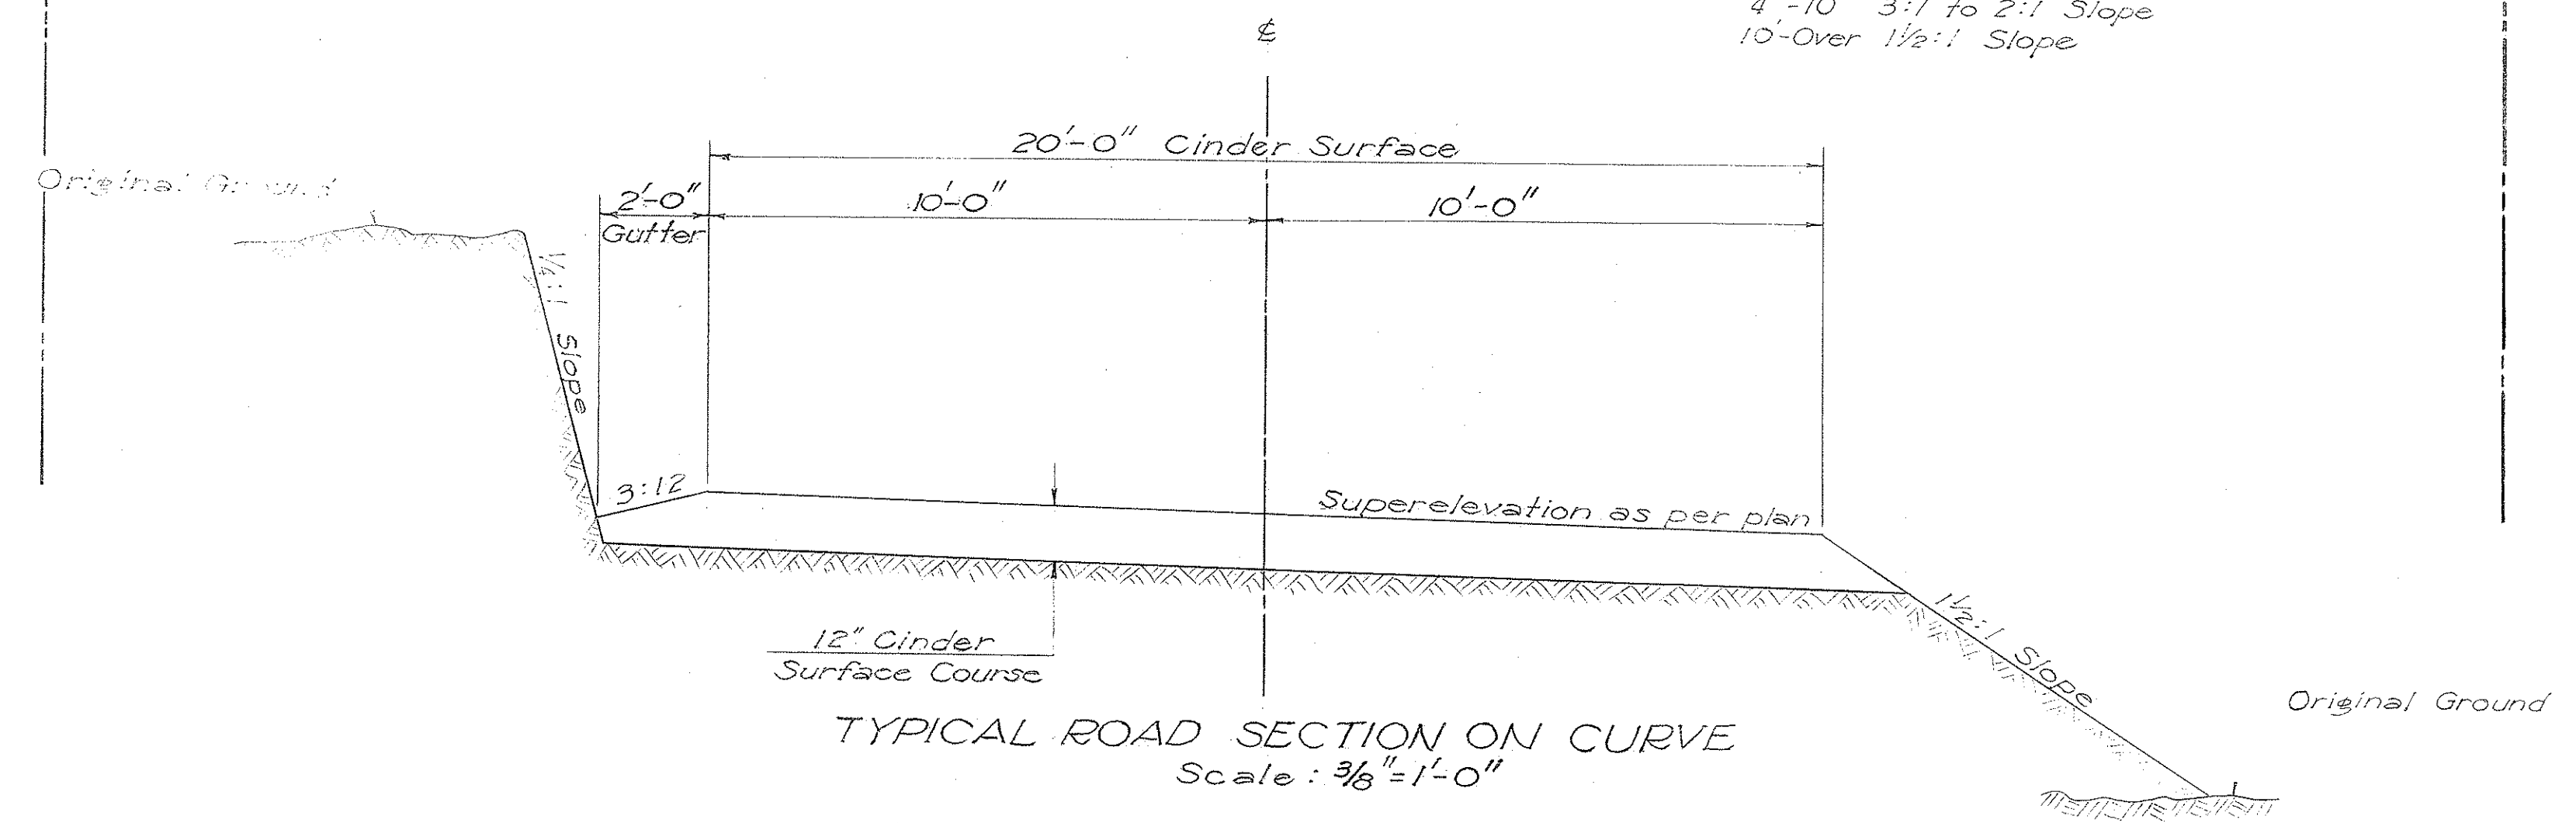

ESTIMATED QUANTITIES

Roadway Excavation	9,500 c.y.	12,926 c.y.
Mile Yard Overhaul	700 mi.yd.	0
Sprinkling	430 Mgal.	105 Mgal.
Cinder Road Surfacing	10,150 cu.yd.	11,472 c.y.