


FINAL SURVEY	BY	DATE
SURVEYED		
PLOTTED		
NOTE BOOK		
AREAS CHECKED		

ORIGINAL SURVEY	BY	DATE
SURVEYED		
PLOTTED		
NOTE BOOK		
AREAS CHECKED		


FED. ROAD DIST. NO.	STATE	PROJ. NO.	FISCAL YEAR	SHEET NO.	TOTAL SHEETS
HAWAII	HAW.	LT-H-02-79	1980	8	12

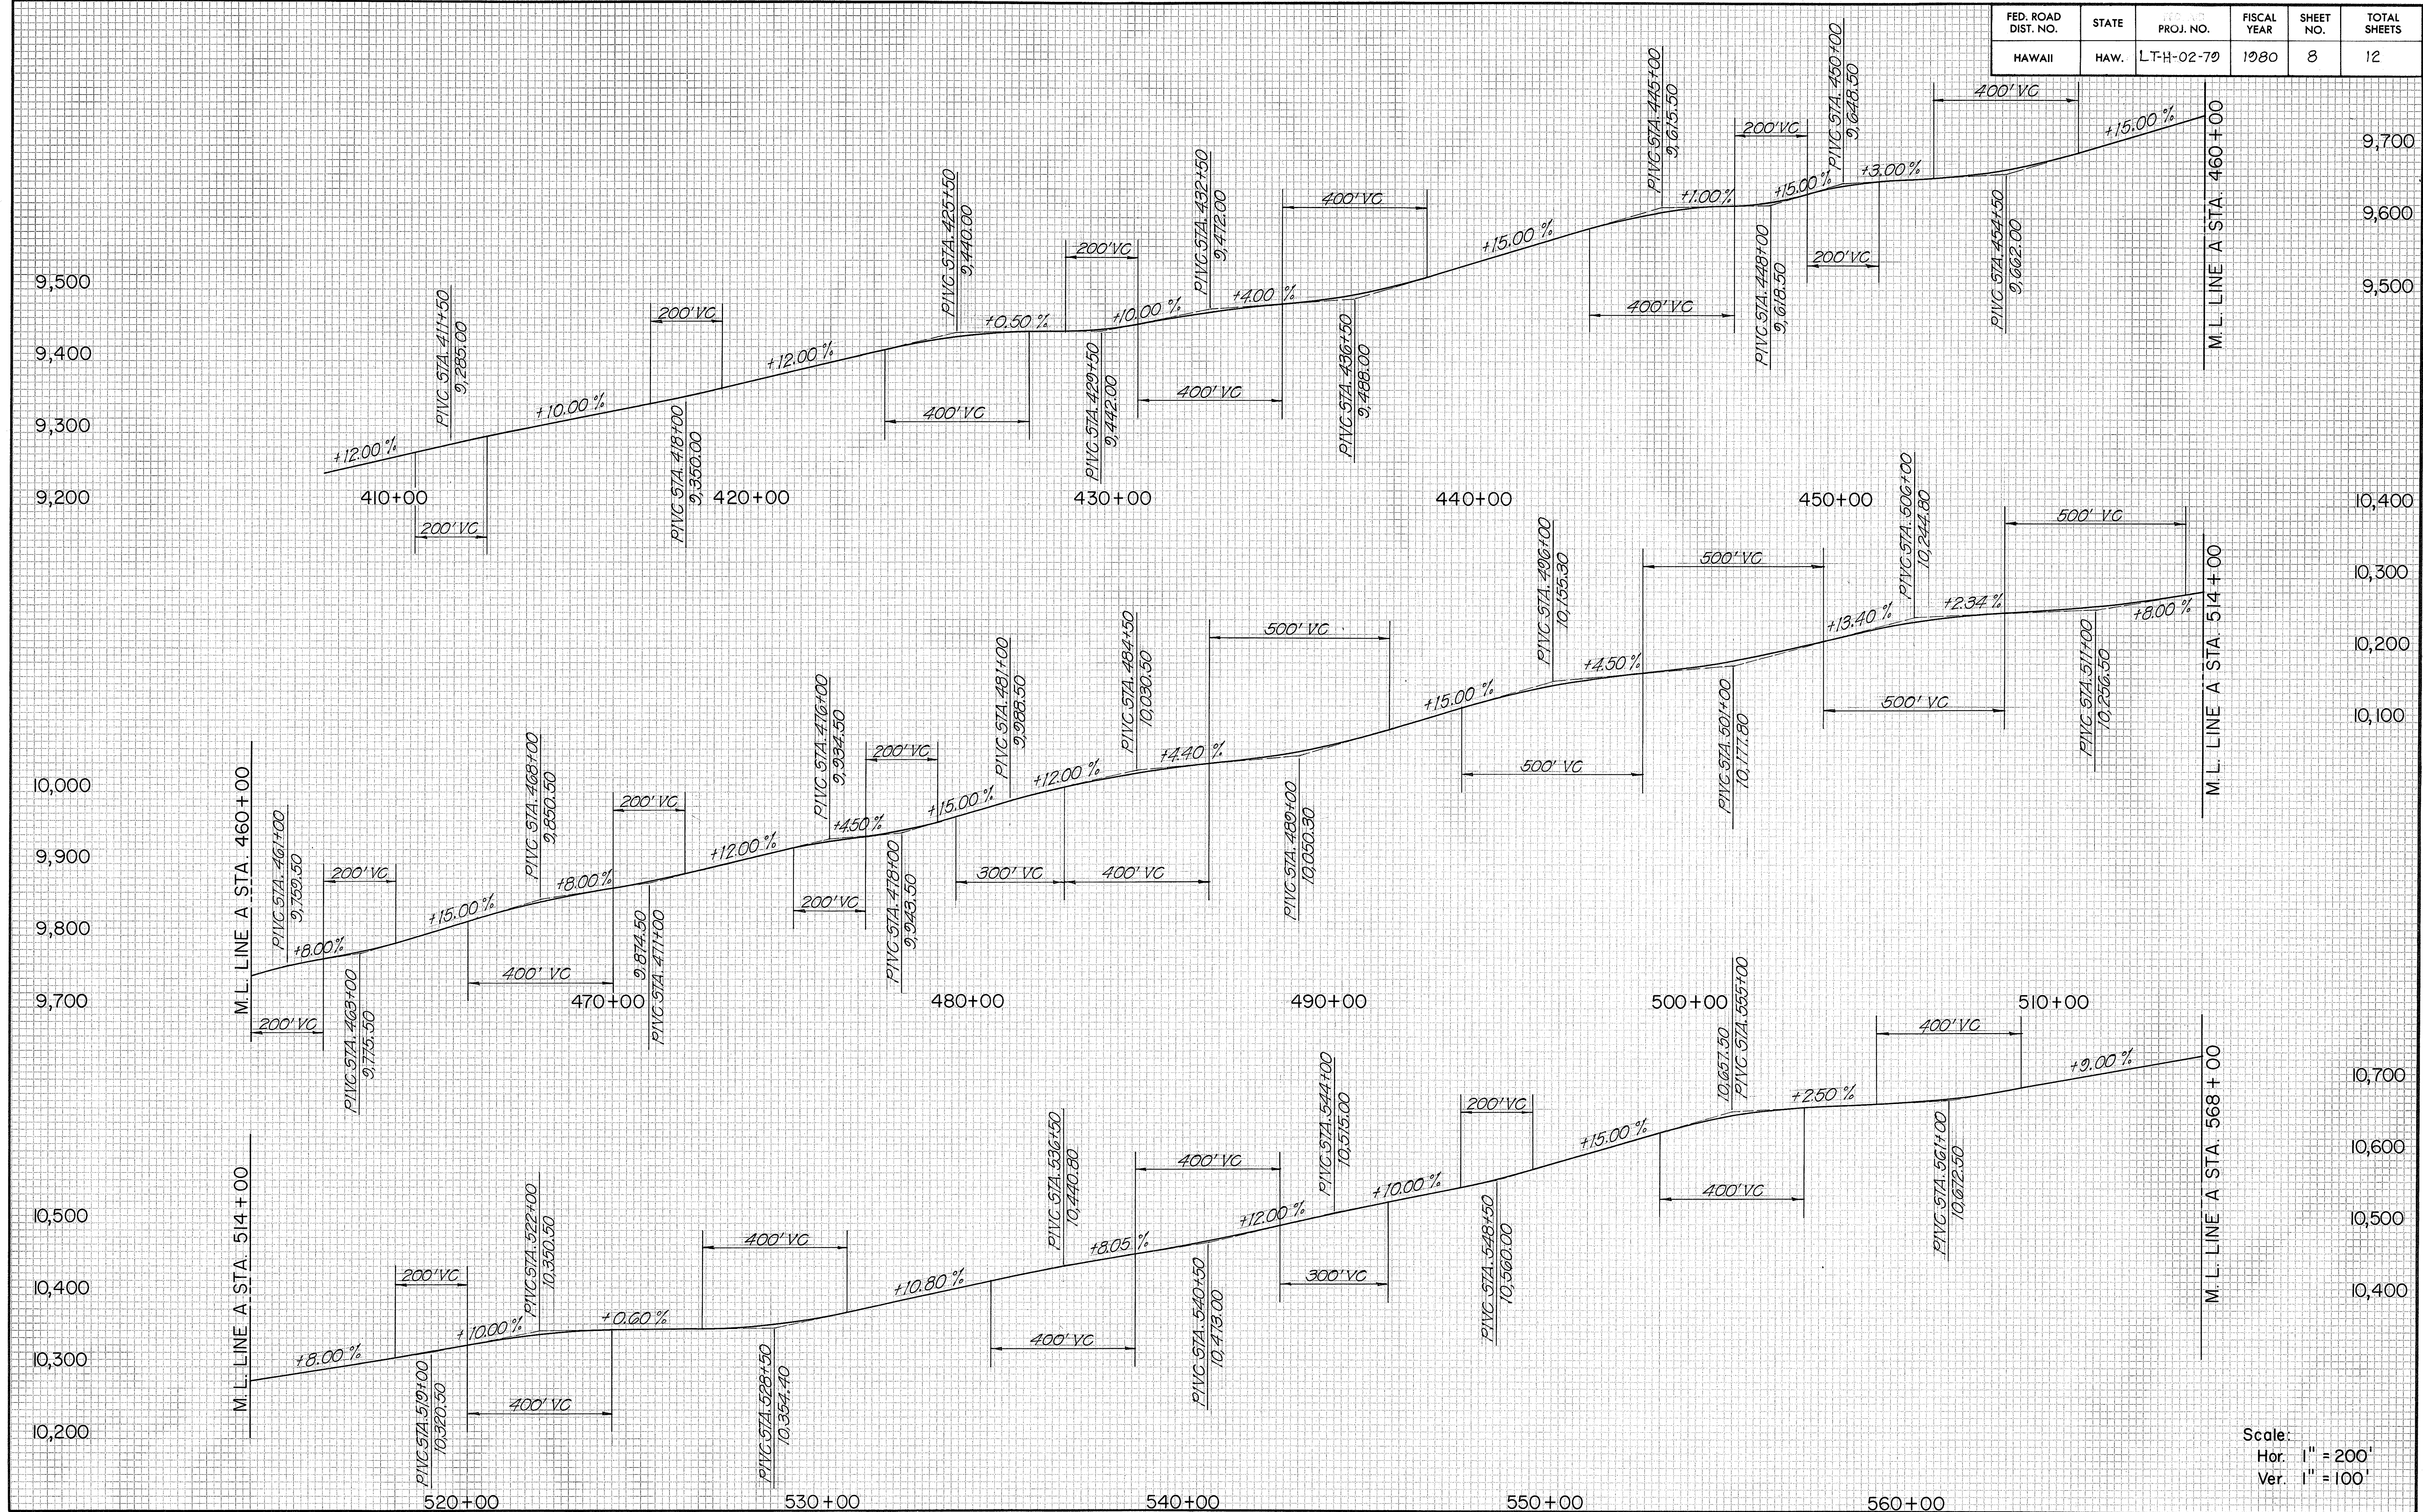

Scale:
 Hor. 1" = 200'
 Ver. 1" = 100'

ORIGINAL SURVEY	DATE
SURVEYED	BY
PLOTTED	
NOTE BOOK	
NO.	

ORIGINAL SURVEY	DATE
SURVEYED	BY
PLOTTED	
NOTE BOOK	
NO.	

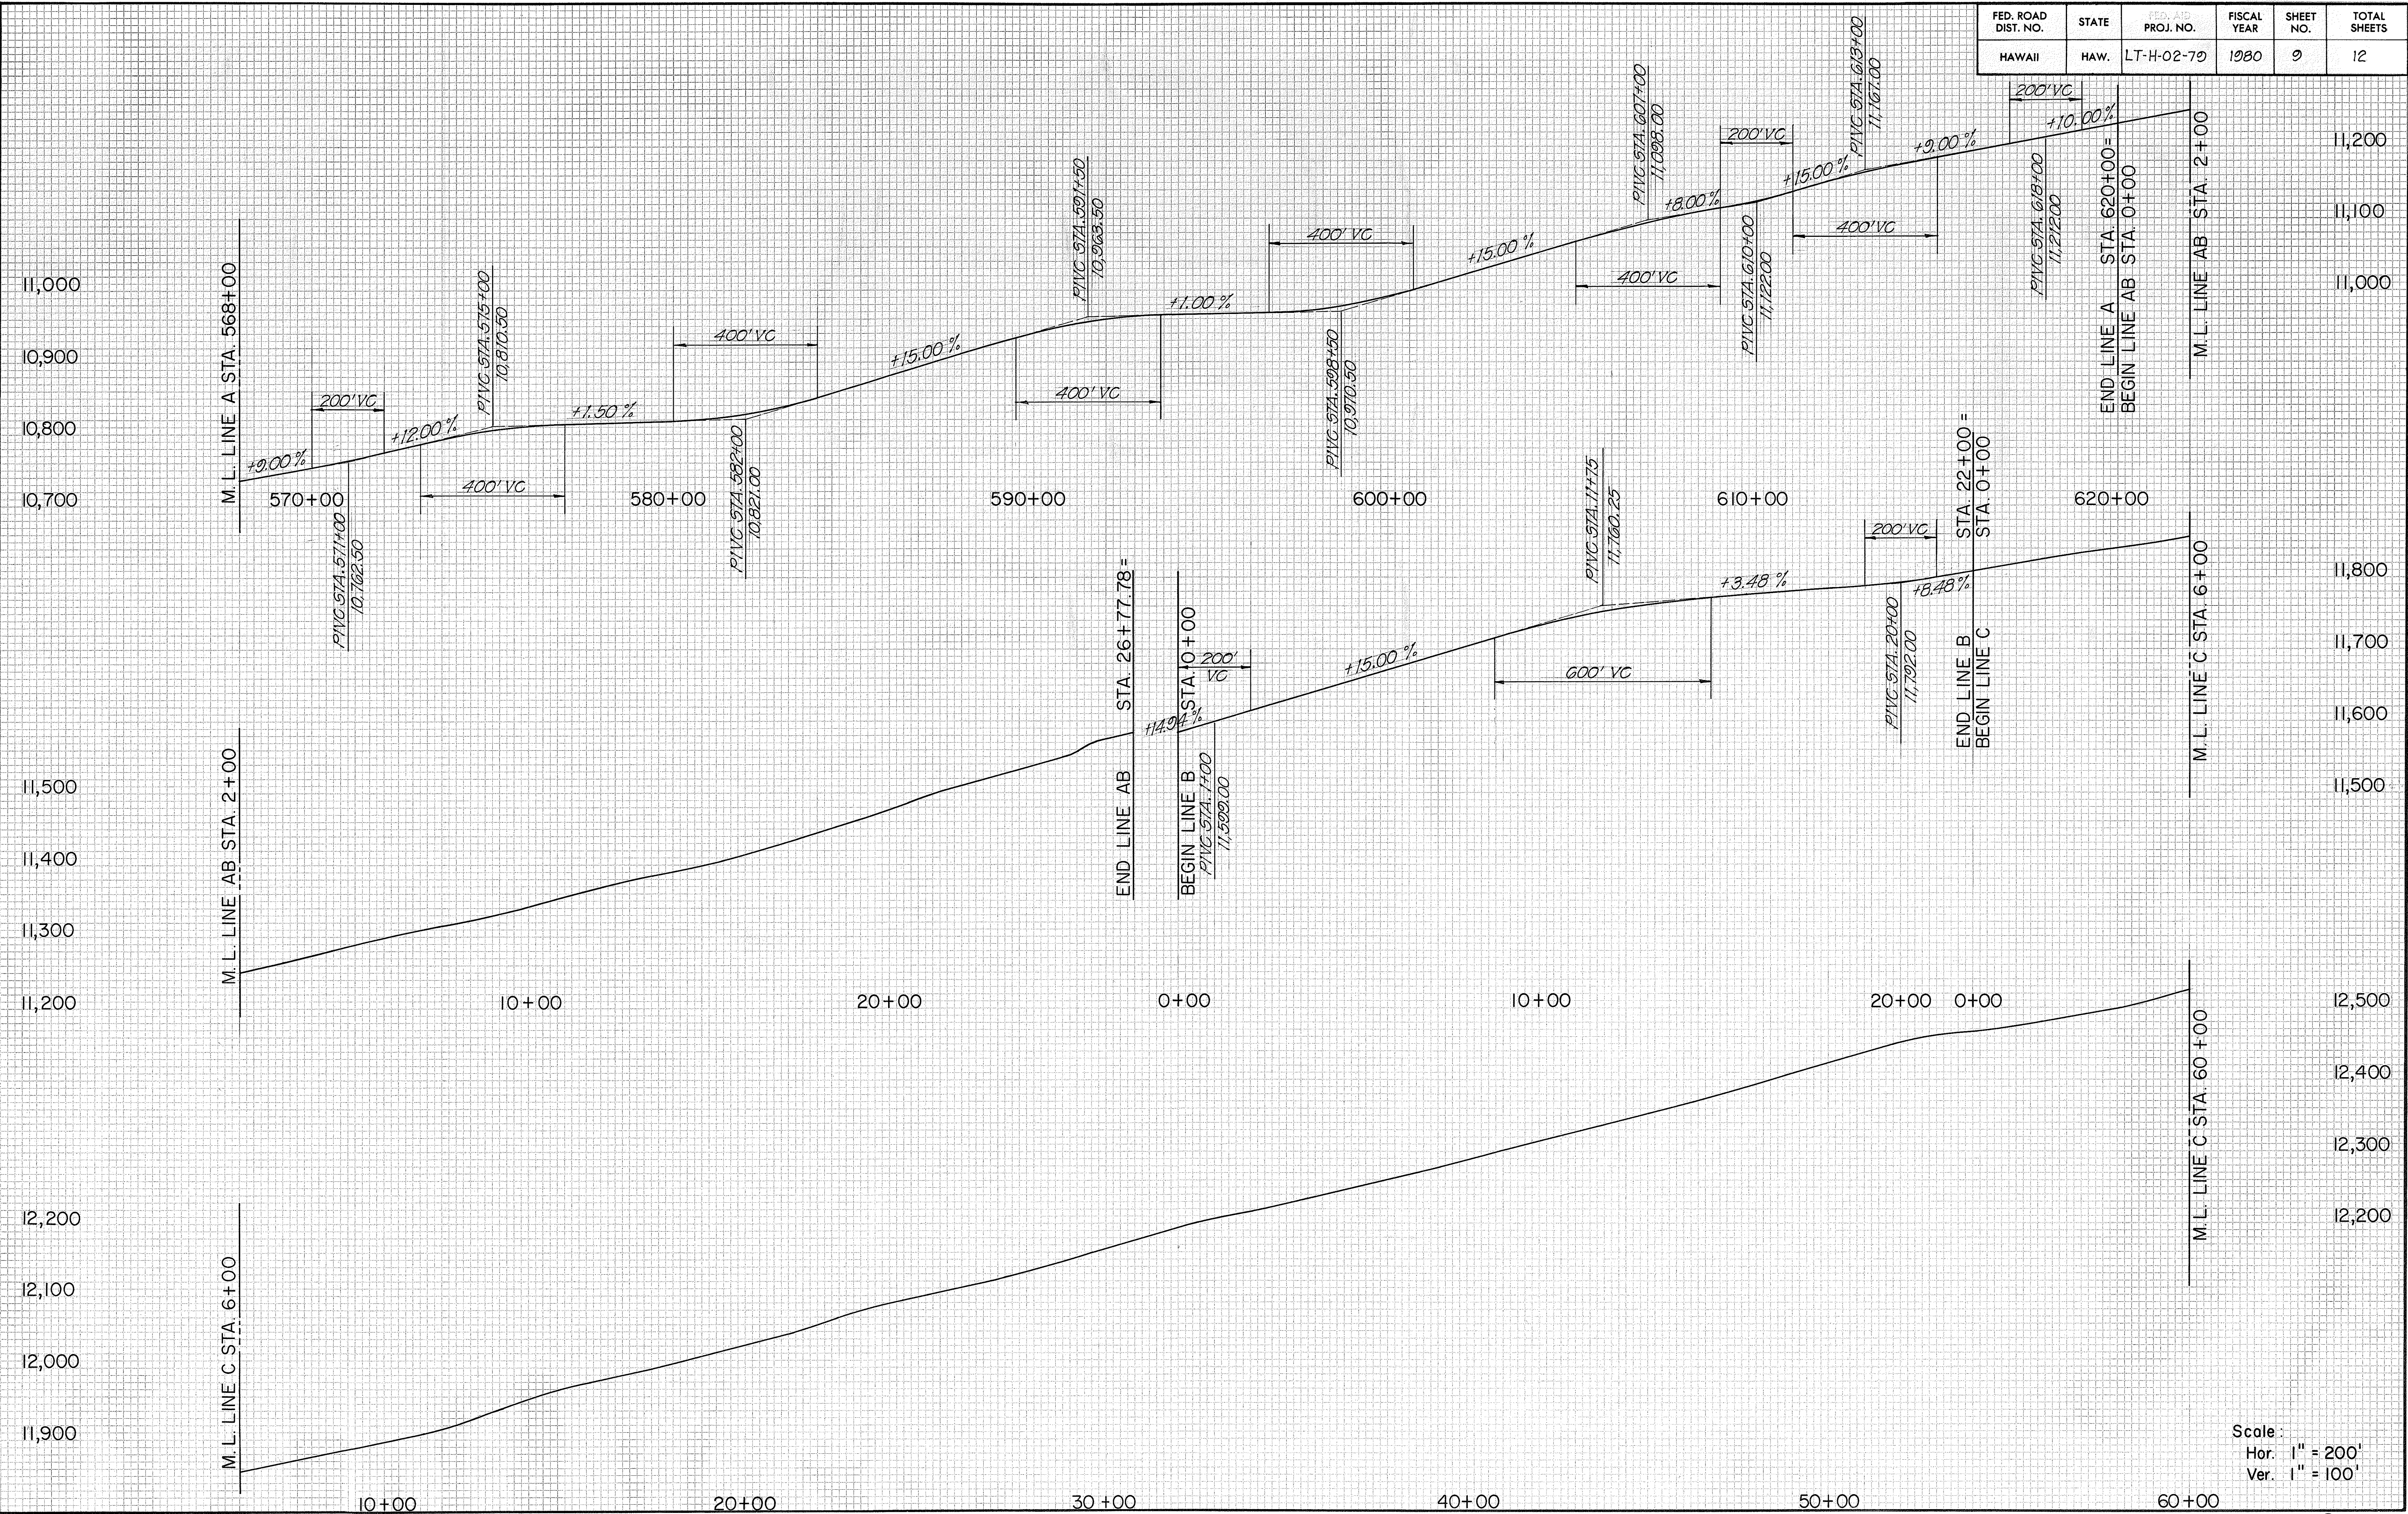

ORIGINAL	BY	DATE
SURVEY		
NOTE BOOK	TEMPERATURE	
NO.	AREAS CHECKED	

ORIGINAL	BY	DATE
SURVEY		
NOTE BOOK	TEMPERATURE	
NO.	AREAS CHECKED	

FED. ROAD DIST. NO.	STATE	PROJ. NO.	FISCAL YEAR	SHEET NO.	TOTAL SHEETS
HAWAII	HAW.	LT-H-02-79	1980	10	12

