
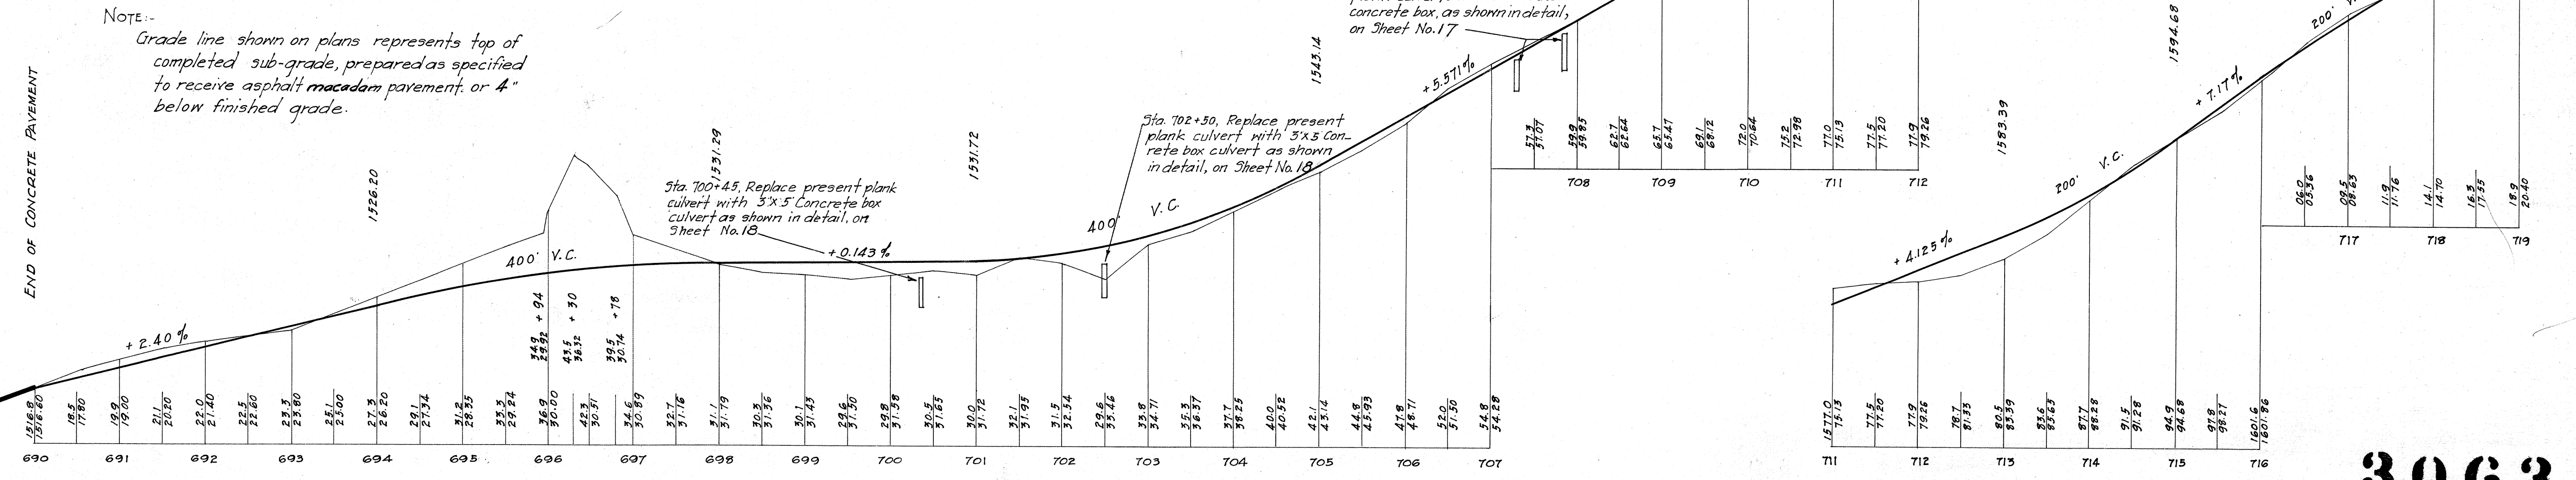


FED. ROAD DIST. NO.	STATE	FED. AID PROJ. NO.	FISCAL YEAR	SHEET NO.	TOTAL SHEETS
	HAW	2	1925	3	39

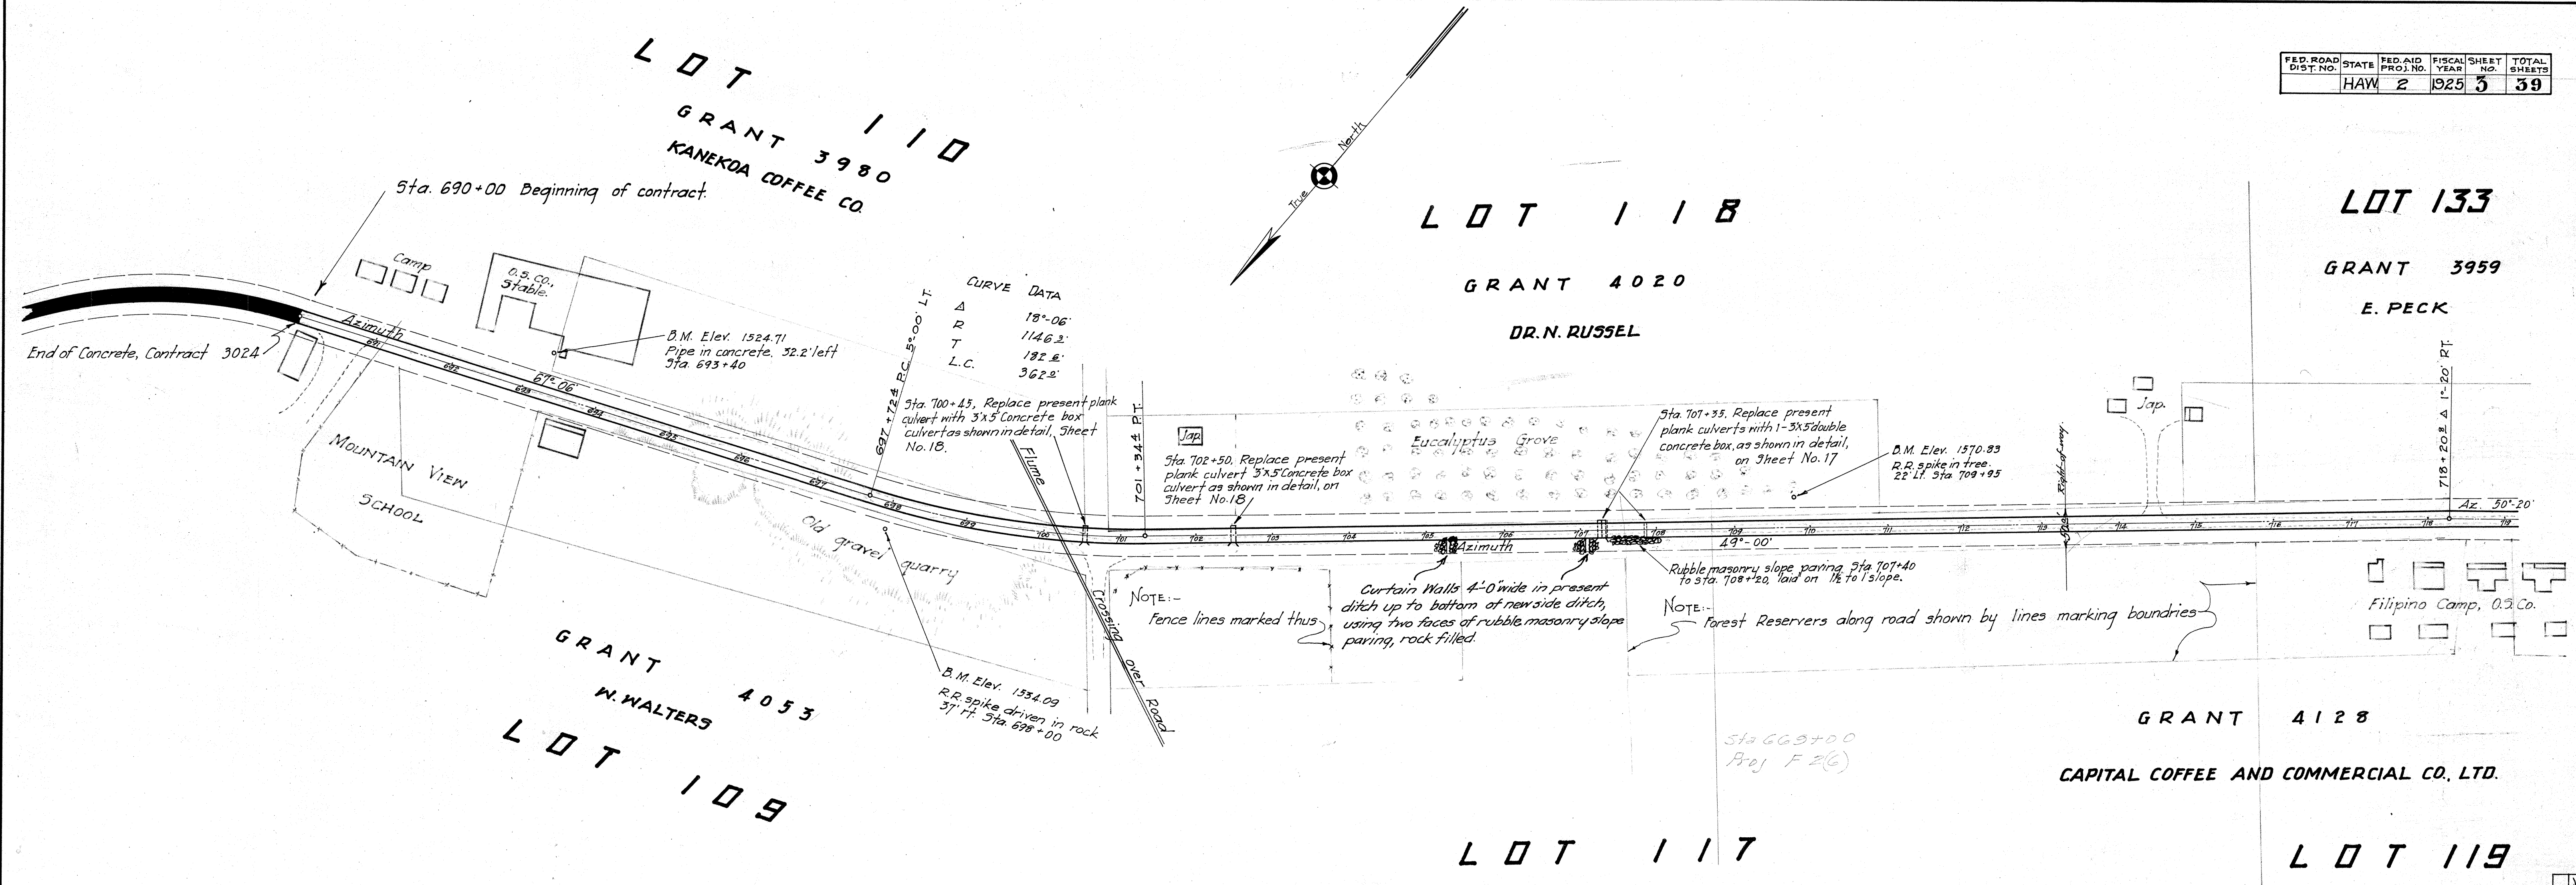

LOT 133

GRANT 3959

E. PECK


LOT 140

GRANT 4130

CAPITAL COFFEE AND COMMERCIAL CO., LTD.

CURVE DATA

Δ	5°-36½'
R	2864.2'
T	139.5'
L	279.2'

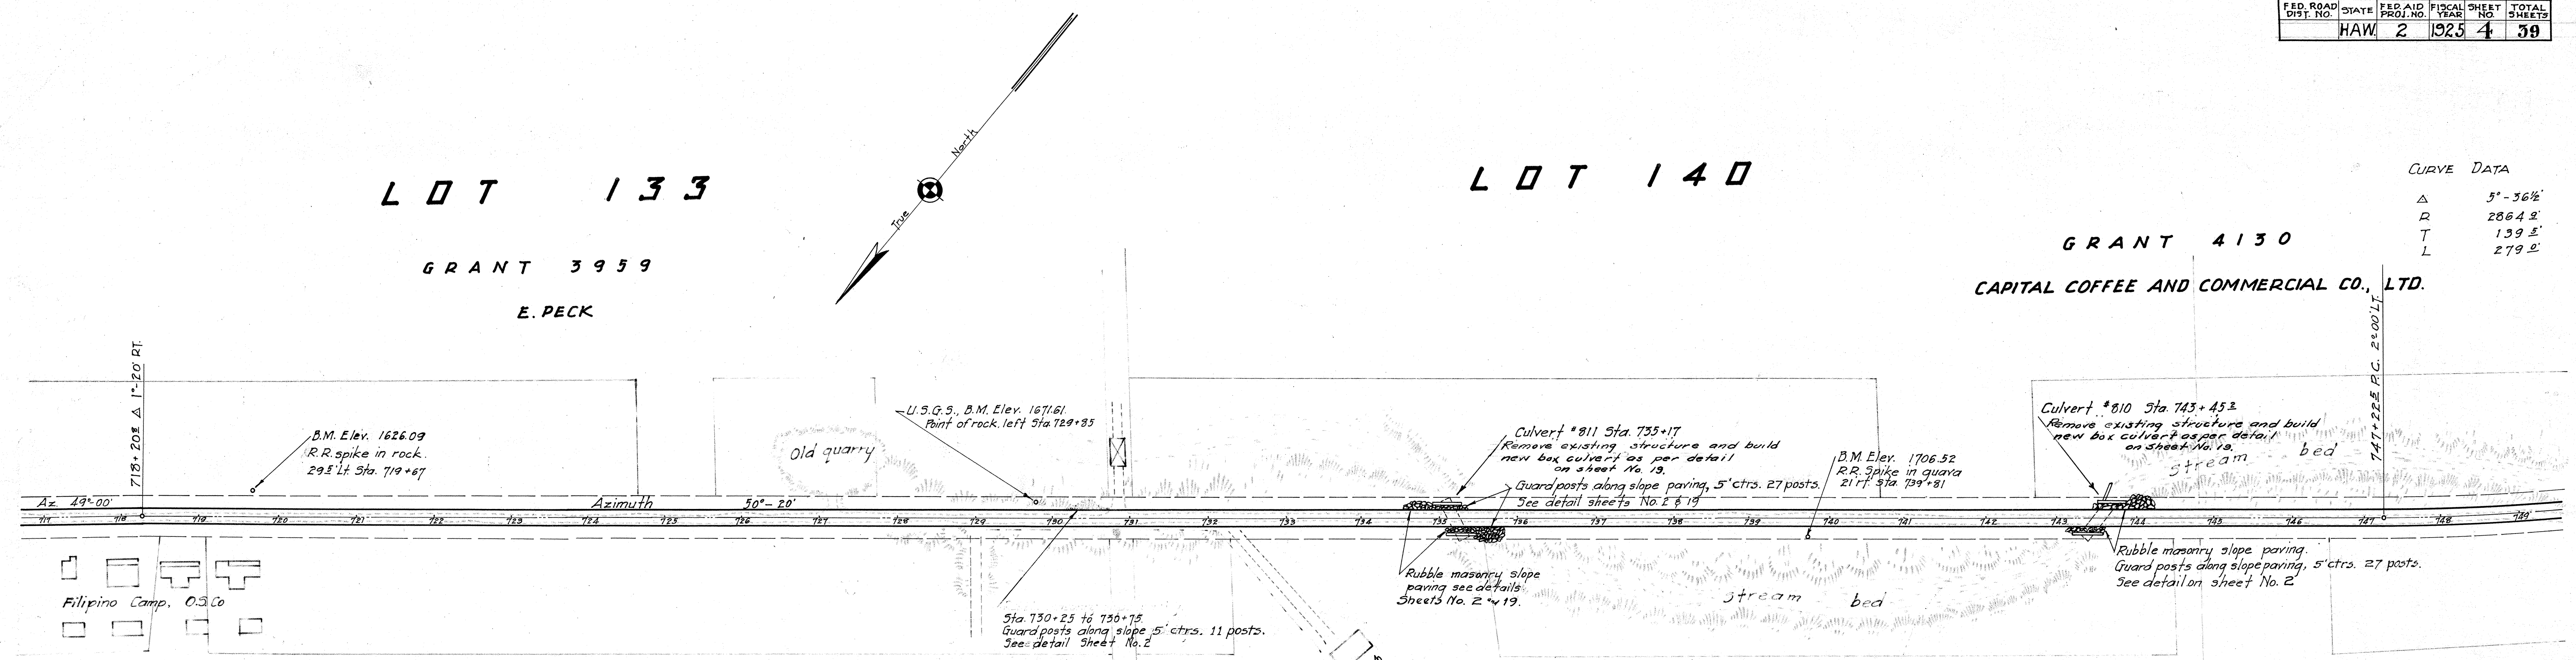


GRANT 4128

CAPITAL COFFEE AND COMMERCIAL CO., LTD.

GRANT 4129

CAPITAL COFFEE AND COMMERCIAL CO., LTD.

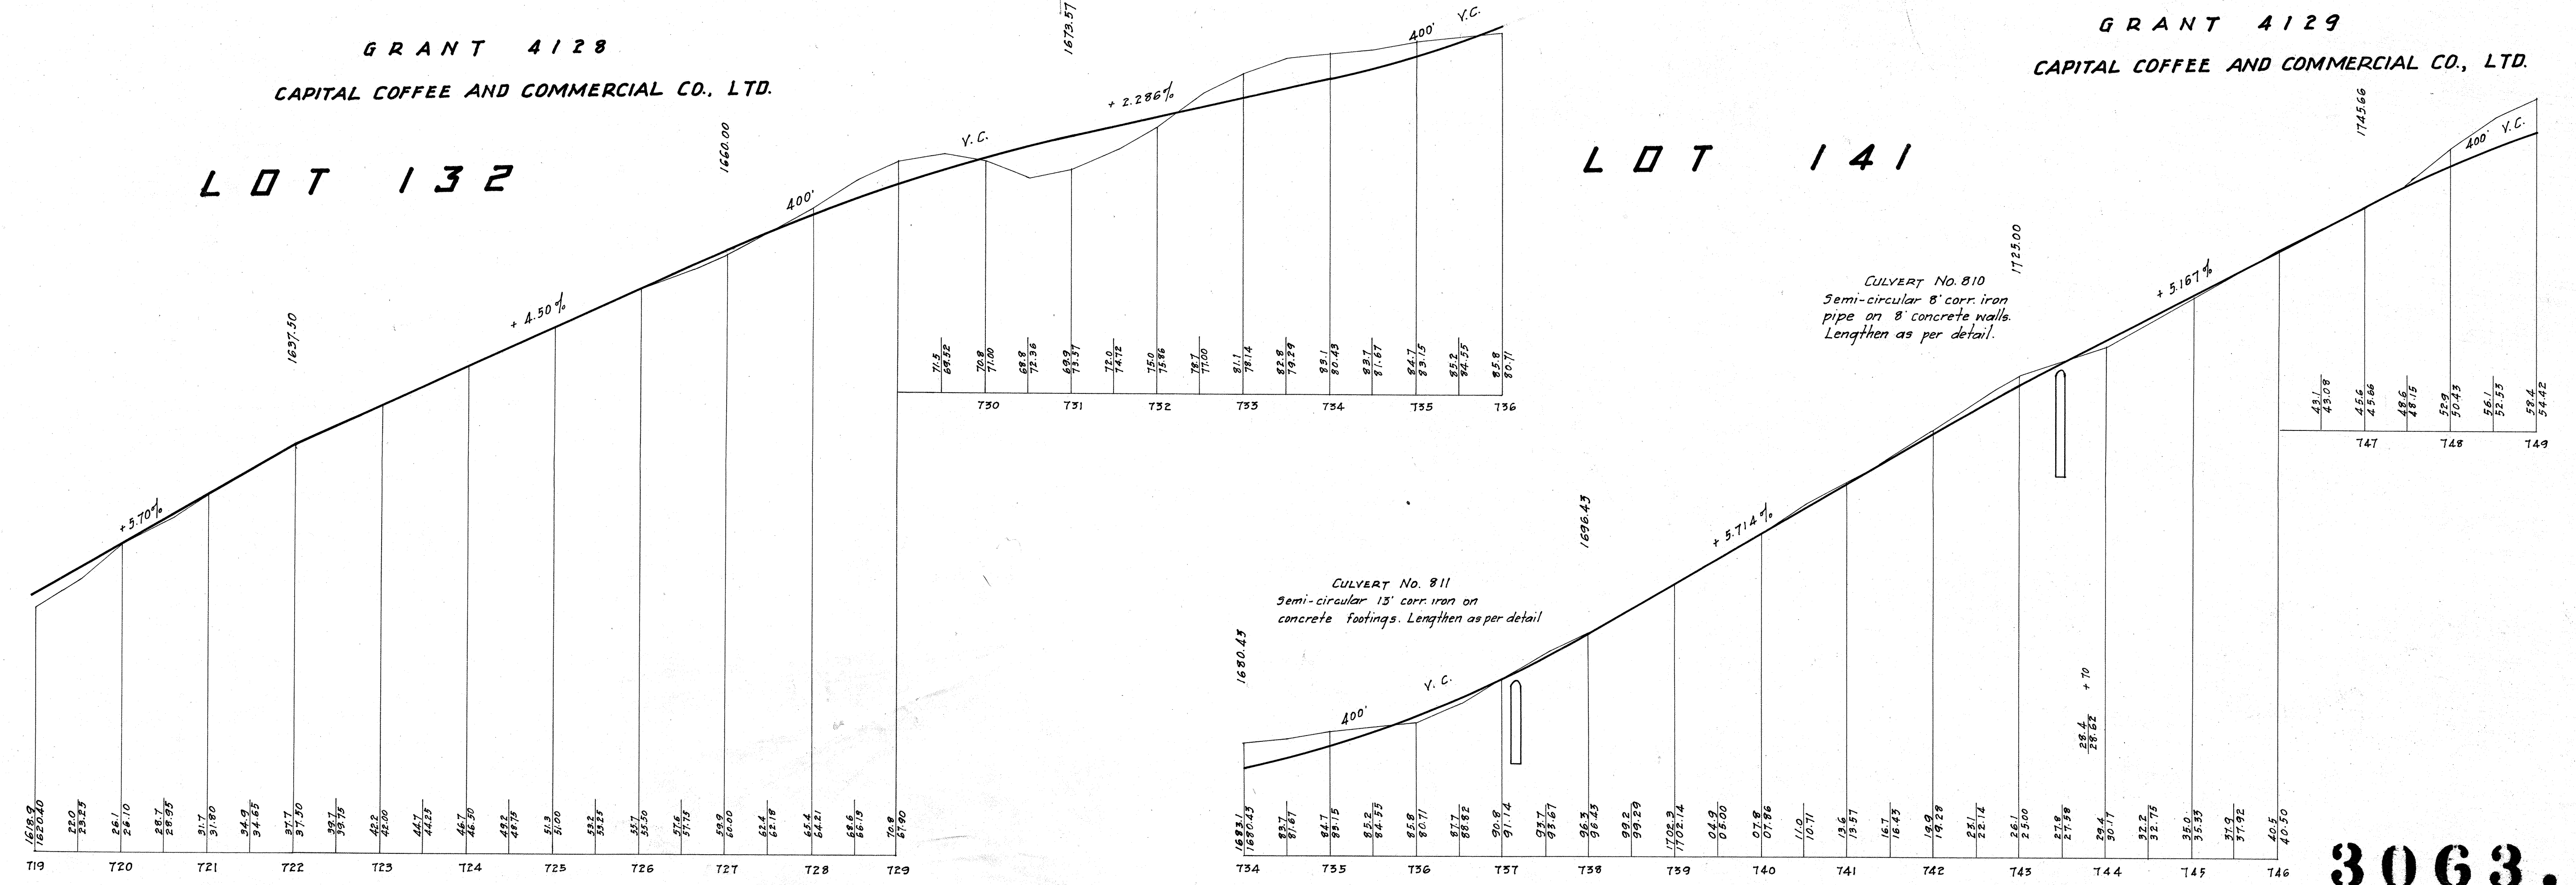

3063.4

LINE AND PROFILE, STA. 719 TO STA. 749.

CURVE DATA

A 5°-36½'
R 2864.2'
T 139.5'
L 279.2'

LOT 157


GRANT 4130

CAPITAL COFFEE AND COMMERCIAL CO., LTD.

LOT 155

GRANT 4022

J. E. GROSSMAN

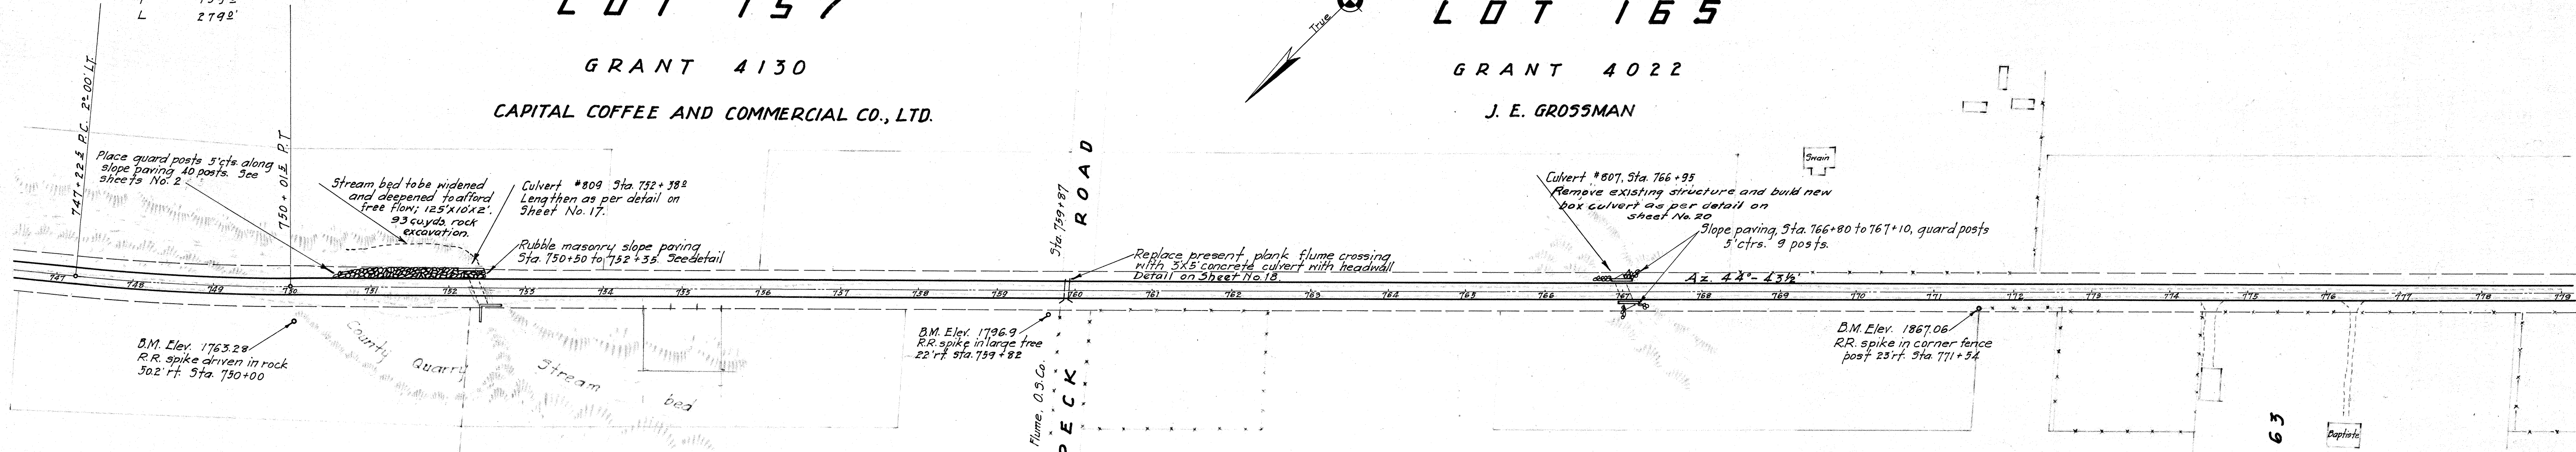

GRANT 4086

S. PALI.

LOT 156


GRANT 3976

J. E. STAPLES

LOT 156

GRANT 4363

H. G. JUNKIN

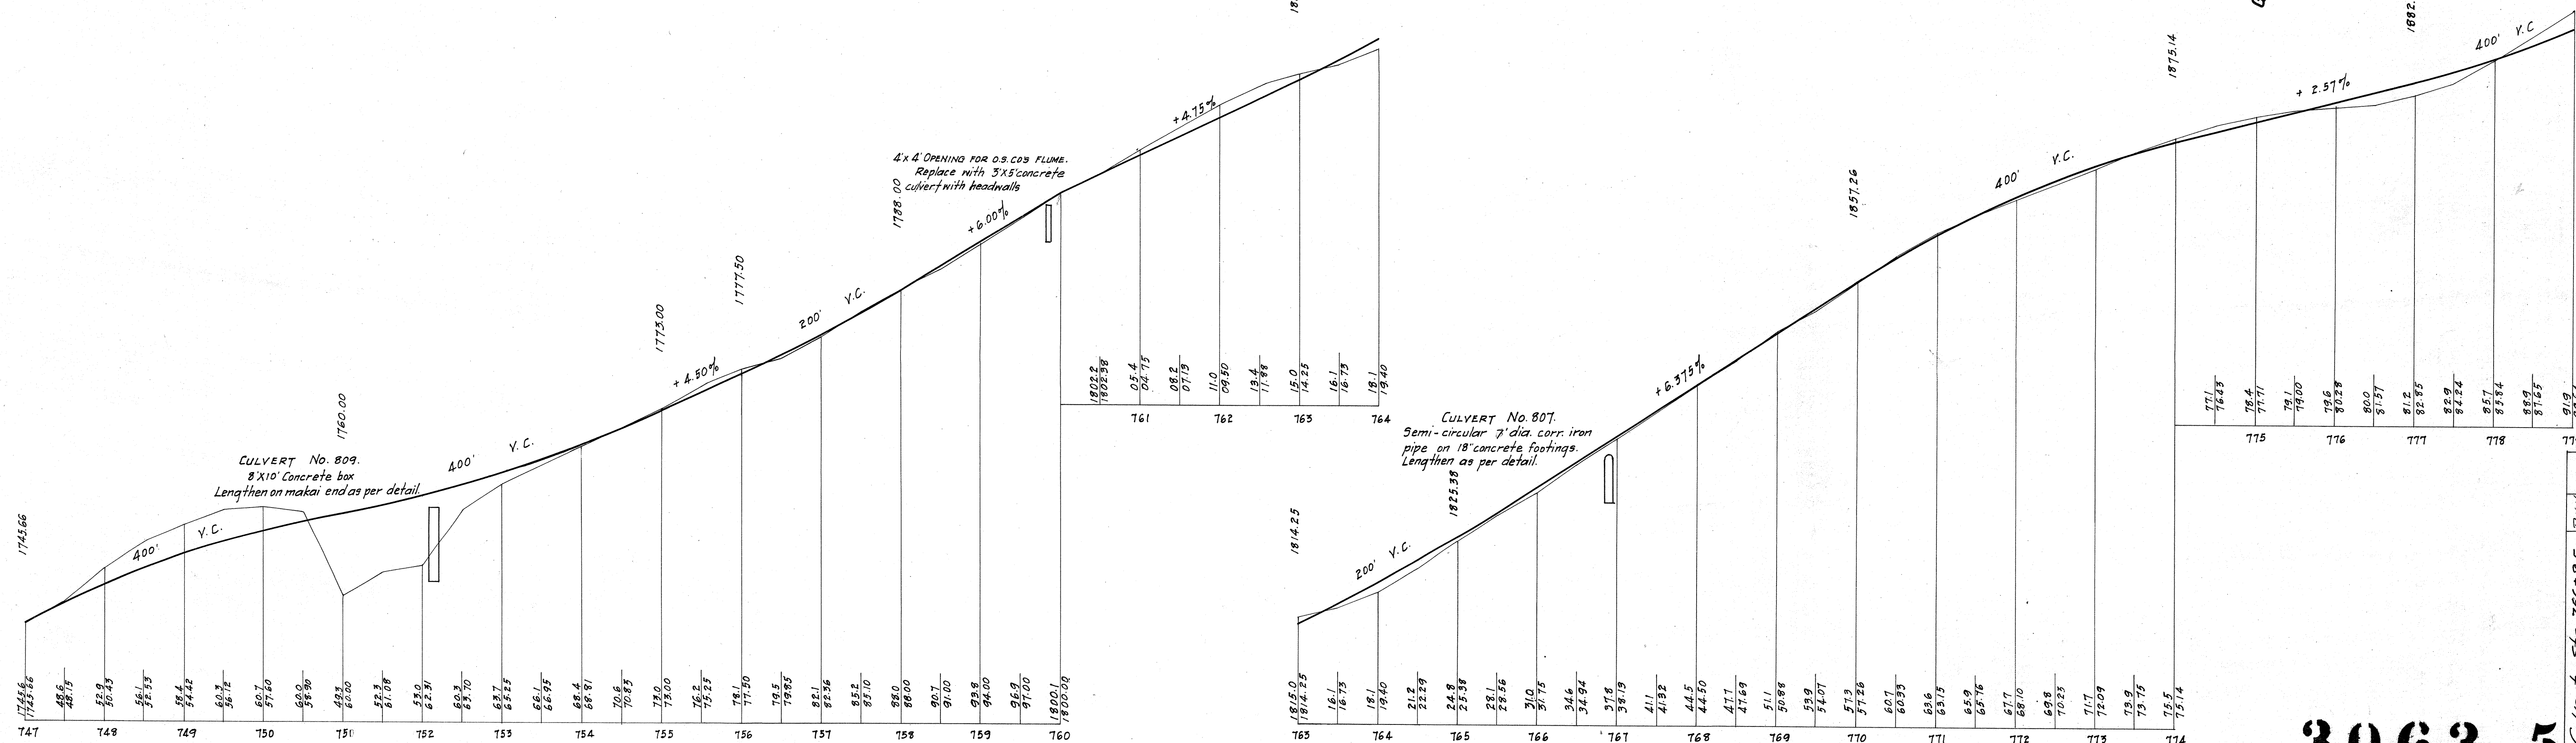

3063.5

LINE AND PROFILE, STA. 747 TO STA. 779.

DATE: 10-22-25
BY: J. E. STAPLES
REVISION: 1

6 17 J

FED. ROAD DIST. NO.	STATE	FED. AID PROJ. NO.	FISCAL YEAR	SHEET NO.	TOTAL SHEETS
	HAW.	2	1925	6	39

LOT 182

GRANT 4645

TOMEKAWA

LOT 187

GRANT 3957

KAWANO

LOT 212

GRANT 5859
J. ZEMBIK

GRANT 3973
SHEKAKI

CURVE DATA
Δ = 26°-46'
R = 2455.1'
T = 585.1'
L = 114.82'

U.S.G.S. B.M. Elev. 200234
Bronze tablet set in stone
step 1 ft. Sta. 799+15

B.M. Elev. 1961.21
R.R. spike in tree
16 ft. Sta. 792+08

B.M. Elev. 1904.07
R.R. spike in fence post
25 ft. Sta. 781+95

GRANT 4031

H. ELDERTS

LOT 181


GRANT 4334

MRS. S. E. SUNTER

LOT 188

GRANT 4322
A. SUNTER

LOT 211

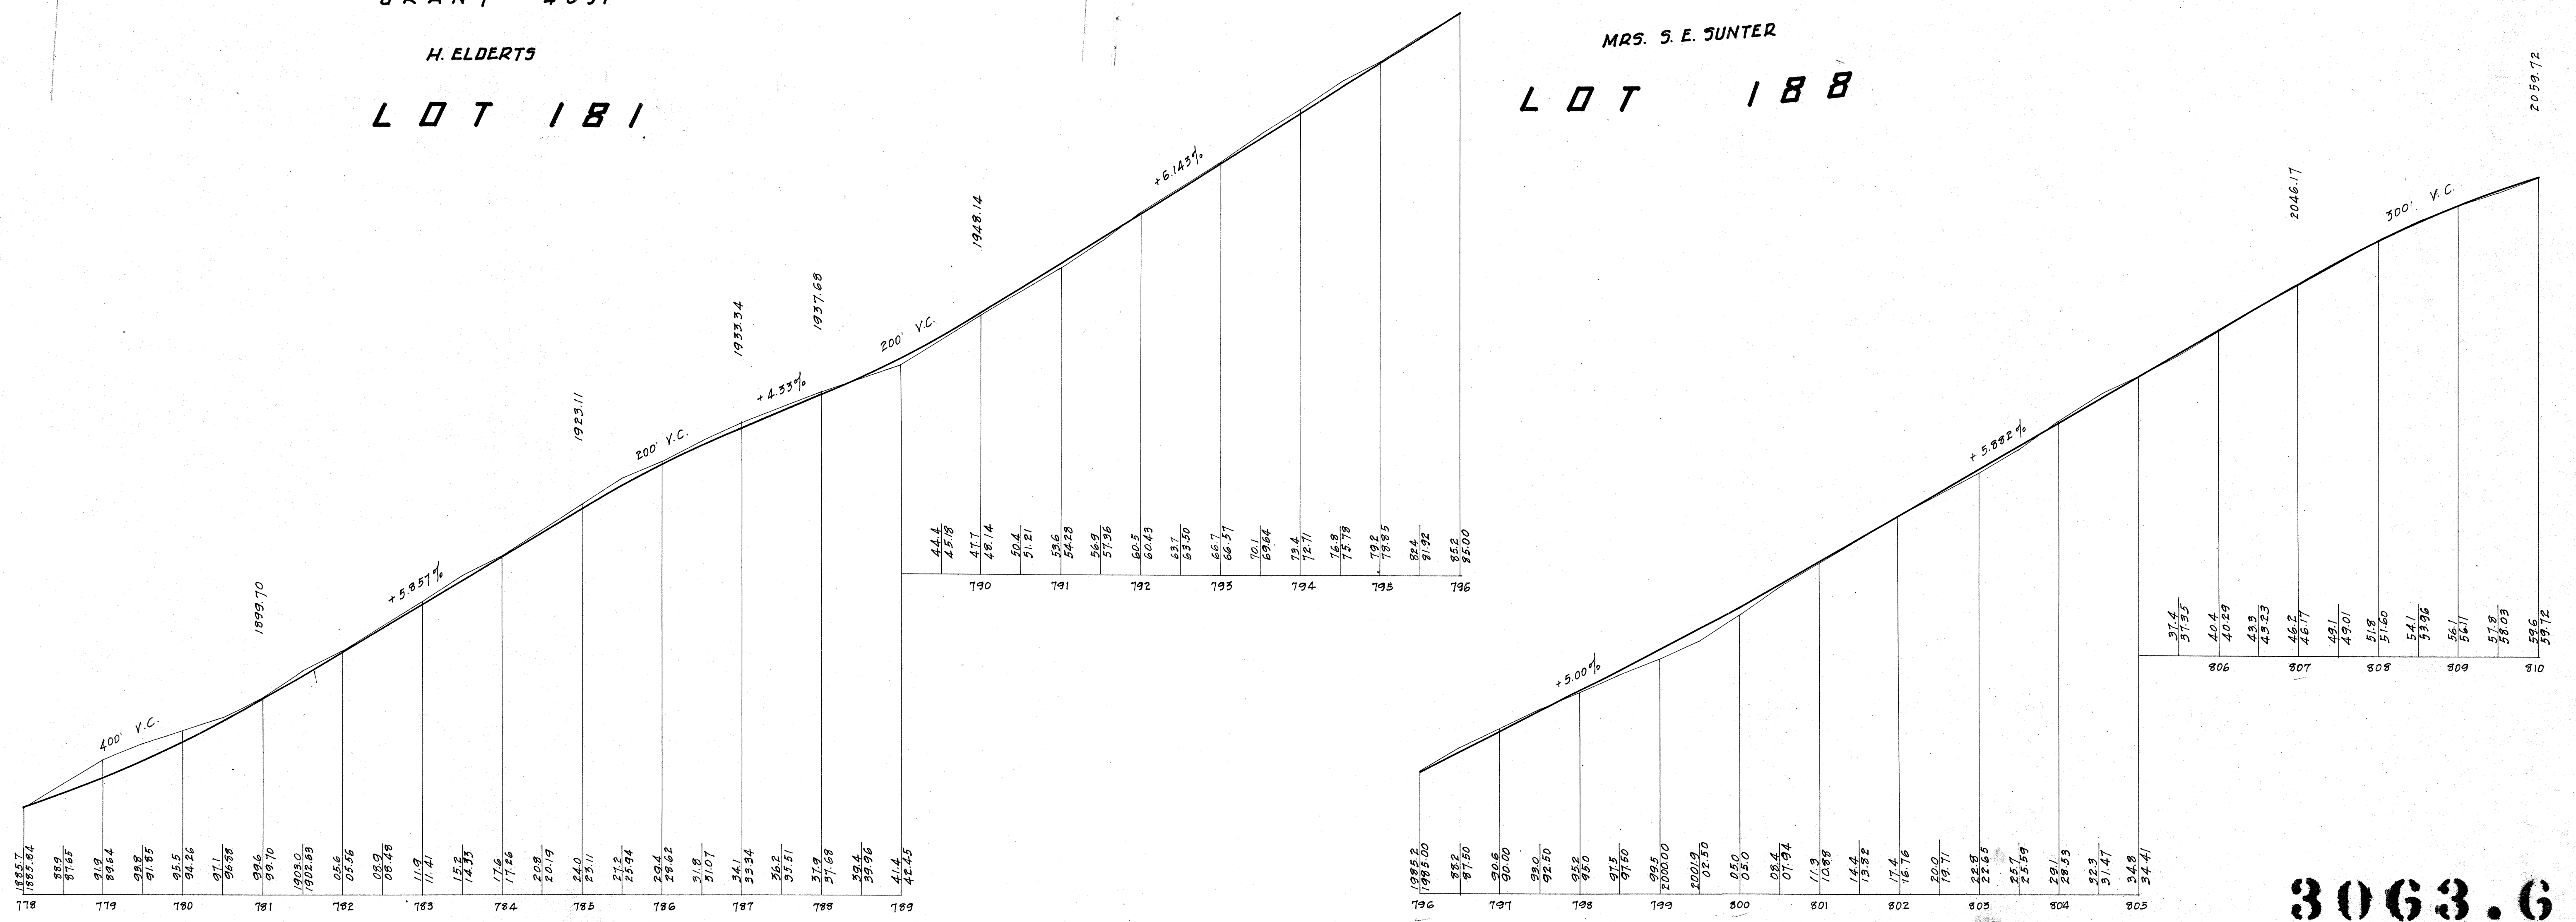

3063.6

LINE AND PROFILE STA. 778 TO STA. 810.

6-17-5

FED. ROAD DIST. NO.	STATE	FED. AID PROJ. NO.	FISCAL YEAR	SHEET NO.	TOTAL SHEETS
	HAW	2	1925	7	39

LOT 212

GRANT 5859



J. ZEMBIK

LOT 216

GRANT 4300

OLAA COFFEE CO.

LOT 229

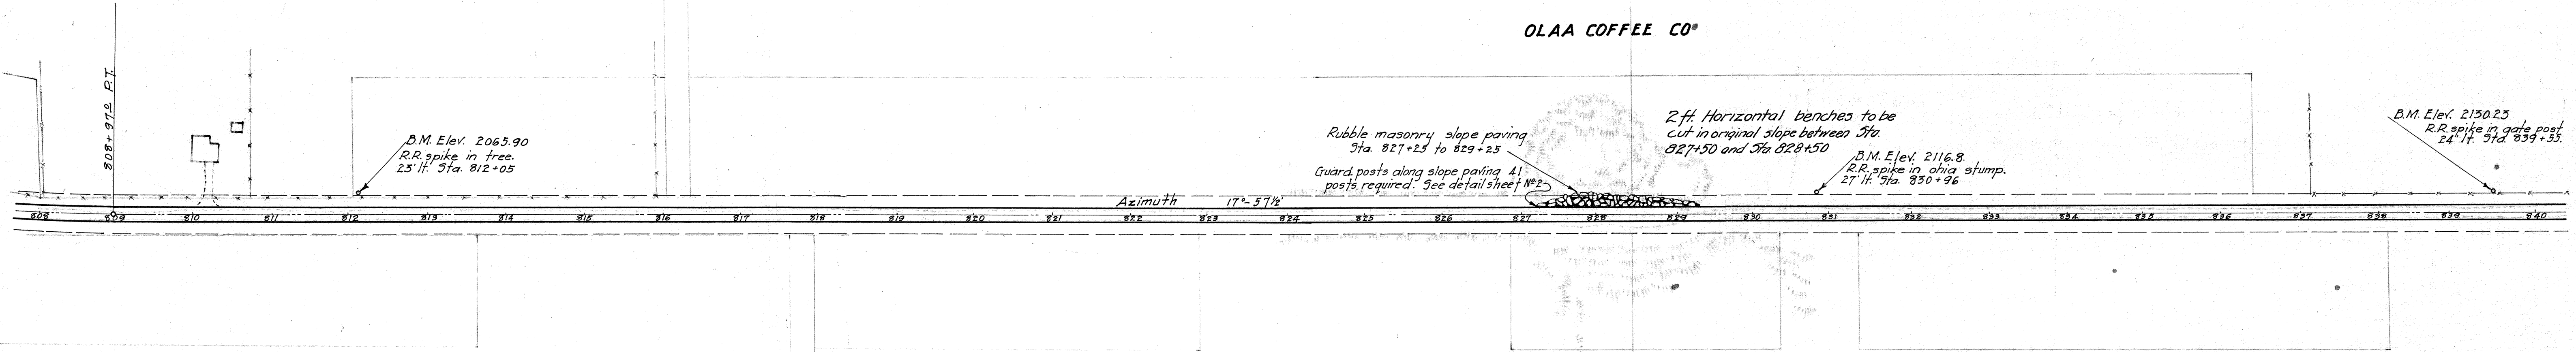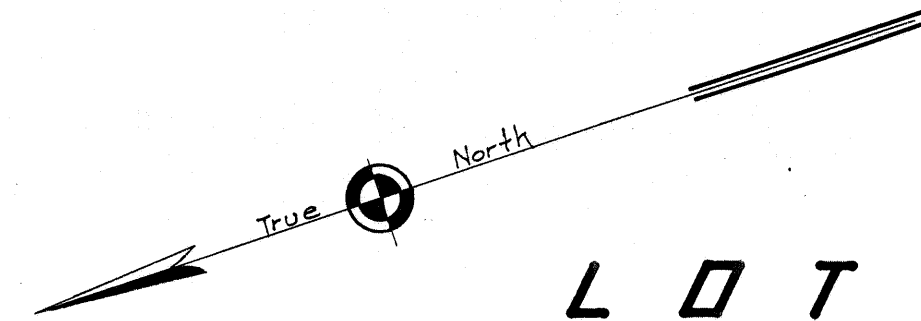

GRANT 4322

A. SUNTER

LOT 211

GRANT 4082


A. F. LINDER

LOT 217

GRANT 3974

J. M. JONES.

LOT 228

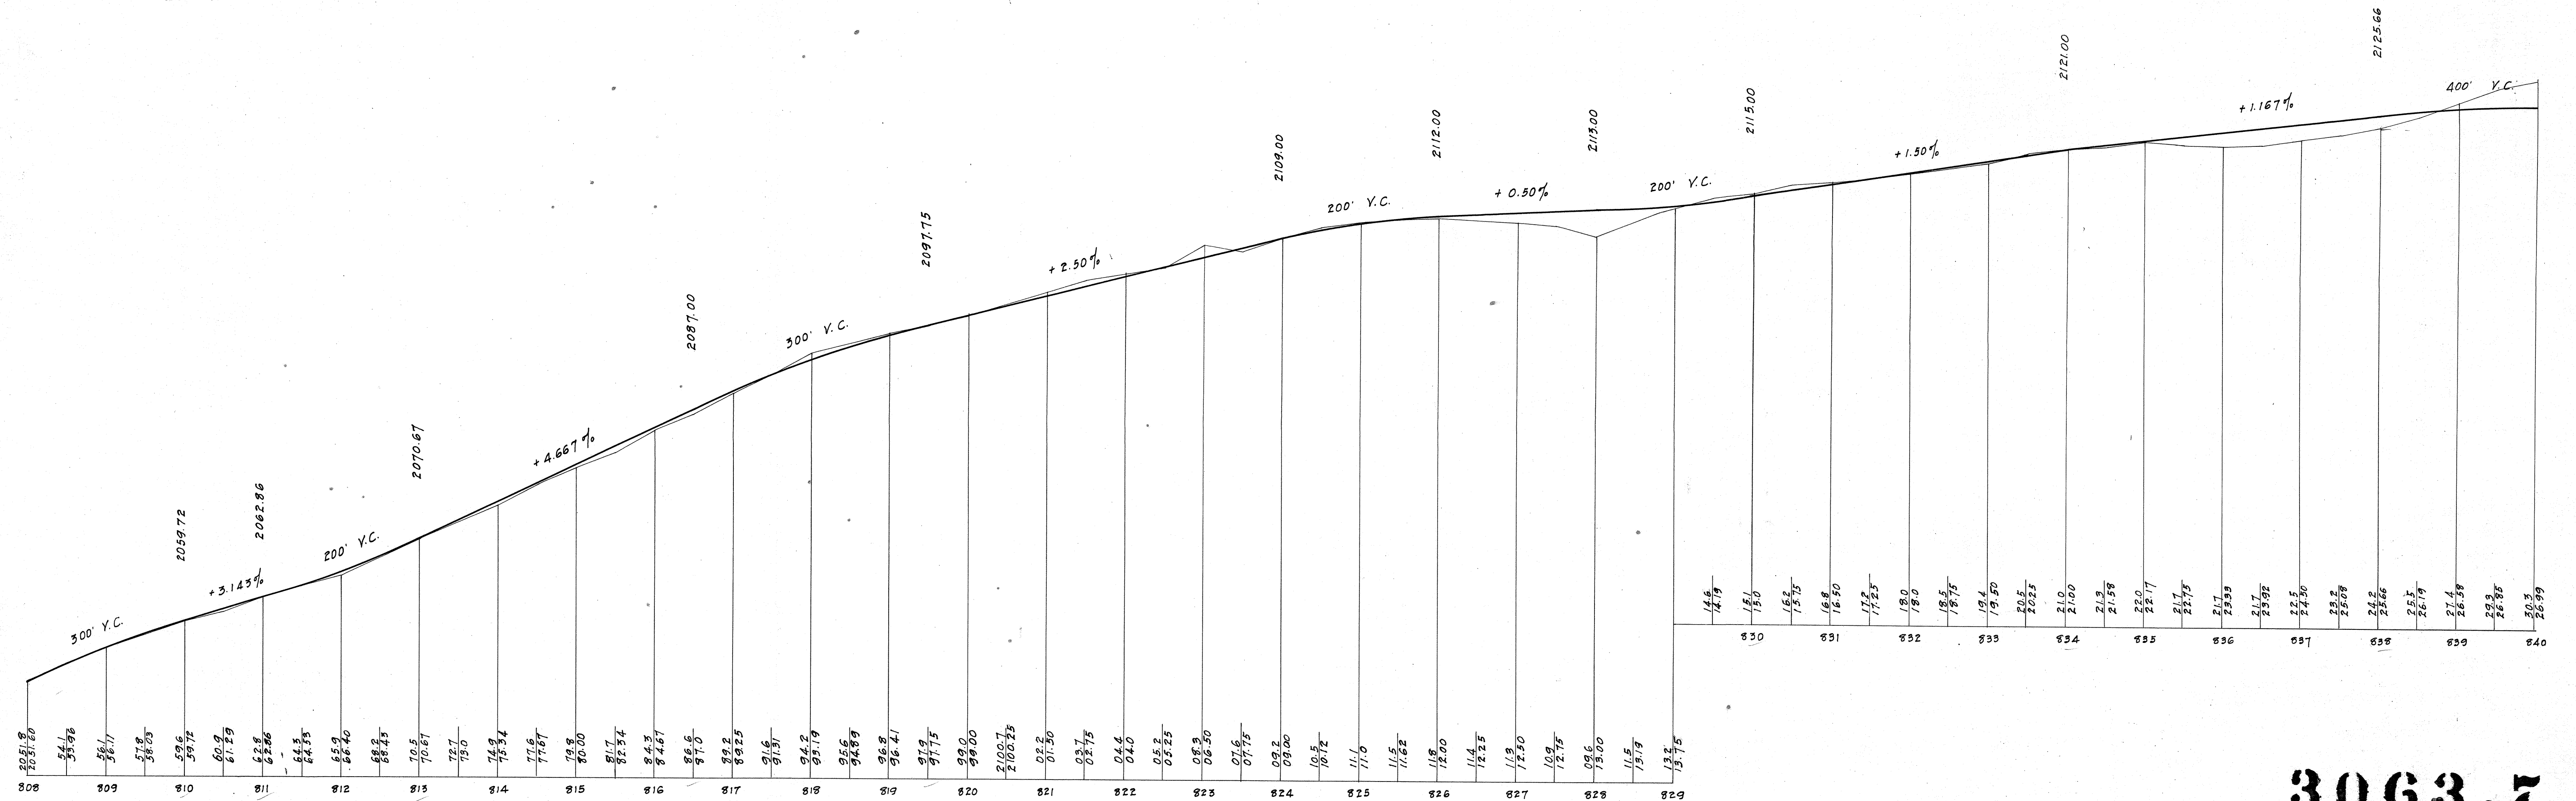

3063.7

LINE AND PROFILE, STA. 808 TO STA. 840.

6 17 ✓

LOT 236

LOT 249


LOT 254

GRANT 4302

GRANT 4303

OLAA COFFEE CO.

OLAA COFFEE CO.

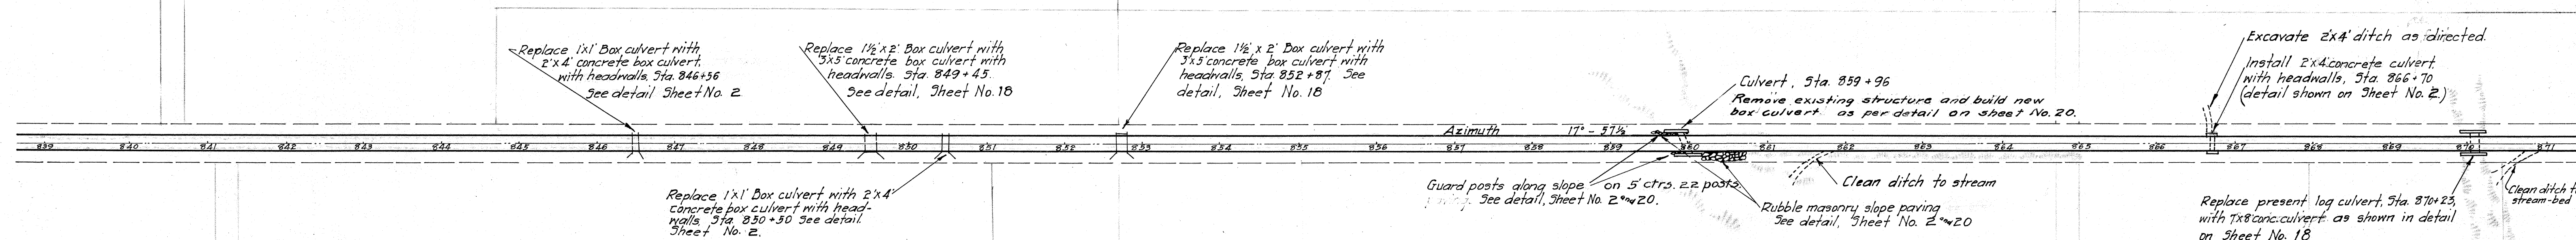

GRANT 4235

GRANT 4350


R. RYCROFT.

J. P. HOWATT

LOT 237

LOT 248

LOT 255

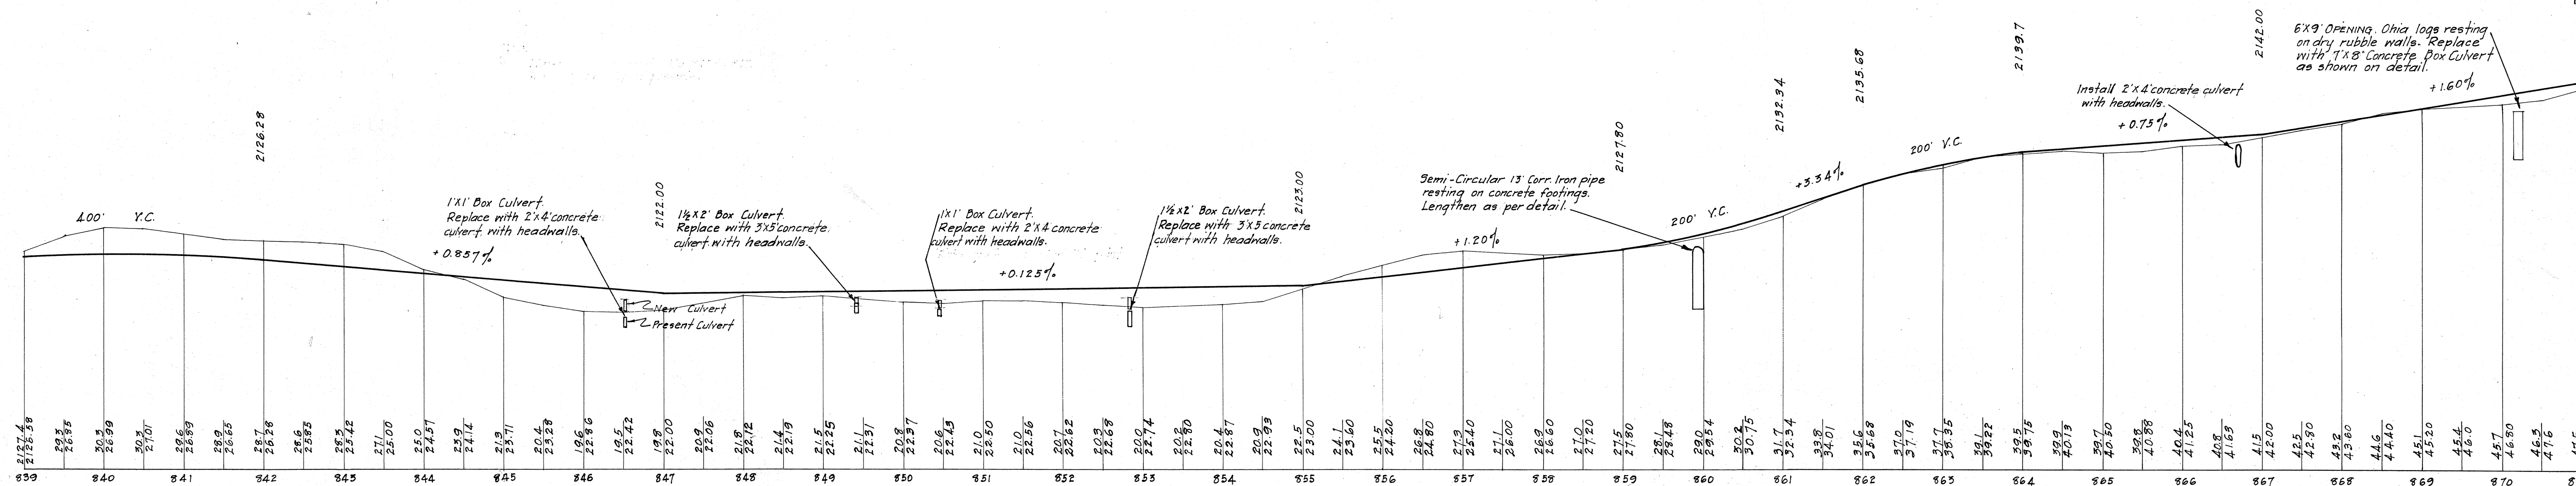

3063.8 LINE AND PROFILE, STA. 839 TO STA. 871.

6 17 ✓

DATE REVISION

FED. ROAD DIST. NO.	STATE	FED. AID PROJ. NO.	FISCAL YEAR	SHEET NO.	TOTAL SHEETS
	HAW.	2	1925	9	39


LOT 254

LOT 267

LOT 272

GRANT 4303
OLAA COFFEE CO.

GRANT 4303
OLAA COFFEE CO.

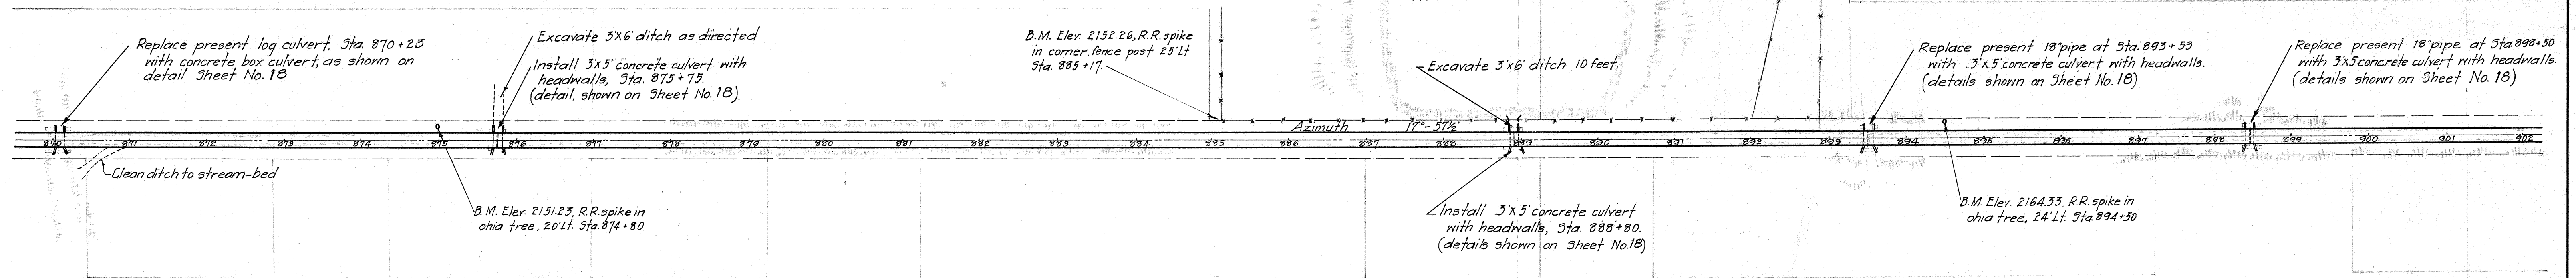

GRANT 4350

J. P. HOWATT

GRANT 4158

MRS. L. M. STAPLES.


GRANT 4296

R. ZINK

LOT 255

LOT 266

LOT 273

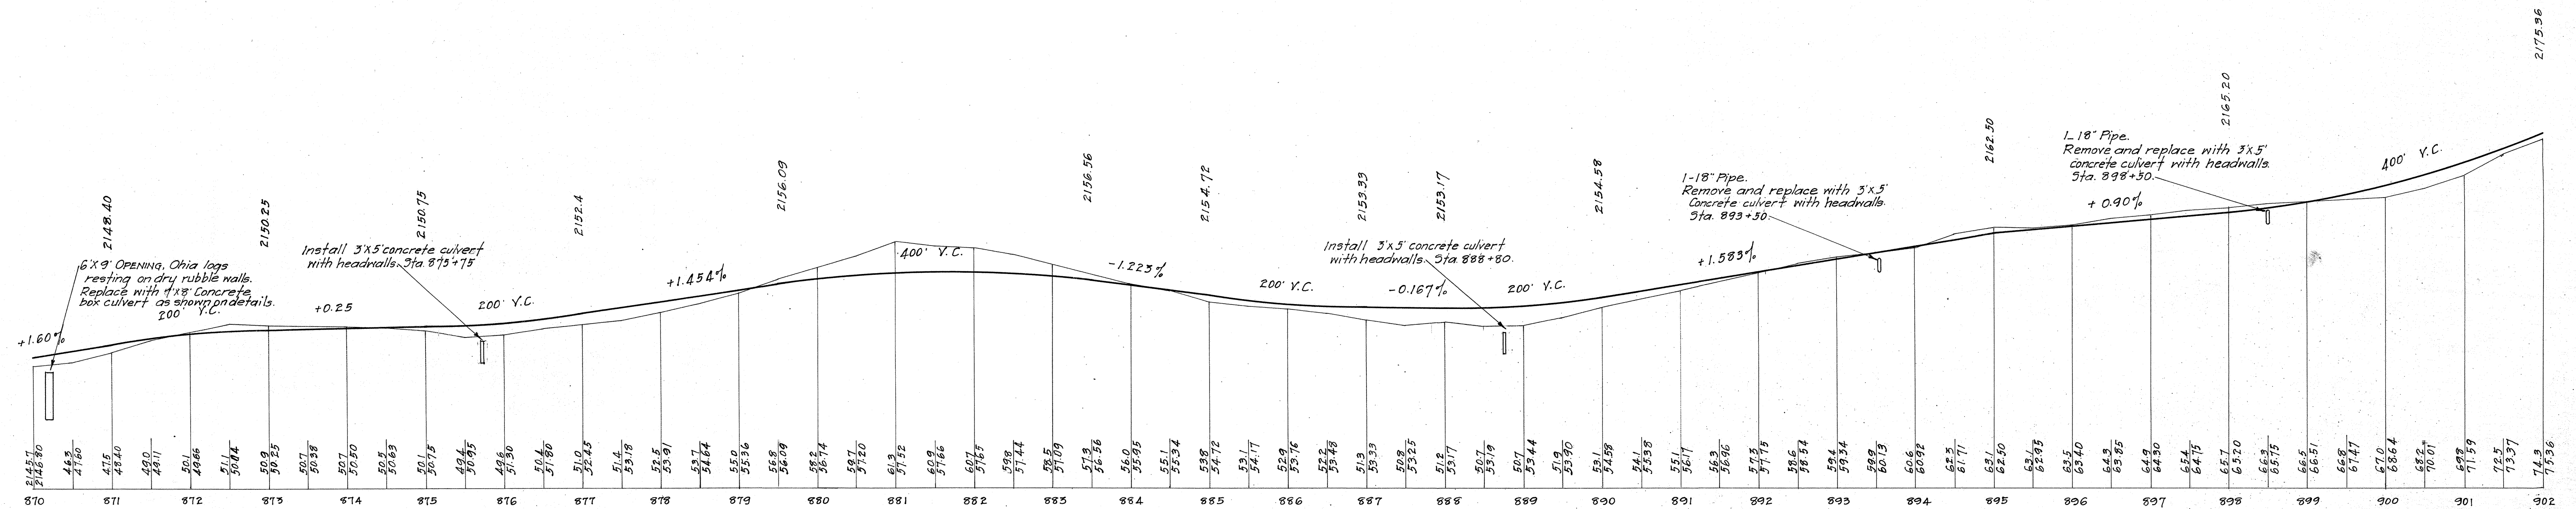

3063.9 LINE AND PROFILE, STA. 870 TO STA. 902.

6 17 ✓

K. OTSUKI


GRANT 4303
OLAA COFFEE CO.

LOT 285

GRANT
E. A. HORAN
LOT 284
4023

G. A. TURNER

L O T 290

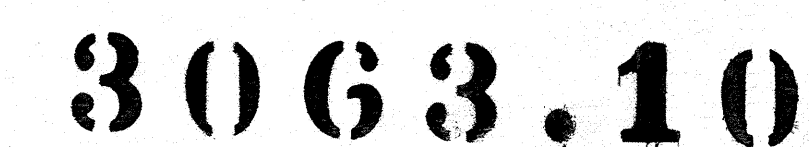

LINE AND PROFILE STA. 899 TO STA. 932

6-17-V

FED. ROAD DIST. NO.	STATE	FED. AID PROJ. NO.	FISCAL YEAR	SHEET NO.	TOTAL SHEETS
	HAW	2	1925	11	39

LOT 297

GRANT 3971

CHAS. TROWBRIDGE



LOT 300

LOT 313

GRANT 4039



G. BENSON

GLENWOOD STATION
H. C. R. R.

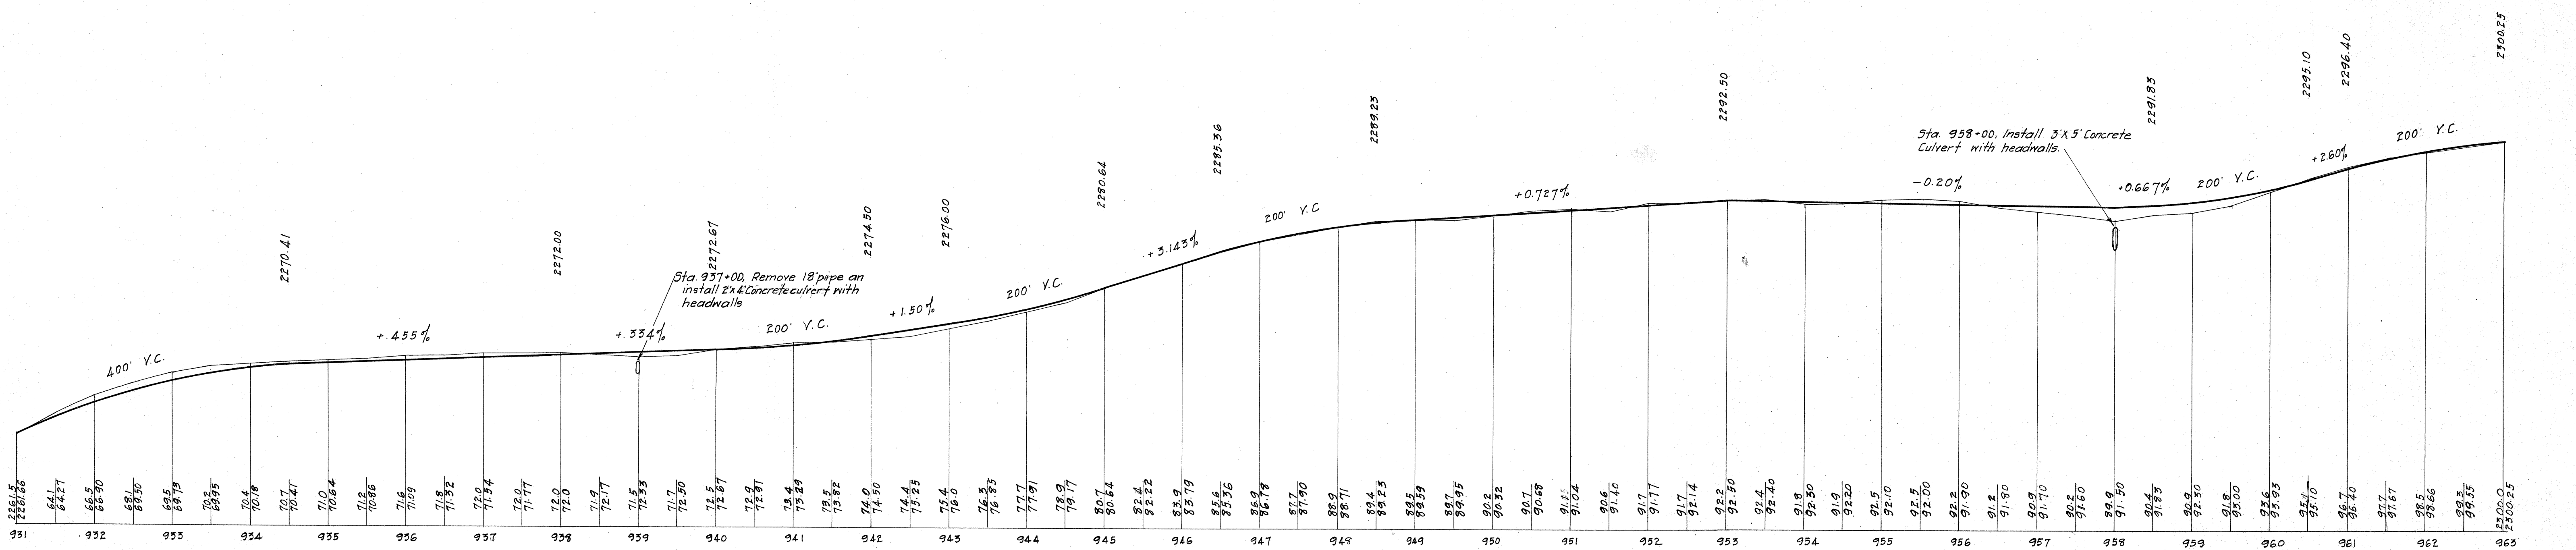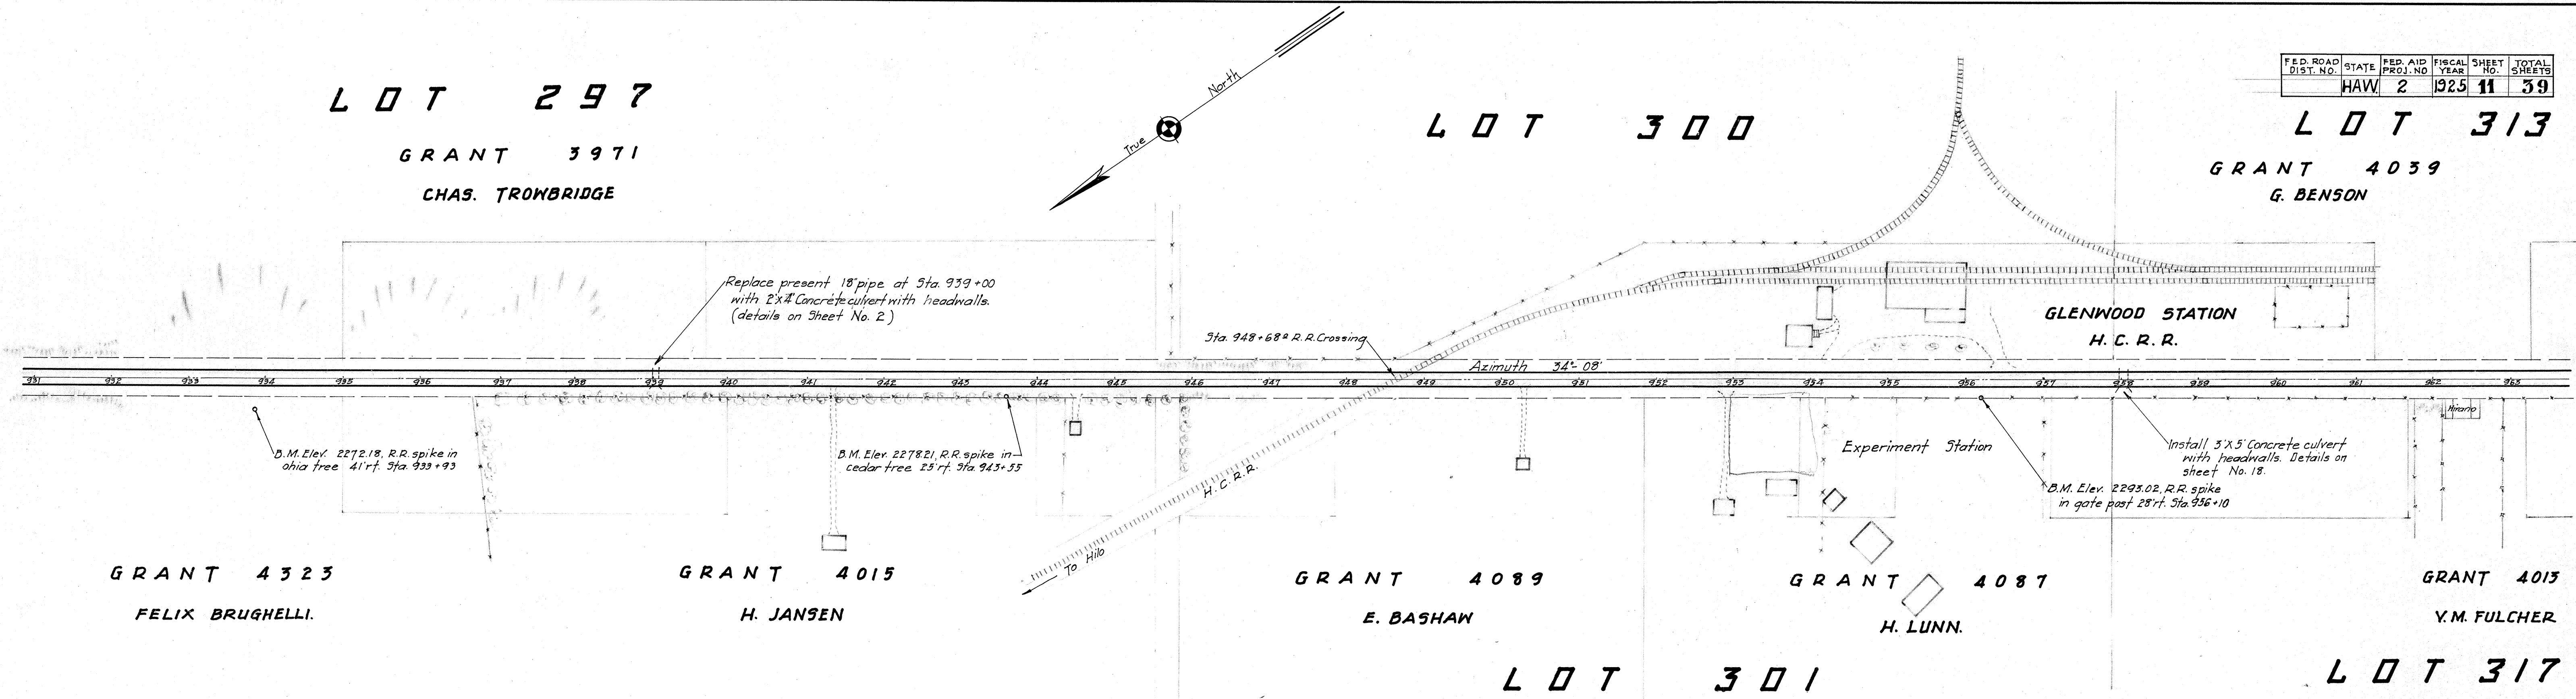

3063.11 LINE AND PROFILE, STA. 931 TO STA. 963

6-17-V

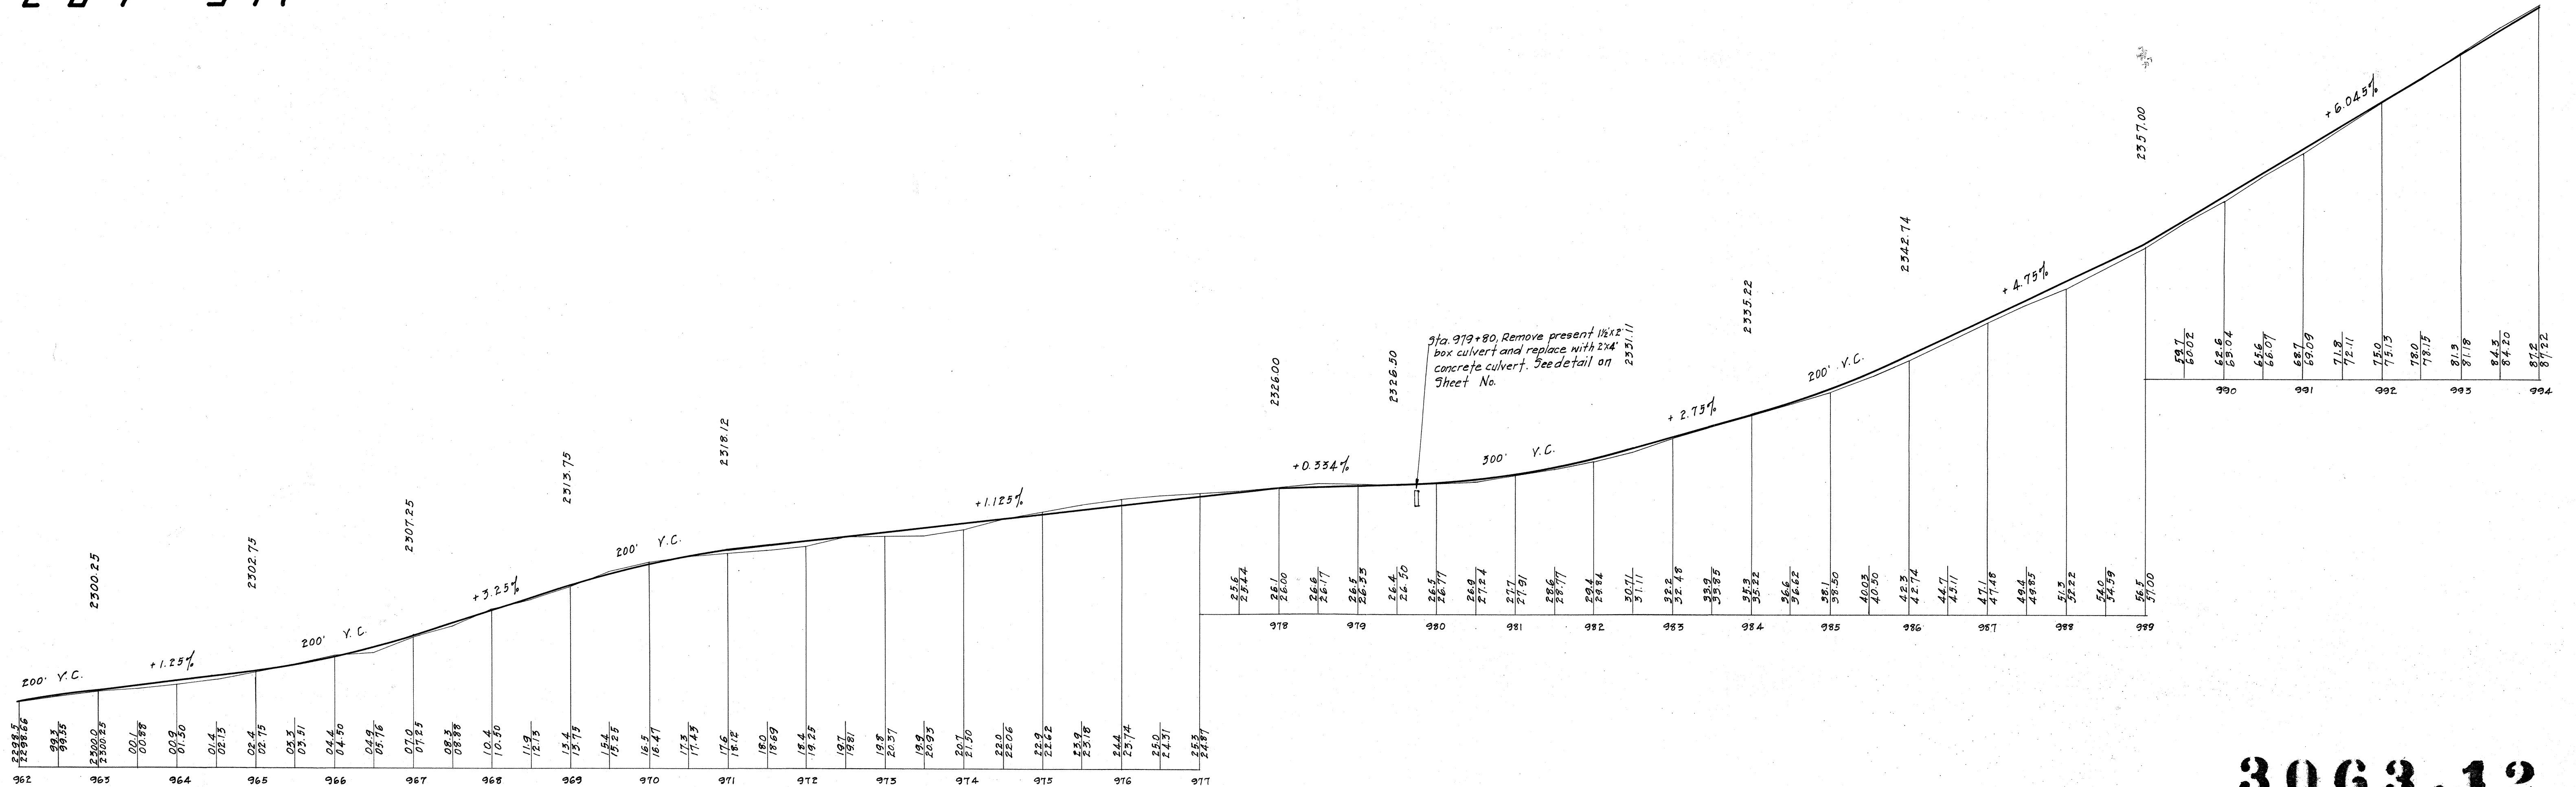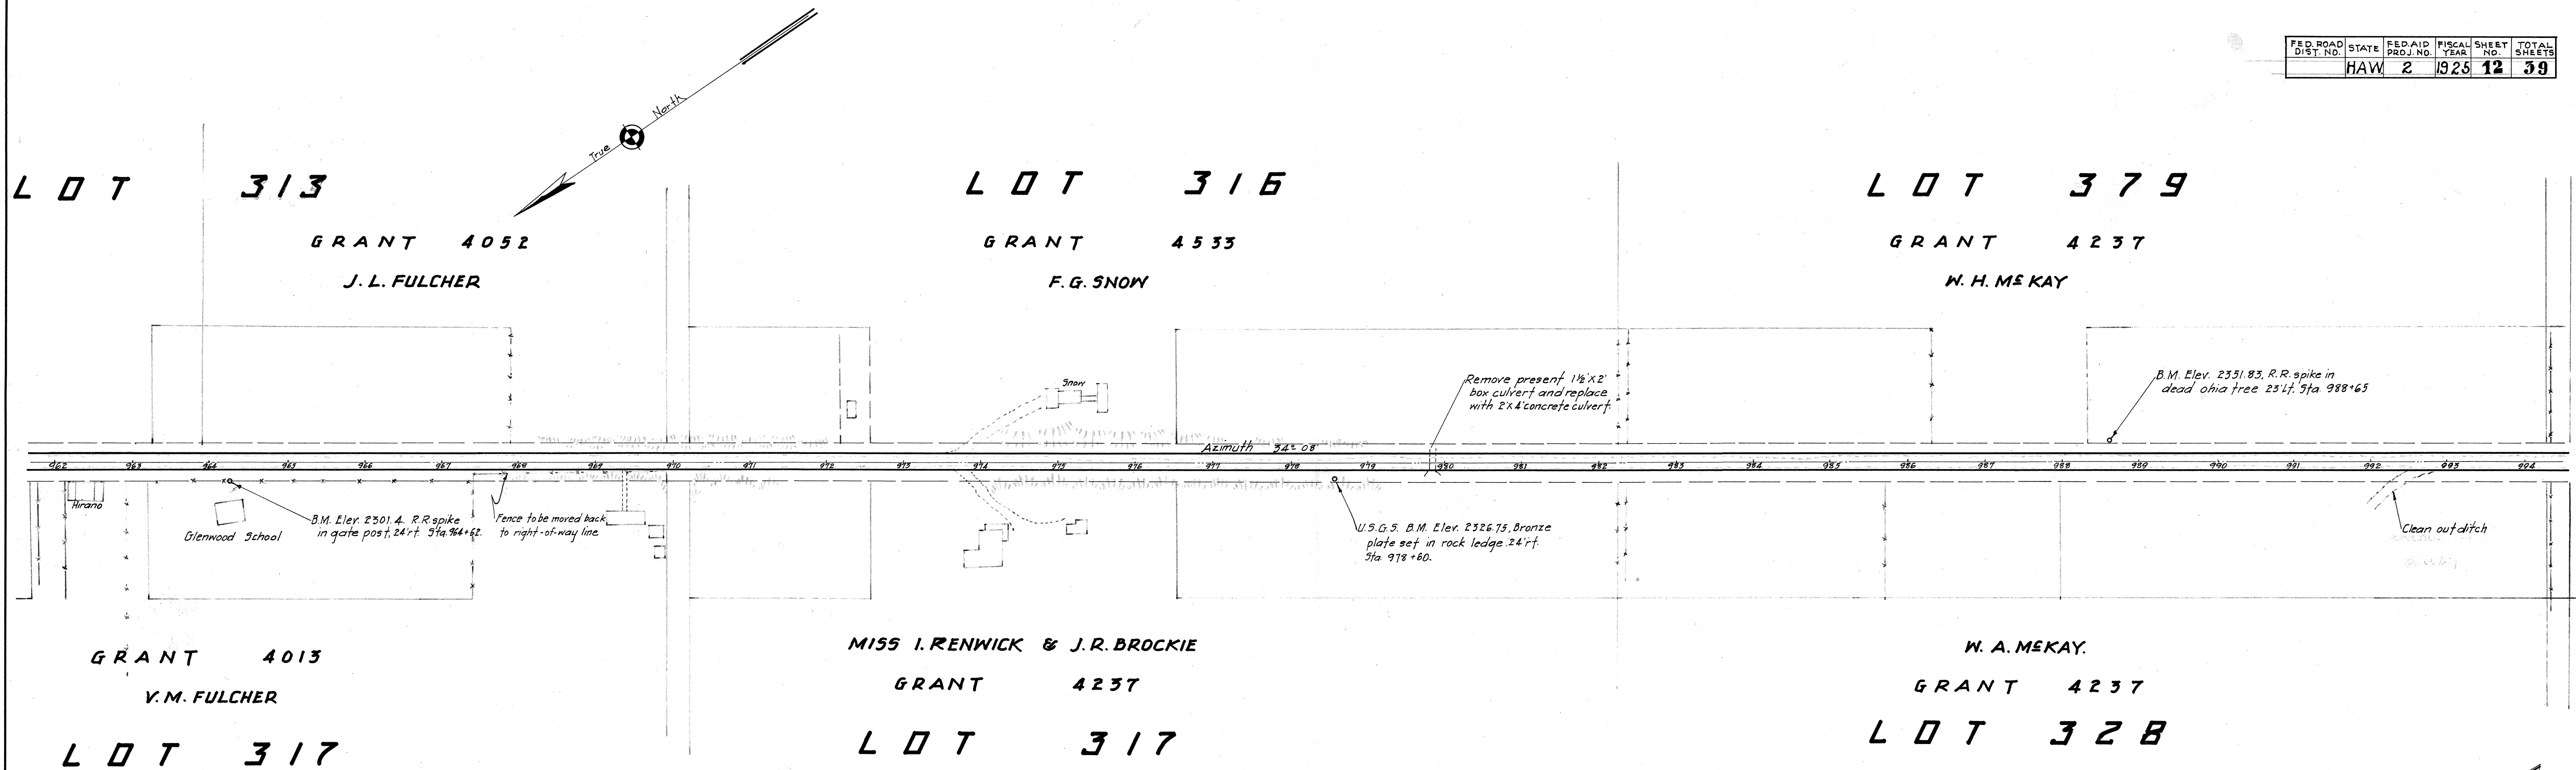

LOT 332

LOT 345


GRANT 4175

F. M. WAKEFIELD

LOT 348

GRANT 4403

A. R. HITCHCOCK

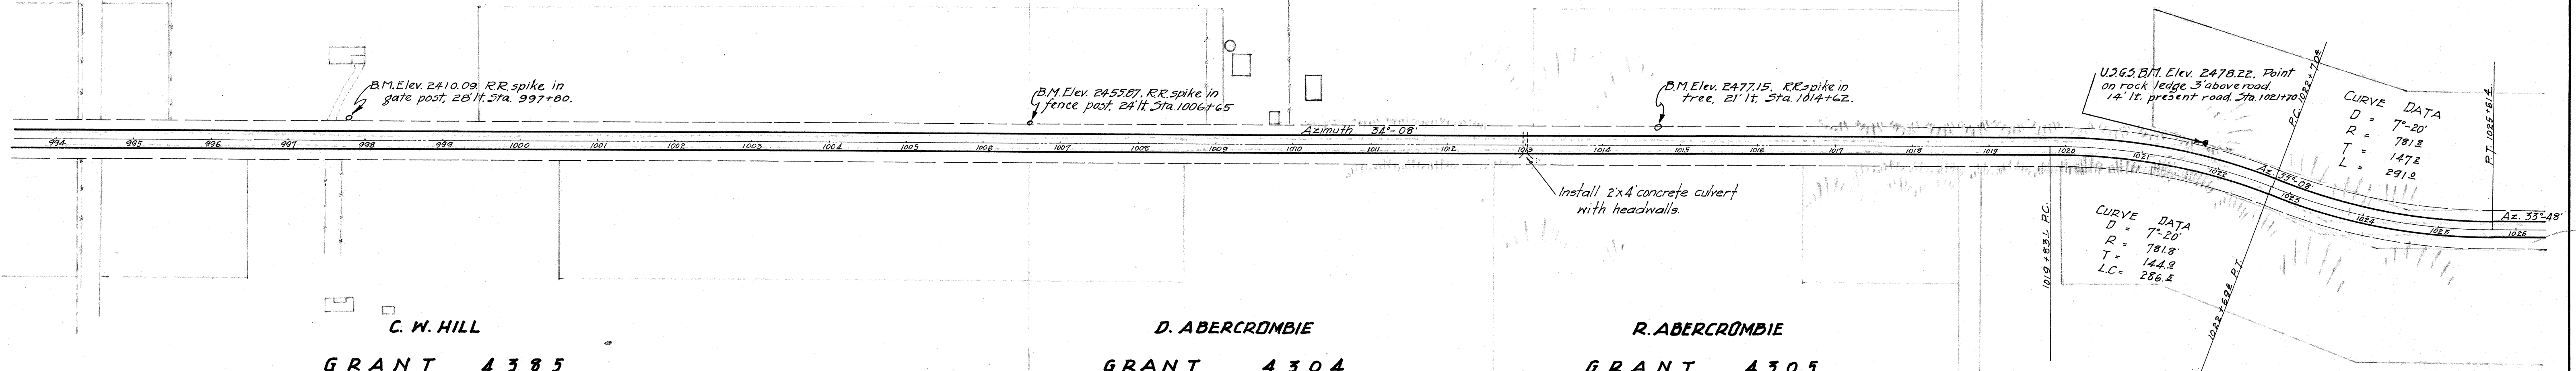

C. W. HILL

GRANT 4385

LOT 333

D. ABERCROMBIE

GRANT 4304

LOT 344


R. ABERCROMBIE

GRANT 4305

GRANT 4346


DR. W. L. MOORE


LOT 349

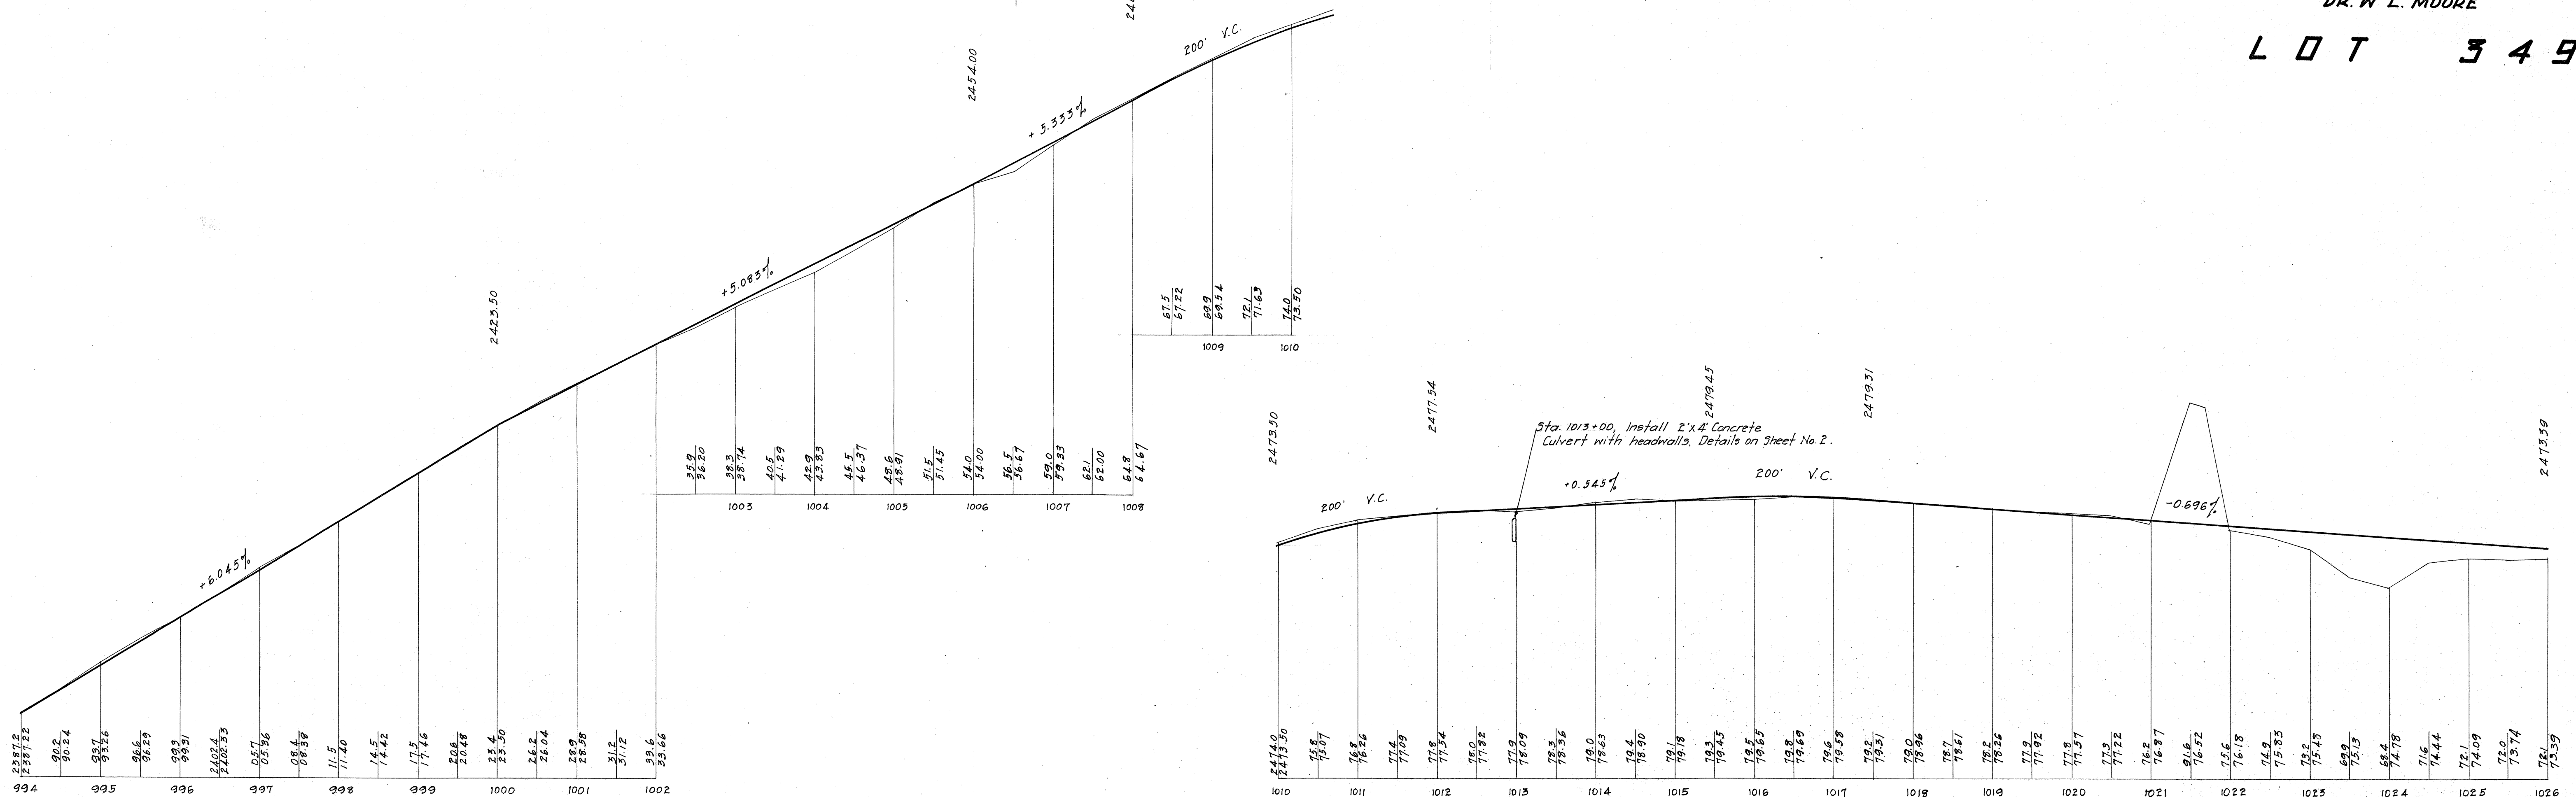

3063.13

LINE AND PROFILE, STA. 994 TO STA. 1026

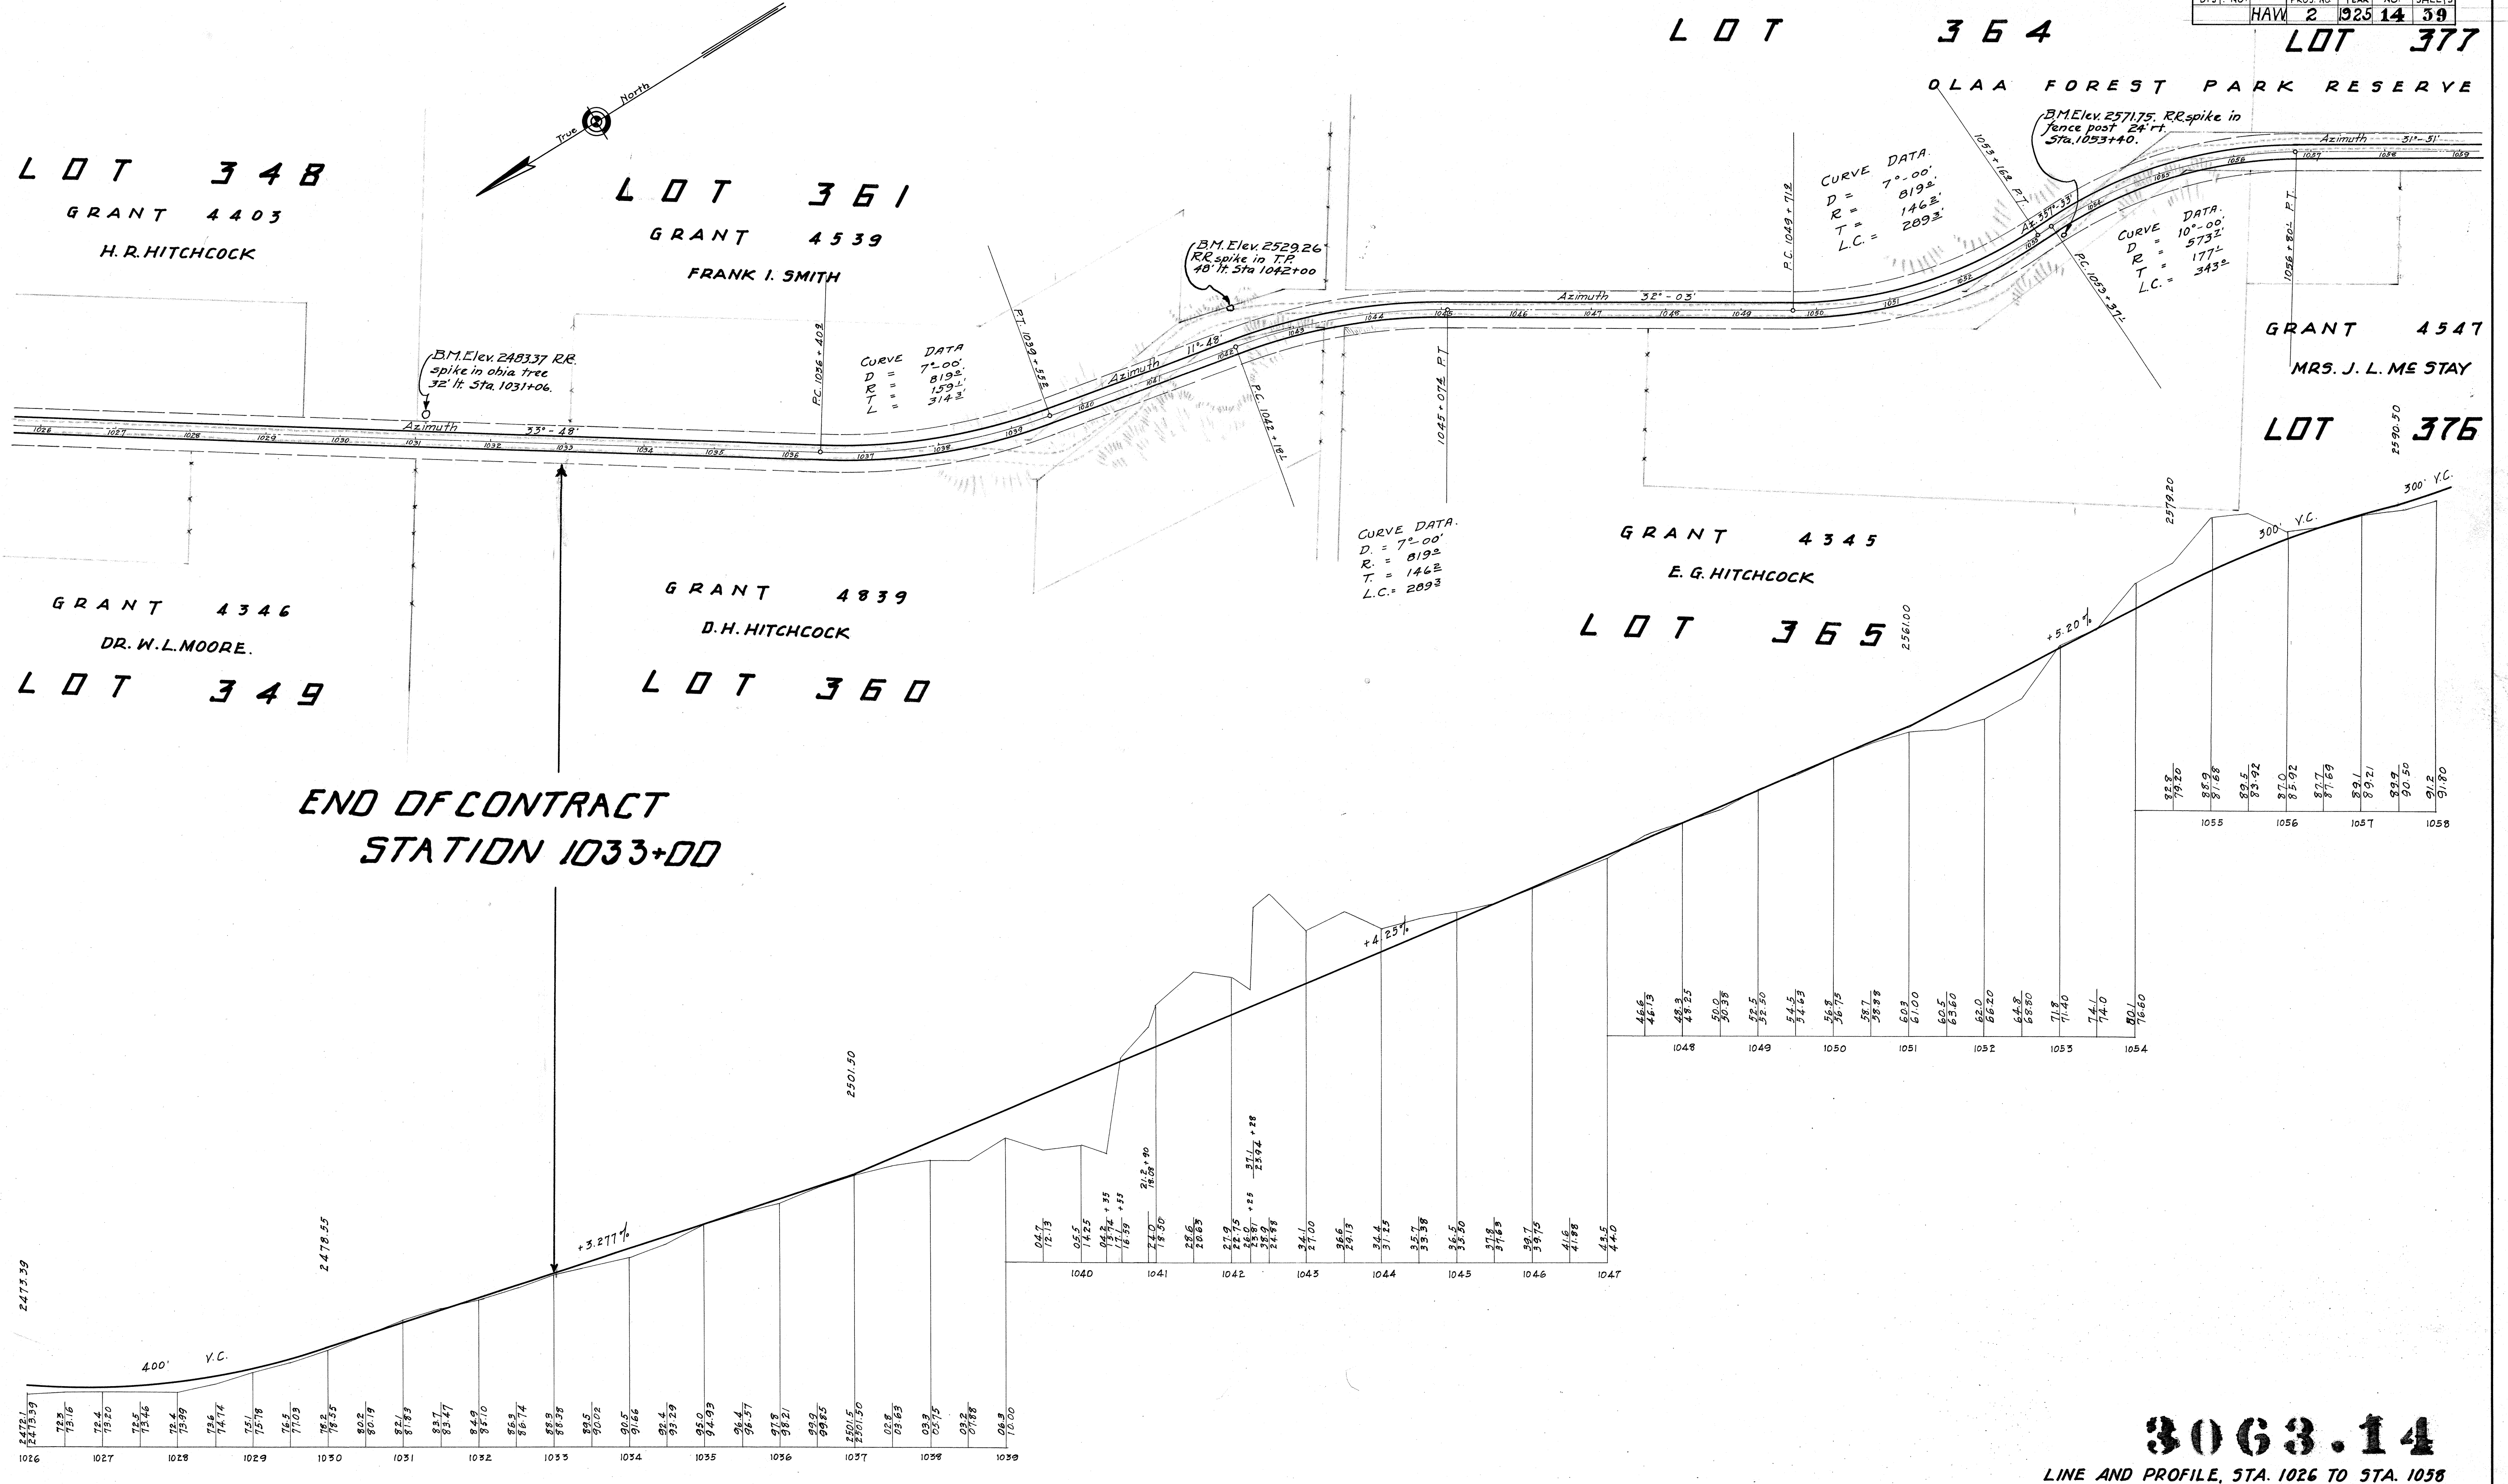

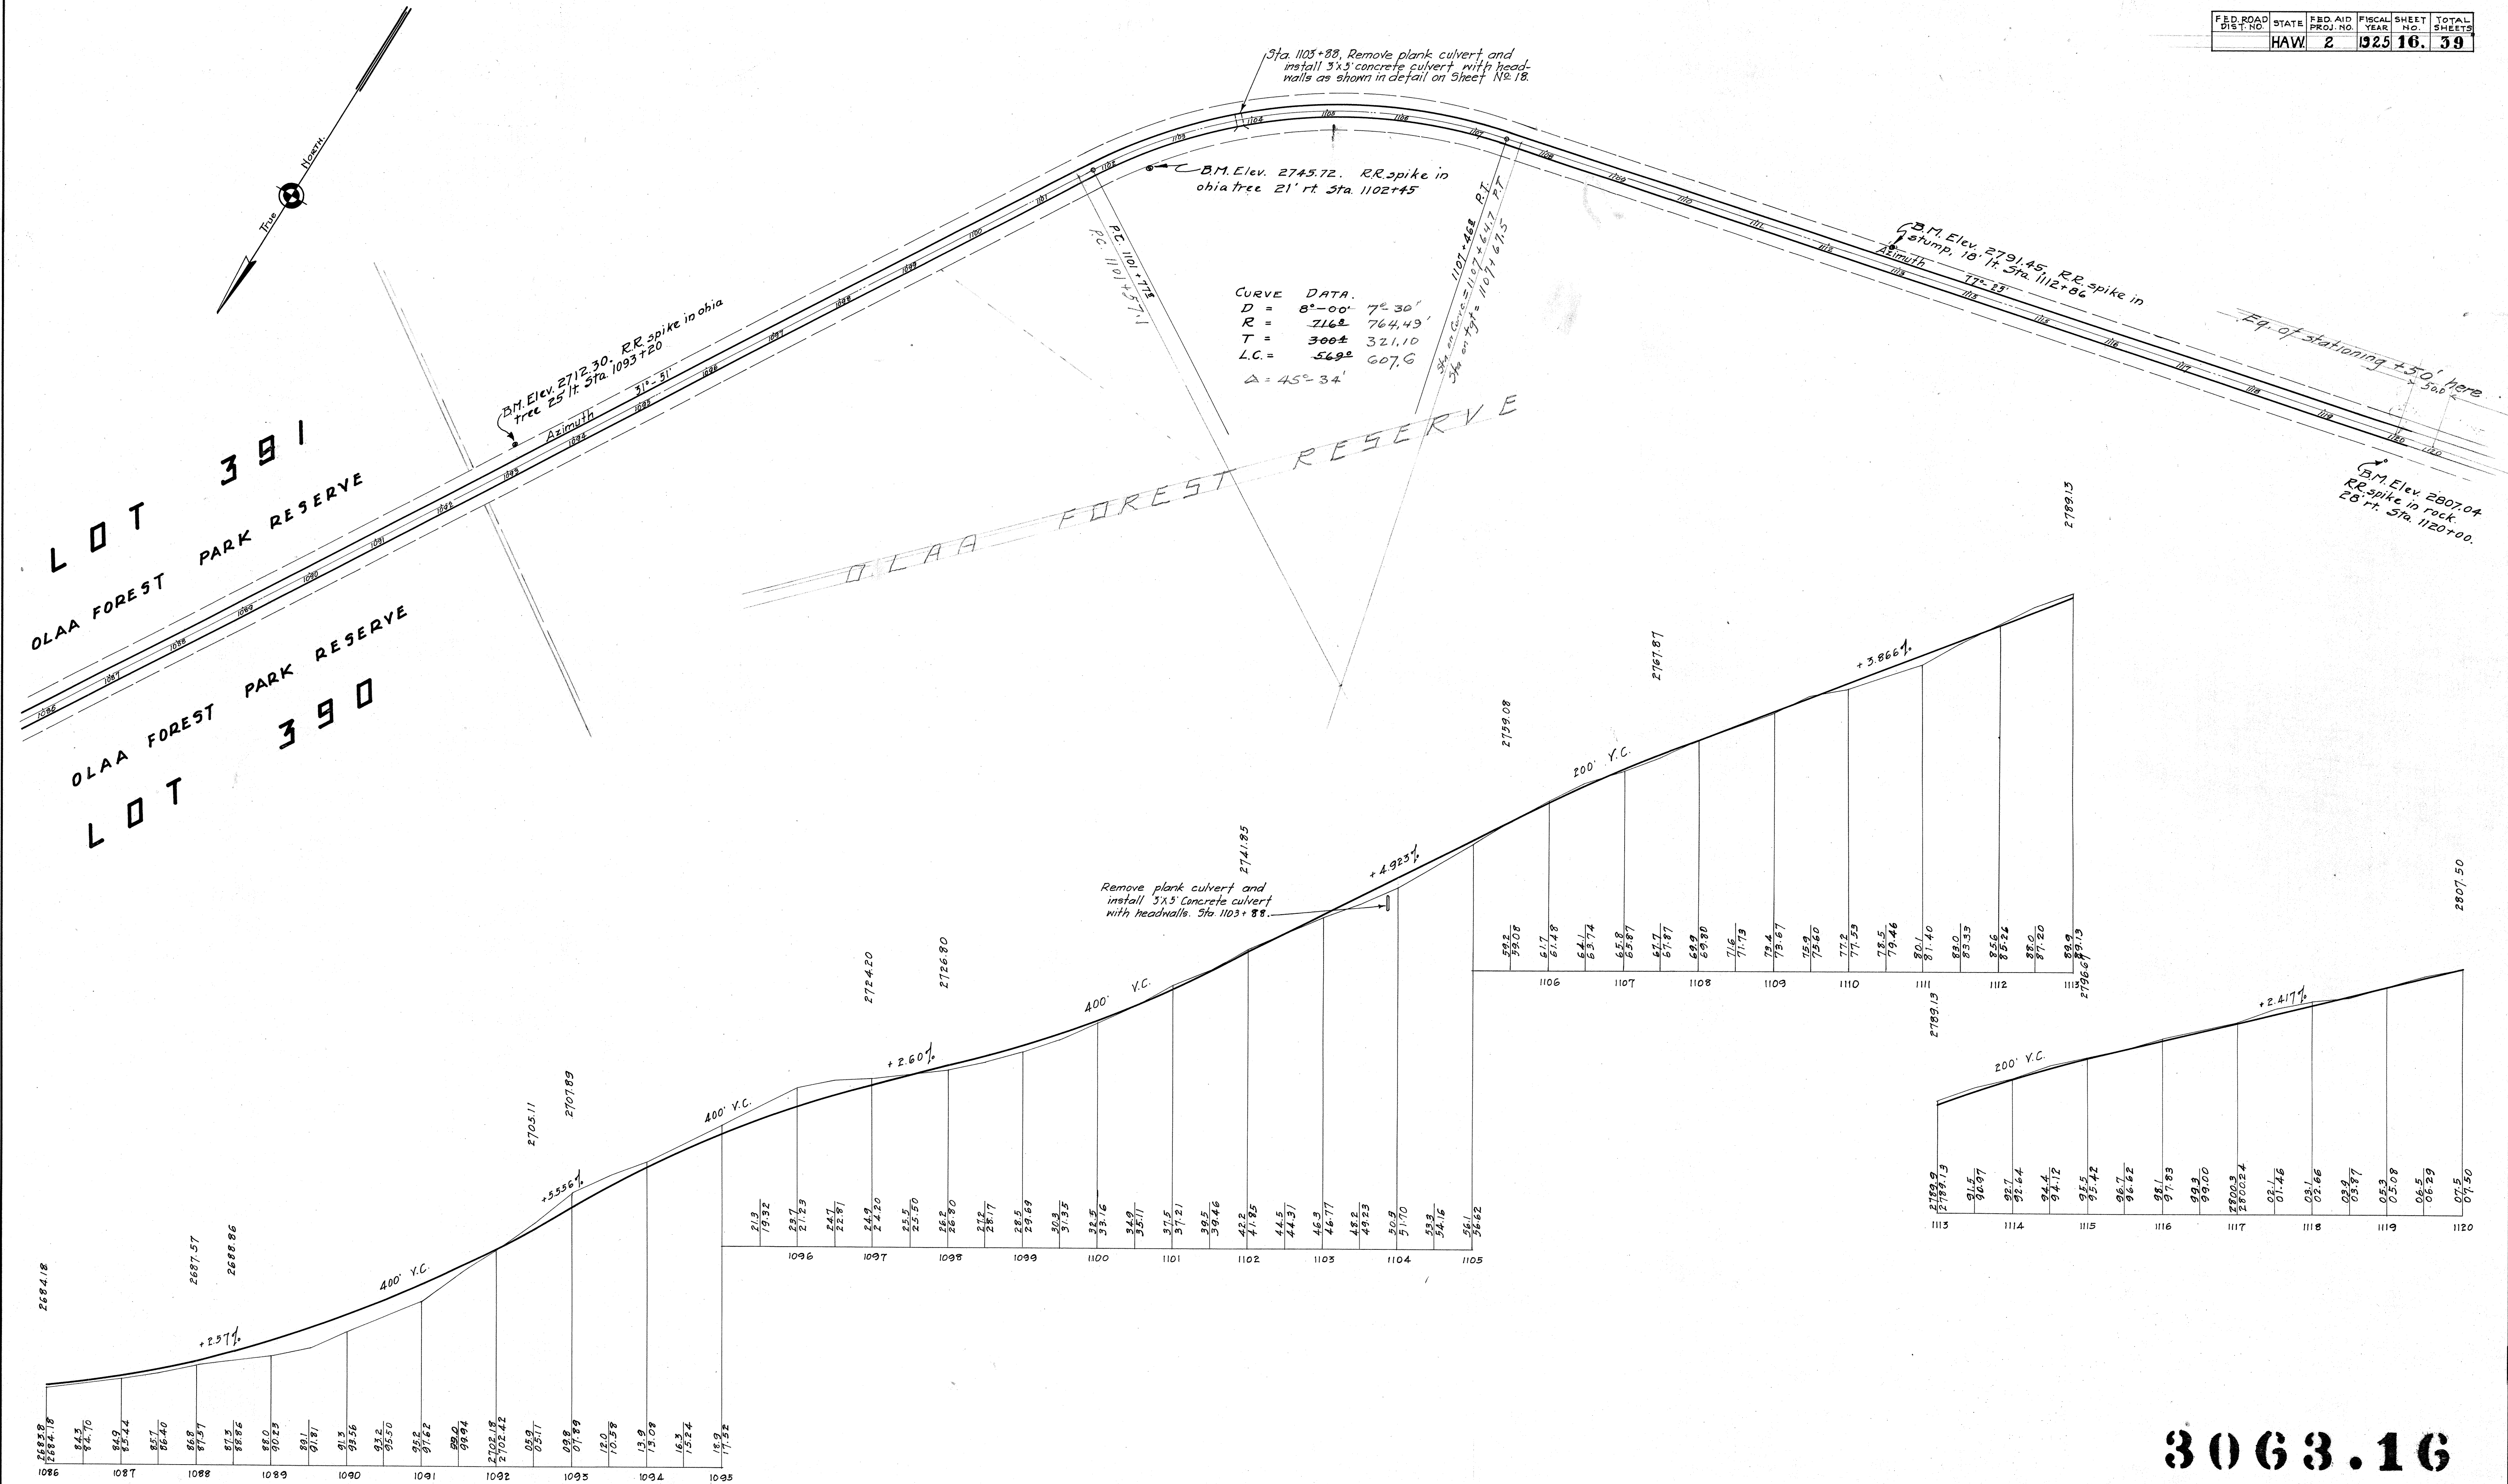

3063.16

LINE AND PROFILE, STA. 1086 TO STA. 1120