


## SCALES

PLAN 1"=100'  
 PROFILE HOR. 1"=100'  
 VER. 1"= 10'  
 SECTIONS 1"= 10'  
 DETAILS AS NOTED.

DEPARTMENT OF PUBLIC WORKS  
 TERRITORY OF HAWAII

FEDERAL AID PROJECT

## LOCATION MAP

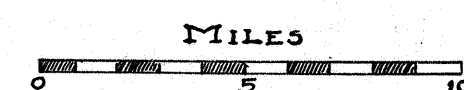

# PLANS FOR THE CONTINUATION OF THE VOLCANO ROAD, HAWAII.

BEGINNING AT THE SOUTH TERMINAL OF THE CONCRETE ROAD CONSTRUCTED  
 UNDER ITEM 19, ACT 218, S.L. 1921, AND RUNNING TOWARD THE VOLCANO.

## INDEX

SUBJECT	SHEET NO.
PLAN & PROFILE.	3 to 15
TYPICAL SECTIONS.	2
CULVERT DETAILS.	2 - 18
DETAILS OF CHANGES TO EXISTING STRUCTURES.	17 to 20
CROSS-SECTIONS.	22 to 39
TABULATION OF QUANTITIES.	21
DETAILS; GUARD POSTS, SLOPE PAVING MILE POSTS.	2

IN ACCORDANCE WITH  
 ITEM 13, ACT 214, S.L. HAW. 1923.

DISTRICT OF PUNA.

COUNTY OF HAWAII.

T.H.

APPROVED *Oct 7* 1924.  
*Superintendent*  
 SUPERINTENDENT OF PUBLIC WORKS.

3063.1

RECOMMENDED FOR APPROVAL

DISTRICT ENGINEER-Bureau of Public Roads

RECOMMENDED FOR APPROVAL

CHIEF ENGINEER-Bureau of Public Roads

APPROVED

DIRECTOR-Bureau of Public Roads