






FOR SECTIONS STA. 558+00 TO 562+83.5 SEE SHEET NO. 16.

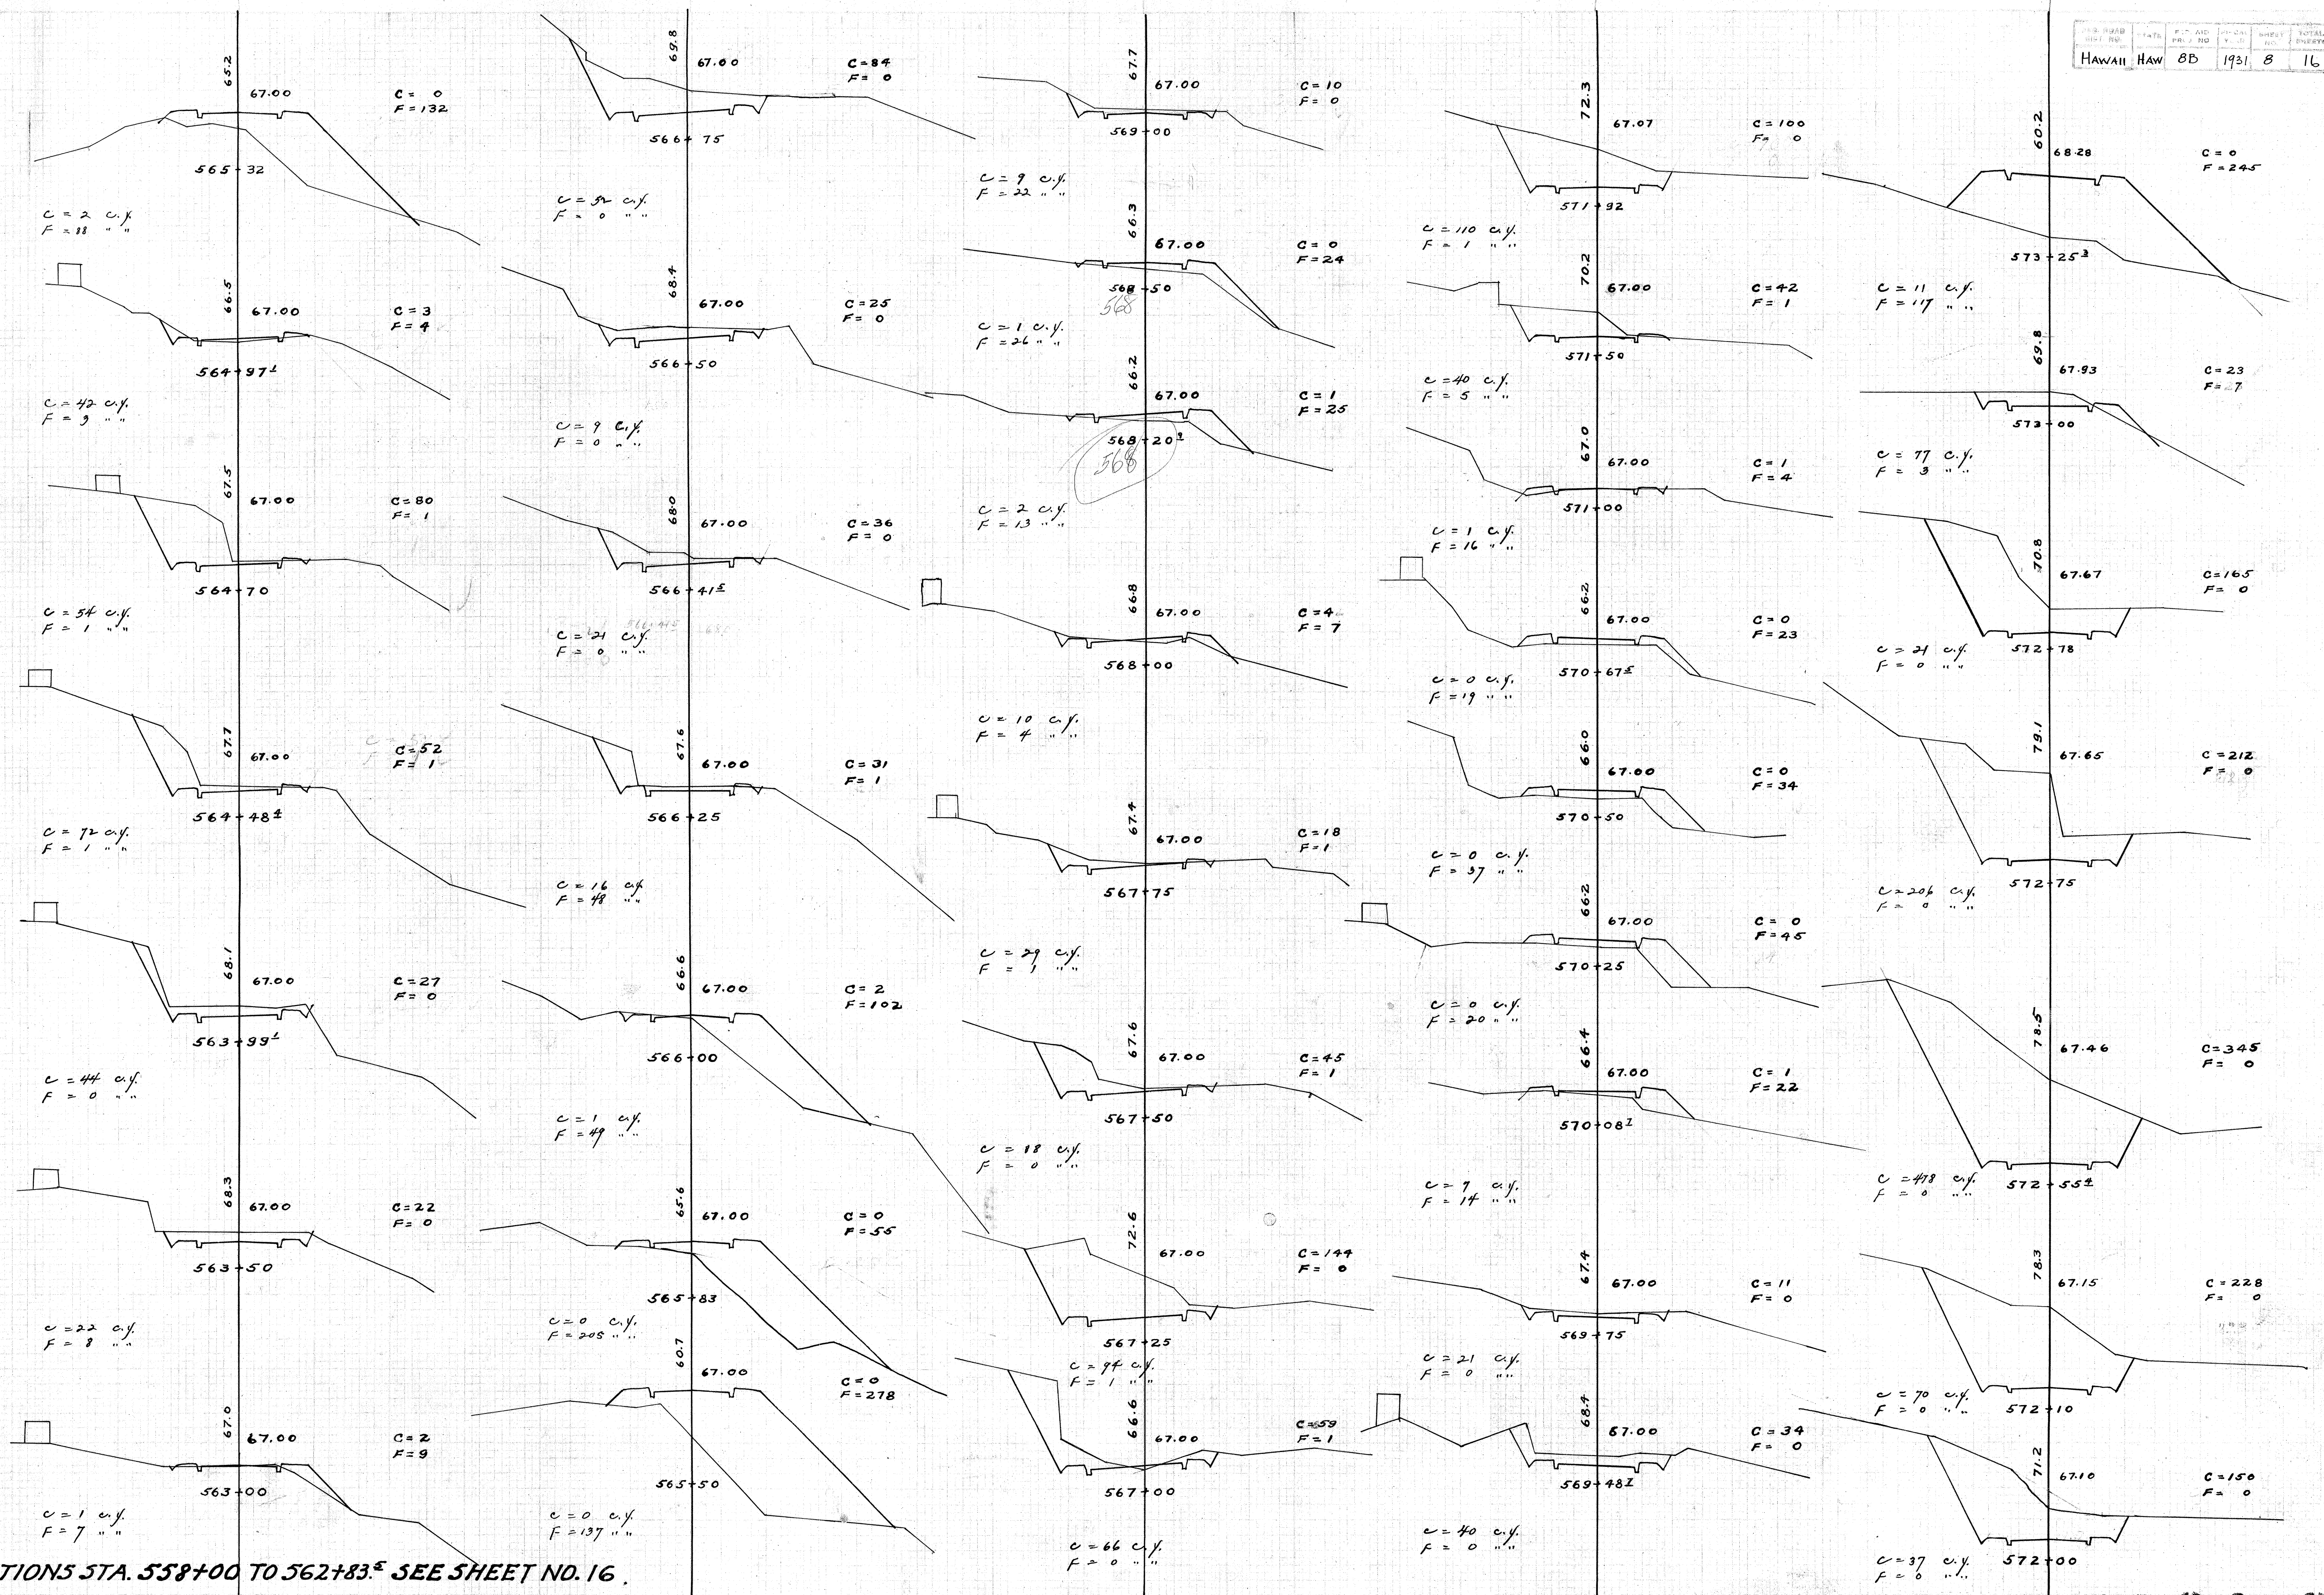

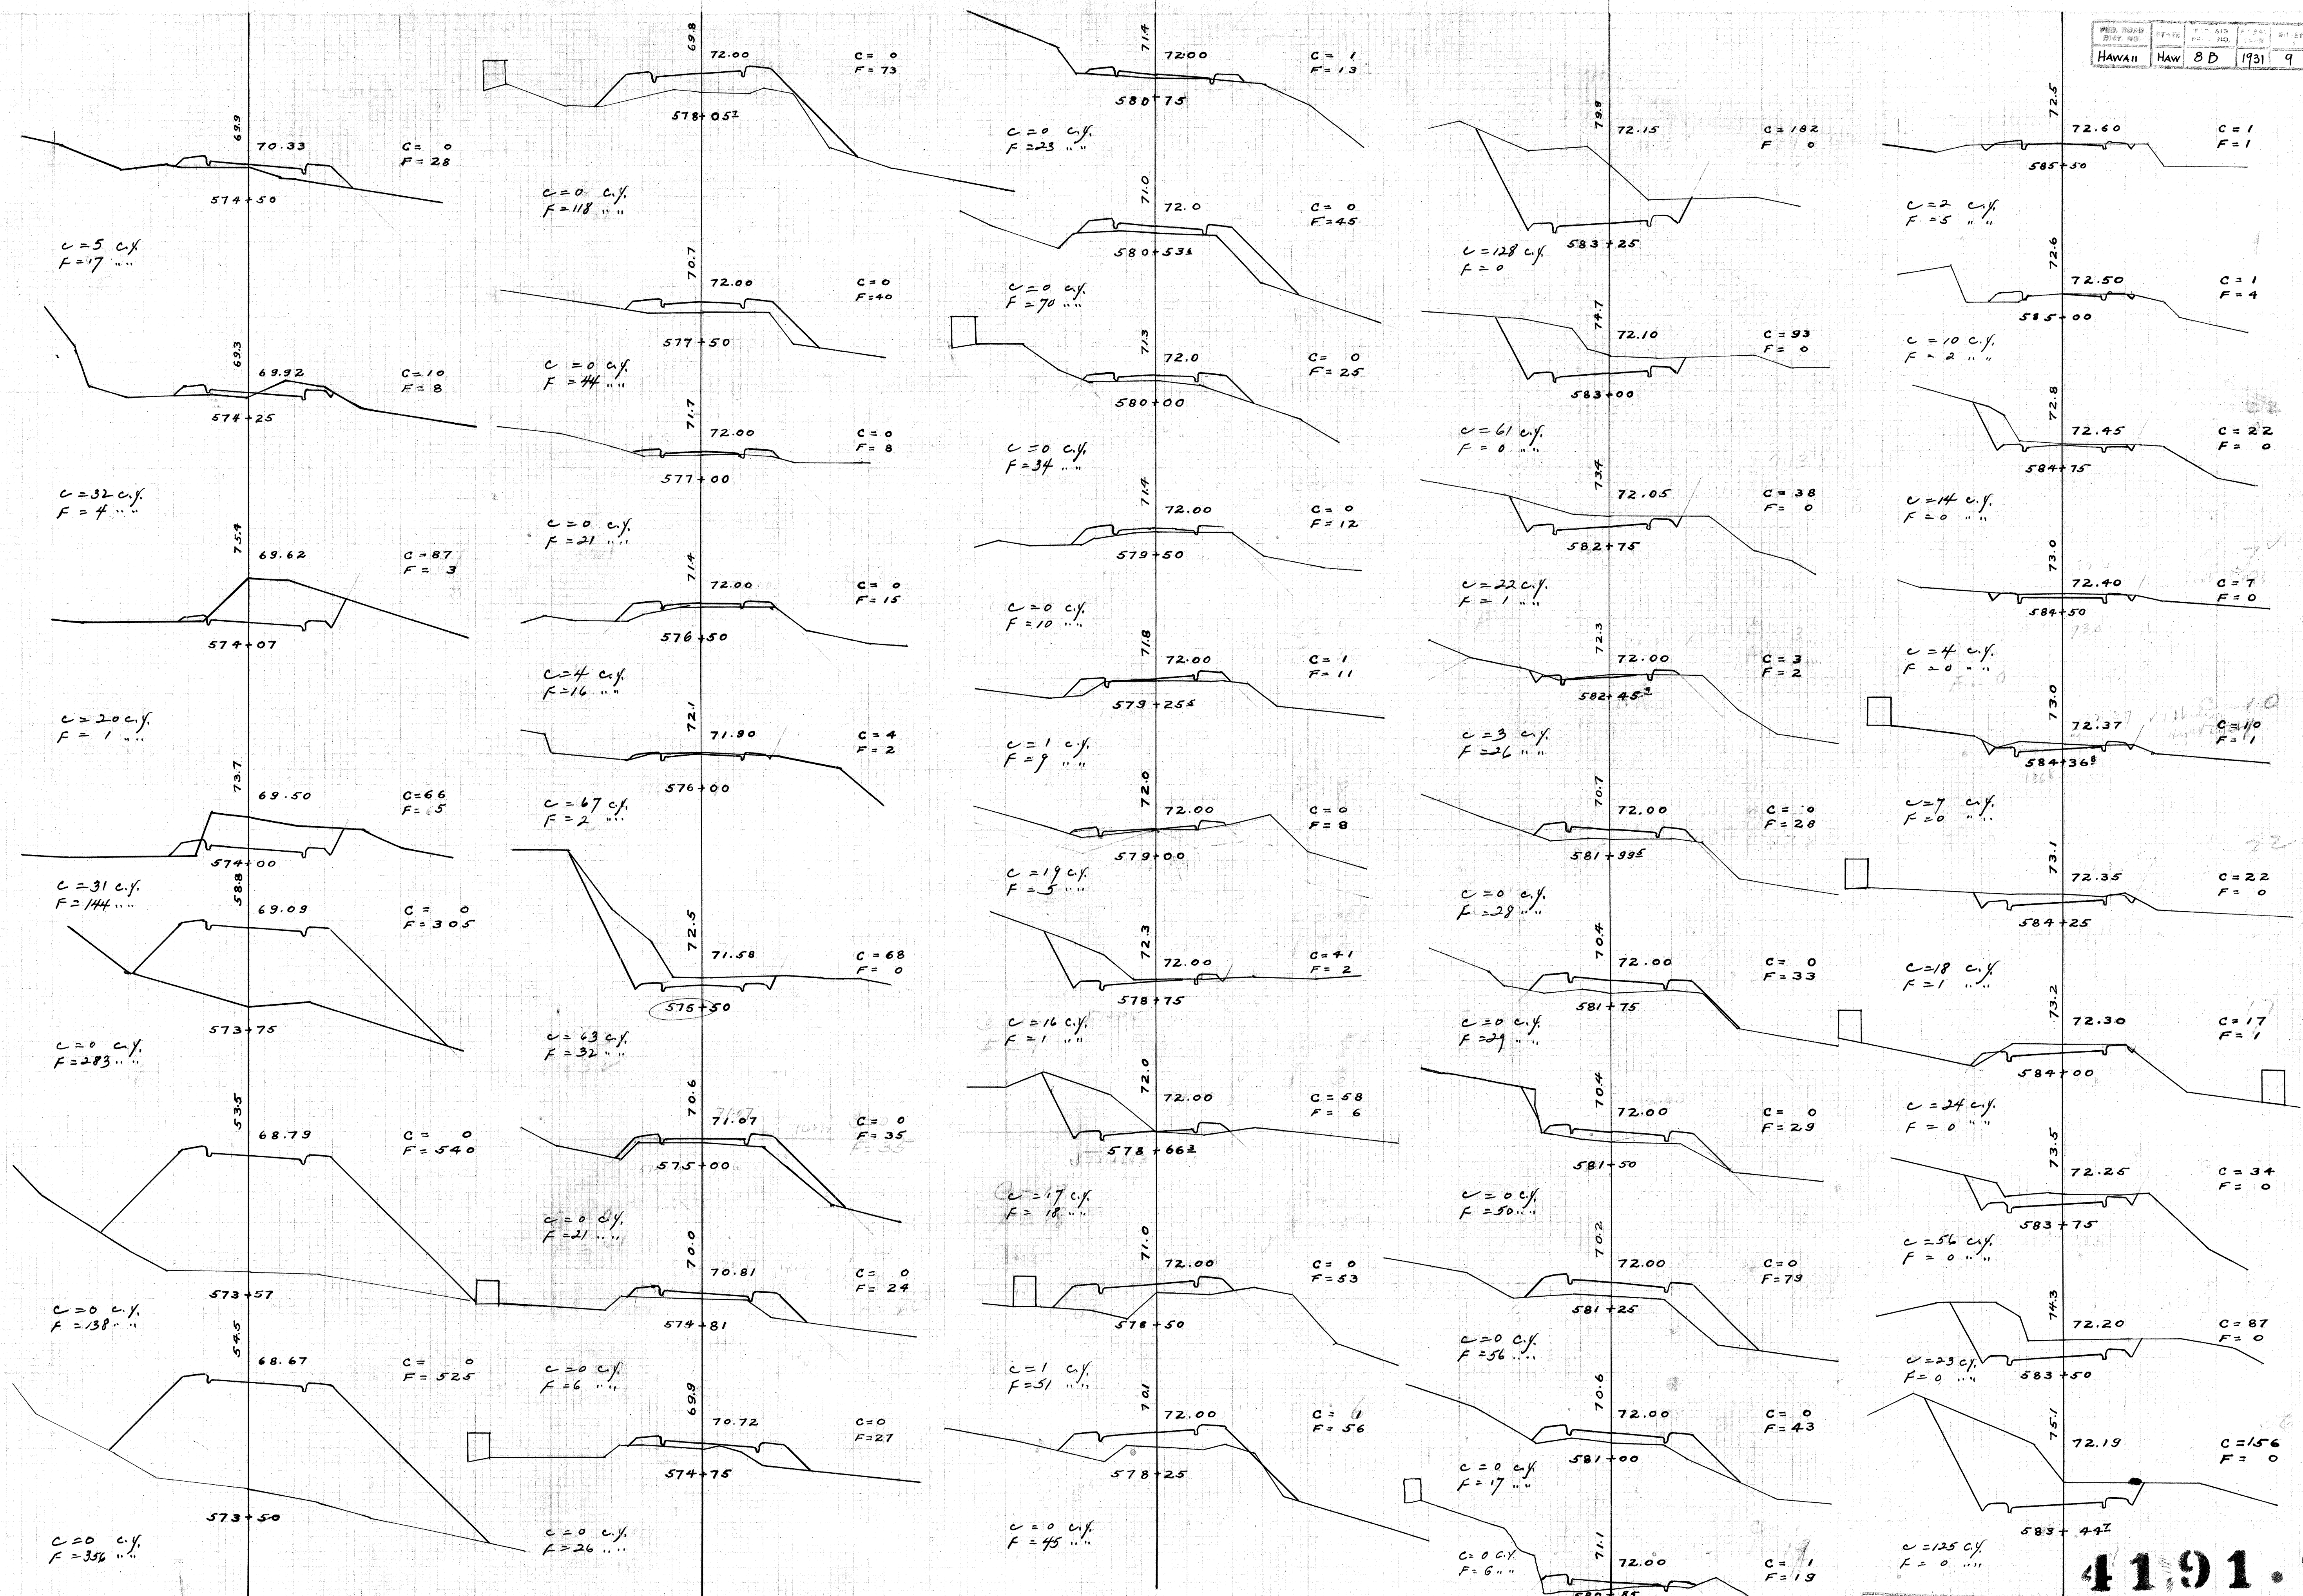


4191.9




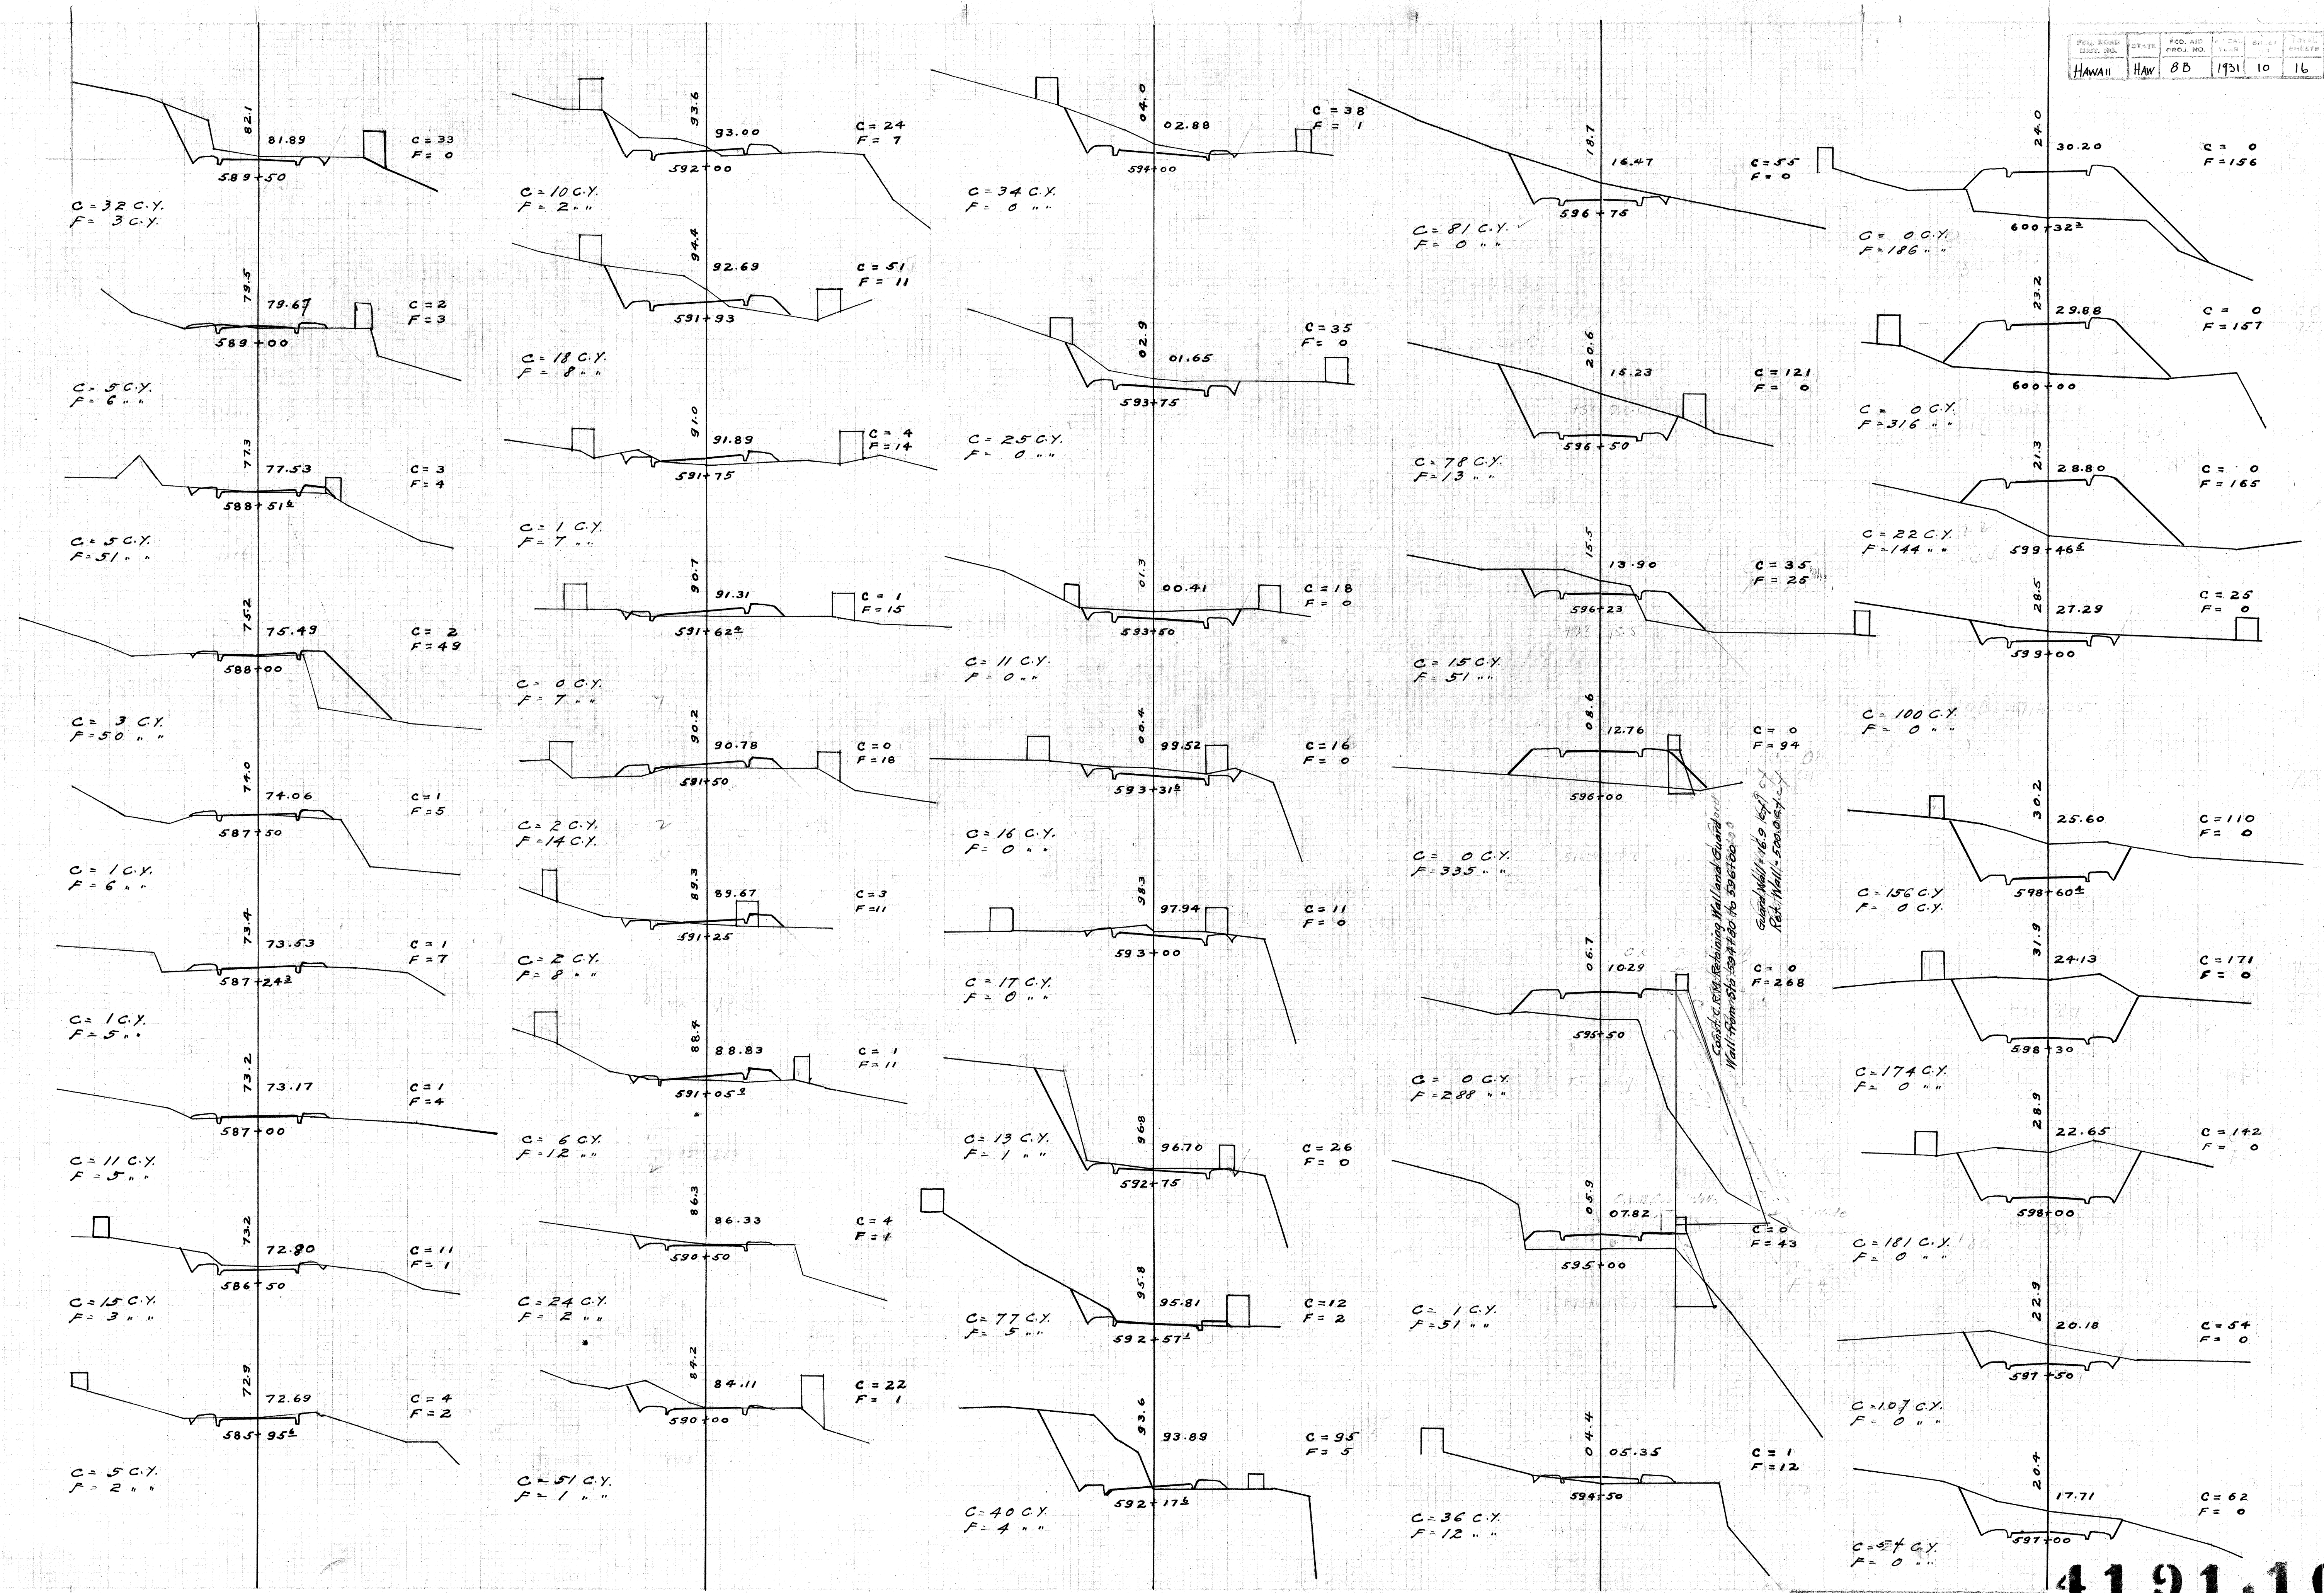



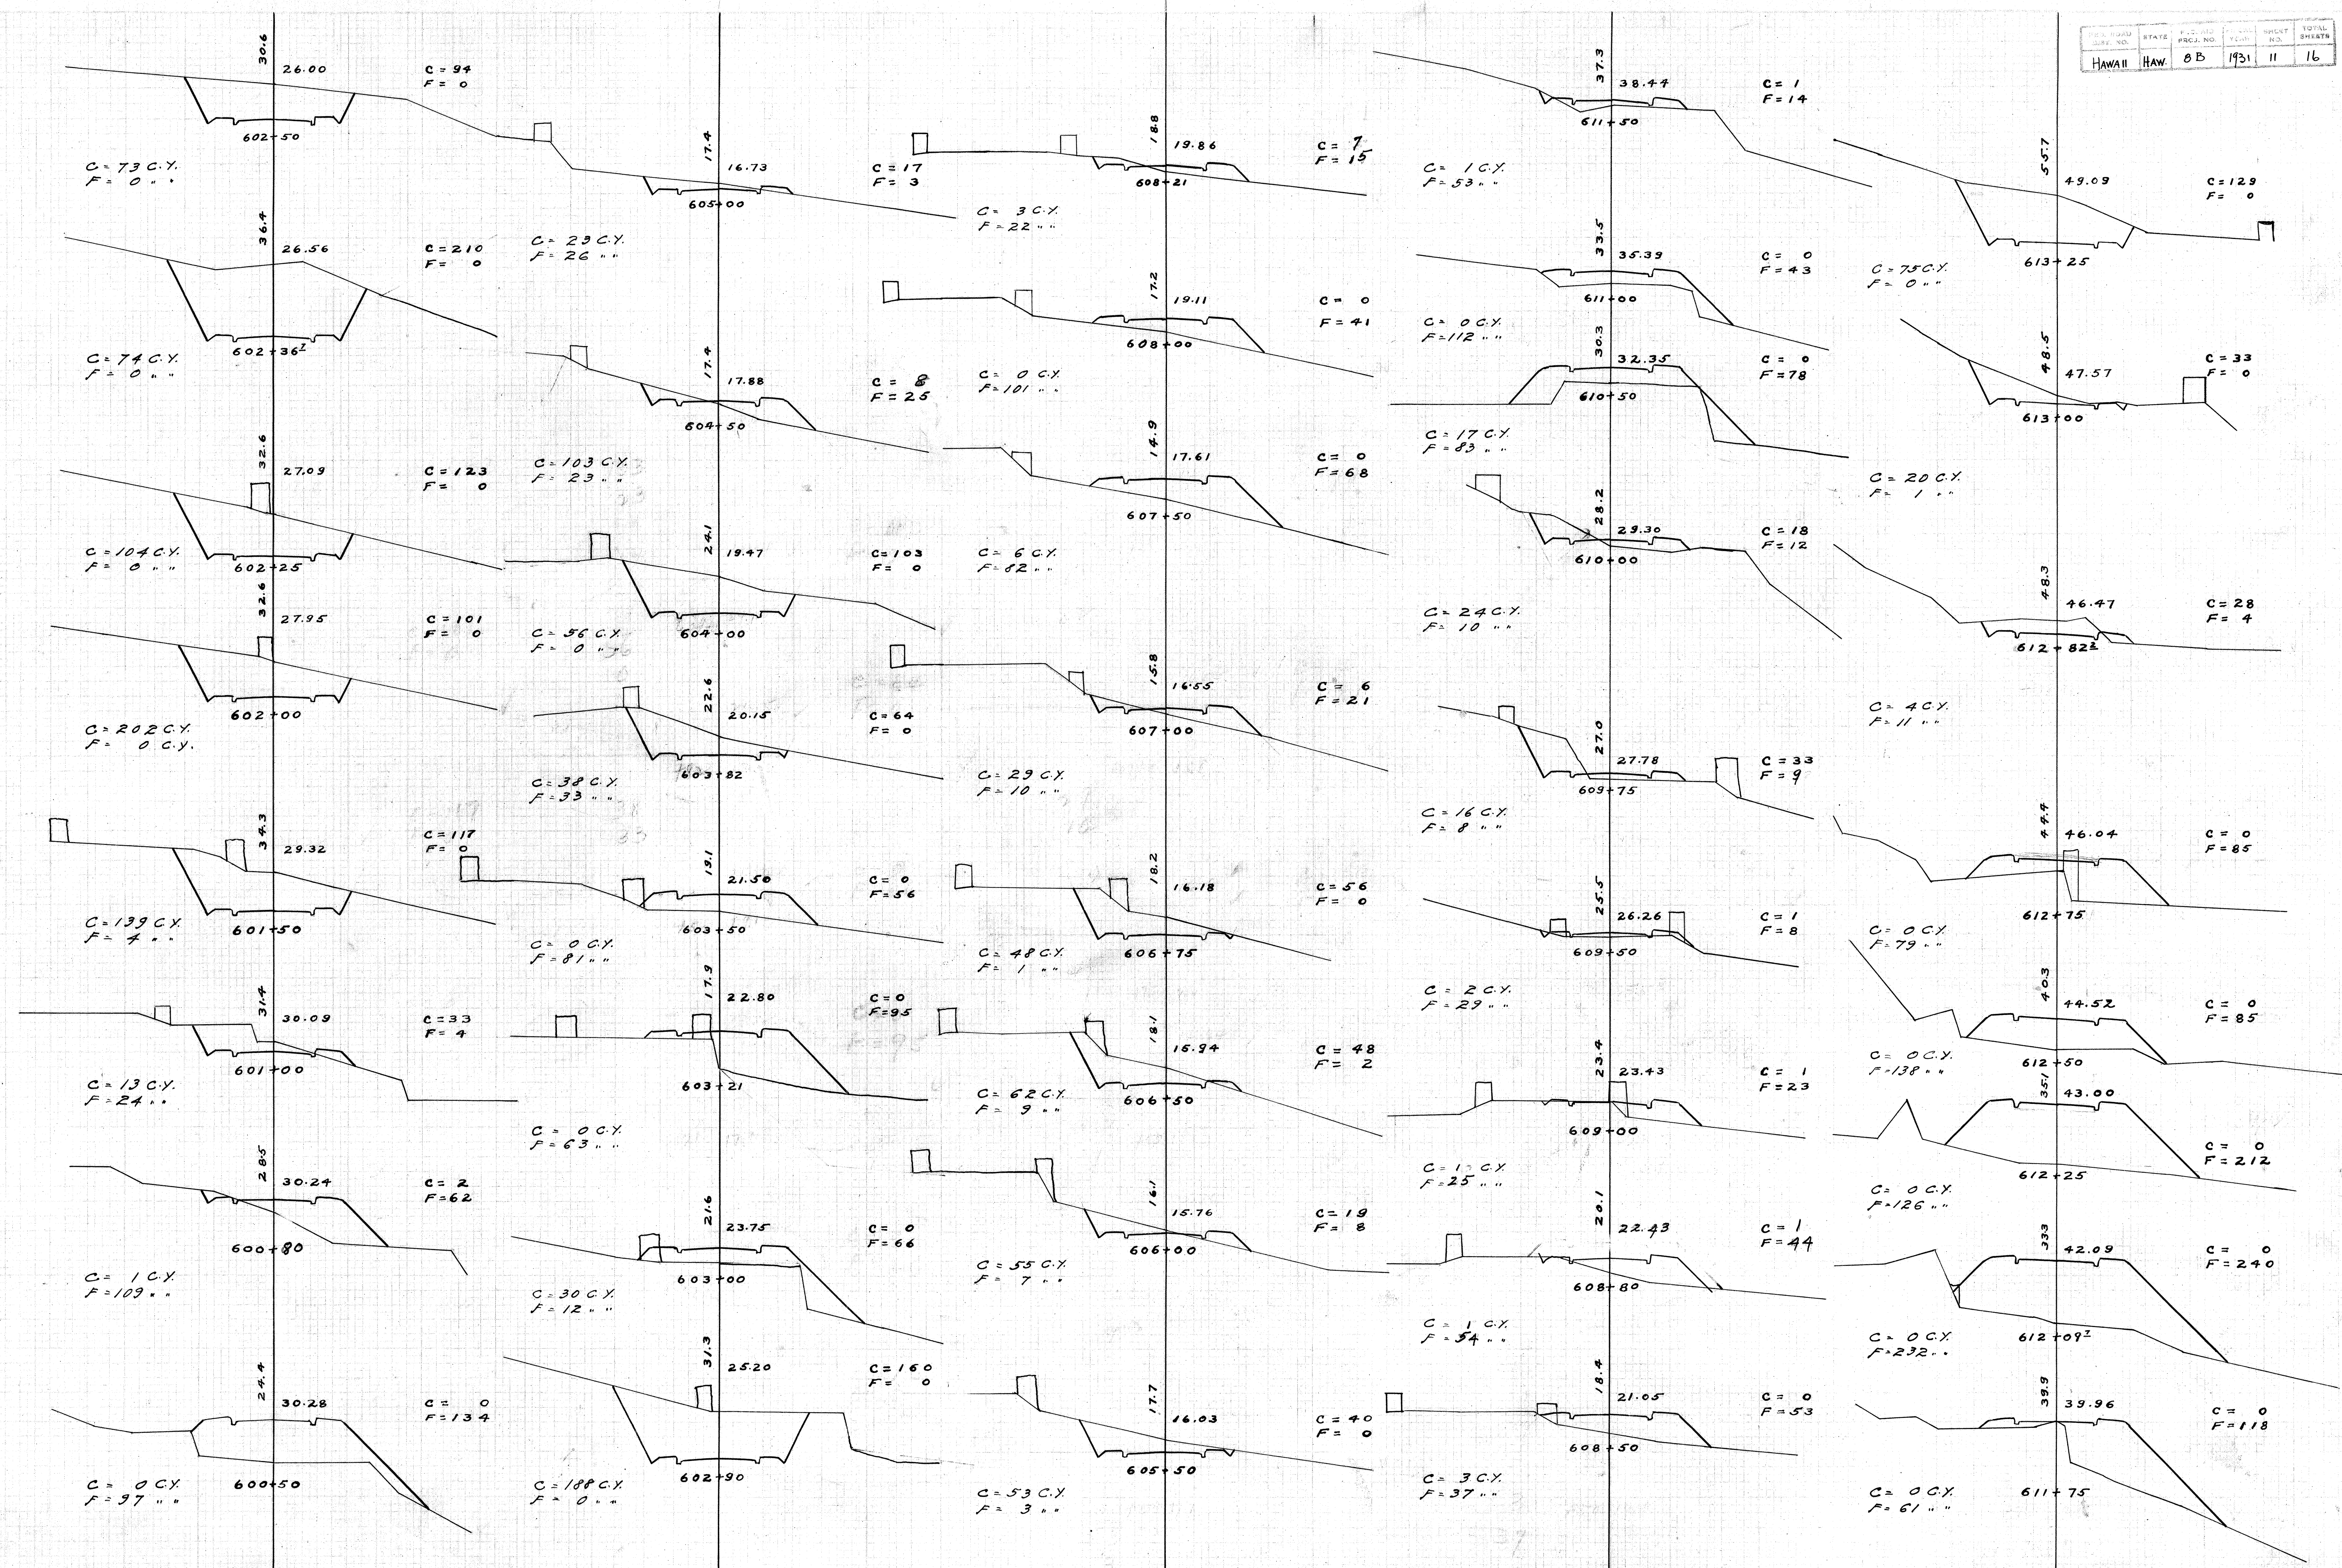




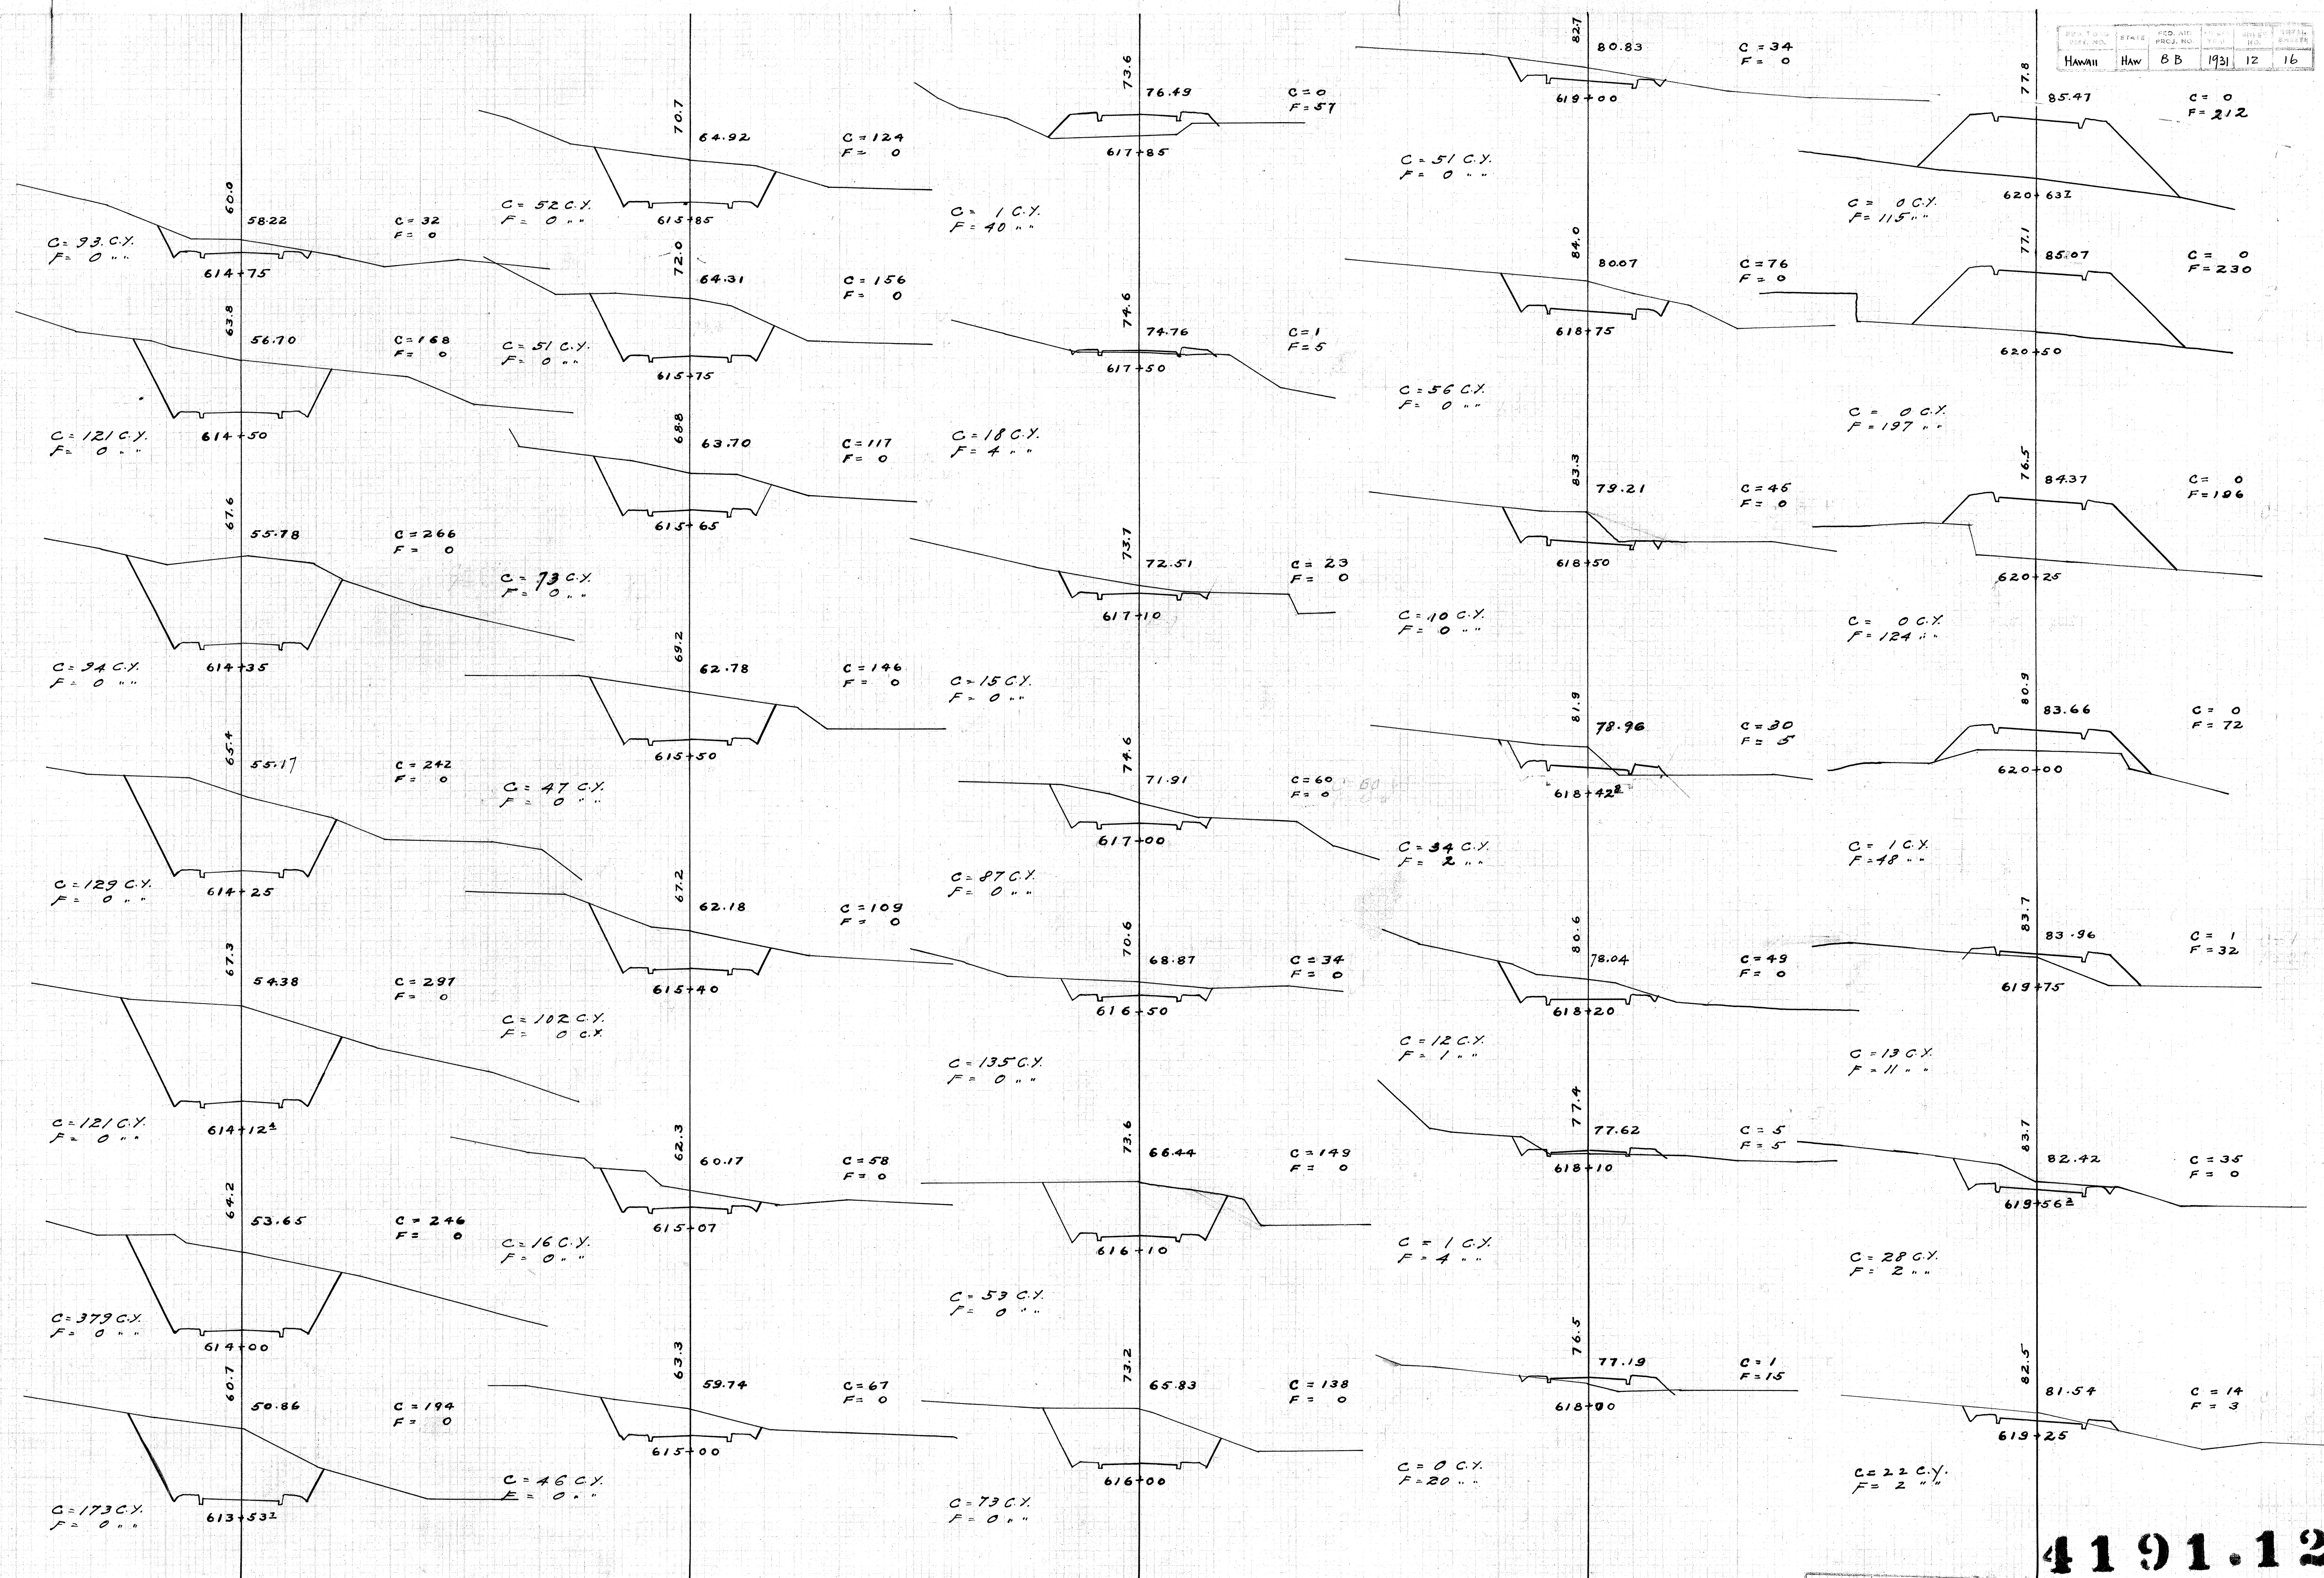

4191.12




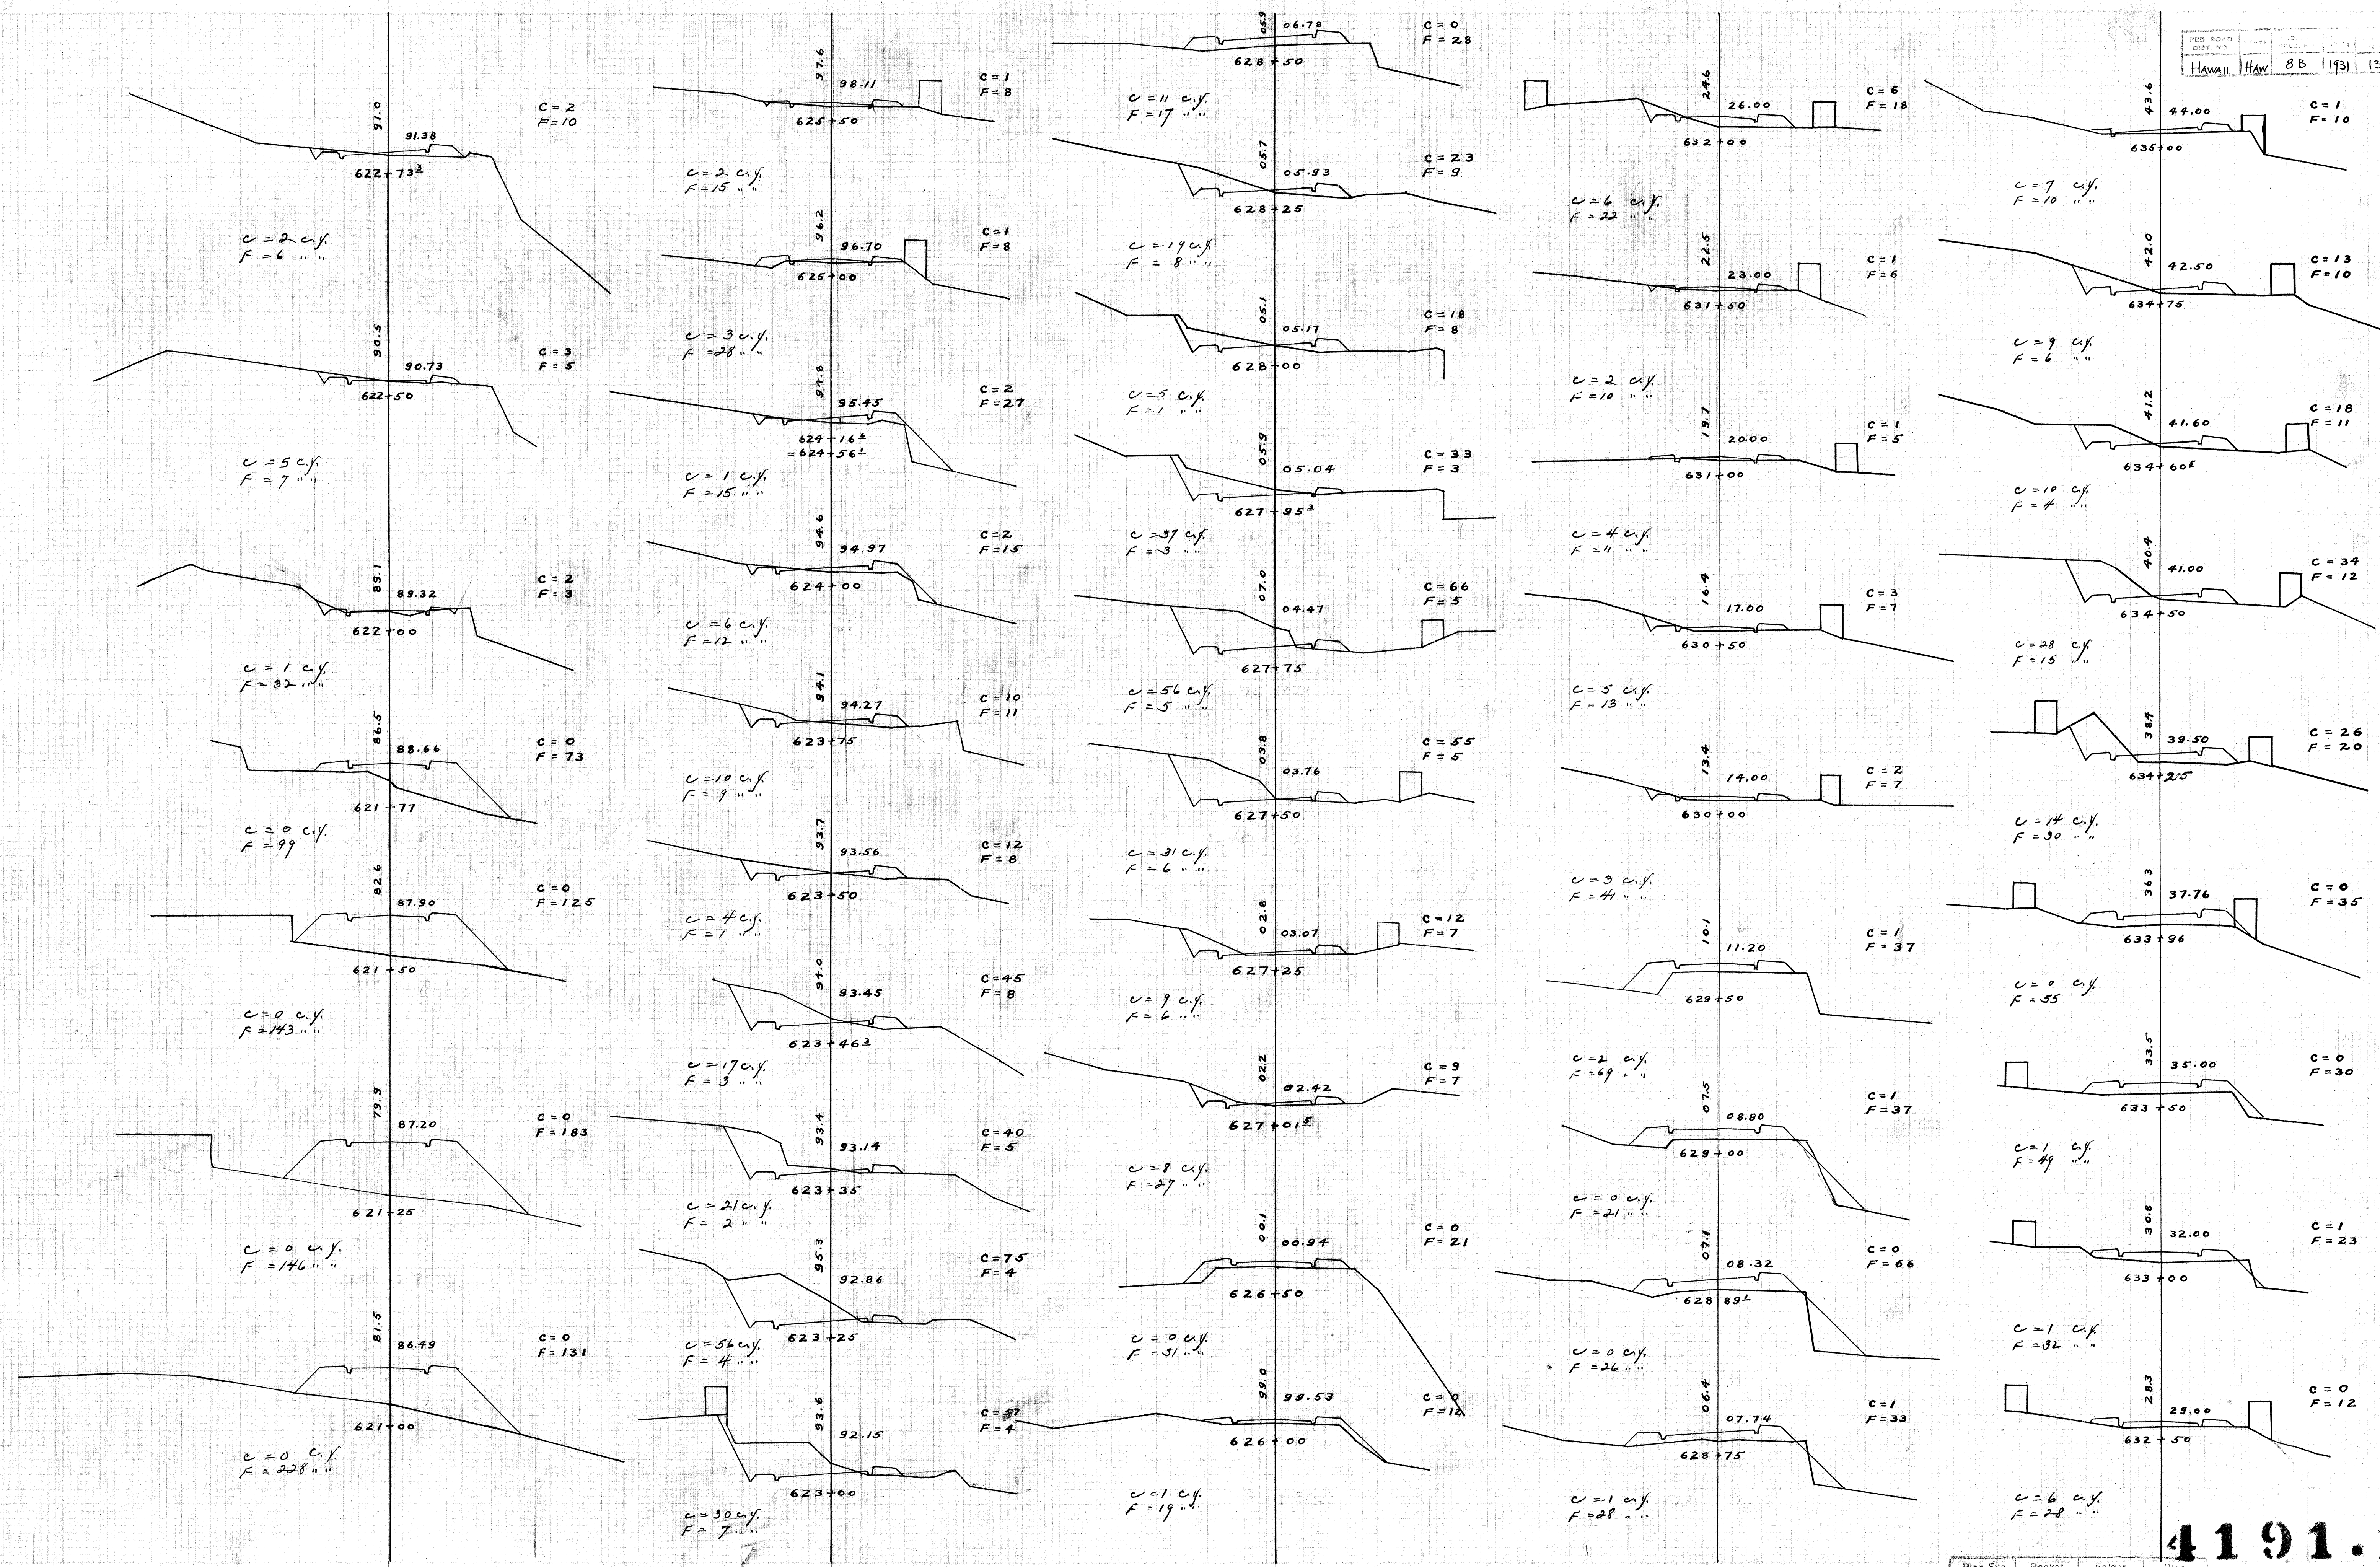








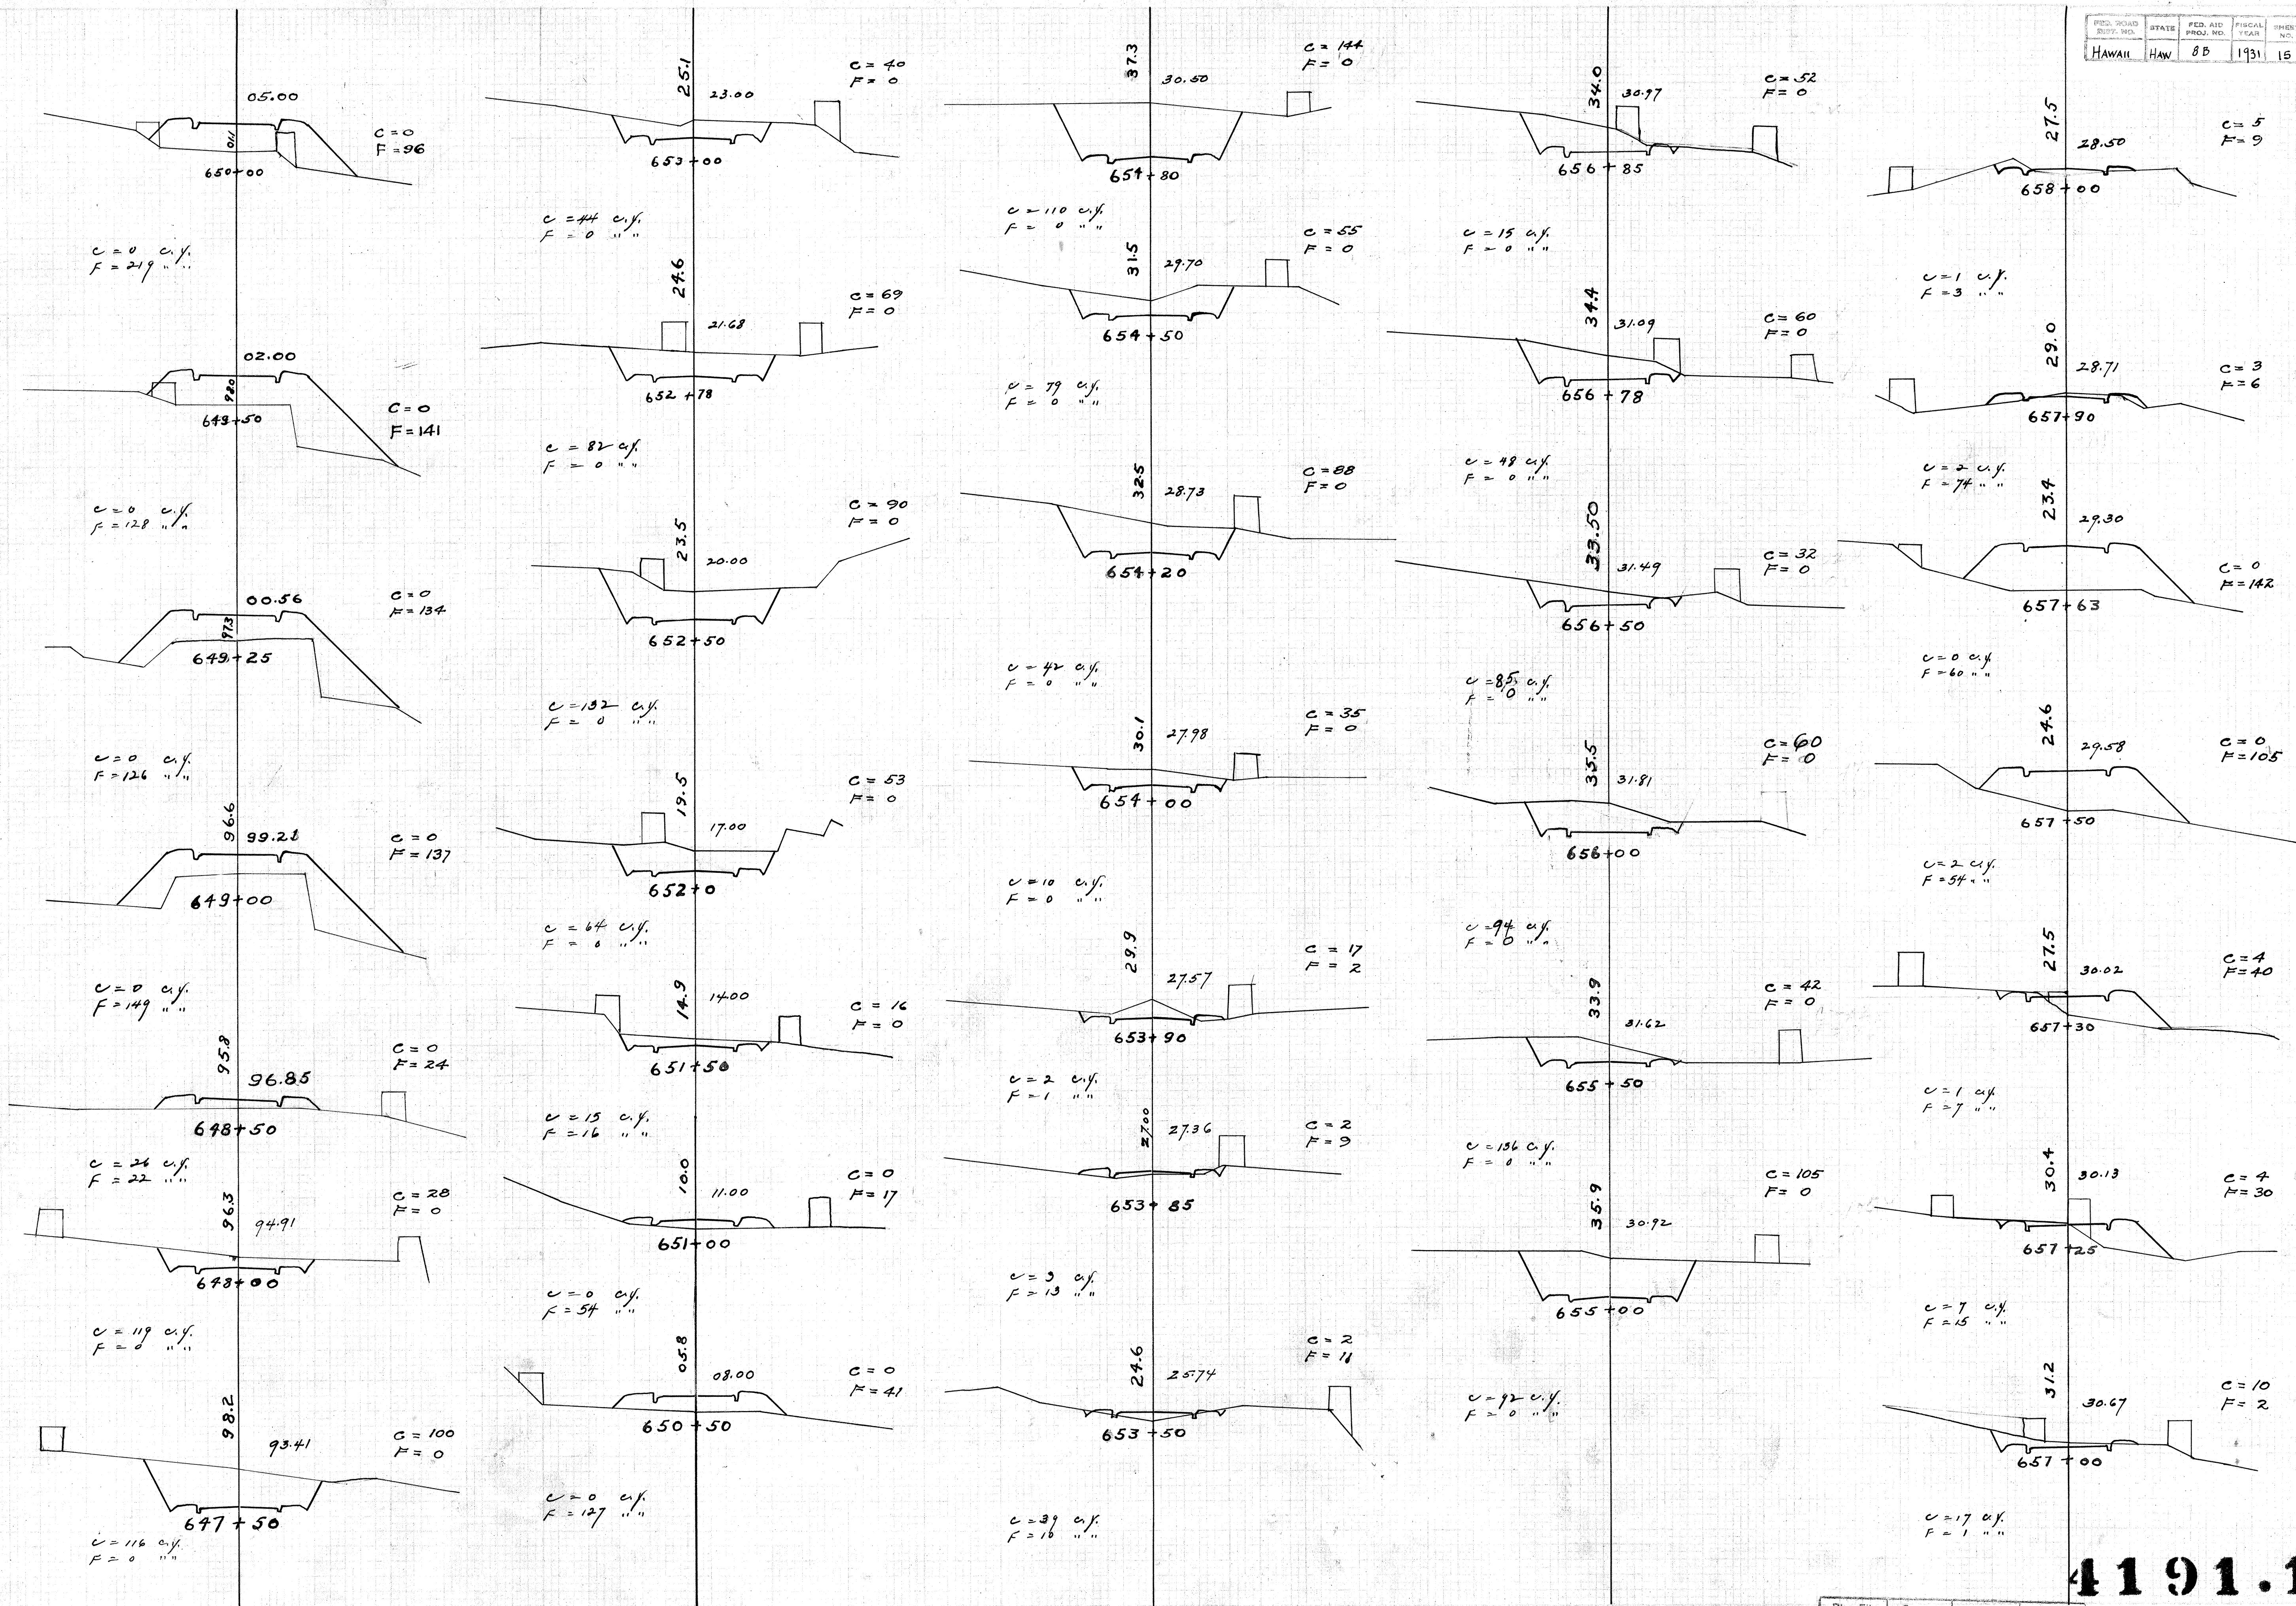


4191.15



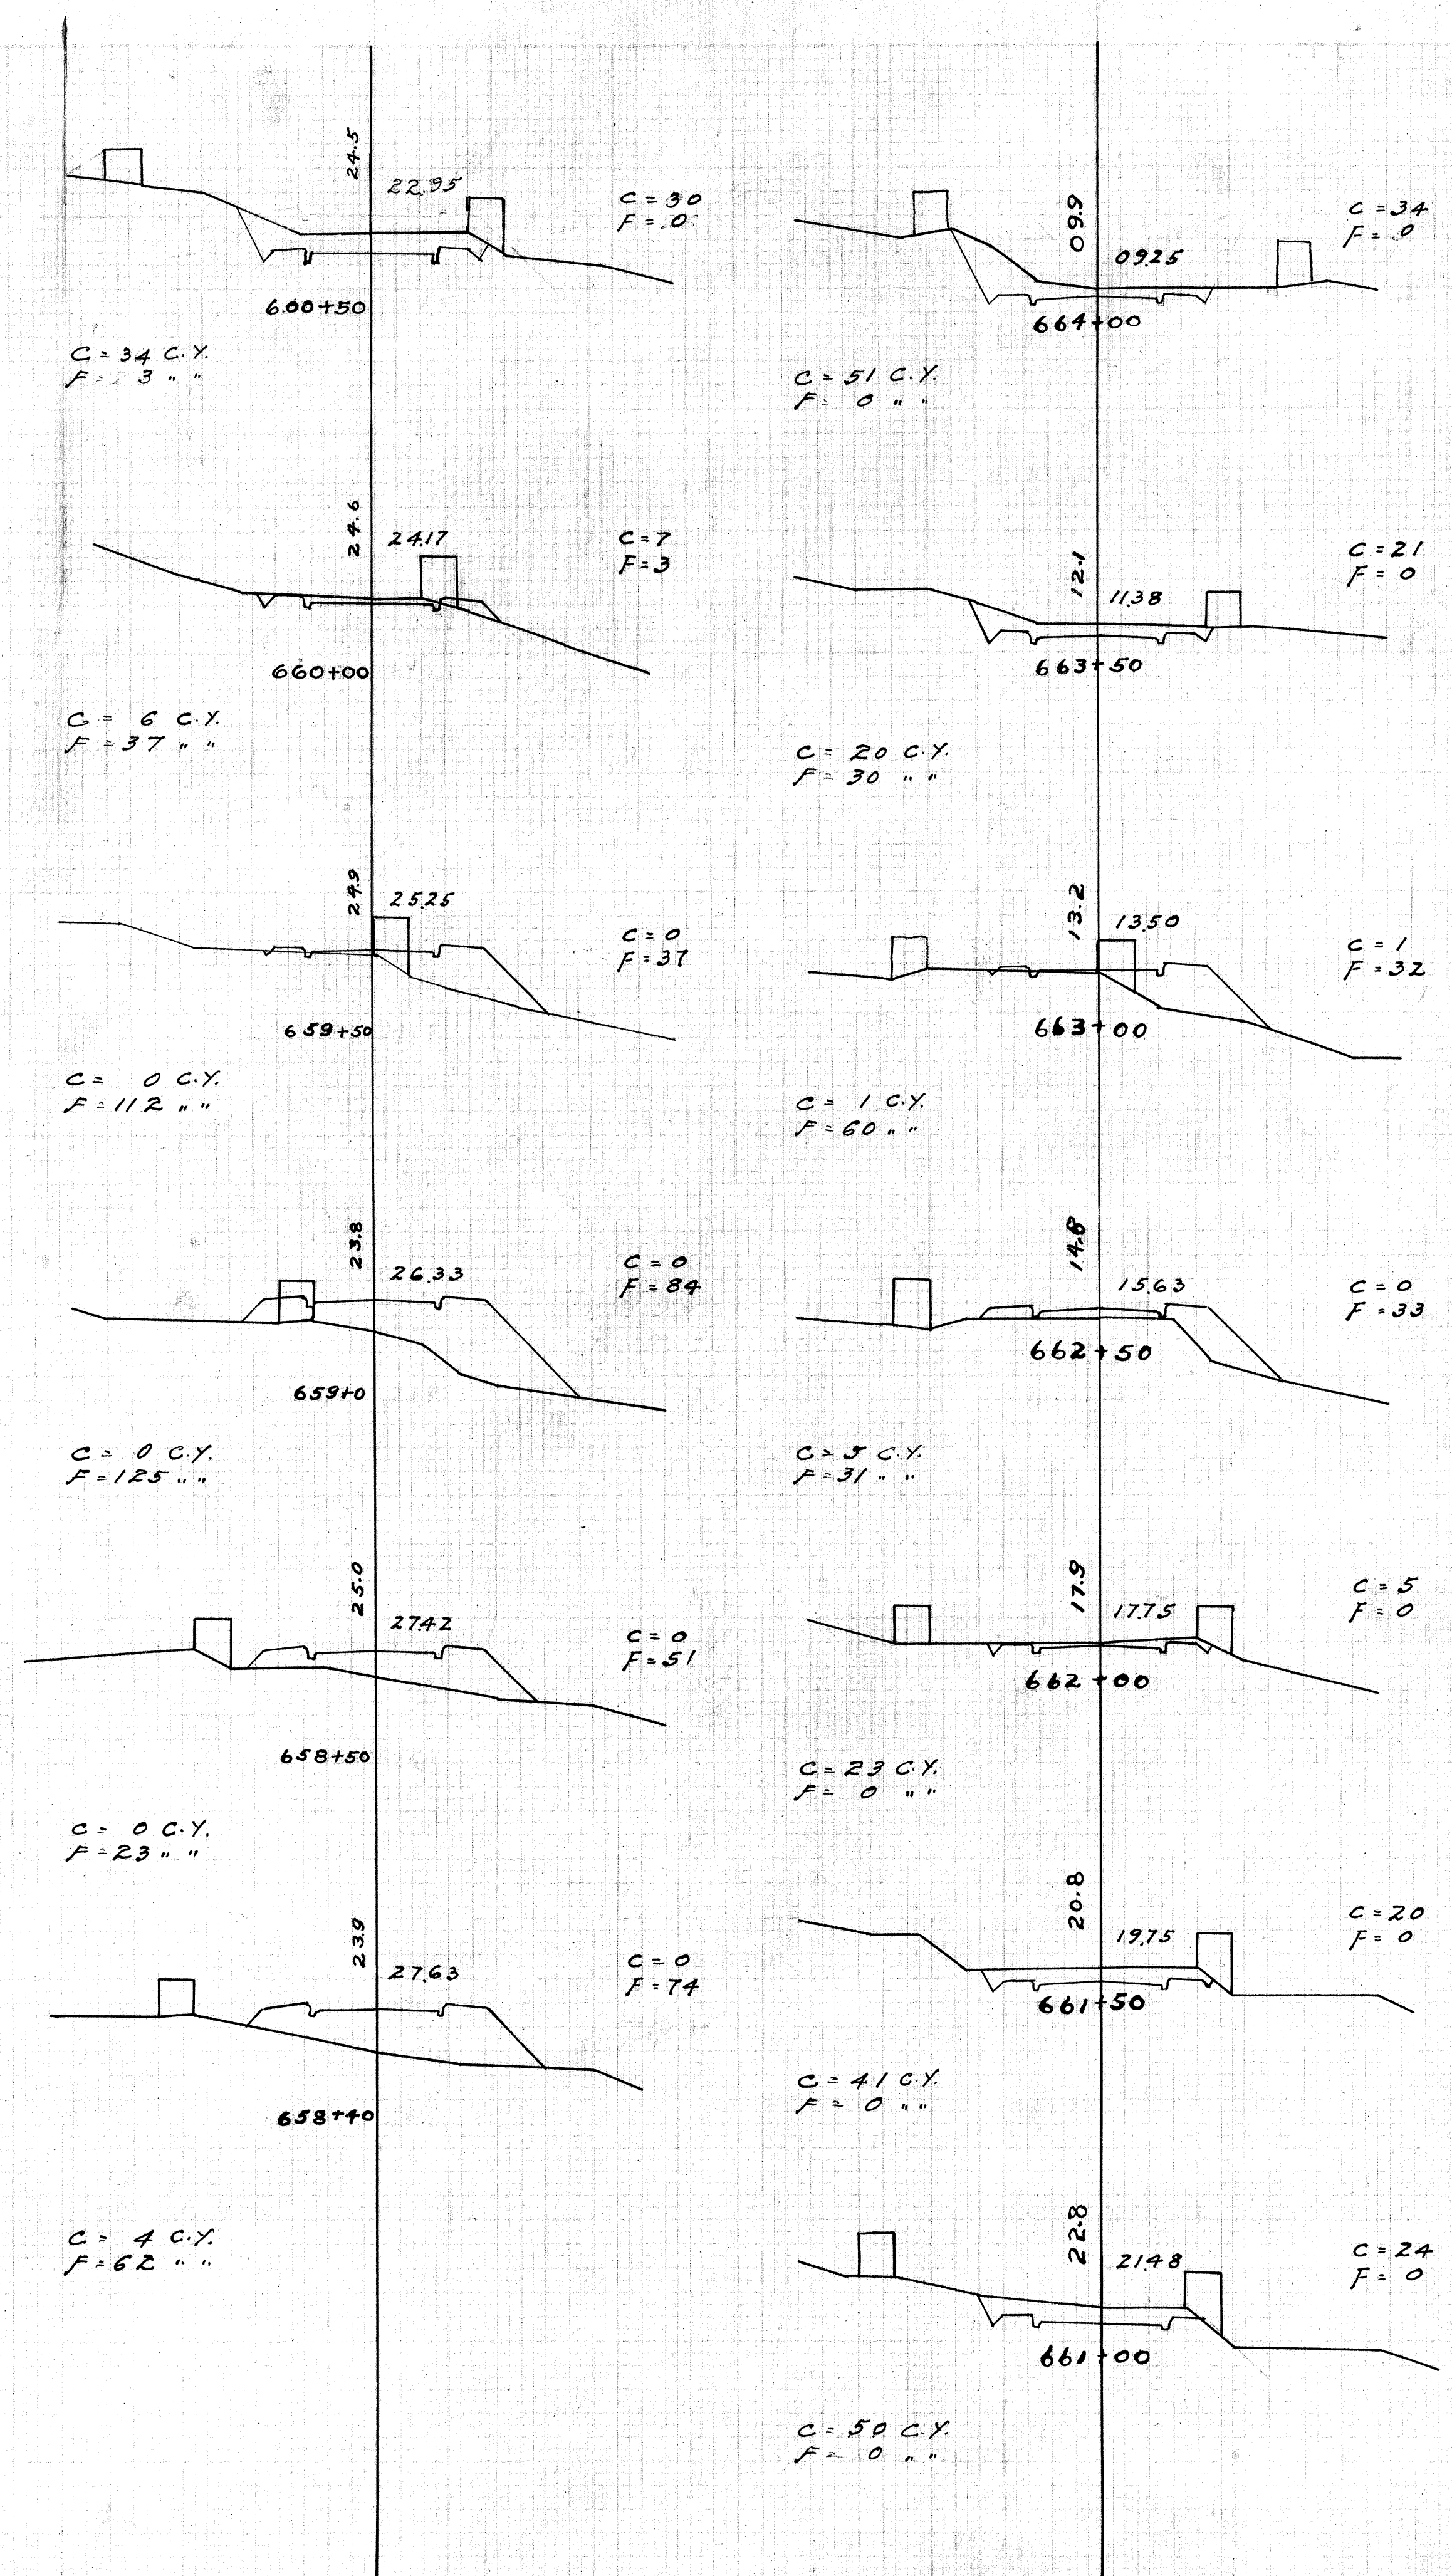

REFERRED TO FROM SHEET NO. 8.

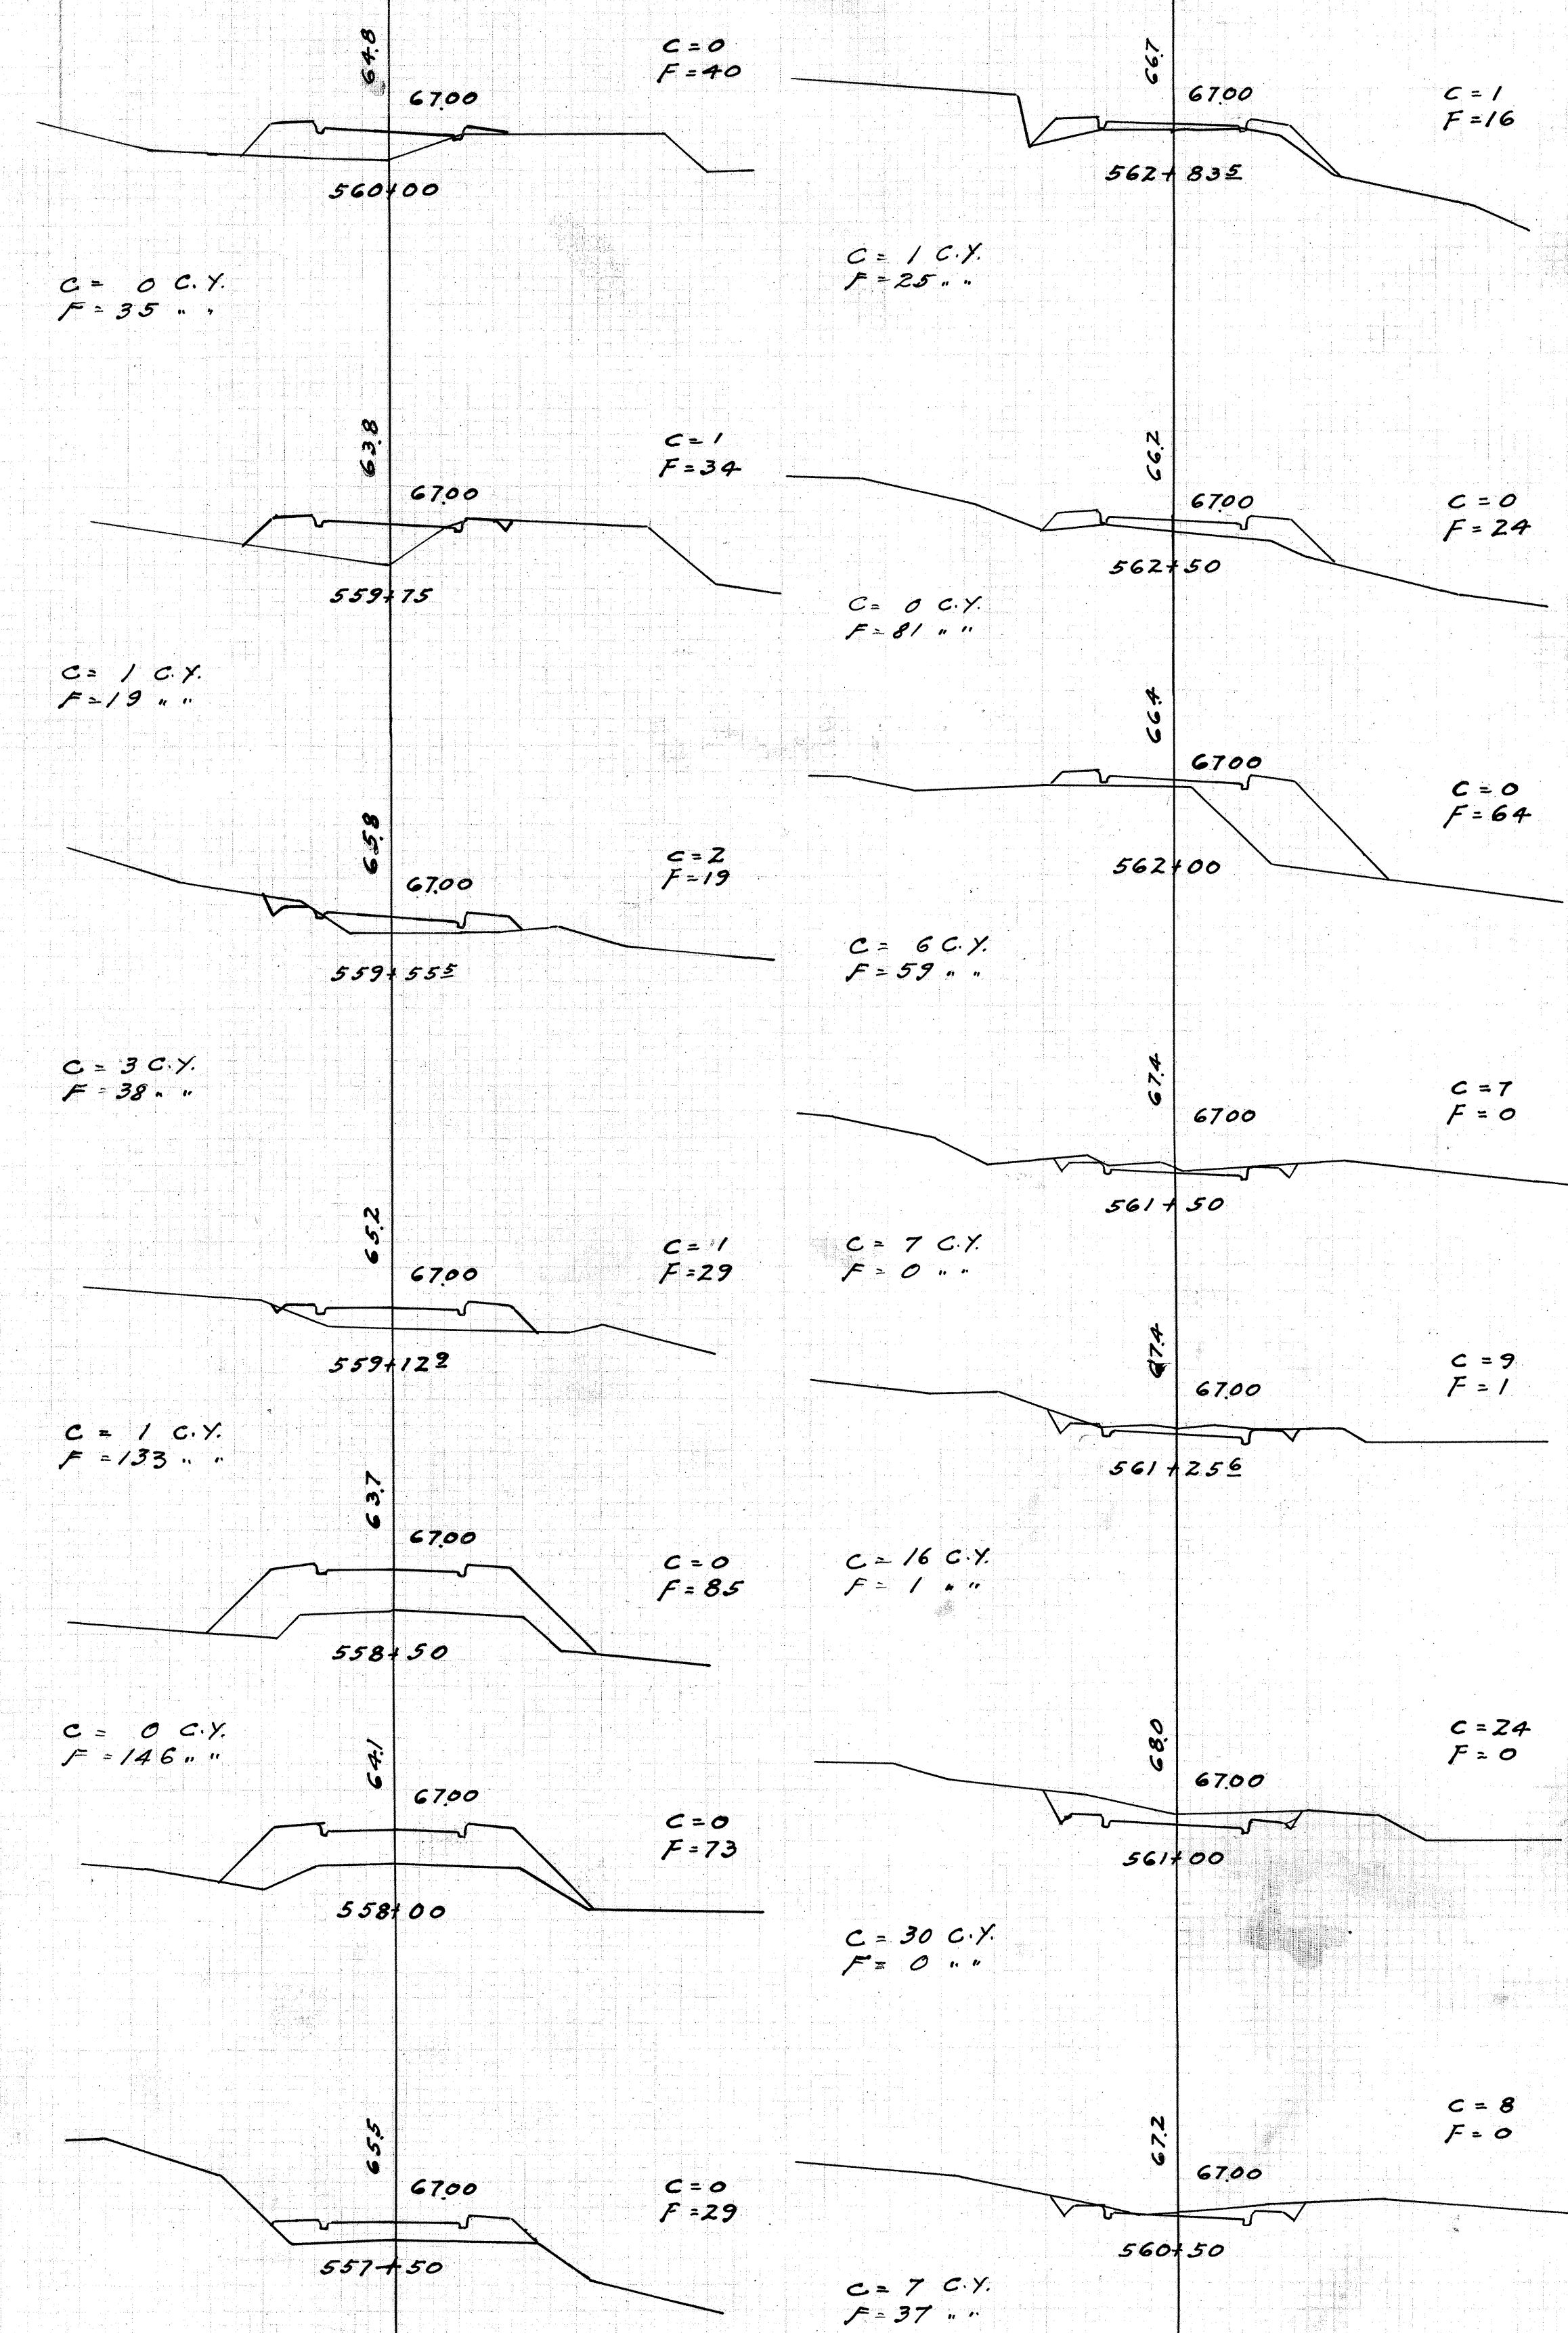

4191.16