


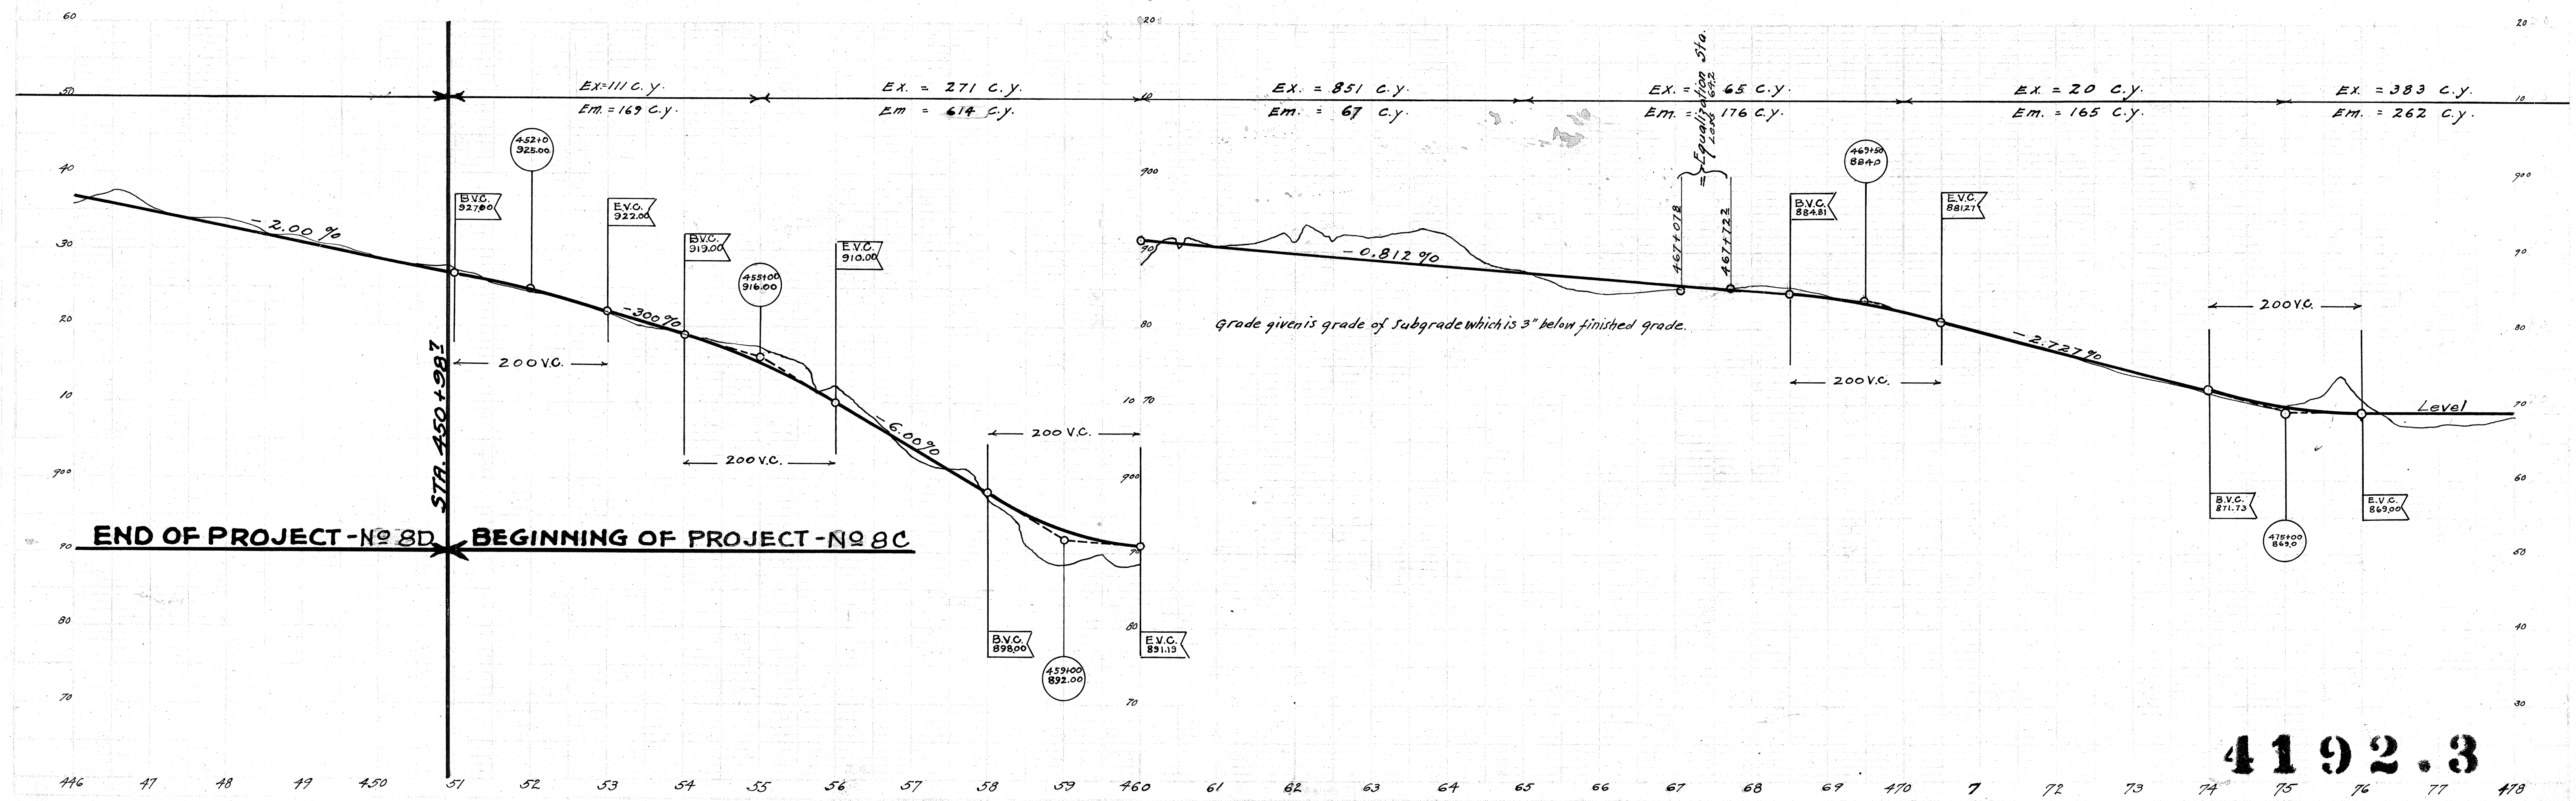
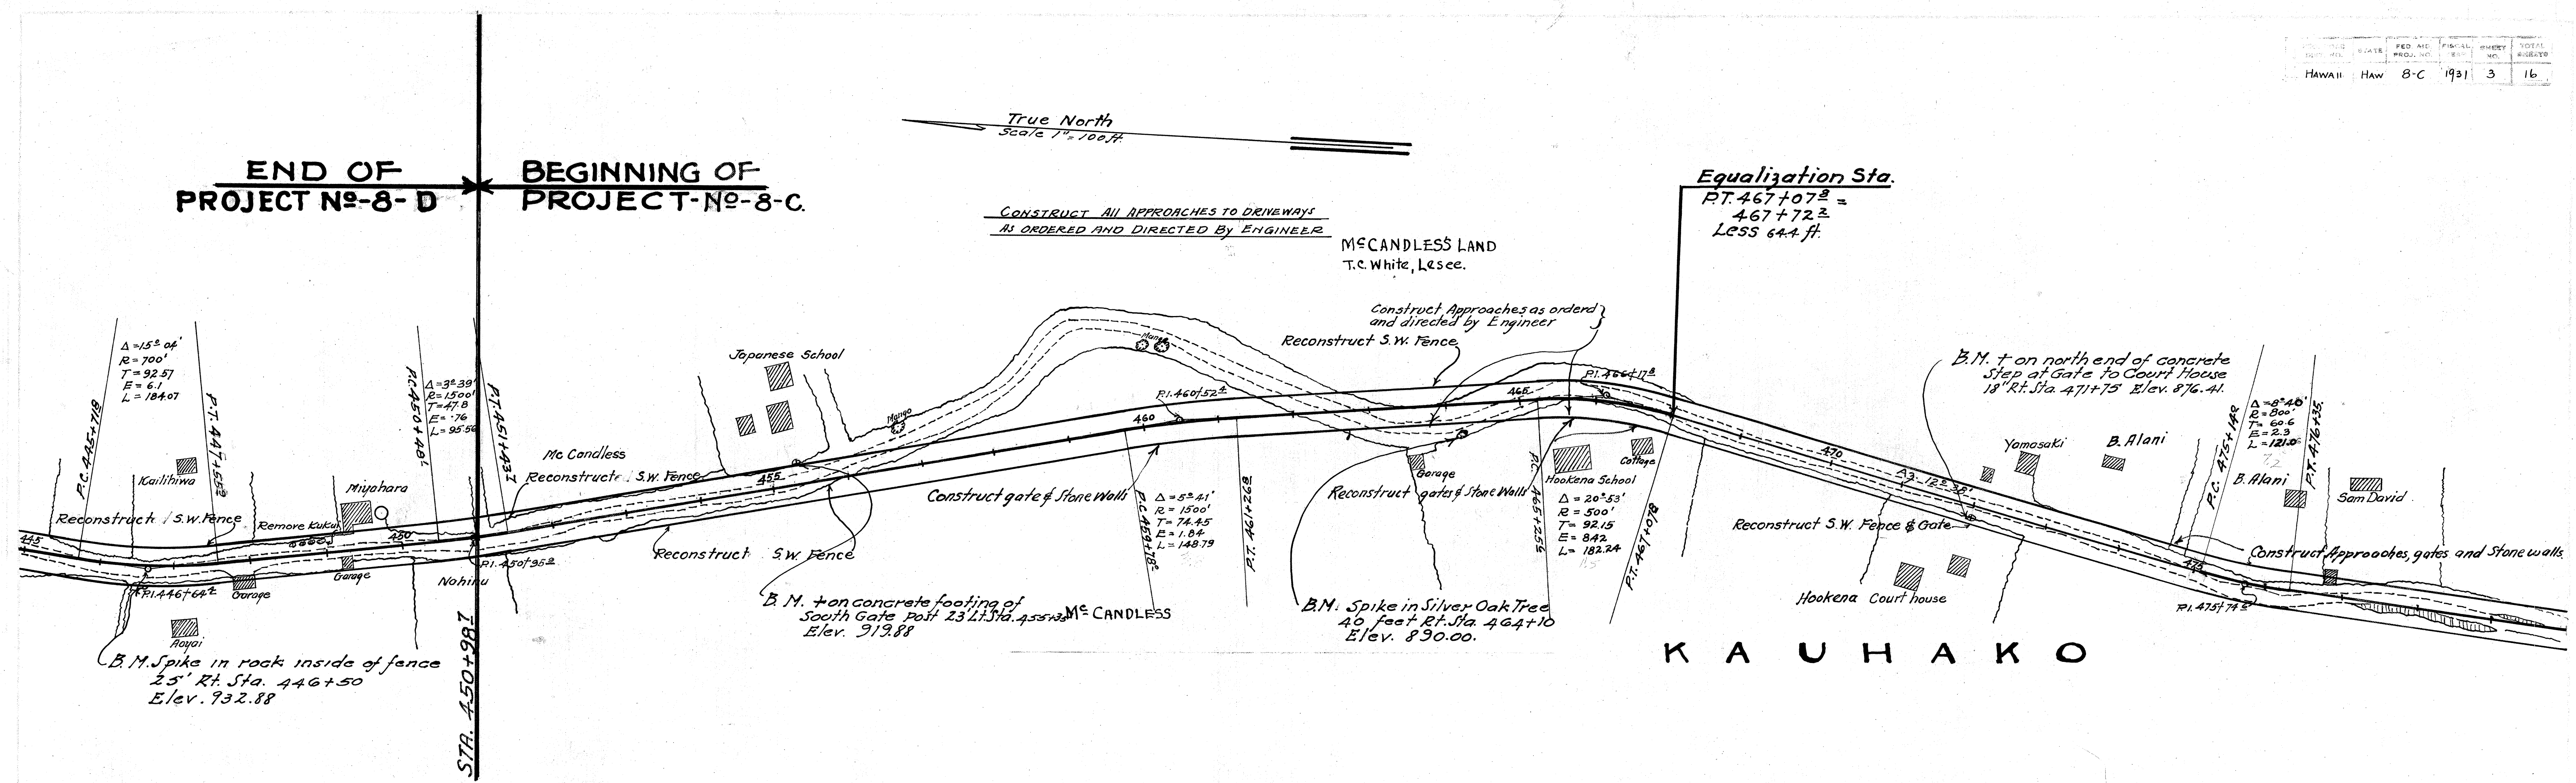


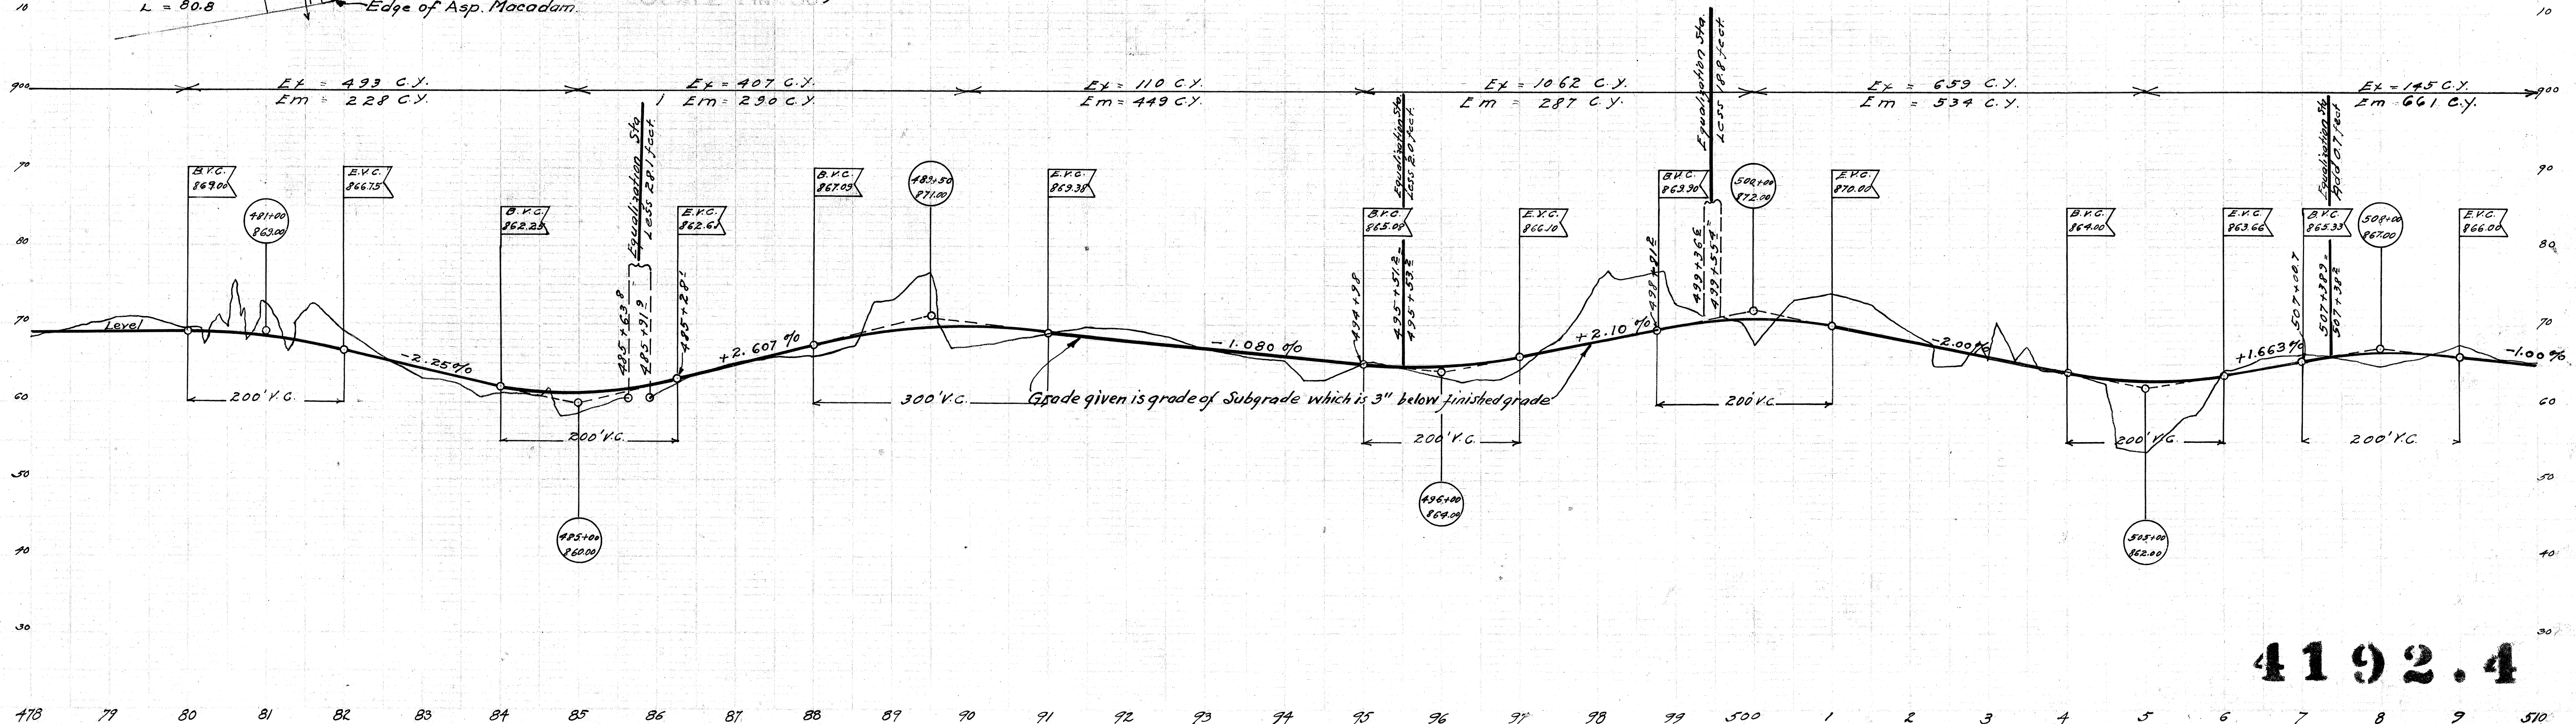


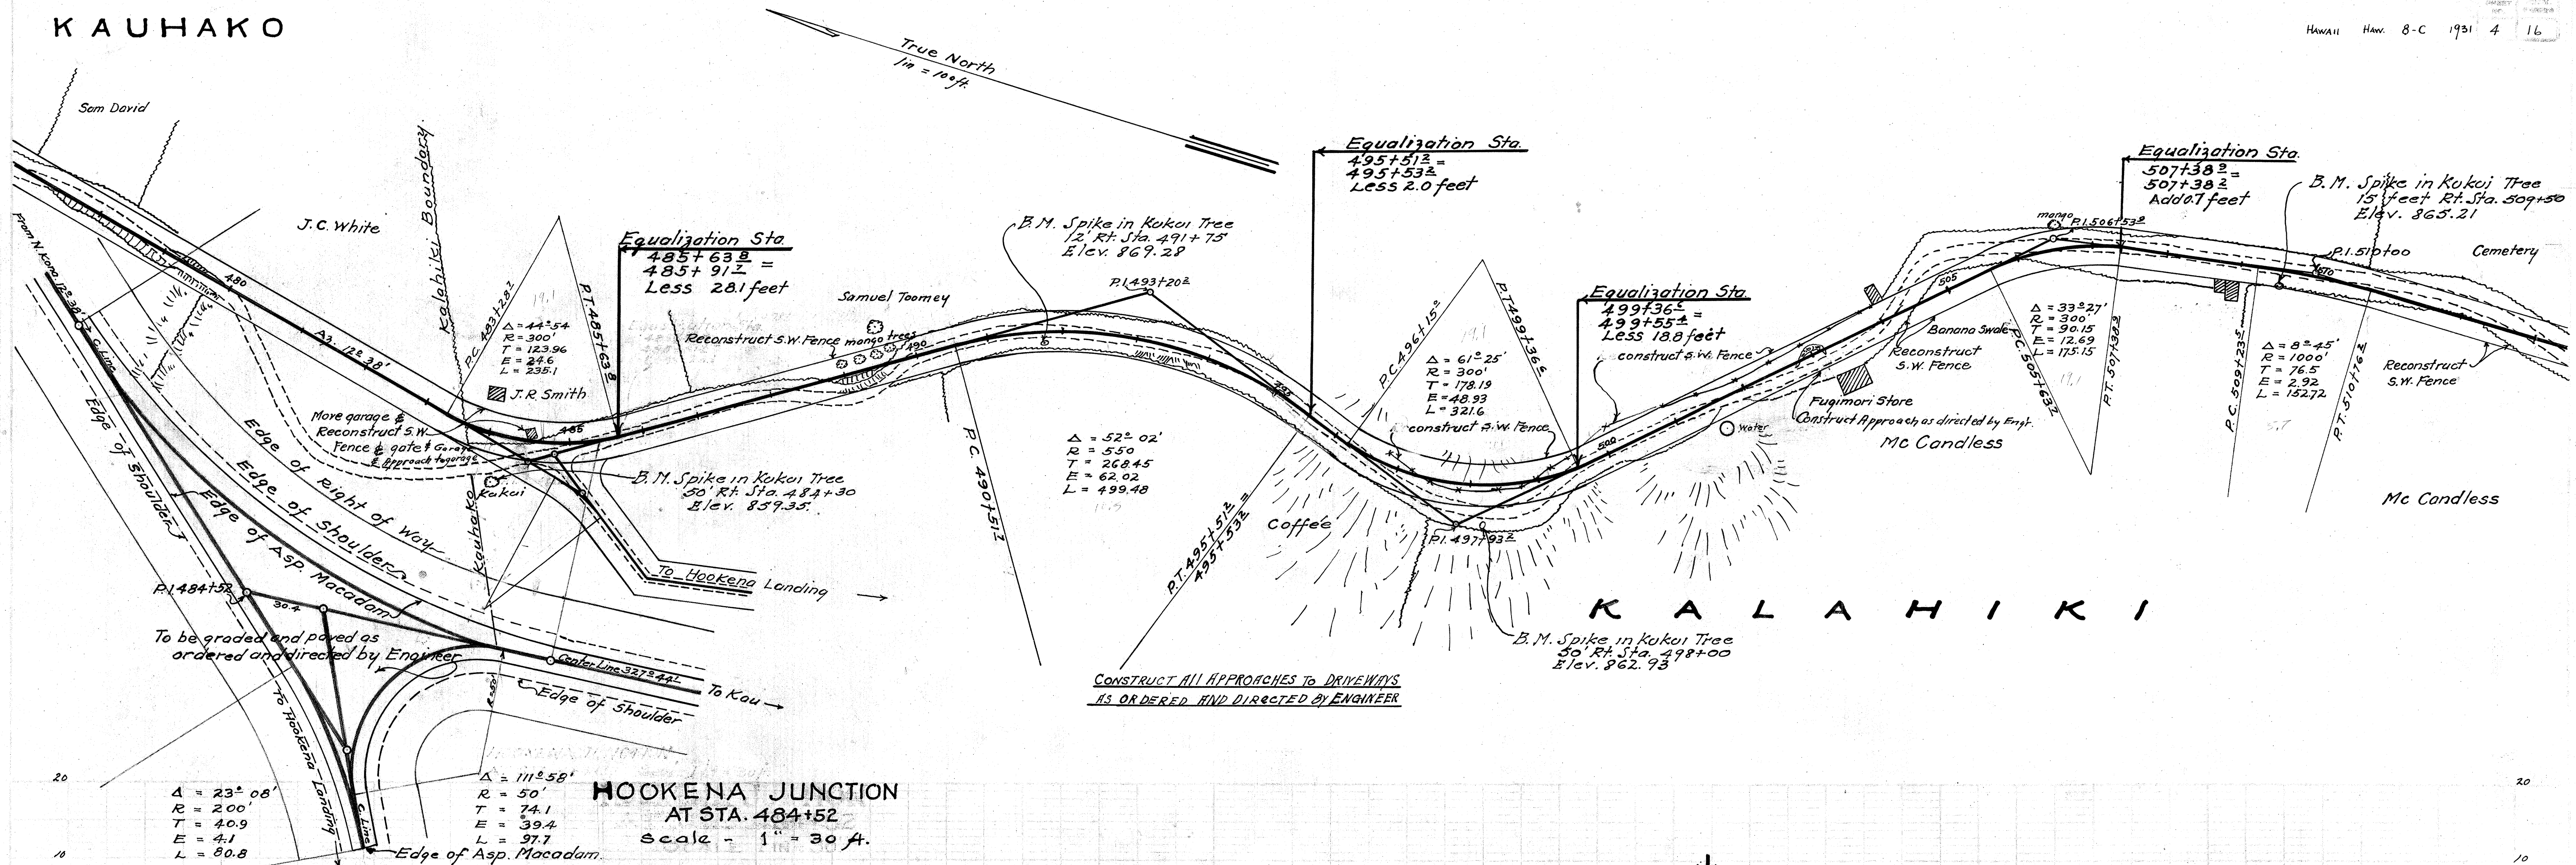

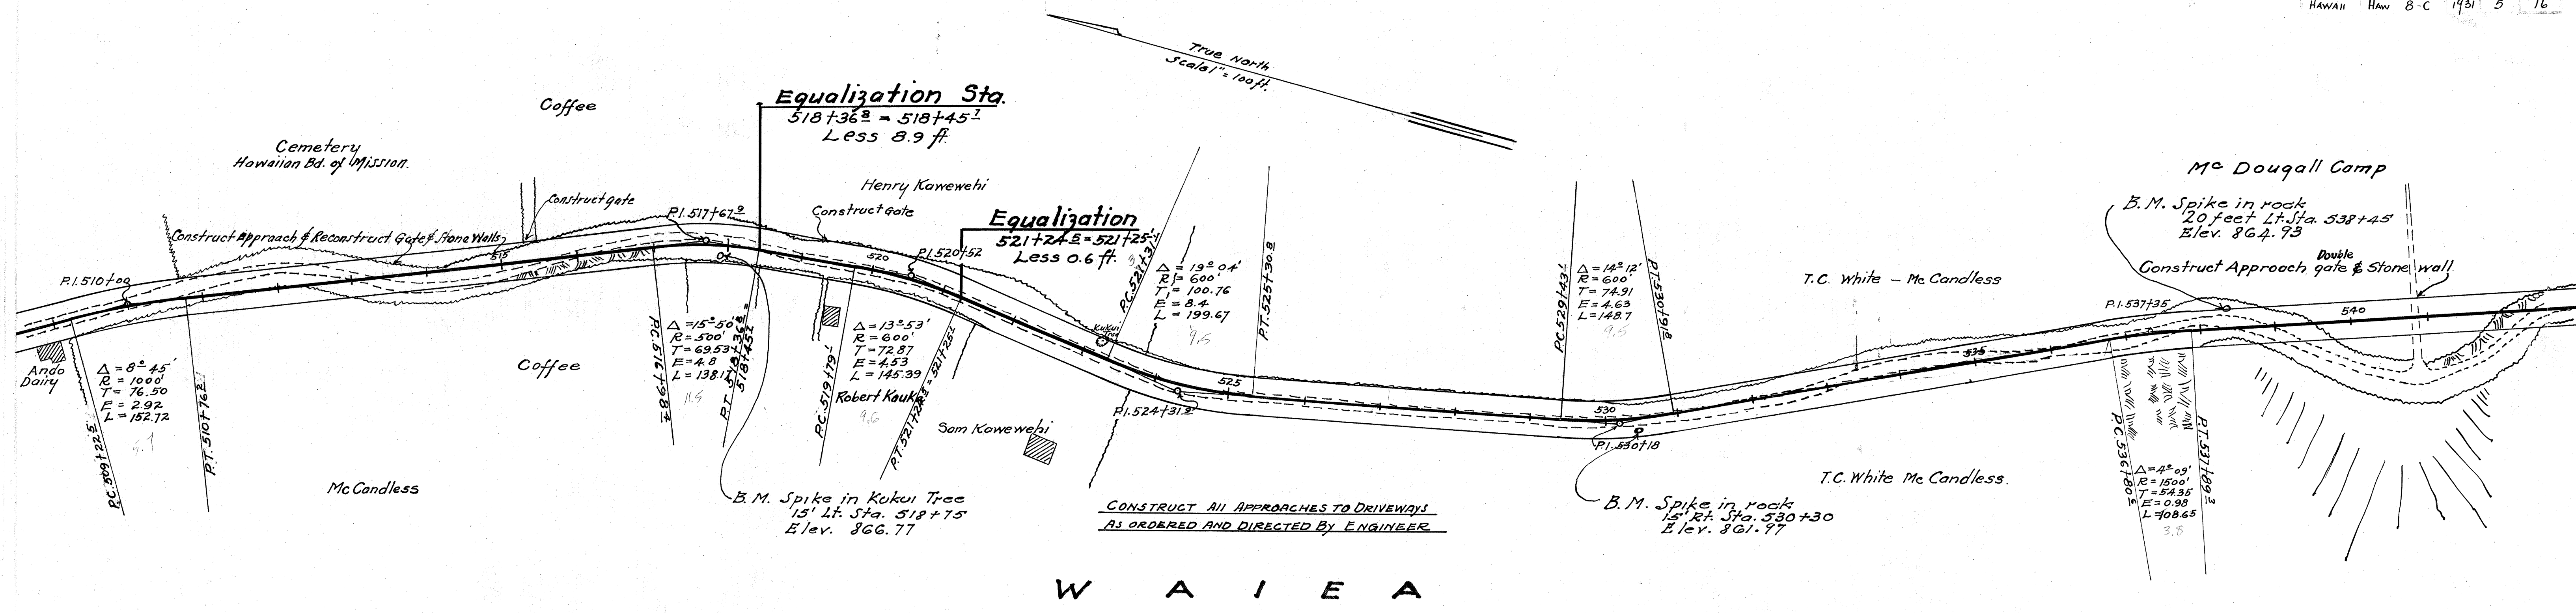

W A I E A

CONSTRUCT ALL APPROACHES TO DRIVEWAYS
AS ORDERED AND DIRECTED BY ENGINEER

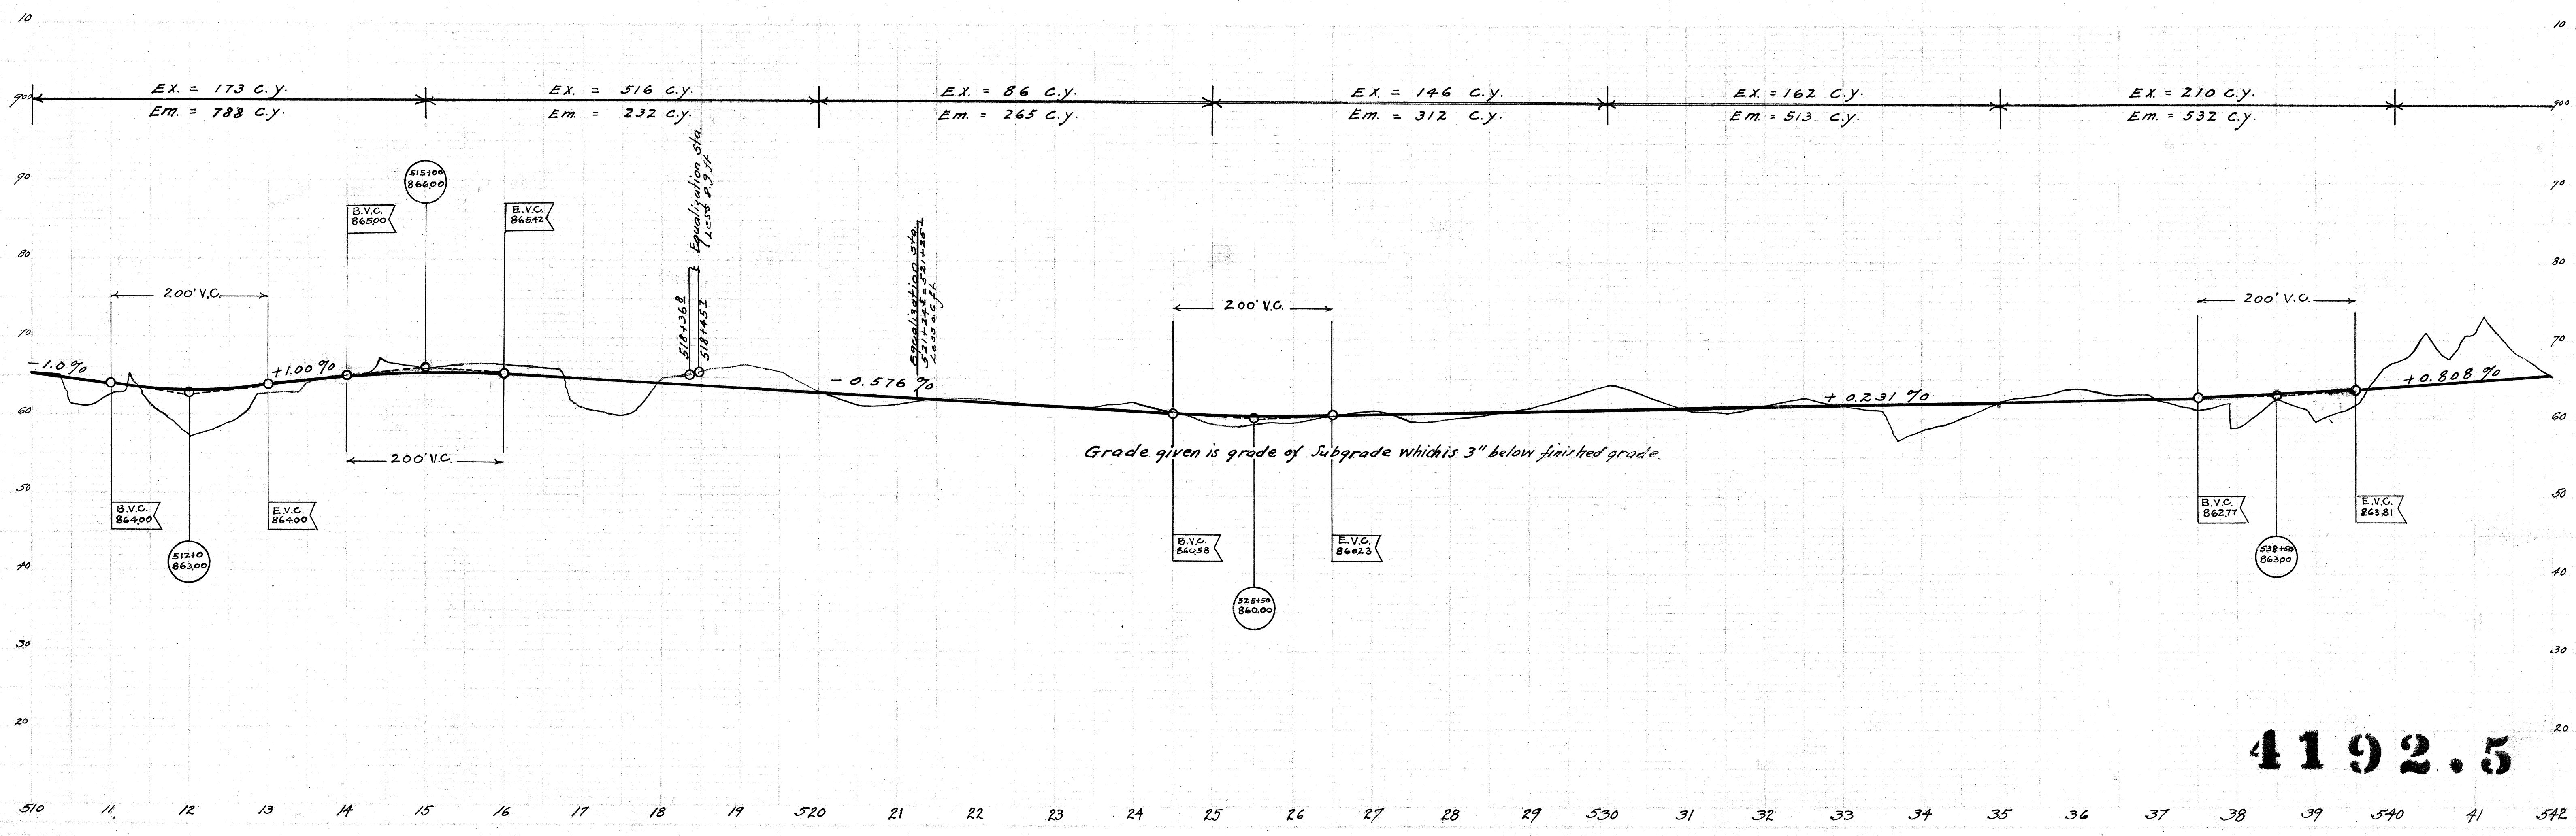

4192.5

FED. ROAD DIST. NO.	DATE	BY	CHKD	APP'D	TOTAL SUGG.
HAW.	HAW.	88	1931	3	16

HAW. HAW. 88 1931 3 16

This Sheet applies to both projects

HONOKUA



END OF PROJECT NO-8-C. BEGINNING OF PROJECT NO-8-B

True North
Scale 1 in = 100 ft.

W A I E A

Equalization Sta.
568+20.2 = 568+17.2
Add 3.0 ft.

Equalization Sta.
555+00.4 = 555+23.4
Less 23.0 ft.

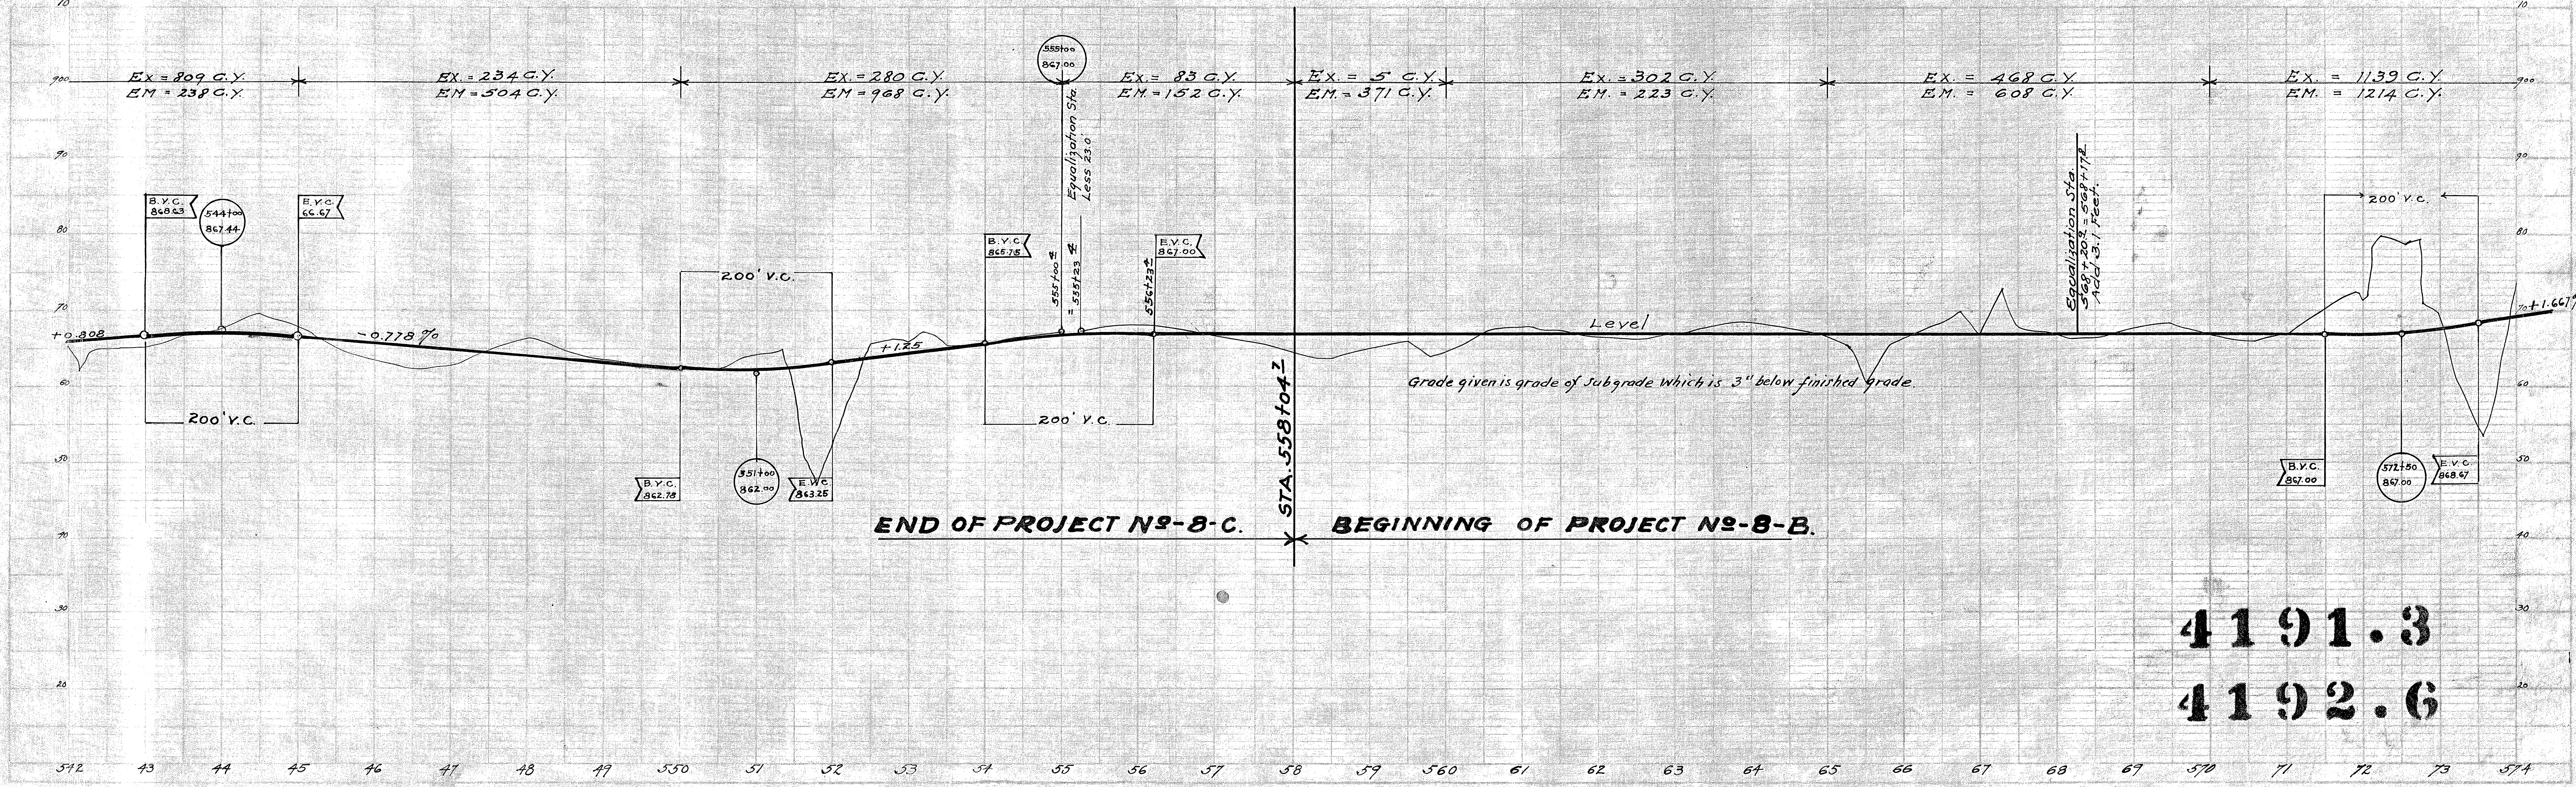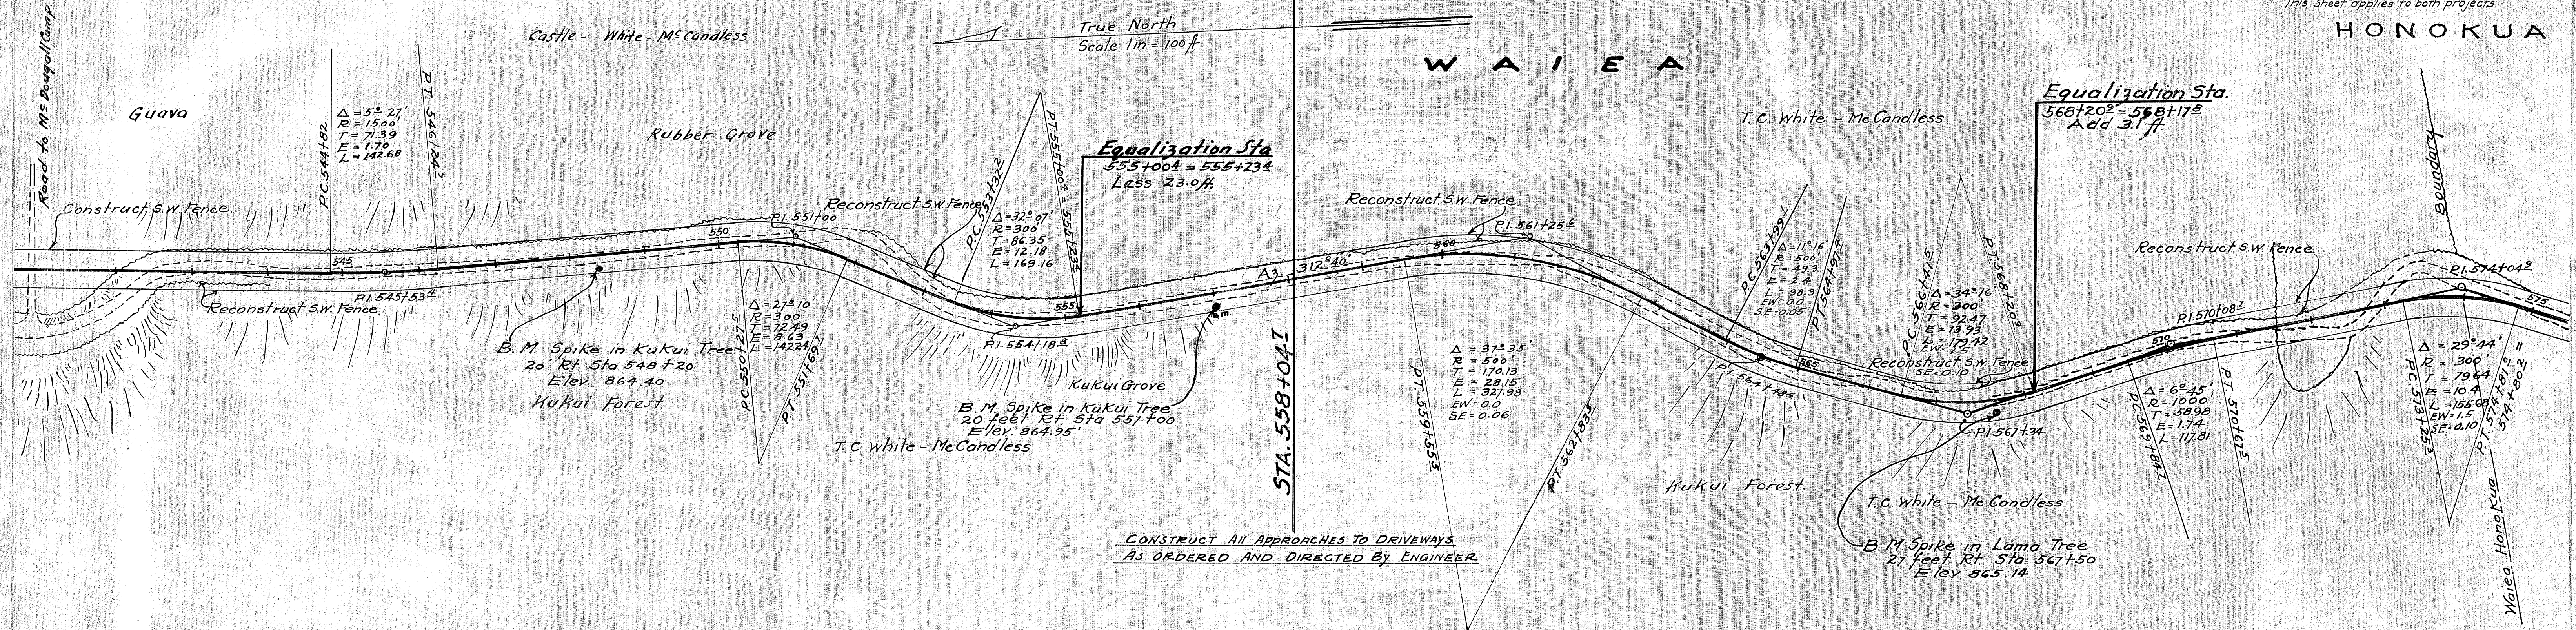

4191.3
4192.6