


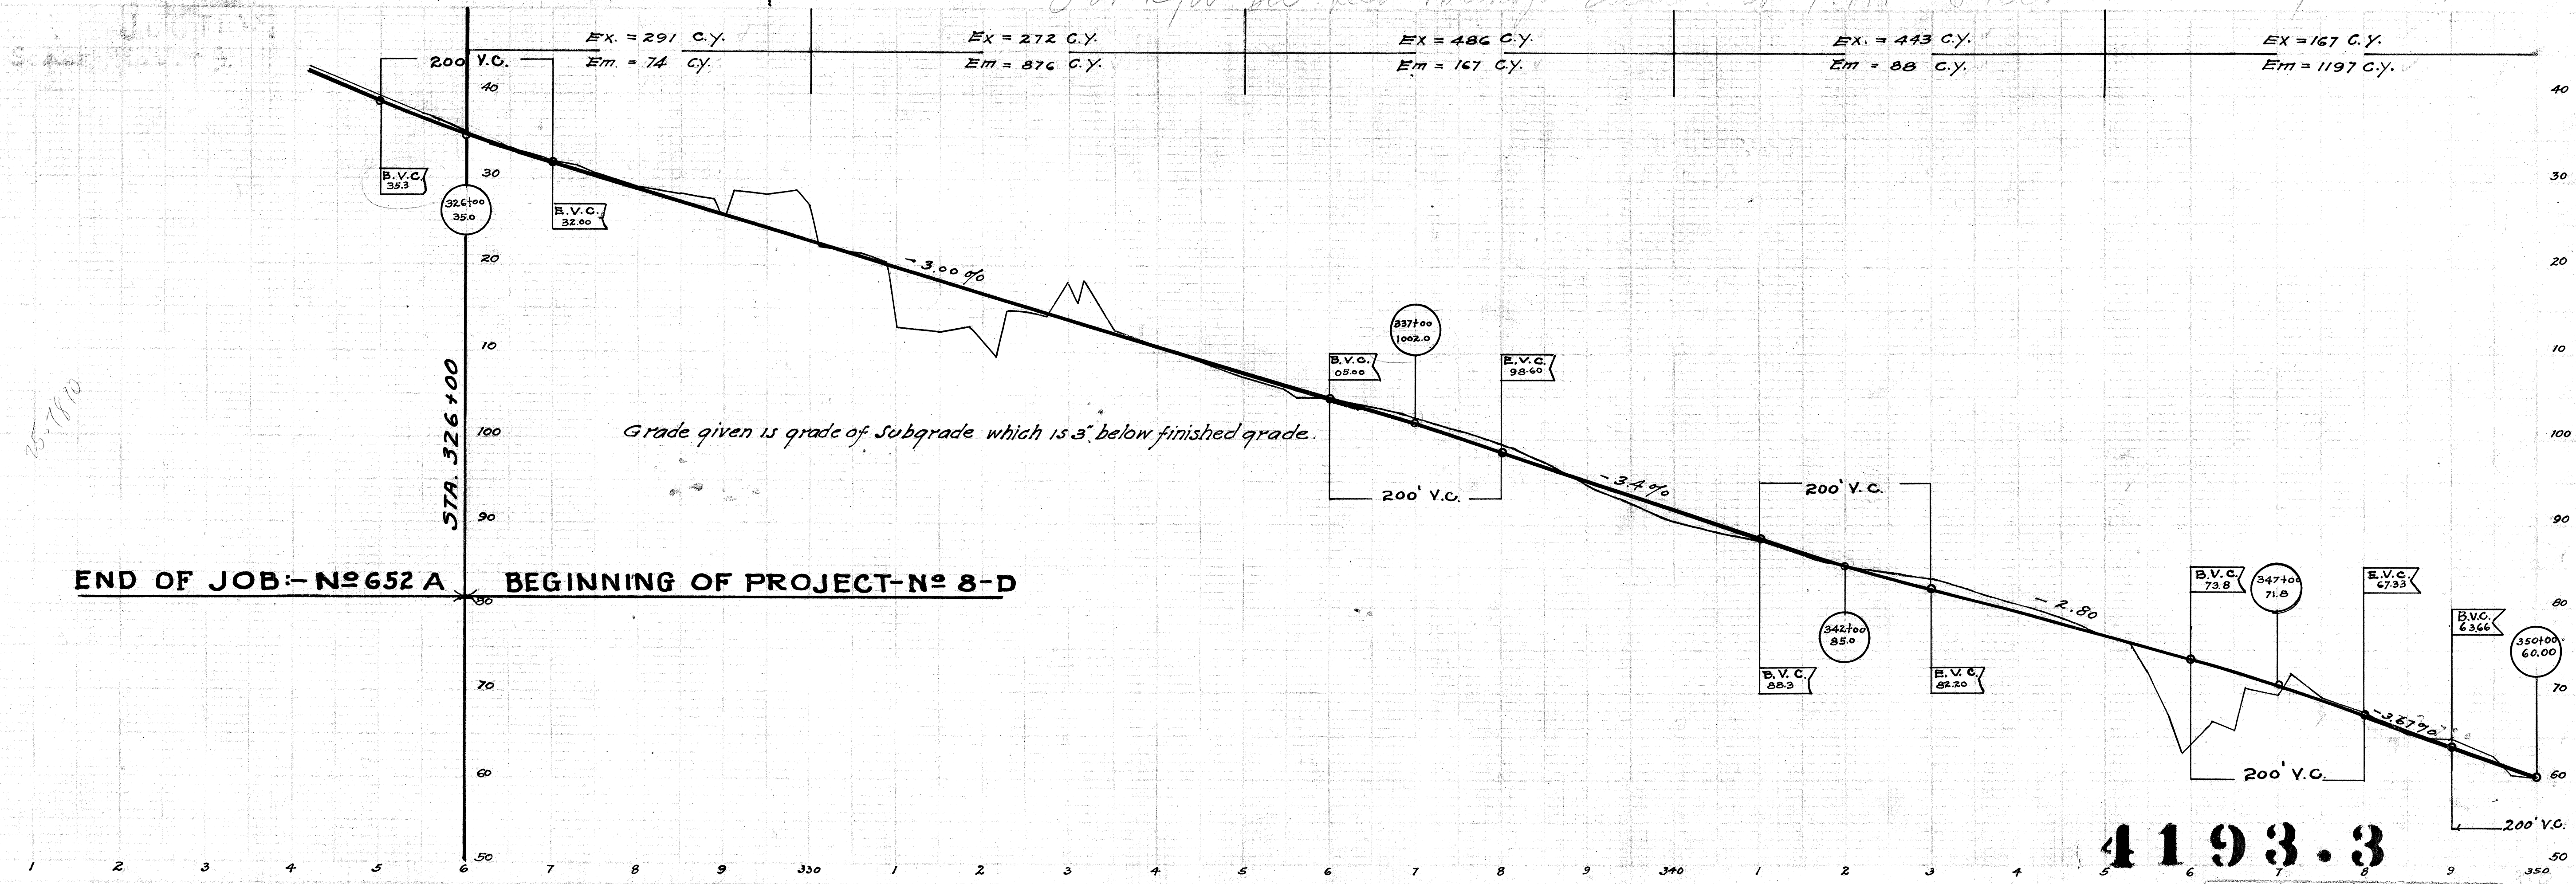
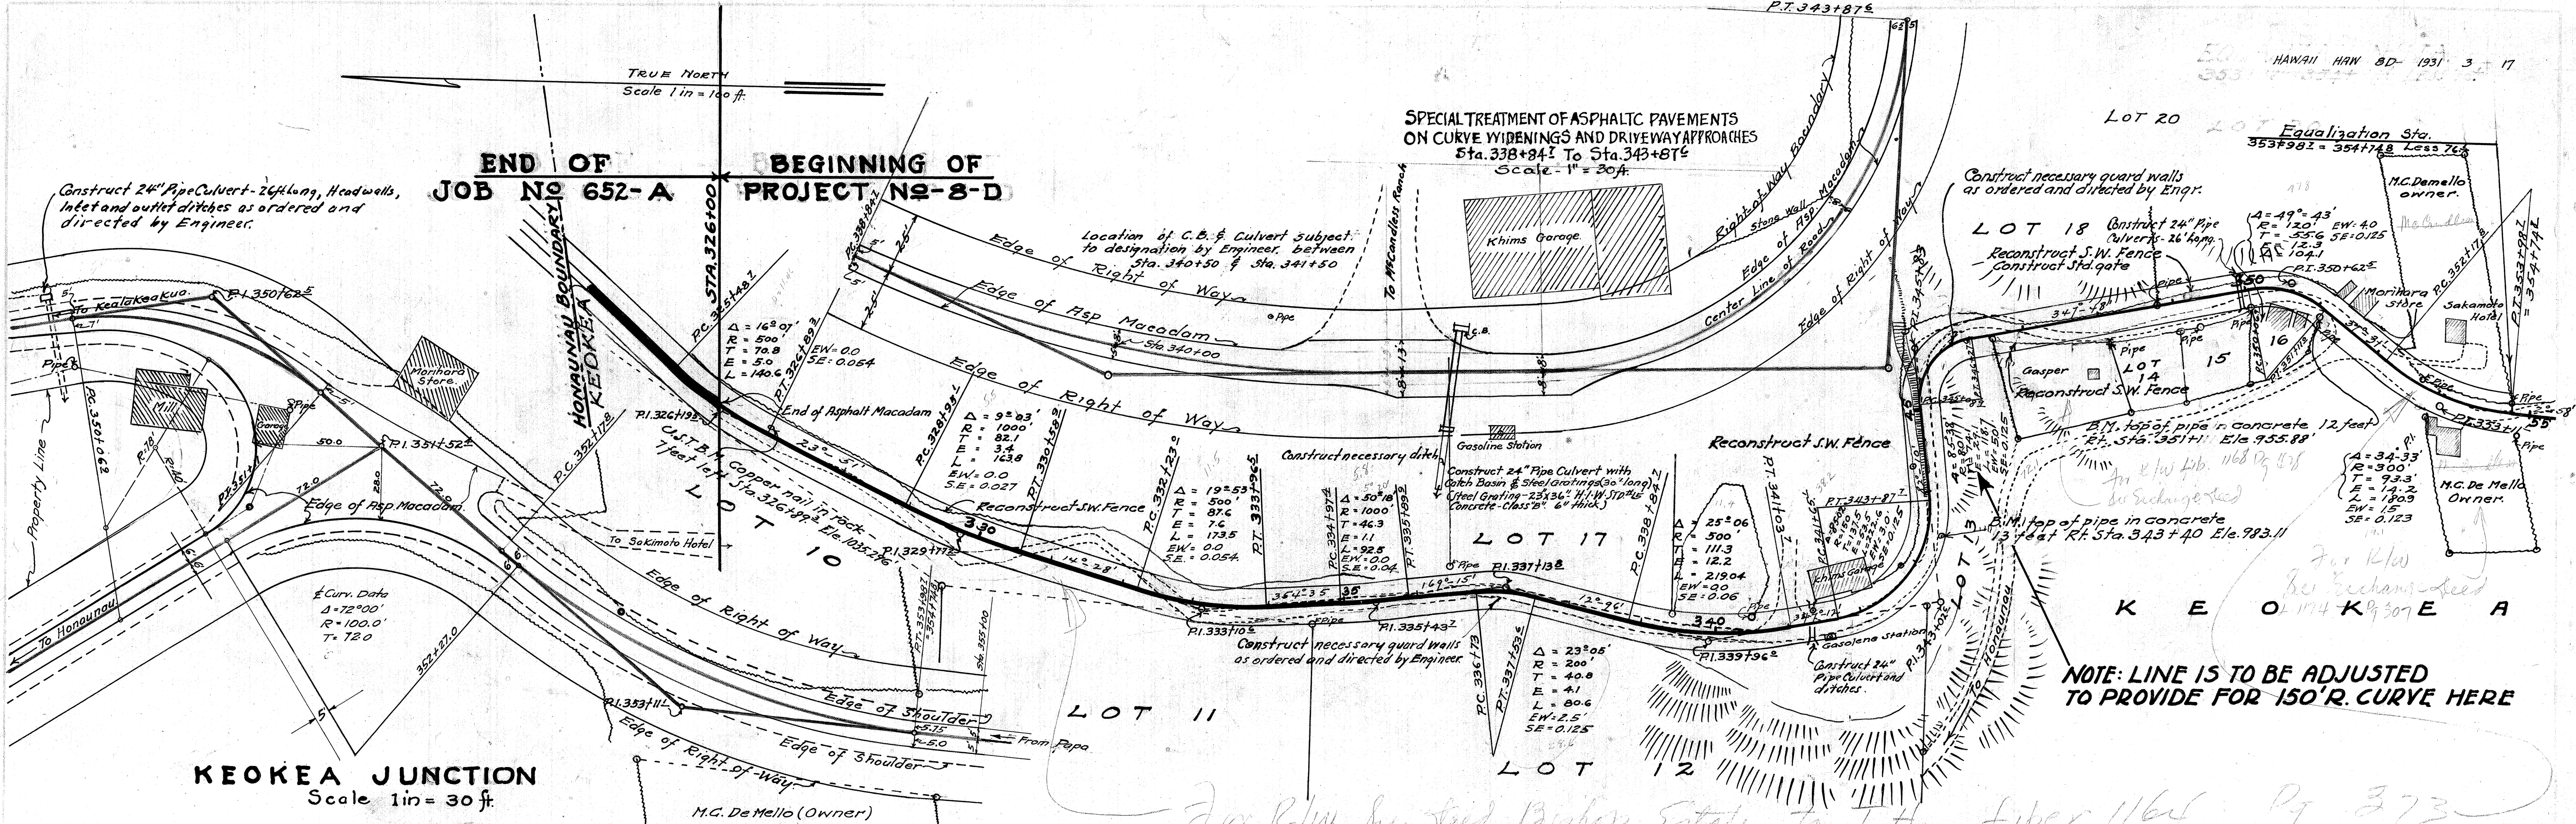
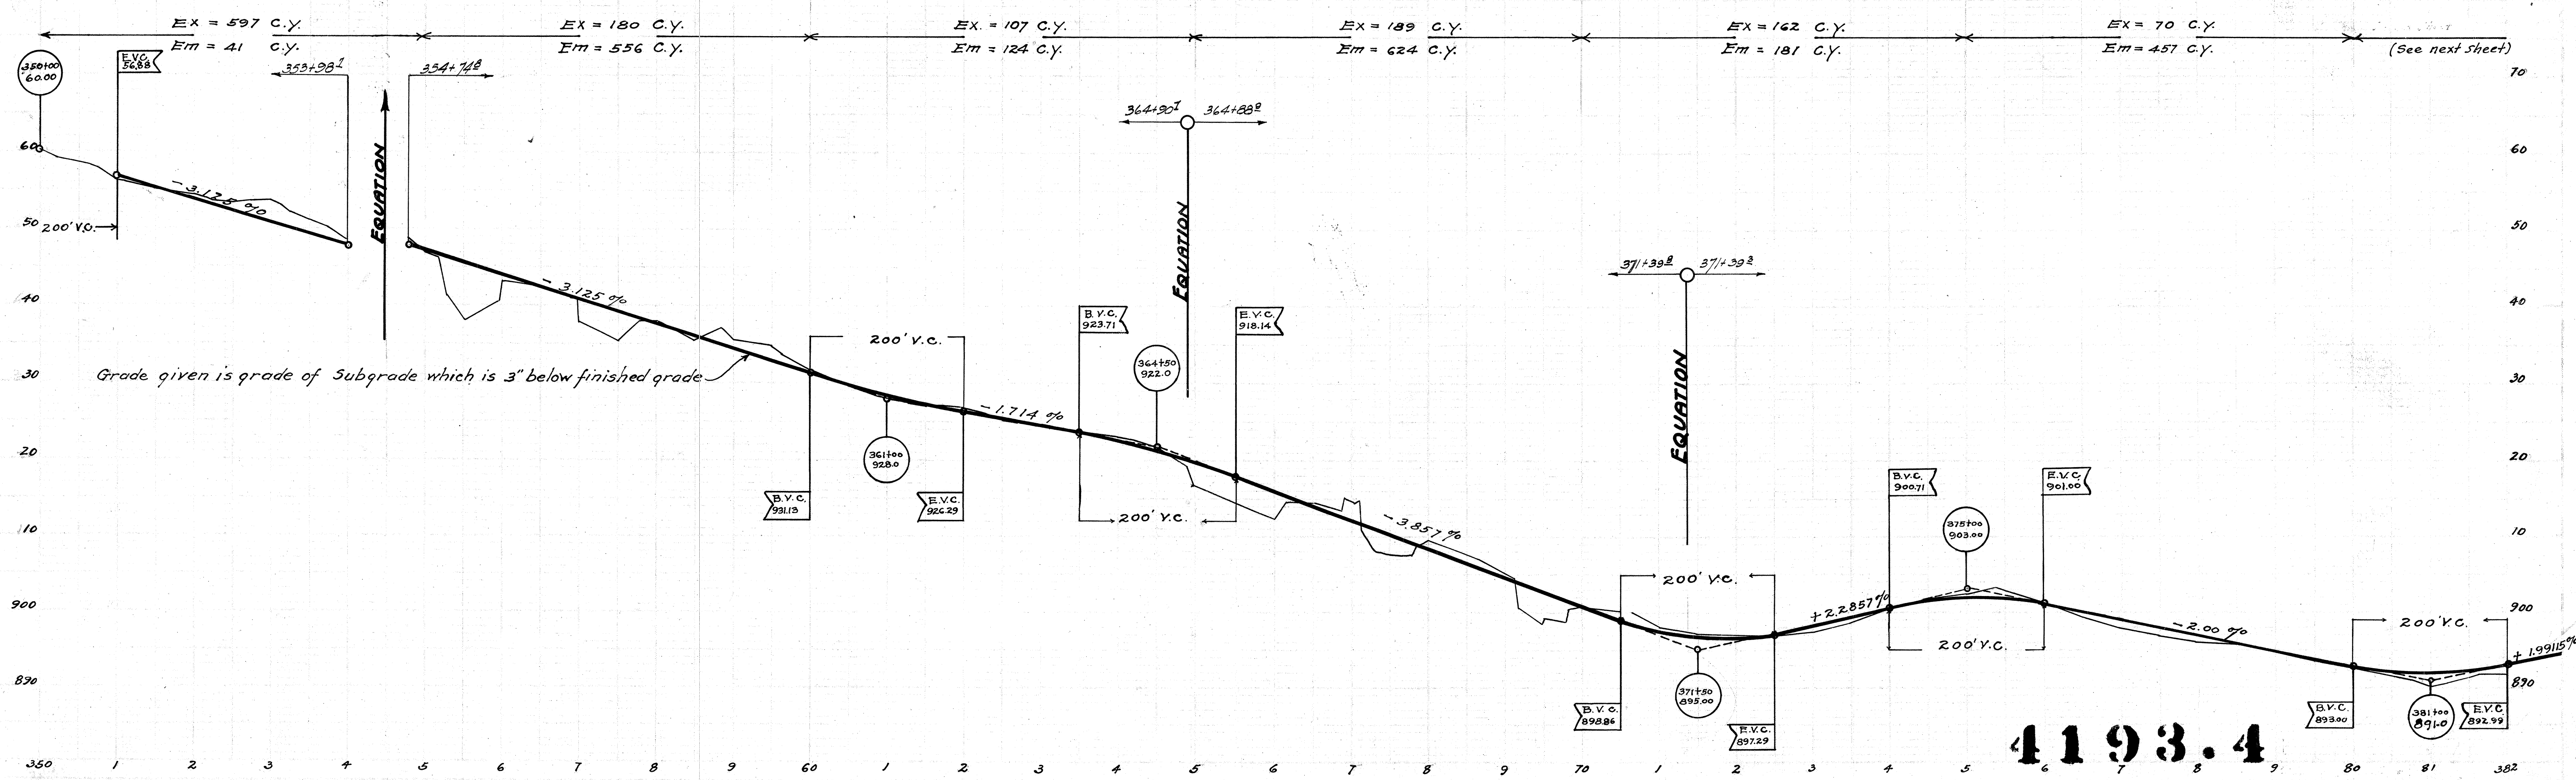


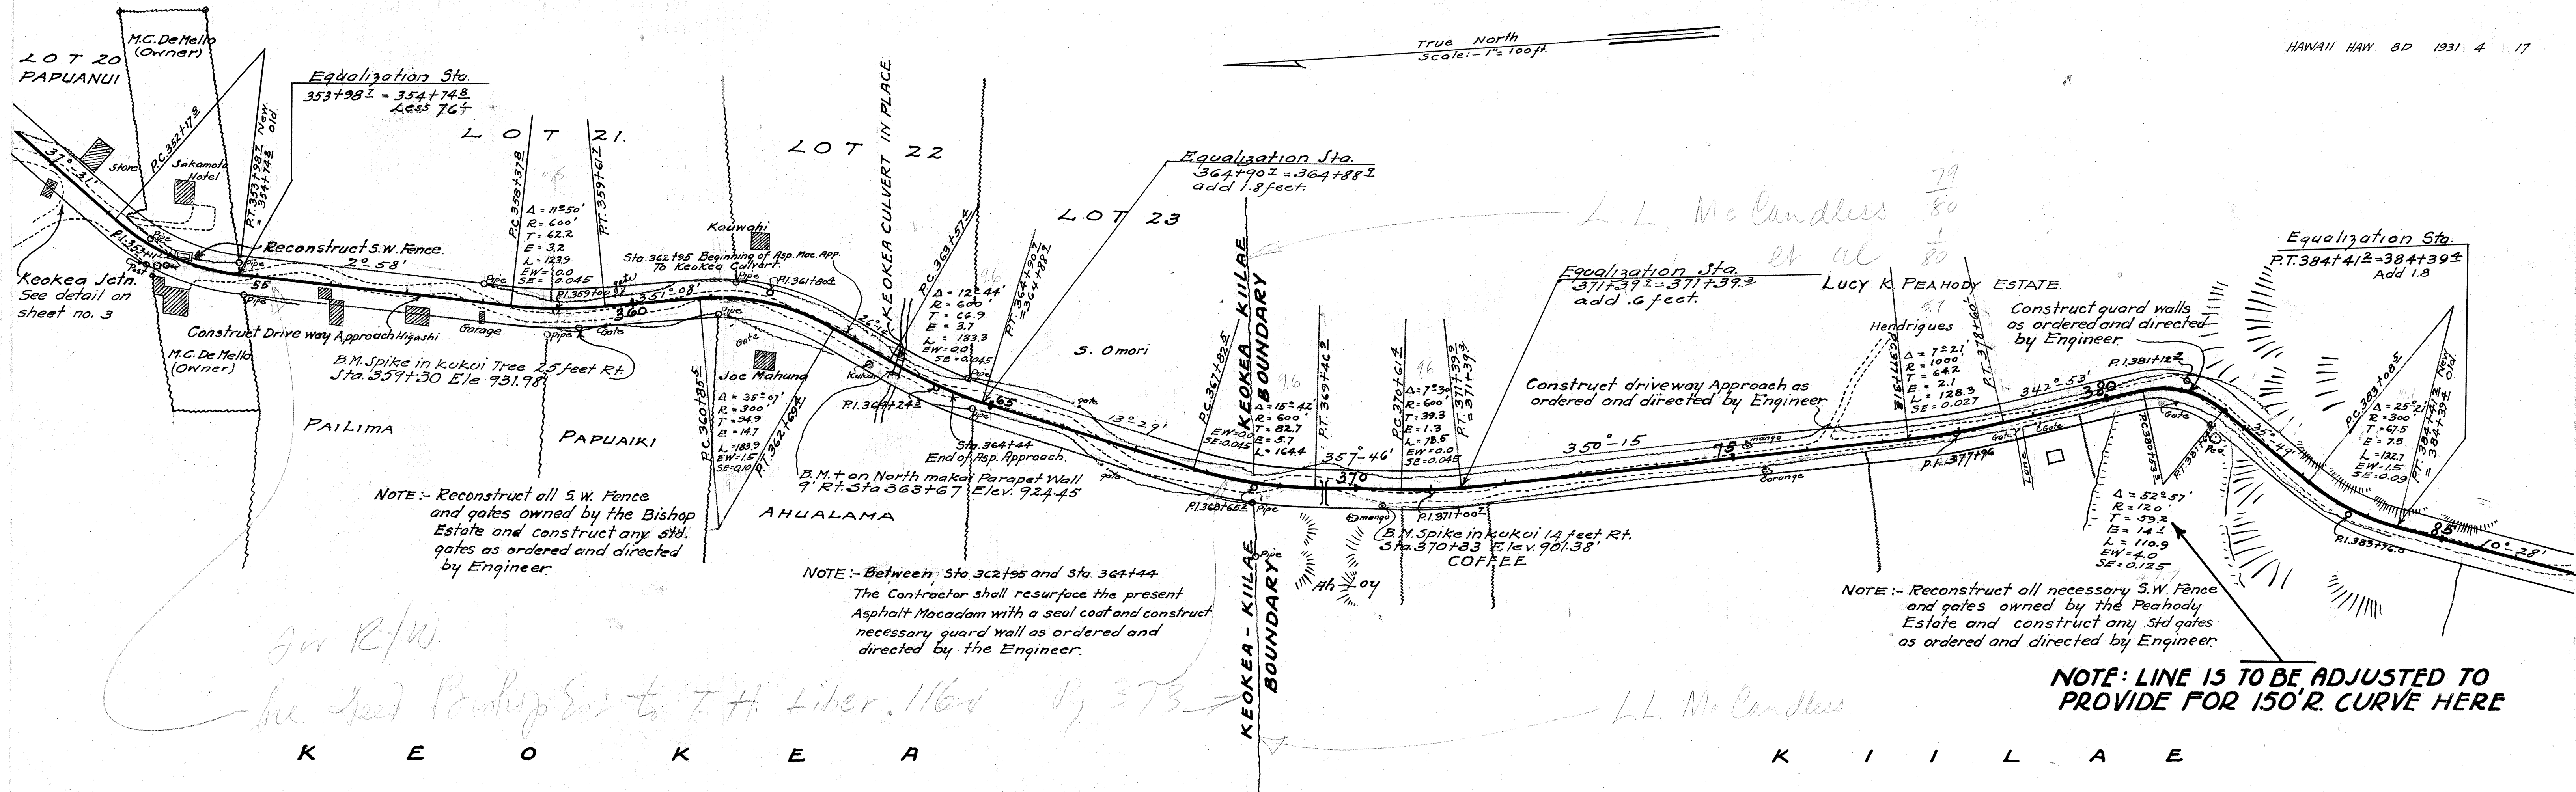

4193.3


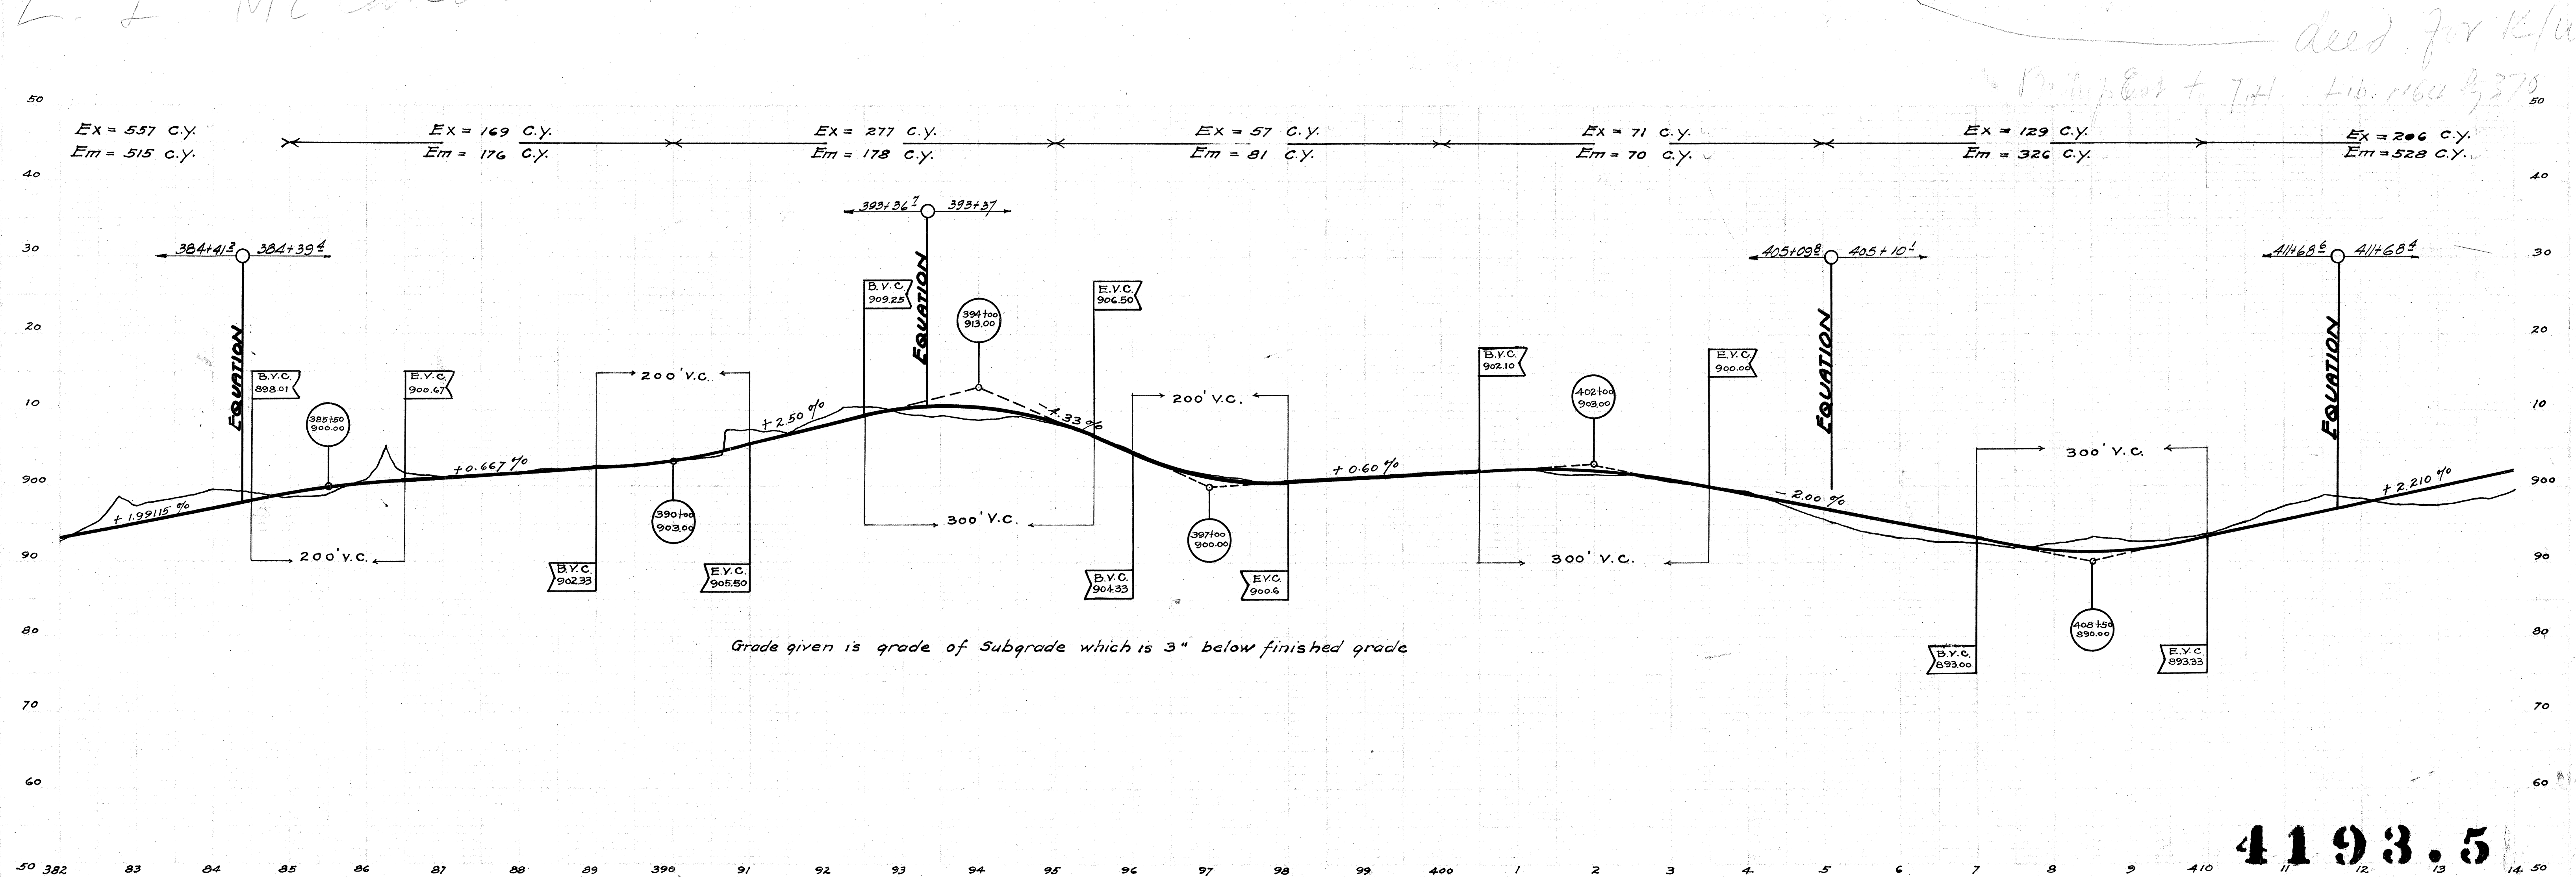


FED. ROAD DIST. NO.	STATE	FED. AID FUND. NO.	FISCAL YEAR	SHEET NO.	TOTAL SHEETS
HAWAII	HAW	8D	1937	5	17


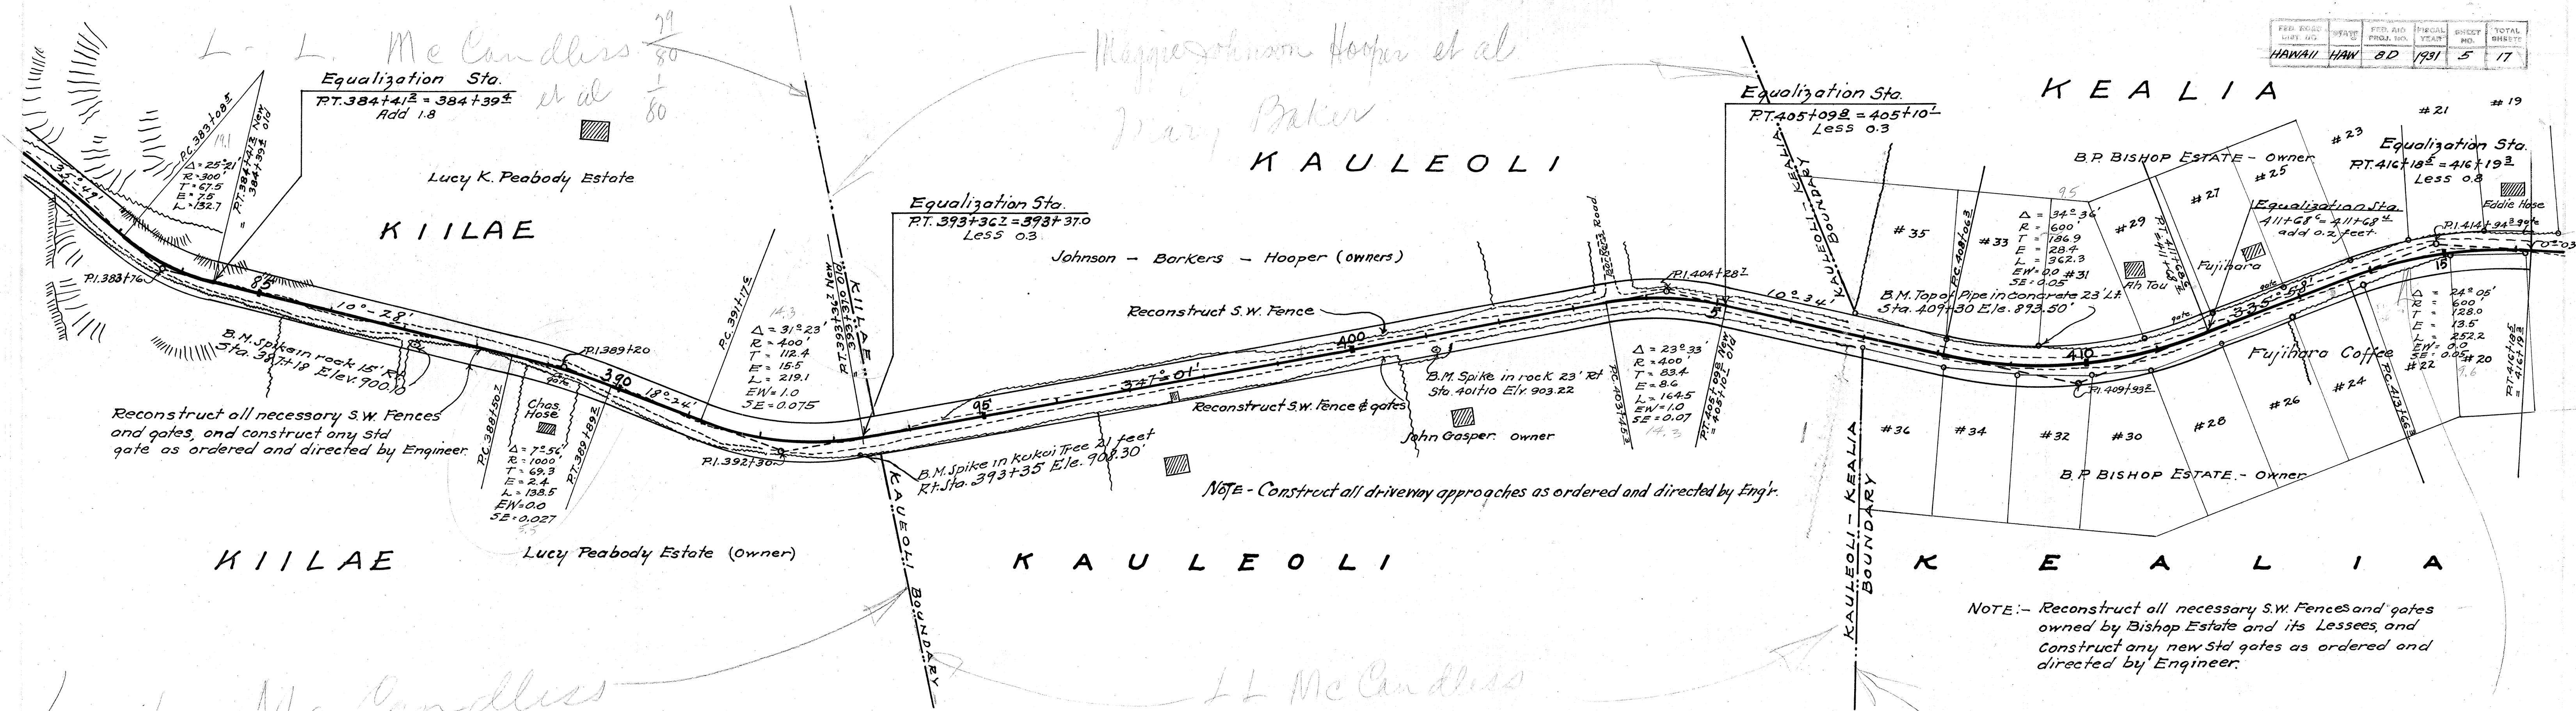


4193.5

Plan File	Sheet	Folio	Page
No. 6	No. 10	No. 1	No.

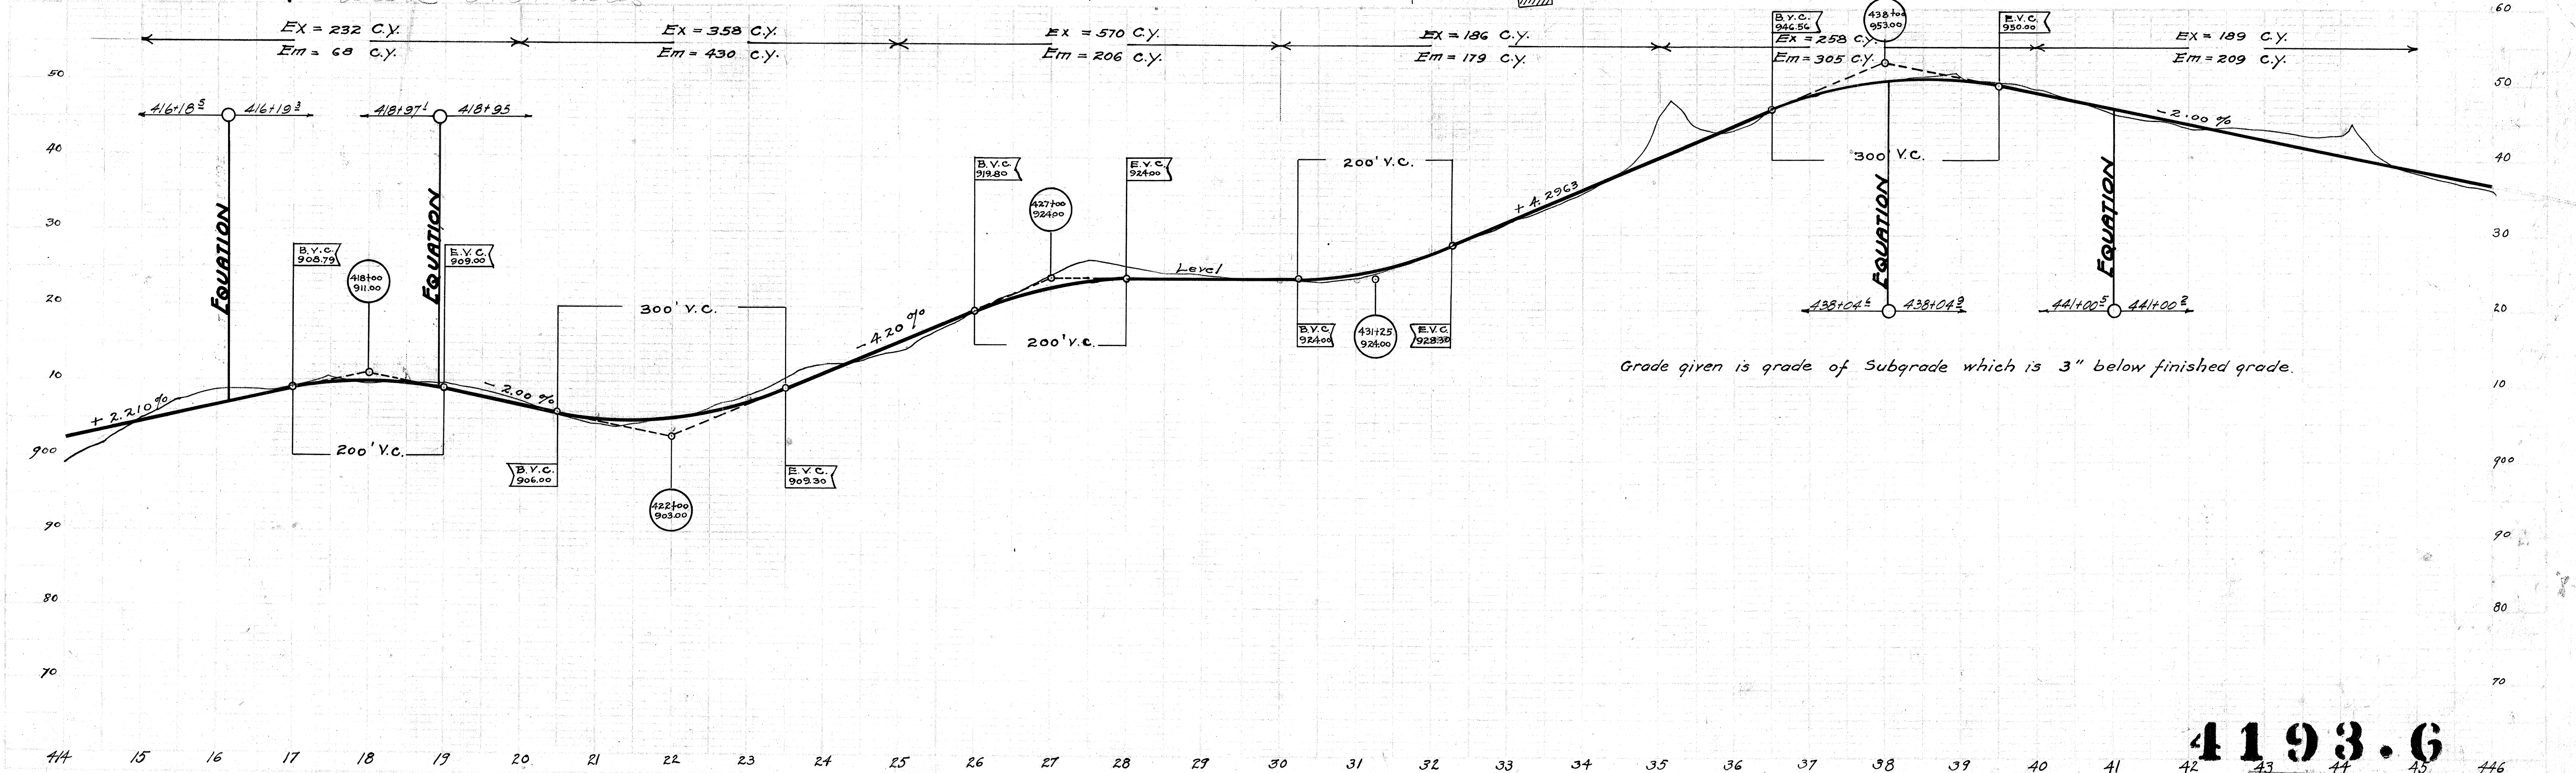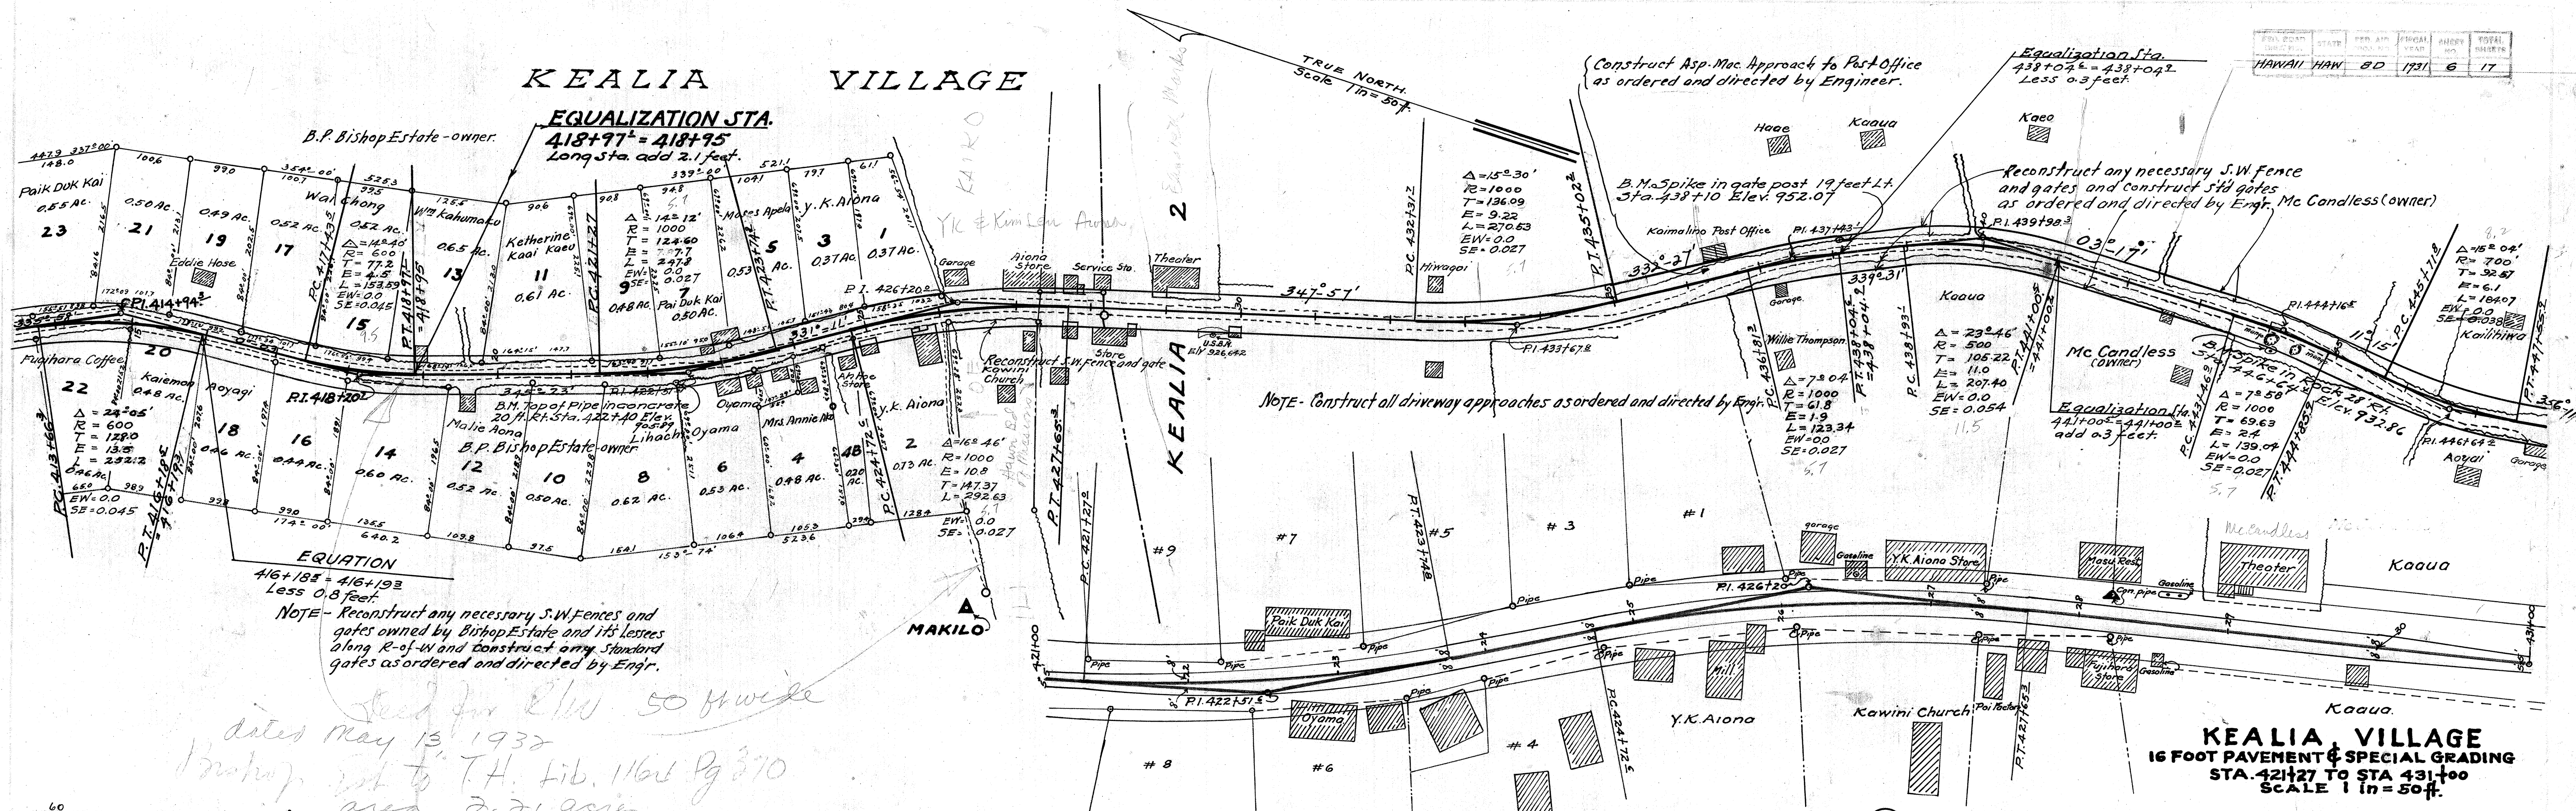

PRO. ROAD DIST. NO.	STATE	PRO. AIR DIST. NO.	LOCAL YEAR	SHEET NO.	TOTAL SHEETS
HAWAII	HAW	80	1931	7	17

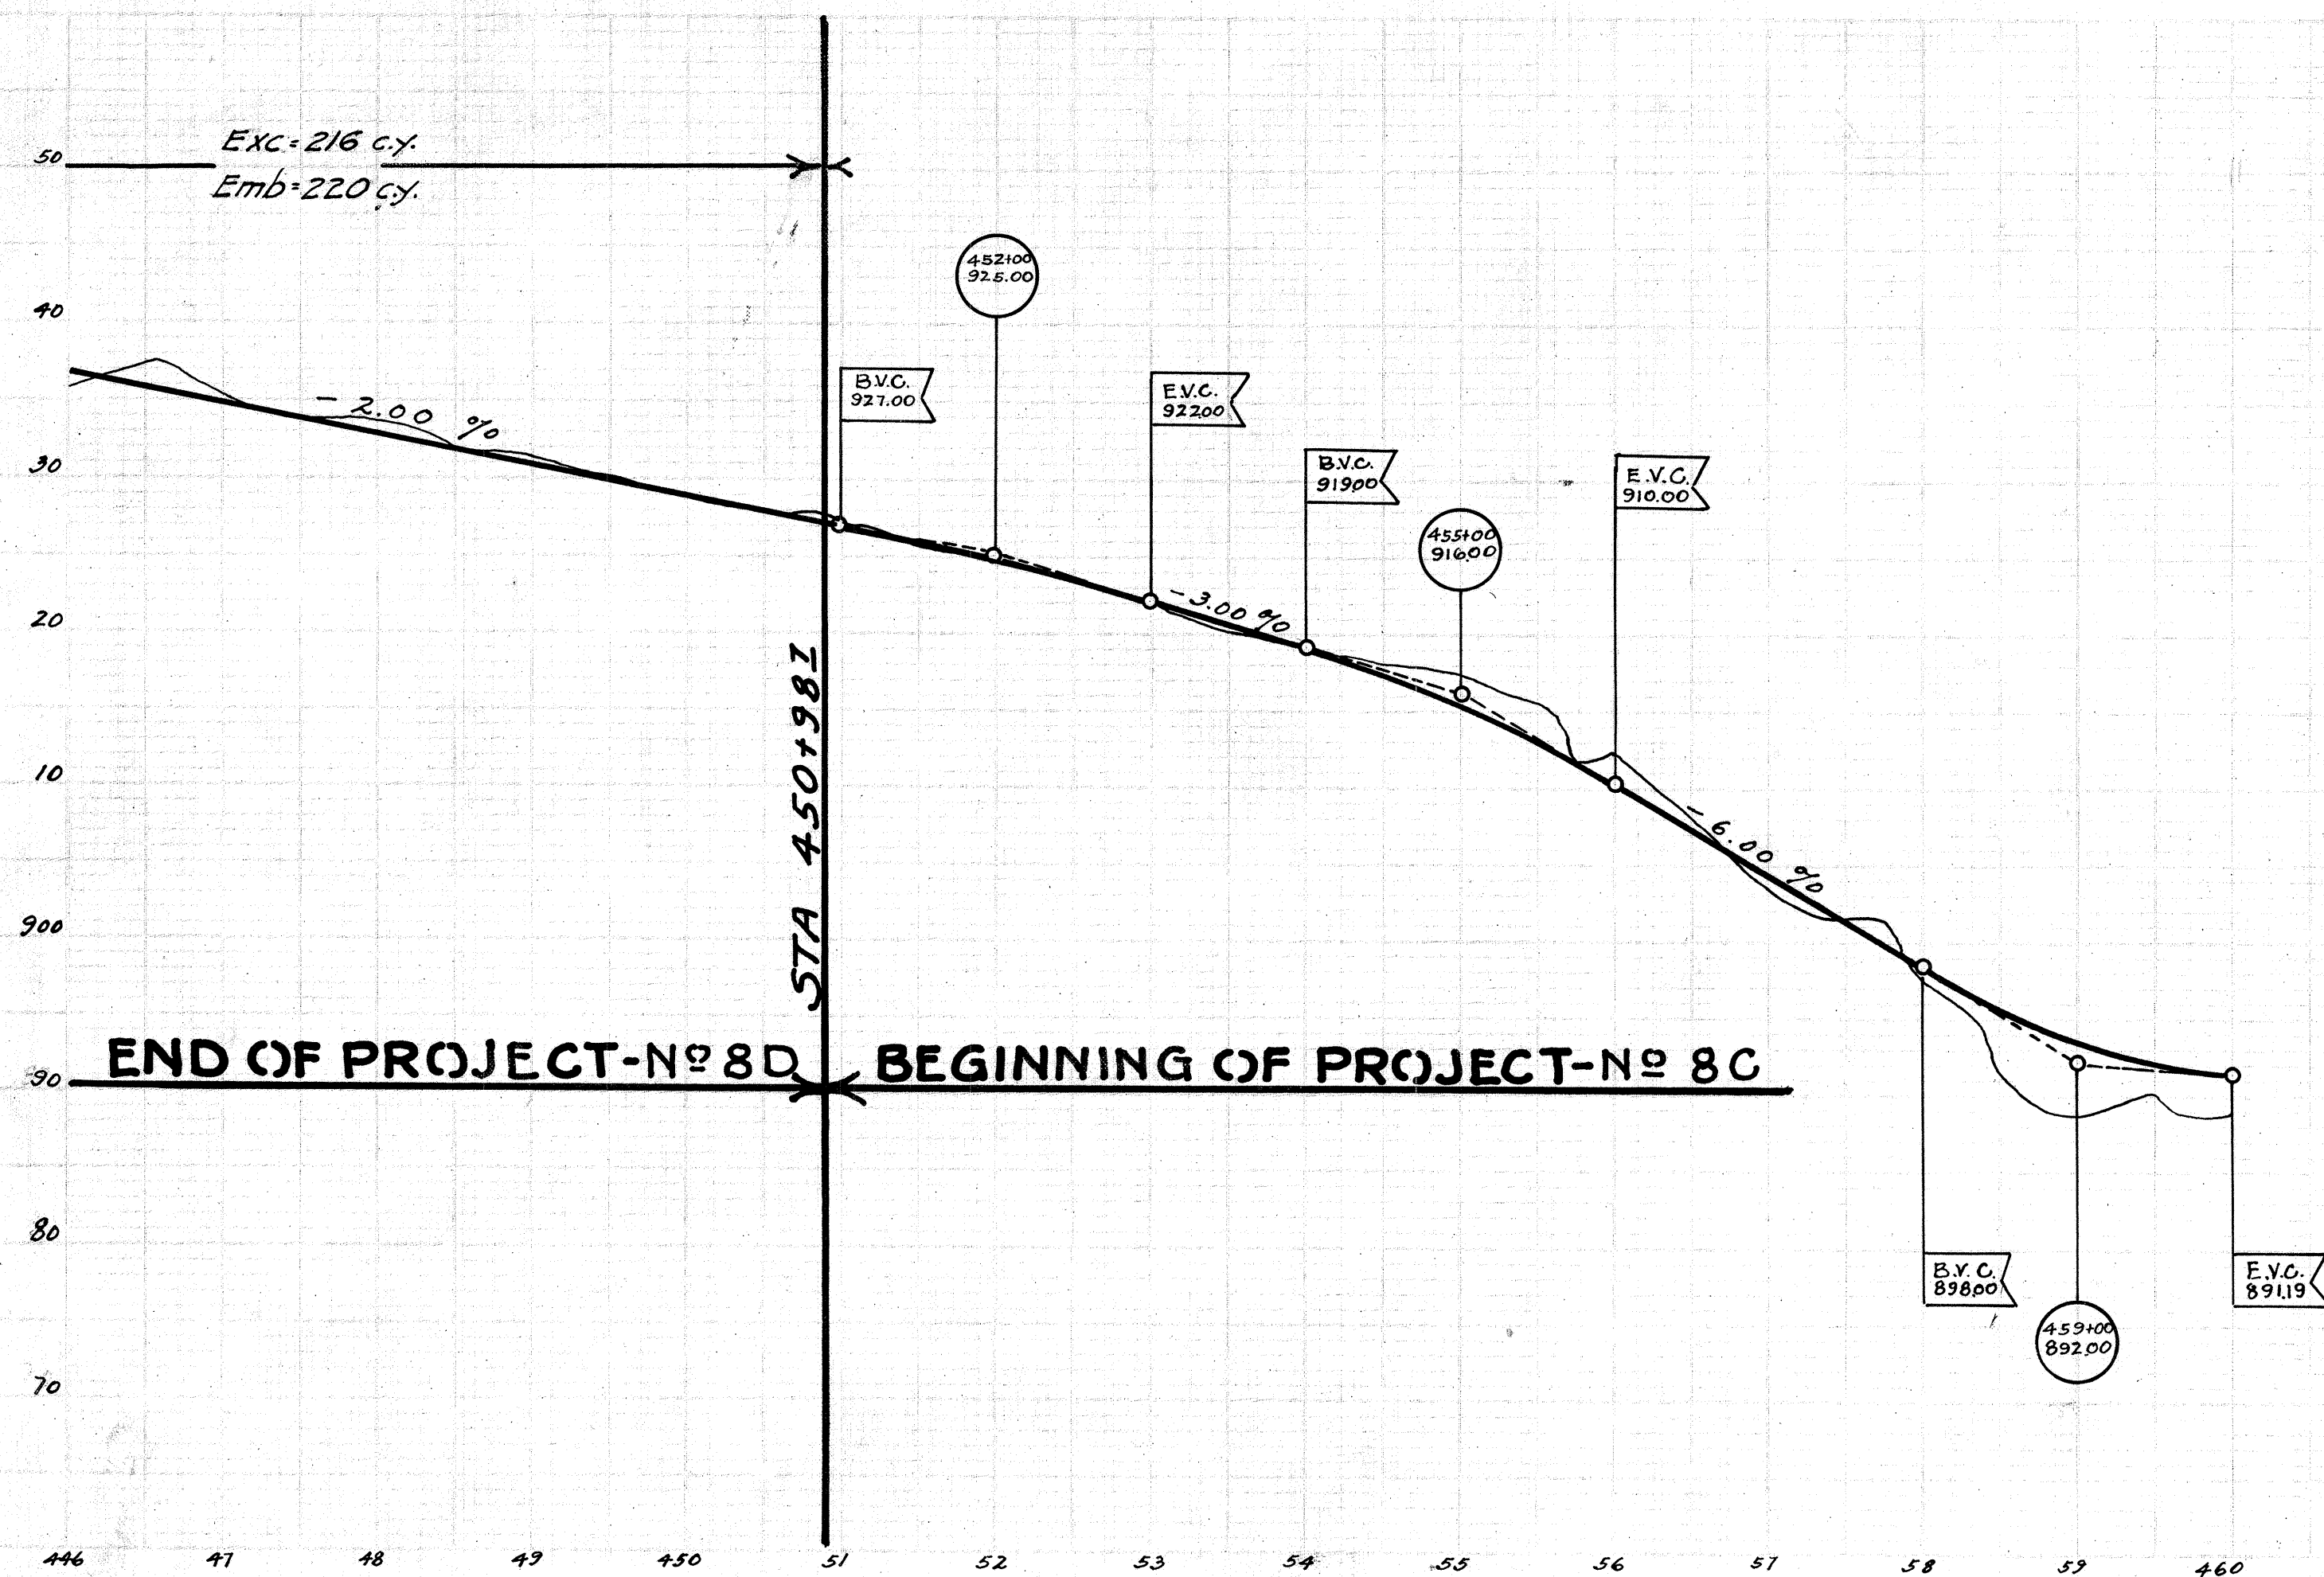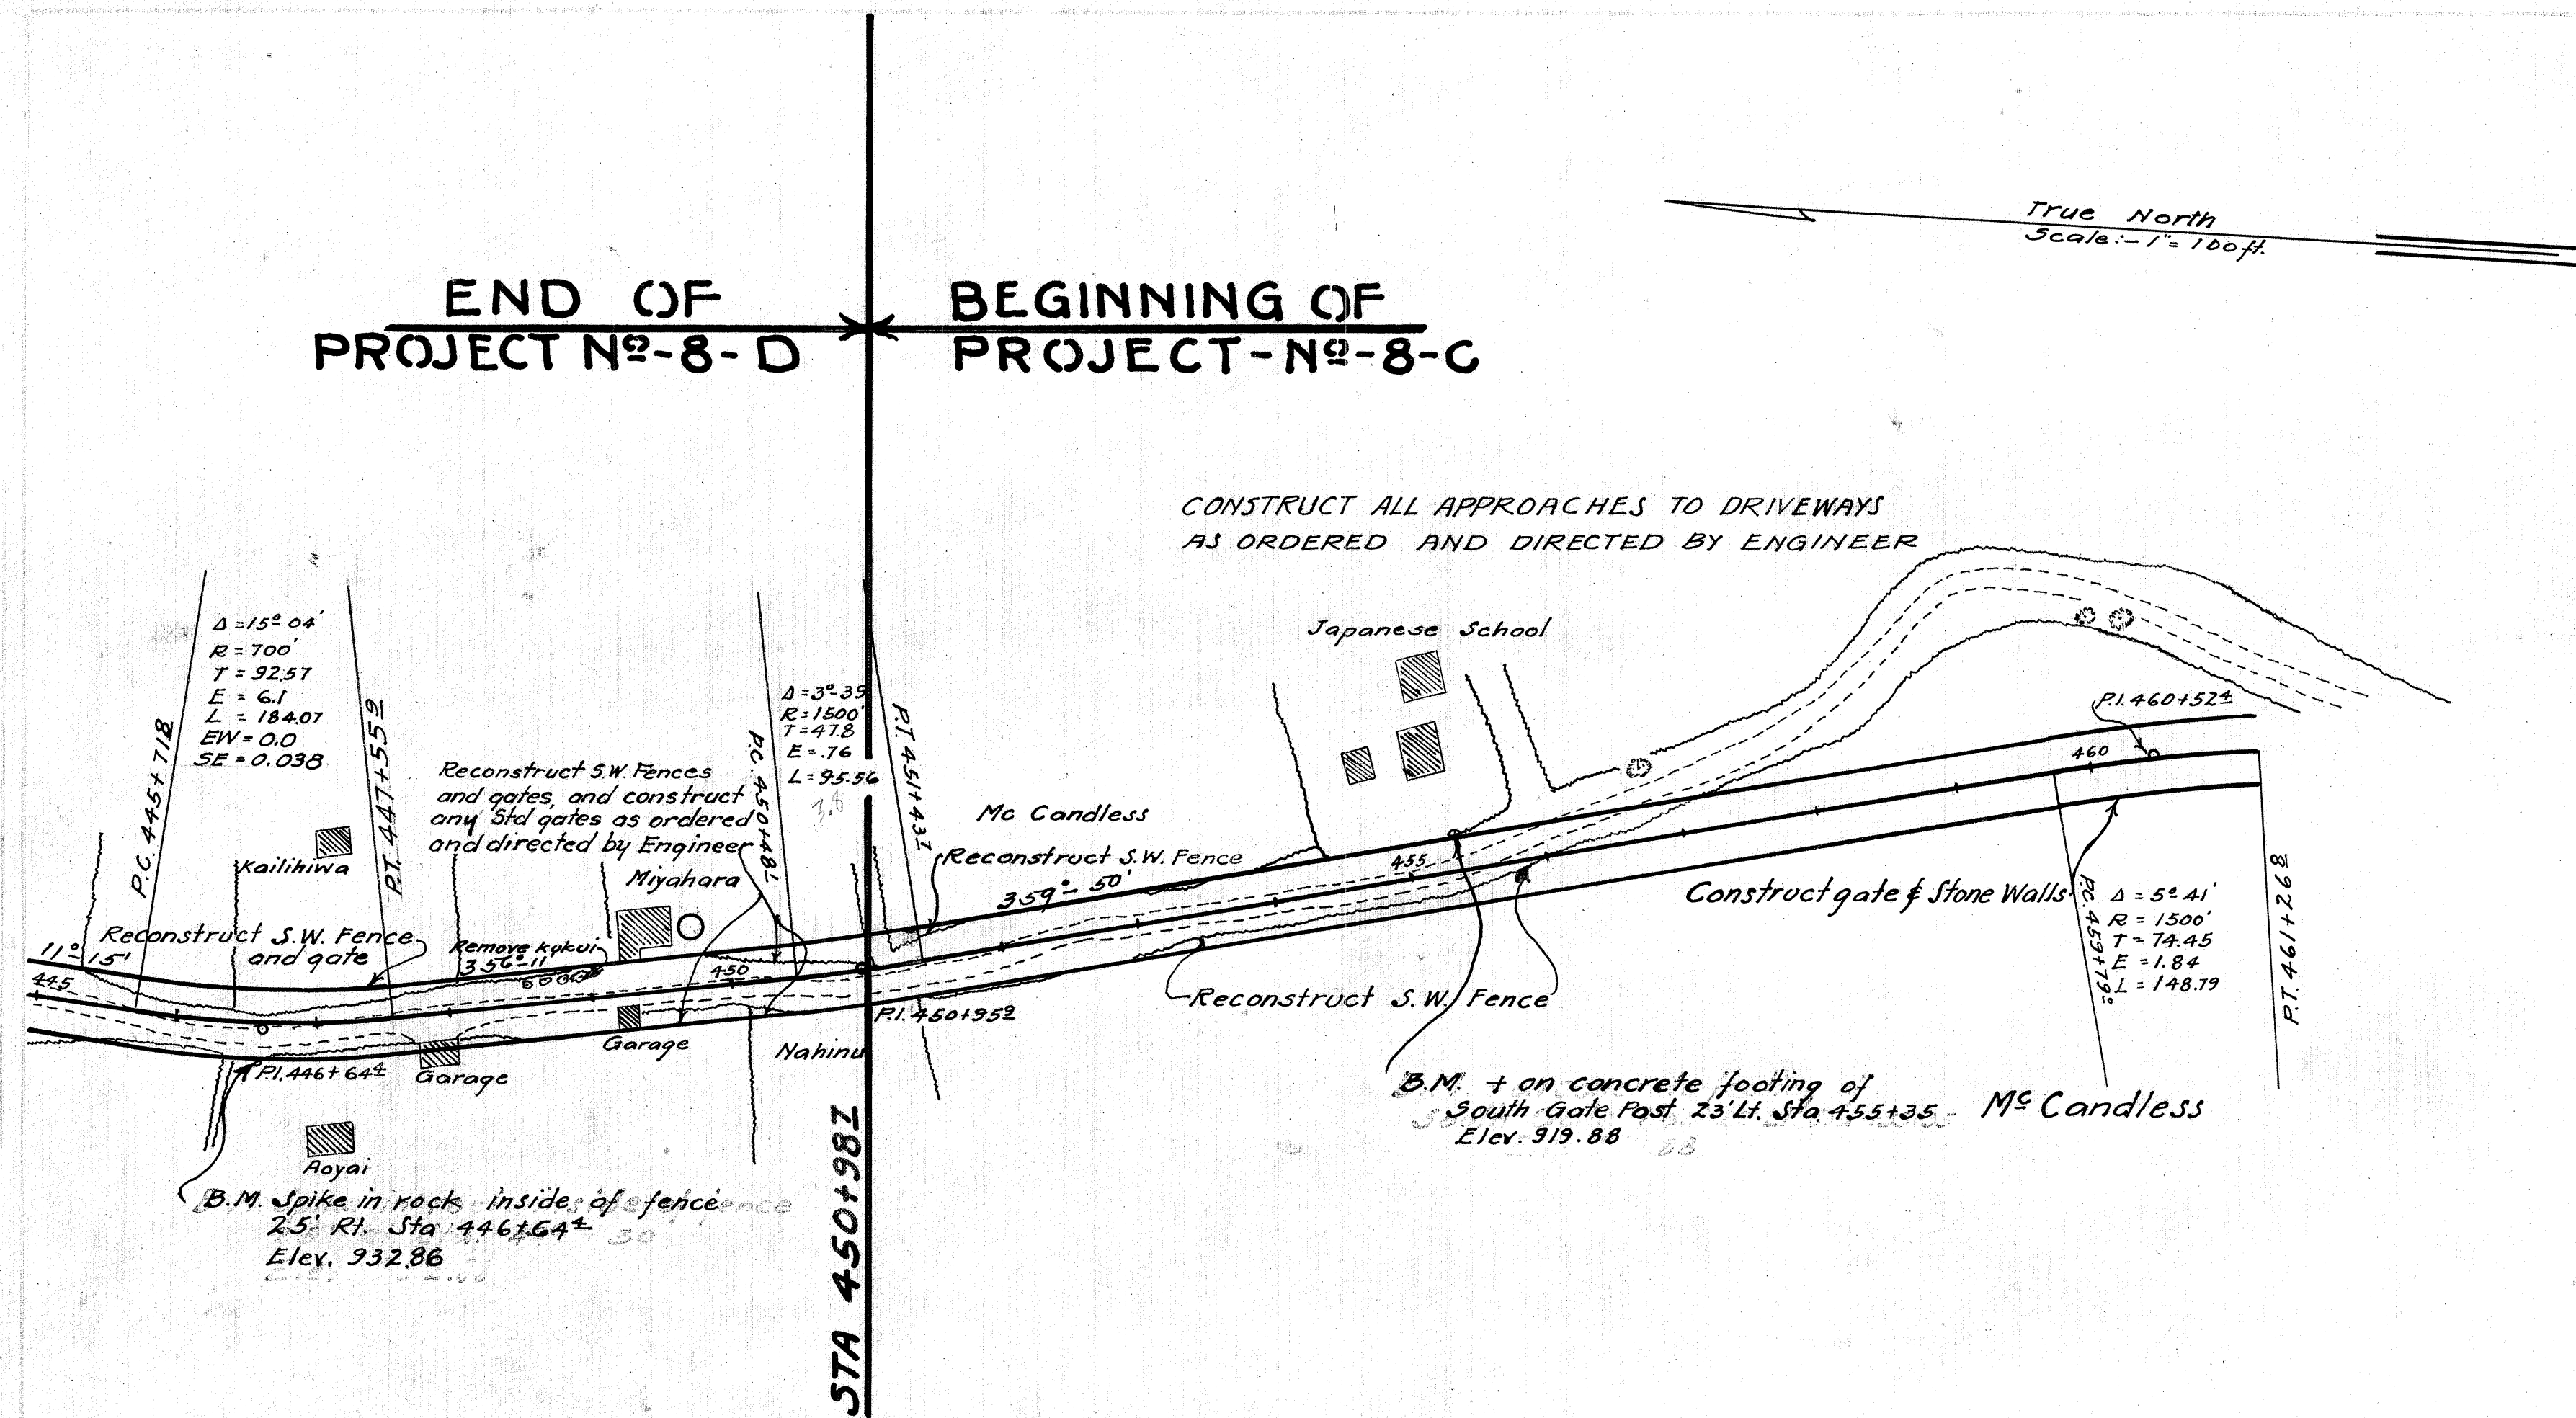

4193.7

Plan File No.	Pocket No.	Folder No.	Plan No.
6	10	1	